

CITY of TAMPA



WASTEWATER DEPARTMENT

PLANS FOR

KRAUSE PS REHABILITATION


CONTRACT NUMBER 14-C-00009

MAY 1, 2014

CONFORMED 1/27/15

RED LINES



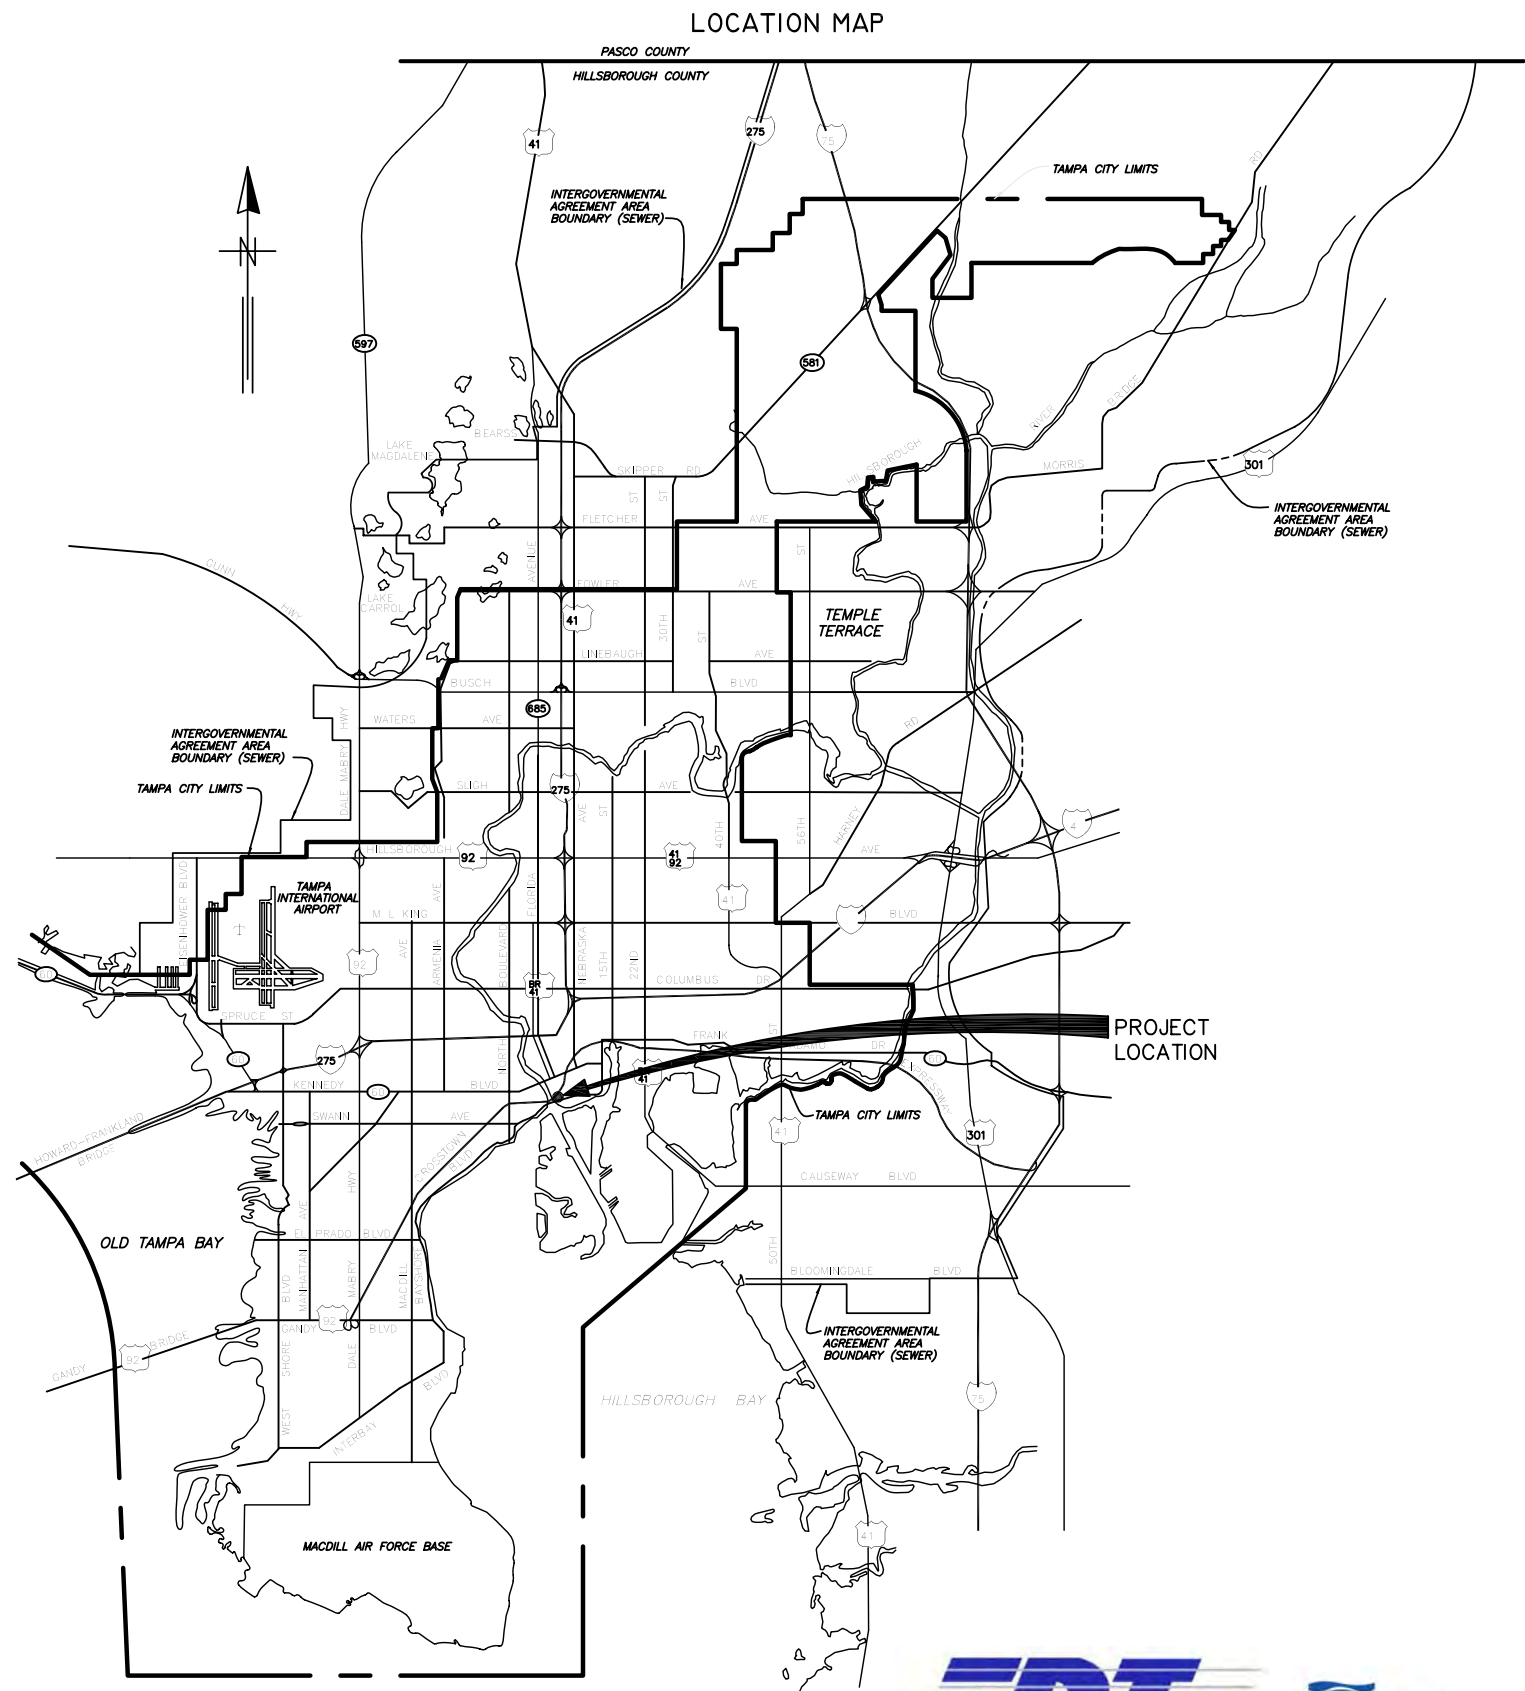

CITY of TAMPA



WASTEWATER DEPARTMENT

PLANS FOR

KRAUSE PS REHABILITATION

CONTRACT NUMBER 14-C-00009

RED LINES

ENGINEER OF RECORD:
BOB E. HALLMAN, P.E.
FLORIDA REGISTRATION NO. 20761



GREELEY AND HANSEN



KRAUSE PS REHABILITATION

COVER SHEET



Engineering Design
Technologies Corp.
P.O. Box 152403
Tampa, FL 33684-2403
813.289.8080
813.282.9184 FAX
engineering@edt1.com

CITY of TAMPA
WASTEWATER DEPARTMENT

Certificate of Authorization Number: 4795

1	1/27/15	CONFORMED
NO.	DATE	REVISIONS

DRAWN: RWB
DESIGN: STK
QC: BEH
DATE: 05/01/14

COVER

DRAWING INDEX

B080-002

CIVIL DRAWINGS

- G-1 GENERAL NOTES
- G-2 MECHANICAL SITE PLAN
- G-3 MECHANICAL YARD PIPING
- G-4 METER REPLACEMENT
- G-5 BYPASS DETAILS
- G-6 TEMPORARY BYPASS-CONCEPTUAL PLAN
- G-7 STANDARD DETAILS
- G-8 CONCEPTUAL MAINTENANCE OF TRAFFIC
- G-9 BYPASS AND MISCELLANEOUS DETAILS

MECHANICAL DEMOLITION DRAWINGS

- D-1 LOWER LEVEL MECHANICAL DEMOLITION PLAN
- D-2 UPPER LEVEL MECHANICAL DEMOLITION PLAN
- D-3 MECHANICAL DEMOLITION SECTIONS
- D-4 WATER, AIR AND PRIMING SYSTEM DIAGRAMS

MECHANICAL DRAWINGS

- M-1 LOWER LEVEL PLAN
- M-2 UPPER LEVEL PLAN
- M-3 SECTIONS AND DETAILS
- M-4 NEW AIR PIPING DIAGRAMS AND NEW SUCTION TUBE DETAILS
- M-5 AIR VACUUM PRIMING SYSTEM AND SUMP PUMP DIAGRAMS
- M-6 UPPER LEVEL PLAN
- M-7 SCREEN AREA SECTIONS AND DETAILS FOR DEBRIS REMOVAL EQUIPMENT
- M-8 WET WELL LEVELS

STRUCTURAL DRAWINGS

- S-1 GENERAL STRUCTURAL NOTES
- S-2 GENERAL STRUCTURAL NOTES
- S-3 GENERAL STRUCTURAL NOTES
- S-4 GENERAL STRUCTURAL NOTES
- S-5 EXISTING PLANS WITH NEW STRUCTURAL MODIFICATION & ADDITIONS


- S-6 EXISTING PLANS WITH NEW STRUCTURAL MODIFICATION & ADDITIONS
- S-7 EXISTING PLANS WITH NEW STRUCTURAL MODIFICATION & ADDITIONS
- S-8 EXISTING PLANS WITH NEW STRUCTURAL MODIFICATION & ADDITIONS
- S-9 EXISTING PLANS WITH NEW STRUCTURAL MODIFICATION & ADDITIONS
- S-10 TRANSFORMER FOUNDATION PLAN
- S-11 TRANSFORMER PLATFORM PLAN
- S-12 SECTIONS & DETAILS
- S-13 SECTIONS & DETAILS
- S-14 SECTIONS & DETAILS
- S-15 SECTIONS & DETAILS
- S-16 SECTIONS & DETAILS
- S-17 SECTIONS & DETAILS
- S-18 SECTIONS & DETAILS
- S-19 SECTIONS & DETAILS
- S-20 SECTIONS & DETAILS
- S-21 SECTIONS & DETAILS
- S-22 SECTIONS & DETAILS
- S-23 SECTIONS & DETAILS
- S-24 SECTIONS & DETAILS
- S-25 STRUCTURAL DETAIL
- S-26 STRUCTURAL DETAIL
- S-27 STRUCTURAL DETAIL
- S-28 ELEVATION
- S-29 PLAN
- S-30 SECTION
- S-31 PLAN
- S-32 SECTIONS & DETAILS
- S-33 SECTIONS & DETAILS
- S-34 SECTIONS AND DETAILS
- S-35 SECTIONS & DETAILS

- S-36 HOIST BEAM PLAN
- S-37 SECTIONS AND DETAILS

ELECTRICAL/INSTRUMENTATION DRAWINGS

- E-1 ELECTRICAL LEGEND & ABBREVIATIONS
- E-2 ELECTRICAL GENERAL NOTES
- E-3 ELECTRICAL DEMOLITION PLAN (UPPER LEVEL) (SHEET 1 OF 2)
- E-4 ELECTRICAL DEMOLITION PLAN (UPPER LEVEL) (SHEET 2 OF 2)
- E-5 ELECTRICAL DEMOLITION PLAN (LOWER LEVEL)
- E-6 ELECTRICAL EQUIPMENT LAYOUT (UPPER LEVEL - FLOOR ELEV. 7.54' NAVD) (SHEET 1 OF 2)
- E-7 ELECTRICAL EQUIPMENT LAYOUT (UPPER LEVEL - FLOOR ELEV. 7.54' NAVD) (SHEET 2 OF 2)
- E-8 ELECTRICAL EQUIPMENT LAYOUT (LOWER LEVEL - FLOOR ELEV. -5.99' NAVD)
- E-9 CONDUIT ROUTING PLAN - POWER (UPPER LEVEL - FLOOR ELEV. 7.54' NAVD) (SHEET 1 OF 2)
- E-10 CONDUIT ROUTING PLAN - POWER (UPPER LEVEL - FLOOR ELEV. 7.54' NAVD) (SHEET 2 OF 2)
- E-11 CONDUIT ROUTING PLAN - POWER (LOWER LEVEL - FLOOR ELEV. -5.99' NAVD)
- E-12 CONDUIT ROUTING PLAN - CONTROLS (UPPER LEVEL - FLOOR ELEV. 7.54' NAVD) (SHEET 1 OF 2)
- E-13 CONDUIT ROUTING PLAN - CONTROLS (UPPER LEVEL - FLOOR ELEV. 7.54' NAVD) (SHEET 2 OF 2)
- E-14 CONDUIT ROUTING PLAN - CONTROLS (LOWER LEVEL - FLOOR ELEV. -5.99' NAVD)
- E-15 SWITCHBOARD-KPS ELECTRICAL ONE-LINE DIAGRAM (SHEET 1 OF 2)
- E-16 SWITCHBOARD-KPS ELECTRICAL ONE-LINE DIAGRAM (SHEET 2 OF 2)
- E-17 MCC-KPS ELECTRICAL ONE-LINE DIAGRAM (SHEET 1 OF 2)
- E-18 MCC-KPS ELECTRICAL ONE-LINE DIAGRAM (SHEET 2 OF 2)
- E-19 ELECTRICAL RISER DIAGRAM (SHEET 1 OF 4)
- E-20 ELECTRICAL RISER DIAGRAM (SHEET 2 OF 4)
- E-21 ELECTRICAL RISER DIAGRAM (SHEET 3 OF 4)
- E-22 ELECTRICAL RISER DIAGRAM (SHEET 4 OF 4)
- E-23 KEYED NOTES
- E-24 GROUNDING GRID DETAILS

ENGINEER OF RECORD:
BOB E. HALLMAN, P.E.
FLORIDA REGISTRATION NO. 20761



Engineering Design
Technologies Corp.
P.O. Box 152403
Tampa, FL 33684-2403
813.289.8080
813.282.9184 FAX
engineering@edt1.com

Certificate of Authorization Number: 4795

CITY of TAMPA
WASTEWATER DEPARTMENT

KRAUSE PS REHABILITATION

DRAWING INDEX
(SHEET 1 OF 2)

RED LINES

1	1/27/15	CONFORMED
NO.	DATE	REVISIONS

DRAWN: RWB
DESIGN: STK
QC: BEH
DATE: 05/01/14

INDEX-1

DRAWING INDEX

B080-003

ELECTRICAL/INSTRUMENTATION DRAWINGS

- E-25 EXHAUST FAN & SUPPLY FAN LAYOUT
- E-26 ELECTRICAL LIGHTING & POWER PLAN
(UPPER LEVEL – FLOOR ELEV. 7.54’ NAVD) (SHEET 1 OF 2)
- E-27 ELECTRICAL LIGHTING & POWER PLAN
(UPPER LEVEL – FLOOR ELEV. 7.54’ NAVD) (SHEET 2 OF 2)
- E-28 ELECTRICAL LIGHTING & POWER PLAN
(LOWER LEVEL – FLOOR ELEV. -5.99’ NAVD)
- E-29 TYPICAL AFD CONNECTION DIAGRAM (SHEET 1 OF 2)
- E-30 TYPICAL AFD CONNECTION DIAGRAM (SHEET 2 OF 2)
- E-31 AIR COMPRESSOR & PUMP SUCTION VALVE CONTROL DIAGRAMS
- E-32 VALVE CONTACT DEVELOPMENT CHARTS
- E-33 REMOTE CIRCUIT BREAKER PANEL (RCBP) DETAILS (SHEET 1 OF 3)
- E-34 REMOTE CIRCUIT BREAKER PANEL (RCBP) DETAILS (SHEET 2 OF 3)
- E-35 REMOTE CIRCUIT BREAKER PANEL (RCBP) DETAILS (SHEET 3 OF 3)
- E-36 CIRCUIT BREAKER CONTROL DIAGRAM (SHEET 1 OF 4)
- E-37 CIRCUIT BREAKER CONTROL DIAGRAM (SHEET 2 OF 4)
- E-38 CIRCUIT BREAKER CONTROL DIAGRAM (SHEET 3 OF 4)
- E-39 CIRCUIT BREAKER CONTROL DIAGRAM (SHEET 4 OF 4)
- E-40 PUMP/MOTOR CONNECTION DETAIL
- E-41 SWITCHBOARD CONDUIT DETAILS
- E-42 MAGNETIC FLOW METER CONNECTION DETAIL
- E-43 ELECTRICAL DETAILS
- E-44 ELECTRICAL DETAILS
- E-45 ELECTRICAL DETAILS
- E-46 ELECTRICAL DETAILS
- E-47 ELECTRICAL PANELBOARD SCHEDULE
- E-48 LUMINAIRE SCHEDULE
- E-49 CONDUIT SCHEDULE
- E-50 CONDUIT SCHEDULE
- E-51 CONDUIT SCHEDULE
- E-52 CONDUIT SCHEDULE
- E-53 CONDUIT SCHEDULE
- E-54 CONDUIT SCHEDULE

- E-55 CONDUIT SCHEDULE
- E-56 CONDUIT SCHEDULE
- I-1 CONTROL PANEL/PLC POWER CONNECTIONS
- I-2 PROPOSED ANNUNCIATOR RISER DIAGRAM &
PARTIAL EQUIPMENT BACK PANEL LAYOUT
- I-3 PLC INTERCONNECTION DIAGRAM (SHEET 1 OF 6)
- I-4 PLC INTERCONNECTION DIAGRAM (SHEET 2 OF 6)
- I-5 PLC INTERCONNECTION DIAGRAM (SHEET 3 OF 6)
- I-6 PLC INTERCONNECTION DIAGRAM (SHEET 4 OF 6)
- I-7 PLC INTERCONNECTION DIAGRAM (SHEET 5 OF 6)
- I-8 PLC INTERCONNECTION DIAGRAM (SHEET 6 OF 6)
- I-9 BUBBLER PANEL DETAILS (SHEET 1 OF 2)
- I-10 BUBBLER PANEL DETAILS (SHEET 2 OF 2)
- I-11 TEMPERATURE ALARM/MONITOR DETAILS

HVAC DRAWINGS

- M0.1 MECHANICAL LOWER LEVEL DEMOLITION PLAN
- M2.1 MECHANICAL LOWER LEVEL DEMOLITION PLAN
- M2.2 MECHANICAL UPPER LEVEL DEMOLITION PLAN
- M4.1 MECHANICAL LOWER LEVEL RENOVATION PLAN
- M4.2 MECHANICAL UPPER LEVEL (LOW) RENOVATION PLAN
- M4.3 MECHANICAL UPPER LEVEL (HIGH) RENOVATION PLAN
- M8.1 MECHANICAL SECTION
- M9.1 MECHANICAL DETAILS
- M10.1 MECHANICAL CONTROLS / SEQUENCE OF OPERATIONS
- M11.1 MECHANICAL FAN SCHEDULE

ENGINEER OF RECORD:
BOB E. HALLMAN, P.E.
FLORIDA REGISTRATION NO. 20761



Certificate of Authorization Number: 4795

Engineering Design
Technologies Corp.
P.O. Box 152403
Tampa, FL 33684-2403
813.289.8080
813.282.9184 FAX
engineering@edt1.com

CITY of TAMPA
WASTEWATER DEPARTMENT

KRAUSE PS REHABILITATION

DRAWING INDEX
(SHEET 2 OF 2)

RED LINES

1	1/27/15	CONFORMED
NO.	DATE	REVISIONS

DRAWN: RWB
DESIGN: STK
QC: BEH
DATE: 05/01/14

INDEX-2

GENERAL NOTES:


1. CONTRACTOR SHALL COORDINATE ALL CONSTRUCTION ACTIVITIES WITH THE ENGINEER AND THE CITY OF TAMPA WASTEWATER DEPARTMENT PERSONNEL PRIOR TO COMMENCING CONSTRUCTION ACTIVITIES.
2. ALL ELEVATIONS SHOWN ARE BASED ON 1988 NAVD.
3. EXISTING DIMENSIONS AND ELEVATIONS ARE BASED ON THE BEST INFORMATION AVAILABLE. TRUE DIMENSIONS AND ELEVATIONS SHALL BE DETERMINED IN THE FIELD PRIOR TO LAYOUT AND SHOP DRAWING SUBMITTALS.
4. ALL SUBMITTALS AND SHOP DRAWINGS SHALL BE ORIGINALS OR HIGH QUALITY COPIES (EASILY READABLE). NO FAXED SHEETS OR POOR QUALITY COPIES WILL BE ACCEPTED FOR SUBMITTAL REVIEW.
5. THE CONTRACTOR IS RESPONSIBLE FOR PROVIDING, INSTALLING, LEVELING AND ALIGNING MOTOR AND PUMP. PROCEDURES FOR INSTALLATION, AS OUTLINED IN THE HYDRAULICS INSTITUTE STANDARDS, MOST CURRENT EDITION, SHALL BE ADHERED TO. SEE SPECIFIC PROVISIONS. IF THERE IS A CONFLICT BETWEEN THE REQUIREMENTS OF THE CONTRACT SPECIFICATIONS AND THE HYDRAULIC INSTITUTE STANDARDS, THE MOST STRINGENT STANDARD SHALL BE FOLLOWED.
6. REPLACE ALL AIR SUPPLY PIPING AND VACUUM PIPING. LAY-OUT NEW PIPING AS REQUIRED FOR THE NEW EQUIPMENT. ISOLATION BALL VALVES AND PIPE UNIONS SHALL BE PROVIDED TO ALLOW REMOVAL OF EQUIPMENT. PIPING SHALL BE TYPE K HARD DRAWN COPPER WITH CAST BRASS SOLDERED FITTINGS. ALL JOINTS SHALL BE THREADED OR SOLDERED. COPPER PIPE SHALL MEET THE REQUIREMENTS AND SHALL BE PAINTED IN ACCORDANCE WITH THE CONTRACT SPECIFICATIONS.
7. PUMP ANCHOR BOLTS SHALL BE PER PUMP MANUFACTURER'S RECOMMENDATIONS. ANCHOR BOLTS SHALL BE DOUBLE-NUTTED AND SHALL HAVE SUFFICIENT LENGTH SO THAT THE BOLTS EXTEND BEYOND THE FASTENING NUTS BY A MINIMUM OF 1/2 INCH.
8. ALL HARDWARE, UNLESS OTHERWISE NOTED, SHALL BE TYPE 316 STAINLESS STEEL.
9. PROPOSED STEEL SPOOL PIECES AND FITTINGS (INCLUDING PUMP DISCHARGE AND SUCTIONS REDUCERS) SHALL BE FABRICATED TO SUIT THE DIMENSIONS OF THE PROPOSED EQUIPMENT OR LAYOUT, AND SHALL BE ASTM A 36 STEEL WITH A MINIMUM WALL THICKNESS OF 1/2 INCH. STEEL PIPE SHALL BE LINED WITH COAL TAR EPOXY (MINIMUM 3/32" THICK) IN ACCORDANCE WITH AWWA C203. FABRICATED STEEL FITTINGS SHALL BE MANUFACTURED BY AN AWWA CERTIFIED FABRICATOR.
10. ALL FIELD WELDS SHALL CONFORM TO PROCEDURES OUTLINED IN AWWA M 11 AND AWWA C 206.
11. CONTRACTOR SHALL PROCURE THE SERVICES OF AN INDEPENDENT CERTIFIED WELDING INSPECTOR TO TEST ALL FIELD WELDS. CERTIFIED WELD INSPECTOR SHALL PERFORM AS A MINIMUM A VISUAL INSPECTION AND EITHER A DYE PENETRATING TINT OR MAG PARTICLE TEST TO ASSERT QUALITY OF FIELD WELDS.
12. BURIED DUCTILE IRON PIPE SHALL BE MINIMUM PRESSURE CLASS 200 AND SHALL HAVE CEMENT MORTAR LINING, EXCEPT WHERE REQUIRED TO HAVE CERAMIC EPOXY LINING. ALL FITTINGS, BENDS AND VALVES FOR THIS PIPELINE SHALL BE POLYETHYLENE ENCASED AND INSTALLED USING CLASS C BEDDING, UNLESS OTHERWISE SHOWN OR DIRECTED.
13. RESTRAIN ALL NEW DUCTILE IRON PIPE, VALVES AND FITTINGS. BURIED DUCTILE IRON PIPE SHALL BE MECHANICAL JOINT TYPE AND RESTRAINED BY EXTERNAL JOINT RESTRAINERS "MEGALUG SERIES 1100" AS MANUFACTURED BY EBBA IRON OR APPROVED EQUAL.
14. EXPOSED DUCTILE IRON PIPE SHALL BE FLANGED, MINIMUM CLASS 53 AND SHALL HAVE CERAMIC EPOXY LINER.
15. THE CONTRACTOR SHALL INSTALL THE FORCE MAIN TO THE ELEVATIONS AND SLOPES SHOWN ON THE DRAWINGS. THERE SHALL BE NO INTERMEDIATE HIGH OR LOW POINTS BETWEEN V.P.I.'S.
16. CONTRACTOR SHALL RESTORE ANY LANDSCAPING, SIDEWALK, CURBING, FENCING, SODDING AND SPRINKLER SYSTEM PIPING THAT MAY HAVE BEEN DAMAGED DURING CONSTRUCTION TO ITS ORIGINAL CONDITION OR BETTER.
17. THE CONTRACTOR SHALL REMOVE ALL DEBRIS FROM WETWELL, PRESSURE WASH ALL WETWELL CONCRETE SURFACES, PREPARE CONCRETE SURFACE AND APPLY 125 MILS OF AN APPROVED COATING SYSTEM IN ACCORDANCE WITH TECHNICAL SPECIFICATION NO. 52 - MANHOLE AND STRUCTURE REHABILITATION.
18. OSHA STANDARD SAFETY EQUIPMENT SUCH AS, BUT NOT LIMITED TO, SAFETY HARNESSSES, GAS MONITORS, LOWER EXPLOSIVE LIMIT(LEL) DETECTORS, BREATHING APPARATUS, ETC. SHALL BE UTILIZED WHERE THE WORK DICTATES THEIR USE.
19. CONTRACTOR SHALL PRESSURE WASH ALL EXISTING WALLS AND CEILINGS WITHIN THE PUMP ROOM AND THE WET WELL TO REMOVE ALL LOOSE PAINT AND DEBRIS FROM THE WALLS. CONTRACTOR SHALL CONTAIN ALL PAINT DEBRIS AND PREVENT FROM ENTERING THE SEWER SYSTEM AND DISPOSE OF PROPERLY. CONTRACTOR SHALL PAINT ALL INTERIOR WALLS OF THE PUMP ROOM BELOW ELEVATION +7.54 (LOWER LEVEL), IN ACCORDANCE WITH THE SPECIFICATIONS. REFER TO PLAN SHEET S-7 FOR CLEANING AND COATING OF THE STEEL ROOF FRAMING.

DEMOLITION NOTES:

1. ALL DIMENSIONS ARE APPROXIMATE. ACTUAL DIMENSIONS SHALL BE DETERMINED IN THE FIELD.
2. SALVAGEABLE MATERIALS AS DETERMINED BY THE WASTEWATER DEPARTMENT PERSONNEL SHALL BE DELIVERED TO THE CITY OF TAMPA'S HOWARD F. CURREN AWTP, LOCATED AT 2700 MARITIME BLVD., TAMPA, FL 33605. NON-SALVAGEABLE MATERIALS ARE TO BE REMOVED FROM SITE AND PROPERLY DISPOSED OF AT THE CONTRACTOR'S EXPENSE. IN GENERAL, ALL PUMP AND CONTROLS EQUIPMENT SHALL REMAIN PROPERTY OF THE CITY AND BE CONSIDERED SALVAGEABLE. REFER TO SPECIFIC PROVISIONS.
3. CONTRACTOR SHALL CUT ALL EXPOSED REINFORCING STEEL TO A DEPTH OF 1-INCH BELOW THE EXPOSED SURFACE AND THE OPENING SHALL BE SEALED WITH GROUT.

B080-004

LEGEND

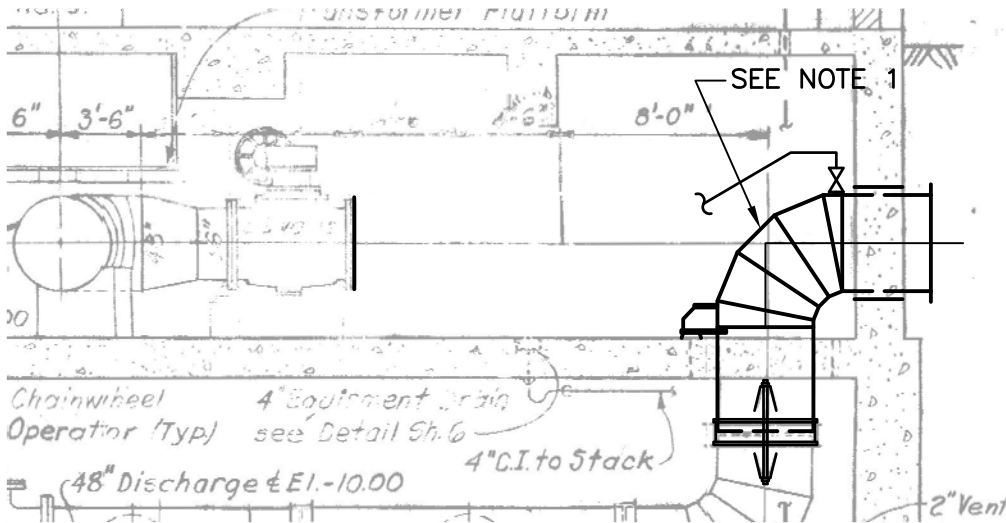

NOTES:

1. ALL WORK INCLUDED IN THIS CONTRACT IS SHOWN IN BOLD. LIGHT LINEWEIGHT DENOTES EQUIPMENT, STRUCTURES, PIPING, ETC. THAT WILL REMAIN AND BE REUSED AND IS ENTENDED AS BACKGROUND INFORMATION, EXCEPT WHERE NOTED OTHERWISE IN THESE PLANS BY BOLD ANNOTATION.

RED LINES



GREELEY AND HANSEN

1715 N. WESTSHORE BLVD., STE. 464
TAMPA, FLORIDA 33607
CERTIFICATE OF AUTHORIZATION NO. 37

P.E. NAME: FREDDY J. BETANCOURT P.E. NO. 68072

P.E. NAME: _____
DATE: _____



Engineering Design
Technologies Corp.
P.O. Box 152403
Tampa, FL 33684-2403
813.289.8080
813.282.9184 FAX
engineering@edt1.com

CITY of TAMPA

WASTEWATER DEPARTMENT

KRAUSE PS REHABILITATION

GENERAL NOTES


NO.	DATE	REVISIONS
2	1/27/15	CONFORMED
1	7/11/14	ADD NOTE 19

DRAWN: J. WHITE
DESIGN: FJB
QC: DCH
DATE: 01/27/15


SHEET G-1

HILLSBOROUGH RIVER

B080-005

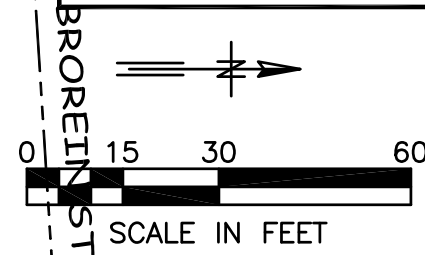

NOTES:
1. THE THREE BURIED 36" PLUG VALVES HAVE BEEN SHOWN PER RECORD DRAWINGS. ALL VALVE BOXES HAVE BEEN PAVED OVER. CONTRACTOR SHALL FIELD LOCATE THESE VALVES. THE CONTRACTOR SHALL COORDINATE WITH THE CITY FOR OPERATION OF THESE VALVES AT THE TIME OF BYPASS ASSEMBLY INSTALLATION.

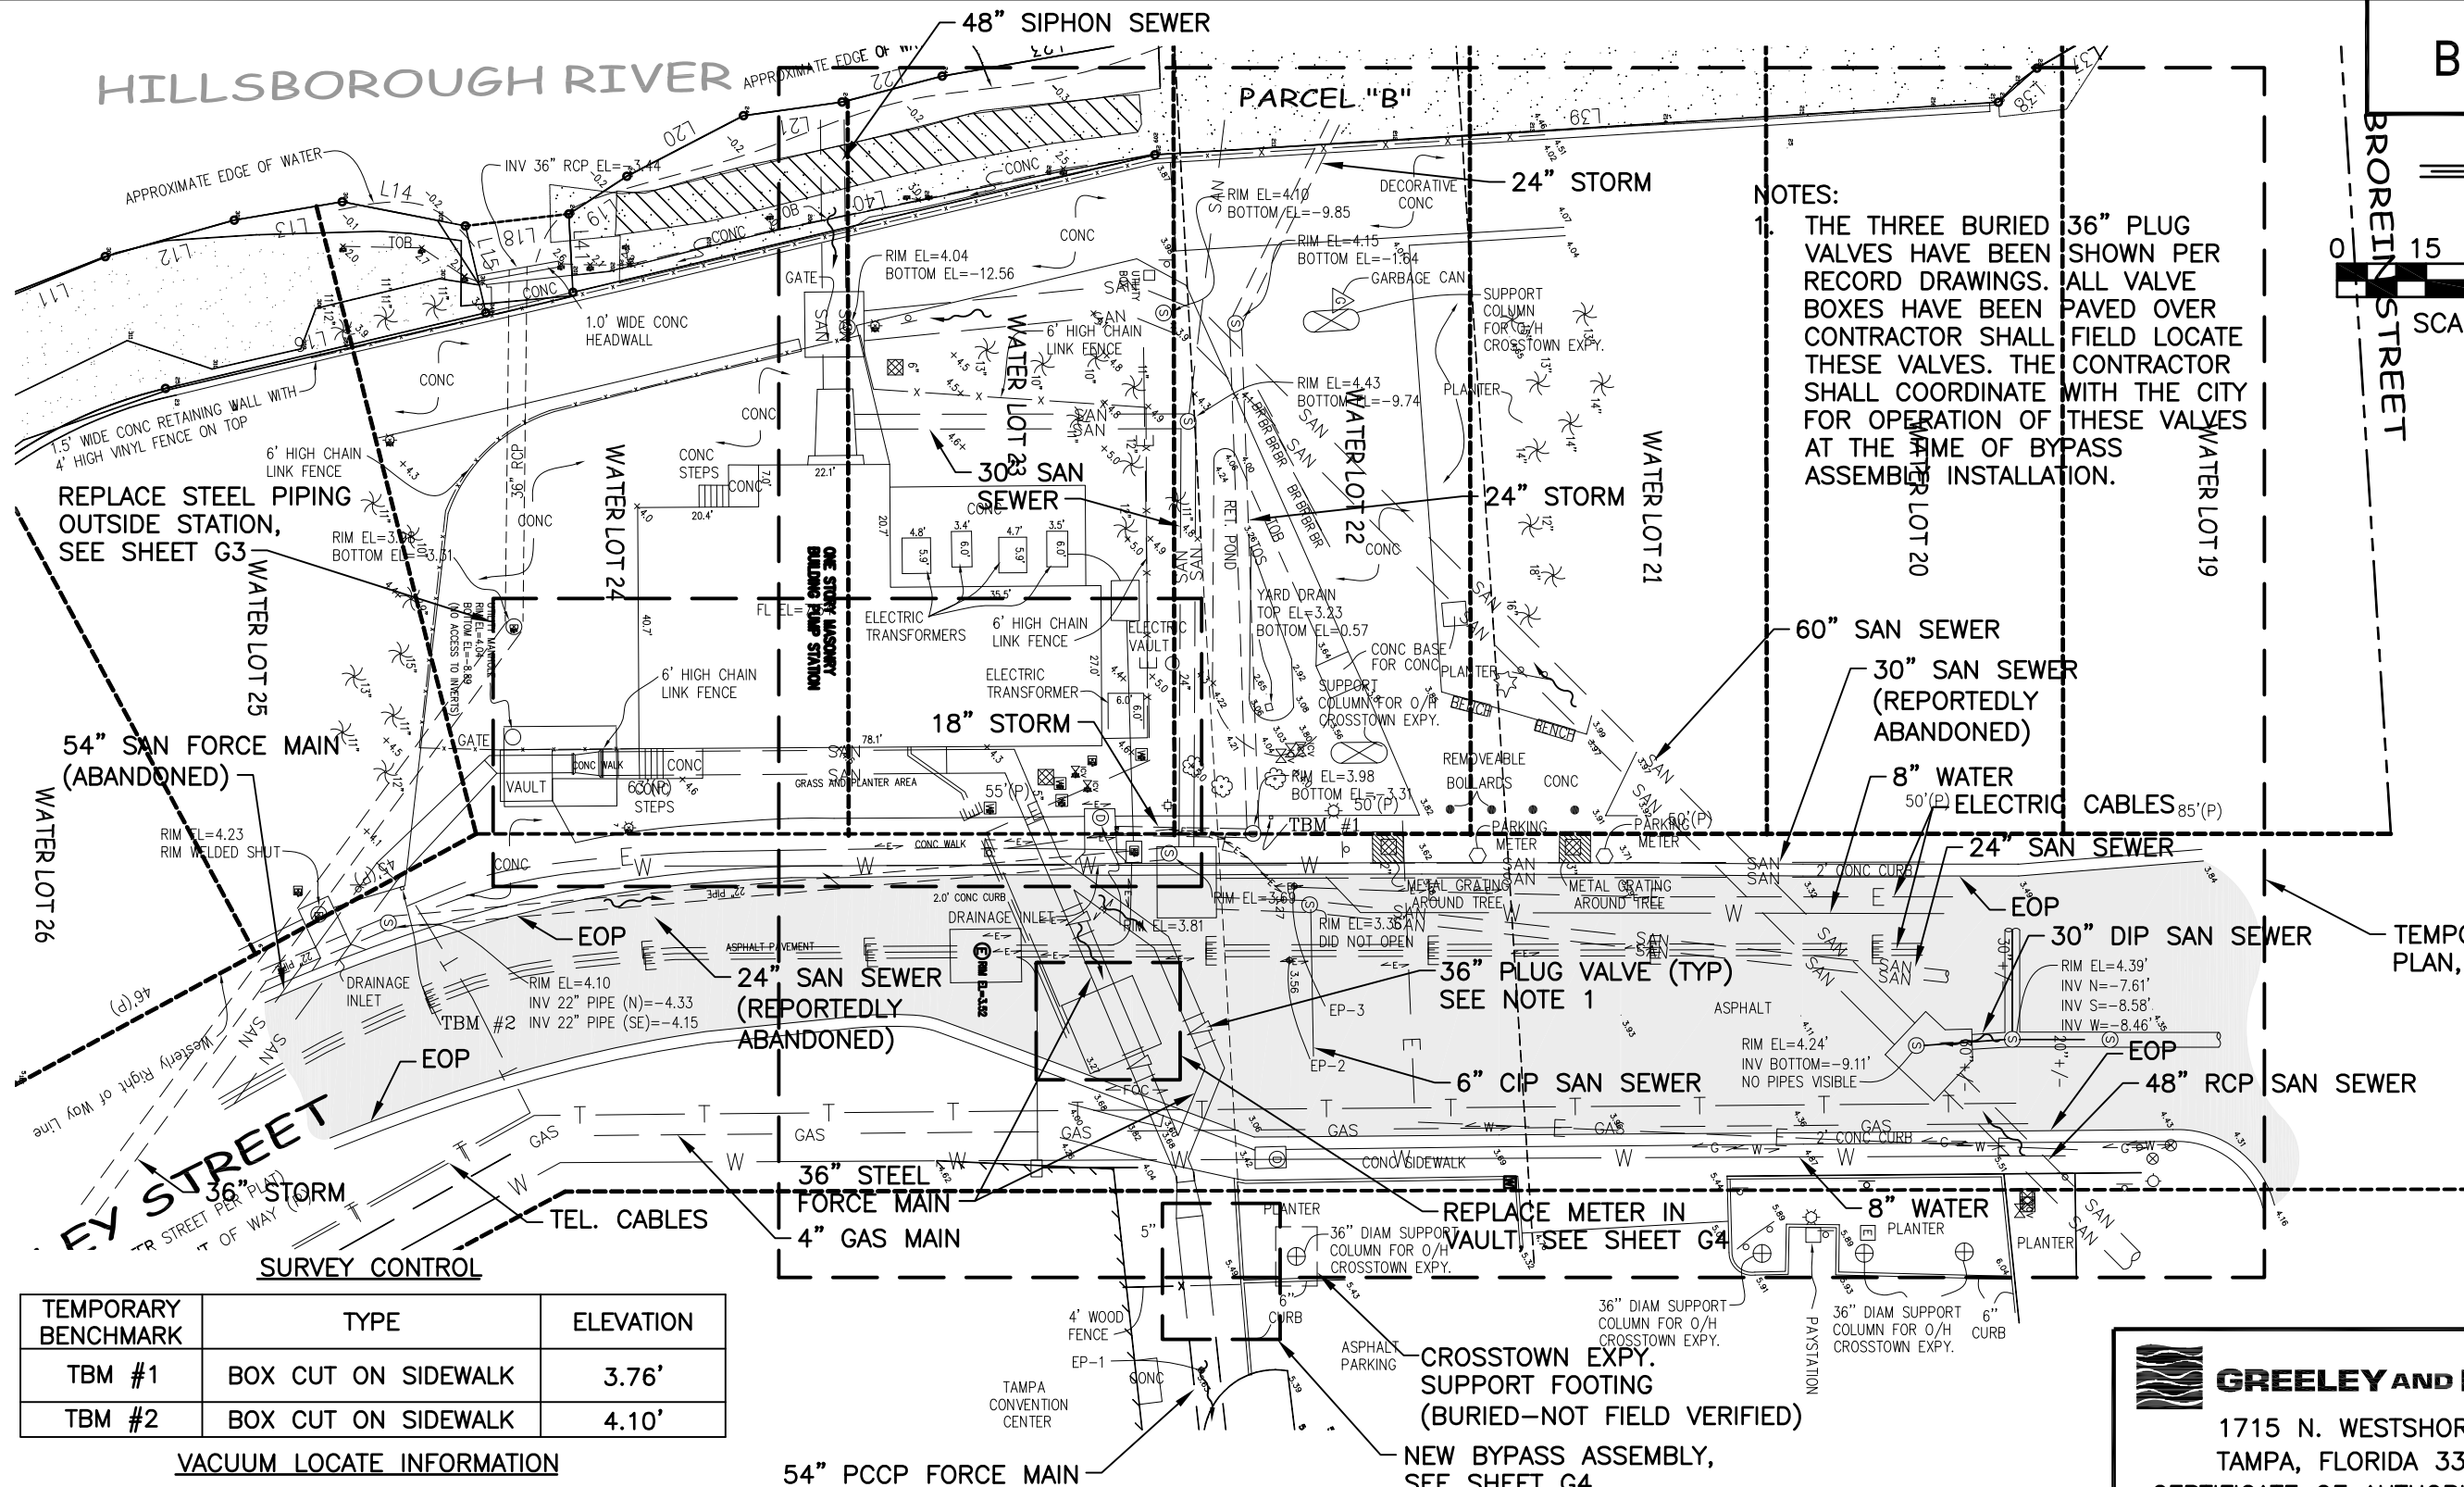


TEMPORARY BENCHMARK	TYPE	ELEVATION
TBM #1	BOX CUT ON SIDEWALK	3.76'
TBM #2	BOX CUT ON SIDEWALK	4.10'


VACUUM LOCATE INFORMATION		
EP-1	54" PCCP FORCE MAIN	TOP EL 0.2
EP-2	ELECTRICAL CONDUITS	TOP EL 0.3
EP-3	ELECTRICAL CABLE	TOP EL -1.2

MECHANICAL SITE PLAN

SCALE: 1" = 30'

**GREELEY AND HANSEN**
1715 N. WESTSHORE BLVD., STE. 464
TAMPA, FLORIDA 33607
CERTIFICATE OF AUTHORIZATION NO. 37

P.E. NAME: FREDDY J. BETANCOURT P.E. NO. 68072
P.E. NAME: _____
DATE: _____

**Engineering Design Technologies Corp.**
P.O. Box 152403
Tampa, FL 33684-2403
813.289.8080
813.282.9184 FAX
engineering@edt1.com

Certificate of Authorization Number: 4795

CITY of TAMPA
WASTEWATER DEPARTMENT

KRAUSE PS REHABILITATION
MECHANICAL SITE PLAN

RED LINES

1	1/27
NO.	DA

NO CHANGES

DRAWN: J. WHITE
DESIGN: FJB
QC: DCH
DATE: 01/27/15
SHEET G-2



NOTES:

-
- MECHANICAL S
- SCALE: 1" = 10'
- NEW LINK SEAL
- EAST WALL OF PUMP STATION
- 0.5" THK STEEL PIPE IN WALL TO REMAIN AS WALL SLEEVE
- 18"
- 42"x36"x0.5" THK FLGxFLG STEEL REDUCER
- CONNECT TO EXISTING FLANGE
- EXISTING 36" BEND ($\text{CL} = -2.11 \pm$)
- 16"
- SEE NOTE 1
- 42"x24" DIP MJ TEE
- MEGALUG
- SEE NOTE 1
- 36" 0.5" THK STEEL OFFSET (MAX 22.5° MITER HORIZONTAL AND VERTICAL COMBINED)
- 42" PEXPE DIP SPOOL W/MEGAFLANGE 1'-6" \pm (CTSIF)
- $\text{CL EL} = -1.96 \pm$

SCALE: 3/16" = 1'-0"



CITY of TAMPA
WASTEWATER DEPARTMENT

MECHANICAL
YARD PIPING

Changes
See Sheet G-3A

GREELEY AND HANSEN

1715 N. WESTSHORE BLVD., STE. 464
TAMPA, FLORIDA 33607

CERTIFICATE OF AUTHORIZATION NO. 37

P.E. NAME: FREDDY J. BETANCOURT	P.E. NO. 68072
---------------------------------	----------------

P F NAME.

DRAWN: J. WHITE



DESIGN: FJB

QC: DCH


DATE: 01/27/15

SHEET G-3

B080-010

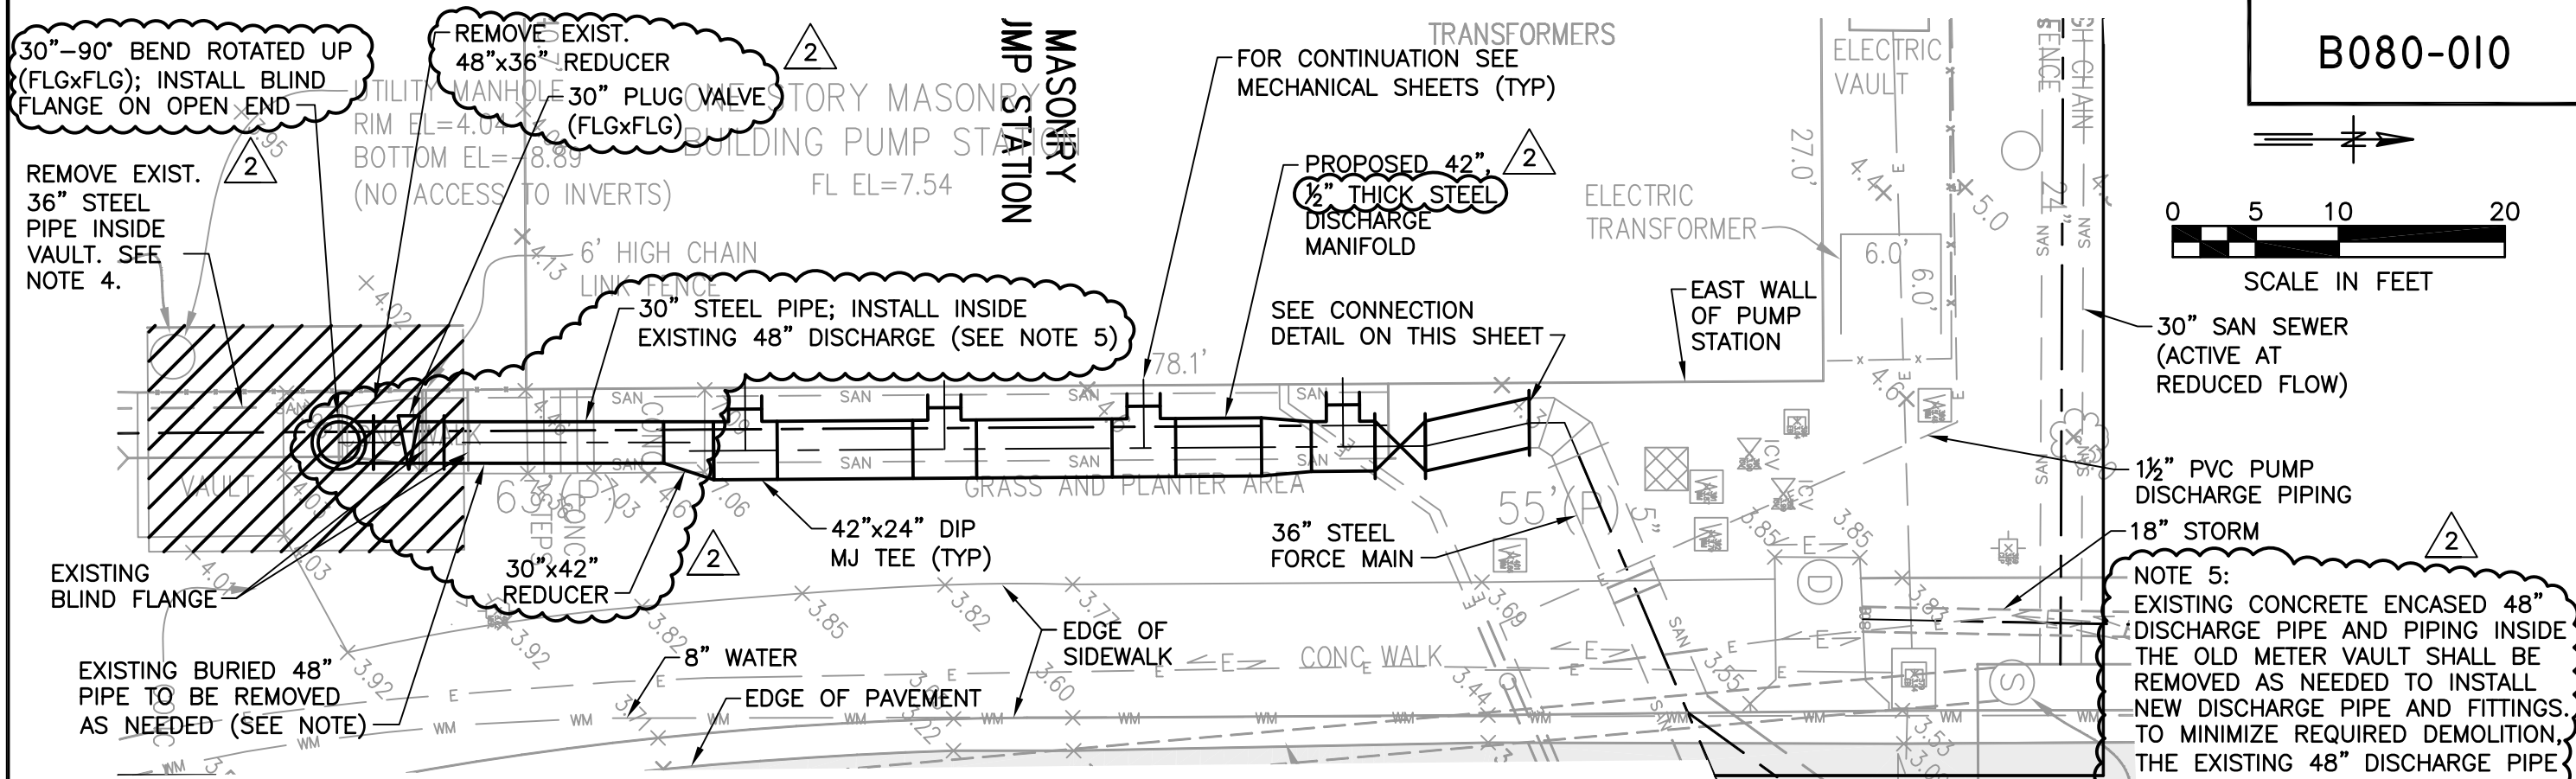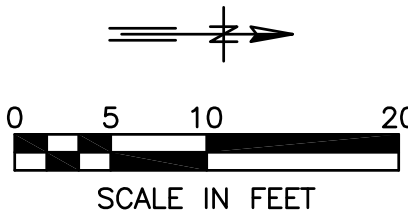

MECHANICAL SITE PLAN

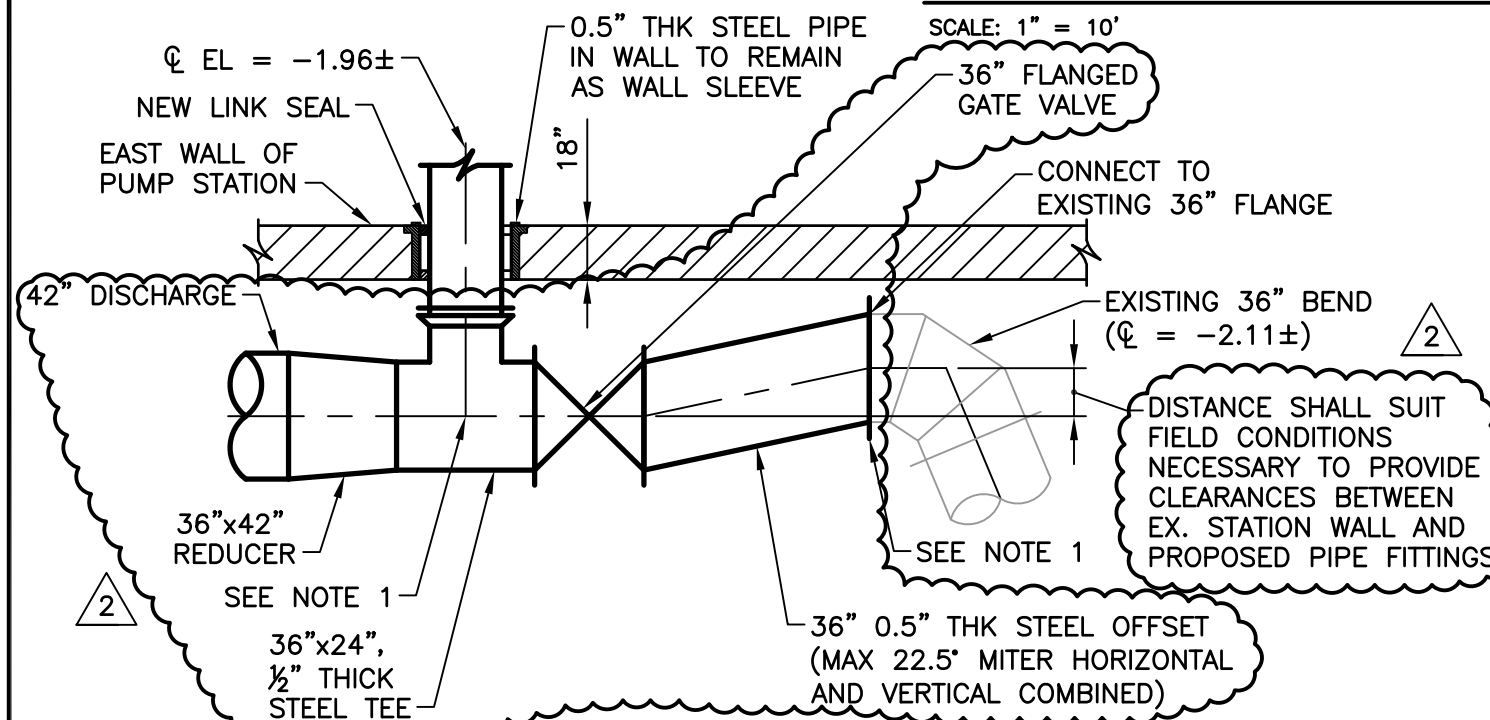

CONNECTION DETAIL

NOTES:

1. CONTRACTOR SHALL FIELD VERIFY LOCATION OF AND ELEVATION EXISTING FLANGE ON 36" STEEL BEND AND CENTER OF WALL PENETRATION. THIS INFORMATION SHALL BE INCLUDED IN SHOP DRAWING FOR FABRICATED OFFSET.
2. CONTRACTOR SHALL ASSEMBLE CONNECTION FROM EXISTING BEND AND CONSTRUCT SOUTHWARD USING THE 42" DIP PEXPE SPOOL CUT TO SIZE IN FIELD FOR ALIGNMENT.
3. 36" STEEL OFFSET FITTING AND 42"x36" STEEL REDUCER SHALL MEET AWWA C208.
4. REMOVE PIPE INSIDE THE VAULT, AS SHOWN.

NOTE 5:
EXISTING CONCRETE ENCASED 48" DISCHARGE PIPE AND PIPING INSIDE THE OLD METER VAULT SHALL BE REMOVED AS NEEDED TO INSTALL NEW DISCHARGE PIPE AND FITTINGS. TO MINIMIZE REQUIRED DEMOLITION, THE EXISTING 48" DISCHARGE PIPE BETWEEN THE OLD METER VAULT AND THE NEW 30"x42" REDUCER CAN REMAIN AND THE 30" PIPE INSTALLED INSIDE THE OLD PIPE. NEW PIPE SHALL BE SUFFICIENTLY SUPPORTED AND THE ENDS OF REMAINING 48" PIPE SEALED WITH MASONRY BULKHEADS. EXISTING VAULT COVERS SHALL BE REMOVED AS NEEDED AND REINSTALLED UPON COMPLETION OF CONSTRUCTION.

GREELEY AND HANSEN
1715 N. WESTSHORE BLVD., STE. 464
TAMPA, FLORIDA 33607
CERTIFICATE OF AUTHORIZATION NO. 37
P.E. NAME: FREDDY J. BETANCOURT P.E. NO. 68072
P.E. NAME:

RED LINES

Revised G-3

Sheet G-3A

EDT Engineering Design Technologies Corp.
P.O. Box 152403
Tampa, FL 33684-2403
813.289.8080
813.282.9184 FAX
engineering@edt1.com
Certificate of Authorization Number: 4795



CITY of TAMPA
WASTEWATER DEPARTMENT

KRAUSE PS REHABILITATION

MECHANICAL
YARD PIPING




NO.	DATE	REVISIONS
2	10/7/2015	11:32:35 AM
1	10/7/2015	11:32:35 AM

DRAWN: J. WHITE
DESIGN: FJB
QC: DCH
DATE: 05/01/14

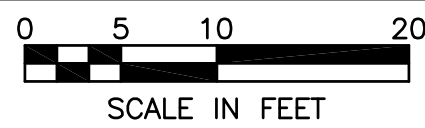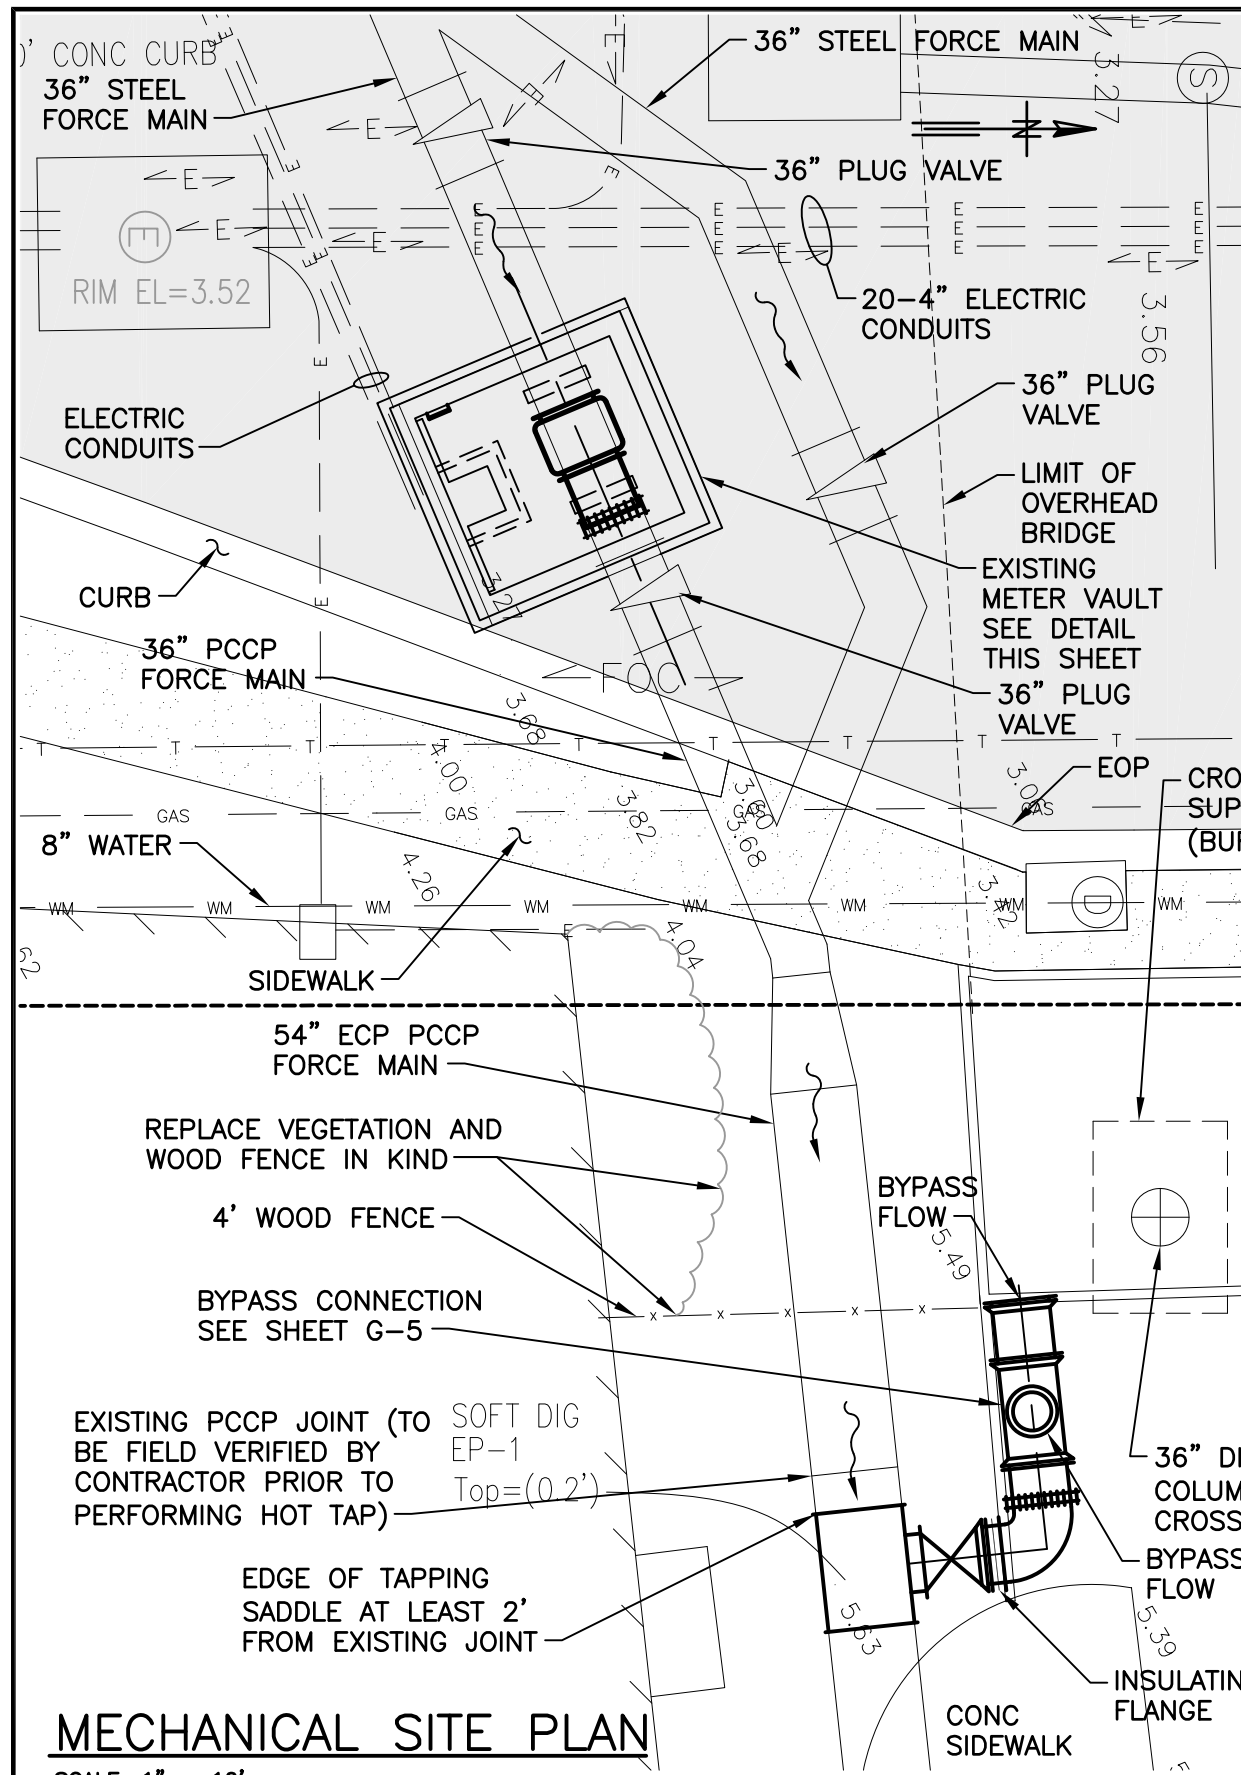

NOTES:
1. REMOVABLE SLABS COVERED BY ASPHALT ROAD SURFACE.

B080-007

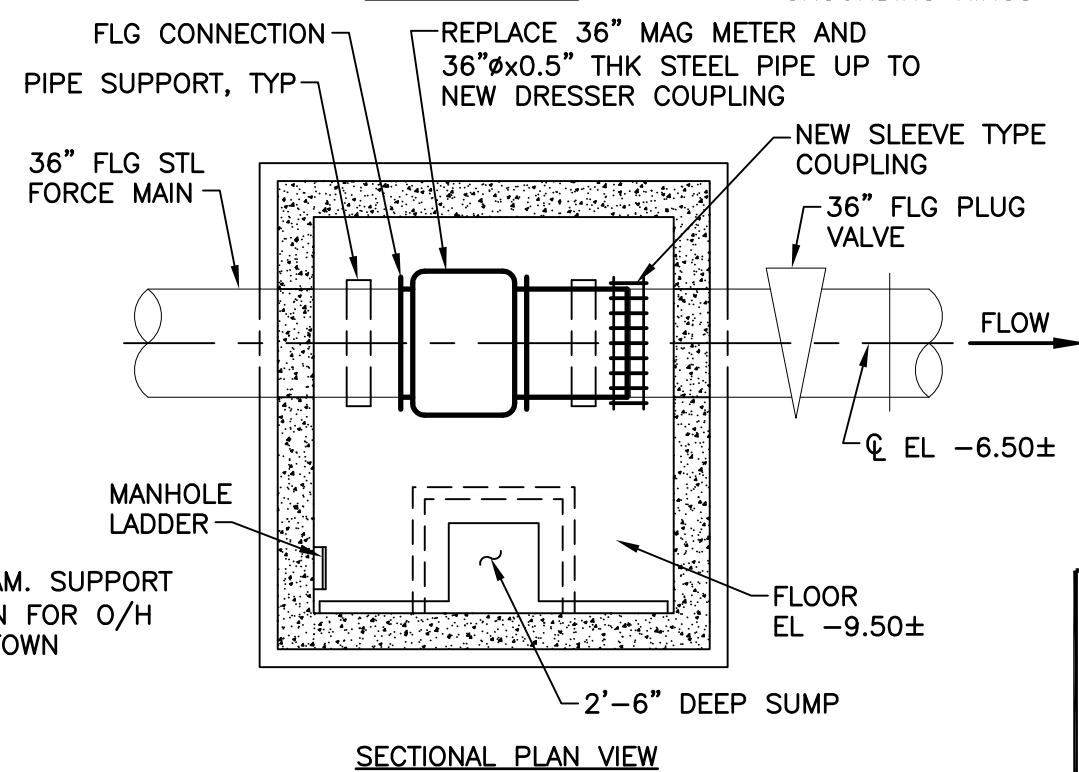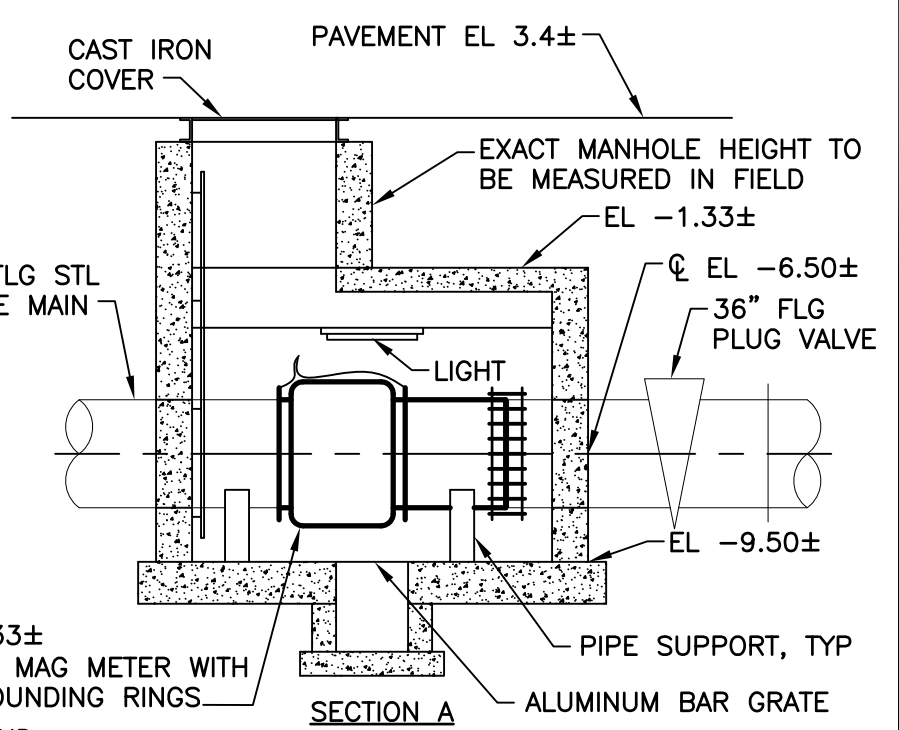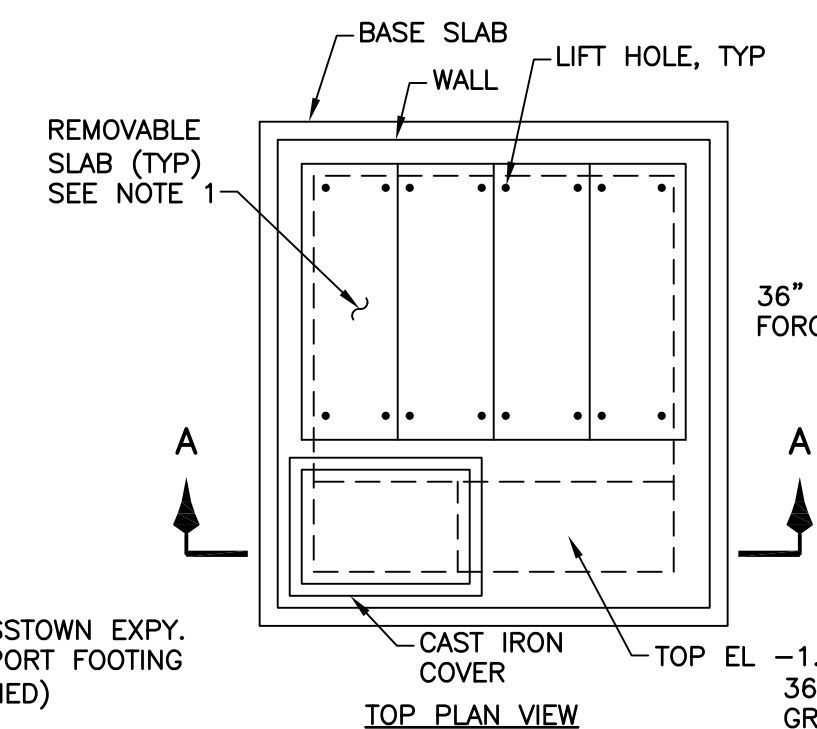


- NOTES:
- CAREFULLY EXCAVATE AND EXPOSE REMOVABLE TOP SLABS AS NEEDED TO ACCOMMODATE INSTALLATION OF NEW FLOW METER.
 - REPAIR ANY DAMAGE TO TOP SLAB. SLAB JOINTS SHALL BE PROPERLY SEALED DURING REINSTALLATION. SEAL JOINTS WITH RN-103 RAM-NEK PREFORMED JOINT SEALANT OR APPROVED EQUAL.

EXISTING METER VAULT DETAIL
SCALE: 3/16" = 1'-0"


GREELEY AND HANSEN
1715 N. WESTSHORE BLVD., STE. 464
TAMPA, FLORIDA 33607
CERTIFICATE OF AUTHORIZATION NO. 37
P.E. NAME: FREDDY J. BETANCOURT P.E. NO. 68072

MECHANICAL SITE PLAN
SCALE: 1" = 10'

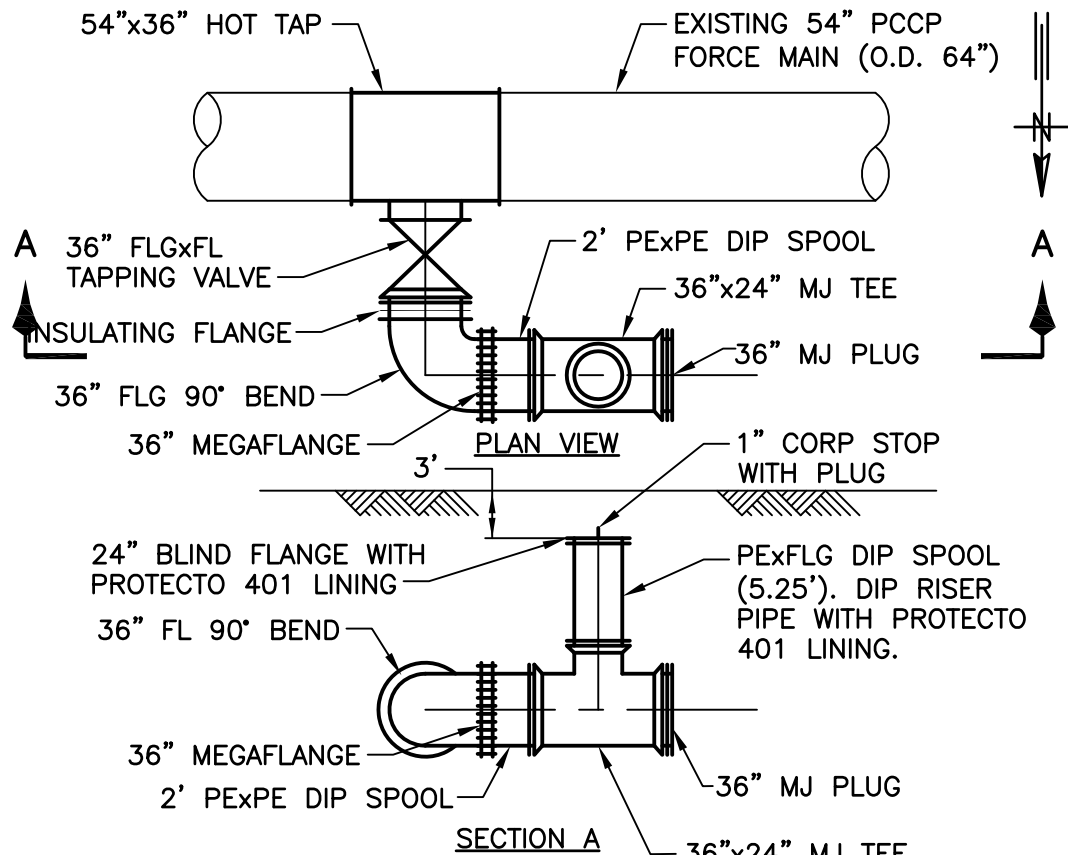

BYPASS ASSEMBLY DETAIL


NOT TO SCALE

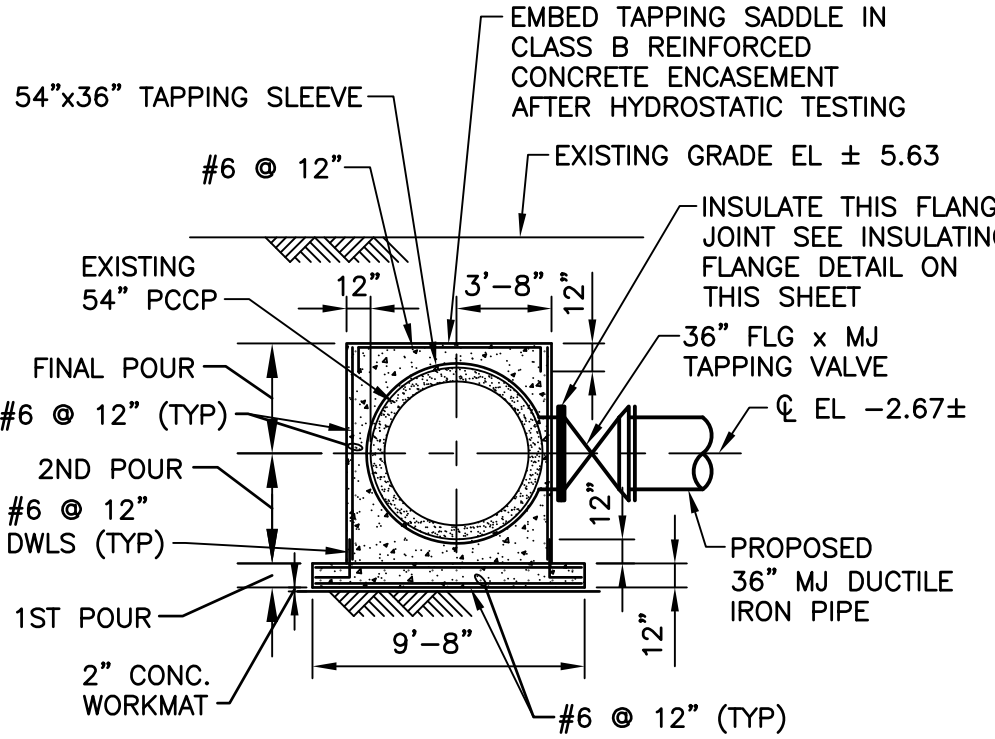

DETAIL OF PIPE CONNECTION TO EXISTING 54" PCCP

NOT TO SCALE

- NOTES:
1. CONTRACTOR SHALL PROVIDE ADEQUATE TEMPORARY SUPPORT TO EXISTING PIPE WHILE THE NEW SUPPORT SLAB IS BEING CONSTRUCTED. CONTRACTOR SHALL SUBMIT SHOP DRAWING, INDICATING INSTALLATION PROCEDURES FOR APPROVAL PRIOR TO INITIATING THE WORK.
 2. CONTRACTOR SHALL TAKE EXTREME CARE CONSTRUCTING NEW SUPPORT SLAB AND ENCASEMENT IN ORDER TO PREVENT ANY DAMAGE TO EXISTING PIPE. ALL THE ABOVE WORK SHALL BE DONE IN THE PRESENCE OF THE ENGINEER.
 3. THE SUPPORT SLAB MAY BE CONSTRUCTED IN SECTIONS WITH KEYWAY JOINTS AND WITH REINFORCING LAPPED 2' MIN.
 4. ALL CONCRETE SHALL BE CLASS B.
 5. EXTEND CONCRETE ENCASEMENT A MINIMUM OF 12" AROUND TAPPING SADDLE, EXCEPT FOR NORTH FACE AS SHOWN TO PERMIT ASSEMBLY OF INSULATING FLANGE JOINT. CONCRETE ENCASEMENT SHALL EXTEND A MINIMUM OF 12" EAST AND WEST OF THE TAPPING SADDLE.

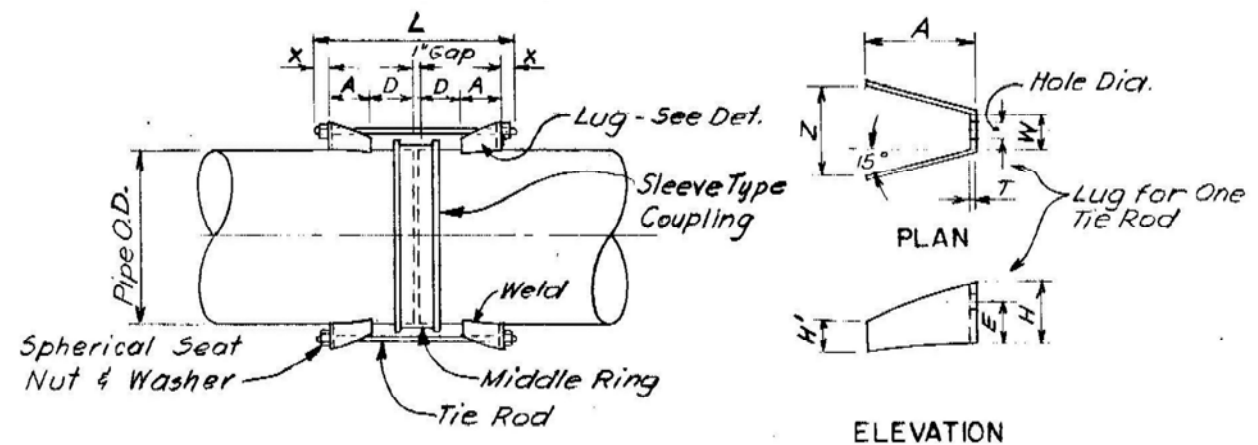

HARNESS ASSEMBLY


NOT TO SCALE

DETAIL OF LUG

NOT TO SCALE


PIPE SIZE	WALL THICKNESS	PIPE O.D.	MIDDLE RING COUPLING		HARNESS TIE ROD				HARNESS LUGS - MINIMUM DIMENSIONS									
			LENGTH	THICKNESS	NO.	DIA.	X	L	D	A	W	Z	T	E	H	H'	HOLE DIA.	WELD SIZE
36"	1/2"	37"	7"	3/8"	2	1 3/8"	1 7/8"	36 3/4"	8 1/2"	7 1/2"	2 13/16"	7"	1 1/2"	3 3/4"	5 3/8"	2 1/2"	1 1/2"	5/16"

DETAILS OF HARNESS SLEEVE – TYPE COUPLING JOINT

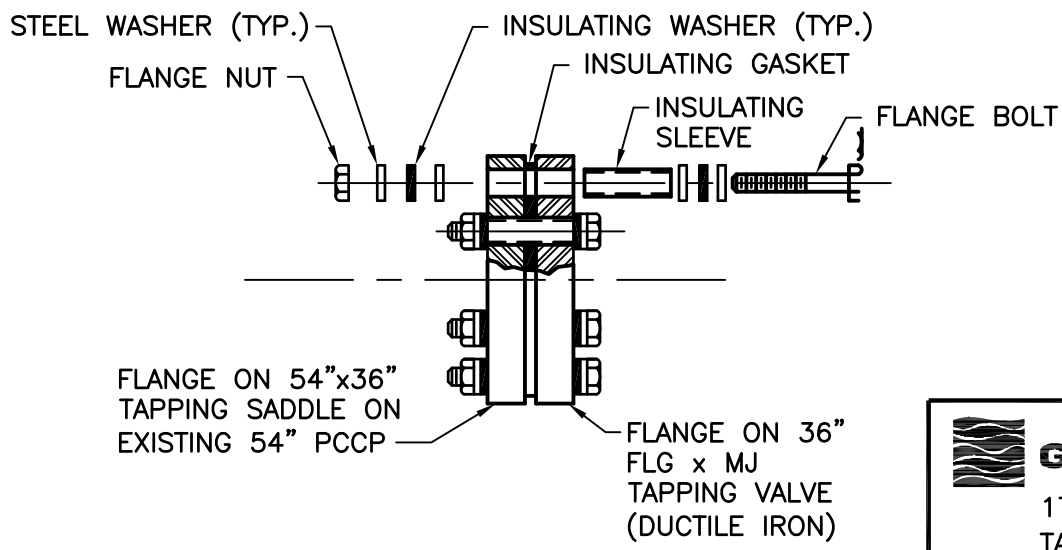

INSULATING FLANGE


NOT TO SCALE

**GREELEY AND HANSEN**
1715 N. WESTSHORE BLVD., STE. 464
TAMPA, FLORIDA 33607
CERTIFICATE OF AUTHORIZATION NO. 37


P.E. NAME: FREDDY J. BETANCOURT P.E. NO. 68072
P.E. NAME: _____
DATE: _____

NOTES:


1. RIVERWALK ACCESS SHALL REMAIN OPEN DURING CONSTRUCTION.
2. CONTRACTOR SHALL INSTALL 3 INFLATABLE PLUGS TO SEAL WASTEWATER FLOW DURING CONSTRUCTION.
3. ONE LANE OF TRAFFIC SHALL REMAIN OPEN DURING CONSTRUCTION FOR EXITING PARKING GARAGE. TEMPORARY CLOSURE FOR INSTALLATION OF TEMPORARY BYPASS PIPE SHALL BE LIMITED TO 24 HOURS, SCHEDULED WITH A MINIMUM TWO WEEK NOTICE TO THE CITY.
4. REFER TO SPECIAL PROVISION FOR SIZING REQUIREMENT OF BYPASS PUMPING SYSTEM.
5. 30" SANITARY SEWER IS ACTIVE BUT AT A VERY REDUCED FLOW (ESTIMATED PEAK FLOW RATE IS 1,000 GPM). THIS SANITARY SYSTEM IS NOT CONNECTED WITH THE 60" SANITARY INTERCEPTOR AND THUS REQUIRES A SEPARATE BYPASS SYSTEM. CONTRACTOR SHALL COORDINATE WITH CITY OF TAMPA TO SIZE PUMP APPROPRIATELY. BYPASS SYSTEM SHALL INCLUDE A FULLY REDUNDANT BACKUP.
6. ALL LANDSCAPE DISTURBED DUE TO BYPASS INSTALLATION SHALL BE REPLACED IN KIND.
7. ROADWAY SHALL BE FULLY RESTORED AFTER BYPASS IS COMPLETE. REFER TO SHEET G-9 FOR RESTORATION DETAIL.
8. MAINTAIN ACCESS TO THE CITY PARKING LOT UNDER THE CROSSTOWN EXPRESSWAY AUTHORITY DURING CONSTRUCTION. BYPASS PIPE CAN EITHER BE BURIED ACROSS ENTRANCE LOCATED UNDER THE ASPHALT PAVEMENT OF ASHLEY ST. OR THE CONCRETE DRIVEWAY AND PARTIALLY PLACED WITH A STEEL RAMP ACROSS FOR CAR ACCESS AS SHOWN ON DETAIL PLAN SHEET G-9. AFTER REMOVAL OF THE BYPASS PUMPING SYSTEM, RESTORE TRENCH BACKFILL COMPACTED TO AT LEAST 98 PERCENT OF THE MODIFIED PROCTOR MAXIMUM DRY DENSITY (ASTM D-1557). REPLACE ASPHALT IN ACCORDANCE WITH THE TYPICAL PAVING DETAIL ON PLAN SHEET G-9 OR POUR 8" CONCRETE REINFORCED SLAB FOR DRIVEWAY, DEPENDING ON LOCATION CHOSEN BY THE CONTRACTOR AND APPROVED BY THE ENGINEER. REINFORCE 8-INCH SLAB WITH TWO MATS (TOP AND BOTTOM) OF #5 BARS @ 12" ON CENTER EACH WAY.

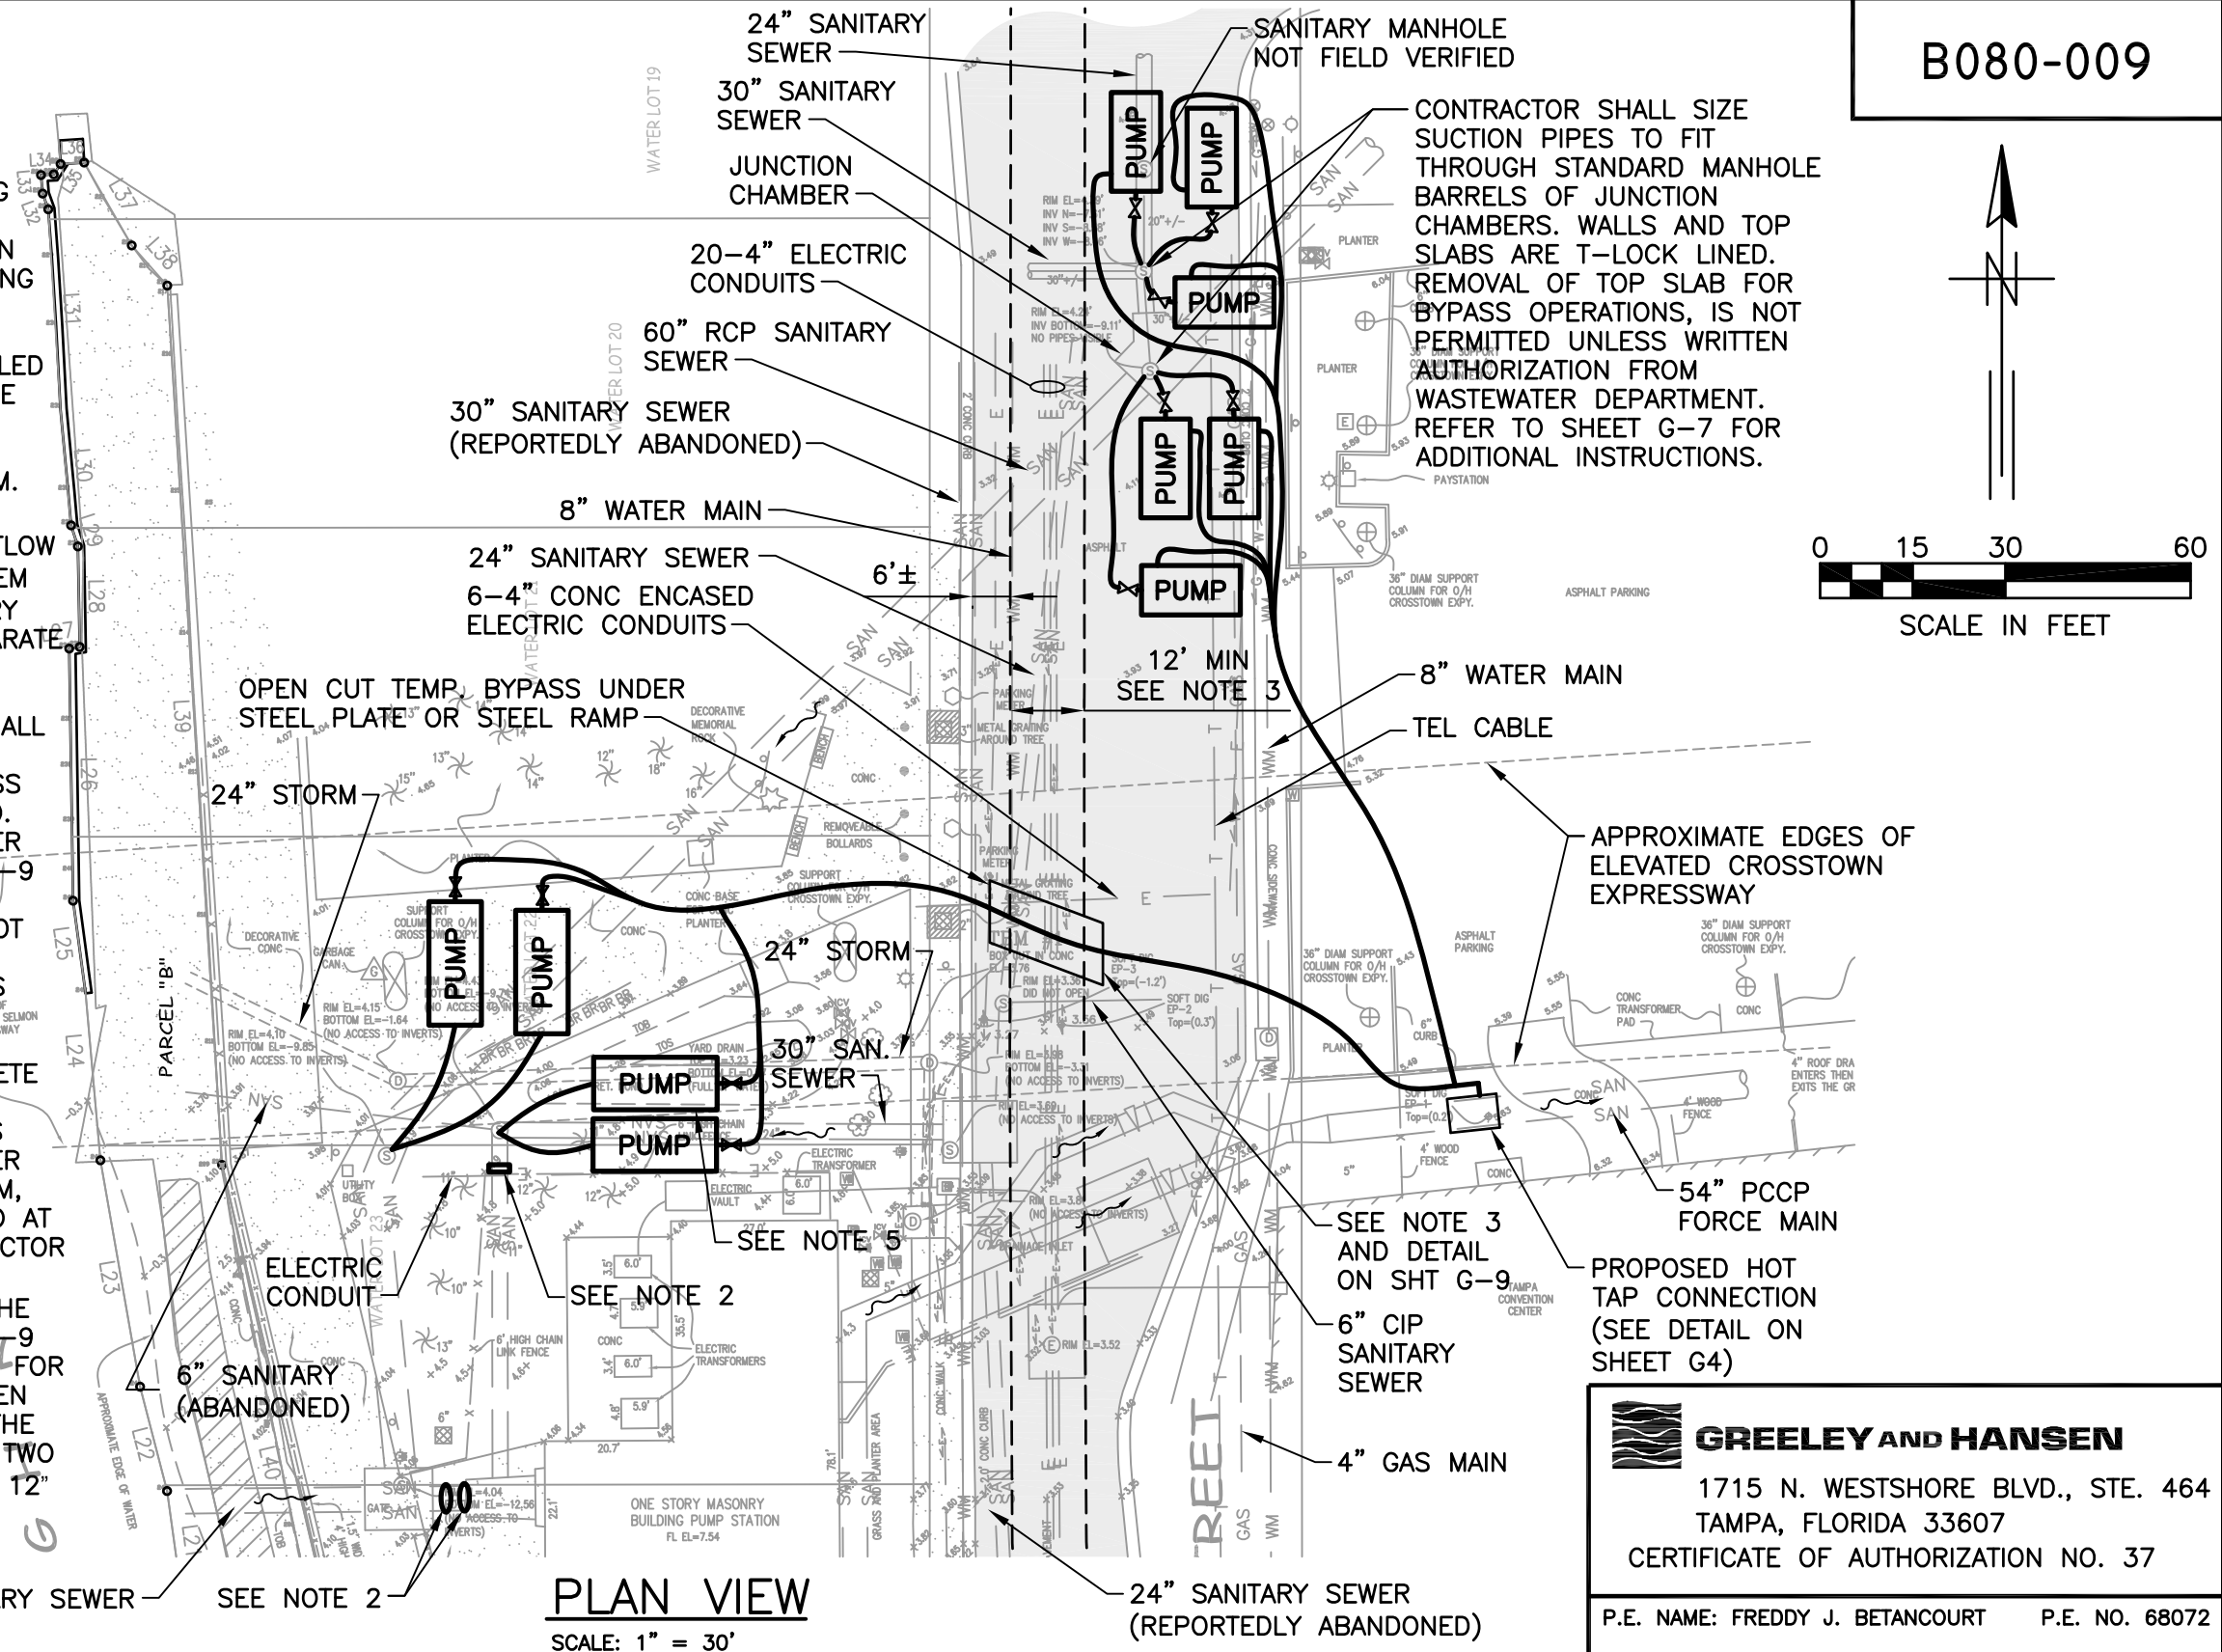


B080-009

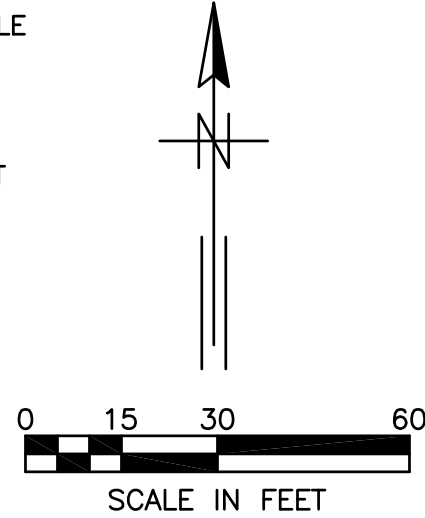

PLAN VIEW
SCALE: 1" = 30'

**GREELEY AND HANSEN**
1715 N. WESTSHORE BLVD., STE. 464
TAMPA, FLORIDA 33607
CERTIFICATE OF AUTHORIZATION NO. 37

P.E. NAME: FREDDY J. BETANCOURT P.E. NO. 68072
P.E. NAME: _____

**Engineering Design Technologies Corp.**
P.O. Box 152403
Tampa, FL 33684-2403
813.289.8080
813.282.9184 FAX
engineering@edt1.com

Certificate of Authorization Number: 4795

CITY of TAMPA
WASTEWATER DEPARTMENT

KRAUSE PS REHABILITATION
TEMPORARY BYPASS-
CONCEPTUAL PLAN


RED LINES
CHANGES
SEE G-6A

NO.	DATE
2	1/27/20
1	7/11/19

DRAWN: J. WHITE
DESIGN: FJB
QC: DCH
DATE: 01/27/15
SHEET G-6

NOTES:


- RIVERWALK ACCESS SHALL REMAIN OPEN DURING CONSTRUCTION.
- CONTRACTOR SHALL INSTALL 3 INFLATABLE PLUGS TO SEAL WASTEWATER FLOW DURING CONSTRUCTION.
- ONE LANE OF TRAFFIC SHALL REMAIN OPEN DURING CONSTRUCTION FOR EXITING PARKING GARAGE. TEMPORARY CLOSURE FOR INSTALLATION OF TEMPORARY BYPASS PIPE SHALL BE LIMITED TO 24 HOURS, SCHEDULED WITH A MINIMUM TWO WEEK NOTICE TO THE CITY.
- REFER TO SPECIAL PROVISION FOR SIZING REQUIREMENT OF BYPASS PUMPING SYSTEM.
- 30" SANITARY SEWER IS ACTIVE BUT AT A VERY REDUCED FLOW (ESTIMATED PEAK FLOW RATE IS 1,000 GPM). THIS SANITARY SYSTEM IS NOT CONNECTED WITH THE 60" SANITARY INTERCEPTOR AND THUS REQUIRES A SEPARATE BYPASS SYSTEM. CONTRACTOR SHALL COORDINATE WITH CITY OF TAMPA TO SIZE PUMP APPROPRIATELY. BYPASS SYSTEM SHALL INCLUDE A FULLY REDUNDANT BACKUP.
- ALL LANDSCAPE DISTURBED DUE TO BYPASS INSTALLATION SHALL BE REPLACED IN KIND.
- ROADWAY SHALL BE FULLY RESTORED AFTER BYPASS IS COMPLETE. REFER TO SHEET G-9 FOR RESTORATION DETAIL.
- MAINTAIN ACCESS TO THE CITY PARKING LOT UNDER THE CROSSTOWN EXPRESSWAY AUTHORITY DURING CONSTRUCTION. BYPASS PIPE CAN EITHER BE BURIED ACROSS THE APPROXIMATE EDGES OF ELEVATED SELMON CROSSTOWN EXPRESSWAY ENTRANCE LOCATED UNDER THE ASPHALT PAVEMENT OF ASHLEY ST. OR THE CONCRETE DRIVEWAY AND PARTIALLY PLACED WITH A STEEL RAMP ACROSS FOR CAR ACCESS AS SHOWN ON DETAIL PLAN SHEET G-9. AFTER REMOVAL OF THE BYPASS PUMPING SYSTEM, RESTORE TRENCH BACKFILL COMPACTED TO AT LEAST 98 PERCENT OF THE MODIFIED PROCTOR MAXIMUM DRY DENSITY (ASTM D-1557). REPLACE ASPHALT IN ACCORDANCE WITH THE TYPICAL PAVING DETAIL ON PLAN SHEET G-9 OR POUR 8" CONCRETE REINFORCED SLAB FOR DRIVEWAY, DEPENDING ON LOCATION CHOSEN BY THE CONTRACTOR AND APPROVED BY THE ENGINEER. REINFORCE 8-INCH SLAB WITH TWO MATS (TOP AND BOTTOM) OF #5 BARS @ 12" ON CENTER EACH WAY.
- INSTALLATION OF HOT TAP SHALL BE A MINIMUM OF 3 FEET FROM NEAREST JOINT. CONTRACTOR TO FIELD VERIFY LOCATION OF JOINTS. LOCATIONS ON DRAWINGS ARE ESTIMATES.

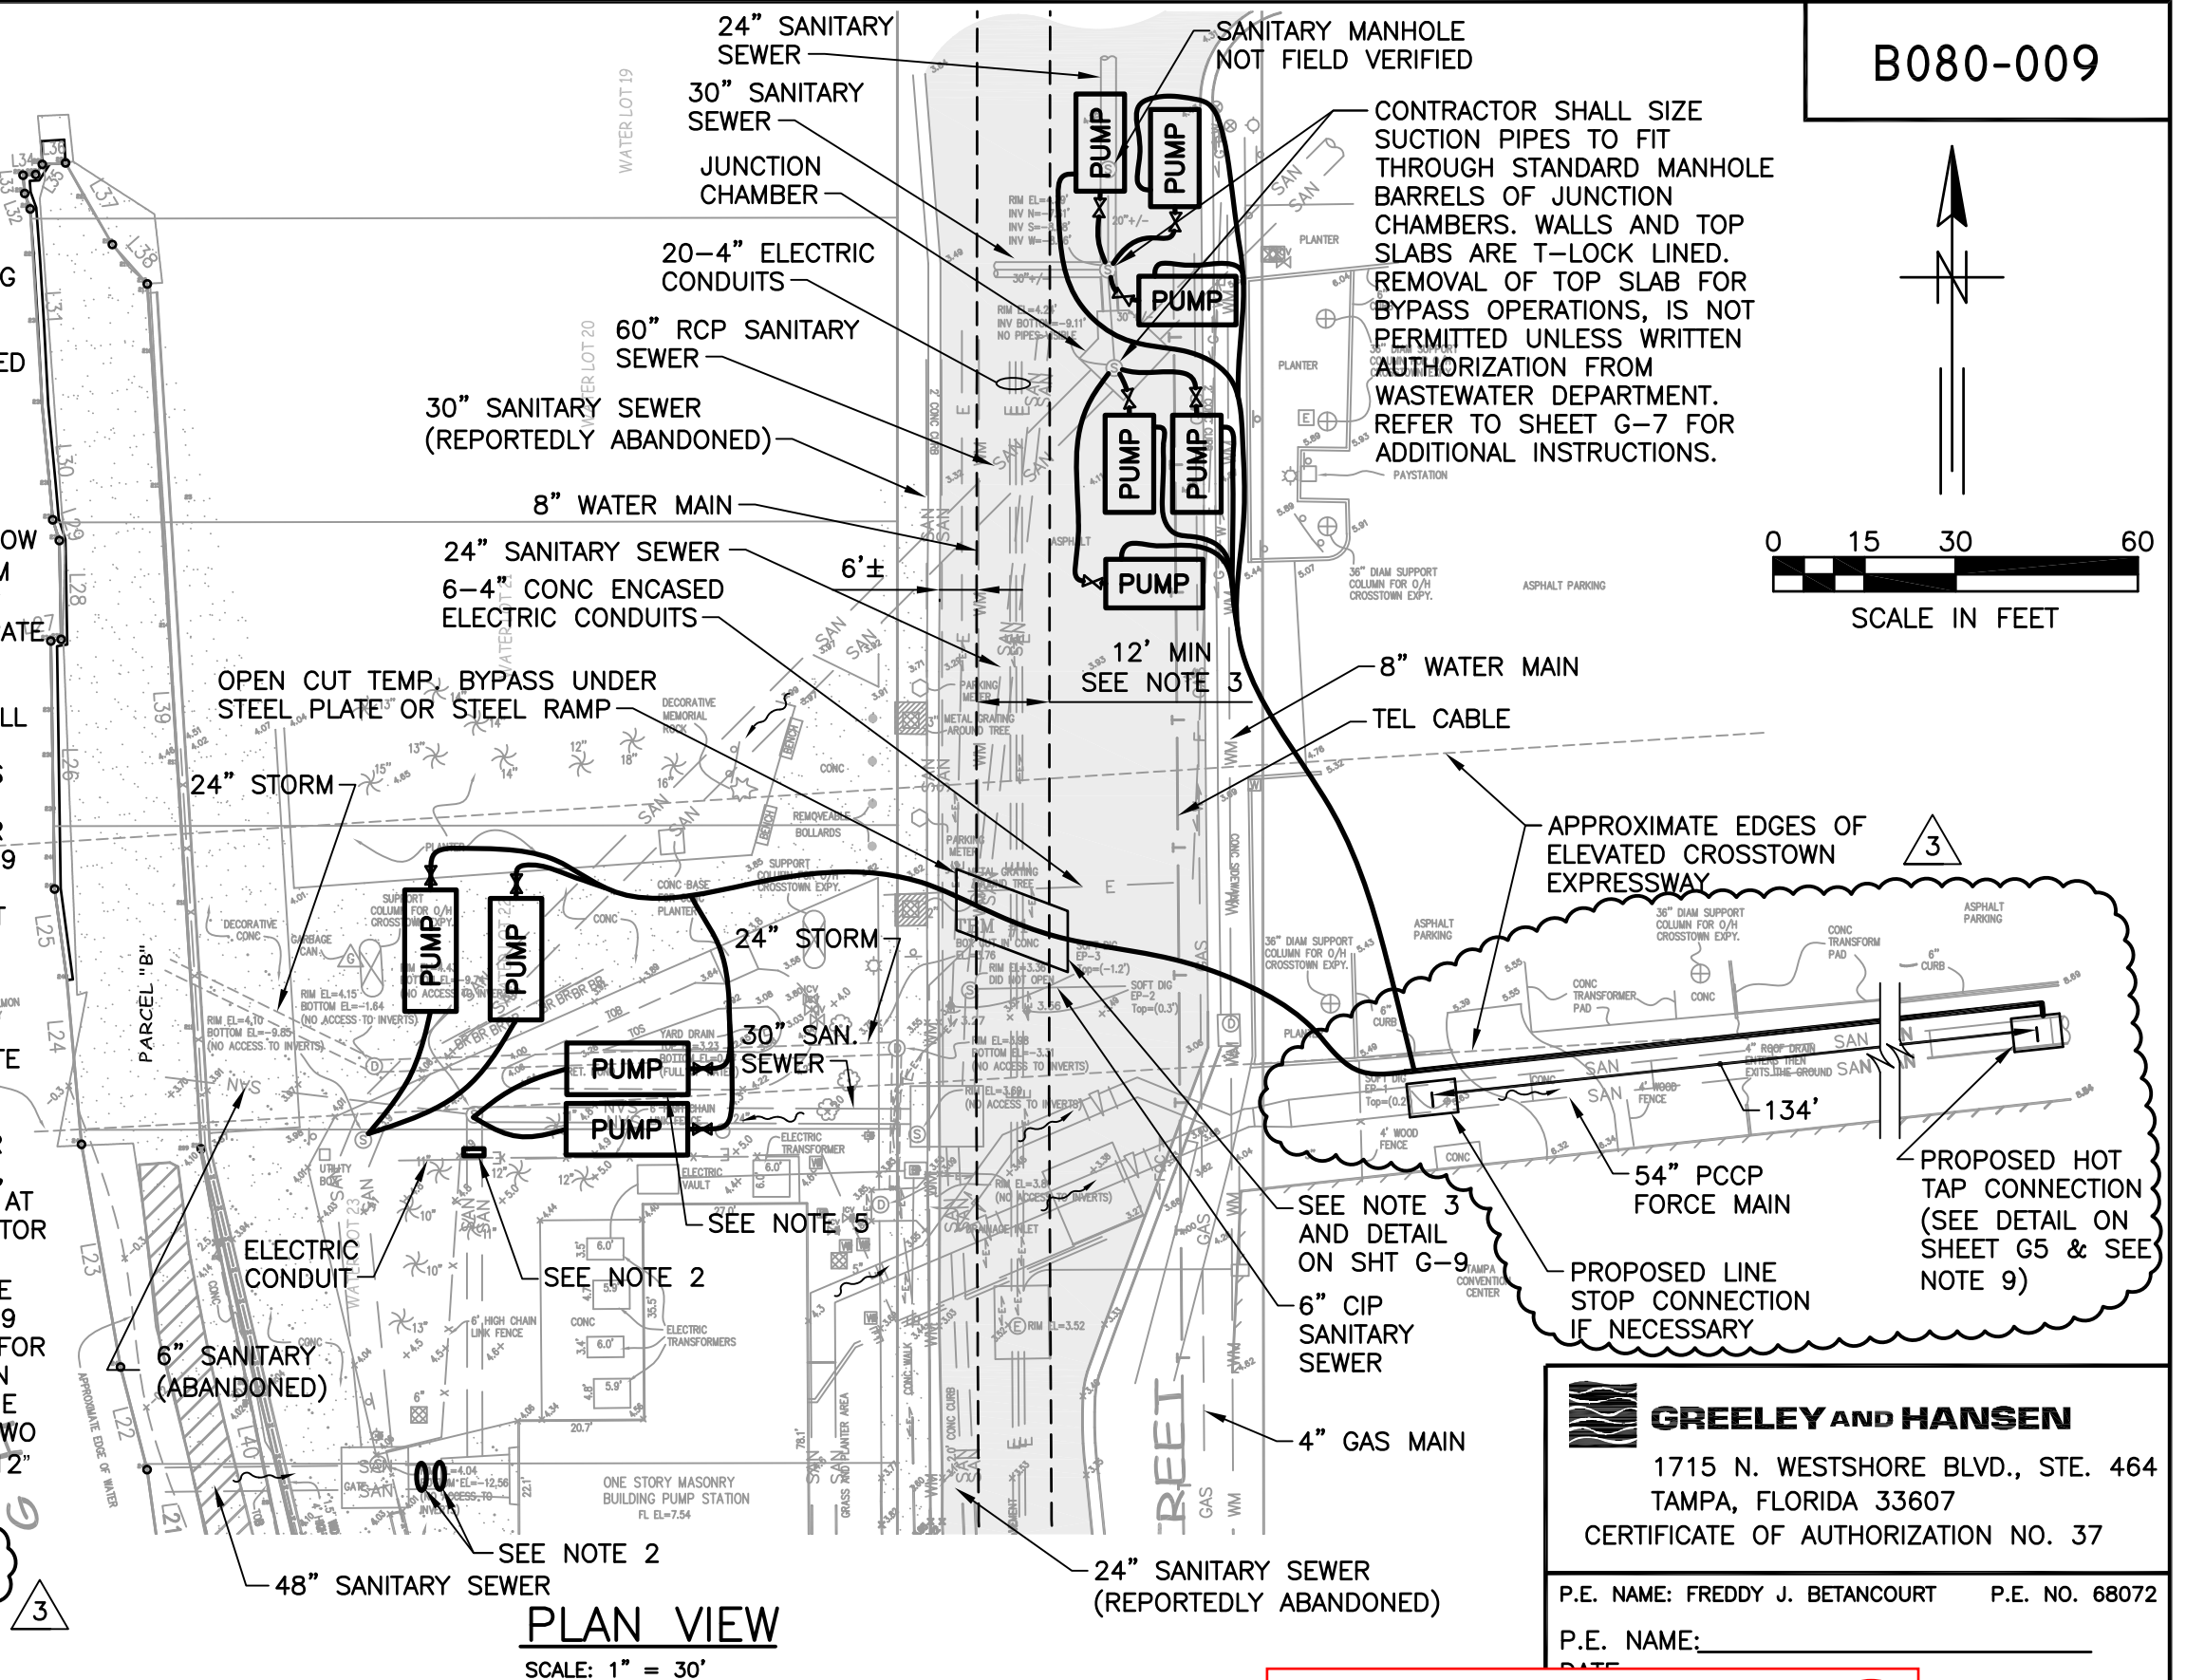

PLAN VIEW

SCALE: 1" = 30'

B080-009

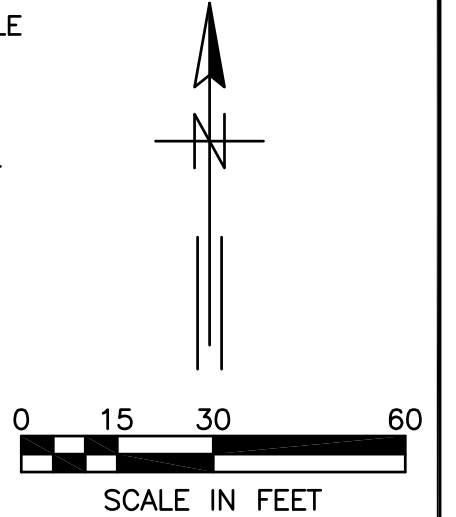

GREELEY AND HANSEN
 1715 N. WESTSHORE BLVD., STE. 464
 TAMPA, FLORIDA 33607
 CERTIFICATE OF AUTHORIZATION NO. 37
 P.E. NAME: FREDDY J. BETANCOURT P.E. NO. 68072
 P.E. NAME: _____

RED LINES

Revised G-6

Sheet G-6A

EDT Engineering Design Technologies Corp.
 P.O. Box 152403
 Tampa, FL 33684-2403
 813.289.8080
 813.282.9184 FAX
 engineering@edt1.com

CITY of TAMPA
 WASTEWATER DEPARTMENT

KRAUSE PS REHABILITATION

TEMPORARY BYPASS-
 CONCEPTUAL PLAN

NO.	DATE	REVISION
3	9/24/15	REV TAPPING LOCATION, ADD NOTE 9
2	1/27	
1	7/11	

B080-010



PROVIDE A BRASS IDENTIFICATION TAG ANCHORED TO THE CONCRETE APRON THAT IS A MINIMUM 2" IN DIAMETER AND 1/8-INCH THICK. THE TAG SHALL BE ENGRAVED WITH "SEWER", SIZE OF VALVE, TYPE OF VALVE, AND DIRECTION AND NUMBER OF TURNS TO OPEN.

SEWER
4" P.V.
1/4 T.O.L.

2" DIA.

NOT TO SCALE

1. CONTRACTOR SHALL ONLY PROCEED TO REMOVE TOP SLAB IF WRITTEN AUTHORIZATION HAS BEEN PROVIDED BY THE CITY.
2. CONTRACTOR SHALL PROVIDE A SAFE ENVIRONMENT AND TAKE ALL NECESSARY PRECAUTIONS FOR HIS WORKERS TO PERFORM ANY WORK INSIDE MANHOLES. OSHA STANDARD SAFETY EQUIPMENT SUCH AS, BUT NOT LIMITED TO, SAFETY HARNESSSES, GAS MONITORS, LOWER EXPLOSIVE LIMITS (LEL) DETECTORS, BREATHING APPARATUS, ETC SHALL BE UTILIZED WHERE WORK DICTATES THEIR USE.
3. MANHOLE TOP SLABS AND BARRELS ARE PLASTIC SHEET LINED. IF TOP SLAB IS REQUIRED TO BE REMOVED FOR BYPASS PUMPING, CONTRACTOR SHALL CUT LINER JUST BELOW WELD STRIP JOINT BETWEEN TOP SLAB AND BARREL. REPLACEMENT TOP SLAB SHALL BE T-LOK LINED, AND T-LOK JOINT BETWEEN TOP SLAB AND BARREL SHALL BE COVERED WITH 275 MILS OF CPP GEL (MANUFACTURED BY EPOXYTEC) BY A CERTIFIED APPLICATOR OR APPROVED EQUAL.



NOT TO SCALE




CITY of TAMPA
WASTEWATER DEPARTMENT


STANDARD DETAILS

NO CHANGES

SHEET G-7

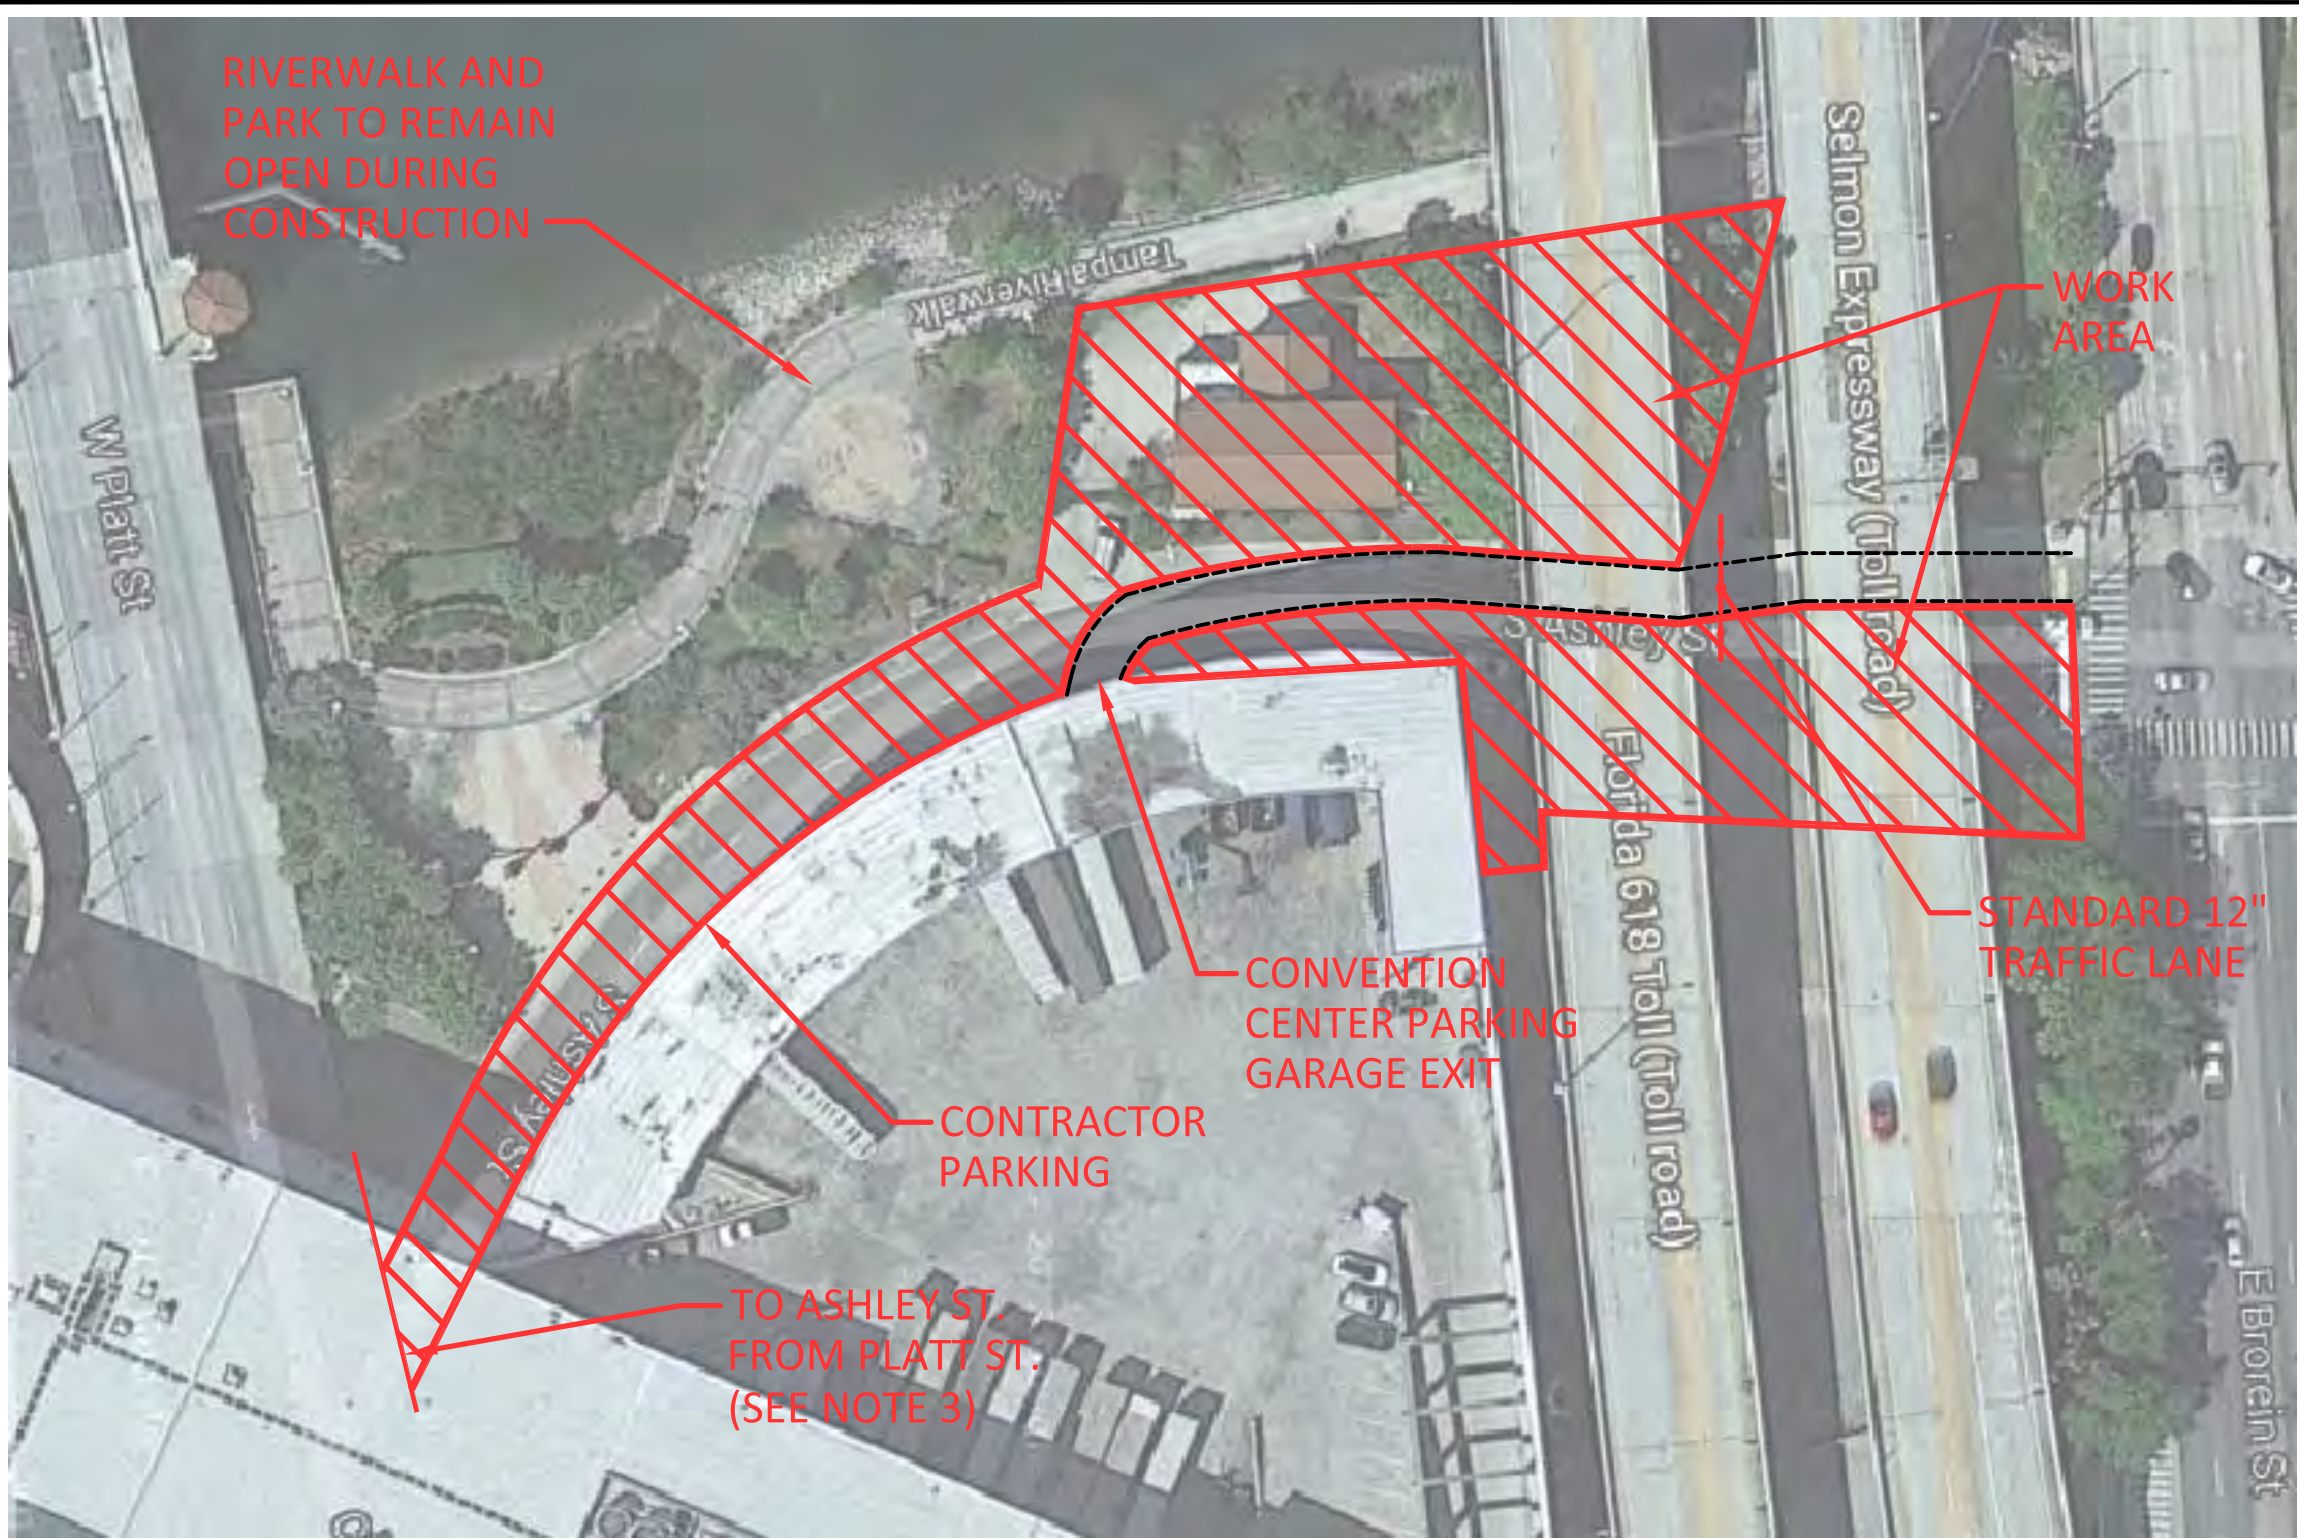


B080-011

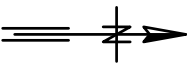

- NOTES:
- 1. CONTRACTOR SHALL ARRANGE A SECURE STAGING AREA NEAR THE SITE FOR ALL CONSTRUCTION EQUIPMENT AND REQUIRED MACHINERY.
 - 2. CONTRACTOR SHALL PROVIDE DETAILED MOT PLAN TO BE SUBMITTED WITH ROW PERMIT APPLICATION TO THE CITY OF TAMPA.
 - 3. ACCESS TO ASHLEY STREET FROM PLATT STREET SHALL BE CLOSED TO THE PUBLIC DURING CONSTRUCTION
 - 4. CONTRACTOR SHALL SECURE THE PUMP STATION SITE, BYPASS PUMPING SYSTEM OR ANY TEMPORARY EQUIPMENT OR MATERIAL LAYOUT AREA WITH TEMPORARY PERIMETER SECURITY FENCES OF AT LEAST 6' OF HEIGHT.


CONSTRUCTION AREA
NOT TO SCALE

**GREELEY AND HANSEN**
1715 N. WESTSHORE BLVD., STE. 464
TAMPA, FLORIDA 33607
CERTIFICATE OF AUTHORIZATION NO. 37

P.E. NAME: FREDDY J. BETANCOURT P.E. NO. 68072

P.E. NAME: _____

DATE: _____

**Engineering Design Technologies Corp.**
P.O. Box 152403
Tampa, FL 33684-2403
813.289.8080
813.282.9184 FAX
engineering@edt1.com

Certificate of Authorization Number: 4795


CITY of TAMPA
WASTEWATER DEPARTMENT

KRAUSE PS REHABILITATION
CONCEPTUAL MAINTENANCE OF TRAFFIC

RED LINES
NO CHANGES


1	1/27/15
NO.	DATE

DRAWN: J.WHITE
DESIGN: FJB
IC: DCH
DATE: 01/27/15
SHEET G-8

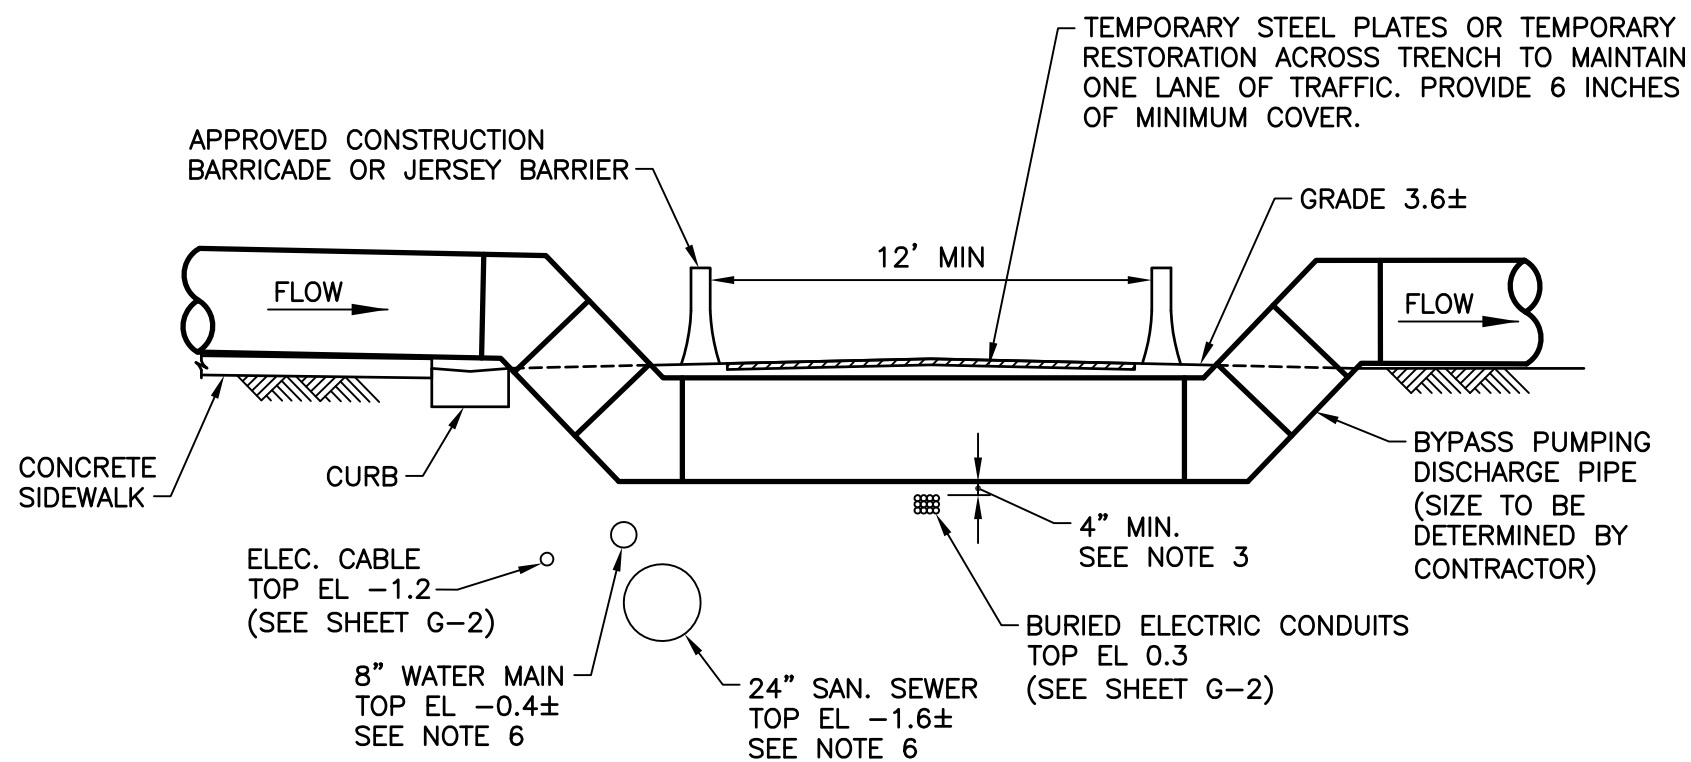

BURIED BYPASS PIPE DETAIL

NOT TO SCALE

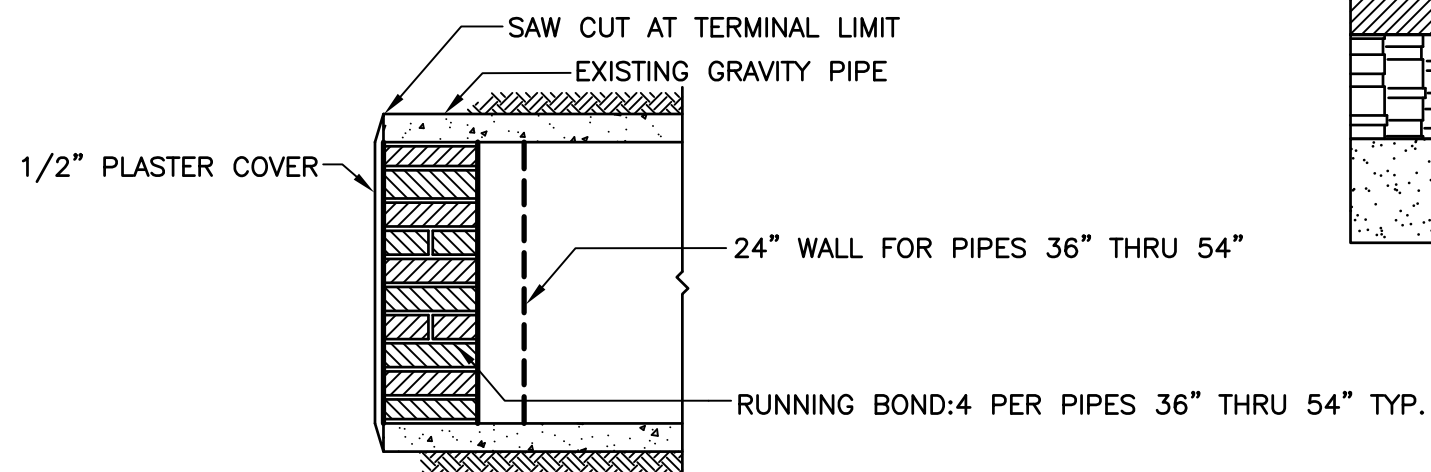

TYPICAL SECTION VIEW

NOTE:

1. BRICK SHALL CONFORM TO ASTM C32.
2. MASONRY CEMENT SHALL CONFORM TO ASTM C 91 AND C 270.


MASONRY BULKHEAD DETAIL

NOT TO SCALE

NOTES:

1. CONTRACTOR SHALL PROVIDE THE CITY AT LEAST TWO WEEKS OF ADVANCED NOTICE PRIOR TO CLOSING LANES OF TRAFFIC FOR INSTALLATION OF BYPASS DISCHARGE PIPE ACROSS ASHLEY STREET.
2. CONTRACTOR SHALL INSTALL AT LEAST 18 FEET OF TEMPORARY PIPE UNDERGROUND AND SHALL EITHER PROVIDE TEMPORARY RESTORATION OR SECURE DRIVABLE STEEL PLATES SO THAT TRAFFIC CAN RESUME.
3. CONTRACTOR SHALL LOCATE IN ADVANCE THE CROSSING UTILITIES, AND SHALL EXERCISE CAUTION DURING INSTALLATION, PROVIDING PROTECTION TO OTHER UTILITIES AS NECESSARY. PROVIDE MIN. 4" CLEARANCE TO ALL UTILITIES.
4. BYPASS DISCHARGE PIPE SHALL BE DESIGNED TO MEET THE HYDRAULIC REQUIREMENTS OF THIS APPLICATION AND BE ABLE TO WITHSTAND THE TEMPORARY LOADINGS FROM TRAFFIC AND RESTORATION WITHOUT FAILING.
5. CONTRACTOR SHALL RESTORE PAVEMENT AS SHOWN ON DETAIL. CONTRACTOR SHALL ALSO RESTORE AND CURB, SIDEWALK OR OTHER INCIDENTAL ITEM DISTURBED IN KIND, TO ITS ORIGINAL CONDITION OR BETTER.
6. CONTRACTOR SHALL FIELD VERIFY ELEVATION OF THE CROSSING UTILITIES ALONG THE ALIGNMENT OF THE BYPASS PUMPING DISCHARGE PIPE.

NOTES:

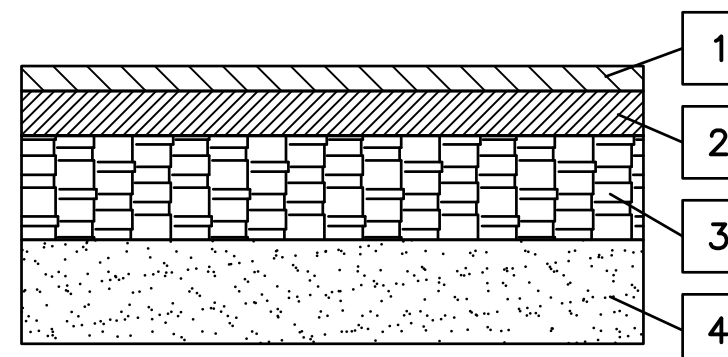

TYPICAL PAVING SECTION

NOT TO SCALE

**GREELEY AND HANSEN**1715 N. WESTSHORE BLVD., STE. 464
TAMPA, FLORIDA 33607

CERTIFICATE OF AUTHORIZATION NO. 37

P.E. NAME: FREDDY J. BETANCOURT P.E. NO. 68072

P.E. NAME: _____

DATE: _____

**Engineering Design
Technologies Corp.**P.O. Box 152403
Tampa, FL 33684-2403
813.289.8080
813.282.9184 FAX
engineering@edt1.com

CITY of TAMPA

WASTEWATER DEPARTMENT

KRAUSE PS REHABILITATION

BYPASS AND MISCELLANEOUS DETAILS

RED LINES1
NO.1/27
DA**NO CHANGES**

DRAWN: J.WHITE

DESIGN: FJB

QC: DCH

DATE: 01/27/15


SHEET G-9

1. REMOVE EXISTING 6" WET WELL/SUMP BYPASS VALVES. GROUT OPENING TO ELIMINATE CONNECTION BETWEEN WET WELL AND SUMP.



1	1/27/15	CONFORME
NO.	DATE	NO CH

B080-014

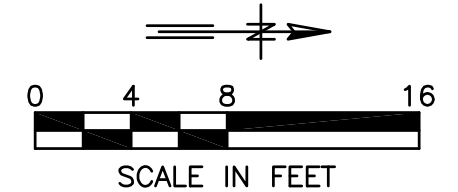

DEMOLISH
EXISTING
PROTRUDING
WALLS

REMOVE
DOOR

DEMOLISH EXISTING SHOWER, COUNTERS
AND SINK, AND CAP ASSOCIATED PIPING
AND REPAIR ASSOCIATED WALLS

DEMOLISH EXISTING
PUMPS

MODIFY CATWALK
ACCESS TO MOTOR.
SEE NOTE 1

ELECTRICAL
ROOM

NOTES:

1. COORDINATE THIS SHEET WITH SHEET M-2 AND STRUCTURAL SHEET FOR NEW MOTOR LOCATION AND CATWALK MODIFICATIONS.

LEGEND:

 DENOTES AREA TO
BE DEMOLISHED

UPPER LEVEL MECHANICAL DEMOLITION PLAN

SCALE: 1/8" = 1'-0"



GREELEY AND HANSEN

1715 N. WESTSHORE BLVD., STE. 464
TAMPA, FLORIDA 33607
CERTIFICATE OF AUTHORIZATION NO. 37

P.E. NAME: FREDDY J. BETANCOURT P.E. NO. 68072

P.E. NAME: _____

DATE: _____



**Engineering Design
Technologies Corp.**
P.O. Box 152403
Tampa, FL 33684-2403
813.289.8080
813.282.9184 FAX
engineering@edt1.com

CITY of TAMPA
WASTEWATER DEPARTMENT

KRAUSE PS REHABILITATION

UPPER LEVEL MECHANICAL
DEMOLITION PLAN




RED LINES

NO CHANGES

DRAWN: J.WHITE
DESIGN: FJB
QC: DCH
DATE: 01/27/15

SHEET D-2

Certificate of Authorization Number: 4795

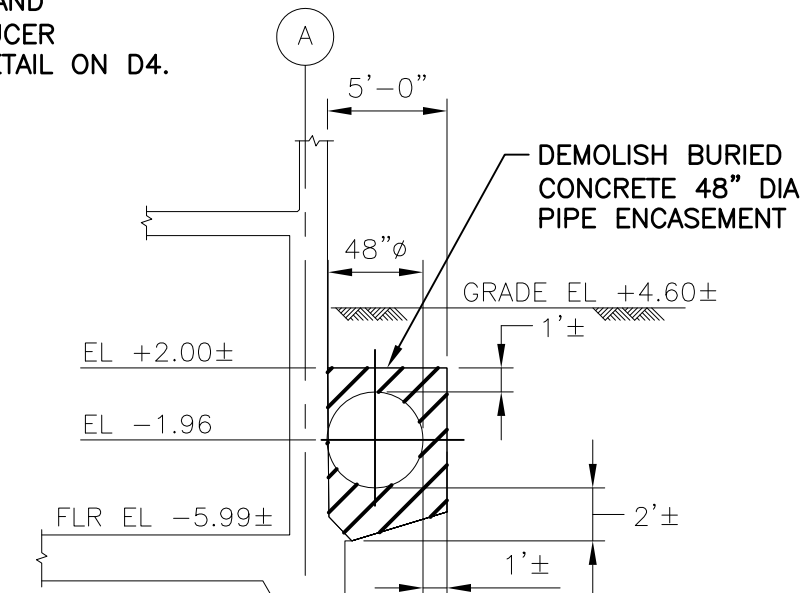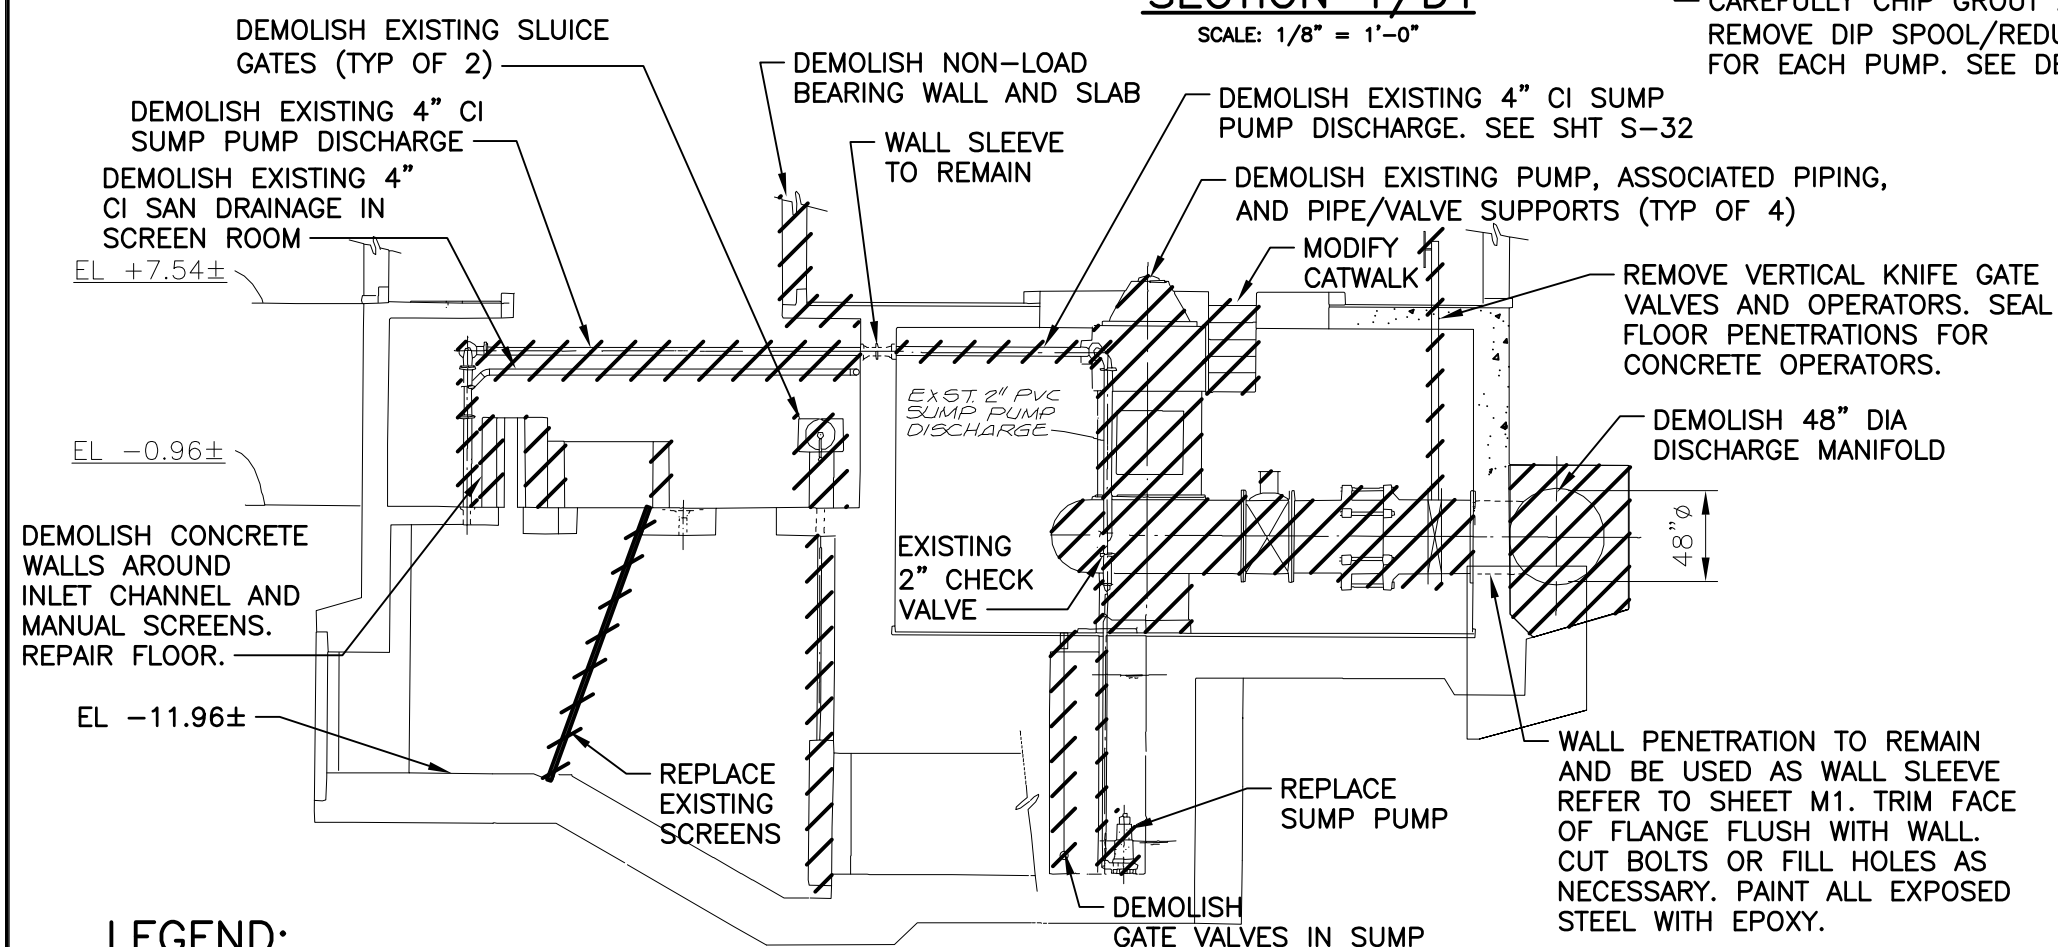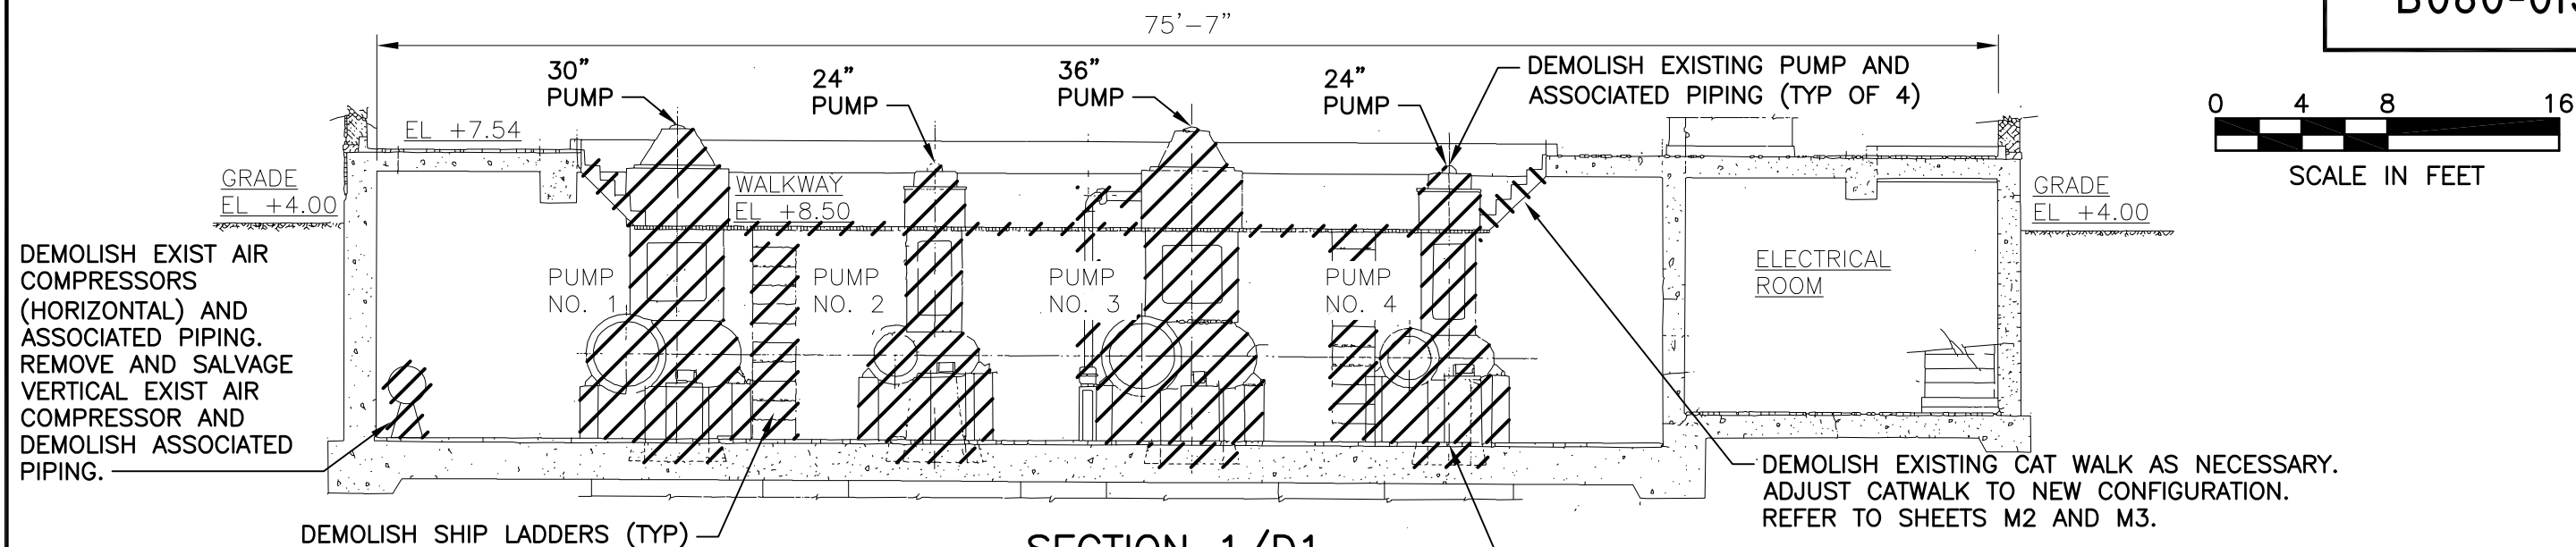

LEGEND:

DENOTES AREA TO BE DEMOLISHED

SECTION 2/D1

SCALE: 1/8" = 1'-0"



Engineering Design
Technologies Corp.
P.O. Box 152403
Tampa, FL 33684-2403
813.289.8080
813.282.9184 FAX
engineering@edt1.com

Certificate of Authorization Number: 4795

CITY of TAMPA
WASTEWATER DEPARTMENT

KRAUSE PS REHABILITATION

MECHANICAL DEMOLITION SECTIONS

RED LINES

1 1/27/15 CONFORMED
NO. DATE

NO CHANGES



GREELEY AND HANSEN

1715 N. WESTSHORE BLVD., STE. 464
TAMPA, FLORIDA 33607
CERTIFICATE OF AUTHORIZATION NO. 37

P.E. NAME: FREDDY J. BETANCOURT P.E. NO. 68072

P.E. NAME: _____

DATE: _____

DRAWN: J.WHITE


DESIGN: FJB

QC: DCH


DATE: 01/27/15

SHEET D-3


B080-016

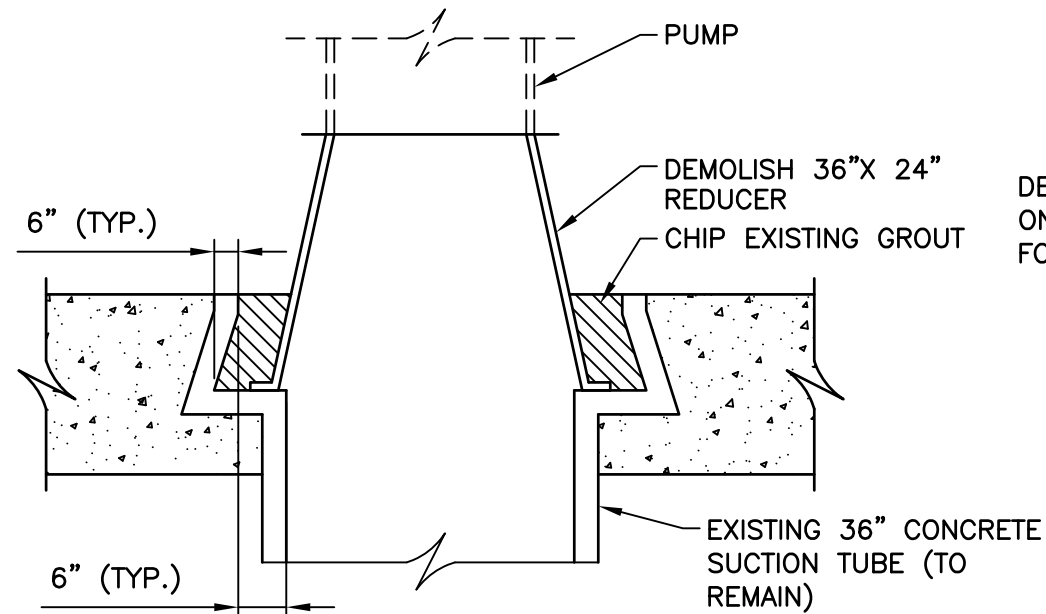


36" SUCTION TUBE DETAIL FOR PUMPS 1 & 2
NOT TO SCALE

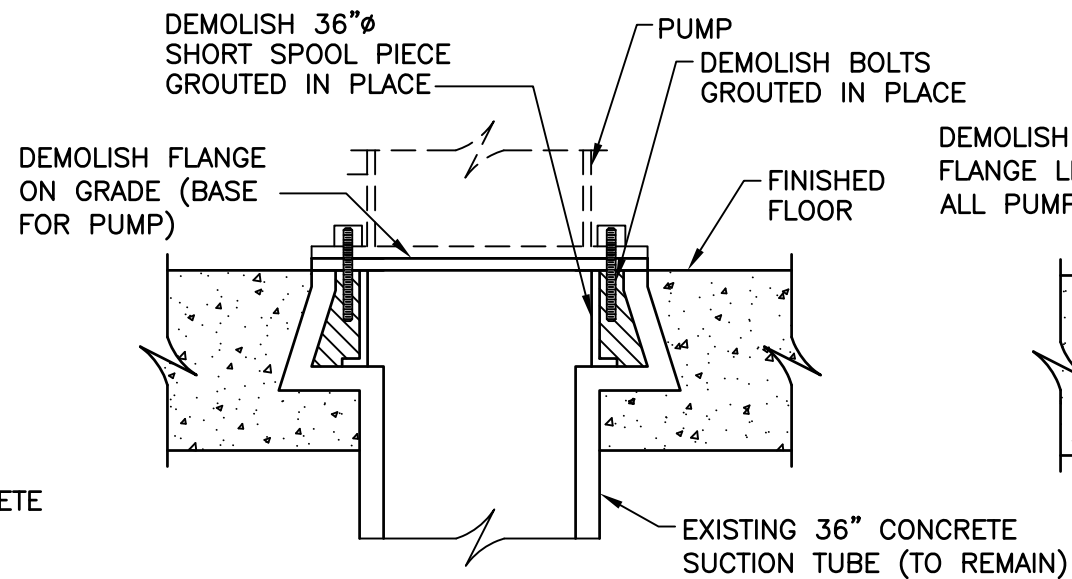

36" SUCTION TUBE DETAIL FOR PUMP NO. 3
NOT TO SCALE

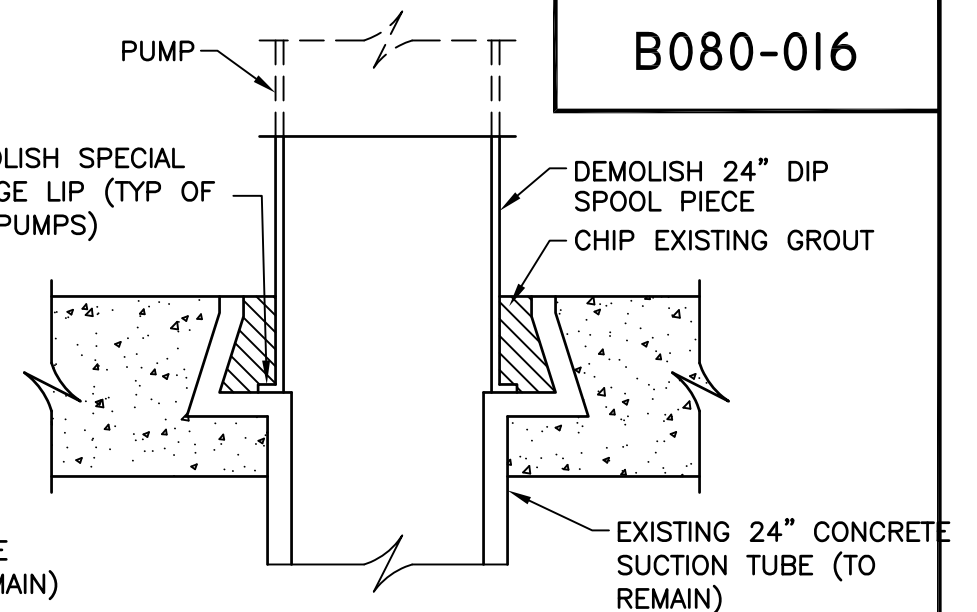

24" SUCTION TUBE DETAIL FOR PUMP NO. 4
NOT TO SCALE

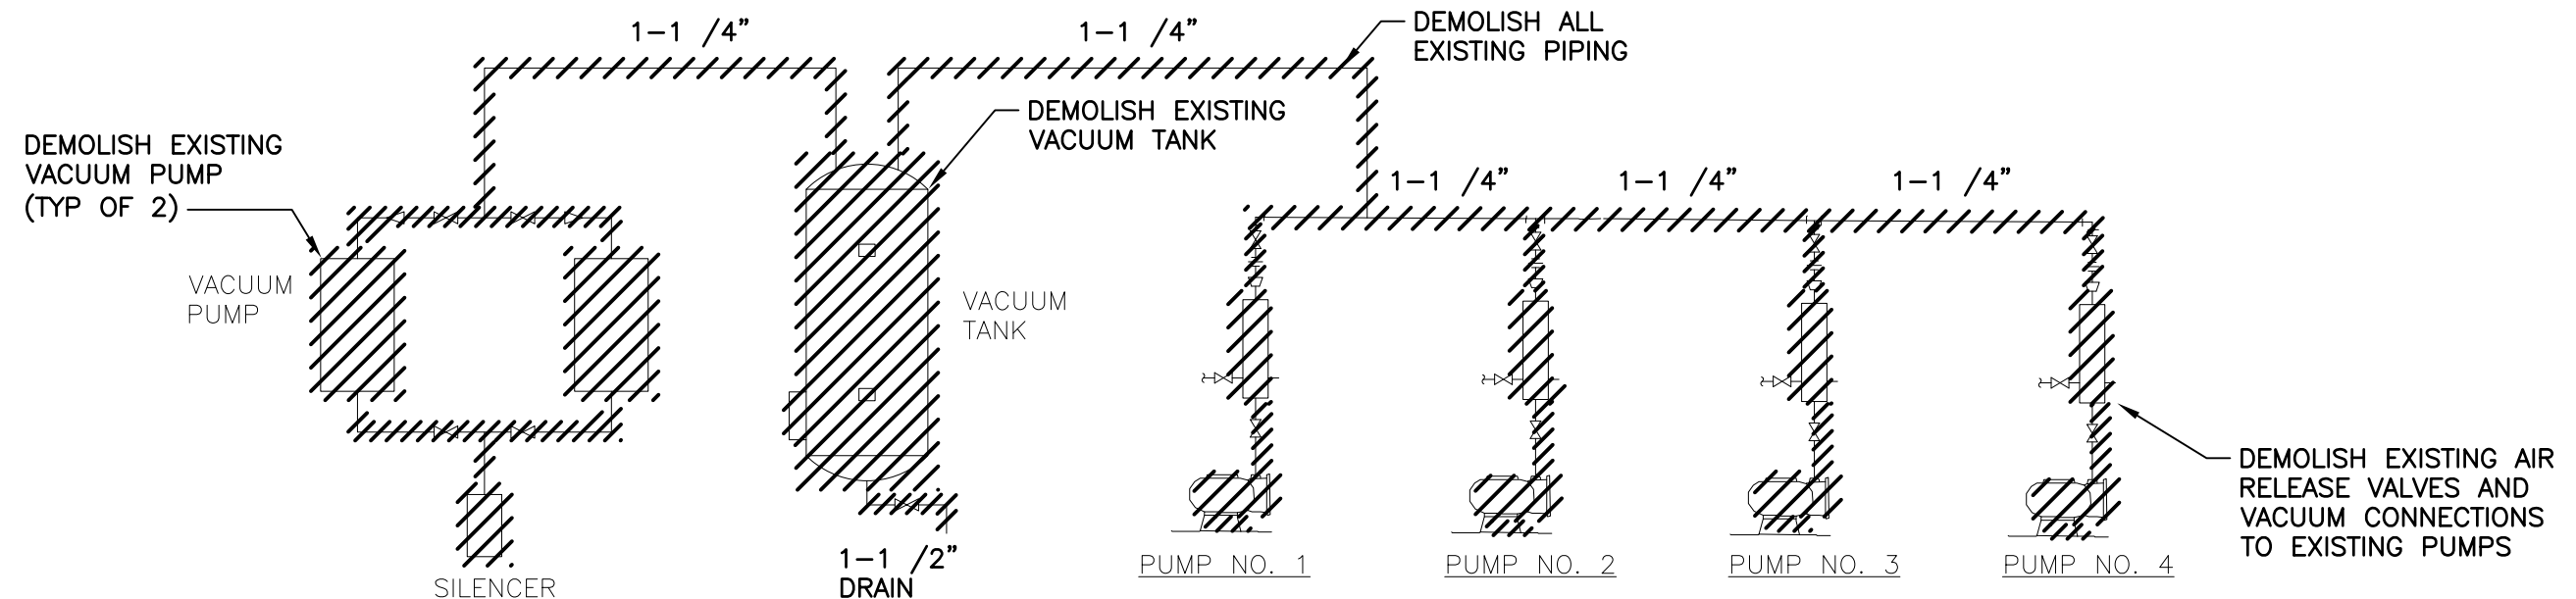

LEGEND:

 DENOTES AREA TO BE DEMOLISHED



GREELEY AND HANSEN

1715 N. WESTSHORE BLVD., STE. 464
TAMPA, FLORIDA 33607

CERTIFICATE OF AUTHORIZATION NO. 37

P.E. NAME: FREDDY J. BETANCOURT P.E. NO. 68072

P.E. NAME: _____

DATE: _____



**Engineering Design
Technologies Corp.**
P.O. Box 152403
Tampa, FL 33684-2403
813.289.8080
813.282.9184 FAX
engineering@edt1.com

CITY of TAMPA
WASTEWATER DEPARTMENT

KRAUSE PS REHABILITATION

WATER, AIR AND PRIMING
SYSTEM DIAGRAMS

RED LINES

NO CHANGES


DRAWN: J.WHITE
DESIGN: FJB
QC: DCH
DATE: 01/27/15

SHEET D-4

1 1/27/15
NO. DATE

Certificate of Authorization Number: 4795

B080-017

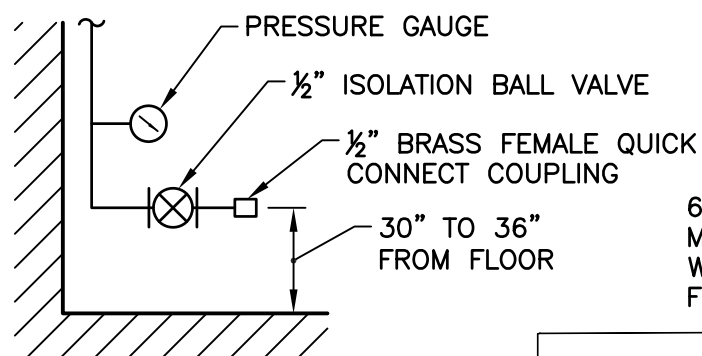

AIR VALVE CONNECTION DETAIL

NOT TO SCALE

6" 316 SS CHANNELS MOUNTED ON CHANNEL WALLS FOR STOP LOG FRAMING. SEE SHT M-7


REPLACE 4" CI DRAINAGE WITH 4" PVC IN WET WELL. TRANSITION 2" FROM WALL SLEEVE.

INFLUENT CHANNEL BUBBLER

2/M3

20"x24" STEEL FABRICATED INCREASER (WITH HORIZONTAL OFFSET)

CL OF NEW PUMP DISCHARGE
20" FLANGE

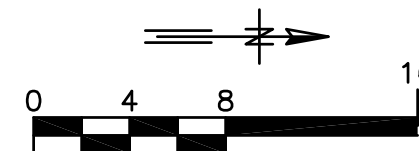

SCALE IN FEET

* DISTANCE TO BE FIELD VERIFIED AND COORDINATED WITH PUMP SUPPLIER. CONTRACTOR SHALL PROVIDE A LIST OF FIELD MEASURED DISTANCES AND CORRESPONDING INCREASER DESIGN DIMENSIONS PER AWWA C208, FOR EACH PUMP, AS PART OF THE SHOP DRAWINGS FOR STEEL INCREASERS.

STEEL INCREASER DETAIL

NOT TO SCALE

INSTALL NEW 3" SCH 80 PVC SUMP PUMP DISCHARGE

POST SCREEN BUBBLER


AIR HOSE VALVE CONNECTION

REUSE EXISTING WALL SLEEVE

BASEMENT
(TO BE ABANDONED)

1/M3

1/M3

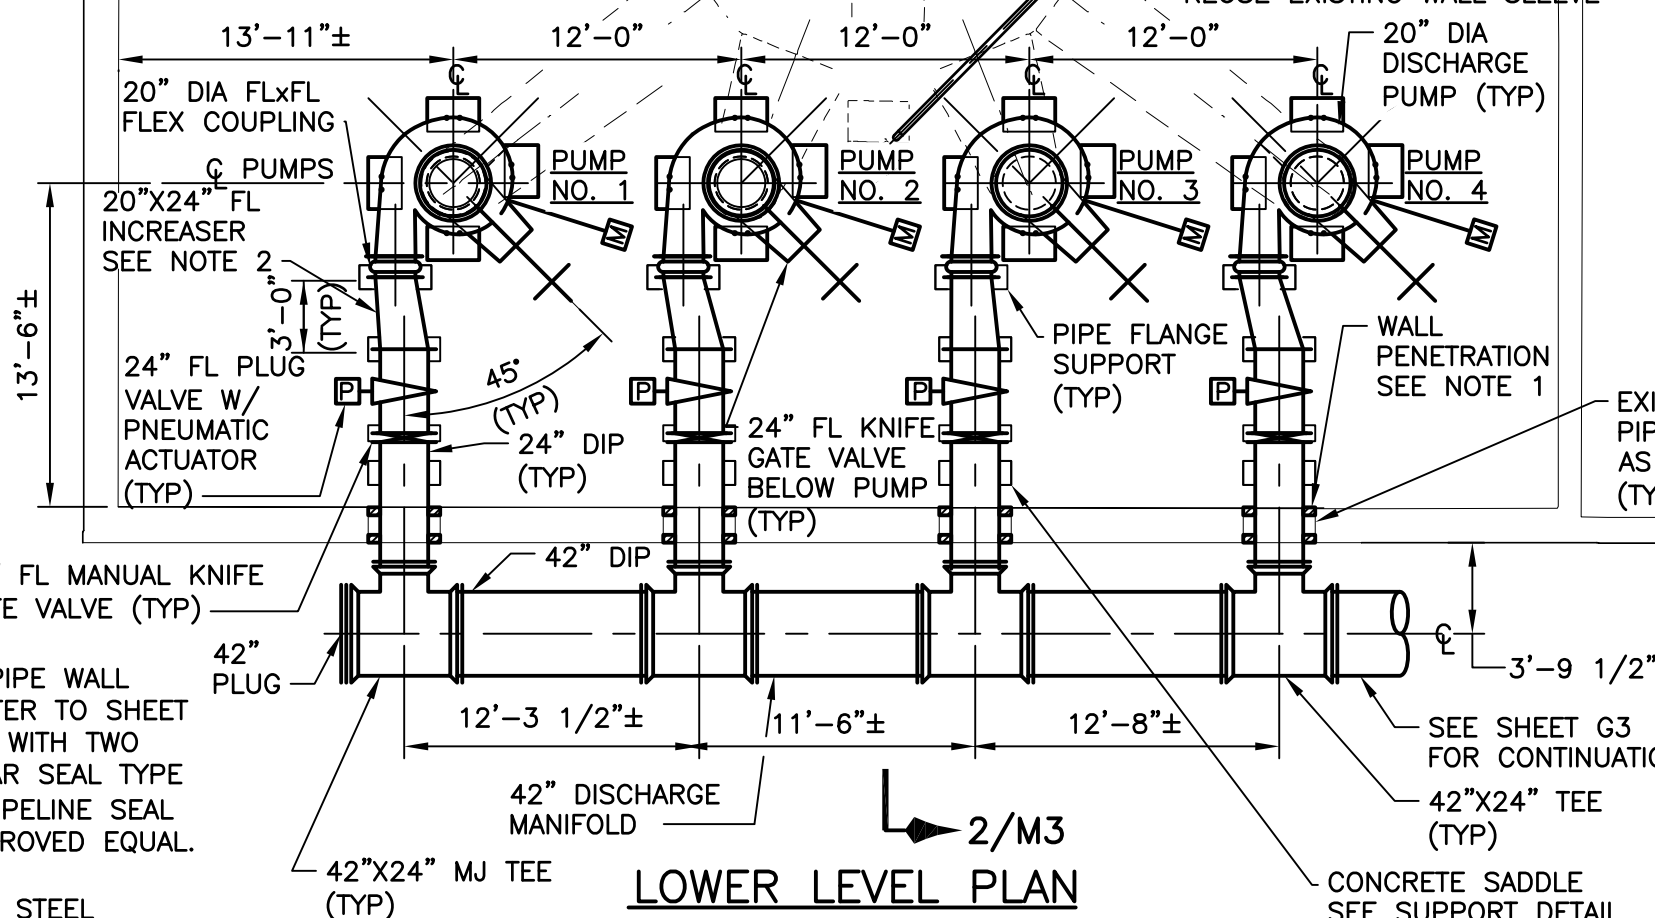

LOWER LEVEL PLAN

SCALE: 1/8" = 1'-0"

NOTES:

1. REUSE EXISTING 36" STEEL PIPE WALL PENETRATION AS CASING. REFER TO SHEET D3. SEAL WALL PENETRATION WITH TWO ROWS OF LINK-SEAL MODULAR SEAL TYPE "C" AS MANUFACTURER BY PIPELINE SEAL AND INSULATOR, INC OR APPROVED EQUAL.
2. 20"x24" CUSTOM FABRICATED STEEL INCREASER PER AWWA C208. SEE DETAIL ON THIS SHEET.



GREELEY AND HANSEN

1715 N. WESTSHORE BLVD., STE. 464
TAMPA, FLORIDA 33607
CERTIFICATE OF AUTHORIZATION NO. 37

P.E. NAME: FREDDY J. BETANCOURT P.E. NO. 68072

P.E. NAME: _____

DATE: _____



Engineering Design Technologies Corp.

P.O. Box 152403
Tampa, FL 33684-2403
813.289.8080
813.282.9184 FAX
engineering@edt1.com

Certificate of Authorization Number: 4795

CITY of TAMPA
WASTEWATER DEPARTMENT

KRAUSE PS REHABILITATION

LOWER LEVEL PLAN

RED LINES

1/27/15 CONFORMED
NO. DATE

NO CHANGES

DRAWN: J.WHITE

DESIGN: FJB

QC: DCH


DATE: 01/27/15

SHEET M-1

B080-018

NOTES:

1. MODIFY CATWALK EXTENSIONS TO NEW MOTORS. CATWALK EDGE TO BE 9-INCHES CLEAR OF MOTOR FRAME. COORDINATE WITH MOTOR MANUFACTURER. PROPOSED CATWALK TO BE LEVEL AT ELEVATION 7.54 (TO MATCH EXISTING FLOOR ELEVATION). SUPPORT COLUMNS AND HANDRAILS TO BE REPLACED. SEE SHT S-34.
2. FIELD ROUTE NEW AIR PIPING TO EACH NEW PNEUMATIC PLUG VALVE ACTUATOR. PIPING SHALL PENETRATE FLOOR SLAB TO LOWER LEVEL AND SHALL BE ROUTED SUSPENDED FROM FLOOR SLAB WITH PIPE HANGERS.
3. FIELD ROUTE NEW VACUUM PIPING TO EACH NEW PUMP ASSEMBLY. PIPE SHALL PENETRATE FLOOR SLAB TO LOWER LEVEL AND SHALL BE ROUTED SUSPENDED FROM FLOOR SLAB WITH PIPE HANGERS.
4. NEW AIR COMPRESSORS, VACUUM PUMPS AND AIR DRYER SHALL HAVE ALL ELECTRICAL COMPONENTS ABOVE ELEVATION +10.0'. INSTALL MECHANICAL EQUIPMENT PADS AS SHOWN ON SHEET S-33. IF REQUIRED RAISE ELEVATION OF EQUIPMENT WITH STANDS.
5. CONSTRUCT NEW 1/2" ALUMINUM CHECKERED PLATE, ASTM B209 -07, NON-SLIP DIAMOND PATTERN, MINIMUM YIELD STRENGTH FY= 35 KSI. FOLLOW DETAIL PROVIDED FOR SUMP PUMP COVER ON SHEET S-33.

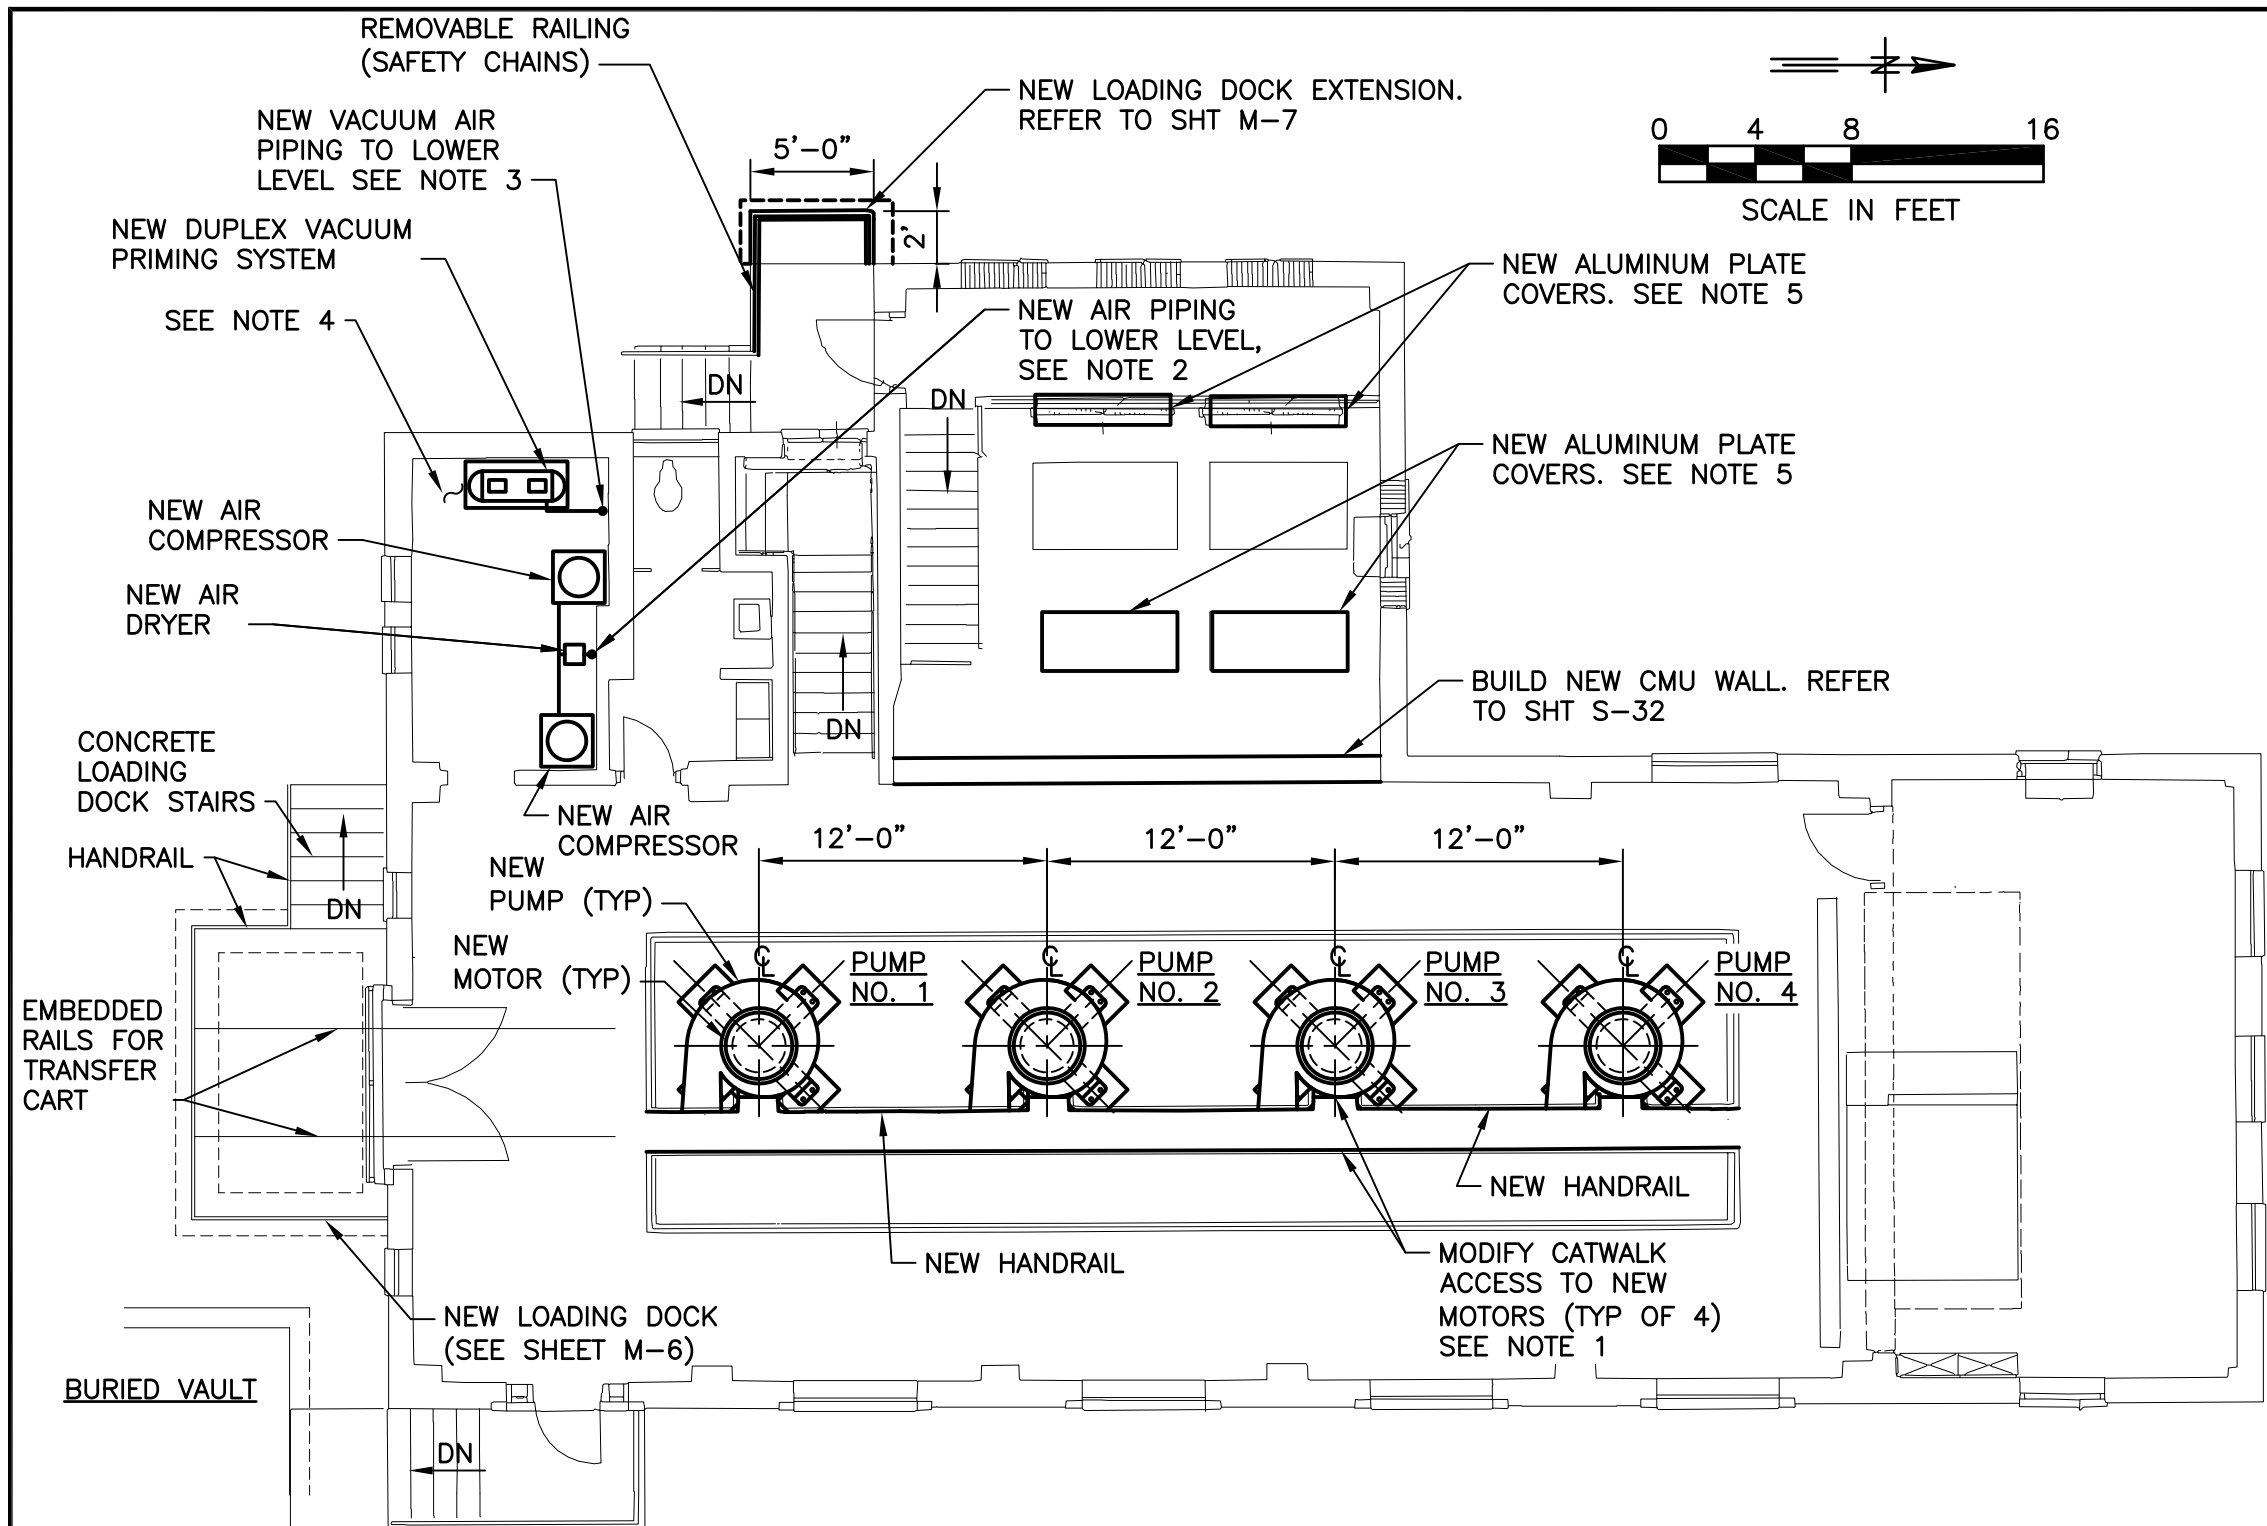

UPPER LEVEL PLAN

SCALE: $1/8" = 1'-0"$



GREELEY AND HANSEN

1715 N. WESTSHORE BLVD., STE. 464
TAMPA, FLORIDA 33607

CERTIFICATE OF AUTHORIZATION NO. 37

P.E. NAME: FREDDY J. BETANCOURT P.E. NO. 68072

P.E. NAME: _____

DATE: _____

DRAWN: J. WHITE

DESIGN: FJB

QC: DCH

DATE: 01/27/

SHEET M-2



Engineering Design Technologies Corp.

P.O. Box 152403
Tampa, FL 33684-2403
813.289.8080
813.282.9184 FAX
engineering@edt1.com

Certificate of Authorization Number: 4795

CITY of TAMPA

WASTEWATER DEPARTMENT


KRAUSE PS REHABILITATION

UPPER LEVEL PLAN

RED LINES

NO CHANGES

1	1/27/15	CONFORME
NO.	DATE	NO CH

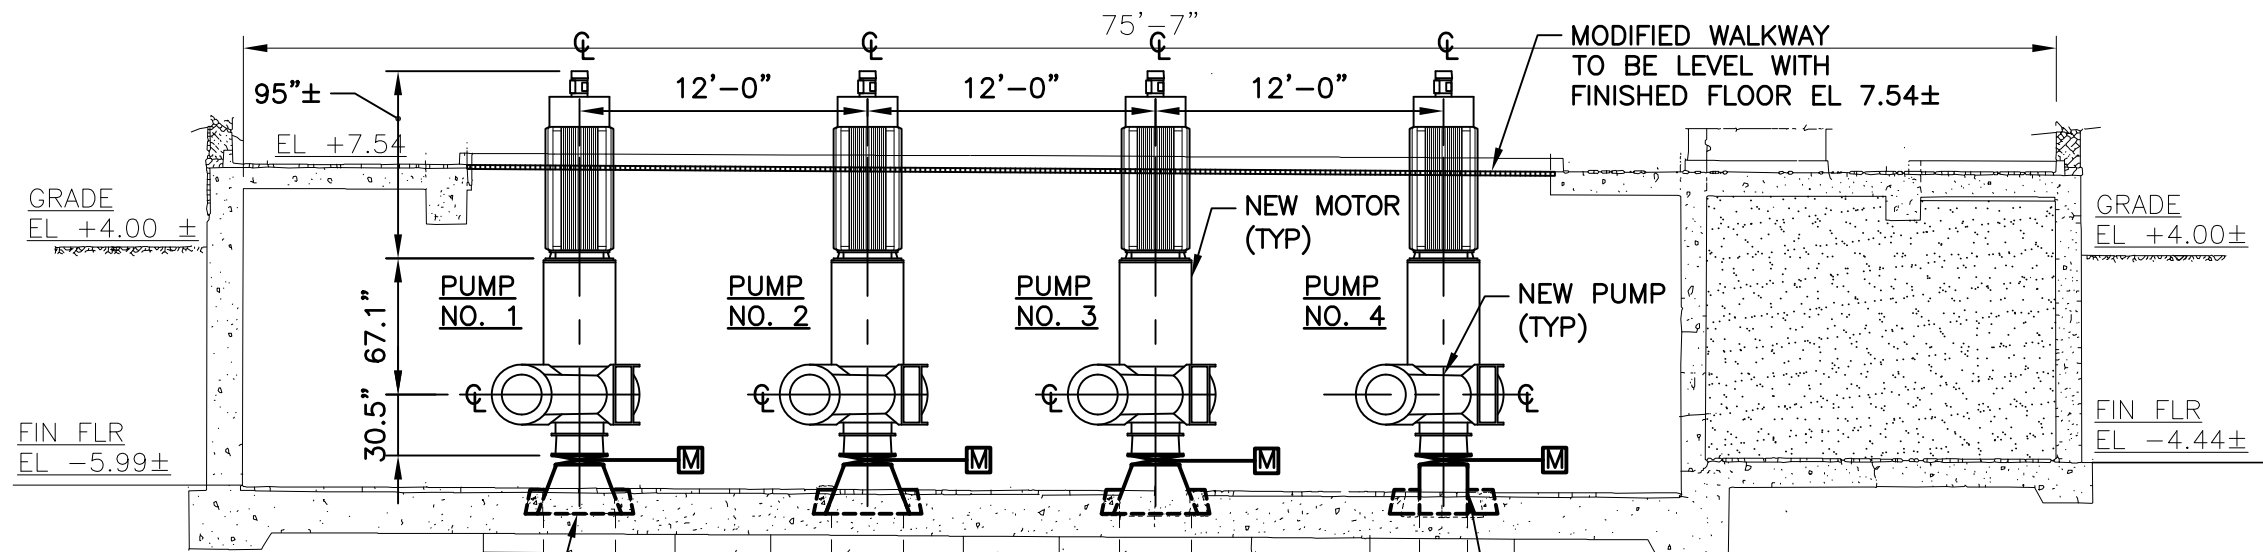


INSTALL NEW CUSTOM FLG X SPECIAL FLANGE SPOOL SUCTION TUBE INCREASER FOR PUMP. GROUT INCREASER IN PLACE. SEE DETAIL ON SHEET M4 (TYP OF 3)

INSTALL NEW CUSTOM 24" FLG X SPECIAL FLG SPOOL PIECE SUCTION TUBE FOR PUMP NO. 4. GROUT TUBE IN PLACE. SEE DETAILS ON SHT M4.

SECTION 1/M1

SCALE: 1/8" = 1'-0"

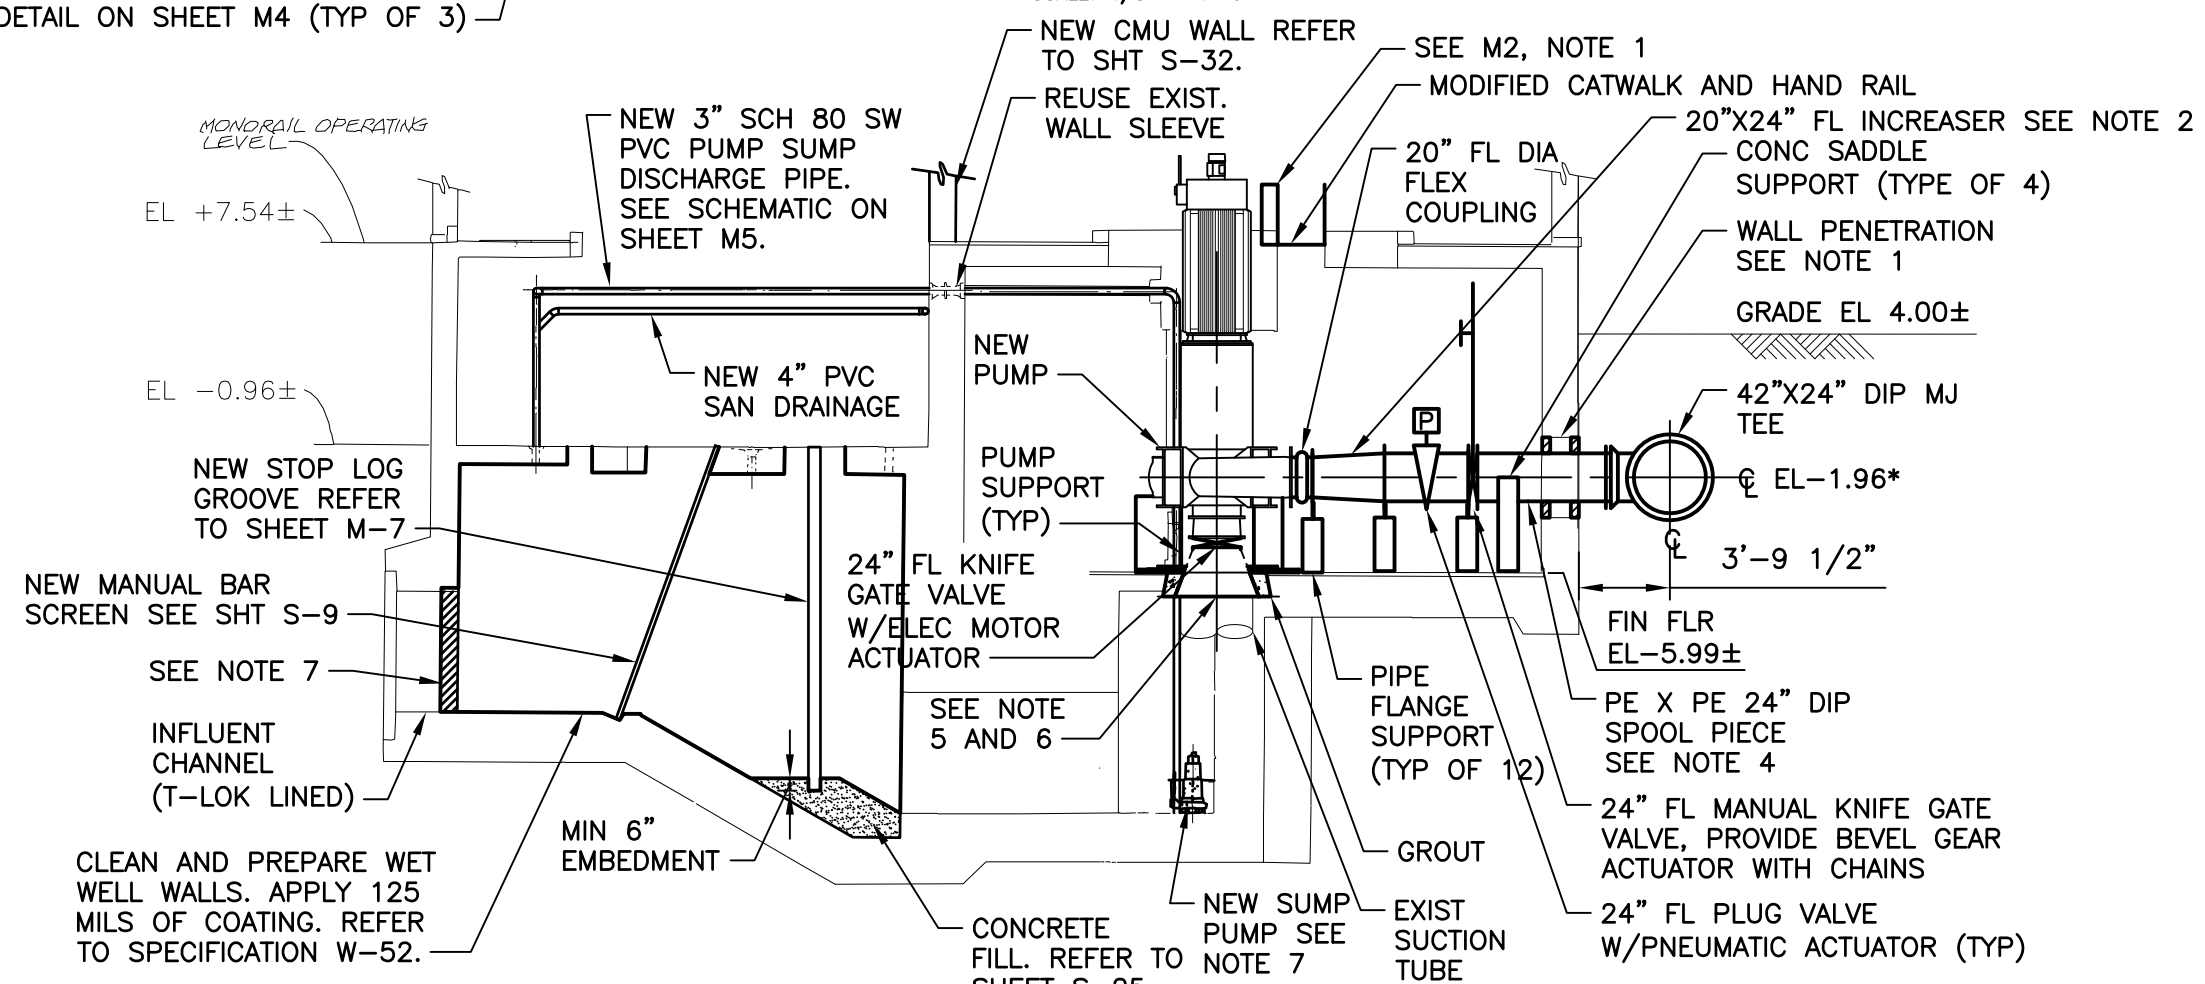

SECTION 2/M1

SCALE: 1/8" = 1'-0"

B080-019

NOTES:

1. REUSE EXISTING WALL PENETRATION. SEAL WALL PENETRATION WITH TWO NEW ROWS OF LINK-SEAL MODULAR SEAL TYPE "C" AS MANUFACTURER BY PIPELINE SEAL AND INSULATOR, INC OR APPROVED EQUAL.
2. 20"x24" CUSTOM FABRICATED STEEL INCREASER. SEE DETAIL ON SHEET M-1
3. *CL TO BE ADJUSTED BASED ON EXISTING WALL PENETRATIONS.
4. PE X PE DIP SPOOL PIECE TO BE CUT TO SUIT IN FIELD. LENGTH TO BE DETERMINED PER ACTUAL LAY LENGTH OF OTHER COMPONENTS SHOWN. CONNECT THE SPOOL PIECE WITH THE KNIFE GATE VALVE BY USING A RESTRAINED FLANGE ADAPTER, MEGA FLANGE AS MANUFACTURED BY EBAA IRON INC. OR APPROVED EQUAL.
5. REPLACE EXISTING SUMP PUMP COVER WITH 1/2" THICK CHECKERED PLATE. SEE SHT S-33.
6. PROVIDE NEW STAINLESS STEEL CONNECTION HARDWARE FOR REDUCER TO SUCTION PIPE ASSEMBLY.
7. COAT A MINIMUM OF 6-INCHES OF OVERLAP ON THE T-LOK LINED INFLUENT CHANNEL.
8. PROVIDE SUBMERSIBLE, SINGLE SEAL, FLOOR MOUNTED, 1/2 HP WASTEWATER SUMP PUMP MODEL NO. 1411, AS MANUFACTURED BY WEIL PUMP COMPANY OR APPROVED EQUAL.



GREELEY AND HANSEN

1715 N. WESTSHORE BLVD., STE. 464
TAMPA, FLORIDA 33607
CERTIFICATE OF AUTHORIZATION NO. 37

P.E. NAME: FREDDY J. BETANCOURT P.E. NO. 68072

P.E. NAME: _____
DATE: _____



Engineering Design Technologies Corp.
P.O. Box 152403
Tampa, FL 33684-2403
813.289.8080
813.282.9184 FAX
engineering@edt1.com

CITY of TAMPA
WASTEWATER DEPARTMENT

KRAUSE PS REHABILITATION

SECTIONS AND DETAILS


RED LINES

NO CHANGES

DRAWN: J.WHITE
DESIGN: FJB
QC: DCH
DATE: 01/27/15

SHEET M-3


Certificate of Authorization Number: 4795

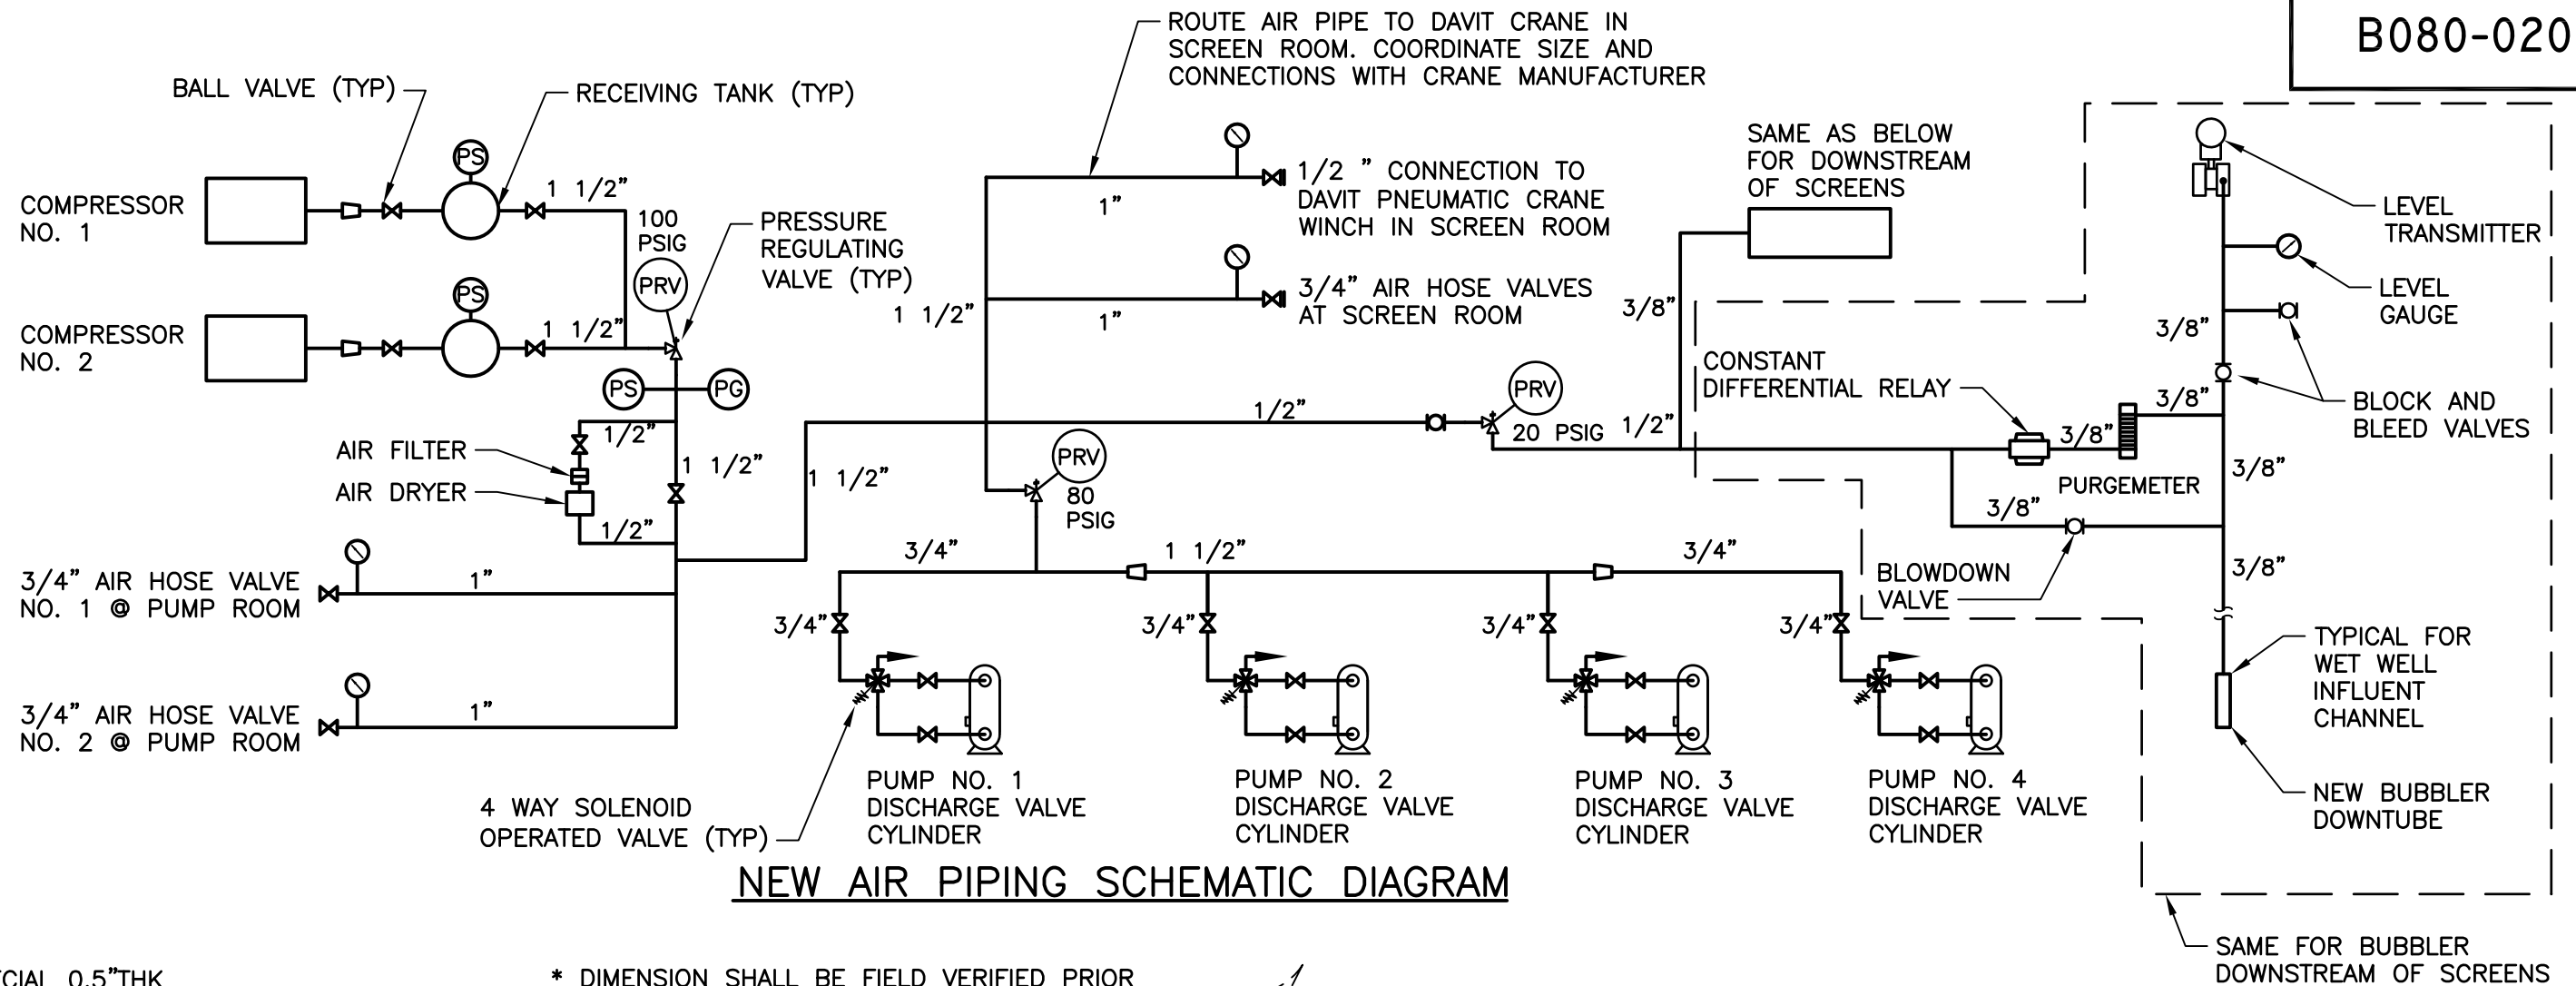

NEW AIR PIPING SCHEMATIC DIAGRAM

SPECIAL 0.5"THK FLANGE (42" O.D.) TO BE USED AS LIP OVER CONC. SUCTION TUBE


EXISTING 36" CONCRETE SUCTION TUBE

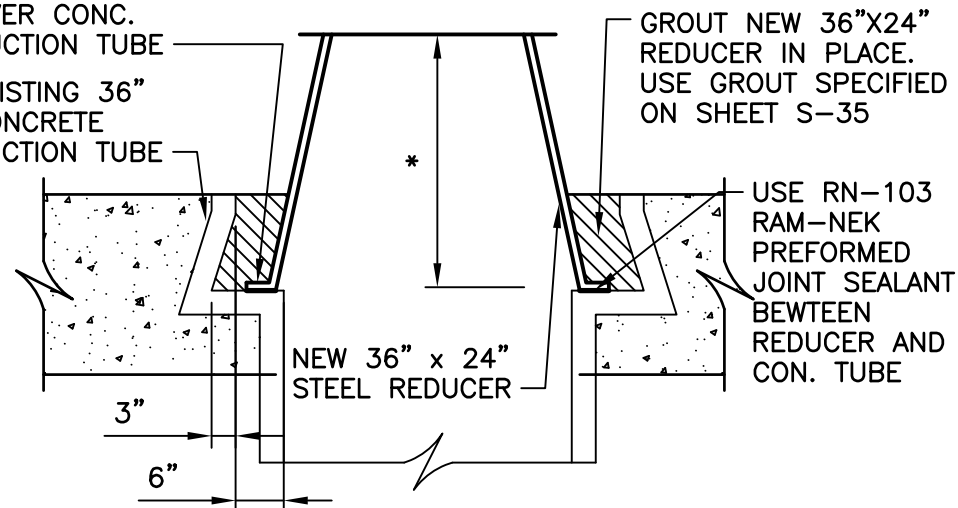

NEW SUCTION TUBE DETAIL FOR PUMPS 1, 2 & 3
NOT TO SCALE

* DIMENSION SHALL BE FIELD VERIFIED PRIOR TO MANUFACTURING SPOOL/REDUCER

NEW 24" STEEL SPOOL PIECE

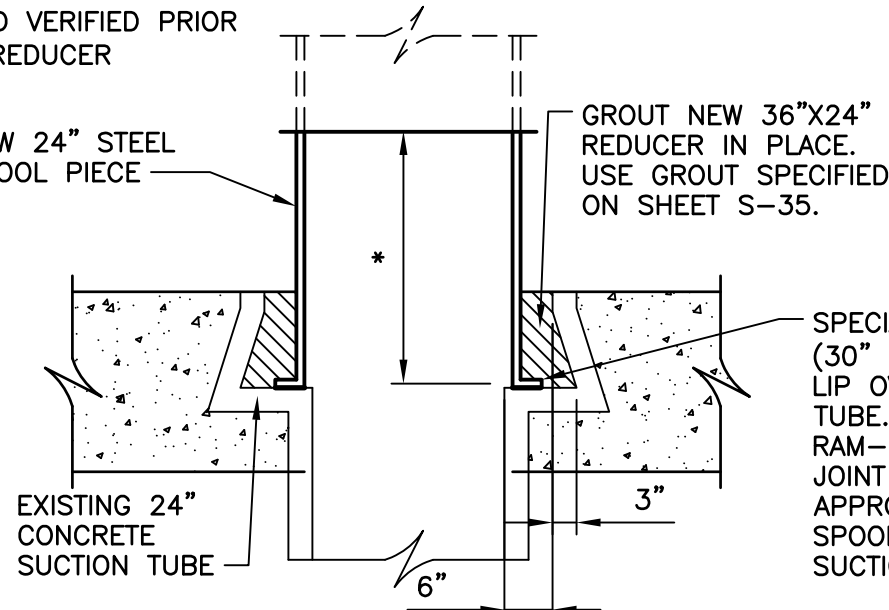

NEW SUCTION TUBE DETAIL FOR PUMP 4
NOT TO SCALE

NOTES:

1. REFER TO SPECIFICATIONS FOR APPROVED PIPE HANGER SYSTEMS. INSTALL NUMBER OF PIPE HANGERS AS REQUIRED. QUANTITY AND SPACING OF HANGER SHALL BE AS RECOMMENDED BY MANUFACTURER.



GREELEY AND HANSEN

1715 N. WESTSHORE BLVD., STE. 464
TAMPA, FLORIDA 33607
CERTIFICATE OF AUTHORIZATION NO. 37

P.E. NAME: FREDDY J. BETANCOURT P.E. NO. 68072

P.E. NAME: _____
DATE: _____



Engineering Design Technologies Corp.
P.O. Box 152403
Tampa, FL 33684-2403
813.289.8080
813.282.9184 FAX
engineering@edt1.com

Certificate of Authorization Number: 4795

CITY of TAMPA
WASTEWATER DEPARTMENT

KRAUSE PS REHABILITATION
NEW AIR PIPING DIAGRAMS
AND NEW SUCTION TUBE DETAILS

RED LINES



NO CHANGES

1	7/3/14	REV. 4	ADDED CONNECTION FOR CRANE
NO.	DATE	REV.	DESCRIPTION

DRAWN: J. WHITE
DESIGN: FJB
QC: DCH
DATE: 01/27/15
SHEET M-4

NOTES:

1. REFER TO SPECIFICATIONS FOR APPROVED PIPE HANGER SYSTEMS. INSTALL NUMBER OF PIPE HANGERS AS REQUIRED. QUANTITY AND SPACING OF HANGER SHALL BE AS RECOMMENDED BY MANUFACTURER.

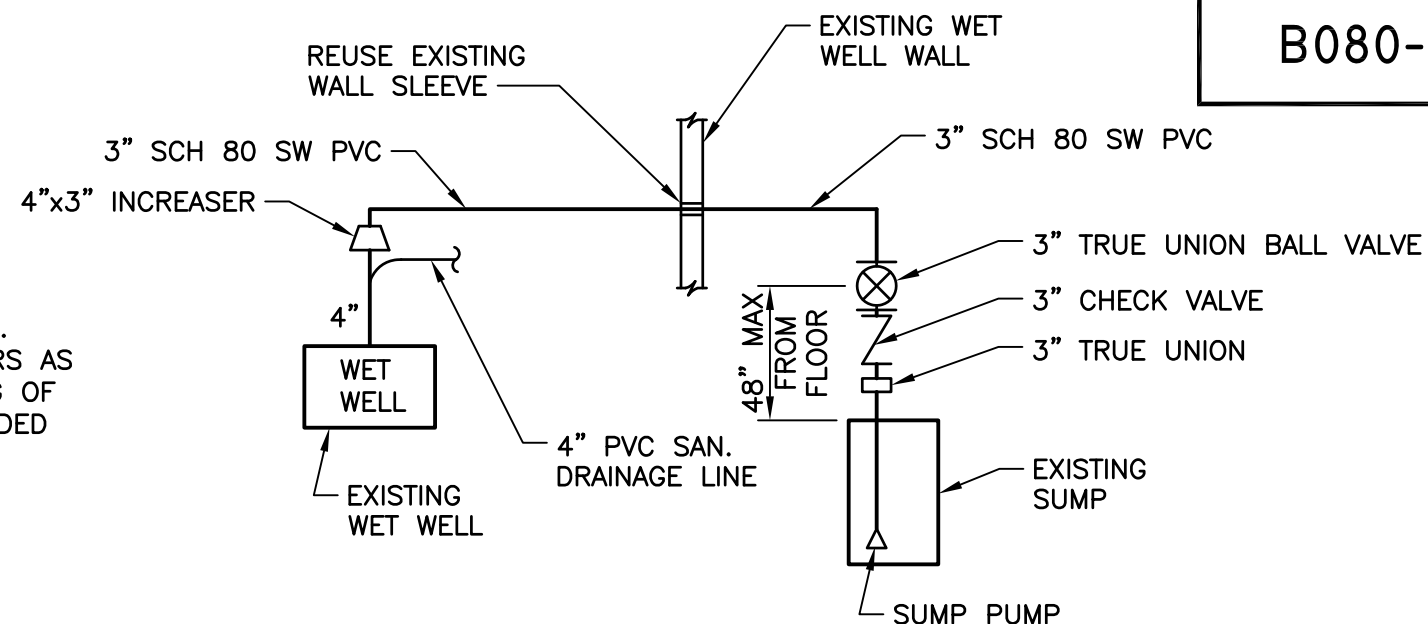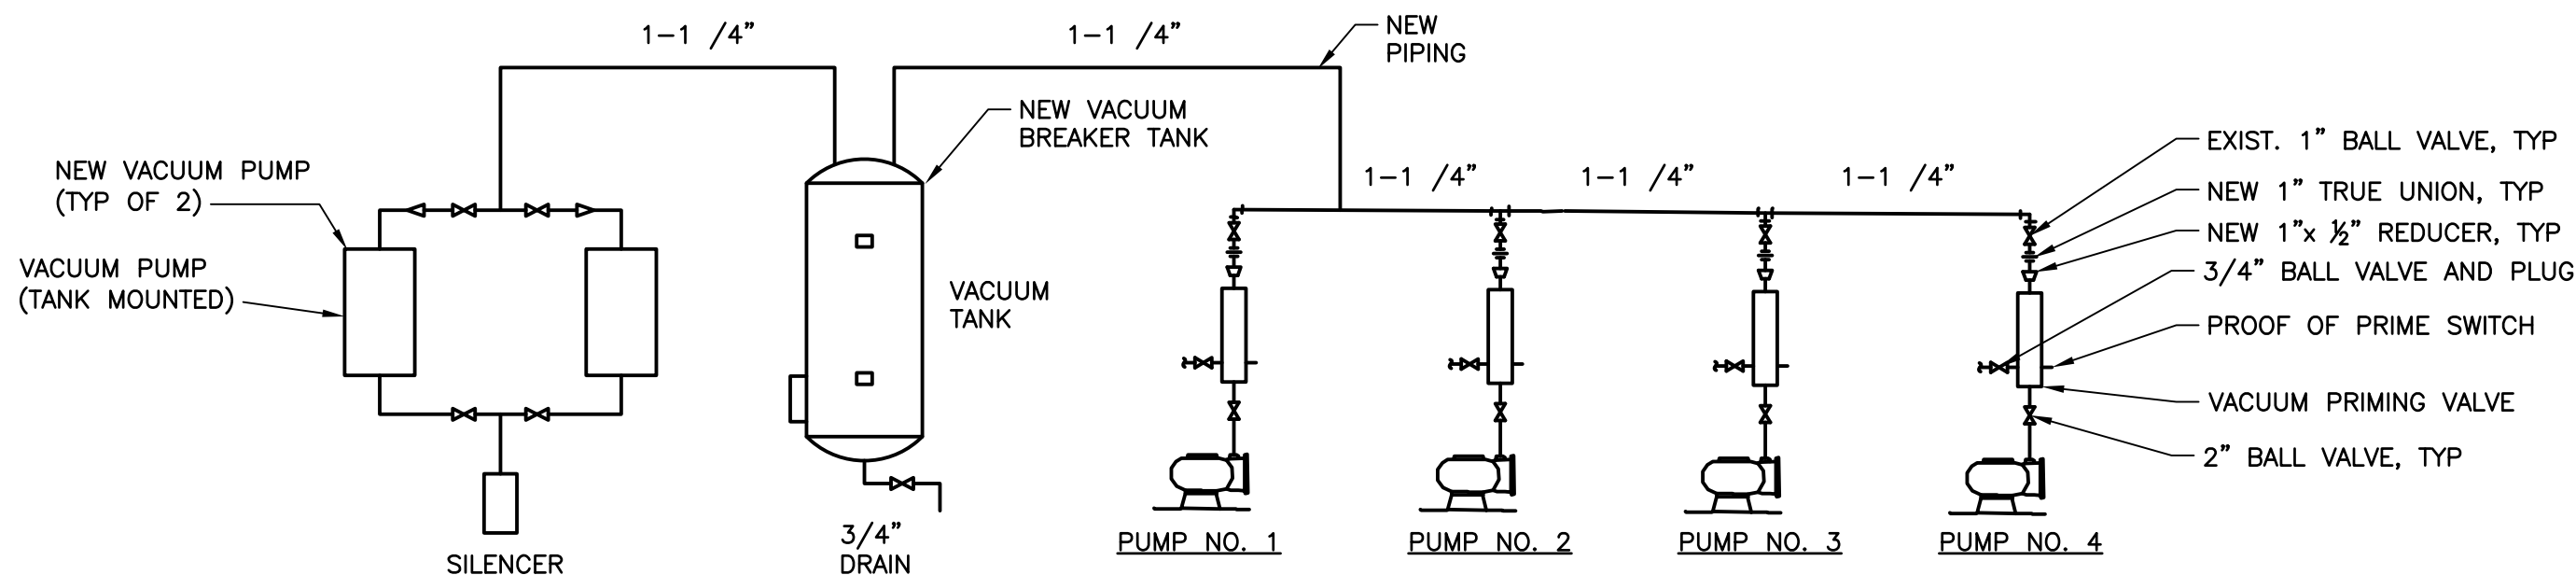**SUMP PUMP RETURN SCHEMATIC DIAGRAM****VACUUM SYSTEM SCHEMATIC DIAGRAM****GREELEY AND HANSEN**1715 N. WESTSHORE BLVD., STE. 464
TAMPA, FLORIDA 33607

CERTIFICATE OF AUTHORIZATION NO. 37

P.E. NAME: FREDDY J. BETANCOURT P.E. NO. 68072

P.E. NAME: _____

DATE: _____

**Engineering Design
Technologies Corp.**P.O. Box 152403
Tampa, FL 33684-2403
813.289.8080
813.282.9184 FAX
engineering@edt1.com

Certificate of Authorization Number: 4795

CITY of TAMPA
WASTEWATER DEPARTMENTKRAUSE PS REHABILITATION
AIR VACUUM PRIMING
SYSTEM AND SUMP PUMP DIAGRAMS**RED LINES****NO CHANGES**


DRAWN: J. WHITE

DESIGN: FJB

QC: DCH

DATE: 01/27/15

SHEET M-5

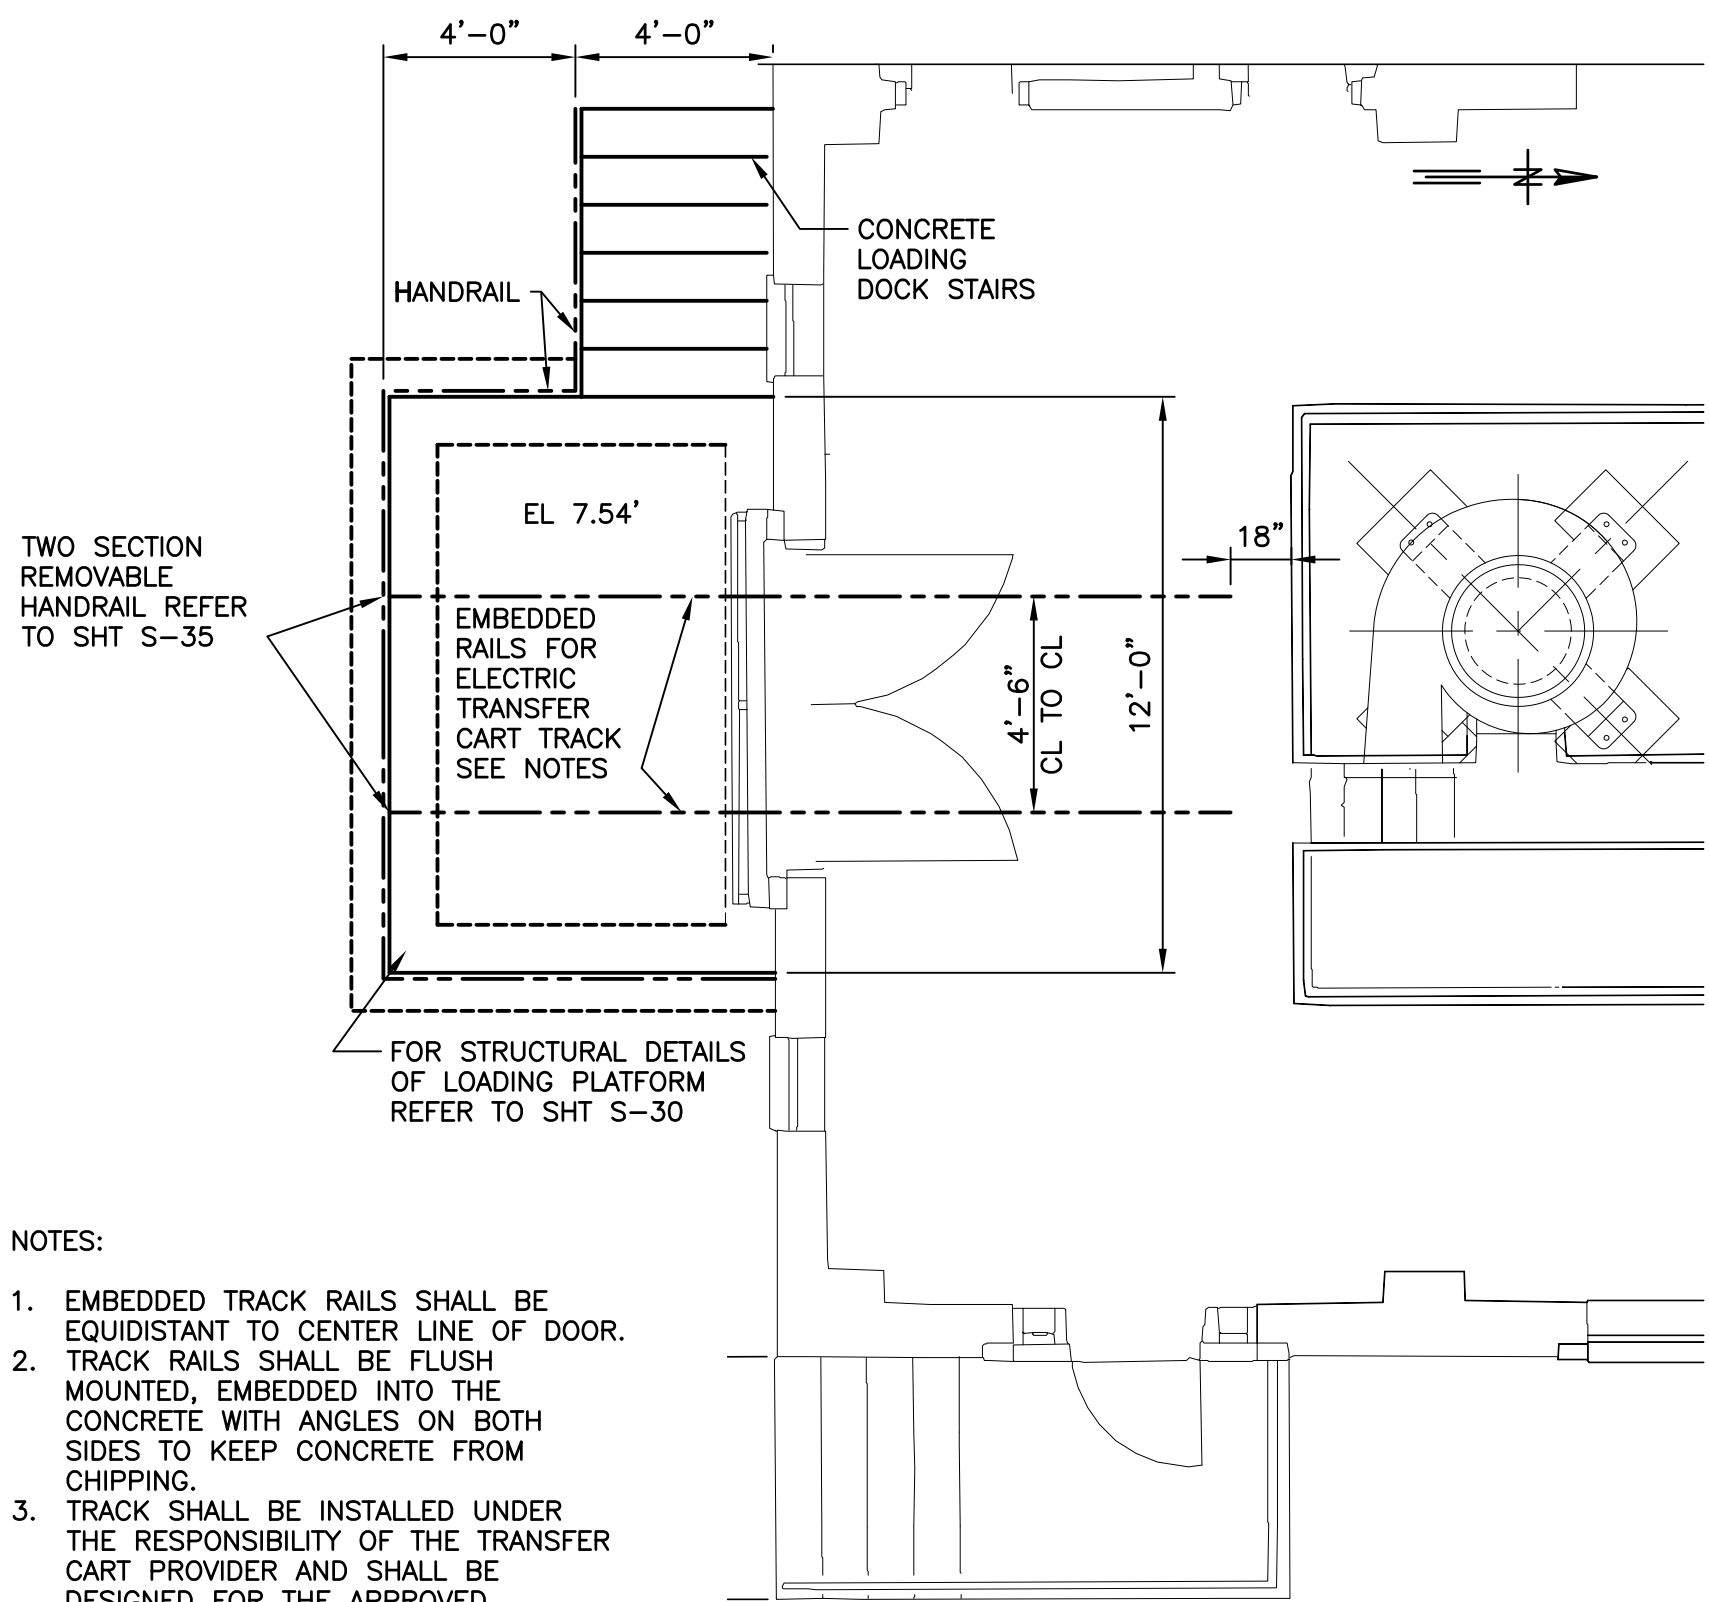


NOTES:

1. EMBEDDED TRACK RAILS SHALL BE EQUIDISTANT TO CENTER LINE OF DOOR.
2. TRACK RAILS SHALL BE FLUSH MOUNTED, EMBEDDED INTO THE CONCRETE WITH ANGLES ON BOTH SIDES TO KEEP CONCRETE FROM CHIPPING.
3. TRACK SHALL BE INSTALLED UNDER THE RESPONSIBILITY OF THE TRANSFER CART PROVIDER AND SHALL BE DESIGNED FOR THE APPROVED TRANSFER CART AND EXPECTED LOADS. EQUIPMENT LOADING PLATFORM UPPER LEVEL PLAN.

LOADING PLATFORM
UPPER LEVEL PLAN – FLR EL 7.54

SCALE: 1/4" = 1'-0"

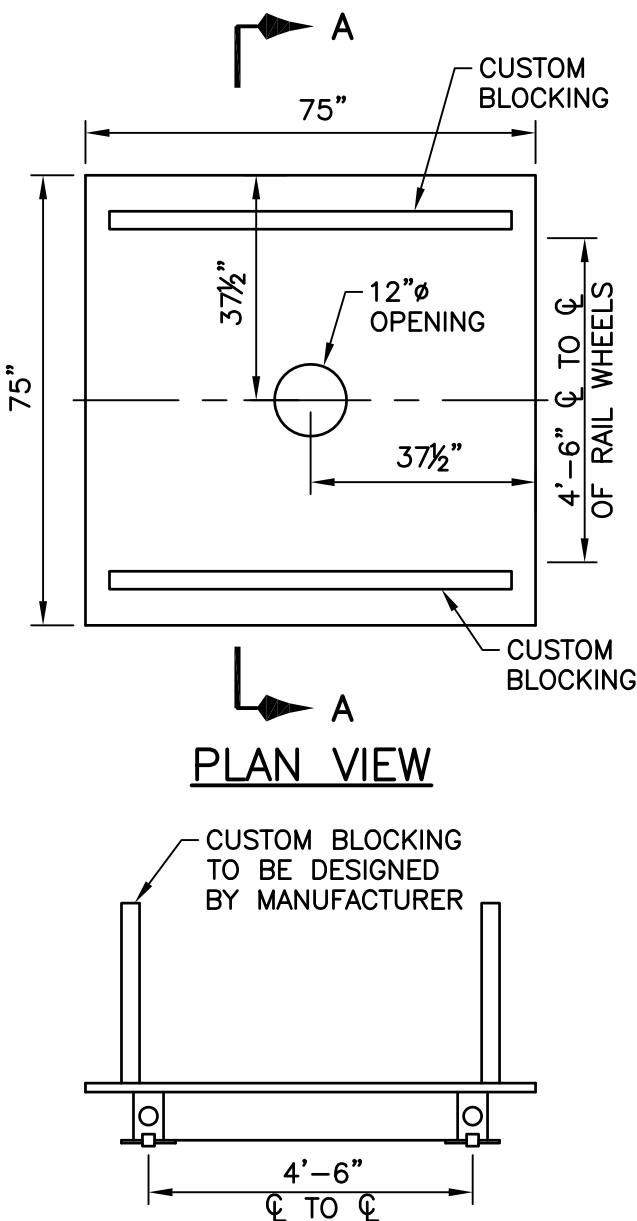

TRANSFER CART DETAILS

SCALE: 1/4" = 1'-0"

NOTES:

1. PROVIDE A SOLID TOP, ELECTRICALLY ASSISTED TRANSFER CART FOR A CAPACITY OF 6.5 TONS.
2. PROVIDE SUITABLE EMBEDDED TRACK RAIL SYSTEM DESIGNED FOR ELECTRICALLY ASSISTED TRANSFER CART. INSTALLATION OF TRACKS SHALL BE RESPONSIBILITY OF TRANSFER CART MANUFACTURER.
3. PROVIDE A 12" DIAMETER OPENING IN CENTER OF SOLID TOP. CART HEIGHT SHALL NOT EXCEED 12 INCHES. IF DESIGN REQUIRES CART HEIGHT HIGHER THAN 12 INCHES, THEN MANUFACTURER SHALL COORDINATE WITH PUMP SUPPLIER AND FIELD DIMENSIONS SO THAT IMMERSIBLE MOTORS CLEAR THE EXISTING DOORWAY.
4. PROVIDE CUSTOM BLOCKING DESIGNED BY TRANSFER CART MANUFACTURER IN COORDINATION WITH PUMP SUPPLIER. PROVIDE BLOCKING SUITABLE TO UPHOLD PROPOSED PUMPS AND IMMERSIBLE MOTORS.



GREELEY AND HANSEN

1715 N. WESTSHORE BLVD., STE. 464
TAMPA, FLORIDA 33607
CERTIFICATE OF AUTHORIZATION NO. 37

P.E. NAME: FREDDY J. BETANCOURT P.E. NO. 68072

P.E. NAME: _____
DATE: _____



**Engineering Design
Technologies Corp.**
P.O. Box 152403
Tampa, FL 33684-2403
813.289.8080
813.282.9184 FAX
engineering@edt1.com

CITY of TAMPA
WASTEWATER DEPARTMENT

KRAUSE PS REHABILITATION

UPPER LEVEL PLAN






RED LINES

1 7/30/14 MOD. CAPACITY TO 6.5 TONS
NO. DATE

DRAWN: J.WHITE
DESIGN: FJB
QC: DCH
DATE: 01/27/15

SHEET M-6

NO CHANGES

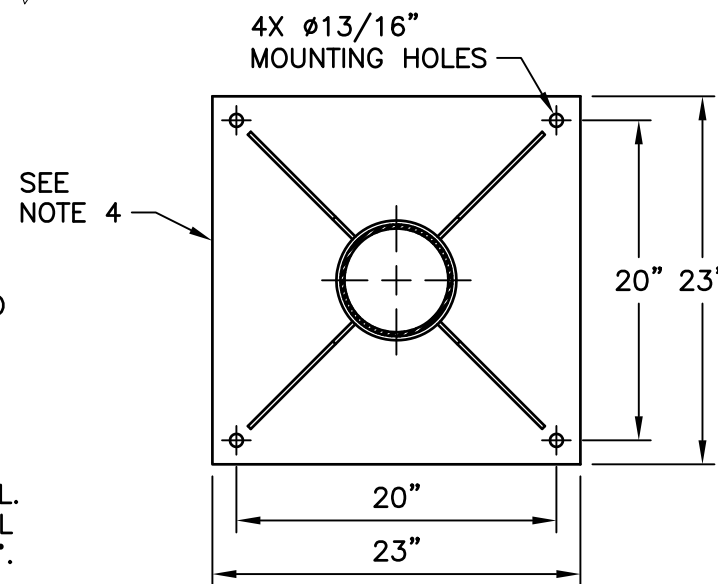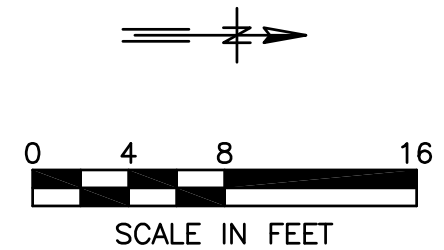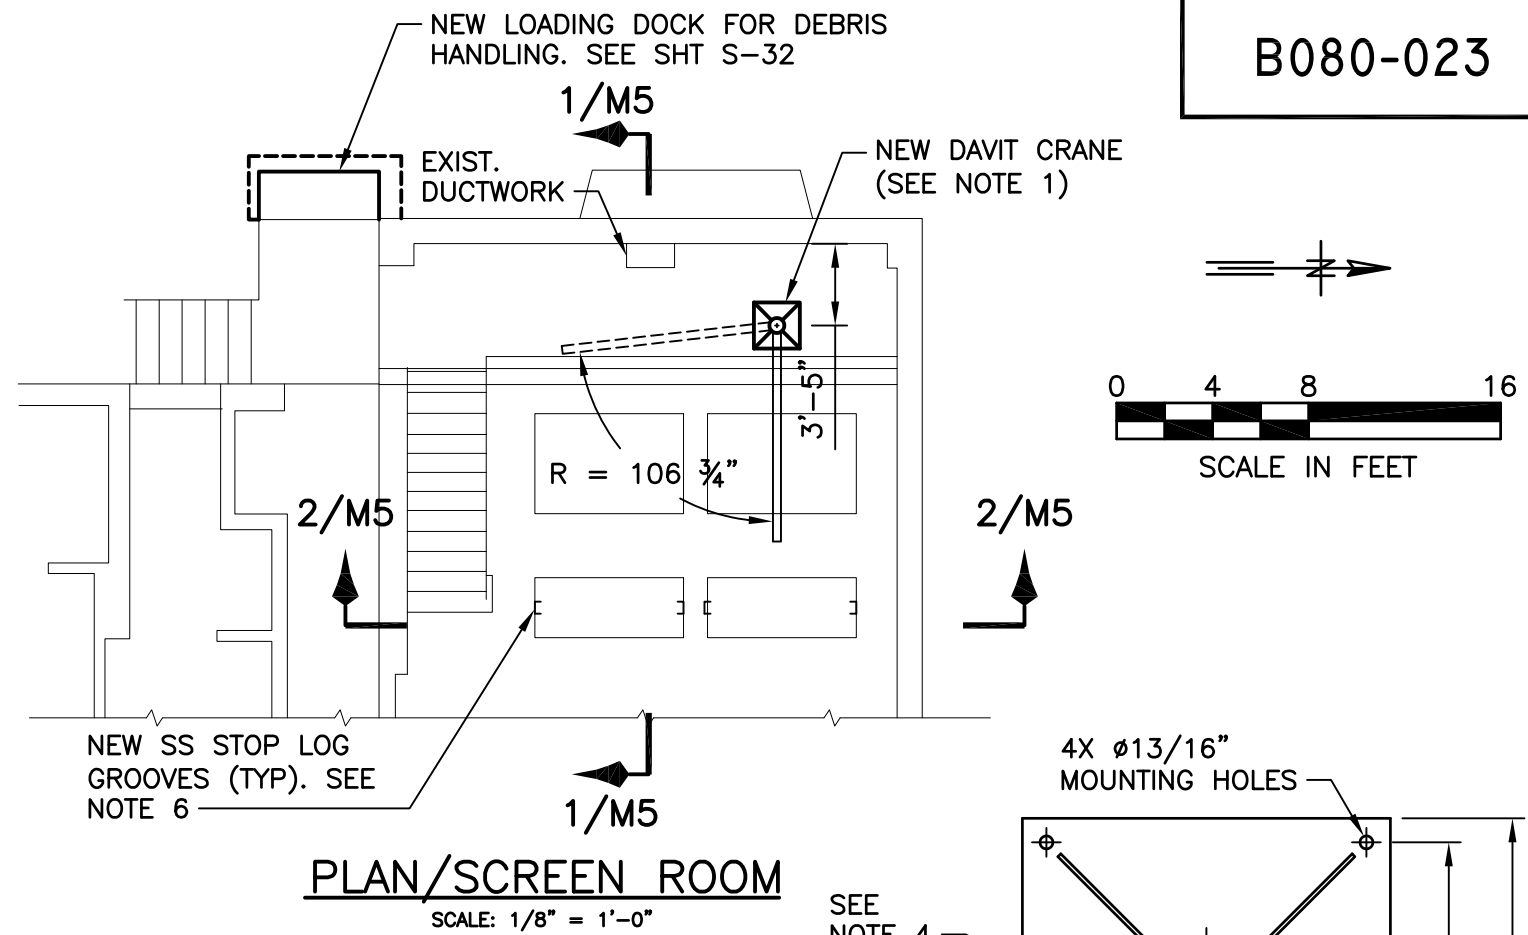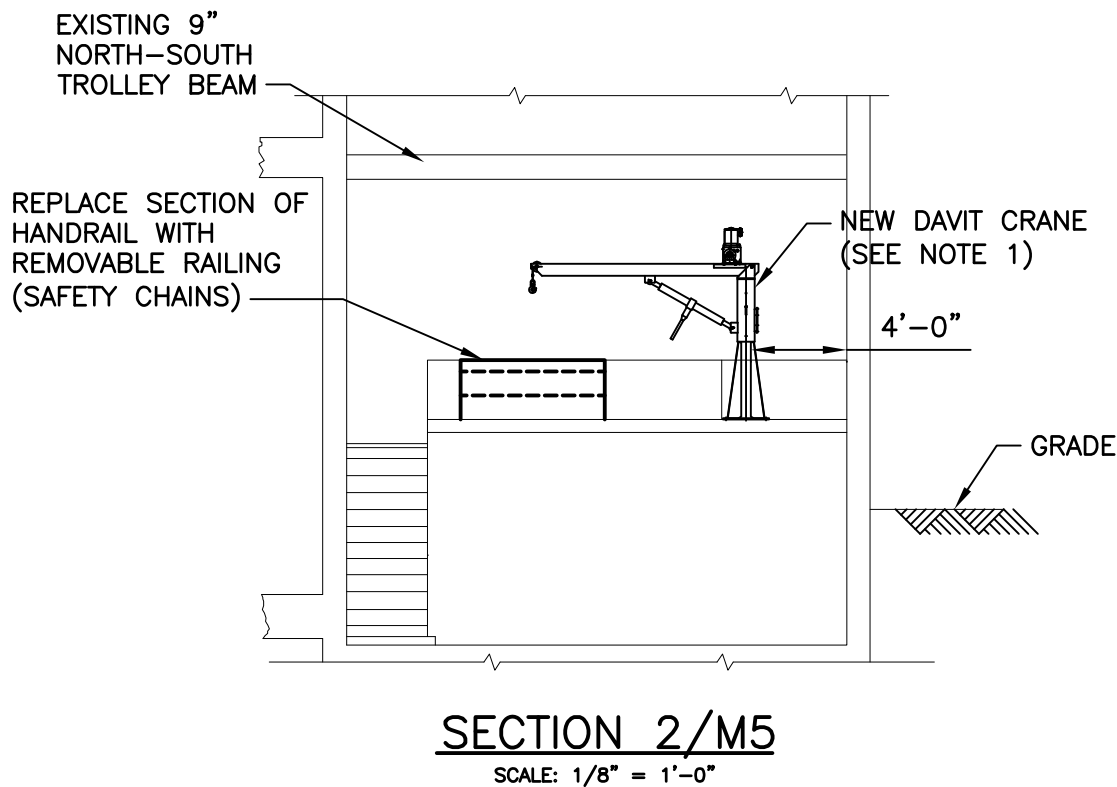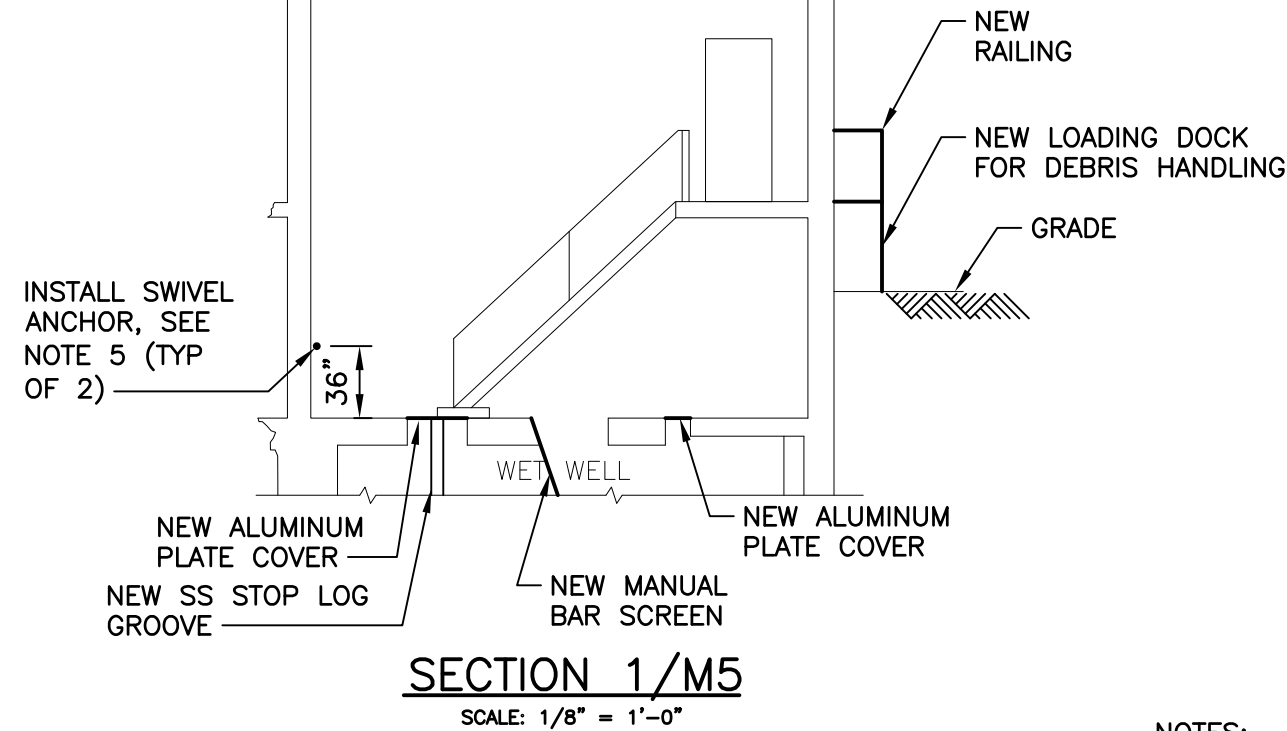


CRANE BASE PLATE DETAIL

NOT TO SCALE

NOTES:

1. INSTALL NEW THERN SERIES 572 DAVIT CRANE (MIN. 1,700 LB LOAD RATING) TO INCLUDE PNEUMATIC WINCH - 572E3PN, ADJUSTABLE SCREW JACK SJ2, PNEUMATIC CONTROLS - 477PN - CNTRL, PNEUMATIC WINCH HOSES - 477PN-HS6, AND A MINIMUM OF 36 FEET OF 5/16" DIA. 304 STAINLESS STEEL WIRE.
2. INSTALL TO 5K HYBRID MEGA SWIVEL ANCHORS OR APPROVED EQUAL. INSTALL ANCHORS IN CONCRETE WALL FOR FALL PROTECTION. SWIVEL ANCHORS SHALL BE CAPABLE OF ROTATING 360° AND FLIPPING 180°. LOCATION OF ANCHORS TO BE COORDINATED WITH CITY PERSONNEL.
3. SECURE SS STOP LOG GROOVES TO EXISTING CHANNEL WALLS WITH HILTI COUNTERSUNK STAINLESS STEEL SS316L KWIK BOLT 3 ANCHORS (C3/8X4) SPACED AT 4 INCHES ON CENTER. INSTALL ANCHORS PER MANUFACTURER'S RECOMMENDATIONS. PRE-DRILL WALL SURFACE MOUNTED STAINLESS STEEL STOP LOG CHANNEL TO ACCOMMODATE COUNTERSUNK ANCHOR HEAD. ANCHORS ARE DESIGNED FOR WATER DEPTH OF 20 FEET MAXIMUM.
4. ANCHOR USING 3/4" DIAMETER HILTI RODS (AISI GRADE 304/316 STAINLESS STEEL) OR APPROVED EQUAL. EMBED RODS 8-3/4" FROM TOP OF FINISHED SLAB. ADHERE RODS WITH HILTI HIT-RE 500 EPOXY. INSTALL RODS AND EPOXY PER MANUFACTURER. ASSUME SLAB TO BE 8-INCHES THICK WITH 2-INCHES CONCRETE TOPPING.


 **GREELEY AND HANSEN**

1715 N. WESTSHORE BLVD., STE. 464
TAMPA, FLORIDA 33607
CERTIFICATE OF AUTHORIZATION NO. 37

P.E. NAME: FREDDY J. BETANCOURT P.E. NO. 68072

P.E. NAME: _____

DATE: _____

 **Engineering Design Technologies Corp.**

P.O. Box 152403
Tampa, FL 33684-2403
813.289.8080
813.282.9184 FAX
engineering@edt1.com

Certificate of Authorization Number: 4795

CITY of TAMPA
WASTEWATER DEPARTMENT

KRAUSE PS REHABILITATION


SCREEN AREA
SECTIONS AND DETAILS FOR
DEBRIS REMOVAL EQUIPMENT

RED LINES

NO CHANGES

DRAWN: J.WHITE
DESIGN: FJB
QC: DCH
DATE: 01/27/15


SHEET M-7

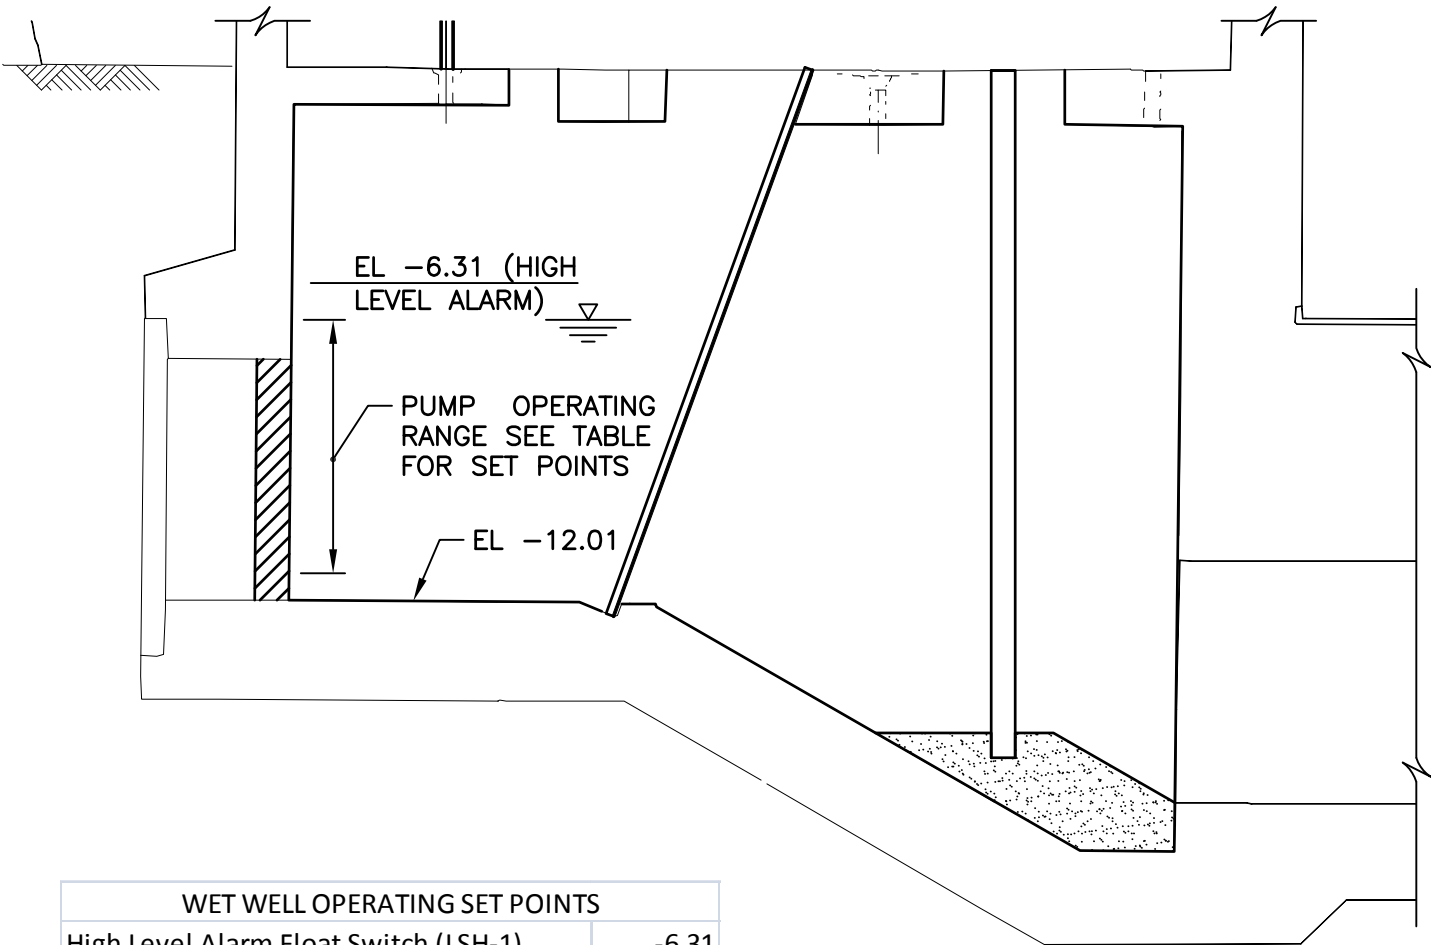

WET WELL OPERATING SET POINTS	
High Level Alarm Float Switch (LSH-1)	-6.31
Lag Pump No.2 Start - Set Point	-6.81
Lag Pump No.2 Off - Set Point	-7.31
Lag Pump No.1 Start - Set Point	-7.81
Lag Pump No.1 Off - Set Point	-8.31
Lead Pump Start - Set Point	-8.81
Lead Pump Off - Set Point	-9.81

WET WELL SECTION

SCALE: 1/4" = 1'-0"

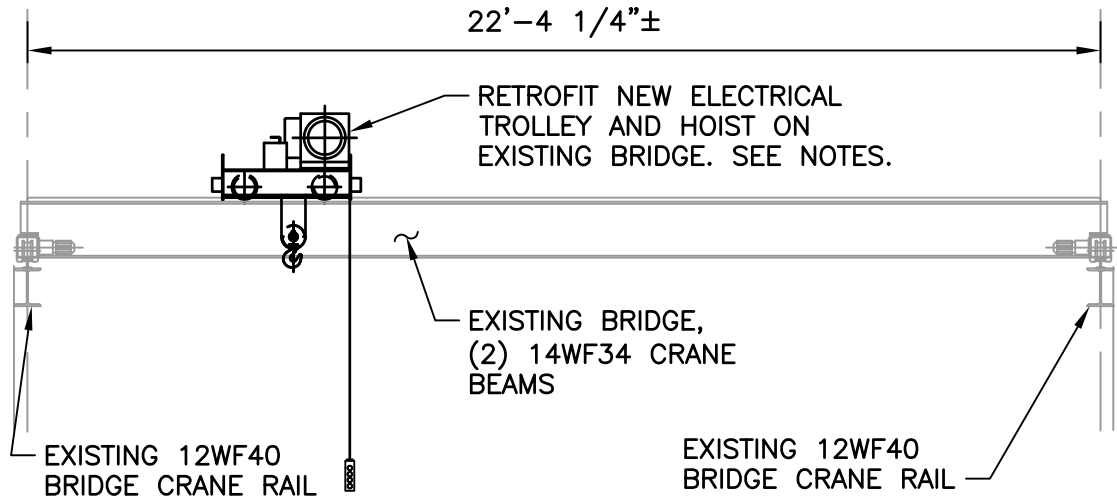

BRIDGE CRANE TROLLEY AND HOIST REPLACEMENT DETAIL

SCALE: 1/4" = 1'-0"

NOTES:

1. FIELD VERIFY DIMENSIONS PRIOR TO SUBMITTAL OF SHOP DRAWINGS.
2. REMOVE EXISTING 5-TON HOIST AND HAND GEARED TROLLEY FROM EXISTING BRIDGE.
3. PROVIDE CUSTOM FABRICATED 7-TON CAPACITY, DECK MOUNTED WITH SPECIAL TOP, ELECTRICAL INVERTER TROLLEY (50 FPM) WITH TWO (2) ½ HP MOTORS AND RETROFIT TO EXISTING BRIDGE.
4. PROVIDE A NEW 7.5-TON, 2-SPEED (15 FPM/3 FPM) ELECTRICAL HOIST (7 ½ HP MOTOR) THAT WILL BE DE-RATED TO 7-TONS. THE WIRE HOIST SHALL BE CAPABLE OF A 32 FOOT VERTICAL LIFT. ELECTRICAL TROLLEY AND ELECTRICAL HOIST SHALL BE PROVIDED AS A PACKAGE UNIT FROM A SINGLE SOURCE, SUCH AS ADVANCED OVERHEAD SYSTEMS (TEL: 863-667-3757), TO WARRANTY THE EQUIPMENT AS A SINGLE UNIT.
5. COORDINATE ELECTRICAL REQUIREMENTS FOR TROLLEY AND HOIST MOTORS. PROVIDE NEW CABLE REEL AND CABLE.
6. AFTER INSTALLATION, PERFORM OSHA FIELD LOAD TEST AT 14,000 LBS AND RE-RATE BRIDGE AND EQUIPMENT TO 7-TONS. INSTALL NEW CAPACITY NAMEPLATES FOR THE EQUIPMENT.



GREELEY AND HANSEN

1715 N. WESTSHORE BLVD., STE. 464
TAMPA, FLORIDA 33607
CERTIFICATE OF AUTHORIZATION NO. 37

P.E. NAME: FREDDY J. BETANCOURT P.E. NO. 68072

P.E. NAME: _____
DATE: _____



**Engineering Design
Technologies Corp.**
P.O. Box 152403
Tampa, FL 33684-2403
813.289.8080
813.282.9184 FAX
engineering@edt1.com

Certificate of Authorization Number: 4795

CITY of TAMPA
WASTEWATER DEPARTMENT

KRAUSE PS REHABILITATION

WET WELL LEVELS AND BRIDGE CRANE
TROLLEY AND HOIST REPLACEMENT

RED LINES

NO CHANGES

DRAWN: J.WHITE
DESIGN: FJB
QC: DCH
DATE: 01/27/15

SHEET M-8

GENERAL STRUCTURAL NOTES

B080-025

SCOPE OF WORK

- 1. WORK DETAILED ON THE DRAWINGS AND APPLICABLE ITEMS DESCRIBED IN THE GENERAL STRUCTURAL NOTES.
- 2. STRUCTURAL DESIGN AND CONSULTATION SERVICES FOR THE PUMP STATION REHABILITATION INCLUDE THE FOLLOWING:
 - A. IN-FILL OF THE EXISTING BASEMENT ELECTRICAL ROOM
 - B. COVERING OF STAIR OPENING TO THE EXISTING BASEMENT ELECTRICAL ROOM AND ADDRESS THE EXISTING CURBING AND SUBSEQUENT SLAB REPAIRS
 - C. PERFORMANCE SPECIFICATIONS AND SCHEMATIC DRAWINGS OF THE PLATFORM (STRUCTURAL STEEL, GRATING, GUARDRAILS AND STAIRS) FOR THE ELECTRICAL EQUIPMENT ON THE MAIN LEVEL THAT IS TO BE RAISED ABOVE THE 100-YEAR FLOOD ELEVATION (APPROXIMATELY 2'-6" ABOVE EXISTING FLOOR - CLEARANCE IS ADEQUATE FROM UNDERSIDE OF EXISTING ROOF STRUCTURE TO TOP OF NEW ELECTRICAL EQUIPMENT ON THE NEW PLATFORM
 - D. PROVIDE FOR NEW EXIT OPENING (INCLUDING DOOR AND FRAME SPECIFICATION) AND EXTERIOR STAIRS AT ELECTRICAL EQUIPMENT
 - E. STRUCTURAL RELATED DESIGN FOR SETTING NEW IMMERSIBLE PUMPS
 - F. STRUCTURAL RELATED DESIGN FOR EXTERIOR TRANSFORMER - DESIGN NEW PLATFORM FOR ACCESS AT PROPER LEVEL
 - G. THE EXISTING MANUAL SCREENS WILL BE ADDRESSED PER MECHANICAL DRAWINGS. CLEARANCE IS ADEQUATE FROM UNDERSIDE OF EXISTING ROOF STRUCTURE FOR BAR SCREENS TO BE ADDRESSED. NO MODIFICATION OF THE ROOF STRUCTURE IS PROPOSED AND/OR REQUIRED. 12" CMU PARTITION WALL TO BE REMOVED AND REPLACED AT NEW LOCATION.
 - H. THE EXISTING STEEL ROOF FRAMING IN THE SCREEN ROOM EXHIBITS CORROSION. THE STEEL IS TO BE CLEANED AND RECOATED PER S-7.
 - I. PROVIDE INSTALLATION DESIGN AND/OR PERFORMANCE SPECIFICATIONS FOR HOISTING EQUIPMENT AT SOUTH END OF PUMP ROOM TO TRANSPORT EQUIPMENT IN AND OUT OF THE BUILDING THROUGH THE EXISTING EXTERIOR WALL DOUBLE DOORS.

DRAWINGS AND SPECIFICATIONS

- 1. DO NOT SCALE DRAWINGS FOR DIMENSIONS NOT GIVEN.
- 2. ADVISE ENGINEER OF DIMENSIONAL DISCREPANCIES.
- 3. VERIFY ALL EXISTING FIELD CONDITIONS AND DIMENSIONS PRIOR TO COMMENCING CONSTRUCTION.
- 4. THE CONTRACTOR SHALL PERFORM NO PORTION OF THE WORK AT ANY TIME WITHOUT CONTRACT DOCUMENTS OR, WHERE REQUIRED, APPROVED SHOP DRAWINGS, PRODUCT DATA OR SAMPLES FOR SUCH PORTION OF THE WORK.

CONSTRUCTION SAFETY

- 1. THESE DRAWINGS DO NOT INCLUDE PROVISIONS TO SATISFY SAFETY REQUIREMENTS. CONTRACTOR IS SOLELY RESPONSIBLE FOR ENSURING SAFETY DURING CONSTRUCTION AND FOR CONFORMANCE TO ALL APPLICABLE OSHA STANDARDS AND OTHER APPLICABLE CODES. JOBSITE VISITS BY ENGINEER SHALL NOT CONSTITUTE APPROVAL, AWARENESS OR LIABILITY FOR ANY HAZARDOUS CONDITIONS.

SHORING AND SUPPORT

- 1. WHEN REMOVAL OF STRUCTURAL ELEMENTS FOR MODIFICATIONS MAY CAUSE TEMPORARY WEAKNESS, EXCESSIVE DEFLECTIONS OR STRUCTURAL INSTABILITY, SHORING OR OTHER SUITABLE SUPPORTS SHALL BE PROVIDED UNTIL COMPLETION AND ADEQUATE CURING OF MODIFICATIONS.
- 2. THE CONTRACTOR SHALL SUBMIT CUT SHEETS WITH CERTIFIED CAPACITIES FOR SHORING TO BE USED. SHORING PLANS SHALL BE PREPARED, SIGNED AND SEALED BY AN ENGINEER REGISTERED IN THE STATE OF FLORIDA.

VALUE ENGINEERING

- 1. ANY CHANGES TO THE STRUCTURE OR DESIGN SHALL HAVE BEEN REVIEWED AND APPROVED IN WRITING BY THE ENGINEER PRIOR TO COMMENCING WORK ON ITEMS AFFECTED.

FIELD MODIFICATIONS

- 1. ANY CHANGES TO THE STRUCTURE SHALL HAVE BEEN REVIEWED AND APPROVED IN WRITING BY THE ENGINEER PRIOR TO COMMENCING WORK ON ITEMS AFFECTED.
- 2. ANY CHANGES MADE WITHOUT PRIOR APPROVAL ARE SUBJECT TO REVIEW BY THE ENGINEER. CONTRACTOR SHALL PROVIDE SKETCHES, PHOTOGRAPHS AND WRITTEN DESCRIPTION OF EACH DEVIATION FROM THE PLANS FOR THE ENGINEER'S REVIEW.

BUILDING CODES AND SPECIFICATIONS

- 1. FLORIDA BUILDING CODE 2010 WITH LATEST UPDATES.
- 2. MINIMUM DESIGN LOADS FOR BUILDINGS AND OTHER STRUCTURES ASCE 7-10.
- 3. BUILDING CODE REQUIREMENTS FOR MASONRY STRUCTURES ACI 530-08 / ASCE 5-08 / TMS 402-08.
- 4. BUILDING CODE REQUIREMENTS FOR STRUCTURAL CONCRETE ACI 318-08.
- 5. AISC MANUAL OF STEEL CONSTRUCTION, 13TH EDITION.
- 6. STRUCTURAL WELDING CODE D1-1.

DESIGN LOADS

- 1. DEAD LOADS
 - A. TABLE C3-1: MINIMUM DESIGN LOADS, ASCE 7-10
- 2. LIVE LOADS
 - A. ROOF20 PSF
 - B. WALKWAYS AND ELEVATED PLATFORMS.....60 PSF
 - C. STAIRS AND EXIT WAYS.....100 PSF
 - D. EQUIPMENT.....AFD'S = 5000 LBS EACH
 - E. TRANSFER CART AND MOTOR.....6 TONS (12 KIPS)
- 3. WIND LOAD
 - A. DESIGN WIND SPEED150 MPH (3 SECOND GUST)
 - B. EXPOSURE CATEGORYC
 - F. ASCE 7 BUILDING RISK CATEGORYIV
 - G. ENCLOSED BUILDING
- 4. COMPONENT AND CLADDING
 - A. SPECIALTY ENGINEER DESIGNING THE COMPONENTS AND CLADDING SHOULD DETERMINE THE TRIBUTARY AREA FOR SUCH COMPONENTS AND CLADDING AND USE THE TABLE FOR THE AREA EQUAL TO OR SMALLER THAN THE ACTUARIAL TRIBUTARY AREA.
 - B. COMPONENT AND CLADDING SUB-CONTRACTOR SHALL PROVIDE SIGNED AND SEALED DRAWINGS AND CALCULATIONS BY A PROFESSIONAL ENGINEER REGISTERED IN THE STATE OF FLORIDA INCLUDING THE DESIGN OF THE COMPONENTS AND CLADDING, CONNECTIONS TO THE MAIN STRUCTURE.



ENGINEERING GROUP INC.
3434 colwell avenue suite 100, tampa, florida 33614
telephone : 813.908.7203 fax : 813.931.5200
email : info@billerreinhardt.com
State of Florida Certificate of Authorization No. 9149

TO THE BEST OF THE ENGINEER'S KNOWLEDGE
THE PLANS AND SPECIFICATIONS COMPLY WITH
THE APPLICABLE MINIMUM BUILDING CODES

ROBERT J. REINHART
FL. P.E. NO. 50076



Engineering Design
Technologies Corp.
P.O. Box 152403
Tampa, FL 33684-2403
813.289.8080
813.282.9184 FAX
engineering@edt1.com

Certificate of Authorization Number: 4795

CITY of TAMPA
WASTEWATER DEPARTMENT

KRAUSE PS REHABILITATION

GENERAL STRUCTURAL
NOTES

RED LINES

NO CHANGES

1	1/27/14
NO.	DATE

DRAWN: RC, KC
DESIGN: RR
IC: RR
DATE: 06/03/14

SHEET S-1

GENERAL STRUCTURAL NOTES (CONT.)

B080-026

5. ROOF COMPONENTS AND CLADDING, PITCHED ROOF AREA (>10 TO 45 DEGREES)

PRESSURE							
EFFECTIVE WIND AREA (SQ. FT.)	EXTERNAL PRESSURE COEFFICIENT GCp			INTERNAL PRESSURE COEFFICIENT GCpi	P (psf)		
	ZONE 1	ZONE 2	ZONE 3		ZONE 1	ZONE 2	ZONE 3
	FIELD	EDGE	CORNER		FIELD	EDGE	CORNER
< 10	0.50	0.50	0.50	± 0.18	32.63	32.63	32.63
20	0.42	0.42	0.42	± 0.18	28.79	28.79	28.79
50	0.38	0.38	0.38	± 0.18	26.87	26.87	26.87
100 <	0.30	0.30	0.30	± 0.18	23.03	23.03	23.03
SUCTION							
EFFECTIVE WIND AREA (SQ. FT.)	EXTERNAL PRESSURE COEFFICIENT GCp			INTERNAL PRESSURE COEFFICIENT GCpi	P (psf)		
	ZONE 1	ZONE 2	ZONE 3		ZONE 1	ZONE 2	ZONE 3
	FIELD	EDGE	CORNER		FIELD	EDGE	CORNER
< 10	-0.90	-1.70	-2.60	± 0.18	-51.82	-90.20	-133.39
20	-0.86	-1.56	-2.40	± 0.18	-49.90	-83.49	-123.79
50	-0.82	-1.38	-2.20	± 0.18	-47.98	-74.85	-114.19
100 <	-0.80	-1.20	-2.00	± 0.18	-47.02	-66.21	-104.60
OVERHANG							
EFFECTIVE WIND AREA (SQ. FT.)	EXTERNAL PRESSURE COEFFICIENT GCp			INTERNAL PRESSURE COEFFICIENT GCpi	P (psf)		
	ZONE 1	ZONE 2	ZONE 3		ZONE 1	ZONE 2	ZONE 3
	FIELD	EDGE	CORNER		FIELD	EDGE	CORNER
< 10	-	-2.20	-3.70	± 0.18	-	-114.19	-186.17
20	-	-2.20	-3.38	± 0.18	-	-114.19	-170.81
50	-	-2.20	-2.82	± 0.18	-	-114.19	-143.94
100 <	-	-2.20	-2.50	± 0.18	-	-114.19	-128.59
ROOF CORNER ZONE WIDTH = 3'-0"		ROOF CORNER ZONE LENGTH = 3'-0"		ROOF EDGE ZONE WIDTH = 3'-0"			

*NOTE: WIND LOAD CALCULATIONS ARE BASED ON LRFD VALUES OF ASCE 7-10

6. WALL COMPONENTS AND CLADDING

PRESSURE							
EFFECTIVE WIND AREA (SQ. FT.)	EXTERNAL PRESSURE COEFFICIENT GCp			INTERNAL PRESSURE COEFFICIENT GCpi	P (psf)		
	ZONE 4	ZONE 5			ZONE 4	ZONE 5	
	FIELD	EDGE			FIELD	EDGE	
< 10	1.0	1.0		± 0.18	56.62	56.62	
20	0.95	0.95		± 0.18	54.22	54.22	
50	0.87	0.87		± 0.18	50.38	50.38	
100	0.80	0.80		± 0.18	47.02	47.02	
SUCTION							
EFFECTIVE WIND AREA (SQ. FT.)	EXTERNAL PRESSURE COEFFICIENT GCp			INTERNAL PRESSURE COEFFICIENT GCpi	P (psf)		
	ZONE 4	ZONE 5			ZONE 4	ZONE 5	
	FIELD	EDGE			FIELD	EDGE	
< 10	-1.10	-1.40		± 0.18	-61.42	-75.81	
20	-1.05	-1.30		± 0.18	-59.02	-71.01	
50	-0.99	-1.18		± 0.18	-56.14	-65.25	
100	-0.96	-1.03		± 0.18	-54.70	-58.06	
WALL EDGE ZONE WIDTH = 3'-0"							

*NOTE: WIND LOAD CALCULATIONS ARE BASED ON LRFD VALUES OF ASCE 7-10

SHALLOW SPREAD FOUNDATIONS

- FOUNDATION DESIGN BASED ON 2000 PSF MINIMUM ALLOWABLE BEARING PRESSURE, TO BE VERIFIED BY CONTRACTOR.
- NOTIFY ENGINEER IF FOOTING EXCAVATION REVEALS UNSUITABLE OR UNSTABLE SOILS OR MATERIALS OR CONDITIONS NOT PREVIOUSLY ANTICIPATED.
- CONTRACTOR SHALL CONSIDER THE POSSIBLE IMPACT OF GROUNDWATER ON CONSTRUCTION TECHNIQUES, SEASONAL VARIATIONS, ANY OTHER SITE INDICATORS AND HIS OWN JUDGMENT.
- SOIL DIRECTLY BELOW FOUNDATIONS AND SLAB ON GRADE SHALL BE COMPACTED TO 95% OF THE ASTM D 1557 (MODIFIED PROCTOR) MAXIMUM DRY DENSITY.

PORTLAND CEMENT CONCRETE - SPECIFICATION 033000


- CONCRETE PROPERTIES
 - FOUNDATIONS: 4000 PSI, 3" TO 5" SLUMP
 - FILLED CELLS IN CMU: 3000 PSI, 8" TO 11" SLUMP, 3/8" PEA GRAVEL
 - SLABS ON GRADE: 4000 PSI, 3" TO 5" SLUMP
 - PUMP PEDESTALS AND PIPE SUPPORTS: 4000 PSI, 3" TO 5" SLUMP
 - EXTERIOR TRANSFORMER PLATFORM AND STAIRS: 4000 PSI, 3" TO 5" SLUMP
- FLY ASH SHALL NOT EXCEED 20 PERCENT BY WEIGHT OF TOTAL CEMENT, IF USED.
- CONTRACTOR SHALL STRICTLY ADHERE TO SLUMP LIMITS. SUPERPLASTICIZER MAY BE USED AT THE CONTRACTORS OPTION TO INCREASE WORKABILITY.
- MAXIMUM MIXING TIME (FROM BATCHING TO PLACEMENT)
 - AIR TEMPERATURE LESS THAN 85° F: 90 MINUTES
 - AIR TEMPERATURE 85° F TO 90° F: 75 MINUTES
 - AIR TEMPERATURE OVER 90° F: 60 MINUTES
- MINIMUM COVER FOR REINFORCEMENT
 - FOOTINGS, 3 INCHES TO BOTTOM AND UNFORMED SIDES, 2 INCHES TO FORMED SIDES.
 - OTHER, 2 INCHES TO MAIN REINFORCING, 1 ½" INCHES TO TIES AND STIRRUPS.
 - AS SPECIFICALLY NOTED.
- ALL REINFORCEMENT SHALL BE SECURELY HELD IN PLACE BY STANDARD ACCESSORIES DURING CONCRETE PLACEMENT.
- REINFORCEMENT SHALL BE GRADE 60 CONFORMING TO ASTM A615.
- WELDED WIRE FABRIC SHALL CONFORM TO ASTM A185.
- DETAIL AND FABRICATE REINFORCEMENT IN ACCORDANCE WITH "MANUAL OF STANDARD PRACTICE FOR DETAILING REINFORCED CONCRETE STRUCTURES," ACI 315.
- PROVIDE MINIMUM LAP SPLICES PER ACI 318-08 FOR ALL REINFORCING BARS, UNLESS OTHERWISE NOTED. STAGGER SPLICES IN ADJACENT BARS AT LEAST 24 INCHES, EXCEPT IN BEAMS AND COLUMNS.
- IN WALL FOOTINGS, GRADE BEAMS AND BOND BEAMS, PROVIDE BENT BARS AT CORNERS AND INTERSECTIONS OF THE SAME NUMBER AND SIZE AS STRAIGHT BARS.
- APPLY CURING COMPOUND TO SLAB WITHIN TWO HOURS OF COMPLETION OF FINISHING OPERATIONS. USE LIQUID MEMBRANE FORMING COMPOUND COMPLYING WITH ASTM C309 TYPE 1 CLASS A. APPLY IN ACCORDANCE WITH MANUFACTURER'S SPECIFICATIONS.
- CHAMFER: 1-INCH TYPICAL ON ALL EXPOSED CORNERS AND EDGES UNLESS NOTED OTHERWISE.
- NON-SLIP BROOM FINISH ON ALL EXTERIOR CONCRETE PLATFORMS AND STEPS.



3434 colwell avenue suite 100, tampa, florida 33614
telephone : 813.908.7203 fax : 813.931.5200
email : info@billerreinhardt.com
State of Florida Certificate of Authorization No. 9149

TO THE BEST OF THE ENGINEER'S KNOWLEDGE,
THE PLANS AND SPECIFICATIONS COMPLY WITH
THE APPLICABLE MINIMUM BUILDING CODES.

ROBERT J. REINHART
FL. P.E. NO. 50076



Engineering Design Technologies Corp.
P.O. Box 152403
Tampa, FL 33684-2403
813.289.8080
813.282.9184 FAX
engineering@edt1.com

Certificate of Authorization Number: 4795

CITY of TAMPA
WASTEWATER DEPARTMENT

KRAUSE PS REHABILITATION

GENERAL STRUCTURAL
NOTES

RED LINES

NO CHANGES

DRAWN: RC, KC
DESIGN: RR
QC: RR
DATE: 06/03/14

SHEET S-2

1	1/27
NO.	DA

GENERAL STRUCTURAL NOTES (CONT.)

CONCRETE MASONRY UNITS - GENERAL INFORMATION

- BLOCKS SHALL BE HOLLOW LOAD-BEARING CONCRETE MASONRY UNITS SHALL CONFORM TO ASTM C 90 LATEST EDITION, TYPE II NON-MOISTURE CONTROLLED. THE MINIMUM NET AREA COMPRESSIVE STRENGTH SHALL BE 1500 PSI FOR AN AVERAGE OF THREE UNITS AND 1900 PSI FOR AN INDIVIDUAL UNIT. SAMPLE AND TEST MASONRY UNITS IN ACCORDANCE WITH ASTM C 140. SAMPLE AND TEST MASONRY GROUT FILL IN ACCORDANCE WITH ASTM C 39.
- MORTAR SHALL CONFORM TO ASTM C 270 LATEST EDITION. MORTAR FOR ABOVE GRADE WORK SHALL BE TYPE S WITH A MINIMUM 28-DAY COMPRESSIVE STRENGTH OF 1800 PSI. MORTAR FOR BELOW GRADE WORK SHALL BE TYPE M MORTAR WITH A MINIMUM 28-DAY COMPRESSIVE STRENGTH OF 2500 PSI. SAMPLE AND TEST MORTAR IN ACCORDANCE WITH ASTM C 109.
- PREFABRICATED HORIZONTAL JOINT REINFORCEMENT SHALL HAVE 9 GAGE SIDE RAILS FABRICATED FROM HIGH-STRENGTH COLD-DRAWN WIRE CONFORMING TO ASTM A 82 AND SHALL BE GALVANIZED AFTER FABRICATION. PLACE JOINT REINFORCEMENT IN ALTERNATE COURSES IN ALL WALLS. PLACE THREE ROWS AT 8 INCHES ON CENTER IMMEDIATELY ABOVE ALL WALL OPENINGS AND AT THE TOP OF ALL WALLS. LAP SIDE RAILS AT LEAST 6 INCHES AT SPLICES. JOINT REINFORCEMENT TO BE TRUSS-TYPE.
- PROVIDE ALL SPECIAL, LINTEL, KNOCK-OUT, JAMB AND SASH BLOCK AS REQUIRED TO COMPLETE THE WALLS. MASONRY SAWS SHALL BE USED TO CUT THE BLOCK AS REQUIRED.
- BRACE FOUNDATION WALLS BEFORE BACKFILLING AGAINST THEM TO PREVENT OVERSTRESSING, BUCKLING OR ROTATION OF THE WALLS. BRACE ALL WALLS AGAINST WIND, CONSTRUCTION LOADS OR OTHER TEMPORARY FORCES UNTIL SUCH PROTECTION IS NO LONGER REQUIRED FOR THE SAFE SUPPORT OF THE WALL. BRACING SHALL BE THE RESPONSIBILITY OF THE CONTRACTOR.
- IN ADDITION TO REQUIREMENTS ELSEWHERE IN THE DRAWINGS FOR FILLING MASONRY CELLS, FILL CELLS WITH CONCRETE AND ONE #5 BAR AT A MAXIMUM SPACING OF 48 INCHES UNLESS OTHERWISE NOTED. FILL FIRST CELL EACH SIDE OF ANY OPENING AND FILL FIRST CELL AT END OF WALL.
- EXTEND AND HOOK VERTICAL BARS INTO FOOTING. EXTEND AND HOOK VERTICAL BARS INTO TOP OF WALL BOND BEAM OR TIE BEAM.
- ALL VERTICAL BARS SHALL BE SECURELY TIED TO THE LOWER BAR AT ANY SPLICES, ESPECIALLY AT THE FOOTING DOWELS. BARS SHALL BE SECURED IN THEIR PROPER POSITIONS WITHIN THE CELLS BY TIE WIRES, REBAR POSITIONERS OR BY OTHER APPROVED METHODS.
- PROVIDE CLEANOUTS AND/OR INSPECTION PORTS FOR FILLING CELLS IN LIFTS EXCEEDING 5 FEET. LIFTS SHALL NOT EXCEED 8 FEET.
- CONTROL JOINT SPACING ALONG A STRAIGHT WALL SHALL NOT EXCEED 25 FEET, NOR 3 TIMES THE WALL HEIGHT. USE PREFORMED NEOPRENE JOINT STRIPS AND STANDARD SASH BLOCKS.
- PROVIDE CONTROL JOINTS IN ACCORDANCE WITH DETAILS ON THE DRAWINGS AND IN ACCORDANCE WITH THESE GUIDELINES:
 - AT CHANGES IN WALL HEIGHT
 - AT CHANGES IN WALL THICKNESS
 - AT WALL OPENINGS LESS THAN 6'-0" WIDE, ONE SIDE
 - AT WALL OPENINGS 6'-0" OR WIDER, BOTH SIDES
 - AT CONTROL JOINTS IN APPLIED PLASTER OR MASONRY VENEER
 - AT CHASES AND RECESSES FOR PIPES, COLUMNS, ETC.
- IN ADDITION TO REQUIREMENTS ELSEWHERE IN THE DRAWING, PROVIDE A CONTINUOUS HORIZONTAL #5 IN FULLY GROUTED KNOCK OUT BLOCK BELOW WINDOW OPENINGS EXTENDED 8" BEYOND EACH SIDE OF OPENING.

CONCRETE SLAB ON GRADE - SPECIFICATION 033000

B080-027

- THE INTENDED USE OF THE SLAB ON GRADE IS FOR PEDESTRIAN TRAFFIC ONLY.
- MINIMUM COMPRESSIVE STRENGTH AT 28 DAYS: 4000 PSI
- MINIMUM THICKNESS: 5 INCHES
- MAXIMUM SLUMP AT POINT OF DELIVERY: 5 INCHES
- MAXIMUM AGGREGATE SIZE: 1 INCH
- ENTRAINED AIR CONTENT: 4.5%
- WELDED WIRE FABRIC SHALL BE WWF 6X6-W1.4XW1.4, UNLESS OTHERWISE NOTED, CONFORMING TO ASTM A 185.
- THE WELDED WIRE FABRIC SHALL BE PLACED IN THE CENTER OF THE DEPTH OF SLAB ON GRADE UNLESS OTHERWISE NOTED. ALL MESH JOINTS SHALL BE LAPPED TWO FULL MESHES.
- INTERRUPT TYPICAL SLAB REINFORCEMENT AT ALL CONSTRUCTION AND EXPANSION JOINTS.
- CUT ALTERNATE WIRES ALONG THE LINE OF SAW CUT CONTROL JOINTS PRIOR TO PLACING CONCRETE. MAKE SAW CUTS WITHIN 12 HOURS OF CONCRETE PLACEMENT, OR AS SOON AS CUTTING CAN BE DONE SUCH THAT THE SAW BLADE DOES NOT DISLODGE AGGREGATE AND THE EDGES OF THE CUT DO NOT RAVEL.
- PROVIDE 1/2" PREFORMED EXPANSION JOINT MATERIAL WHERE SLAB ABUTS VERTICAL SURFACES SUCH AS WALLS AND COLUMNS.
- PROVIDE TERMITE PROTECTION TO SOIL PER FLORIDA BUILDING CODE 2010 BEFORE SLAB PLACEMENT.
- PROVIDE VAPOR RETARDER UNDER ALL SLABS ON GRADE IN ENCLOSED SPACE.
- APPLY CURING COMPOUND TO SLAB WITHIN TWO HOURS OF COMPLETION OF FINISHING OPERATIONS. USE LIQUID MEMBRANE FORMING COMPOUND COMPLYING WITH ASTM C 309 TYPE 1 CLASS A. THE COMPOUND SHALL BE APPLIED IN ACCORDANCE WITH THE MANUFACTURER'S INSTRUCTIONS.
- THE CONTRACTOR SHALL CONFIRM THAT THE CURING COMPOUND WILL NOT INTERFERE WITH THE BONDING OF ANY APPLIED FLOOR SURFACE. IF THE CURING COMPOUND IS FOUND TO INTERFERE WITH BONDING, THE USE OF WET BURLAP AND TRICKLE HOSES IS ACCEPTABLE.
- FOR LARGE SLABS, IT IS RECOMMENDED THAT THE SLAB BE CAST IN ALTERNATING LONG STRIPS AND SAW CUT TRANSVERSELY TO MINIMIZE SHRINKAGE CRACKING.

WELDED STEEL GRATING

- GRATING SHALL BE HOT DIPPED GALVANIZED WELDED STEEL GRATING WITH 1" x 3/16" SERRATED BEARING BARS AT 1'- 3/16" CENTERS AND CROSS BARS AT 4" CENTERS (GW 19W4).
- GRATING SHALL BE WELDED TO THE SUPPORT FRAMING EXCEPT THAT REMOVABLE GRATING SHALL BE FASTENED TO SUPPORT FRAMING WITH "GRATE-FAST" GRATING FASTENERS AS MANUFACTURED BY STRUCT-FAST INC., OR APPROVED EQUAL.
- THE LOCATION'S OF GRATING CUT-OUTS LARGER THAN 6" DIAMETER ARE INDICATED ON DESIGN DRAWINGS. GRATING CUT-OUTS LESS THAN 6" DIAMETER MAY BE CUT IN THE FIELD.
- HOLES THROUGH GRATING 6" IN DIAMETER AND LARGER SHALL BE BANDED, UNLESS TOE PLATE IS CALLED FOR ON THE DESIGN DRAWINGS.
- GRATING SHALL BE SHOP-CUT AND BANDED AT ALL COLUMNS, BRACING, POSTS, GUSSET PLATES AND OTHER LOCATIONS INDICATED ON THE DESIGN DRAWINGS.

STEEL STAIRS

- STAIR TREADS SHALL BE HOT DIPPED GALVANIZED WELDED STEEL GRATING WITH 1" x 3/16" SERRATED BEARING BARS AT 1'- 3/16" CENTERS AND CROSS BARS AT 4" CENTERS. STAIR TREADS SHALL BE HOT DIPPED GALVANIZED WITH STEEL END PLATES AND CHECKERED PLATE NOSING.
- STAIR TREADS SHALL BE SHOP ASSEMBLED TO STRINGERS.
- ALL RISERS MUST BE EQUAL ON A SET OF STAIRS.
- STAIR STRINGERS SHALL BE C10 X 15.3, GALVANIZED AS PER ASTM A123.

3434 colwell avenue suite 100, tampa, florida 33614
telephone : 813.908.7203 fax : 813.931.5200
email : info@billerreinhardt.com
State of Florida Certificate of Authorization No. 9149

TO THE BEST OF THE ENGINEER'S KNOWLEDGE
THE PLANS AND SPECIFICATIONS COMPLY WITH
THE APPLICABLE MINIMUM BUILDING CODES

ROBERT J. REINHART
FL. P.E. NO. 50076

Engineering Design Technologies Corp.
P.O. Box 152403
Tampa, FL 33684-2403
813.289.8080
813.282.9184 FAX
engineering@edt1.com

Certificate of Authorization Number: 4795

CITY of TAMPA
WASTEWATER DEPARTMENT

KRAUSE PS REHABILITATION

GENERAL STRUCTURAL
NOTES

RED LINES

NO CHANGES

DRAWN: RC, KC
DESIGN: RR
QC: RR
DATE: 06/03/14

SHEET S-3

GENERAL STRUCTURAL NOTES (CONT.)

B080-028

STRUCTURAL STEEL - SPECIFICATION 051000

- 1. ALL W-SHAPED STEEL (BEAMS AND COLUMNS) SHALL CONFORM TO ASTM A992 GRADE 50.
- 2. STEEL CHANNELS, ANGLES, PLATES, AND BARS CONFORM TO ASTM A36.
- 3. RECTANGULAR HOLLOW STRUCTURAL SECTIONS (HSS) SHALL CONFORM TO ASTM A500 GRADE B, Fy = 46 KSI.
- 4. ROUND HOLLOW STRUCTURAL SECTIONS (HSS) SHALL CONFORM TO ASTM A500 GRADE B, Fy = 42 KSI.
- 5. STRUCTURAL STEEL PIPE SECTIONS SHALL CONFORM TO ASTM A53 GRADE B, Fy = 35 KSI.
- 6. ANCHOR BOLTS AND RODS SHALL CONFORM TO ASTM F1554 GRADE 36.
- 7. ALL BEAMS SHALL BE FABRICATED AND ERECTED WITH NATURAL CAMBER UP.
- 8. ALL WELDS SHALL BE MADE WITH E70 LOW HYDROGEN ELECTRODES, BY QUALIFIED WELDERS AS PER AWS D1.1 REQUIREMENTS.
- 9. ALL BOLTS, EXCEPT ANCHOR BOLTS, SHALL BE HIGH-STRENGTH ASTM A325, 3/4 IN. DIA., UNLESS NOTED OTHERWISE. USE HARDENED WASHERS UNDER TURNED ELEMENTS.
- 10. CONTRACTOR SHALL PROVIDE ADEQUATE TEMPORARY BRACING, SHORING AND GUYING OF THE FRAMING AGAINST WIND, CONSTRUCTION LOADS OR OTHER TEMPORARY FORCES UNTIL SUCH PROTECTION IS NO LONGER REQUIRED FOR THE SAFE SUPPORT OF THE STRUCTURE.
- 11. RETURN ALL WELDS AT CORNERS TWICE THE NOMINAL WELD SIZE MINIMUM.
- 12. ANCHOR BOLTS SHALL BE FURNISHED WITH HEAVY HEX NUTS AND FLAT WASHERS AND SHALL BE THREADED WITH A NUT AT THE EMBEDDED END. TAC WELD NUT TO BOLT OR STRIKE THREADS.
- 13. ALL COPES, BLOCKS, CUTOUTS AND OTHER CUTTING OF STRUCTURAL MEMBERS SHALL HAVE ALL REENTRANT CORNERS SHAPED NOTCH-FREE TO A RADIUS OF 1/2 IN. MINIMUM.
- 14. ENDS OF COLUMNS SHALL BE MILLED TO BEAR AT ALL SPLICES AND ATTACHMENT OF BASE PLATES.
- 15. WELDS NOT OTHERWISE DESIGNATED SHALL BE 1/4 IN. MINIMUM FILLET WELDS.
- 16. ADHESIVE ANCHORS SHALL BE THE HILTI HIT RE 500 ADHESIVE ANCHOR SYSTEM (OR APPROVED EQUAL) INSTALLED AS PER MANUFACTURER'S RECOMMENDATIONS.
- 17. EXPANSION ANCHORS SHALL BE HILTI KWIK BOLT III (OR APPROVED EQUAL) INSTALLED AS PER THE MANUFACTURERS RECOMMENDATIONS.
- 18. ALL STRUCTURAL STEEL SHALL BE GALVANIZED AS PER ASTM A123.
- 19. WHEN SPECIFICALLY NOT DETAILED ON THE DESIGN DRAWINGS PROVIDE THE GREATER OF ONE OF THE FOLLOWING BEAM END CONNECTIONS:
 - A. MINIMUM 5/16 INCHES THICK DOUBLE ANGLE SHEAR CONNECTION, FULL DEPTH OF THE BEAM, WELDED OR BOLTED WITH VERTICAL BOLT SPACING = 3".
 - B. WHERE BEAM REACTIONS ARE SHOWN, CONNECTIONS SHALL DEVELOP THE REACTION GIVEN.
 - C. WHEN BEAM REACTIONS ARE NOT SHOWN, CONNECTIONS SHALL BE PROPORTIONED TO SUPPORT 60% OF THE TOTAL UNIFORM LOAD CAPACITY (ULC) SHOWN IN THE ALLOWABLE UNIFORM LOAD TABLES, PART 3 OF THE AISC STEEL CONSTRUCTION MANUAL, FOR THE GIVEN BEAM, SPAN, AND GRADE OF STEEL SPECIFIED. FOR COMPOSITE BEAMS, PROPORTION CONNECTIONS FOR 100 % OF THE ULC.
 - D. CONNECTIONS SHALL BE PROPORTIONED FOR THE ECCENTRICITY BETWEEN THE CONNECTION CENTROID AND THE CENTROID OF THE SUPPORTING MEMBER.
- 20. SHOP DRAWINGS TO BE SUBMITTED PER PROJECT SPECIFICATION SECTION 051000 STRUCTURAL STEEL.

GUARD RAIL AND HANDRAIL DESIGN NOTES

- 1. THE CONTRACTOR SHALL SUBMIT MANUFACTURER'S PRODUCT TECHNICAL DATA, SPECIFICATION, AND LABORATORY TEST RESULTS THAT VALIDATE PRODUCT COMPLIANCE WITH THE REQUIREMENTS FOR THE PROJECT. SHOW COMPLETE LAYOUT; PLAN VIEWS, ELEVATIONS CONNECTIONS, DETAILS FOR FABRICATION AND ATTACHMENT TO OTHER ELEMENTS, AND OTHER INSTALLATION DETAILS.
- 2. INCLUDE CALCULATIONS AND MEASUREMENTS SIGNED AND SEALED BY A FLORIDA REGISTERED PE ENGINEER RESPONSIBLE FOR THE SYSTEM'S STRUCTURAL DESIGN.
- 3. THE CONTRACTOR SHALL ISSUE CERTIFICATES OF WARRANTY STATING THAT ALL MATERIALS HAVE BEEN INSTALLED IN ACCORDANCE WITH THE MANUFACTURER'S PUBLISHED INSTRUCTIONS. PROVIDE A 5 YEAR WARRANTY AGAINST WORKMANSHIP AND FINISH
- 4. ALL SUBMITTALS FOR SUBSTITUTIONS MUST BE MADE IN WRITING TO THE ENGINEER WITH SUPPORTING TECHNICAL DATA SHEETS AND TEST DATA SHOWING COMPLETE EQUIVALENT PERFORMANCE.
- 5. STRUCTURAL PERFORMANCE OF RAILING SYSTEM: ENGINEER, FABRICATE, AND INSTALL HAND RAILING SYSTEMS TO WITHSTAND ALL APPLICABLE STRUCTURAL LOADS AS INDICATED MEET OR EXCEED APPLICABLE BUILDING CODES.
- 6. ALL FASTENERS TO BE CORROSIVE RESISTANT GALVANIZED. FASTENER SIZE AND TYPE SHALL BE AS PER THE MANUFACTURER'S ENGINEERED DRAWINGS. FASTENERS SHALL BE COATED OR ISOLATED (NEOPRENE WASHERS), IF REQUIRED, TO INHIBIT GALVANIC ACTION.
- 7. GUARDRAIL/HANDRAIL SYSTEMS SHALL BE DESIGNED FOR A SINGLE CONCENTRATED LOAD OF 200 LBS. APPLIED IN ANY DIRECTION AT ANY POINT ON THE TOP OF THE GUARDRAIL AND TO TRANSFER THIS LOAD THROUGH THE SUPPORTS TO THE STRUCTURE. THIS LOAD NOT BE ASSUMED TO ACT CONCURRENTLY WITH THE LOADS SPECIFIED IN FBC § 1607.7.1. (FBC § 1607.7.1.1).
- 8. GUARDRAIL/HANDRAIL SYSTEMS SHALL BE DESIGNED FOR TO RESIST A LOAD OF 50 POUNDS PER LINEAL FOOT OR A CONCENTRATED LOAD OF 200 POUNDS APPLIED IN ANY DIRECTION AT THE TOP OF SUCH BARRIERS AT ANY LOCATION ON THE SAFEGUARD, WHICHEVER CONDITION PRODUCES THE MAXIMUM STRESSES. THE REACTIONS AND STRESSES CAUSED BY THE ABOVE REFERENCED UNIFORM AND CONCENTRATED LOADS SHALL BE CONSIDERED NOT BE ACTING SIMULTANEOUSLY (FBC HVHZ § 1618.4.6.1).
- 9. COMPONENTS - INTERMEDIATE RAILS (ALL THOSE EXCEPT THE HANDRAIL), BALUSTERS AND PANEL FILLERS SHALL BE DESIGNED TO WITHSTAND A HORIZONTALLY APPLIED NORMAL LOAD OF 50 POUNDS ON AN AREA EQUAL TO 1 SQ. FT., INCLUDING OPENINGS AND SPACE BETWEEN RAILS. REACTIONS DUE TO THIS LOADING ARE NOT REQUIRED TO BE SUPERIMPOSED WITH THOSE OF FBC § 1607.7.1 OR 1607.7.1.1. (FBC § 1607.7.1.2).
- 10. IN HVHZ, INTERMEDIATE RAILS, BALUSTERS AND PANEL FILLERS ARE DESIGNED FOR A UNIFORM HORIZONTAL LOAD OF NOT LESS THAN 25 POUNDS PER SQUARE FOOT OVER THE GROSS AREA OF THE GUARD, INCLUDING THE AREA OF ANY OPENINGS IN THE GUARD, OF WHICH THEY ARE A PART WITHOUT RESTRICTION BY DEFLECTION. REACTIONS RESULTING FROM THIS LOADING NEED NOT BE ADDED TO THE LOADING SPECIFIED IN FBC

STRUCTURAL STAINLESS STEEL

- 1. PLATES, BARS, CHANNELS AND ANGLES SHALL CONFORM TO ASTM A276 STANDARD SPECIFICATION FOR STAINLESS STEEL BARS AND SHAPES, ALLOY TYPE 304. TUBES SHALL CONFORM TO ASTM A554, ALLOY TYPE 304. STAINLESS STEEL SHEETS SHALL CONFORM TO ASTM A240 (OR ASTM A666), ALLOY TYPE 304.
- 2. ALL WELDS SHALL BE MADE BY QUALIFIED WELDERS WITH ELECTRODES AS PER AWS REQUIREMENTS FOR STAINLESS STEEL (AWS D1.6 STRUCTURAL WELDING CODE STAINLESS STEEL, AWS E/ER 308 OR 312 FILLER METAL).
- 3. ALL FRAMING MEMBERS SHALL BE CONNECTED WITH FULL WELDS AT MEMBER INTERFACES. WELDS NOT OTHERWISE DESIGNATED SHALL BE 3/16 INCH MINIMUM FILLET.
- 4. RETURN ALL WELDS AT CORNERS TWICE THE NORMAL WELD SIZE MINIMUM.
- 5. ALL BOLTS SHALL CONFORM TO ASTM F593 STAINLESS STEEL SPECIFICATION, ALLOY TYPE 304, ¾ INCH DIAMETER, UNLESS NOTED OTHERWISE.
- 6. ALL NUTS SHALL CONFORM TO ASTM F594 STAINLESS STEEL SPECIFICATION, ALLOY TYPE 304, UNLESS NOTED OTHERWISE.
- 7. ALL COPES, BLOCKS, CUTOUTS AND OTHER CUTTING OF STRUCTURAL MEMBERS SHALL HAVE ALL RE-ENTRANT CORNERS SHAPED NOTCH-FREE TO A RADIUS OF ½ INCH MINIMUM.



3434 colwell avenue suite 100, tampa, florida 33614
telephone : 813.908.7203 fax : 813.931.5200
email : info@billerreinhardt.com
State of Florida Certificate of Authorization No. 9149

TO THE BEST OF THE ENGINEER'S KNOWLEDGE
THE PLANS AND SPECIFICATIONS COMPLY WITH
THE APPLICABLE MINIMUM BUILDING CODES

ROBERT J. REINHART
FL. P.E. NO. 50076



Engineering Design
Technologies Corp.
P.O. Box 152403
Tampa, FL 33684-2403
813.289.8080
813.282.9184 FAX
engineering@edt1.com

Certificate of Authorization Number: 4795

CITY of TAMPA
WASTEWATER DEPARTMENT

KRAUSE PS REHABILITATION

GENERAL STRUCTURAL
NOTES

RED LINES

NO CHANGES


1 1/27
NO. DA

DRAWN: RC, KC
DESIGN: RR
QC: RR
DATE: 06/03/14

SHEET S-4

PLAN NOTES

- N-1** STRUCTURAL RELATED DESIGN FOR EXTERIOR TRANSFORMER – DESIGN NEW PLATFORM FOR ACCESS AT PROPER LEVEL, SEE SHEETS S-10 AND S-11 FOR PLANS.
- N-2** COVERING OF STAIR OPENING TO THE EXISTING BASEMENT ELECTRICAL ROOM AND ADDRESS THE EXISTING CURBING AND SUBSEQUENT SLAB REPAIRS, SEE 1/S-18
- N-3** PERFORMANCE SPECIFICATIONS AND SCHEMATIC DRAWINGS OF THE PLATFORM (STRUCTURAL STEEL, GRATING, GUARDRAILS AND STAIRS) FOR THE ELECTRICAL EQUIPMENT ON THE MAIN LEVEL THAT IS TO BE RAISED ABOVE THE 100-YEAR FLOOD ELEVATION (APPROXIMATELY 2'-6" ABOVE EXISTING FLOOR – CLEARANCE IS ADEQUATE FROM UNDERSIDE OF EXISTING ROOF STRUCTURE TO TOP OF NEW ELECTRICAL EQUIPMENT ON THE NEW PLATFORM, SEE 1/S-12, 1/S-13, S-22, S-23 & 1/S-24. COORDINATE PLATFORM WITH E-6
- N-4** PROVIDE FOR NEW EXIT OPENING (INCLUDING DOOR AND FRAME SPECIFICATION) AND EXTERIOR STAIRS AT ELECTRICAL EQUIPMENT. DOOR AND FRAME TO CLOSELY MATCH MAIN ENTRY ON EAST ELEVATION. SEE S-28.
- N-5** TRANSFER CART AND RAILS THROUGH CENTER LINE OF EXISTING DOORS AND NEW CONCRETE PLATFORM AND STAIRS. SEE S-29.
- N-6** NEW EXTERIOR STAIR AND PLATFORM LANDINGS WITH HAND AND GUARDRAILS. SEE S-29.
- N-12** LANDING EXTENSION. SEE 1/S-32.
- N-13** REPAIR CONCRETE SURFACES IN ACCORDANCE WITH SPECIFICATION 033000 AND ADD MECHANICAL PADS AS REQ'D. SEE 1/S-33.
- N-14** SEE S-34 FOR CATWALK MODIFICATIONS.
- N-15** 12" CMU PARTITION WALL AND 8" CONCRETE SLAB SUPPORTING CMU WALL TO BE REMOVED AND RECONSTRUCTED AT NEW LOCATION. SEE 2/S-32.

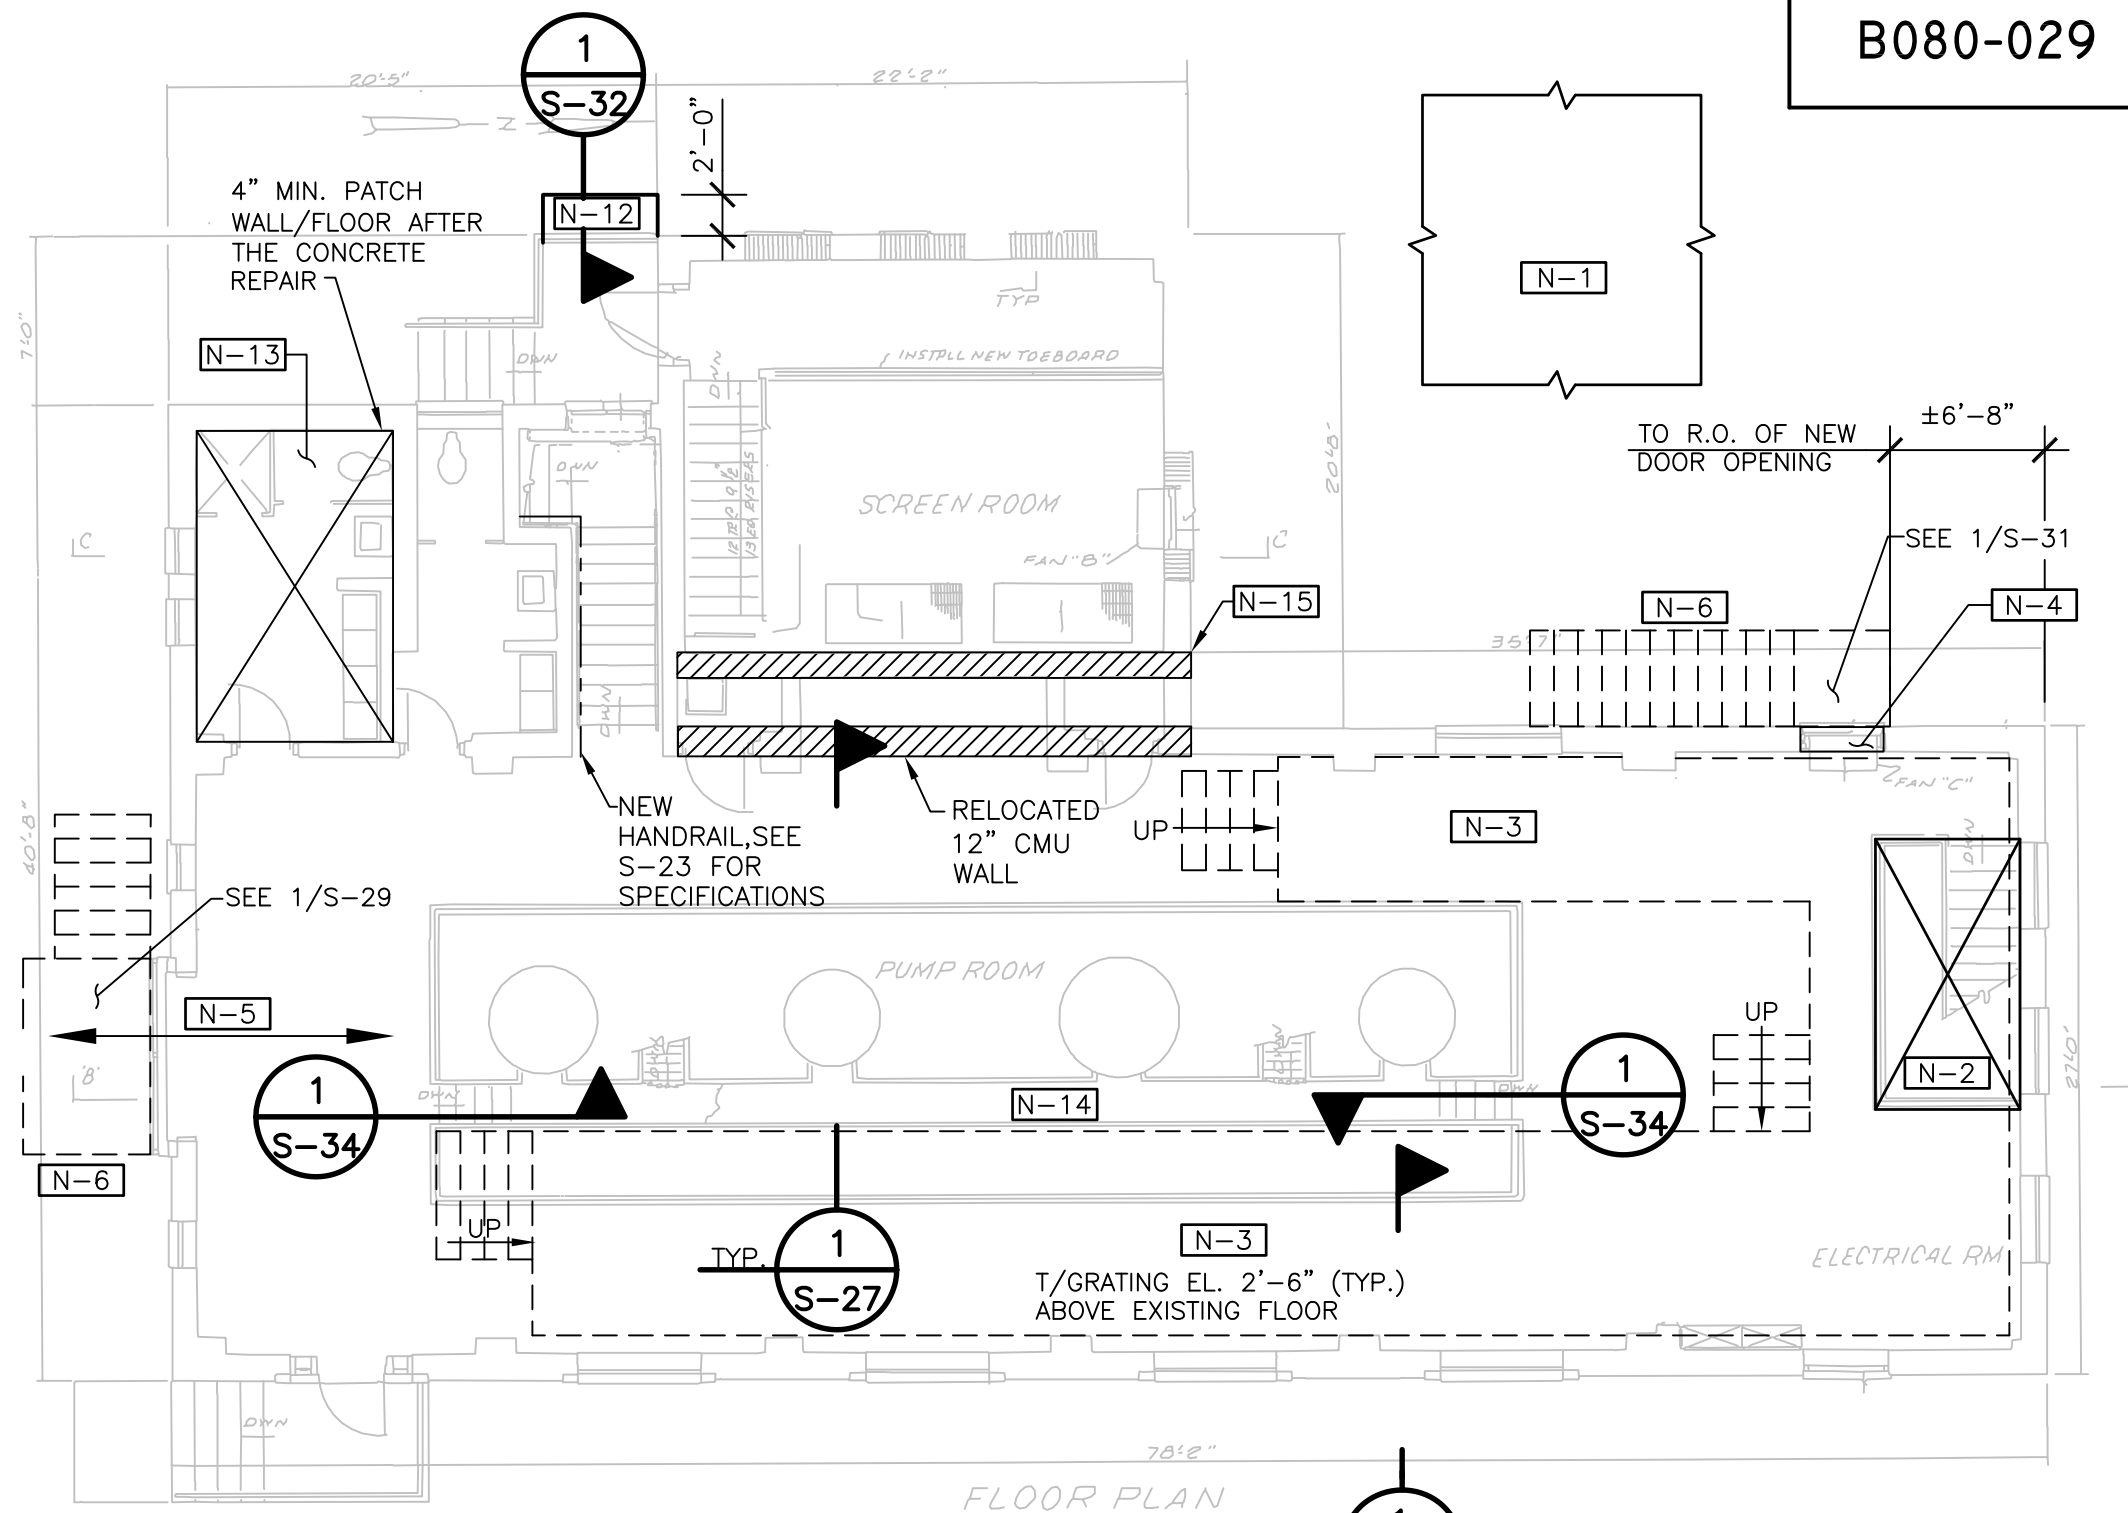

EXISTING PLANS & SECTIONS WITH NEW STRUCTURAL MODIFICATIONS & ADDITIONS

1
S-5

SCALE: 1/8" = 1'-0" (NOTE EXISTING PLANS & SECTION UNDERLAY IS APPROXIMATE AND FOR LOCATION PURPOSES ONLY)

billerreinhardt
ENGINEERING GROUP INC.
3434 colwell avenue suite 100, tampa, florida 33614
telephone : 813.908.7203 fax : 813.931.5200
email : info@billerreinhardt.com
State of Florida Certificate of Authorization No. 9149

TO THE BEST OF THE ENGINEER'S KNOWLEDGE
THE PLANS AND SPECIFICATIONS COMPLY WITH
THE APPLICABLE MINIMUM BUILDING CODES

ROBERT J. REINHART
FL. P.E. NO. 50076



**Engineering Design
Technologies Corp.**
P.O. Box 152403
Tampa, FL 33684-2403
813.289.8080
813.282.9184 FAX
engineering@edt1.com

Certificate of Authorization Number: 4795

CITY of TAMPA
WASTEWATER DEPARTMENT

KRAUSE PS REHABILITATION

**EXISTING PLANS WITH NEW
STRUCTURAL MODIFICATION & ADDITIONS**

RED LINES

NO CHANGES

DRAWN: RC, KC
DESIGN: RR
QC: RR
DATE: 06/03/14


SHEET S-5

1
NO.

1/27/
DATE

PLAN NOTES

- N-7 IN-FILL OF THE EXISTING BASEMENT ELECTRICAL ROOM, SEE 1/S-18.
- N-8 STRUCTURAL RELATED DESIGN FOR SETTING NEW IMMERSIBLE PUMPS AND PIPES, SEE 1/S-14 THROUGH 1/S-17.
- N-9 SEE S-9 FOR PROPOSED BAR SCREEN (NOTE 2" O.C. BAR SPACING)
- N-16 SUMP PUMP COVER. SEE 2/S-33.
- N-17 CHAMBER INLET MODIFICATIONS WITH NEW STOP LOG GROOVES SEE 1/S-25

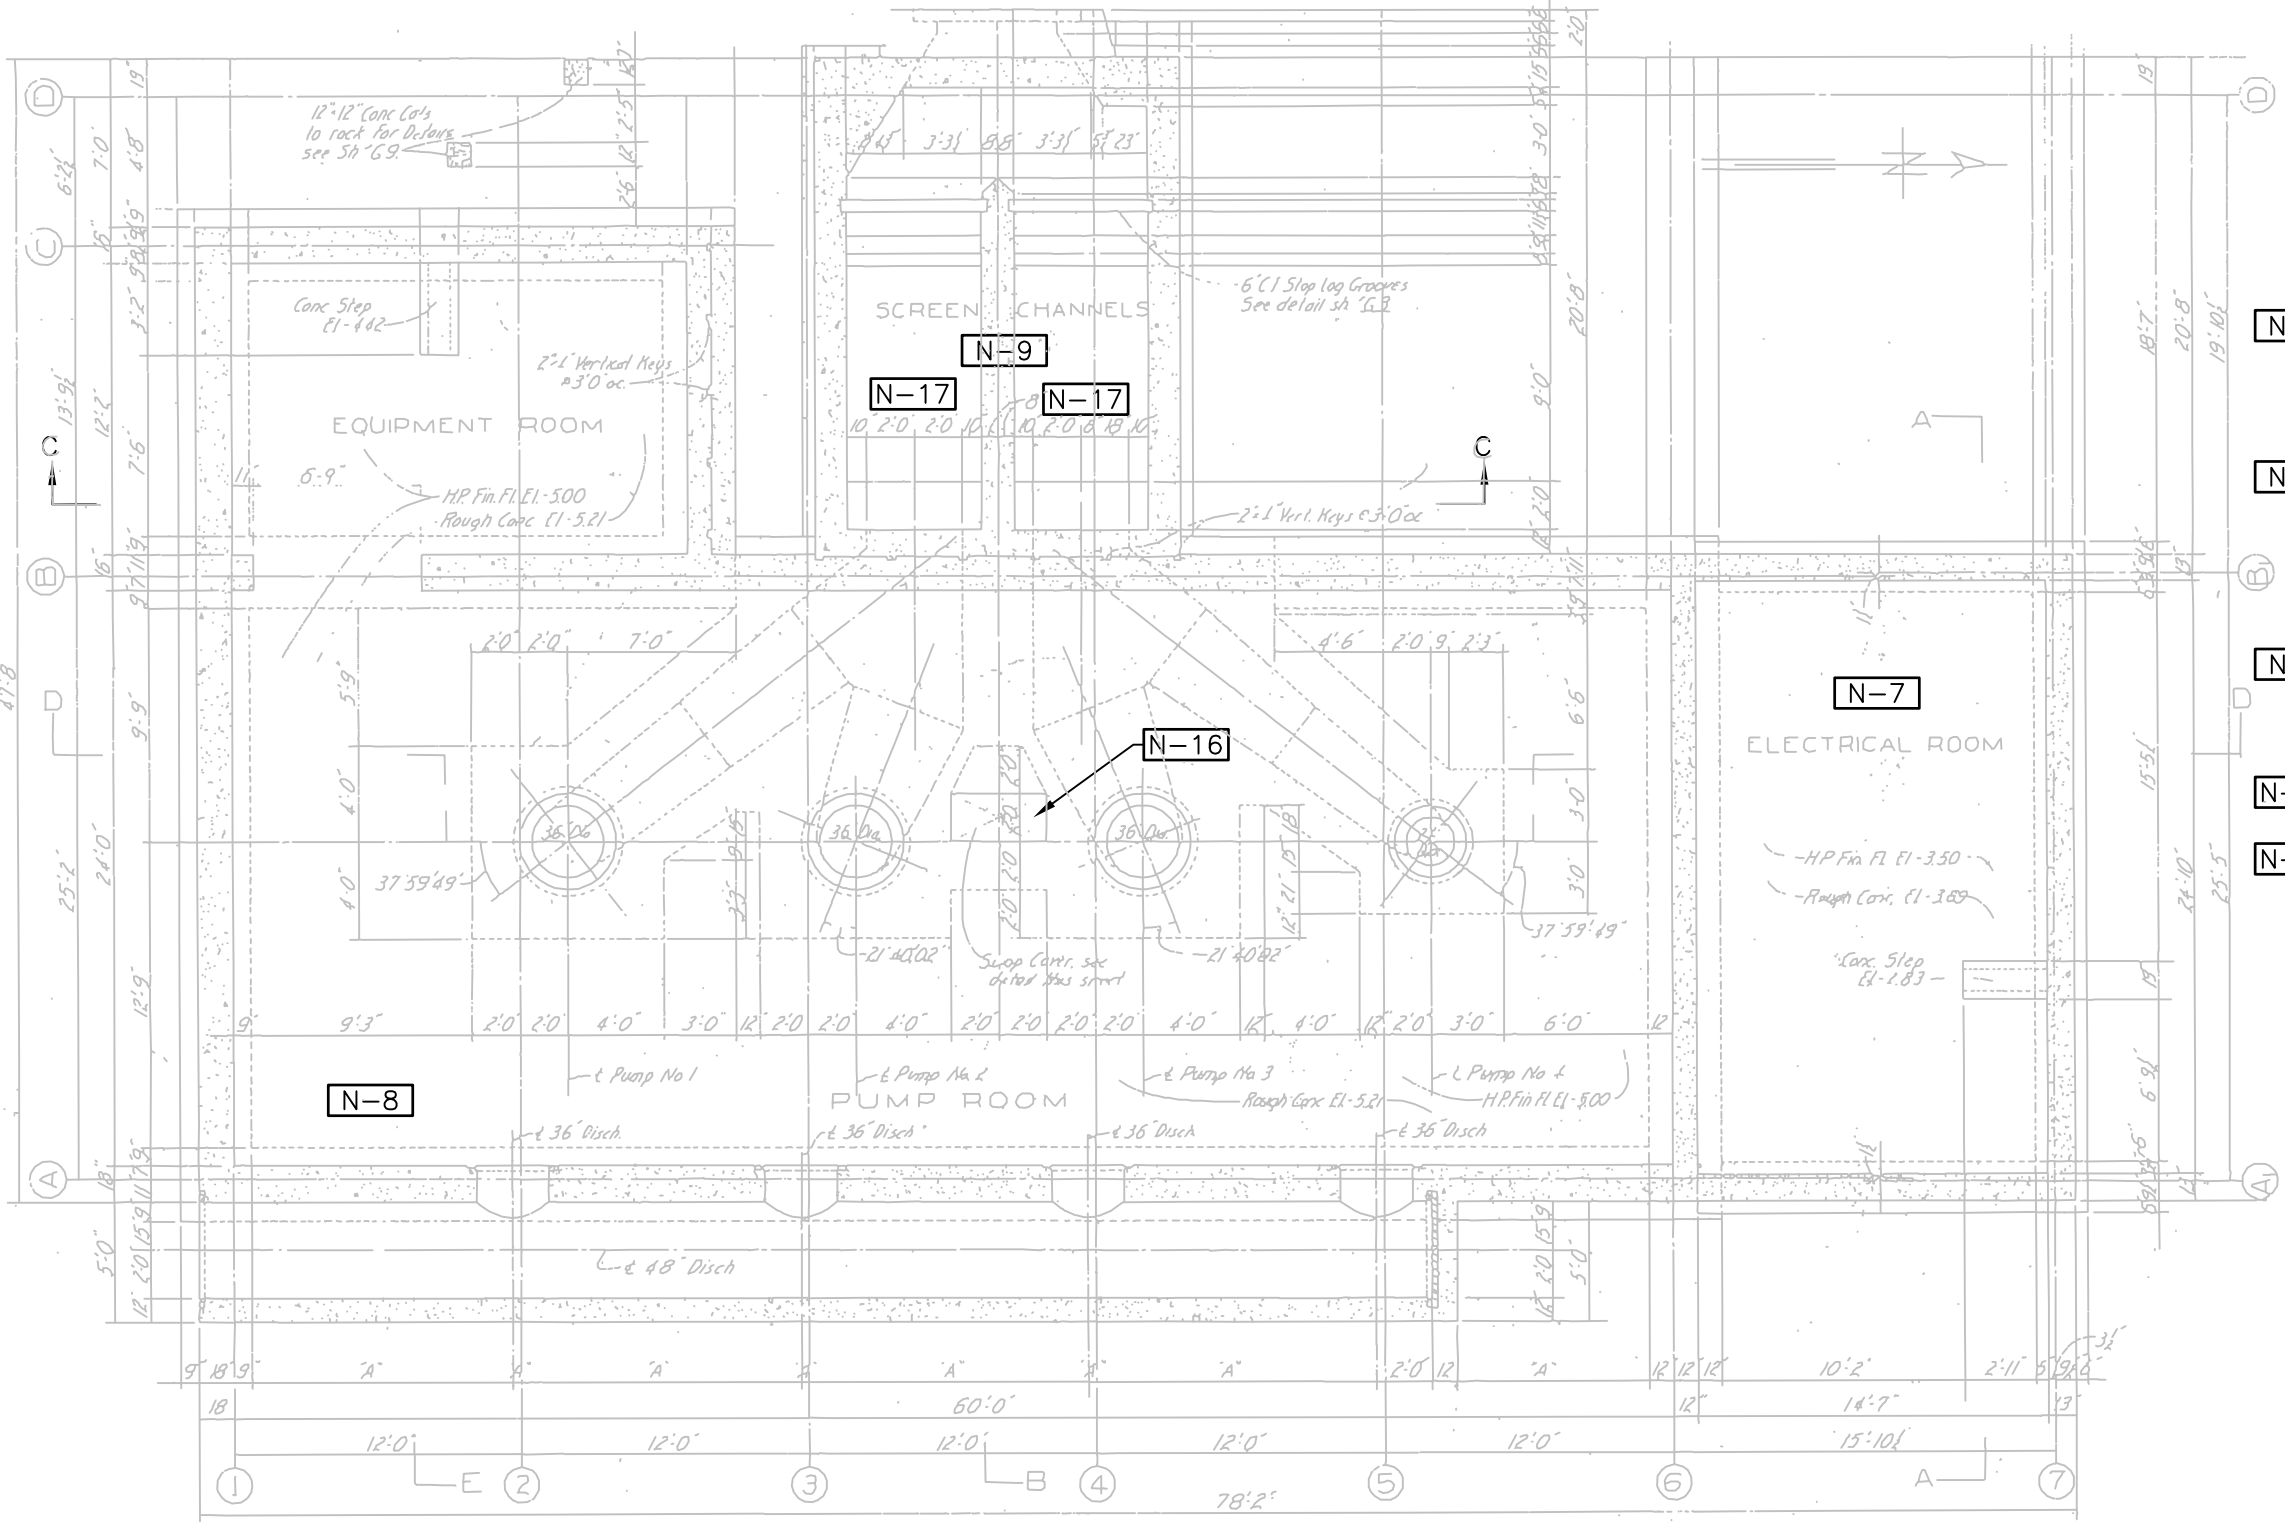

EXISTING PLANS & SECTIONS WITH
NEW STRUCTURAL MODIFICATIONS & ADDITIONS

1 S-6 SCALE: 1/8" = 1'-0" (NOTE EXISTING PLANS & SECTION UNDERLAY IS APPROXIMATE AND FOR LOCATION PURPOSES ONLY)

ENGINEERING GROUP INC.
3434 colwell avenue suite 100, tampa, florida 33614
telephone : 813.908.7203 fax : 813.931.5200
email : info@billerreinhardt.com

TO THE BEST OF THE ENGINEER'S KNOWLEDGE
THE PLANS AND SPECIFICATIONS COMPLY WITH
THE APPLICABLE MINIMUM BUILDING CODES

ROBERT J. REINHART
FL. P.E. NO. 50076

PLAN NOTES

B080-031

N-10 THE EXISTING MANUAL SCREENS WILL BE ADDRESSED PER MECHANICAL DRAWINGS. CLEARANCE IS ADEQUATE FROM UNDERSIDE OF EXISTING ROOF STRUCTURE FOR BAR SCREENS TO BE ADDRESSED. NO MODIFICATION OF THE ROOF STRUCTURE IS PROPOSED AND/OR REQUIRED

N-11 THE EXISTING STEEL ROOF FRAMING IN THE SCREEN ROOM EXHIBITS CORROSION.

A. CLEANING / SURFACE PREPARATION PROCESS OF THE EXISTING EXPOSED STEEL FRAMING: STEEL SURFACE PREPARATION: SSPC-SP10 IS PREFERABLE; HOWEVER, RECOGNIZING THE SPACE CONSTRUCTIONS AND ACCESSIBILITY ABOVE SCREENS, SSPC-SP3 WOULD BE ACCEPTABLE FOR THE AREAS THAT ARE DIFFICULT TO ACCESS.

B. MINOR STRUCTURAL STEEL REPAIR (I.E., WELDMENTS, SUPPLEMENTAL PLATES) OF FRAMING ELEMENTS MAY BE REQUIRED. TYPICAL REPAIR SUPPLEMENTAL STEEL WOULD BE ASTM A36 1/4-INCH THICK PLATE.


C. APPLICATION OF A PROTECTIVE COATING SYSTEM TO THE EXISTING EXPOSED STEEL FRAMEWORK:

1. SURFACE PREPARATION

- REMOVE ALL GREASE, OIL, DIRT, DUST, MOLD, MILDEW, AND OTHER SOLUBLE CONTAMINANTS BY HIGH PRESSURE WATER CLEANING (MINIMUM 3000 PSI, 3-5 GALLONS PER MINUTE, POTABLE WATER).
- GRIND ALL SHARP EDGES AND SEAMS SMOOTH.
- REMOVE ALL AREAS OF RUST AND RUST STAIN BY NEAR WHITE BLAST CLEANING (SSPC-SP10).
- ALL SURFACES MUST BE CLEAN AND DRY PRIOR TO THE APPLICATION OF ANY COATINGS. ALL BLASTED SURFACES MUST BE PRIMED AS SOON AS POSSIBLE THE SAME DAY TO PREVENT FLASH RUSTING OR RE-CONTAMINATION OF THE SURFACE.

2. COATING SYSTEM:

- PRIMER: TNEPEC SERIES 446 PERMA-SHIELD MCU @ 7.0-9.0 MILS DFT
- STRIPE COAT: (SPOT APPLY TO AREAS OF PITTING, WELDS, SEAMS, EDGES, AND PROTRUSIONS) TNEPEC SERIES 446 PERMA-SHIELD MCU @ 5.0-7.0 MILS DFT
- FINISH COAT: TNEPEC SERIES 446 PERMA-SHIELD MCU @ 7.0-9.0.0 MILS DFT

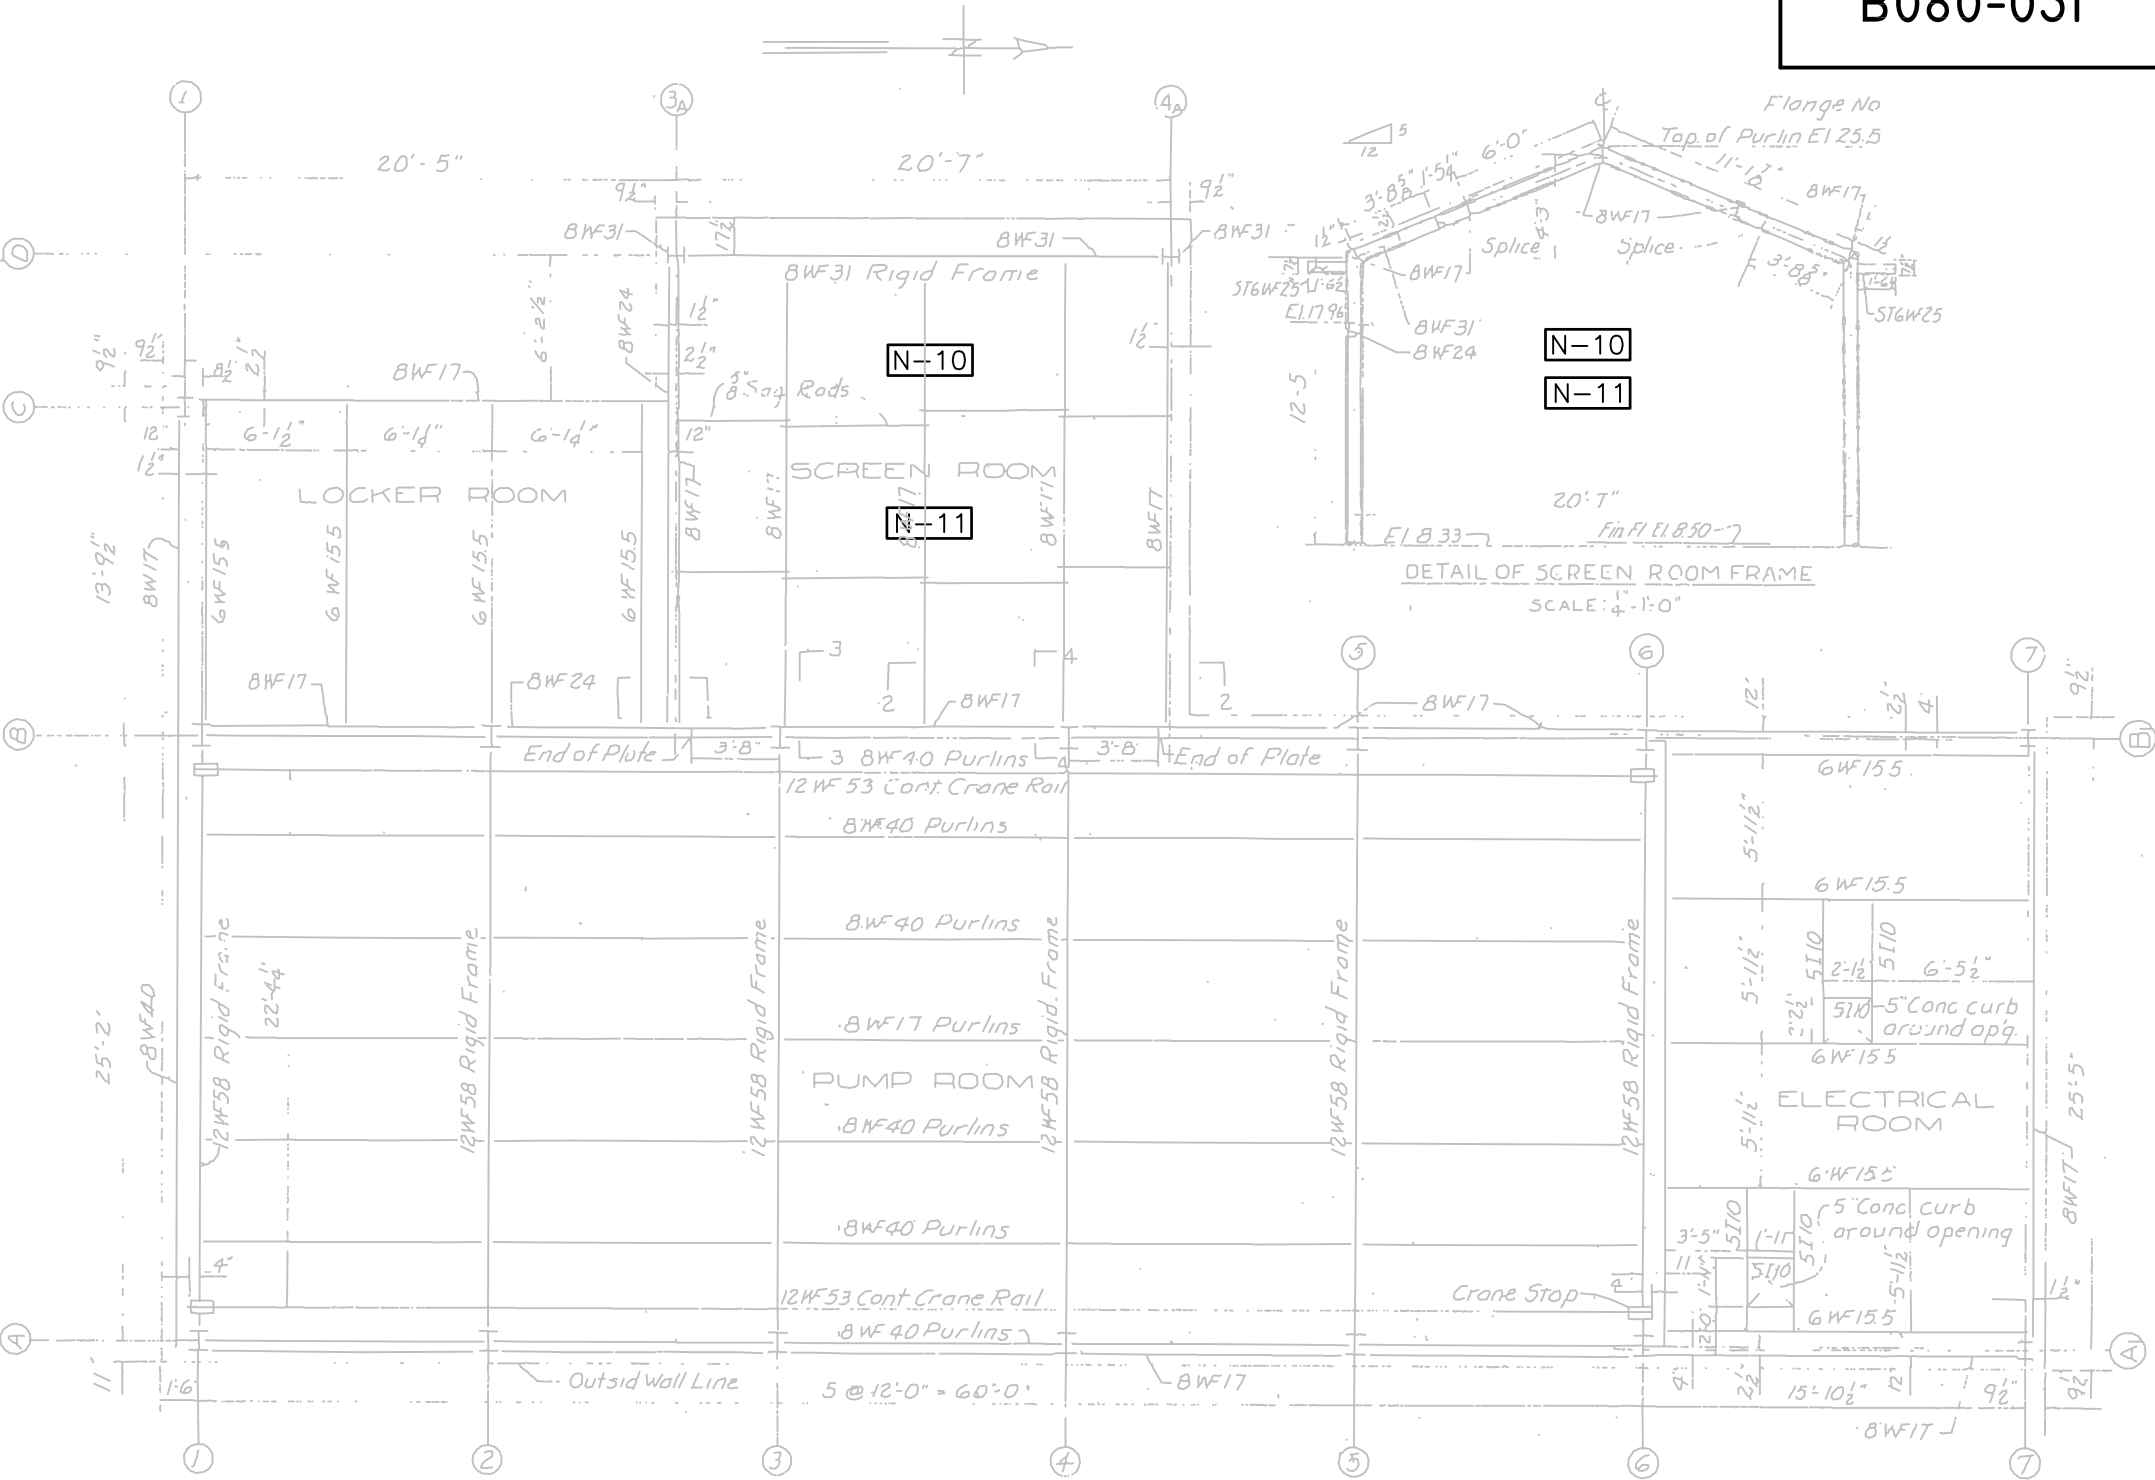

EXISTING PLANS & SECTIONS WITH
NEW STRUCTURAL MODIFICATIONS & ADDITIONS

1
S-7

SCALE: 1/8" = 1'-0" (NOTE EXISTING PLANS & SECTION UNDERLAY IS APPROXIMATE AND FOR LOCATION PURPOSES ONLY)



billerreinhardt
ENGINEERING GROUP INC.
3434 colwell avenue suite 100, tampa, florida 33614
telephone : 813.908.7203 fax : 813.931.5200
email : info@billerreinhardt.com
State of Florida Certificate of Authorization No. 9149

TO THE BEST OF THE ENGINEER'S KNOWLEDGE
THE PLANS AND SPECIFICATIONS COMPLY WITH
THE APPLICABLE MINIMUM BUILDING CODES
ROBERT J. REINHART
FL. P.E. NO. 50076



Engineering Design
Technologies Corp.
P.O. Box 152403
Tampa, FL 33684-2403
813.289.8080
813.282.9184 FAX
engineering@edt1.com

CITY of TAMPA
WASTEWATER DEPARTMENT

KRAUSE PS REHABILITATION
EXISTING PLANS WITH NEW
STRUCTURAL MODIFICATION & ADDITIONS

RED LINES

NO CHANGES

DRAWN: RC, KC
DESIGN: RR
QC: RR
DATE: 06/03/14


SHEET S-7

1 1/27/15
NO. DATE

CONFIRMED

PLAN NOTES

- N-2 COVERING OF STAIR OPENING TO THE EXISTING BASEMENT ELECTRICAL ROOM AND ADDRESS THE EXISTING CURBING AND SUBSEQUENT SLAB REPAIRS, SEE 1/S-18
- N-4 PROVIDE FOR NEW EXIT OPENING (INCLUDING DOOR AND FRAME SPECIFICATION) AND EXTERIOR STAIRS AT ELECTRICAL EQUIPMENT. DOOR AND FRAME TO CLOSELY MATCH MAIN ENTRY ON EAST ELEVATION. SEE S-28.
- N-7 IN-FILL OF THE EXISTING BASEMENT ELECTRICAL ROOM, SEE 1/S-18

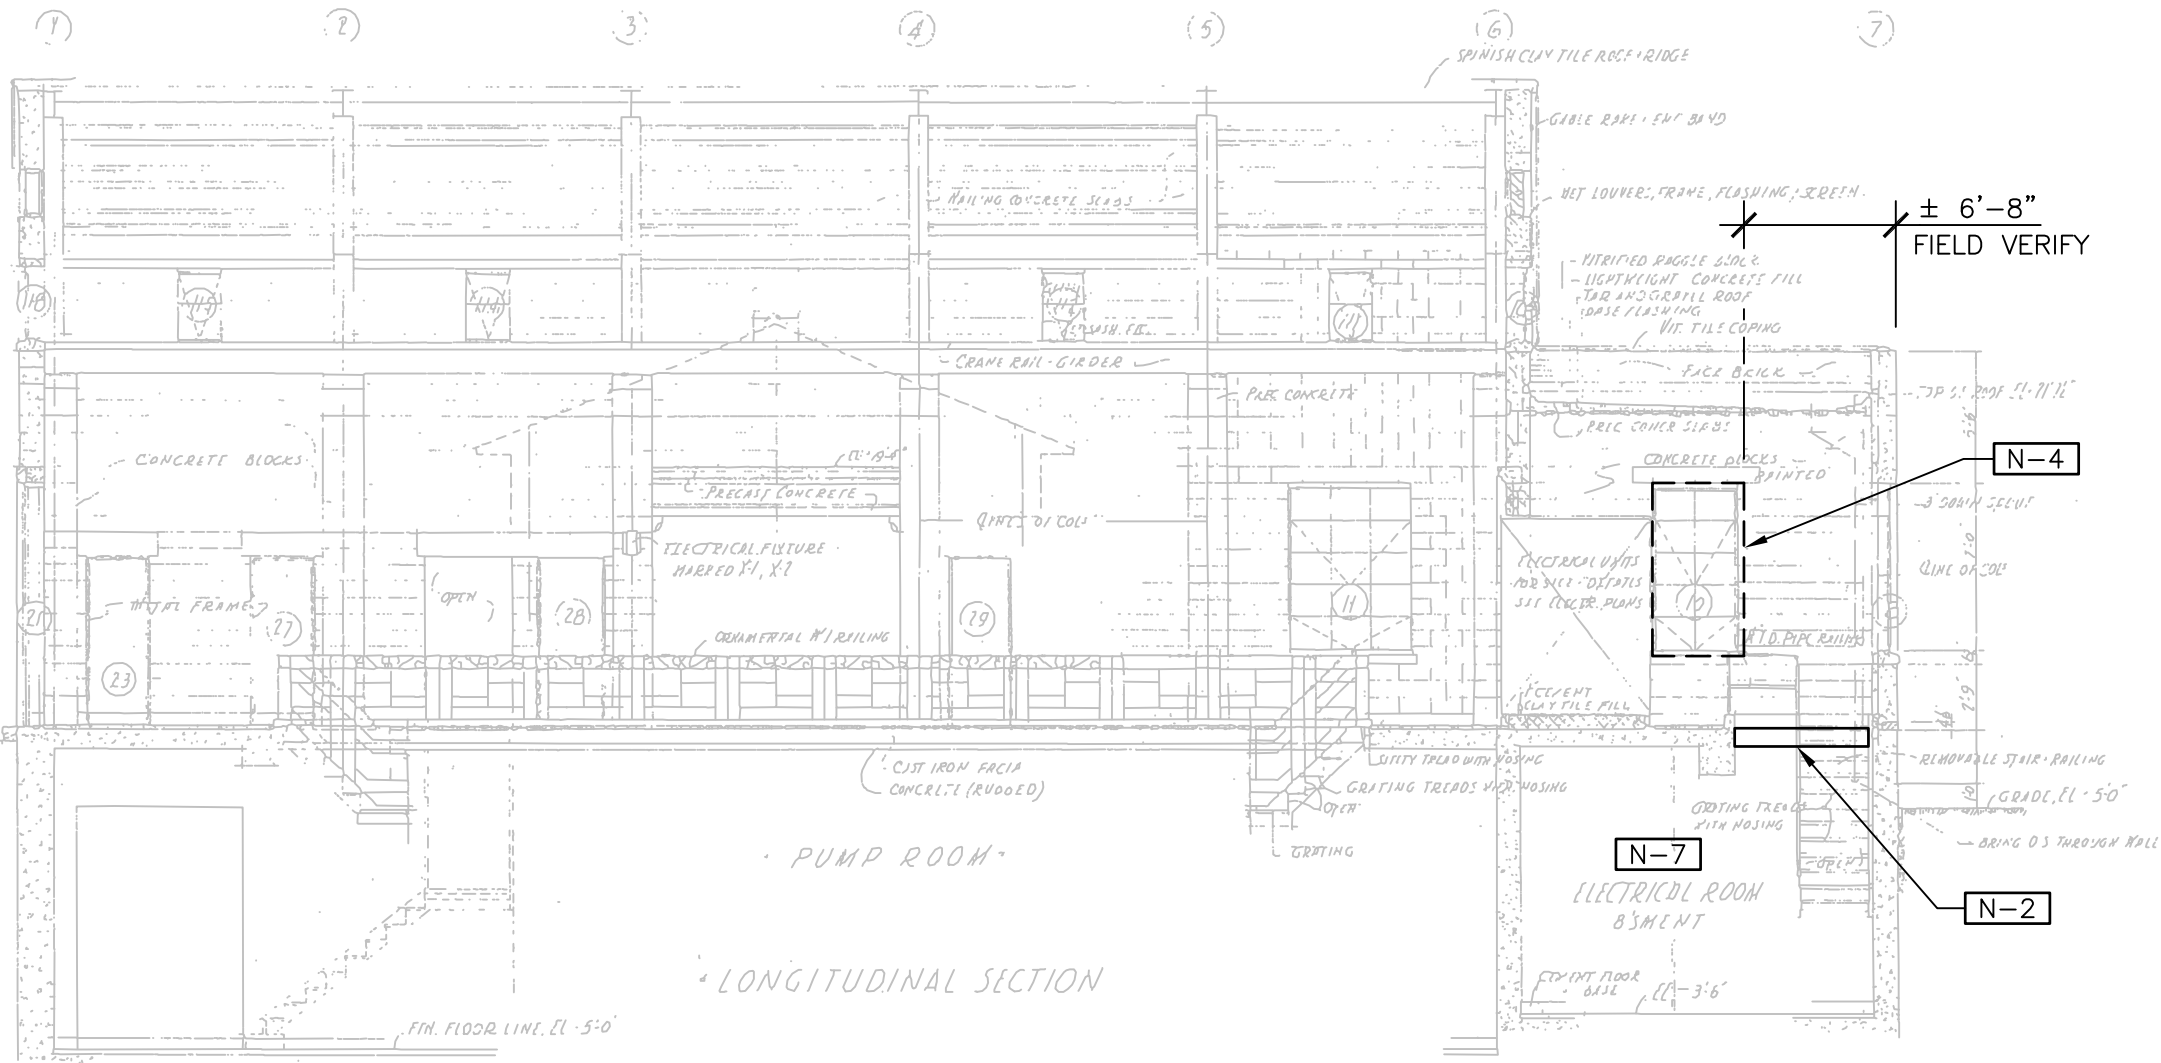

EXISTING PLANS & SECTIONS WITH NEW
STRUCTURAL MODIFICATIONS & ADDITIONS

1
S-8

SCALE: 1/8" = 1'-0" (NOTE EXISTING PLANS & SECTION UNDERLAY IS APPROXIMATE AND FOR LOCATION PURPOSES ONLY)



billerreinhardt
ENGINEERING GROUP INC.
3434 colwell avenue suite 100, tampa, florida 33614
telephone : 813.908.7203 fax : 813.931.5200
email : info@billerreinhardt.com
State of Florida Certificate of Authorization No. 9149

TO THE BEST OF THE ENGINEER'S KNOWLEDGE
THE PLANS AND SPECIFICATIONS COMPLY WITH
THE APPLICABLE MINIMUM BUILDING CODES

ROBERT J. REINHART
FL. P.E. NO. 50076

EDT
Engineering Design
Technologies Corp.
P.O. Box 152403
Tampa, FL 33684-2403
813.289.8080
813.282.9184 FAX
engineering@edt1.com

Certificate of Authorization Number: 4795

CITY of TAMPA
WASTEWATER DEPARTMENT

KRAUSE PS REHABILITATION


EXISTING PLANS WITH NEW
STRUCTURAL MODIFICATION & ADDITIONS

RED LINES

NO CHANGES

DRAWN: RC, KC
DESIGN: RR
QC: RR
DATE: 06/03/14

SHEET S-8

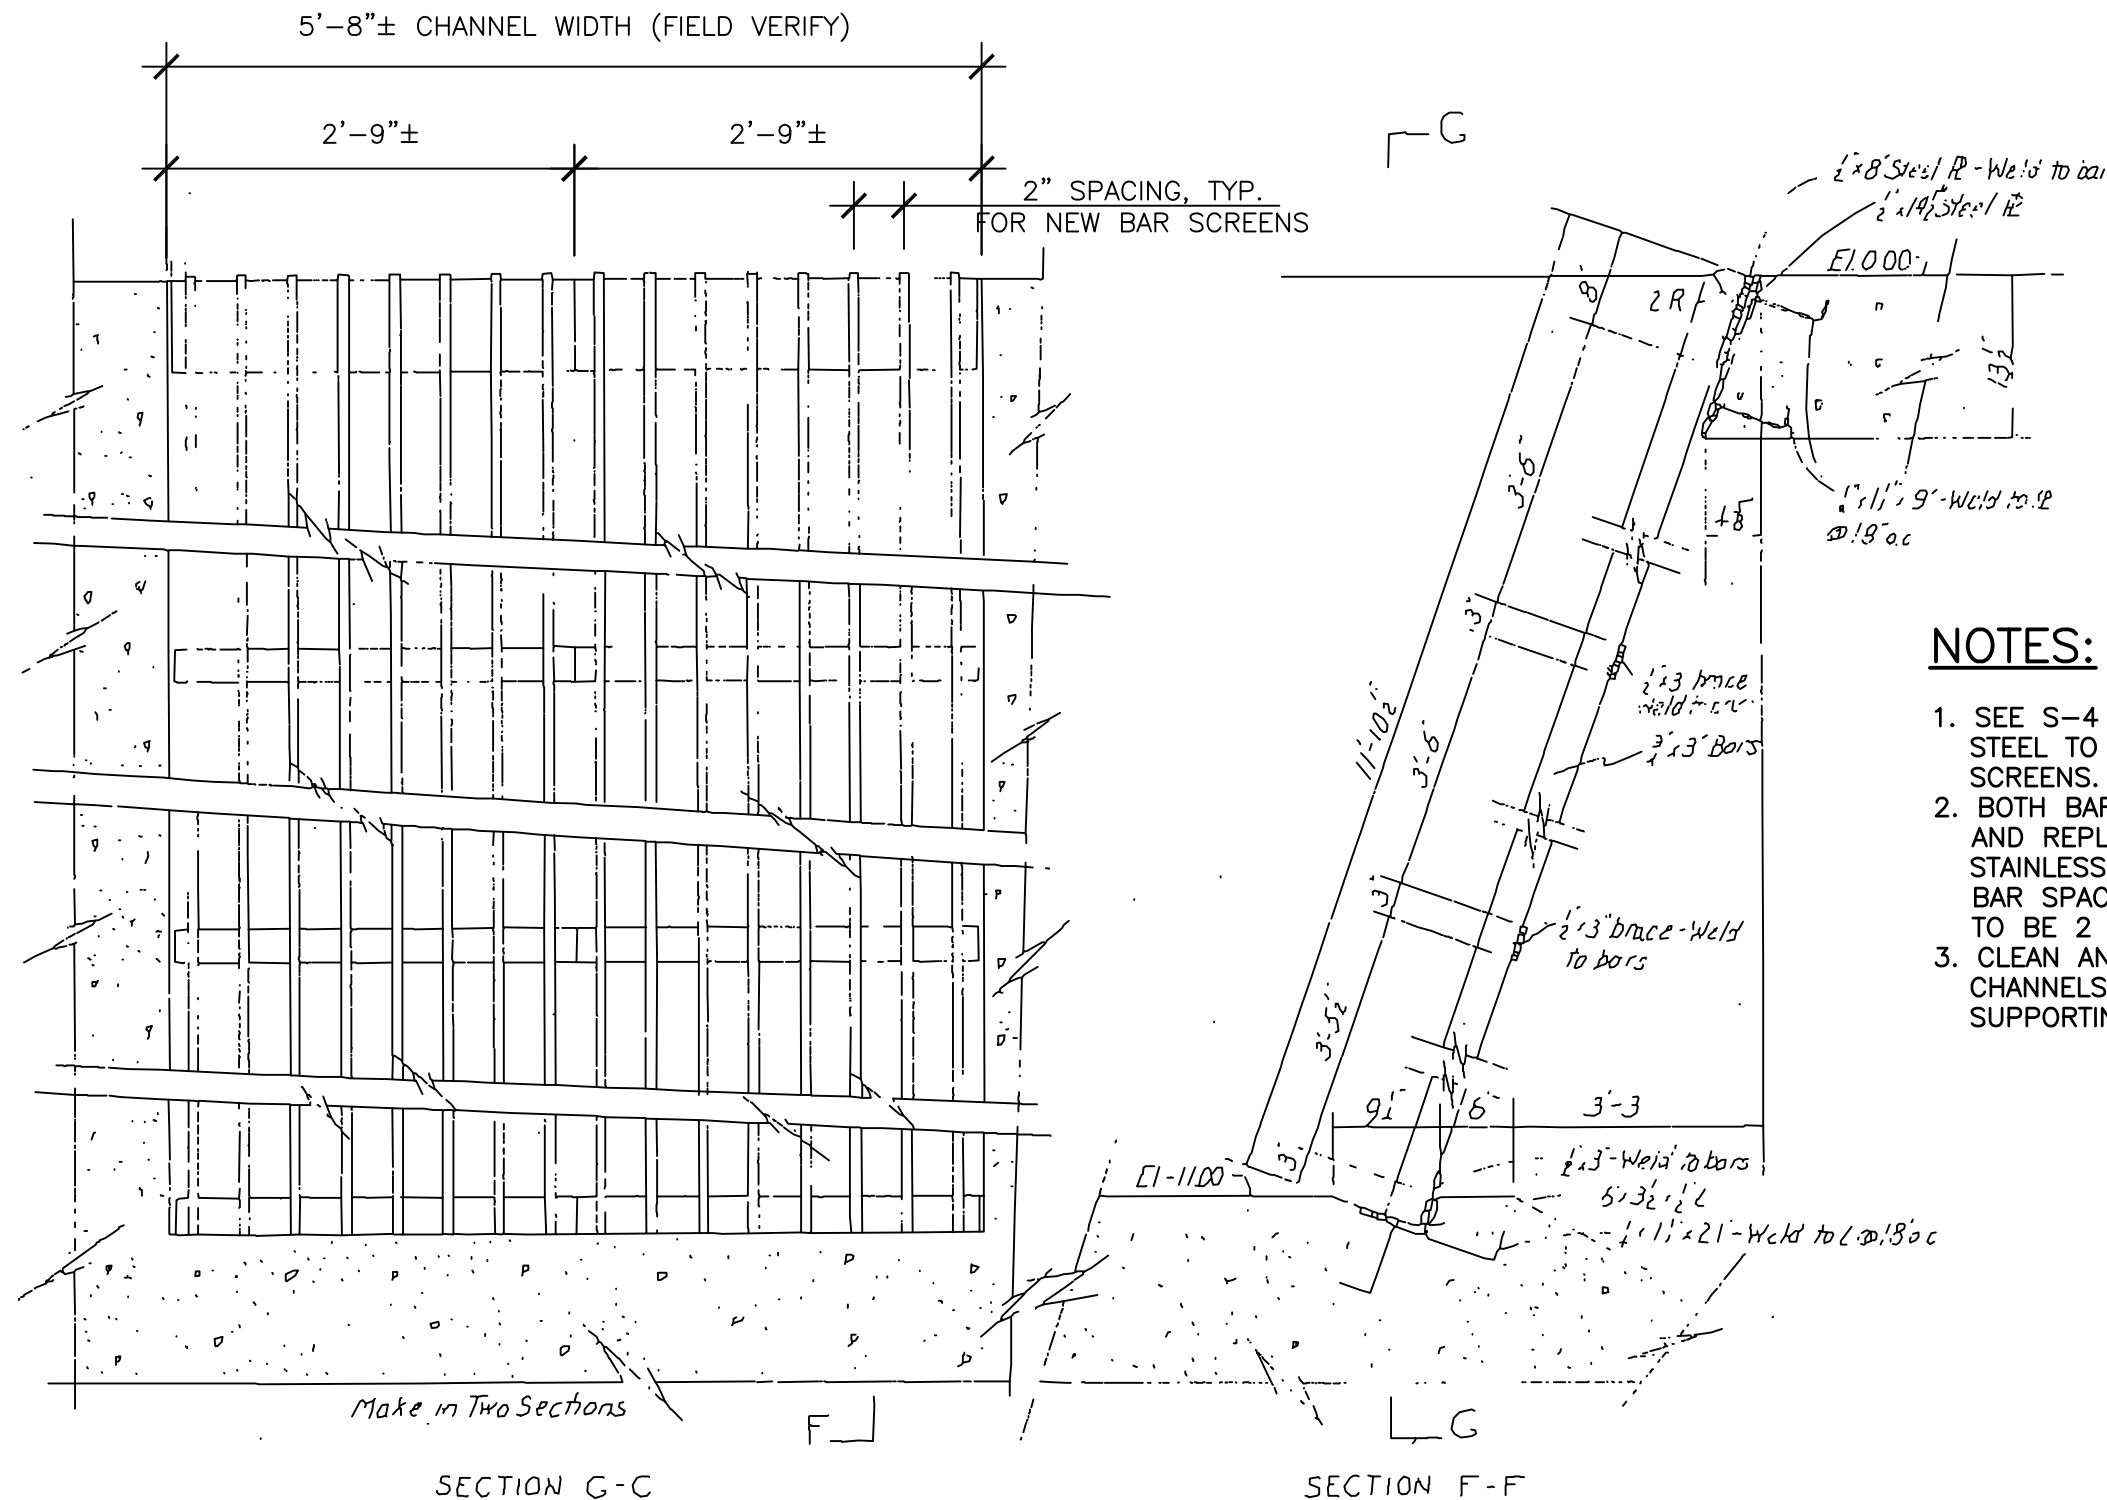


- NOTES:**
- 1. SEE S-4 FOR STRUCTURAL STAINLESS STEEL TO BE USED FOR NEW BAR SCREENS.
 - 2. BOTH BAR SCREENS ARE TO BE REMOVED AND REPLACED IN KIND UTILIZING STAINLESS STEEL, EXCEPT FOR VERTICAL BAR SPACING. NEW VERTICAL BAR SPACING TO BE 2 INCHES ON CENTER
 - 3. CLEAN AND REUSE THE EXISTING CHANNELS, PLATES AND ANGLES SUPPORTING BAR SCREENS.

1
S-9 **EXISTING BAR SCREEN DETAIL**
SCALE: N.T.S.

3434 colwell avenue suite 100, tampa, florida 33614
telephone : 813.908.7203 fax : 813.931.5200
email : info@billerreinhardt.com
State of Florida Certificate of Authorization No. 9149

TO THE BEST OF THE ENGINEER'S KNOWLEDGE
THE PLANS AND SPECIFICATIONS COMPLY WITH
THE APPLICABLE MINIMUM BUILDING CODES

ROBERT J. REINHART
FL. P.E. NO. 50076

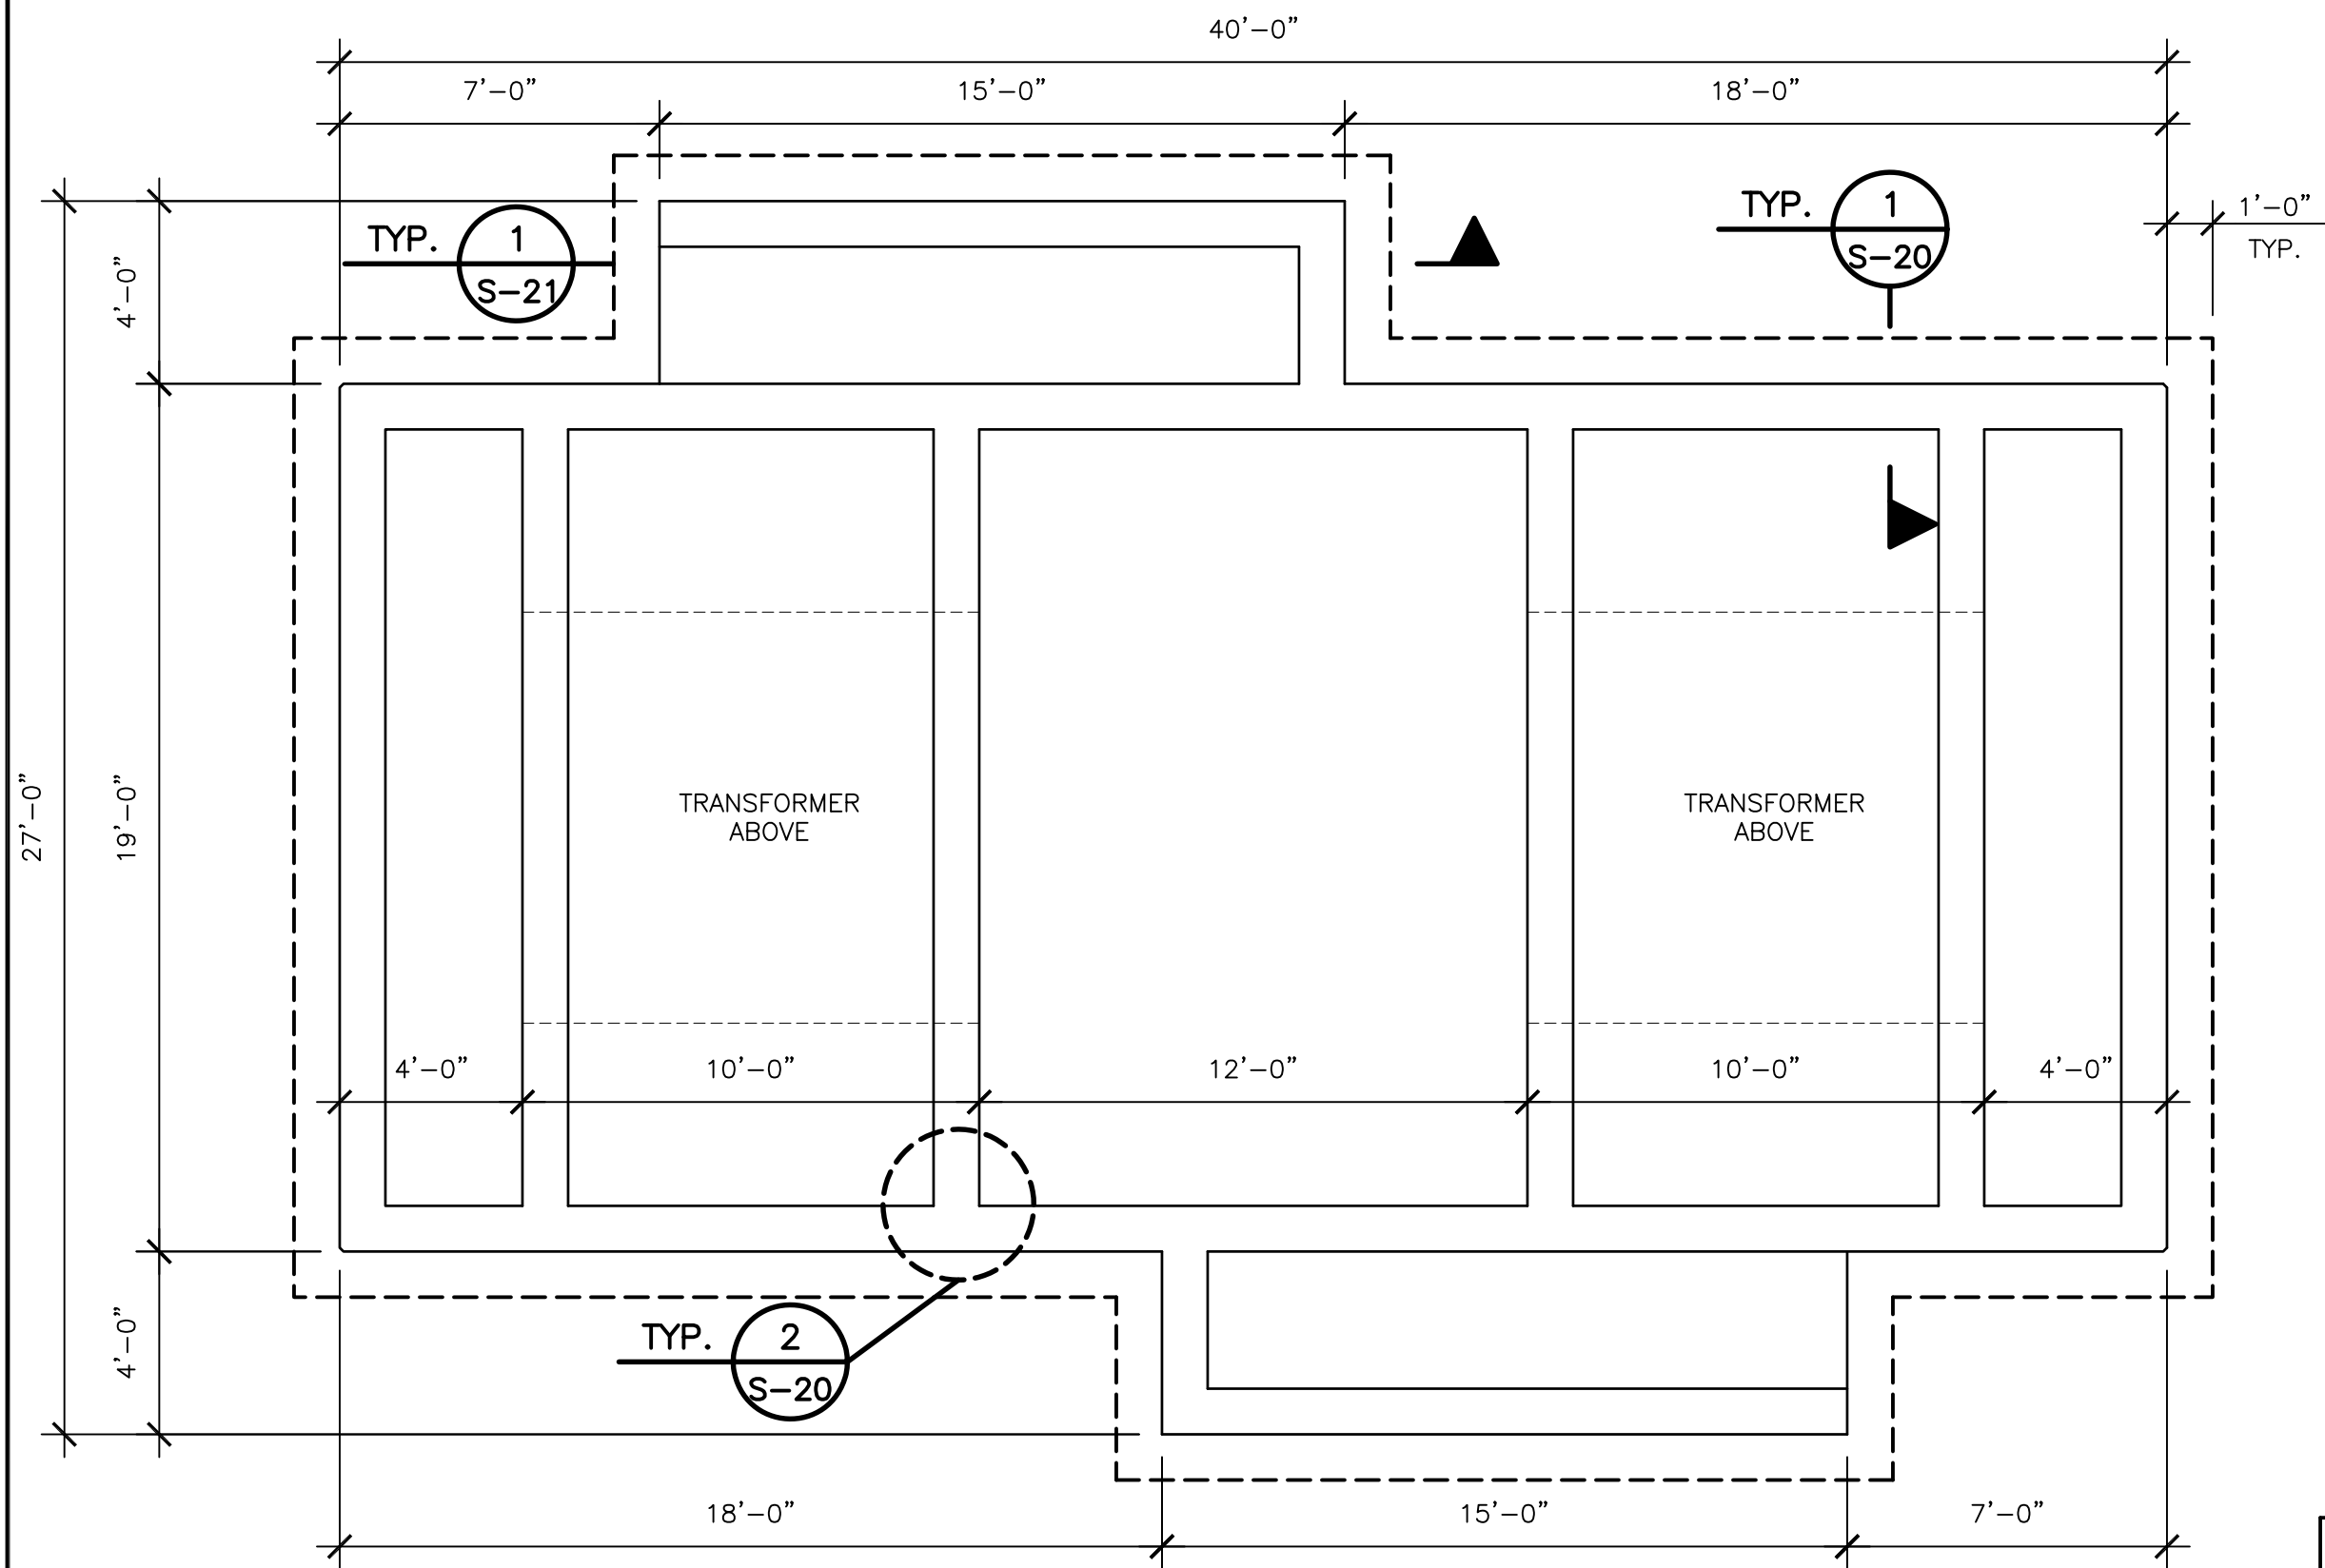


1 TRANSFORMER PLATFORM FOUNDATION PLAN
S-10 SCALE: 1/4" = 1'-0"

3434 colwell avenue suite 100, tampa, florida 33614
phone 813.282.9184 fax 813.282.9184
www.billerreinhardt.com

TO THE BEST OF THE ENGINEER'S KNOWLEDGE,
THE PLANS AND SPECIFICATIONS COMPLY WITH
THE APPLICABLE MINIMUM BUILDING CODES.

ROBERT J. REINHART
FL. P.E. NO. 50076

B080-034

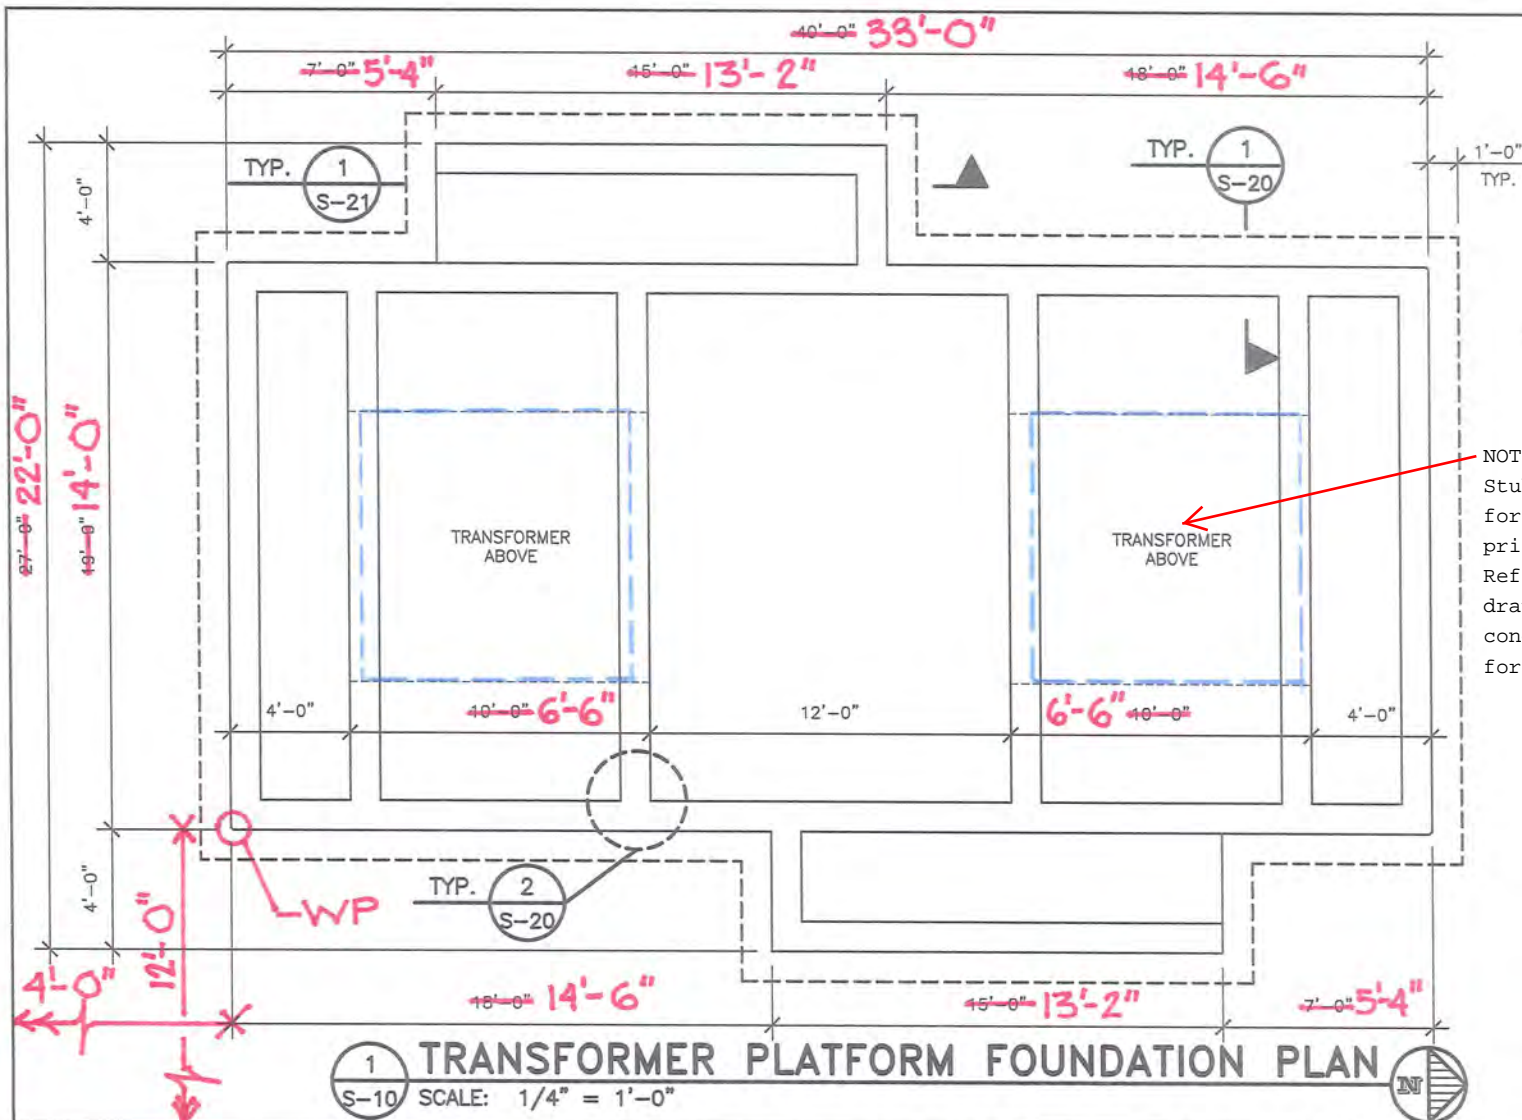

NOTE:

Stub-up electrical conduits for transformer connections prior to pouring concrete. Reference the electrical drawings for the number of conduits and sizes. Typical for each transformer.

1 TRANSFORMER PLATFORM FOUNDATION PLAN
S-10 SCALE: 1/4" = 1'-0"

billerreinhardt
SPECIAL GROUP, INC.
3434 Colwell Avenue, Suite 100, Tampa, Florida 33614
Telephone: 813.902.2203 Fax: 813.931.5200
email: info@billerreinhardt.com
State of Florida Certificate of Authorization No. 9149
ROBERT J. REINHART
FL P.E. NO. 50076



Engineering Design
Technologies Corp.
P.O. Box 152403
Tampa, FL 33684-2403
813.289.8080
813.282.9184 FAX
engineering@edt1.com

Certificate of Authorization Number: 4795

CITY OF TAMPA
WASTEWATER DEPARTMENT


KRAUSE
TRANSFORMER

RED LINES

DRAWN: RC, KC
DESIGN: RR
QC: RR
DATE: 06/03/14

Sheet S-10A

Revised S-10

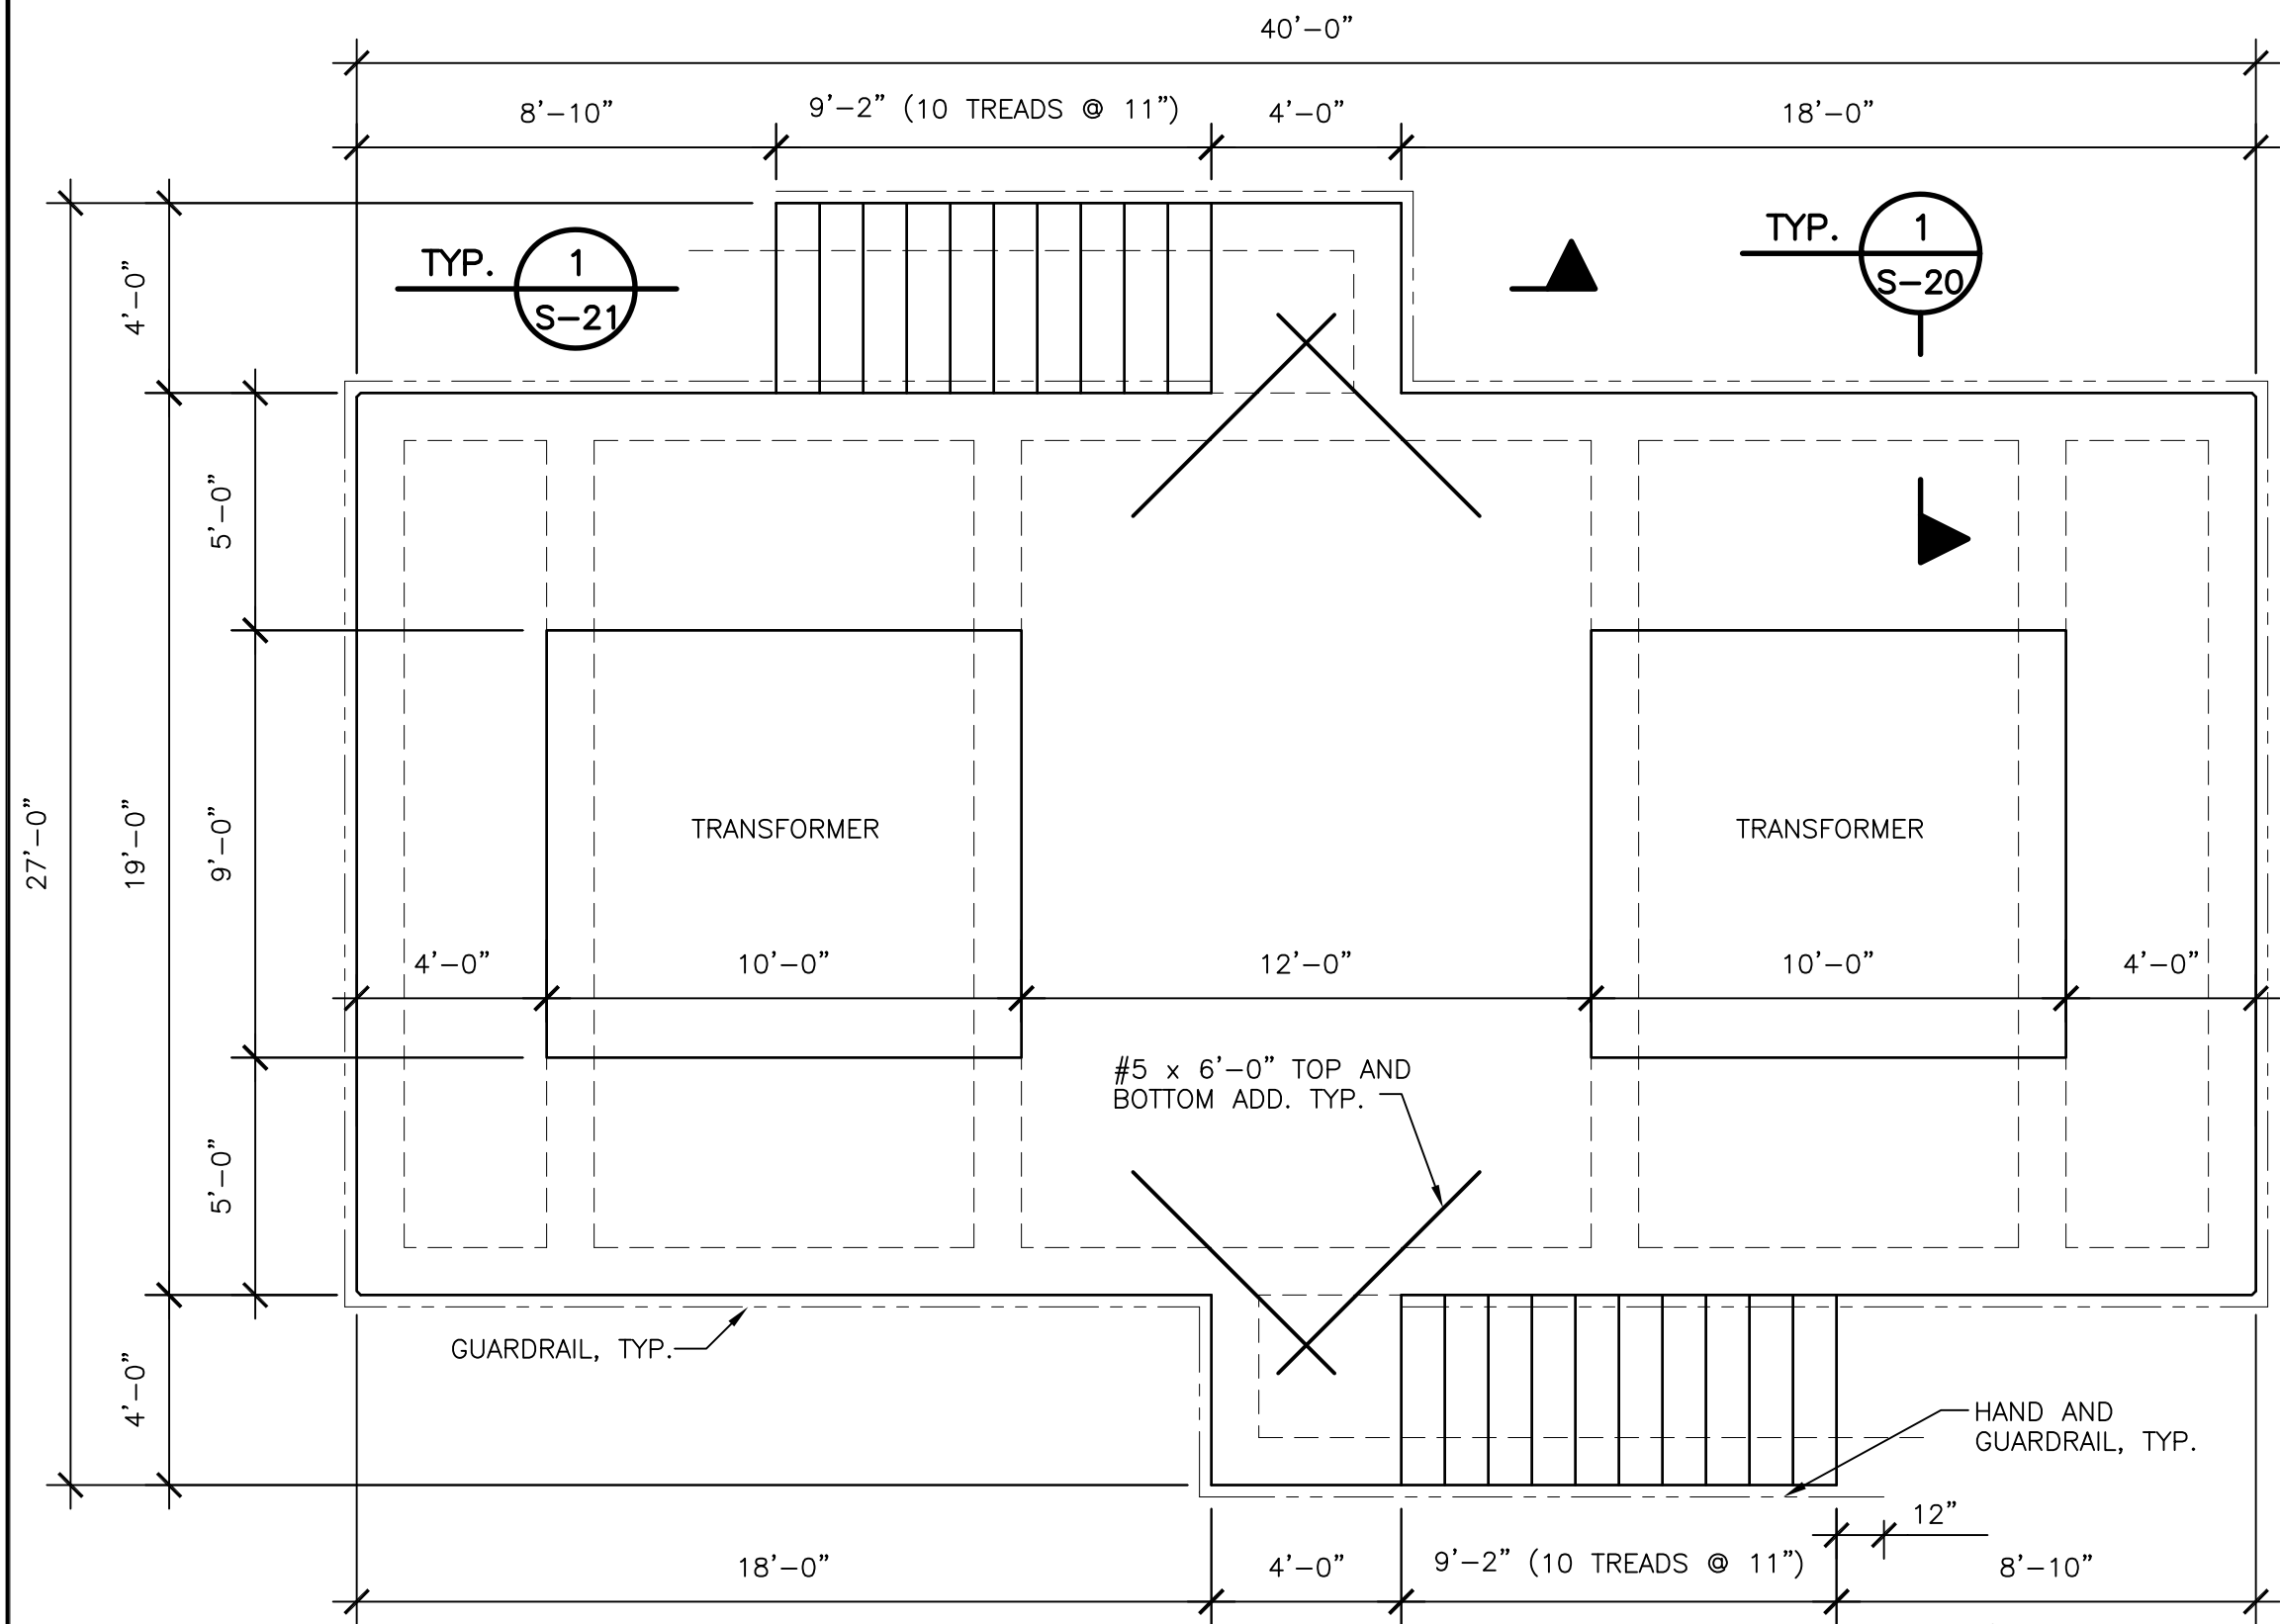


1 TRANSFORMER PLATFORM PLAN
S-11 SCALE: 1/4" = 1'-0"

3434 colwell avenue suite 100, tampa, florida 33614
telephone : 813.908.7203 fax : 813.931.5200

TO THE BEST OF THE ENGINEER'S KNOWLEDGE,
THE PLANS AND SPECIFICATIONS COMPLY WITH
THE APPLICABLE MINIMUM BUILDING CODES.

ROBERT J. REINHART
FL. P.E. NO. 50076

B080-036

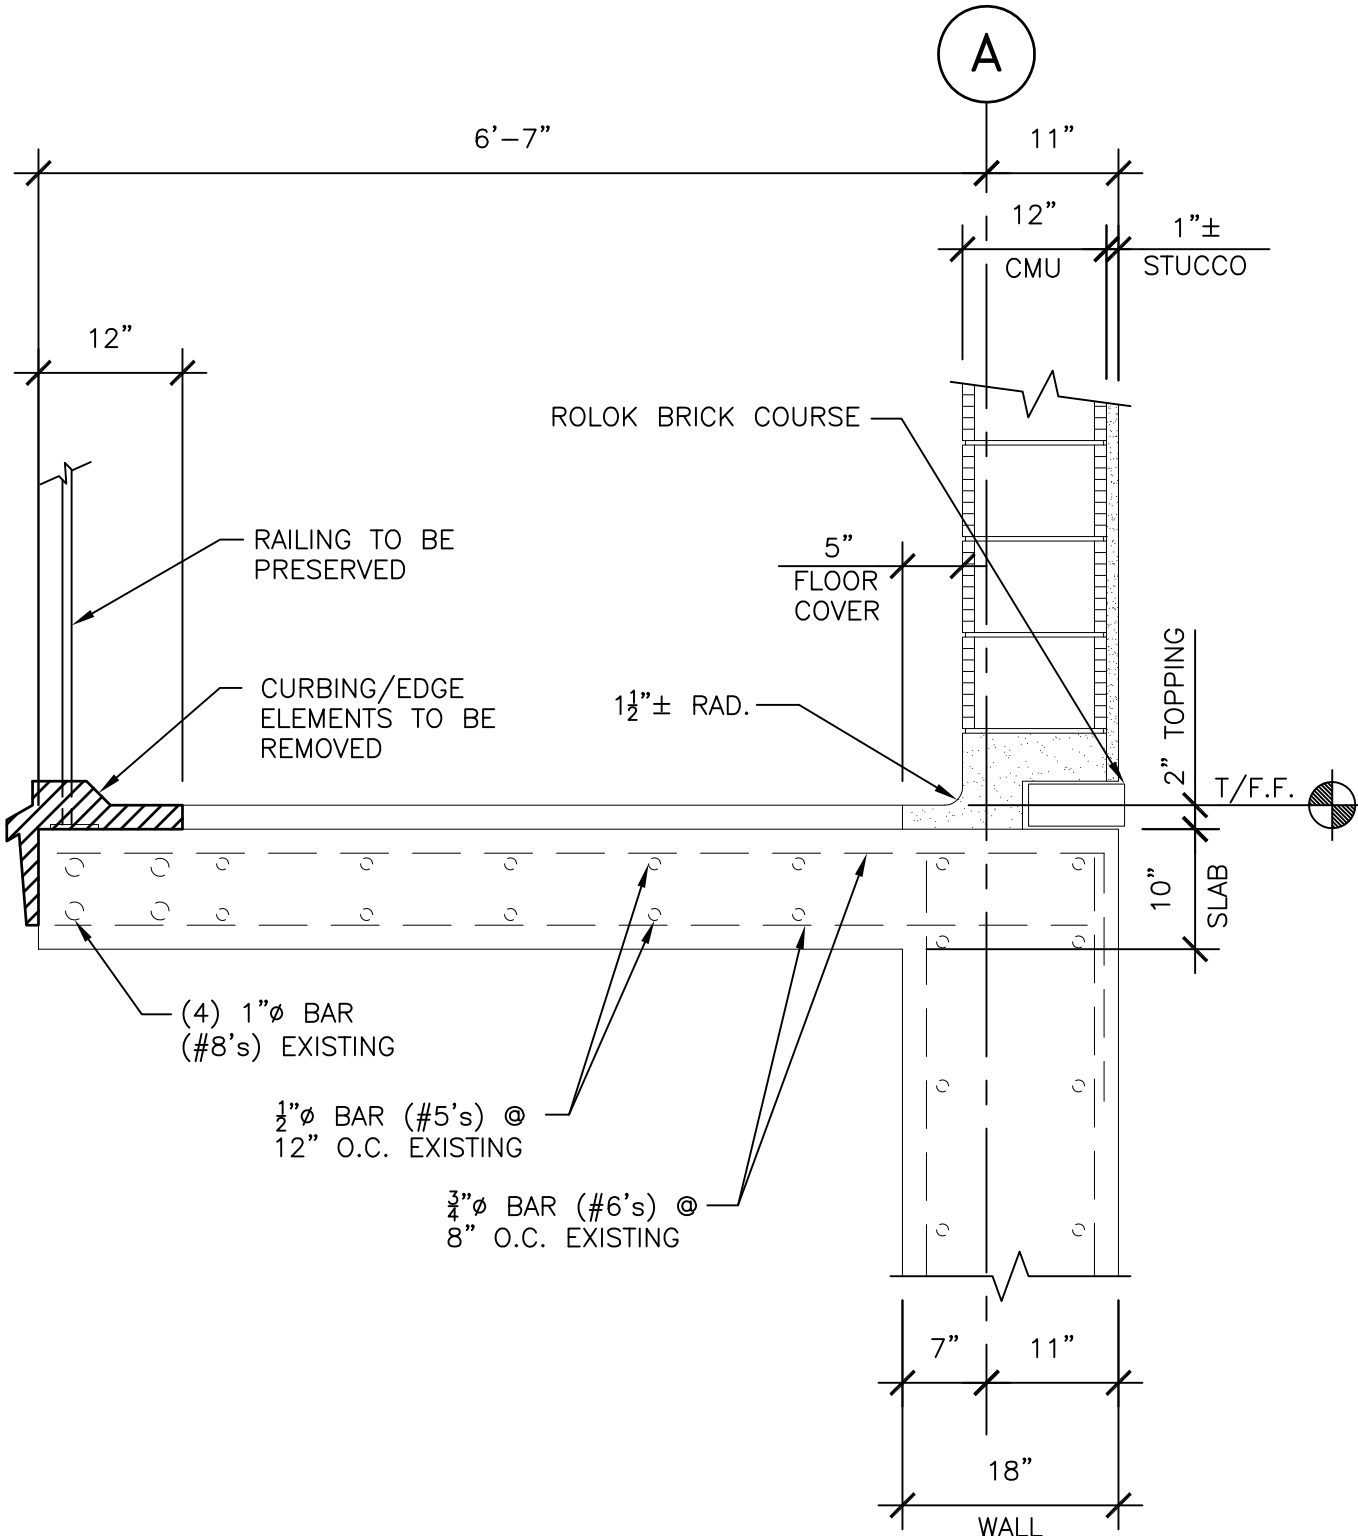

1 EXISTING PLATFORM DEMOLITION SECTION
S-12 SCALE: 3/4" = 1'-0"



TO THE BEST OF THE ENGINEER'S KNOWLEDGE
THE PLANS AND SPECIFICATIONS COMPLY WITH
THE APPLICABLE MINIMUM BUILDING CODES

ROBERT J. REINHART
FL. P.E. NO. 50076



**Engineering Design
Technologies Corp.**
P.O. Box 152403
Tampa, FL 33684-2403
813.289.8080
813.282.9184 FAX
engineering@edt1.com

CITY of TAMPA
WASTEWATER DEPARTMENT

KRAUSE PS REHABILITATION

SECTIONS & DETAILS


RED LINES

1	1/27/	NO CHANGES
NO	DAT	

DRAWN: RC, KC
DESIGN: RR
QC: RR
DATE: 06/03/14

SHEET S-12

Certificate of Authorization Number: 4795

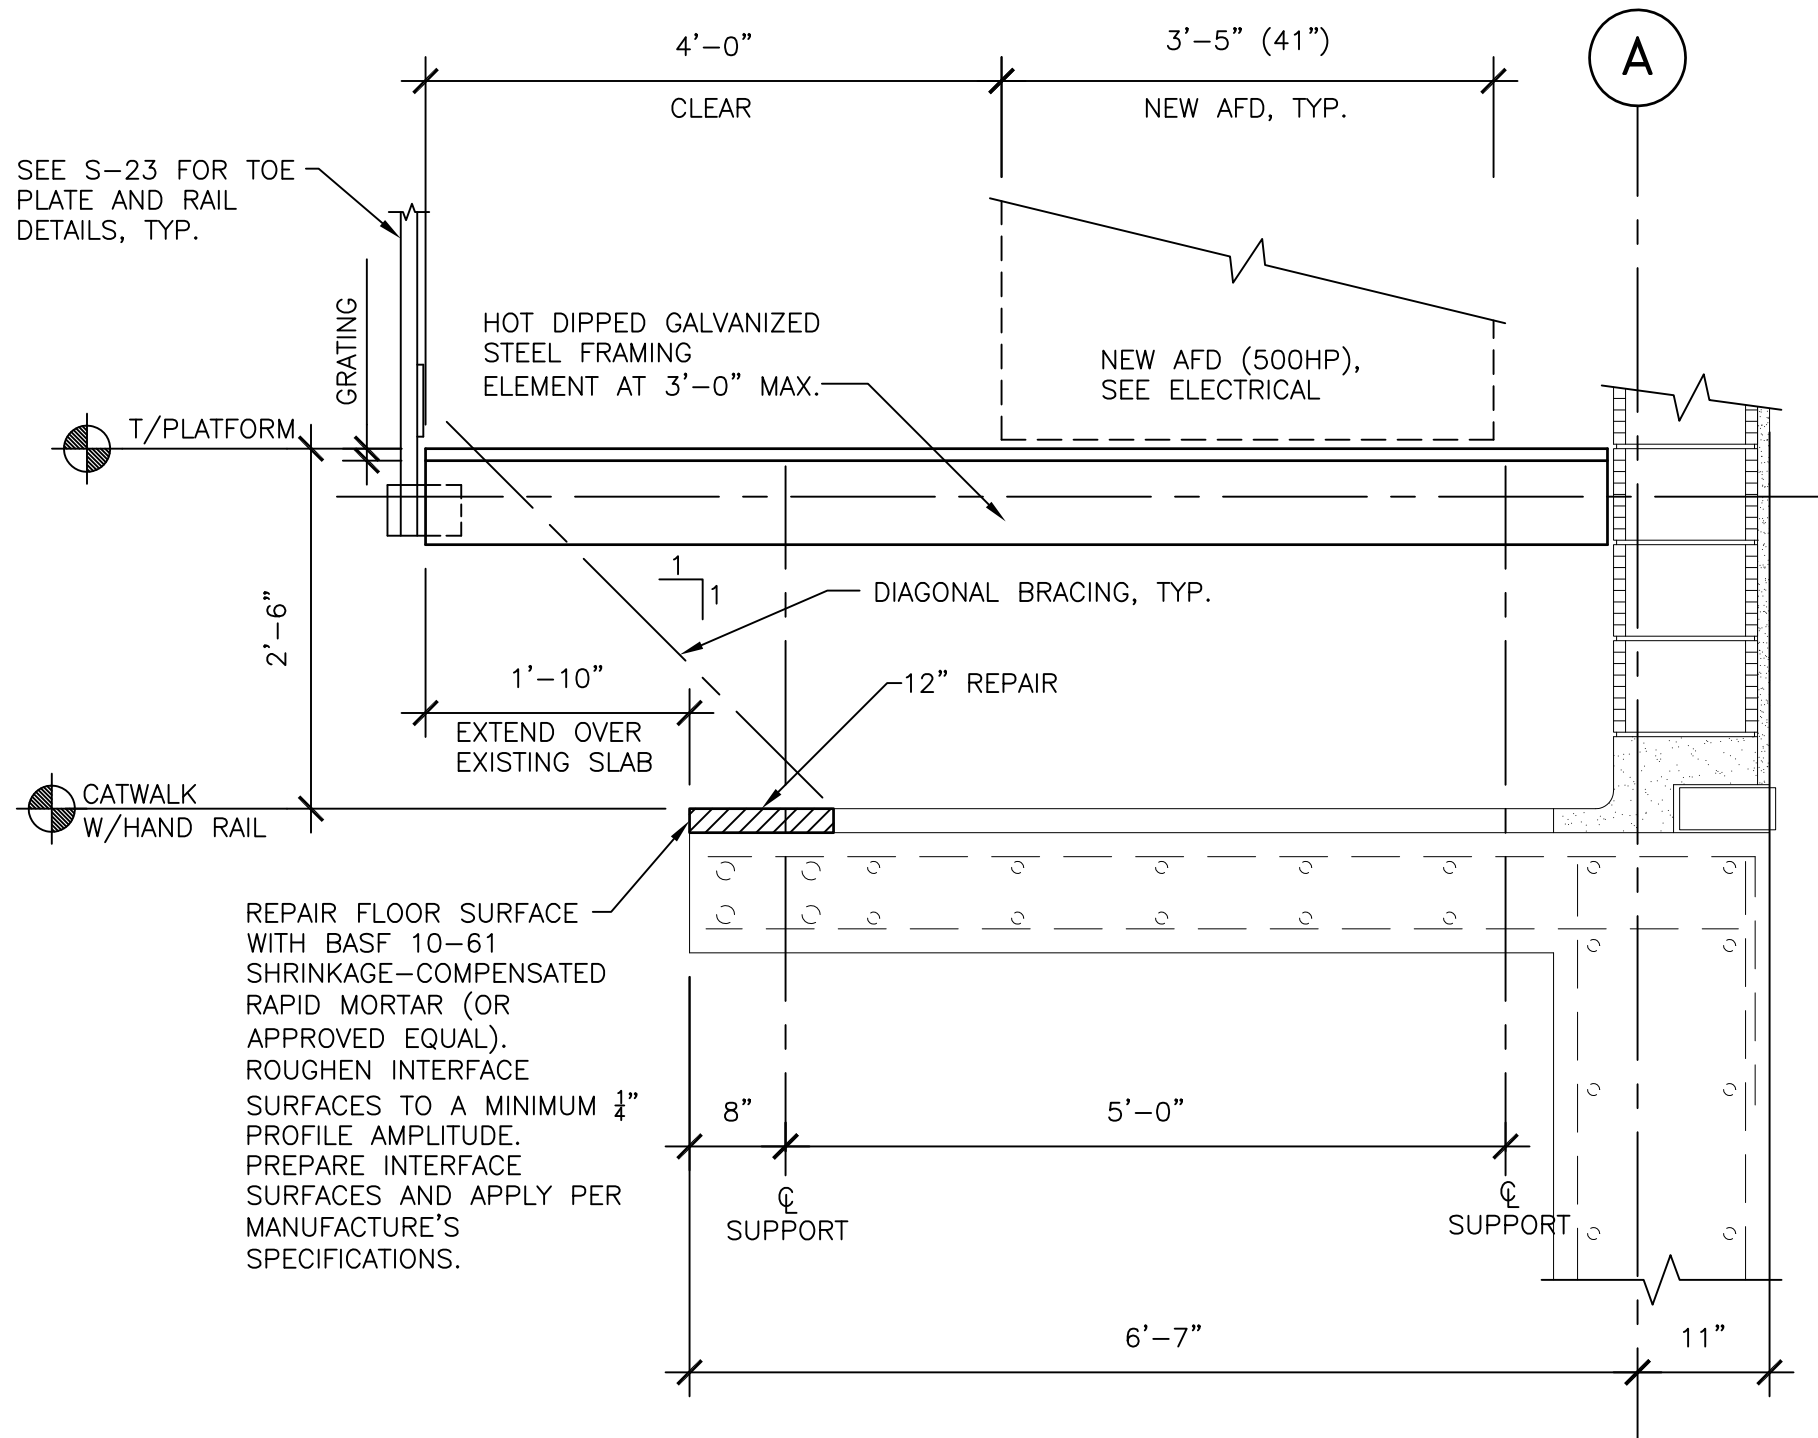

INTERIOR ELEVATED ELECTRICAL PLATFORM

- SEE DRAWING S-3 AND S-4 FOR HOT DIPPED GALVANIZED WELDED STEEL GRATING SPECIFICATIONS.
- SEE DRAWING S-4 FOR STRUCTURAL STEEL SPECIFICATIONS.
- SEE DRAWING S-22 FOR STEEL STAIRS
- SEE DRAWING S-23 FOR PIPE HANDRAIL
- MAXIMUM SPAN (SPACING OF SUPPORTING STEEL ELEMENTS) OF GRATING IS 3'-0". MAXIMUM SUPERIMPOSED LIVE LOAD IS 150 PSF (AREAS AROUND AFD'S).
- AFD'S ARE APPROXIMATELY 5000 LBS EACH.
- THE CONTRACTOR SHALL SUBMIT SHOP DRAWINGS FOR REVIEW AND APPROVAL PRIOR TO FABRICATION. SHOP DRAWINGS ARE TO SHOW COMPLETE LAYOUT; PLAN VIEWS, ELEVATIONS, CONNECTIONS, DETAILS FOR FABRICATION AND ATTACHMENT TO OTHER ELEMENTS, AND OTHER INSTALLATION DETAILS. INCLUDE CALCULATIONS AND MEASUREMENTS SIGNED AND SEALED BY A FLORIDA REGISTERED PROFESSIONAL ENGINEER RESPONSIBLE FOR THE SYSTEMS' STRUCTURAL DESIGN.
- COORDINATE PLATFORM PLAN CONFIGURATION WITH DRAWING E-6. LOCATION OF STAIRS, FINAL DIMENSION REQUIREMENTS, ELECTRICAL COMPONENTS, ETC., SHALL BE COORDINATED WITH MECHANICAL AND ELECTRICAL DRAWINGS.

1 NEW PLATFORM SECTION

S-13 SCALE: 3/4" = 1'-0"

3434 colwell avenue suite 100, tampa, florida 33614
telephone : 813.908.7203 fax : 813.931.5200
email : info@billerreinhardt.com
State of Florida Certificate of Authorization No. 9149

TO THE BEST OF THE ENGINEER'S KNOWLEDGE, THE PLANS AND SPECIFICATIONS COMPLY WITH THE APPLICABLE MINIMUM BUILDING CODES.

ROBERT J. REINHART
FL. P.E. NO. 50076



Engineering Design Technologies Corp.
P.O. Box 152403
Tampa, FL 33684-2403
813.289.8080
813.282.9184 FAX
engineering@edt1.com

Certificate of Authorization Number: 4795

CITY of TAMPA
WASTEWATER DEPARTMENT

KRAUSE PS REHABILITATION

**SECTIONS &
DETAILS**


RED LINES

NO CHANGES

DRAWN: RC, KC
DESIGN: RR
QC: RR
DATE: 06/03/14

SHEET S-13

1	1/27/14
NO.	DATE

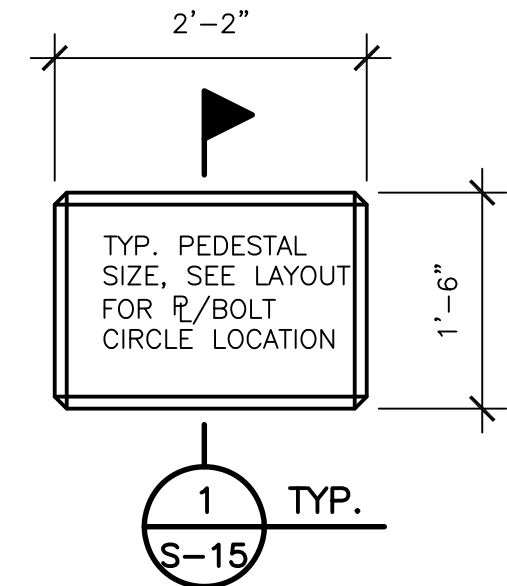

STAINLESS STEEL BOLTS NOTES:

1. ALL BOLTS SHALL CONFORM TO ASTM F593 STAINLESS STEEL SPECIFICATION, ALLOY TYPE 316, ¾ INCH DIAMETER, UNLESS NOTED OTHERWISE.
2. ALL NUTS AND WASHERS SHALL CONFORM TO ASTM F594 STAINLESS STEEL SPECIFICATION, ALLOY TYPE 316, UNLESS NOTED OTHERWISE.

149 ROBERT J. REINHART
FL. P.E. NO. 50076

RAWN: RC, KC

DESIGN: RR

QC: _____ RR _____

DATE: 06/03/14

SHEET S-14

1 SETTING PLAN – BASIC PUMP 20" IM2434WD (350 HP)
S-14 SCALE: 3/4" = 1'-0"

SCALE: $3/4" = 1'-0"$



Certificate of Authorization Number: 4795

**- Engineering Design
Technologies Corp.**
P.O. Box 152403
Tampa, FL 33684-2403
813.289.8080
813.282.9184 FAX
engineering@edt1.com

CITY of TAMPA
WASTEWATER DEPARTMENT


KRAUSE PS REHABILITATION

SECTIONS & DETAILS


1	1/27/15
NO.	DATE

Changes
See S-14A

RED LINES

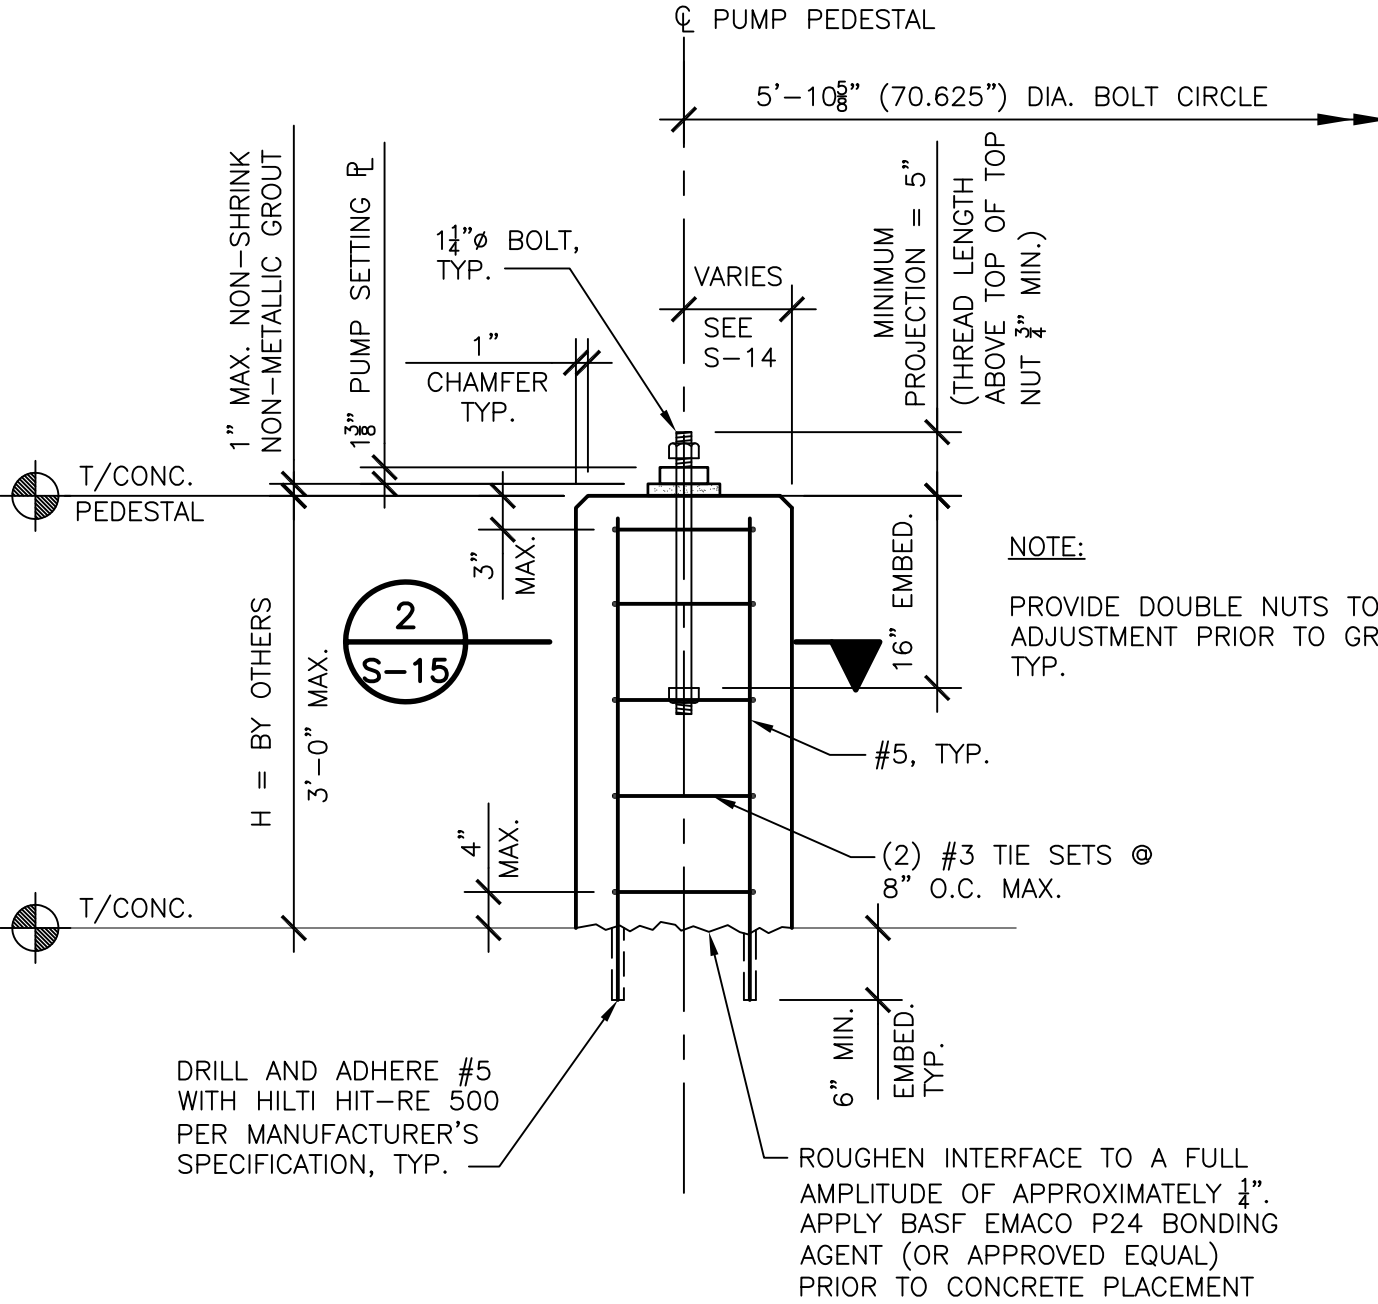

1 SECTION - PUMP PEDESTAL
S-15 SCALE: 3/4" = 1'-0"

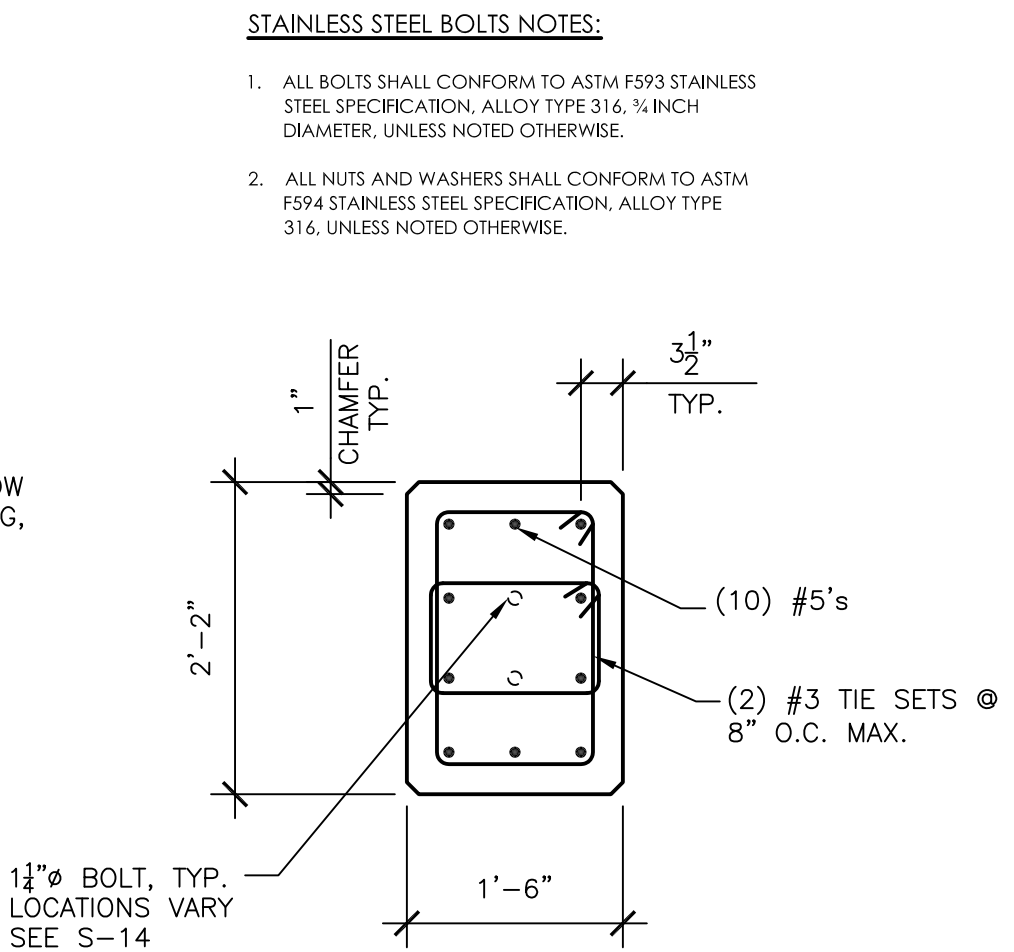

2 SECTION - PUMP PEDESTAL
S-15 SCALE: 3/4" = 1'-0"

- STAINLESS STEEL BOLTS NOTES:
1. ALL BOLTS SHALL CONFORM TO ASTM F593 STAINLESS STEEL SPECIFICATION, ALLOY TYPE 316, 3/4 INCH DIAMETER, UNLESS NOTED OTHERWISE.
 2. ALL NUTS AND WASHERS SHALL CONFORM TO ASTM F594 STAINLESS STEEL SPECIFICATION, ALLOY TYPE 316, UNLESS NOTED OTHERWISE.

STAINLESS STEEL BOLTS NOTES:

1. ALL BOLTS SHALL CONFORM TO ASTM F593 STAINLESS STEEL SPECIFICATION, ALLOY TYPE 316, 3/4" INCH DIAMETER, UNLESS NOTED OTHERWISE.
2. ALL NUTS AND WASHERS SHALL CONFORM TO ASTM F594 STAINLESS STEEL SPECIFICATION, ALLOY TYPE 316, UNLESS NOTED OTHERWISE.

PUMP FOOT \varnothing SEE 1/S-14 LOCATIONS AND CONNECTION (CONTRACTOR TO COORDINATE WITH PUMP MANUFACTURER)

PUMP SOLE \varnothing (CONTRACTOR TO COORDINATE WITH PUMP MANUFACTURER)

NOTE:

PROVIDE DOUBLE NUTS TO ALLOW ADJUSTMENT PRIOR TO GROUTING, TYP.

#5, TYP.

(3) #3 TIE SETS @ 8" O.C. MAX.

(6) - #5's
(\varnothing OF PEDESTAL)

2 SECTION - PUMP PEDESTAL

S-15 SCALE: 3/4" = 1'-0"

1 SECTION - PUMP PEDESTAL

S-15 SCALE: 3/4" = 1'-0"

1" MAX. NON-SHRINK
NON-METALLIC GROUT

T/CONC.
PEDESTAL

H = BY OTHERS
(3'-0" MAX.)

(CONTRACTOR TO COORDINATE
WITH PUMP MANUFACTURER)

2
S-15

MINIMUM
PROJECTION = 5"
(THREAD LENGTH
ABOVE TOP OF TOP
NUT 3/4" MIN.)

\varnothing 1 1/4" BOLT

24"

8 1/8"

3" MAX.

16" EMBED.

4" MAX.

6" MIN.
EMBED.
TYP.

CHAMFER
BASE OVER
SUMP

AT SUMP,
(2) - #5s
CONT.


#5s
TO ALIGN
WITH MAIN
PIER REINF.
(3 SIDES)

DRILL AND ADHERE #5
WITH HILTI HIT-RE 500
PER MANUFACTURER'S
SPECIFICATION, TYP.

#3 W/180° HOOKS
EACH END AND ALIGN
WITH MAIN PIER
REINFORCING TIES, TYP.

TEMPORARY FORM IN SUMP OPENING
ROUGHEN INTERFACE TO A FULL
AMPLITUDE OF APPROXIMATELY 1/4".
APPLY BASF EMACO P24 BONDING
AGENT (OR APPROVED EQUAL)
PRIOR TO CONCRETE PLACEMENT

#5 BENT BARS @ SUMP

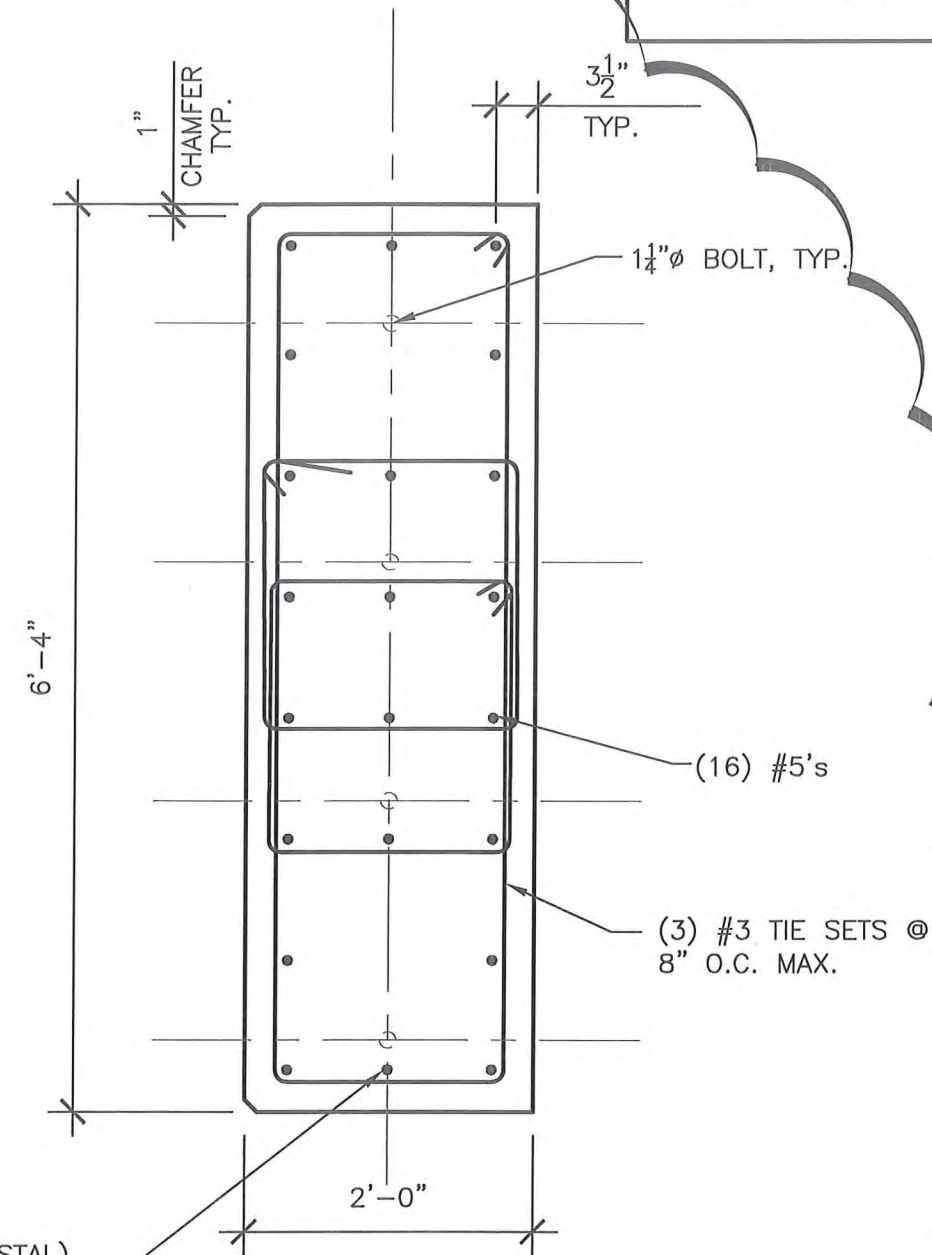

billerreinhardt
ENGINEERING GROUP INC.
3434 colwell avenue suite 100, tampa, florida 33614
telephone : 813.908.7203 fax : 813.931.5200
email : info@billerreinhardt.com
State of Florida Certificate of Authorization No. 9149

TO THE BEST OF THE ENGINEER'S KNOWLEDGE
THE PLANS AND SPECIFICATIONS COMPLY WITH
THE APPLICABLE MINIMUM BUILDING CODES
ROBERT J. REINHART
FL. P.E. NO. 50076

KRAUSE PS REHABILITATION

SECTIONS &
DETAILS

RED LINES

2 4/10/15 PUMP PIERS FOR ADDED SOLE PLATE
1 1/27/11
NO. DATE

DRAWN: RC, KC
DESIGN: RR
QC: RR
DATE: 05/01/14

Revised S-15

Sheet S-15A





Engineering Design
Technologies Corp.
P.O. Box 152403
Tampa, FL 33684-2403
813.289.8080
813.282.9184 FAX
engineering@edt1.com

CITY of TAMPA
WASTEWATER DEPARTMENT

Certificate of Authorization Number: 4795

B080-040

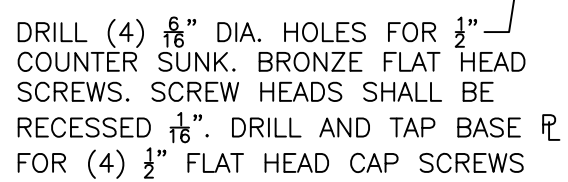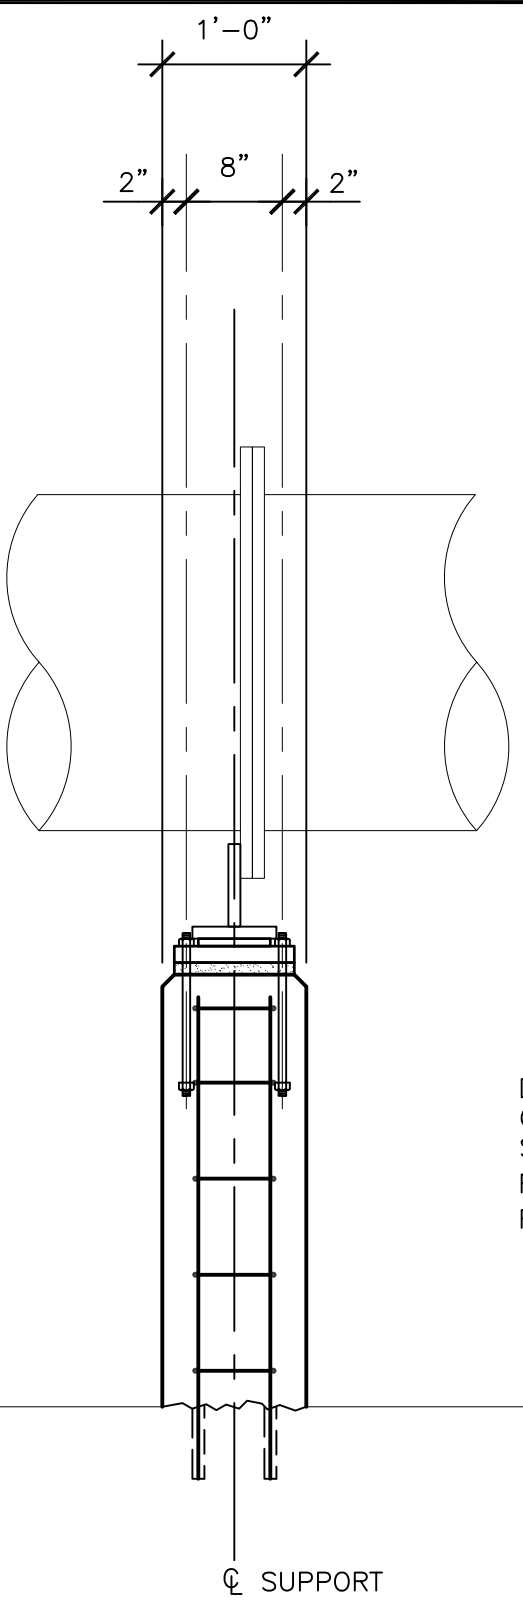


STAINLESS STEEL BOLTS NOTES:

1. ALL BOLTS SHALL CONFORM TO ASTM F593 STAINLESS STEEL SPECIFICATION, ALLOY TYPE 316, ¾ INCH DIAMETER, UNLESS NOTED OTHERWISE.
2. ALL NUTS AND WASHERS SHALL CONFORM TO ASTM F594 STAINLESS STEEL SPECIFICATION, ALLOY TYPE 316, UNLESS NOTED OTHERWISE.

billerreinhardt
ENGINEERING GROUP INC.
3434 colwell avenue suite 100, tampa, florida 33614
telephone : 813.908.7203 fax : 813.931.5200
email : info@billerreinhardt.com
State of Florida Certificate of Authorization No. 9149

ROBERT J. REINHART
FL. P.E. NO. 50076

NOTE: SEE M-3.

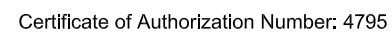

CITY of TAMPA
WASTEWATER DEPARTMENT


SECTIONS & DETAILS

1	1/27/15	NO CHANGES
NO.	DATE	

SHEET S-16

1	1/27/11
NO.	DATE

B080-041

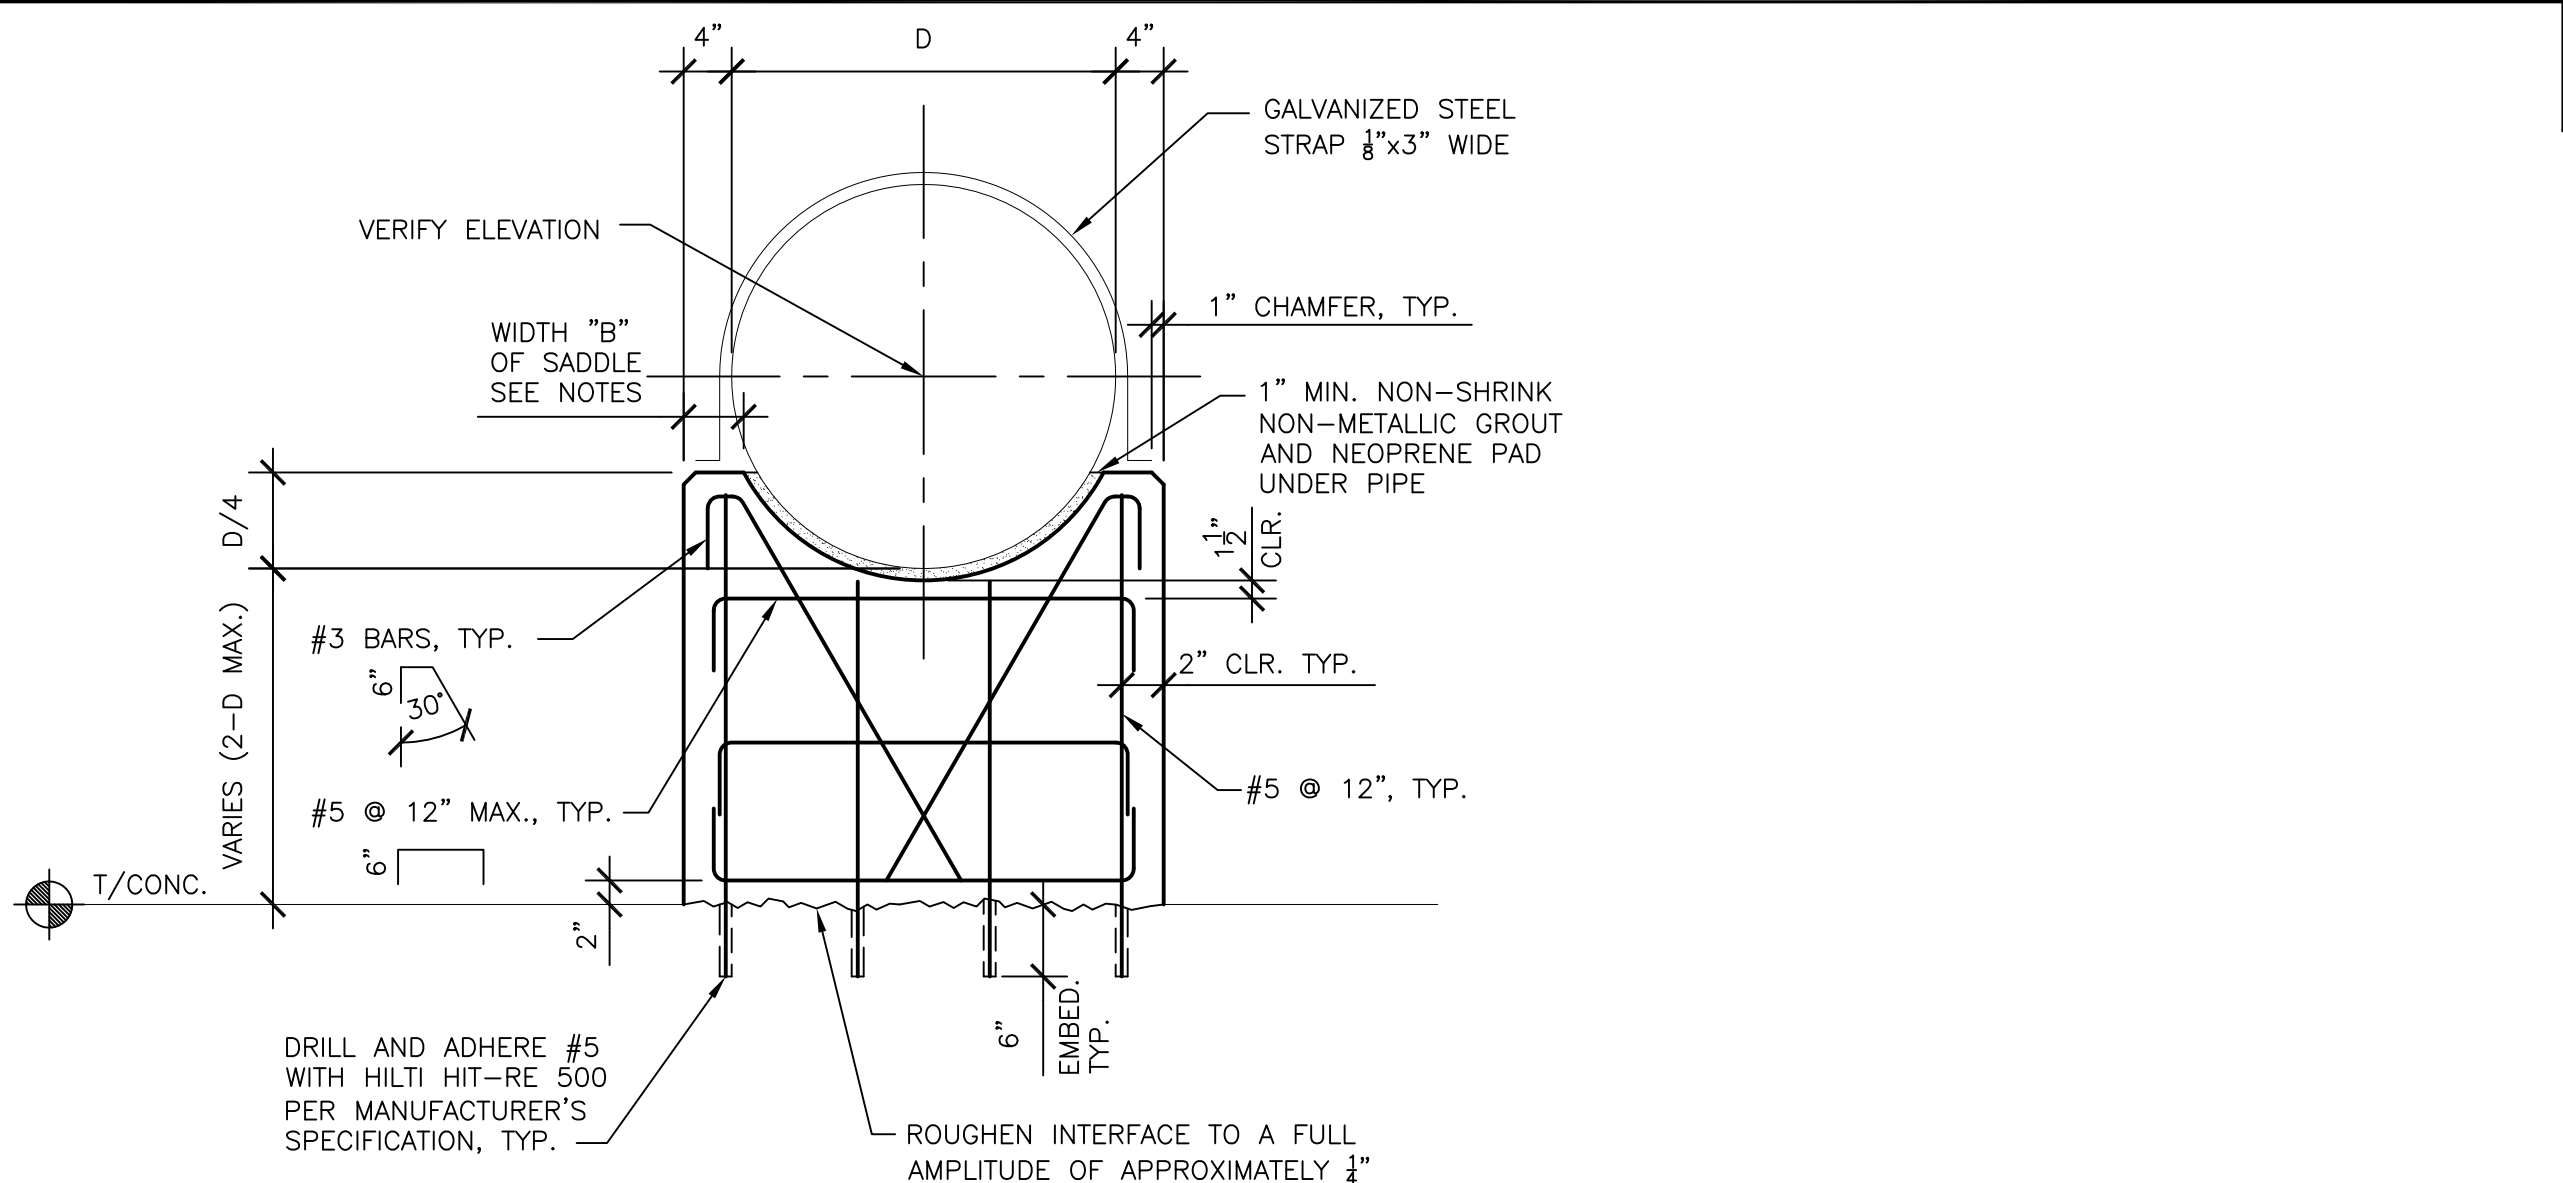

NOTES:

1. THICKNESS "B" OF SADDLE
B = 6" WHEN: D < 12"
B = 8" WHEN: 12" < D < 24"
B = 10" WHEN: 24" < D < 36"
B = 12" WHEN: 36" < D < 48"
2. FOR "B" = 10 OR THICKER, USE 2 LAYERS OF REINFORCING,
TURN HORIZONTAL BARS 90° TO HOOK AROUND VERTICAL
1½" CLEAR OF CONCRETE.

1 CONCRETE PIPE SADDLE DETAIL—SADDLE SUPPORT TYPE B
 S-17 SCALE: N.T.S. NOTE: SEE M-3.

NOTE: SEE M-3.



Certificate of Authorization Number: 4795

**Engineering Design
Technologies Corp.**
P.O. Box 152403
Tampa, FL 33684-2403
813.289.8080
813.282.9184 FAX
engineering@edt1.com

CITY of TAMPA
WASTEWATER DEPARTMENT

KRAUSE PS REHABILITATION

SECTIONS & DETAILS


RED LINES

NO CHANGES

DRAWN: RC, KC
DESIGN: RR
QC: RR
DATE: 06/03/14

SHEET S-17

1	1/27/
NO.	DATE

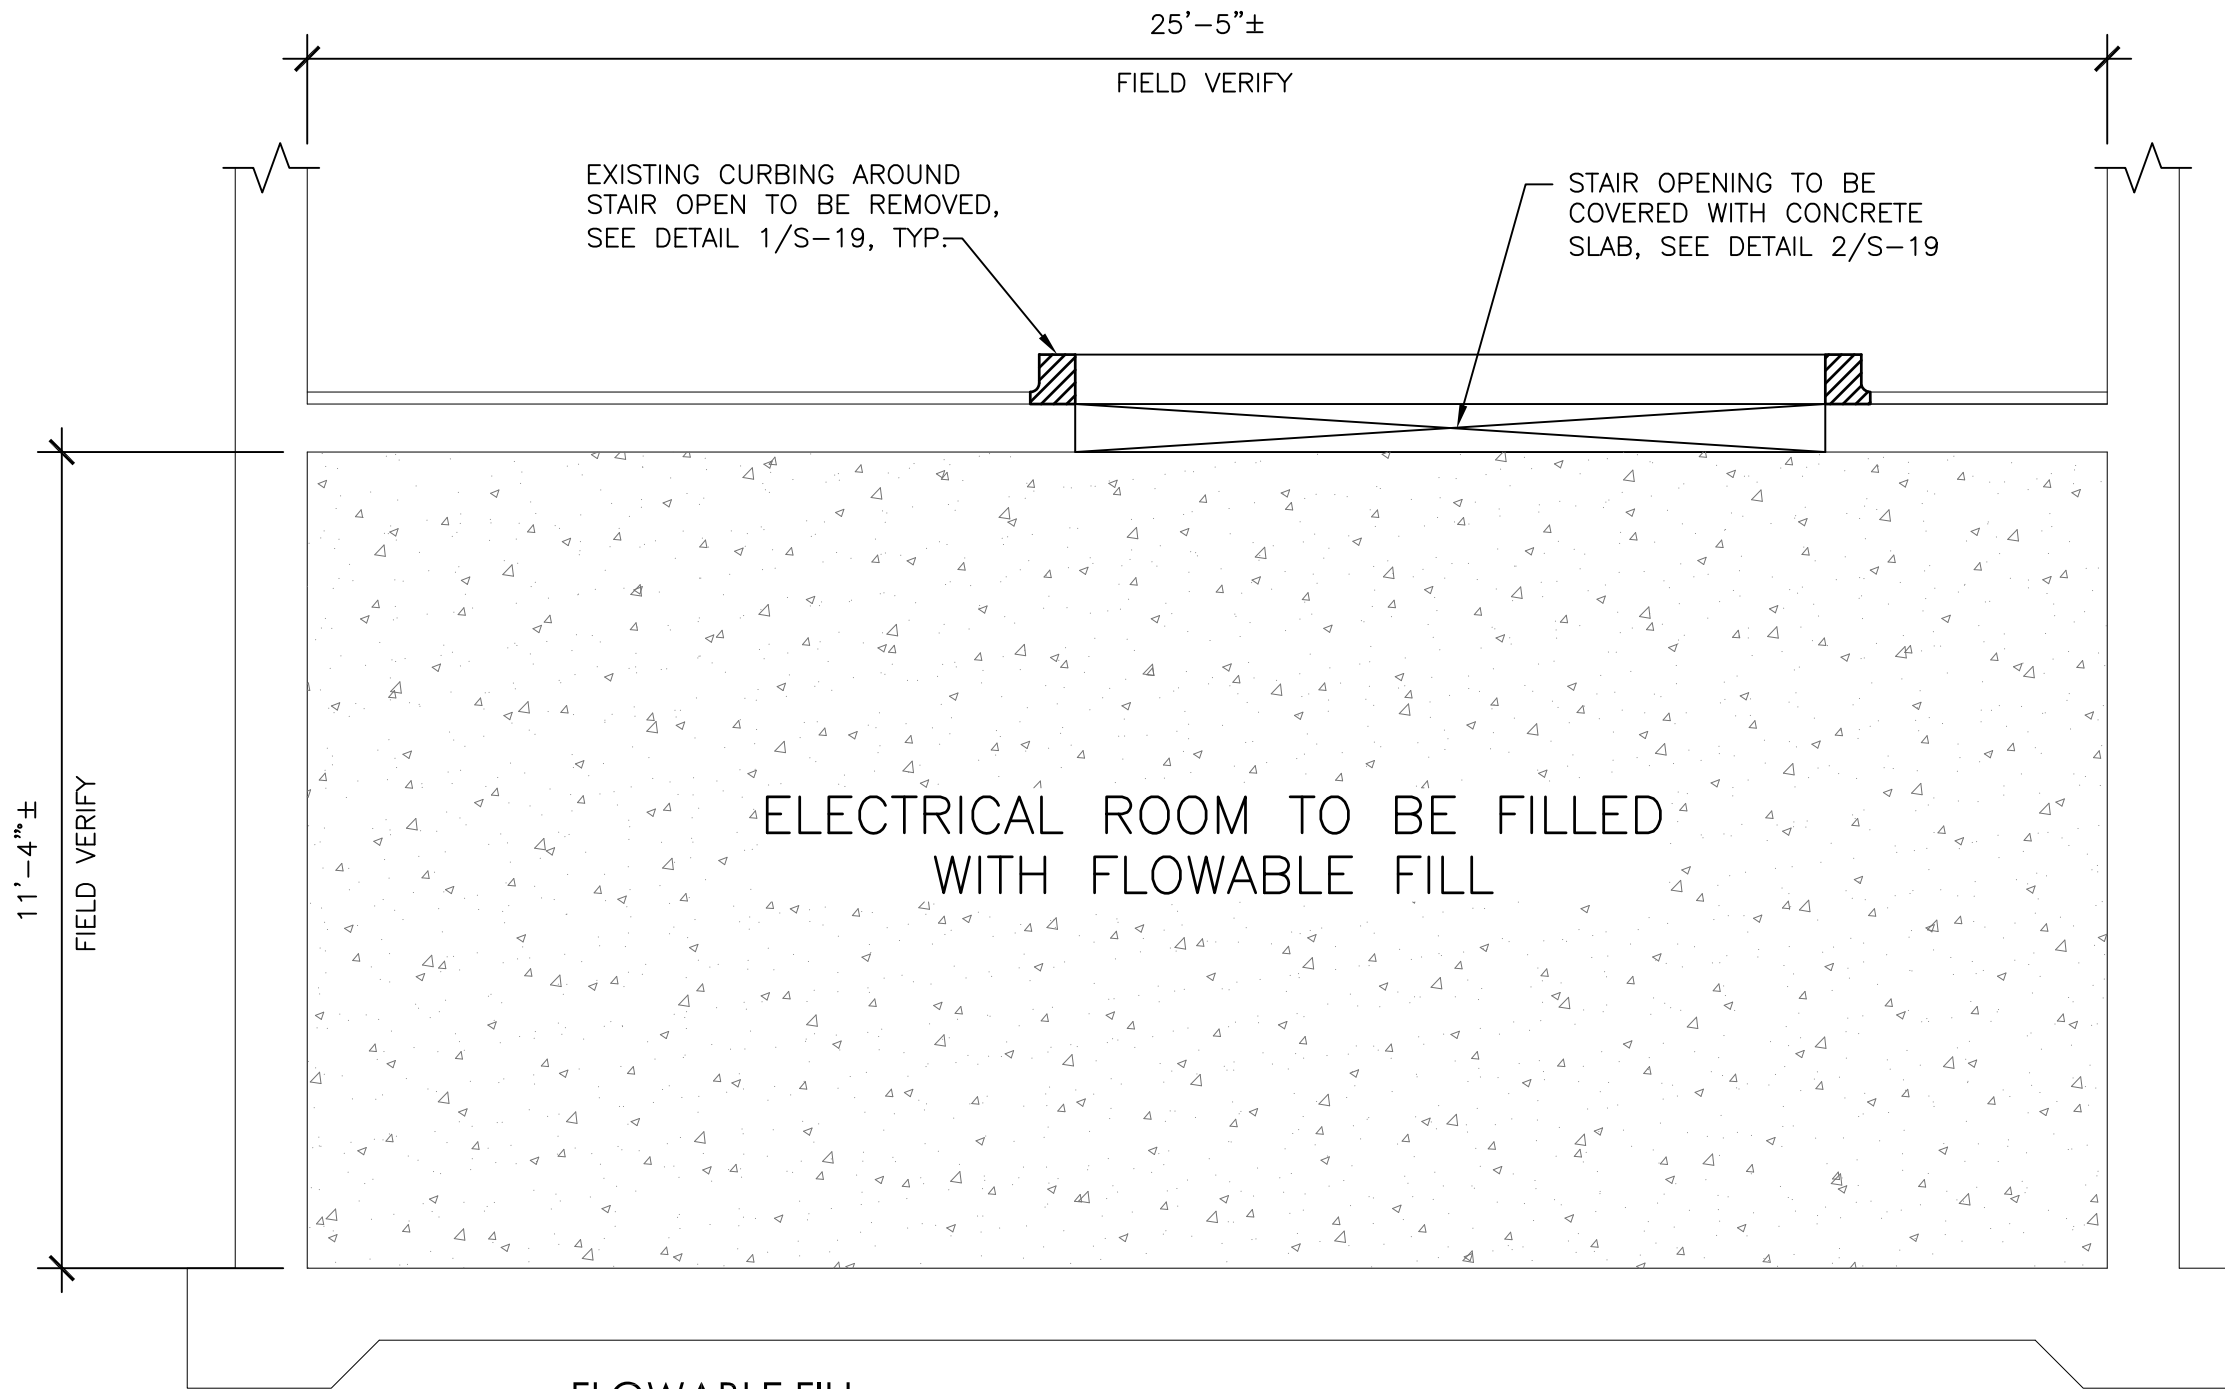

FLOWABLE FILL

1. THE 28-DAY COMPRESSIVE STRENGTH OF THE FLOWABLE FILL SHALL BE 50 TO 100 PSI.
2. THE FLOWABLE FILL IS A CONTROLLED LOW-STRENGTH MATERIAL (CLSM) AND SHALL MEET THE REQUIREMENTS OF ACI 229R (LATEST EDITION).

1
S-18

ELECTRICAL ROOM SECTION

SCALE: 3/8" = 1'-0"

billerreinhardt
ENGINEERING GROUP INC.
3434 colwell avenue suite 100, tampa, florida 33614
telephone : 813.908.7203 fax : 813.931.5200
email : info@billerreinhardt.com
State of Florida Certificate of Authorization No. 9149

TO THE BEST OF THE ENGINEER'S KNOWLEDGE,
THE PLANS AND SPECIFICATIONS COMPLY WITH
THE APPLICABLE MINIMUM BUILDING CODES.

ROBERT J. REINHART
FL. P.E. NO. 50076



**Engineering Design
Technologies Corp.**
P.O. Box 152403
Tampa, FL 33684-2403
813.289.8080
813.282.9184 FAX
engineering@edt1.com

**CITY of TAMPA
WASTEWATER DEPARTMENT**

KRAUSE PS REHABILITATION


**SECTIONS &
DETAILS**

RED LINES


NO CHANGES

DRAWN: RC, KC
DESIGN: RR
C: RR
DATE: 06/03/14

SHEET S-18

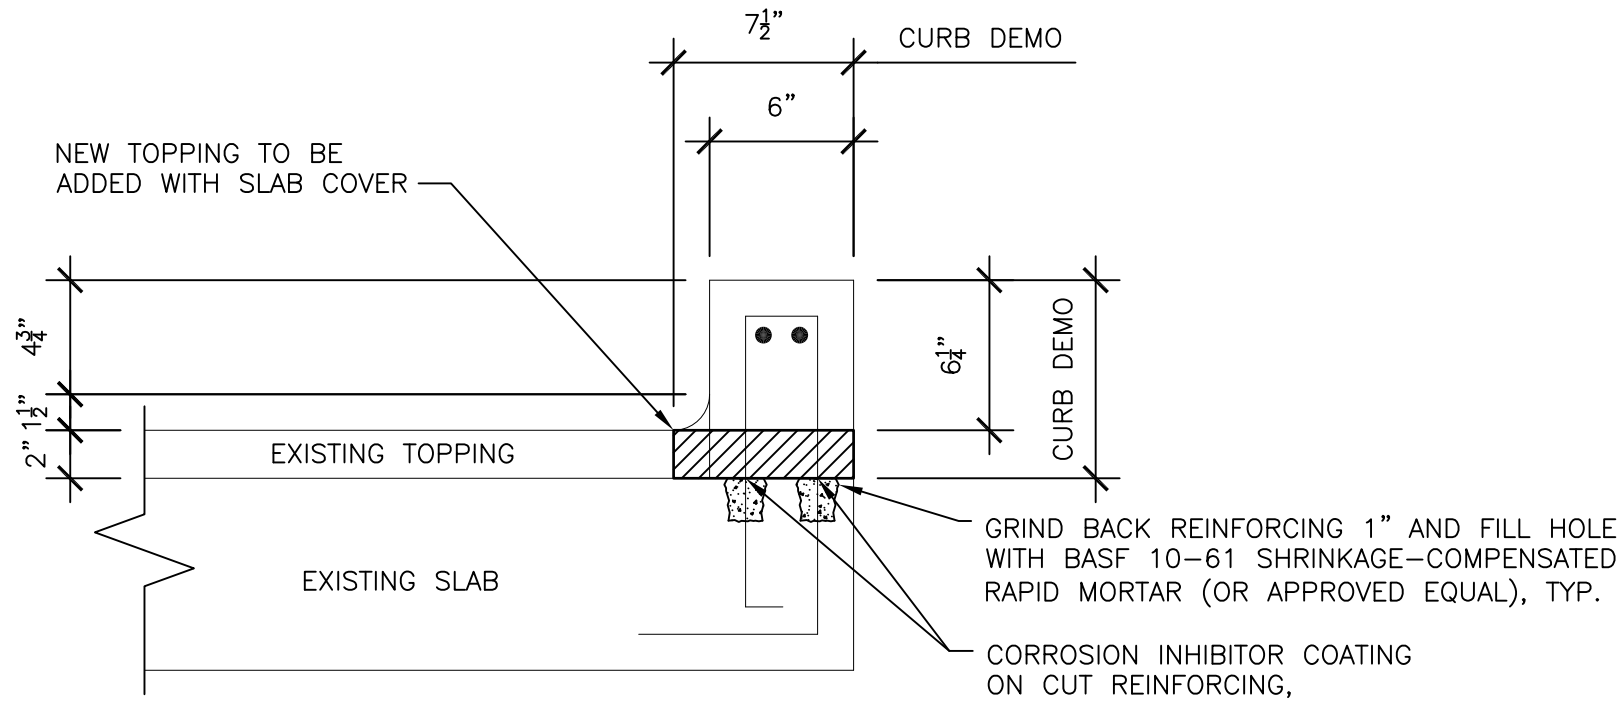

1 CURBING DEMOLITION & REPAIR DETAIL
S-19 SCALE: 1 1/2" = 1'-0"

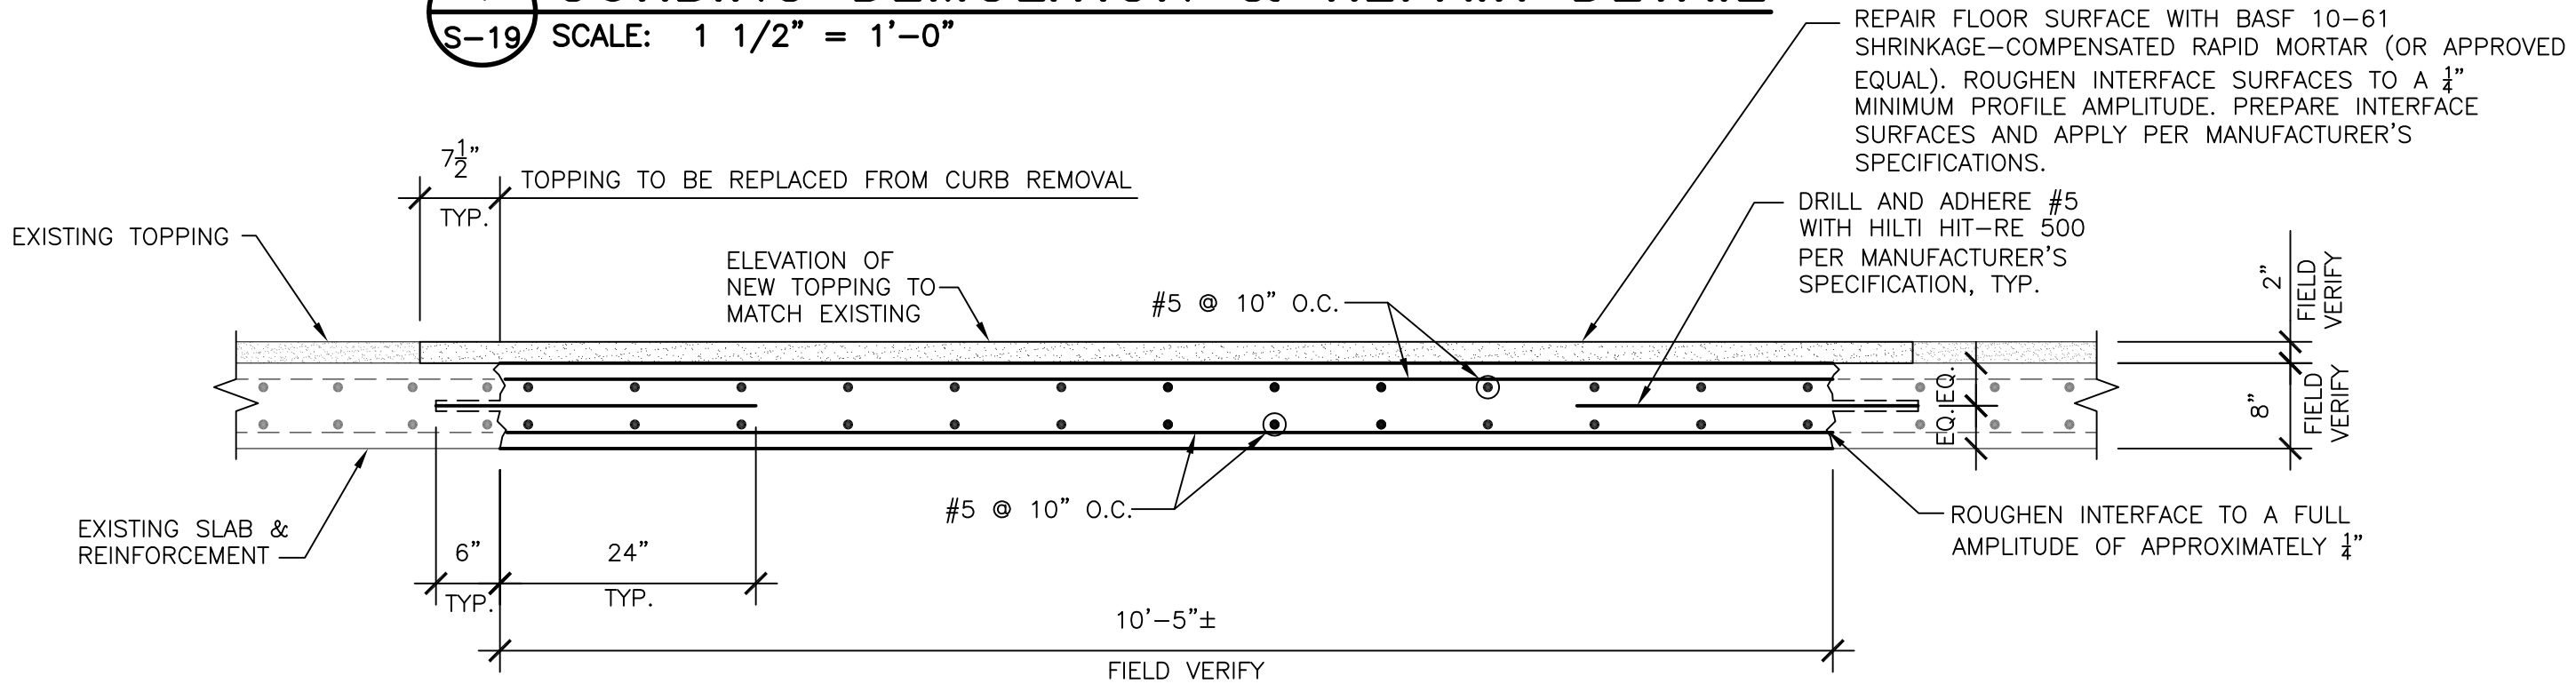

2 SLAB COVER OVER STAIR OPENING DETAIL
S-19 SCALE: 3/4" = 1'-0"

billerreinhardt
ENGINEERING GROUP INC.
3434 colwell avenue suite 100, tampa, florida 33614
telephone : 813.908.7203 fax : 813.931.5200
email : info@billerreinhardt.com
State of Florida Certificate of Authorization No. 9149
ROBERT J. REINHART
FL. P.E. NO. 50076



Engineering Design
Technologies Corp.
P.O. Box 152403
Tampa, FL 33684-2403
813.289.8080
813.282.9184 FAX
engineering@edt1.com

CITY of TAMPA
WASTEWATER DEPARTMENT

KRAUSE PS REHABILITATION

SECTIONS &
DETAILS

RED LINES


NO CHANGES

DRAWN: RC, KC
DESIGN: RR
C: RR
DATE: 06/03/14


SHEET S-19

Certificate of Authorization Number: 4795

B080-044

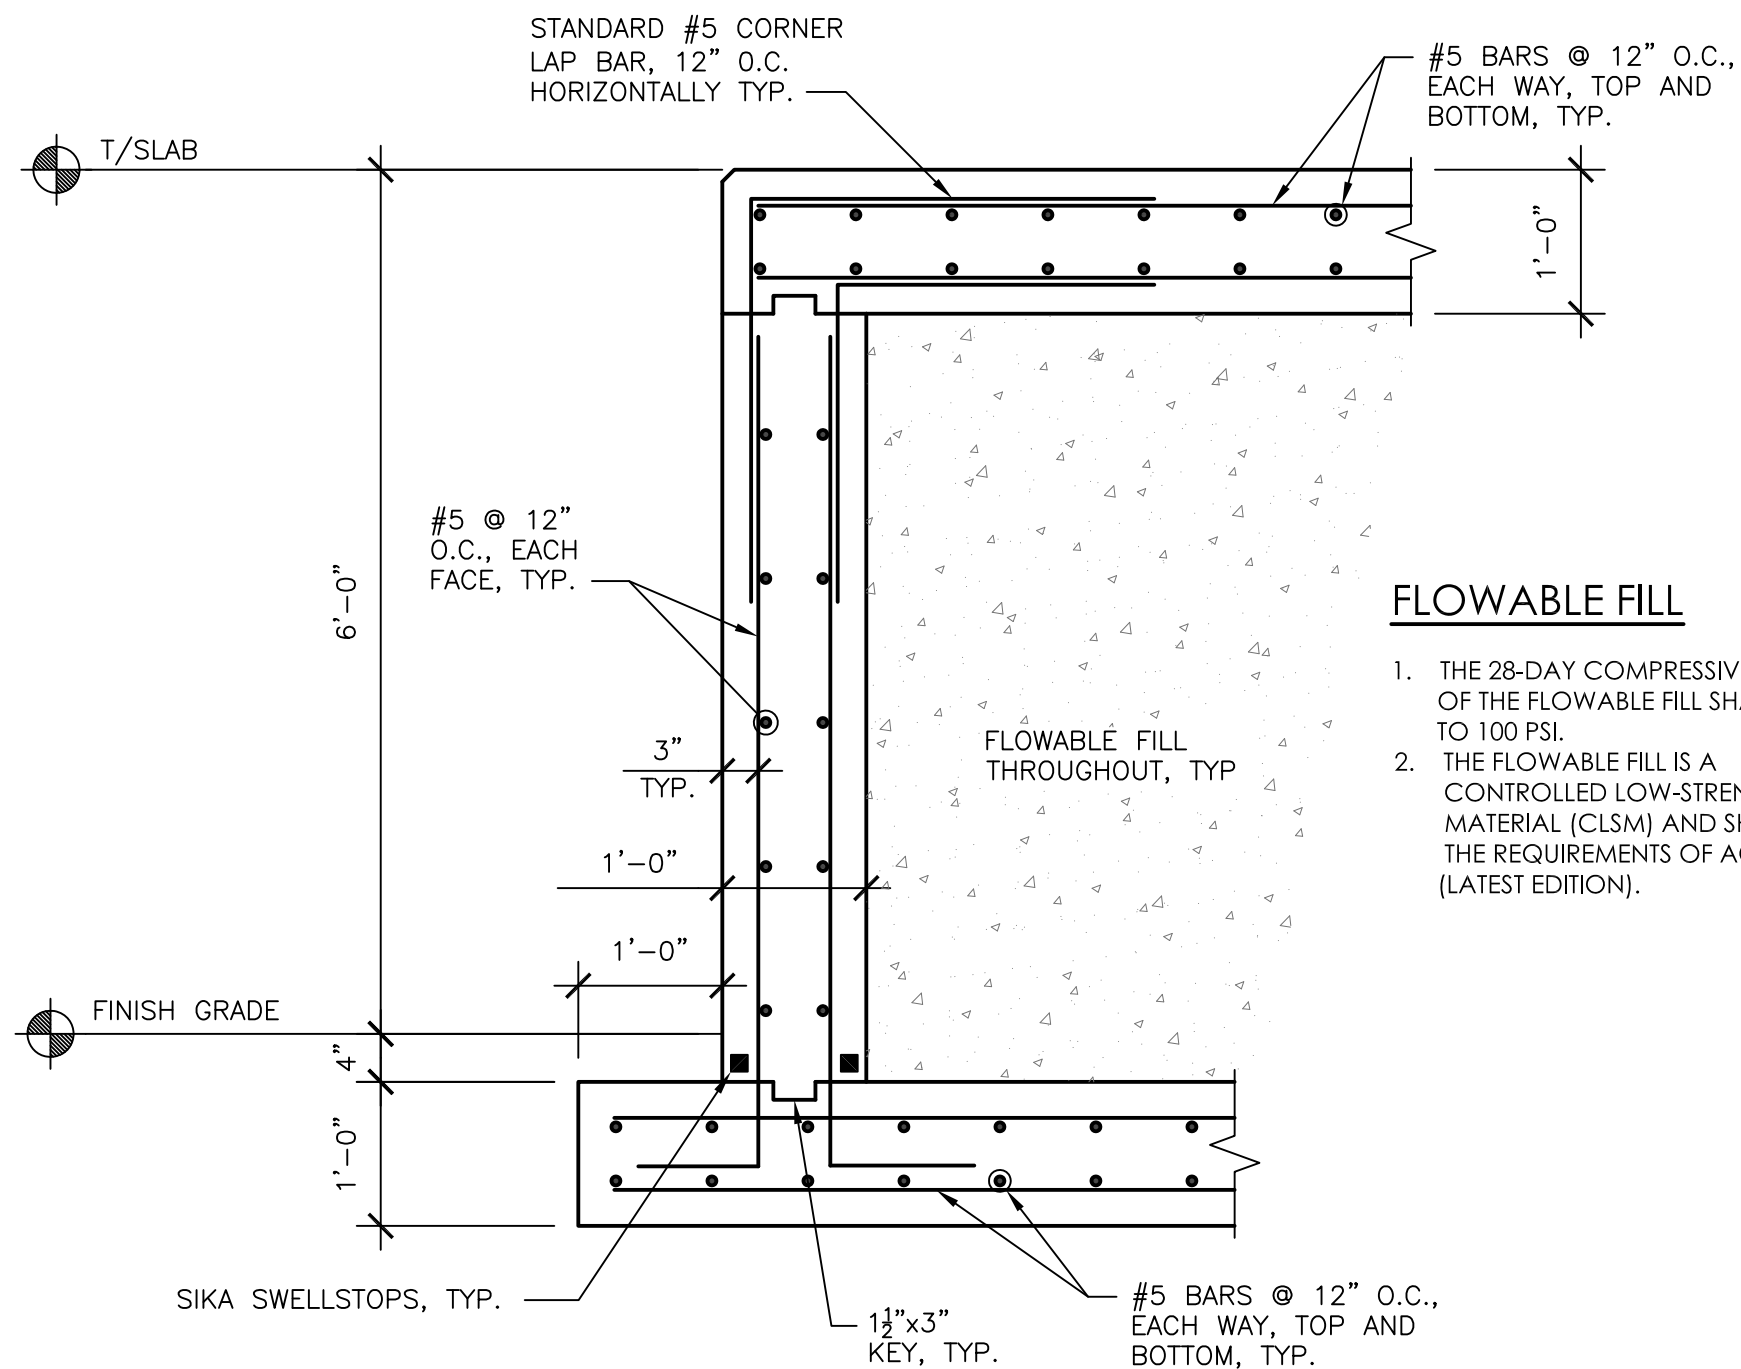

SECTION
 1
 S-20 SCALE: 3/4" = 1'-0"

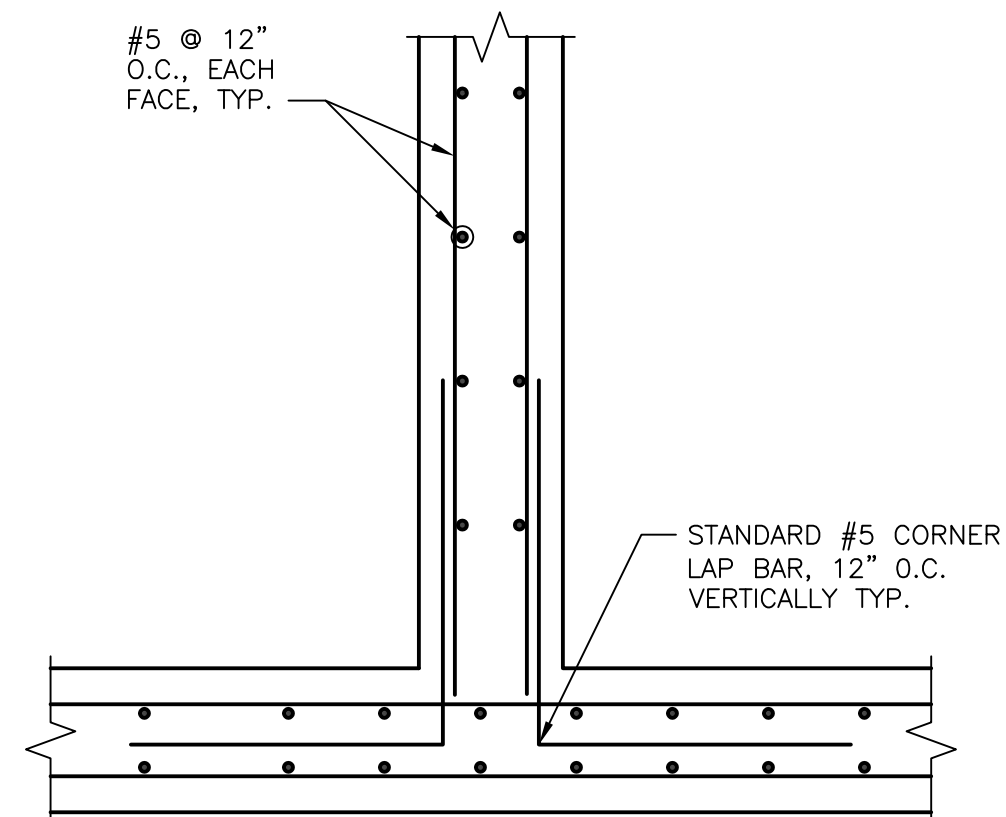

WALL INTERSECTION DETAIL

2
S-20 SCALE: 3/4" = 1'-0"

EDT

Certificate of Authorization Number: 4795

**- Engineering Design
Technologies Corp.**
P.O. Box 152403
Tampa, FL 33684-2403
813.289.8080
813.282.9184 FAX
engineering@edt1.com

CITY of TAMPA
WASTEWATER DEPARTMENT

KRAUSE PS REHABILITATION

SECTIONS & DETAILS

RED LINES

1	1/27/15	CONFIRMED
NO.	DATE	NO CHANGES

billerreinhardt
ENGINEERING GROUP INC.
3434 colwell avenue suite 100, tampa, florida 33611
telephone : 813.908.7203 fax : 813.931.5200
email : info@billerreinhardt.com
State of Florida Certificate of Authorization No. 914


TO THE BEST OF THE ENGINEER'S KNOWLEDGE
THE PLANS AND SPECIFICATIONS COMPLY
WITH THE APPLICABLE MINIMUM BUILDING CODE

19 ROBERT J. REINHARD
FL. P.F. NO. 50076

DRAWN: RC, KC
DESIGN: RR
QC: RR
DATE: 06/03/1

SHEET S-20

B080-045

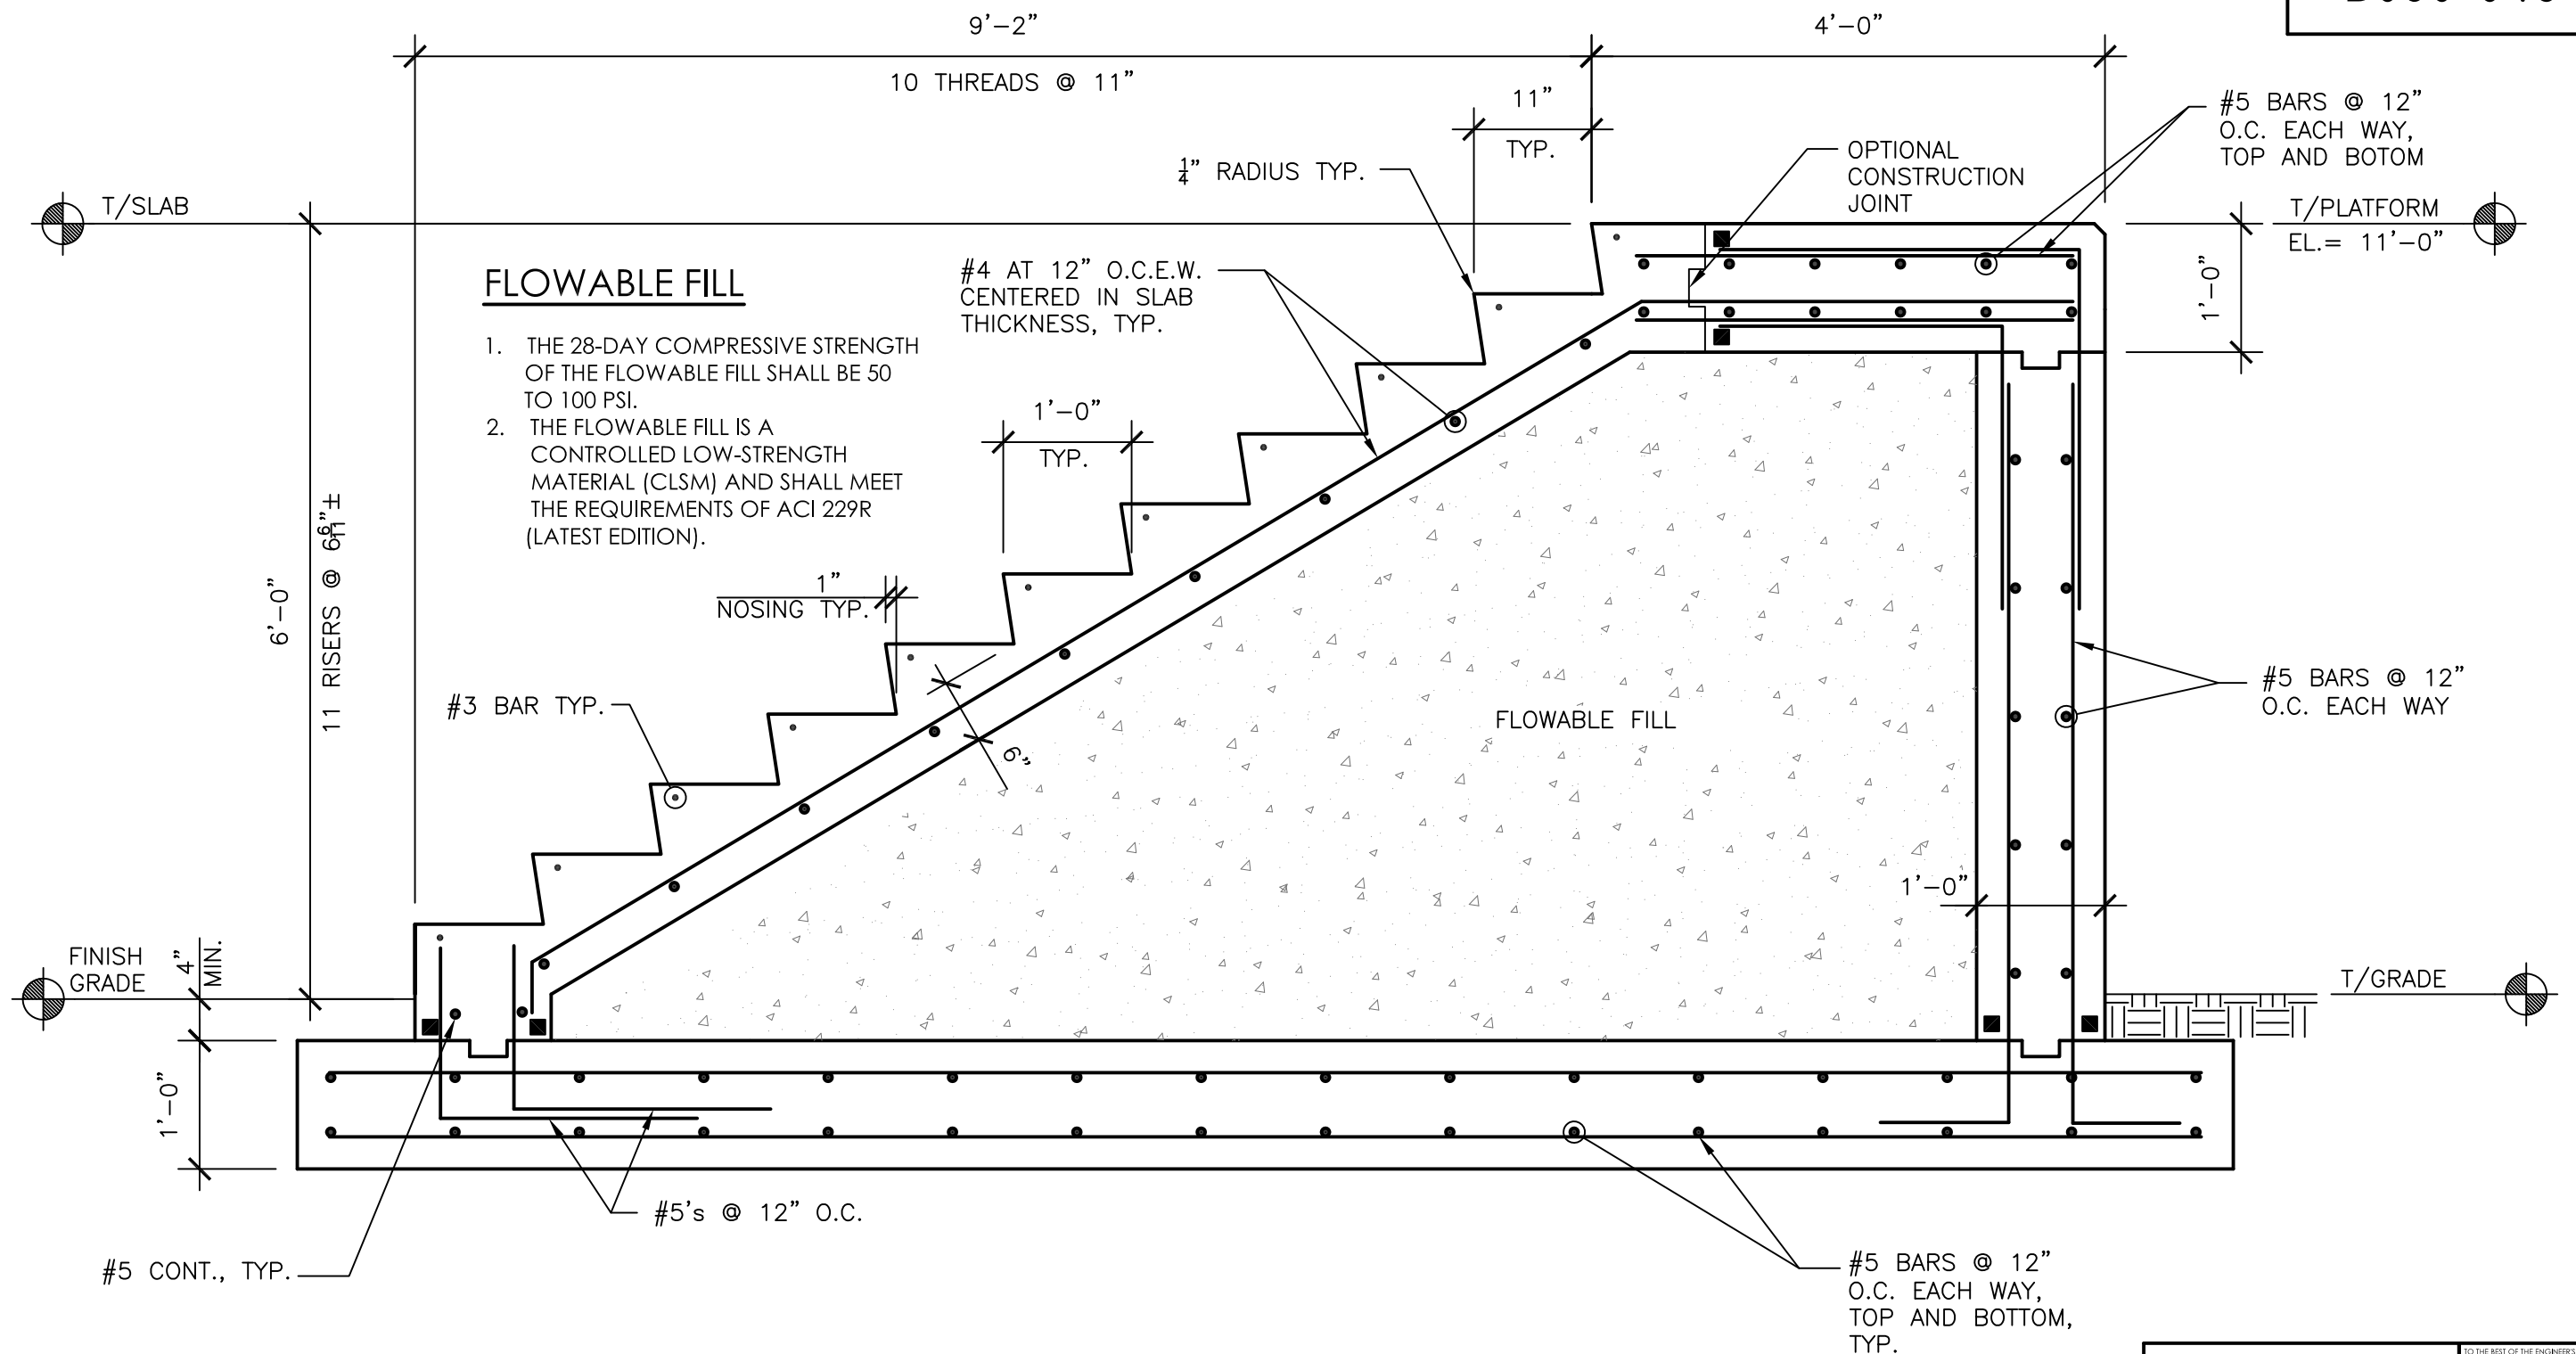

1 STAIR SECTION

S-21 SCALE: 3/4" = 1'-0"

billerreinhardt
ENGINEERING GROUP INC.
3434 colwell avenue suite 100, tampa, florida 33614
telephone : 813.908.7203 fax : 813.931.5200
email : info@billerreinhardt.com
State of Florida Certificate of Authorization No. 9149

ROBERT J. REINHART
FL. P.E. NO. 50076



**Engineering Design
Technologies Corp.**
P.O. Box 152403
Tampa, FL 33684-2403
813.289.8080
813.282.9184 FAX
engineering@edt1.com

CITY of TAMPA
WASTEWATER DEPARTMENT

KRAUSE PS REHABILITATION

**SECTIONS &
DETAILS**


RED LINES

NO CHANGES


DRAWN: RC, KC
DESIGN: RR
QC: RR
DATE: 06/03/14

SHEET S-21

Certificate of Authorization Number: 4795

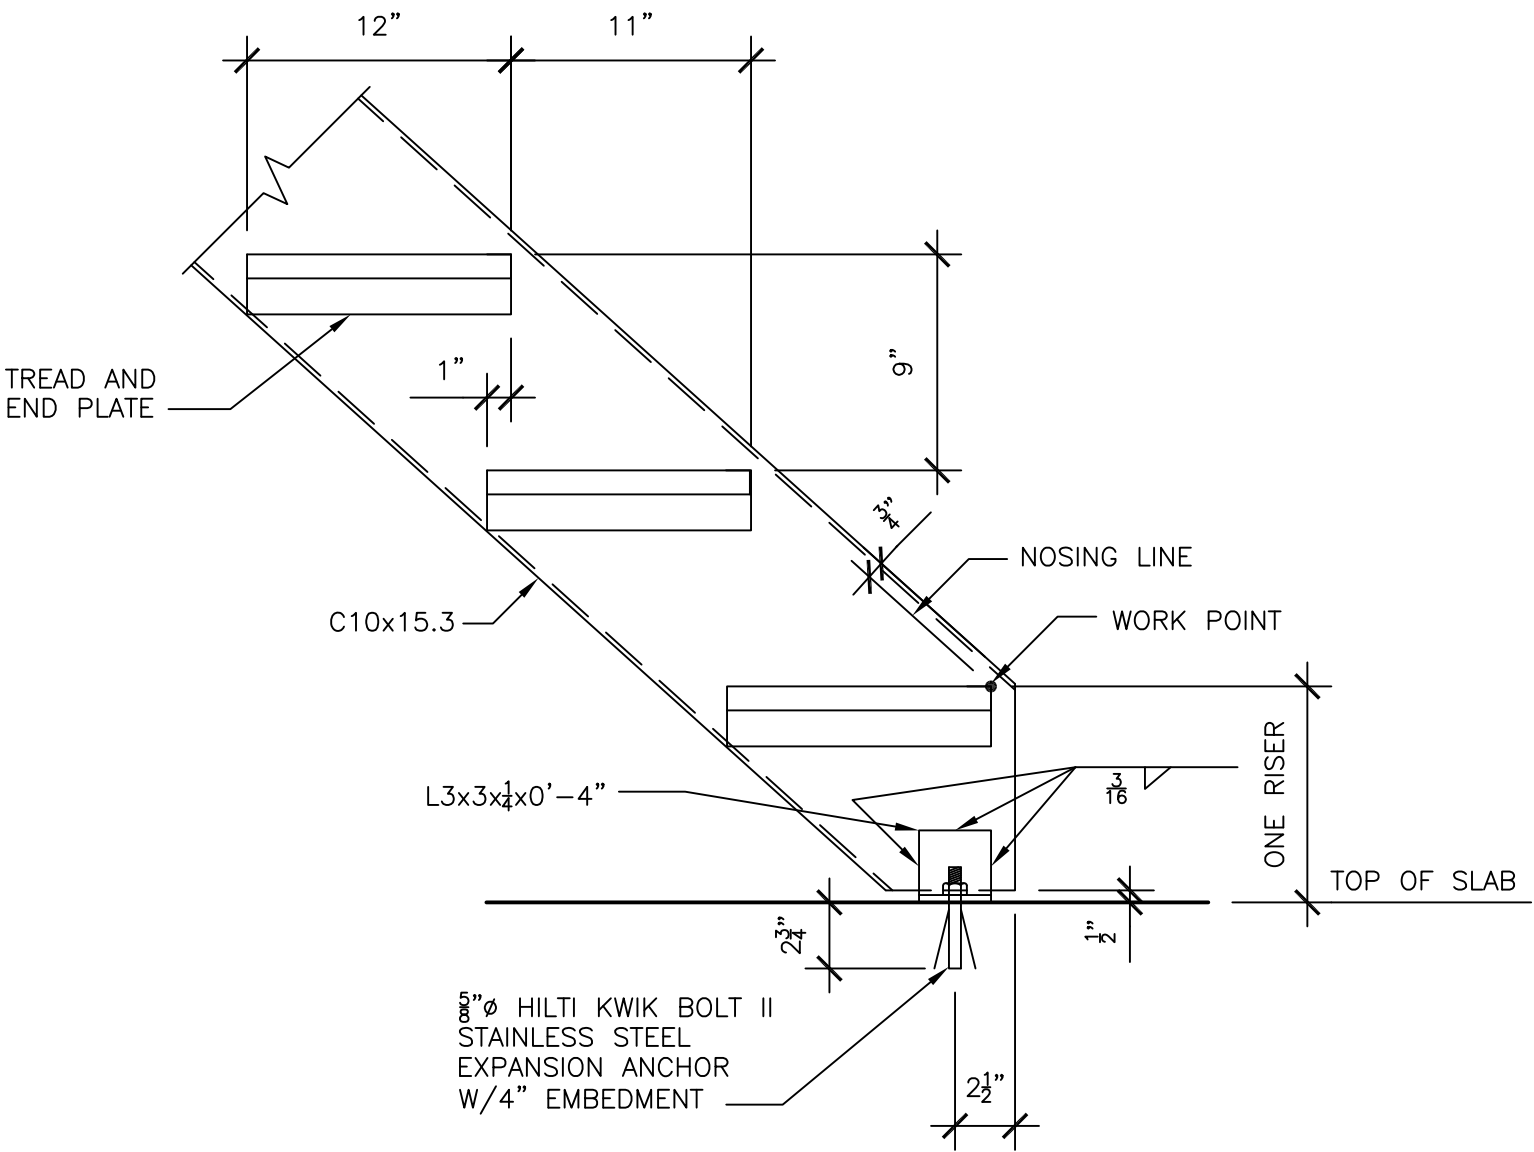

STAIR DETAIL

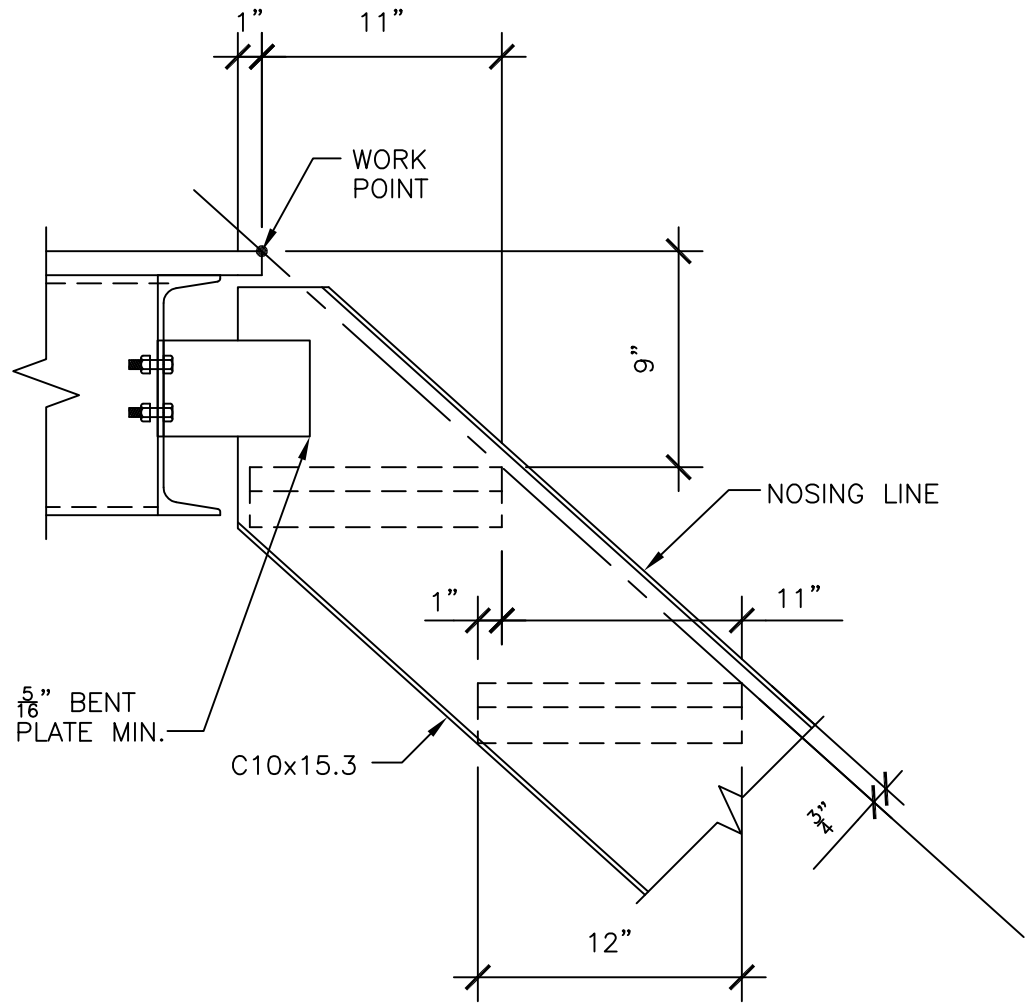

STAIR DETAIL

1 TYPICAL STAIR SECTIONS AND DETAILS
S-22 SCALE: NTS

billerreinhardt
ENGINEERING GROUP INC.
3434 colwell avenue suite 100, tampa, florida 33614
telephone : 813.908.7203 fax : 813.931.5200
email : info@billerreinhardt.com
State of Florida Certificate of Authorization No. 9149



TO THE BEST OF THE ENGINEER'S KNOWLEDGE,
THE PLANS AND SPECIFICATIONS COMPLY WITH
THE APPLICABLE MINIMUM BUILDING CODES.

ROBERT J. REINHART
FL. P.E. NO. 50076


STRUCTURAL ALUMINUM FOR GUARD RAIL AND HANDRAIL ASSEMBLIES

B080-047

1. ALL ANGLES ASTM B308/B308M - 02, "STANDARD SPECIFICATION FOR ALUMINUM-ALLOY 6061-T6 STANDARD STRUCTURAL PROFILES", WITH MINIMUM YIELD STRENGTH $F_y = 35$ KSI.
2. ALL STRUCTURAL PIPE AND TUBE (NOT INTENDED FOR FLUID-CARRYING APPLICATIONS) SHALL CONFORM TO ASTM B429/B429M -06, "STANDARD SPECIFICATION FOR ALUMINUM-ALLOY EXTRUDED STRUCTURAL PIPE AND TUBE", WITH MINIMUM YIELD STRENGTH $F_y = 35$ KSI.
3. ALL PLATES SHALL CONFORM TO ASTM B209 - 07, "STANDARD SPECIFICATION FOR ALUMINUM AND ALUMINUM-ALLOY SHEET AND PLATE", WITH MINIMUM YIELD STRENGTH $F_y = 35$ KSI.
4. TOE PLATES SHALL BE $4" \times 1/4"$.
5. HANDRAIL SHALL BE SHOP ASSEMBLED WITH TOE PLATE IN COMPLETE PANELS REQUIRING NO FIELD SPLICES.
6. EACH HANDRAIL PANEL SHALL HAVE A MINIMUM OF TWO POSTS.
7. MINIMUM WELD SHALL BE $3/16"$ FILLET.
8. ALL WELDED JOINTS SHALL BE COMPLETELY SEALED.
9. ALL JOINTS AND WELDS IN TOP RAIL SHALL BE GROUND SMOOTH.
10. BOLTED CONNECTIONS SHALL BE MADE WITH $3/4"$ DIA. ASTM F 593 STAINLESS STEEL ALLOY 316 BOLTS.
11. ALL CORNERS SHALL BE MITER CUT OR MINIMUM RADIUS BEND.
12. OPEN END OF ALL POSTS SHALL BE PLUGGED AND WELDED.
13. WELDING PROCESSES FOR ALUMINUM SHALL BE GAS METAL ARC WELDING (GMAW), COMMONLY CALLED MIG, OR GAS TUNGSTEN ARC WELDING (GTAW), REFERRED TO AS TIG.
14. ALL WELDS SHALL BE MADE BY QUALIFIED WELDERS AS PER AWS D1.2 "STRUCTURAL WELDING CODE - ALUMINUM" REQUIREMENTS. MIG AND TIG FILLER ALLOYS SHALL BE PER AWS A5.10/A5.10M "SPECIFICATION FOR BARE ALUMINUM AND ALUMINUM-ALLOY WELDING ELECTRODES AND RODS." ALUMINUM ALLOY FILLER MATERIALS SHALL BE PER TABLE 7.2-1 OF THE ALUMINUM DESIGN MANUAL 2005. ALLOY FILLER PREFERRED IS 5356; HOWEVER, ALLOYS 4043, 4047, 5183, OR 5556 MAY BE USED.
15. RETURN ALL WELDS AT CORNERS TWICE THE NOMINAL WELD SIZE MINIMUM.
16. WELDS NOT OTHERWISE DESIGNATED SHALL BE $1/4"$ IN. MINIMUM FILLET WELDS.
17. ALUMINUM FINISHES
 - A. FINISH DESIGNATIONS PREFIXED BY AA COMPLY WITH THE SYSTEM ESTABLISHED BY THE ALUMINUM ASSOCIATION FOR DESIGNATING ALUMINUM FINISHES.
 - B. AS-FABRICATED: AA-M10 (MECHANICAL FINISH: AS FABRICATED, UNSPECIFIED).
 - C. CLASS I, CLEAR ANODIC FINISH; AA-M12C22A41 (MECHANICAL FINISH: NONSPECULAR AS FABRICATED; CHEMICAL FINISH: ETCHED, MEDIUM MATTE; ANODIC COATING: ARCHITECTURAL CLASS I, CLEAR COATING 0.018 MM OR THICKER) COMPLYING WITH AAMA 607.1.
18. SHOP DRAWINGS: SUBMIT SHOP DRAWINGS PREPARED UNDER SUPERVISION OF A REGISTERED PROFESSIONAL ENGINEER, INCLUDING COMPLETE DETAILS AND SCHEDULES FOR FABRICATION AND ASSEMBLY OF STRUCTURAL ALUMINUM MEMBERS, PROCEDURES AND DIAGRAMS. INCLUDE DETAILS OF CUTS, CONNECTIONS, CAMBER, HOLES AND OTHER PERTINENT DATA. INDICATE WELDS BY STANDARD AWS SYMBOLS AND SHOW SIZE, LENGTH AND TYPE OF EACH WELD. STRUCTURAL ALUMINUM SHOP DRAWINGS SHALL BE SIGNED AND SEALED BY THE PROFESSIONAL ENGINEER WHO SUPERVISED THEIR PRODUCTION.

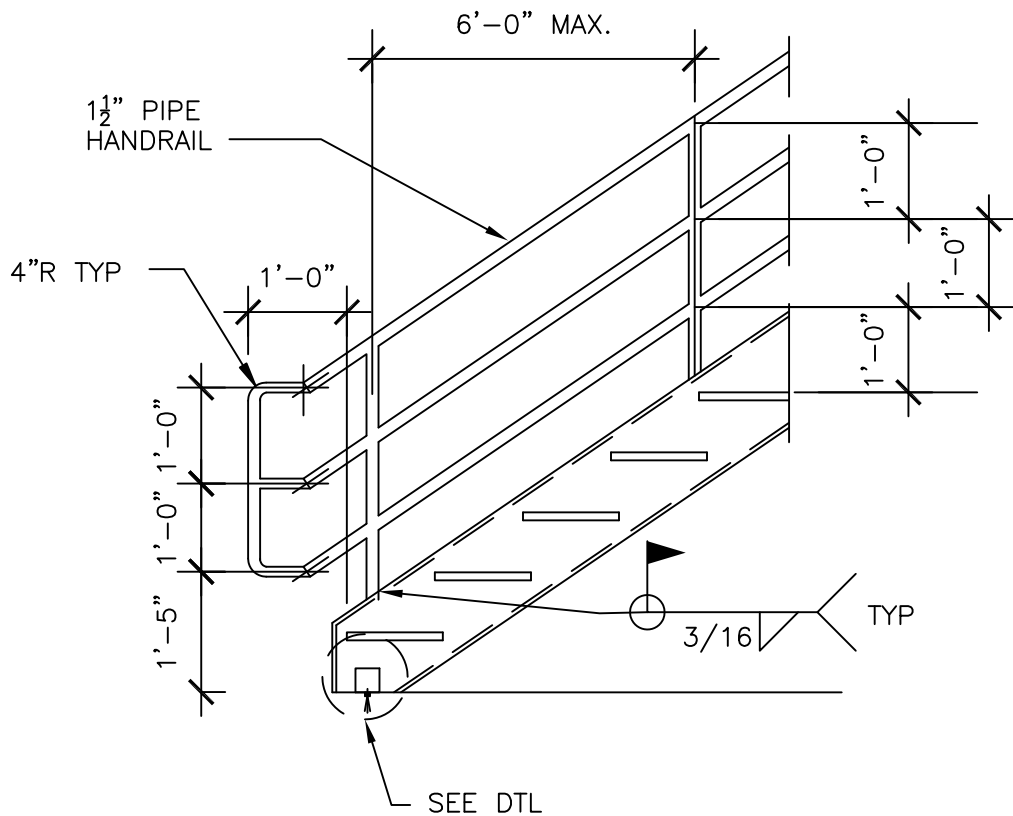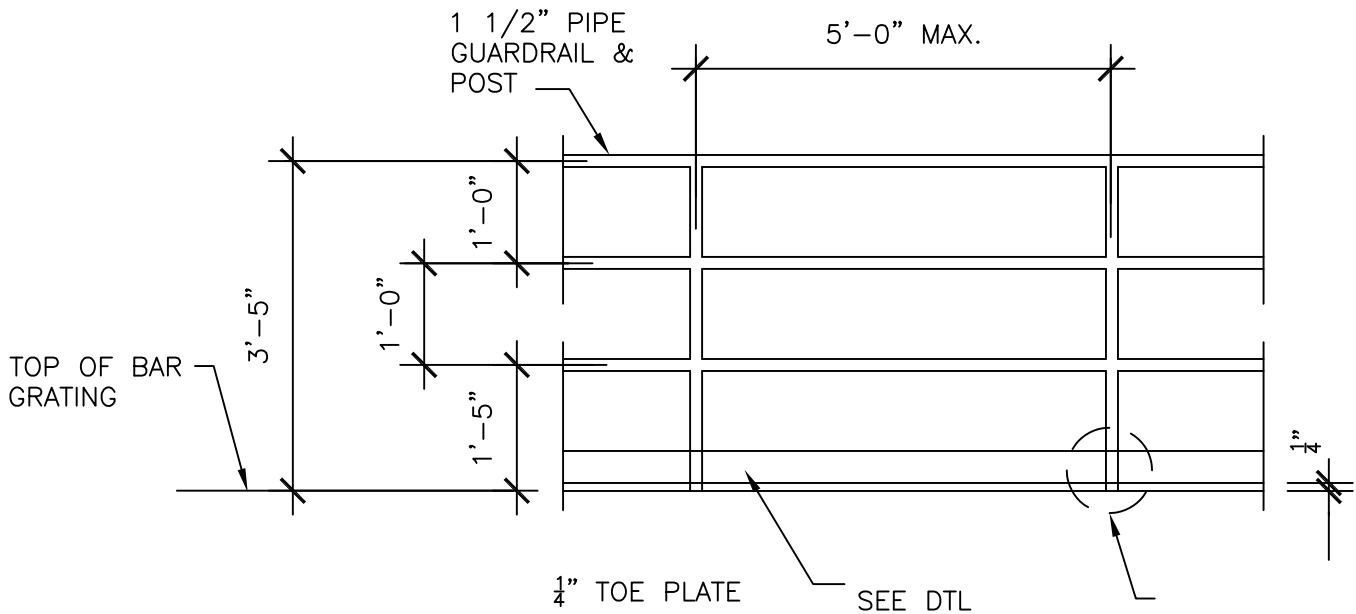

TYPICAL HANDRAIL

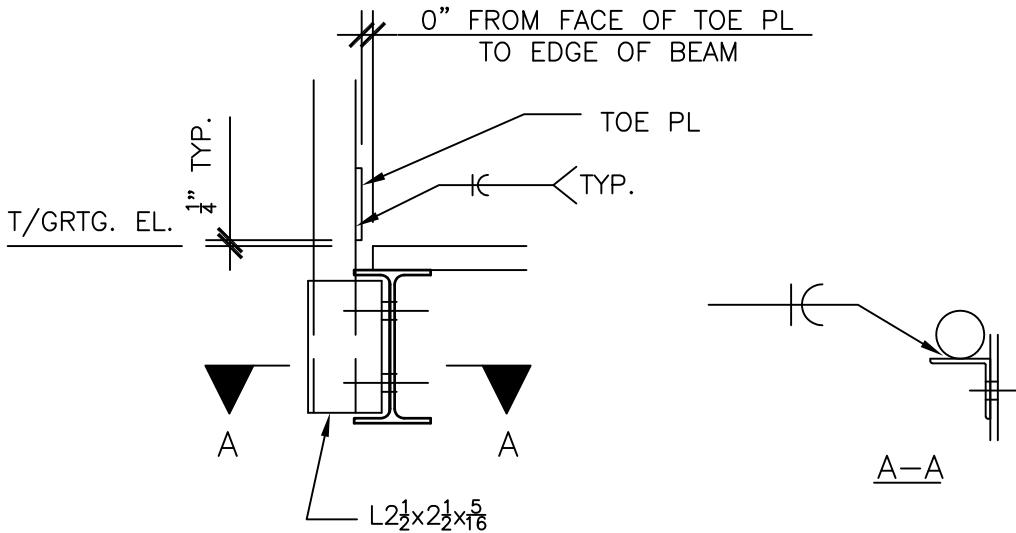

POST CONNECTION DETAIL

1 TYPICAL STAIR SECTIONS AND DETAILS
S-23 SCALE: NTS

billerreinhardt
ENGINEERING GROUP INC.
3434 colwell avenue suite 100, tampa, florida 33614
telephone : 813.908.7203 fax : 813.931.5200
email : info@billerreinhardt.com
State of Florida Certificate of Authorization No. 9149
ROBERT J. REINHART
FL. P.E. NO. 50076



Engineering Design
Technologies Corp.
P.O. Box 152403
Tampa, FL 33684-2403
813.289.8080
813.282.9184 FAX
engineering@edt1.com

CITY of TAMPA
WASTEWATER DEPARTMENT

KRAUSE PS REHABILITATION

SECTIONS &
DETAILS

RED LINES


NO CHANGES

DRAWN: RC, KC
DESIGN: RR
IC: RR
DATE: 06/03/14


SHEET S-23

1 1/27/15
NO. DATE


CONFORMED

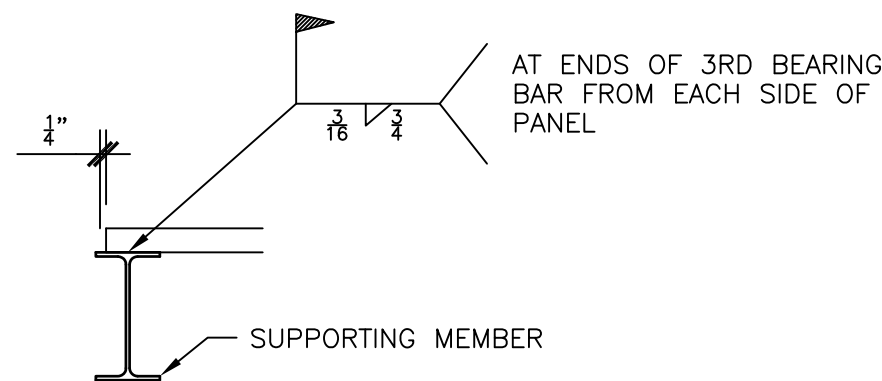


PERIMETER SUPPORTS DETAIL

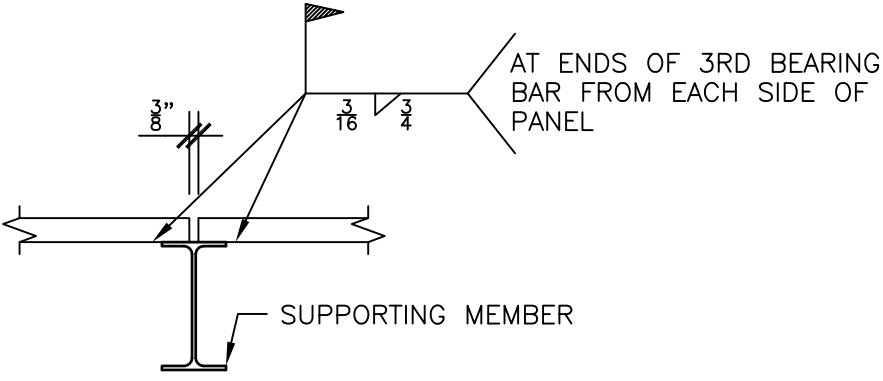


SPLICE AT SUPPORT DETAIL

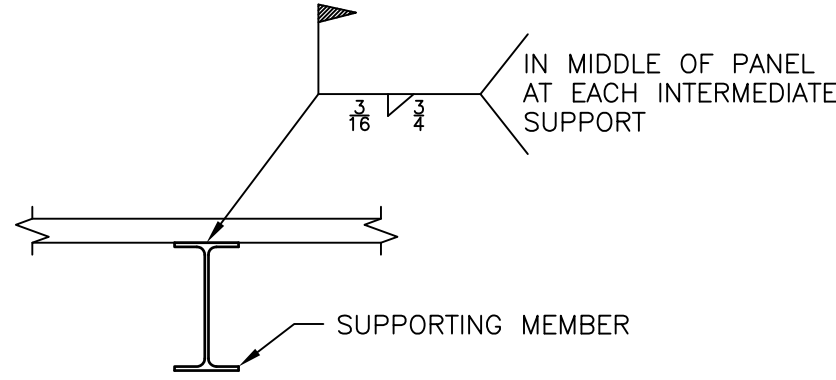

INTERMEDIATE SUPPORT DETAIL

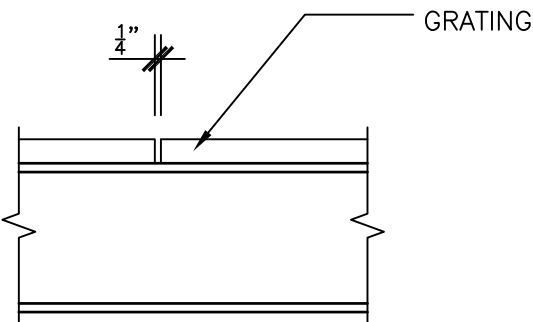

PANEL SIDES DETAIL

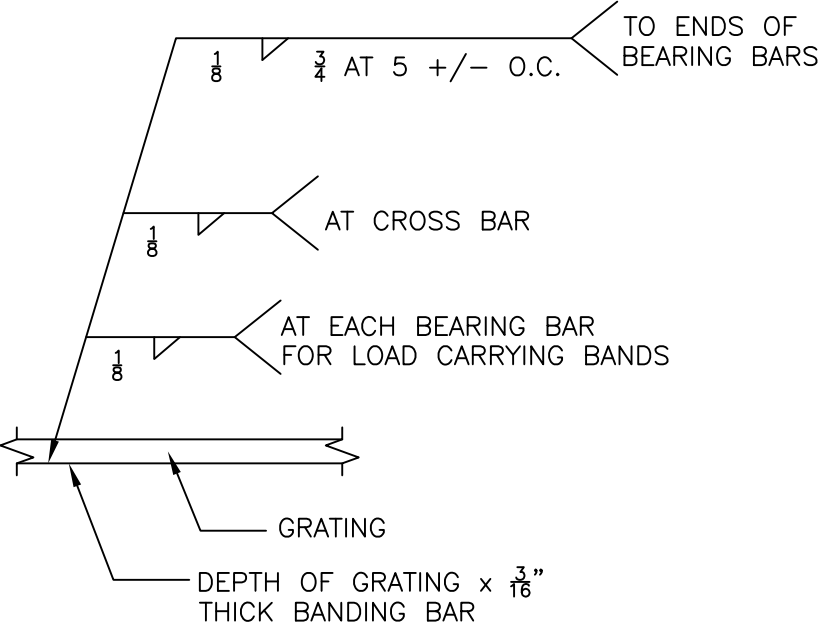

BANDING BAR DETAIL

TYPICAL GRATING DETAILS

1 TYPICAL STAIR SECTIONS AND DETAILS
S-24 SCALE: NTS

billerreinhardt
ENGINEERING GROUP INC.
3434 colwell avenue suite 100, tampa, florida 33614
telephone : 813.908.7203 fax : 813.931.5200
email : info@billerreinhardt.com
State of Florida Certificate of Authorization No. 9149

TO THE BEST OF THE ENGINEER'S KNOWLEDGE,
THE PLANS AND SPECIFICATIONS COMPLY WITH
THE APPLICABLE MINIMUM BUILDING CODES.

ROBERT J. REINHART
FL. P.E. NO. 50076



Engineering Design
Technologies Corp.
P.O. Box 152403
Tampa, FL 33684-2403
813.289.8080
813.282.9184 FAX
engineering@edt1.com

CITY of TAMPA
WASTEWATER DEPARTMENT

KRAUSE PS REHABILITATION

SECTIONS &
DETAILS

RED LINES

NO CHANGES

DRAWN: RC, KC
DESIGN: RR
RC: RR
DATE: 06/03/14

SHEET S-24

1 1/27/15
NO. DATE

Ø OPENING AND SS STOP LOG GROOVES

C6x10.5 STAINLESS STEEL CHANNELS (SEE S-4 FOR STRUCTURAL STAINLESS STEEL) ALONG SIDES AND BOTTOM OF EACH CHAMBER INLET. SECURE C6'S WITH HILTI COUNTERSUNK STAINLESS STEEL SS316L KWIK BOLT III ANCHORS (C6x4) SPACED AT 4 INCHES ON CENTER. INSTALL ANCHORS PER MANUFACTURER'S RECOMMENDATIONS. PRE-DRILL SURFACE MOUNTED C6'S TO ACCOMMODATE COUNTER SUNK HEAD. ANCHORS ARE DESIGNED FOR WATER DEPTH OF 20 FEET MAXIMUM.

#3's W/ STD. HOOK AT END, 12" O.C. GRID IN CHAMBER INLET BASE, HORIZ. AND VERT., 6" EMBEDMENT ADHERED W/ HILTI HIT-RE 500 PER MANUFACTURER'S SPECIFICATIONS, TYP.

#3'S CONT.
AT 12" O.C.
MAX. EACH
WAY, TYP.

REMOVE CONCRETE WITHOUT
DAMAGING EXISTING REBAR TO
PROVIDE VERT. INTERFACE, TYP.

ROUGHEN INTERFACE TO A FULL AMPLITUDE OF APPROXIMATELY 1/4", APPLY BASF EMACO P24 BONDING AGENT (OR APPROVED EQUAL) PRIOR TO PLACEMENT ON NON-SHRINK CONCRETE, TYP. EACH CHAMBER INLET

1 CHAMBER INLET SECTION

S-25 SCALE: 3/8" = 1'-0" (NOTE EXISTING SECTION UNDERLAY IS APPROXIMATE AND FOR LOCATION PURPOSES ONLY)

billerreinhardt
ENGINEERING GROUP INC.
3434 colwell avenue suite 100, tampa, florida 33614
telephone : 813.908.7203 fax : 813.931.5200
email : info@billerreinhardt.com
State of Florida Certificate of Authorization No. 9149

TO THE BEST OF THE ENGINEER'S KNOWLEDGE
THE PLANS AND SPECIFICATIONS COMPLY WITH
THE APPLICABLE MINIMUM BUILDING CODES
ROBERT J. REINHART
FL. P.E. NO. 50076



Engineering Design
Technologies Corp.
P.O. Box 152403
Tampa, FL 33684-2403
813.289.8080
813.282.9184 FAX
engineering@edt1.com

CITY of TAMPA
WASTEWATER DEPARTMENT

KRAUSE PS REHABILITATION

STRUCTURAL DETAIL

RED LINES

1	1/27/15
NO.	DATE

NO CHANGES

DRAWN: RC, KC
IGN: RR
RR
E: 06/03/14

SHEET S-25

Certificate of Authorization Number: 4795

B080-050


ENGINEERING GROUP INC.
3434 colwell avenue suite 100, tampa, florida 33614
telephone : 813.908.7203 fax : 813.931.5200
email : info@billerreinhardt.com
State of Florida Certificate of Authorization No. 9149

TO THE BEST OF THE ENGINEER'S KNOWLEDGE,
THE PLANS AND SPECIFICATIONS COMPLY WITH
THE APPLICABLE MINIMUM BUILDING CODES.

ROBERT J. REINHART
FL. P.E. NO. 50076



Engineering Design
Technologies Corp.
P.O. Box 152403
Tampa, FL 33684-2403
813.289.8080
813.282.9184 FAX
engineering@edt1.com

CITY of TAMPA
WASTEWATER DEPARTMENT

KRAUSE PS REHABILITATION

STRUCTURAL DETAIL

RED LINES


1	1/27/15
NO.	DATE

NO CHANGES

DRAWN: RC, KC
DESIGN: RR
QC: RR
DATE: 06/03/14

SHEET S-26

B080-051

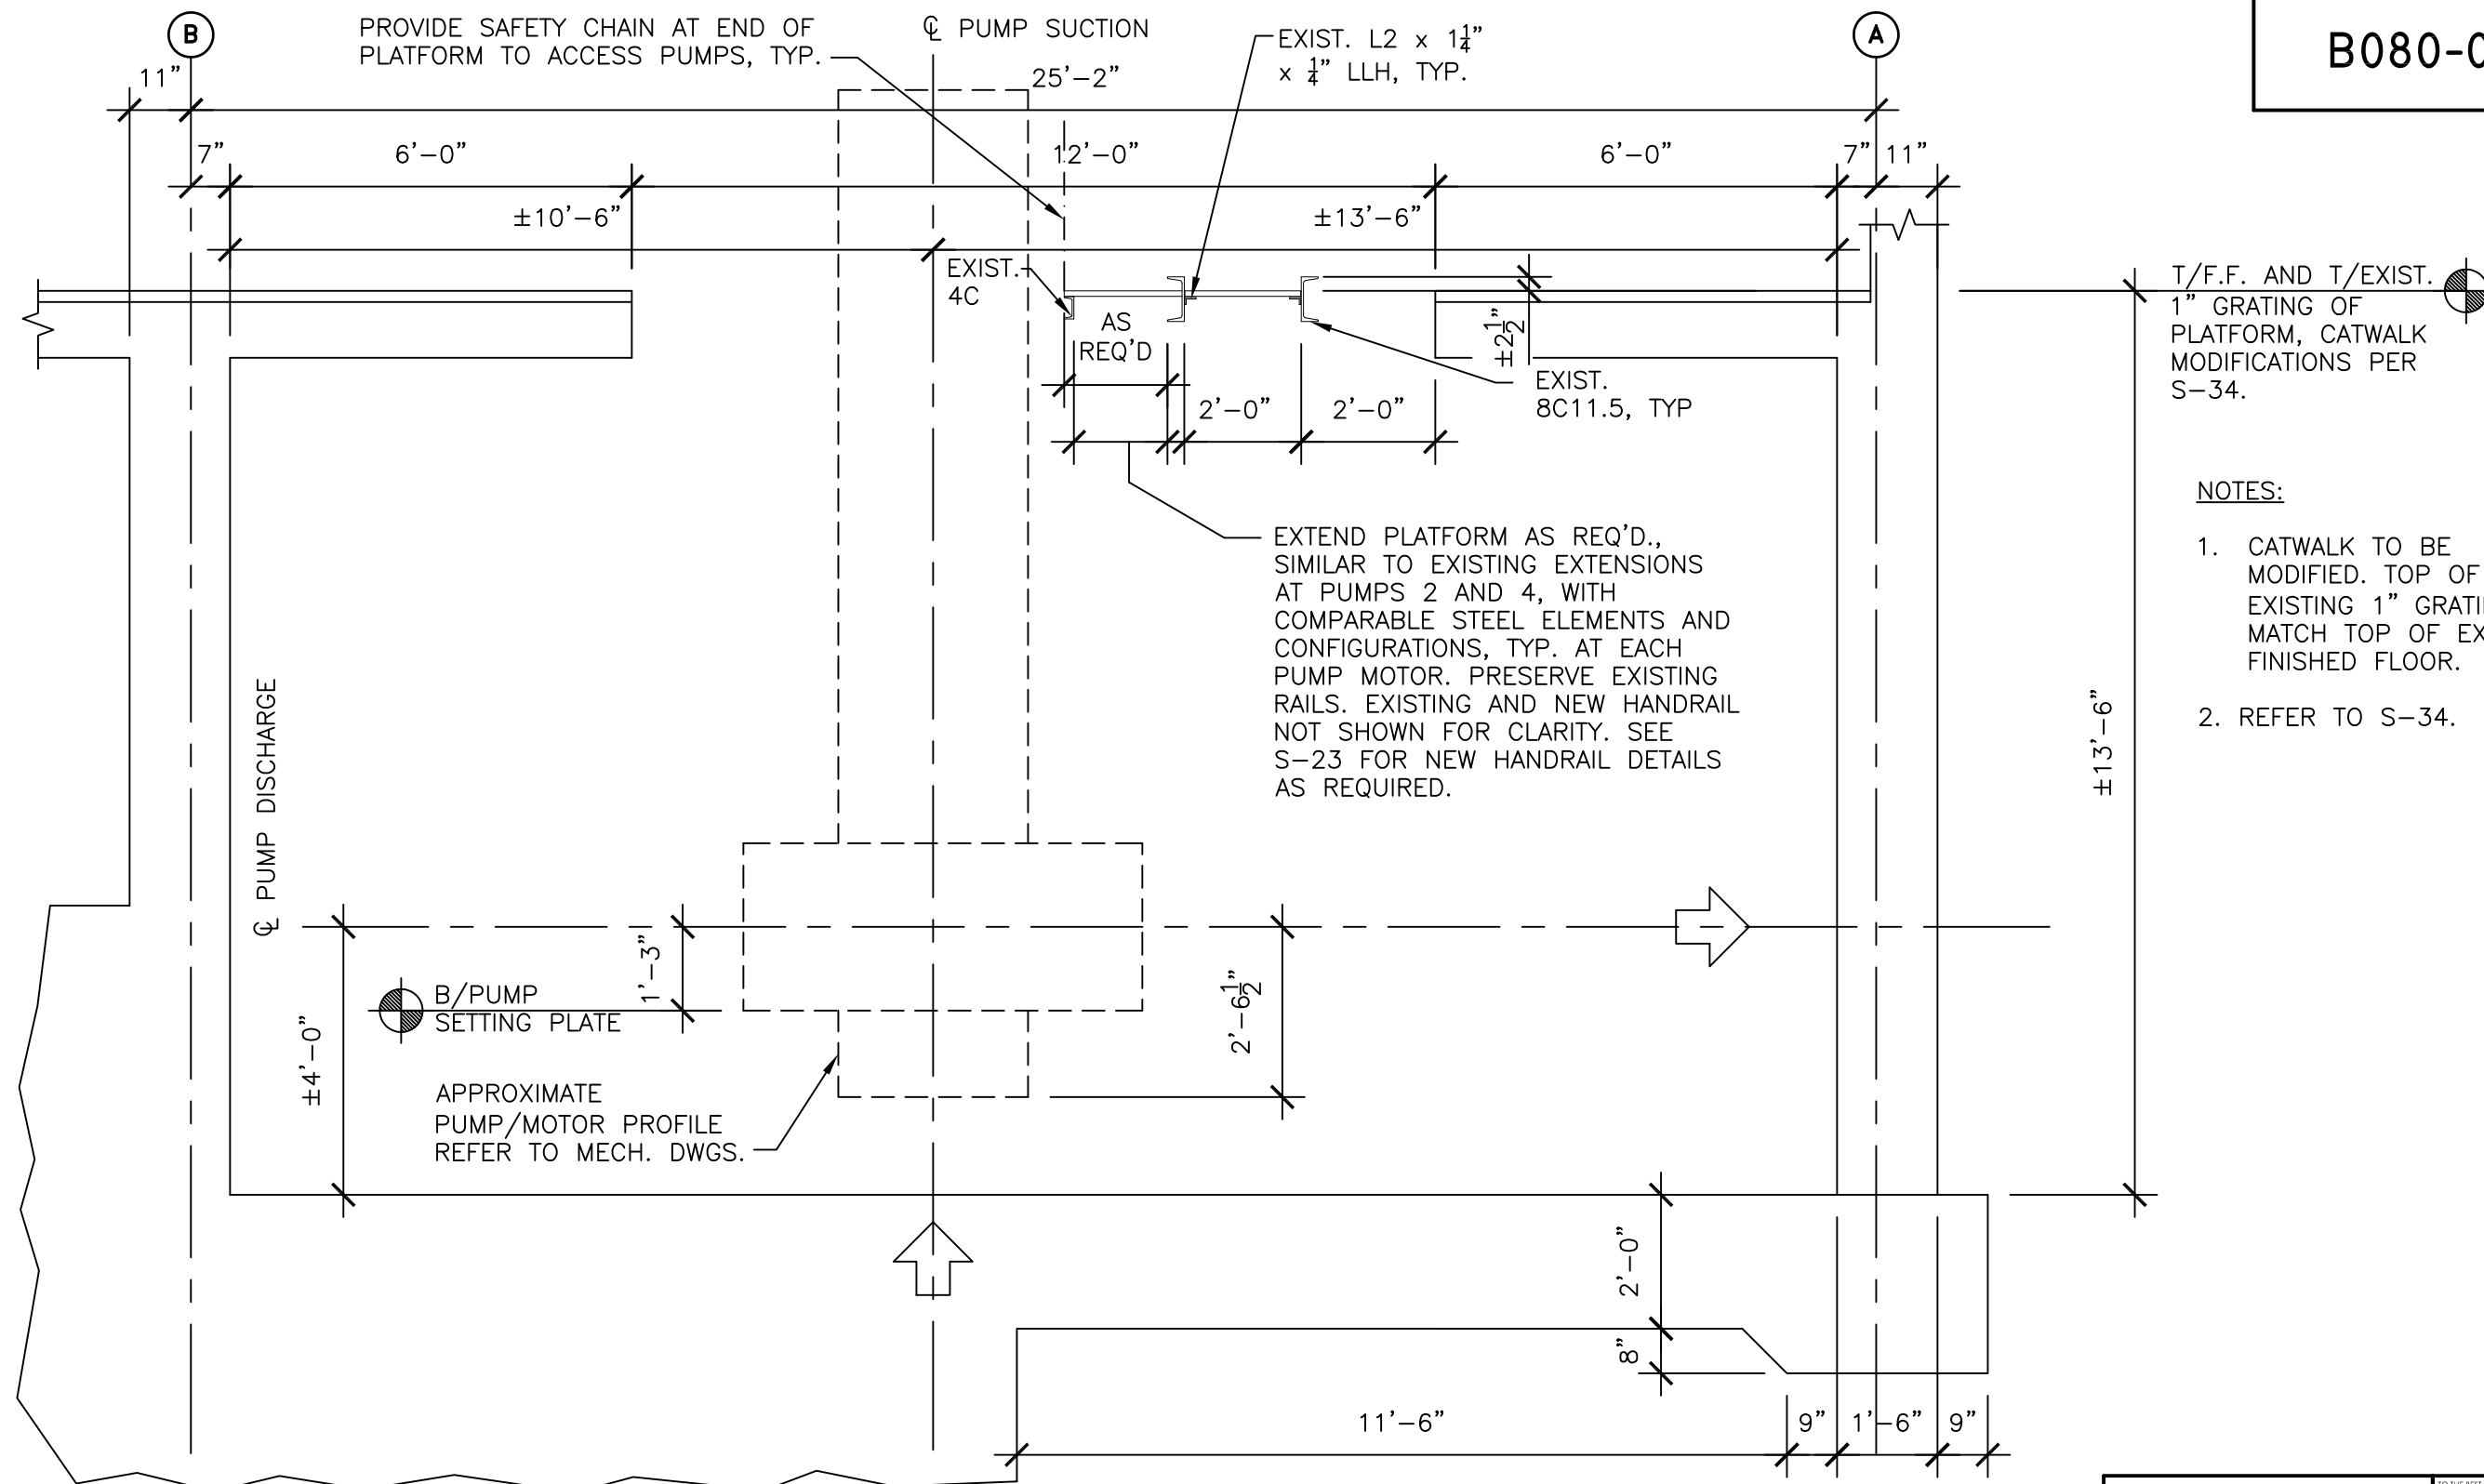

1 PUMP DETAIL
S-27 SCALE: 3/8" = 1'-0"

billerreinhardt
ENGINEERING GROUP INC.
3434 colwell avenue suite 100, tampa, florida 33614
telephone : 813.908.7203 fax : 813.931.5200
email : info@billerreinhardt.com
State of Florida Certificate of Authorization No. 9149
ROBERT J. REINHART
FL. P.E. NO. 50076



Engineering Design Technologies Corp.
P.O. Box 152403
Tampa, FL 33684-2403
813.289.8080
813.282.9184 FAX
engineering@edt1.com

Certificate of Authorization Number: 4795

CITY of TAMPA
WASTEWATER DEPARTMENT

KRAUSE PS REHABILITATION


STRUCTURAL DETAIL

RED LINES

NO CHANGES

DRAWN: RC, KC
SIGN: RR
: RR
TE: 06/03/14

1 1/27/15
NO. DATE SHEET S-27

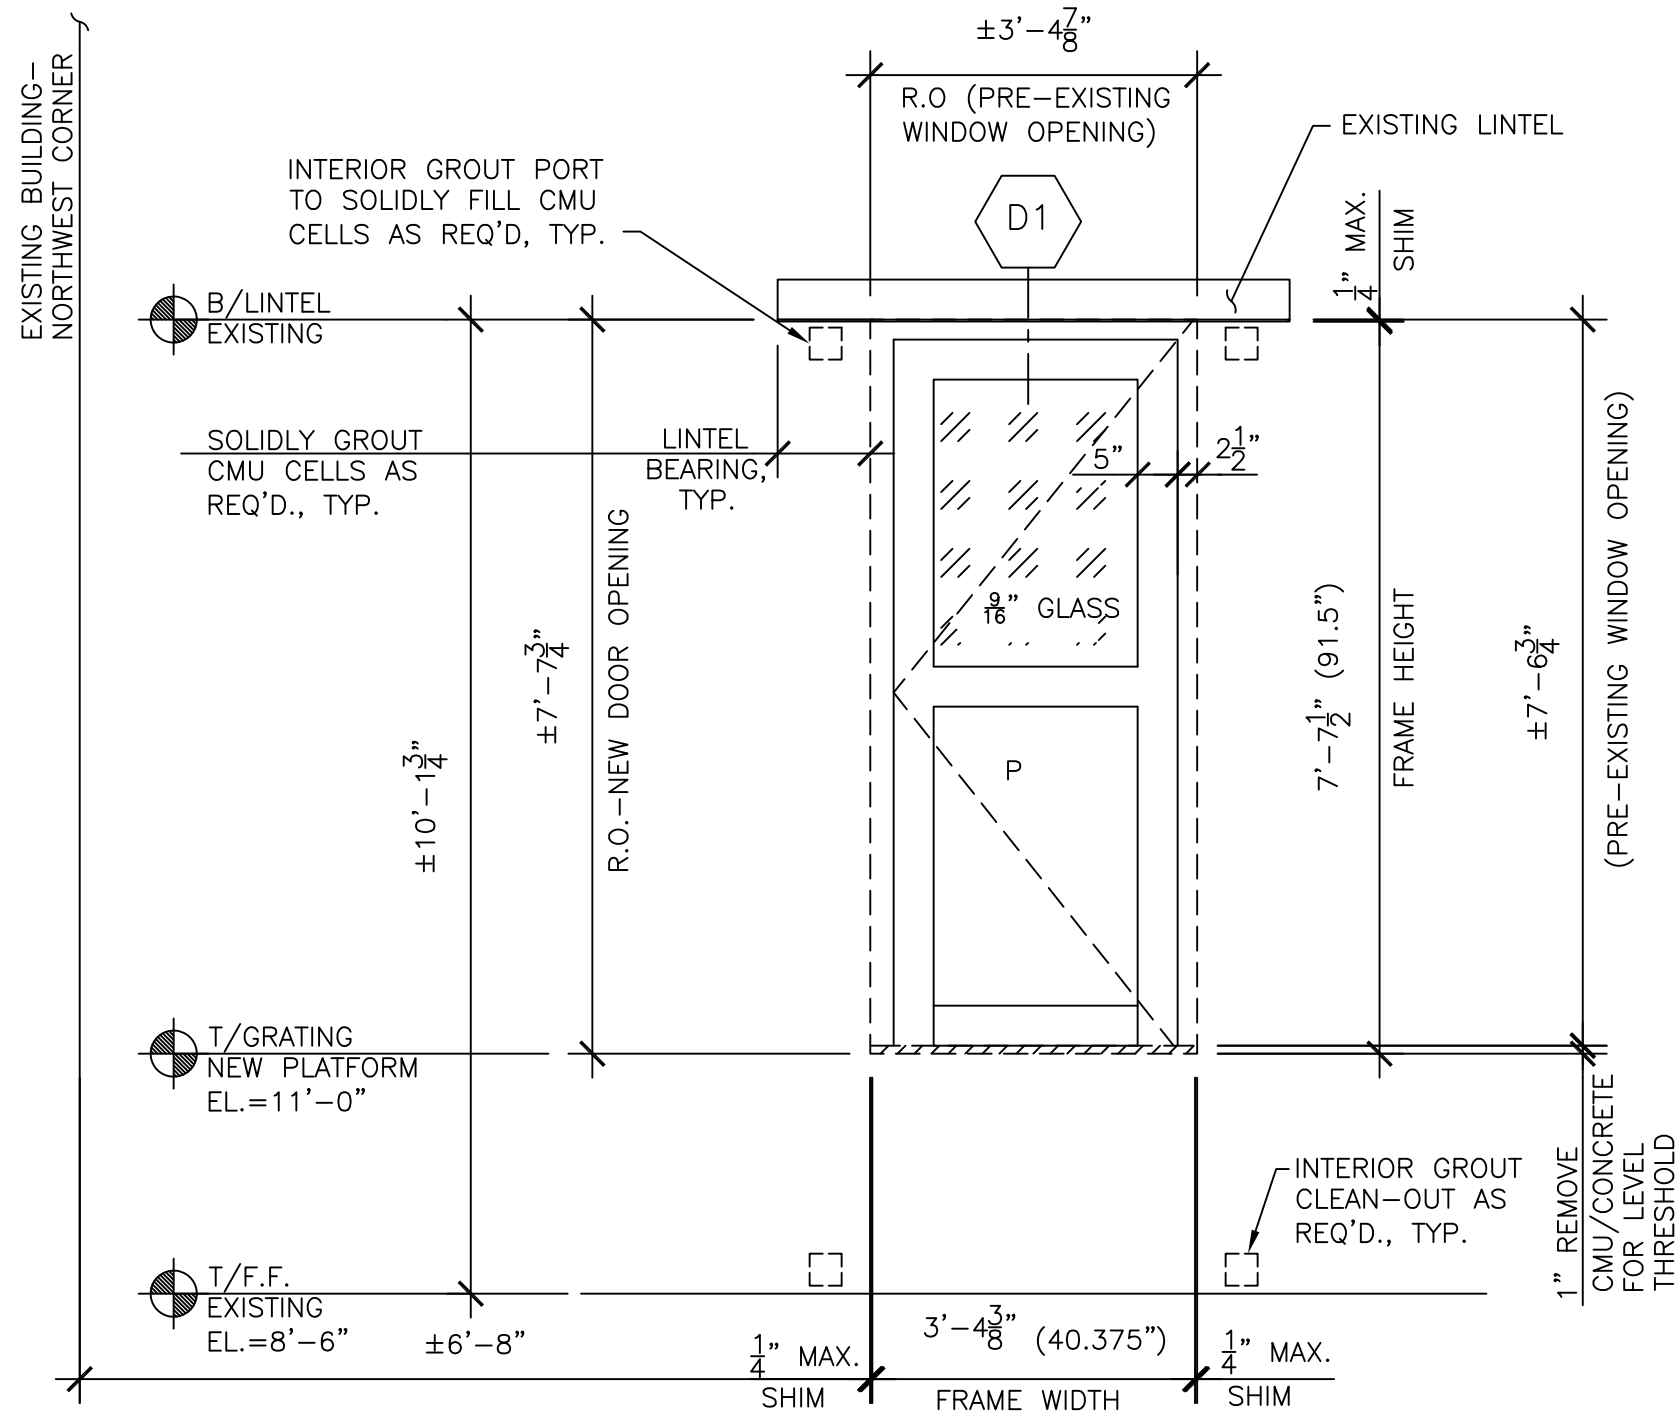

DOOR DETAILS AND FINISH HARDWARE SCHEDULE

SET #1 ELECTRICAL ROOM DOOR - ALL HARDWARE STANDARD CLEAR		
2 PR (4)	IMPACT BUTT HINGES	PER DOOR AND FRAME MANUFACTURER (EFCO CORPORATION)
1 SET	STANDARD PUSH/PULL	PER DOOR AND FRAME MANUFACTURER (EFCO CORPORATION)
1	LOCKSET	3 POINT IMPACT LOCK (MK DR16) AND 1490 IMPACT PANIC BAR (MK DR 21) PER DOOR AND FRAME MANUFACTURER (EFCO CORPORATION)
1	DOOR CLOSER	LCN 4041 SURFACE MOUNT
1	THRESHOLD	8924 IMPACT WITH SEAL PER DOOR AND FRAME MANUFACTURER (EFCO CORPORATION)
1	SWEEP	9960/9961 IMPACT PER DOOR AND FRAME MANUFACTURER (EFCO CORPORATION)
1	BOTTOM RAIL	PER DOOR AND FRAME MANUFACTURER (EFCO CORPORATION)
1	CROSS RAILS	PER DOOR AND FRAME MANUFACTURER (EFCO CORPORATION)
1	BOTTOM PANEL	PER DOOR AND FRAME MANUFACTURER (EFCO CORPORATION)
1 SET	WEATHERSTRIPPING	PER DOOR AND FRAME MANUFACTURER (EFCO CORPORATION)
	OTHER	ALL ITEMS TO BE INCLUDED FOR A COMPLETE ENTRY DOOR AND FRAME SYSTEM
	FASTENERS/ANCHORS	PER FLORIDA PRODUCT APPROVAL DOCUMENTS AND DOOR AND FRAME MANUFACTURER (EFCO CORPORATION)

NOTE: LOCKSET TO BE KEYED TO EXISTING PUMP STATION DOOR LOCKS.

DOOR SCHEDULE																	
DOORS					FRAMES					FIN. HOW. SET	FLORIDA PRODUCT APPROVAL	HAND OF DOOR	NOTES				
MARK	UNIT	TYPE	MATERIAL	ROUGH OPENING WIDTH	ROUGH OPENING HEIGHT	UNIT	MATERIAL	TYPE	NOMINAL SIZE					DETAILS			
									WIDTH	HEIGHT	DEPTH	HEAD	JAMB				
D1	EA.	G	ALUMINUM	3'-4-7/8"	7'-7-1/2"	EA.	ALUMINUM	6063-T6	3'-4-7/8"	7'-7-1/2"	5"	2-1/2"	2-1/2"	1	FL # 16398	LHR	EFCO SERIES 0500 WIDE STILE DOOR WITH SS25 FABRICATED FRAME; GLASS - 9/16" LAMINATED GLASS (1/4" GREY HEAT STRENGTHENED x 0.090 CLR SAFLEX INTERLAYER x 1/4" CLR HEAT STRENGTHENED); LARGE MISSILE IMPACT LEVEL D; MATERIAL FINISH ULTRAFON™ COAT 70% PVDF COLOR TO MATCH EXISTING DOORS; WARRANTY 5 YEAR MATERIAL & 5 YEAR FINISH

G HALF GLASS TOP, PANEL BOTTOM

LH LEFT HAND
RH RIGHT HAND
LHR LEFT HAND REVERSE
RHR RIGHT HAND REVERSE

1 PARTIAL WEST EXTERIOR ELEVATION
S-28 SCALE: 1/2" = 1'-0"

NOTE: SEE S-8 FOR INTERIOR ELEVATION

3434 colwell avenue suite 100, tampa, florida 33614
telephone : 813.908.7203 fax : 813.931.5200
email : info@billerreinhardt.com
State of Florida Certificate of Authorization No. 9149

TO THE BEST OF THE ENGINEER'S KNOWLEDGE
THE PLANS AND SPECIFICATIONS COMPLY WITH
THE APPLICABLE MINIMUM BUILDING CODES

ROBERT J. REINHART
FL. P.E. NO. 50076



Engineering Design
Technologies Corp.
P.O. Box 152403
Tampa, FL 33684-2403
813.289.8080
813.282.9184 FAX
engineering@edt1.com

CITY of TAMPA
WASTEWATER DEPARTMENT


KRAUSE PS REHABILITATION
ELEVATION

RED LINES

NO CHANGES

DRAWN: RC, KC
DESIGN: RR
QC: RR
DATE: 06/03/14

SHEET S-28

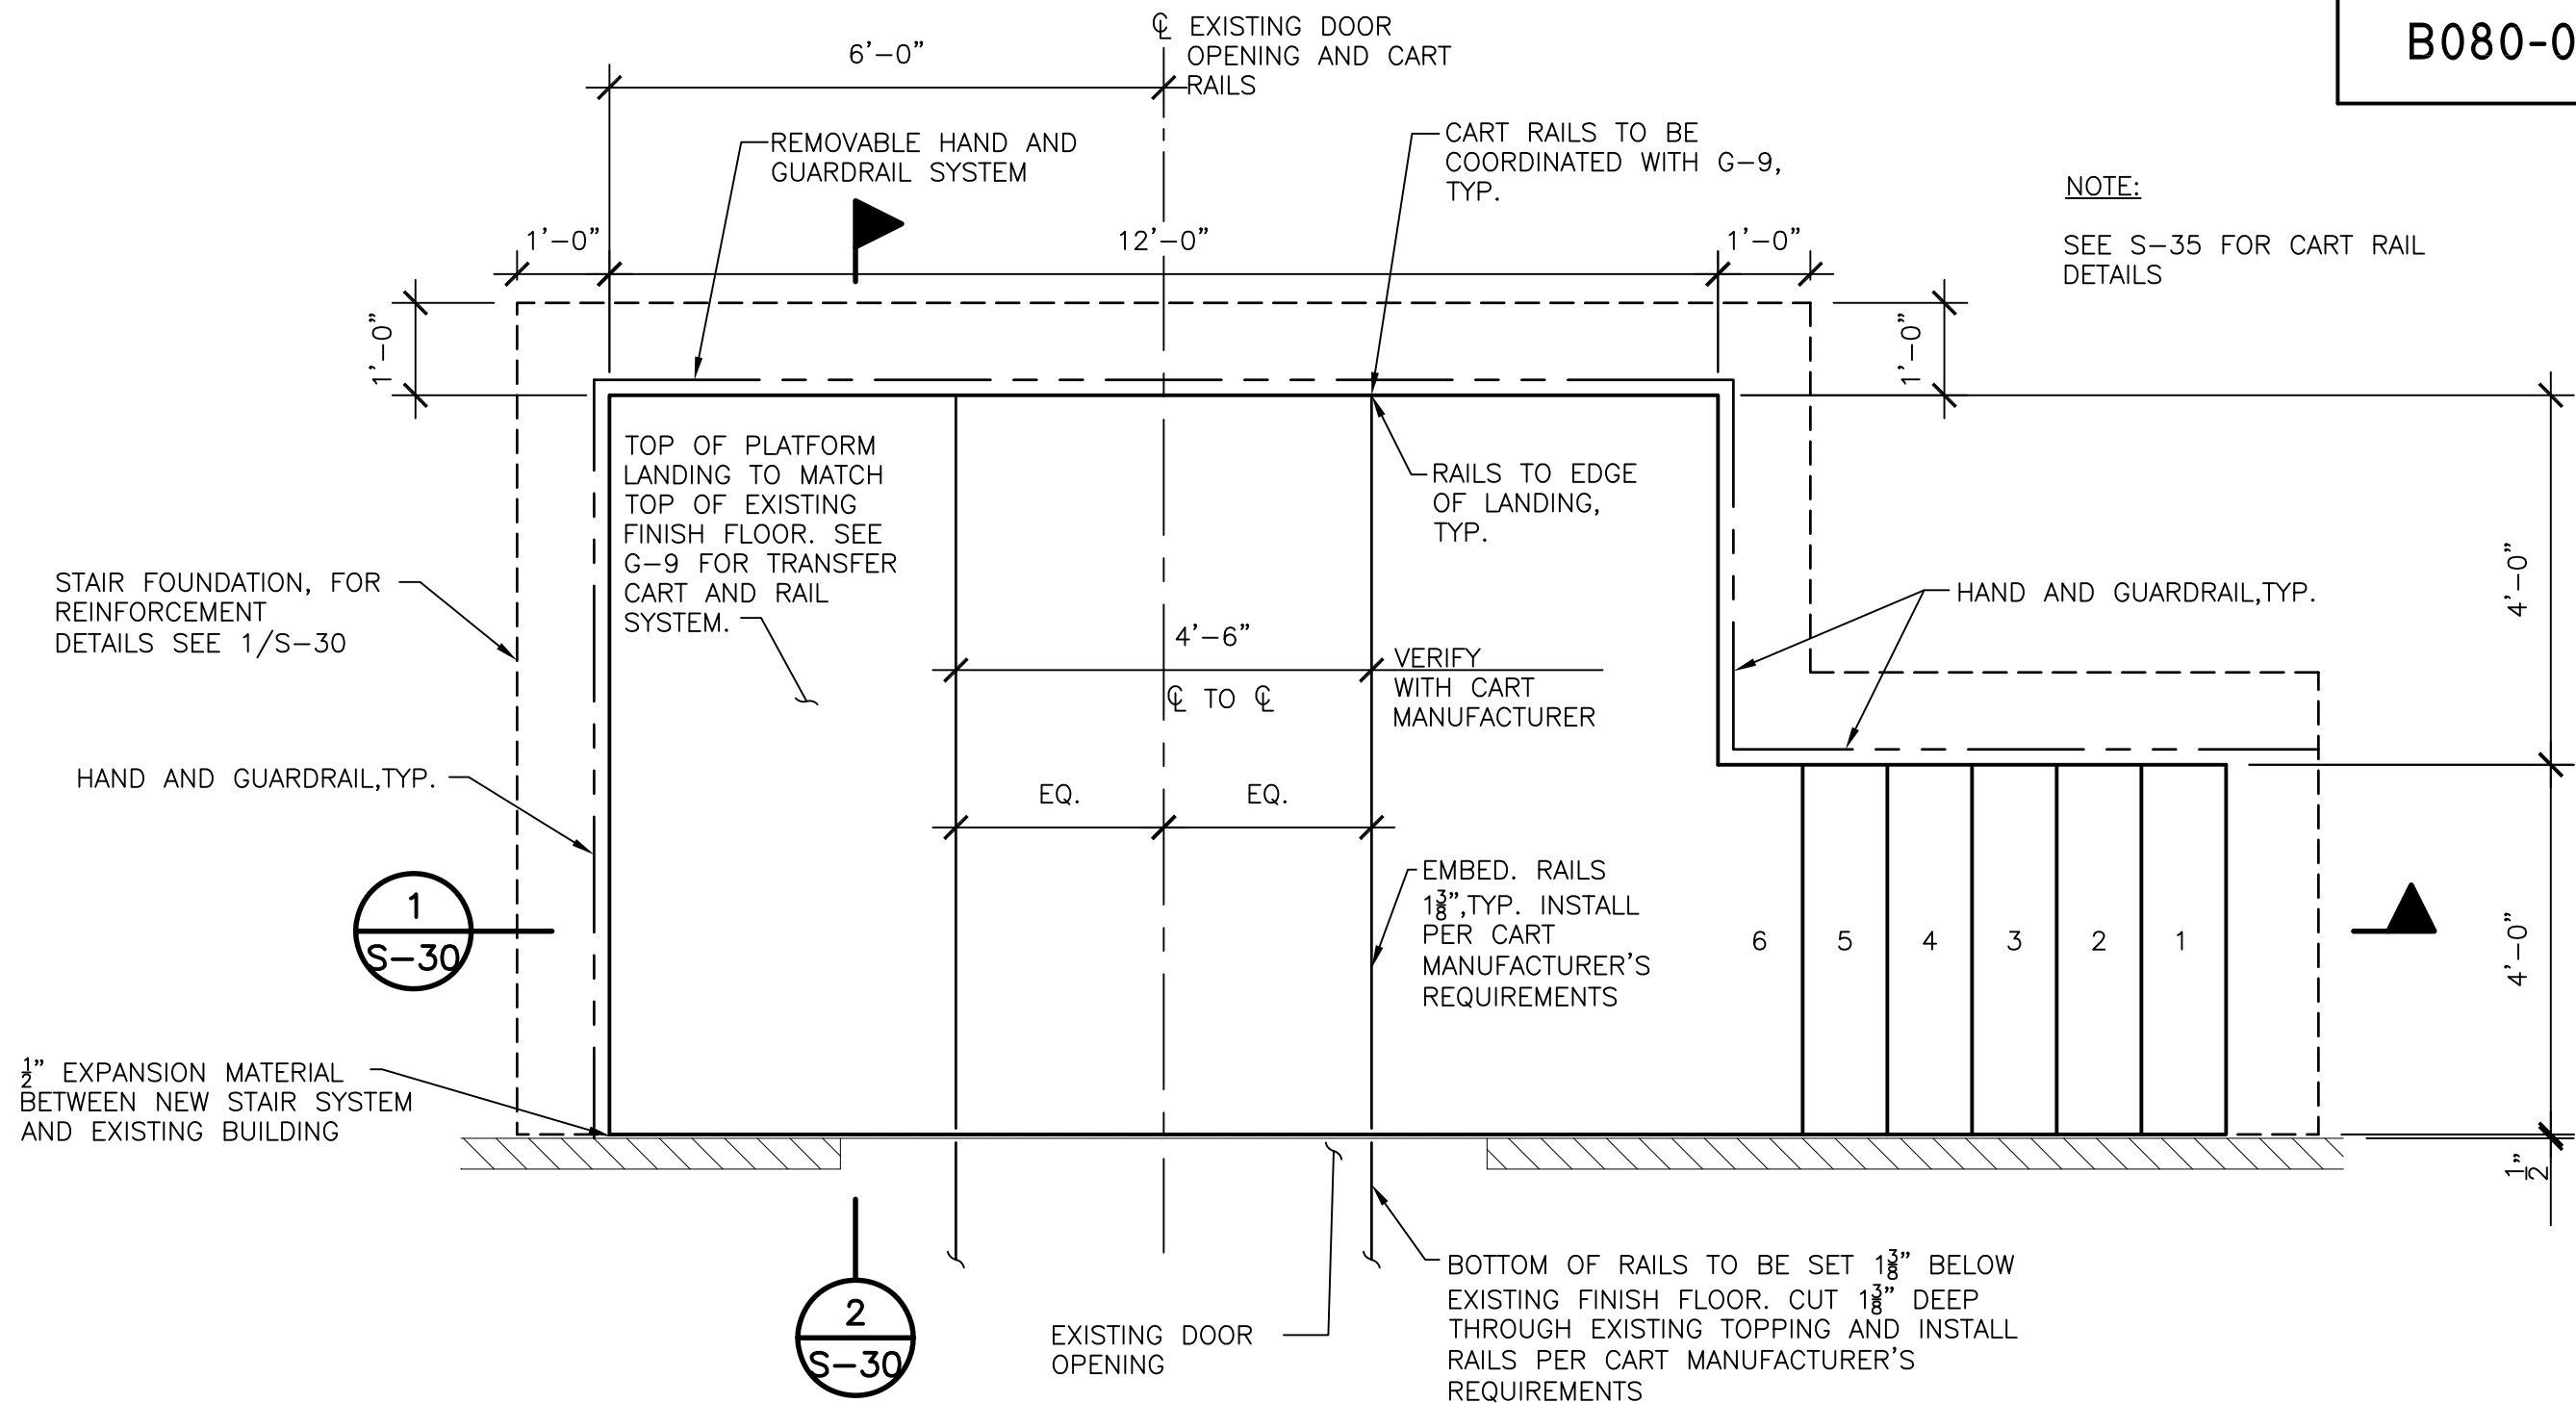

1 LIFTED ACCESS STAIR & PLATFORM PLAN N
S-29 SCALE: 1/2" = 1'-0"

billerreinhardt
ENGINEERING GROUP INC.
3434 colwell avenue suite 100, tampa, florida 33614
telephone : 813.908.7203 fax : 813.931.5200
email : info@billerreinhardt.com
State of Florida Certificate of Authorization No. 9149

ROBERT J. REINHART
FL. P.E. NO. 50076

EDT Engineering Design
Technologies Corp.
P.O. Box 152403
Tampa, FL 33684-2403
813.289.8080
813.282.9184 FAX
engineering@edt1.com

Certificate of Authorization Number: 4795

CITY of TAMPA
WASTEWATER DEPARTMENT


KRAUSE PS REHABILITATION
PLAN

RED LINES


NO CHANGES

DRAWN: RC, KC
DESIGN: RR
QC: RR
DATE: 06/03/14

1 1/27/15
NO. DATE CONFORMED
SHEET S-29

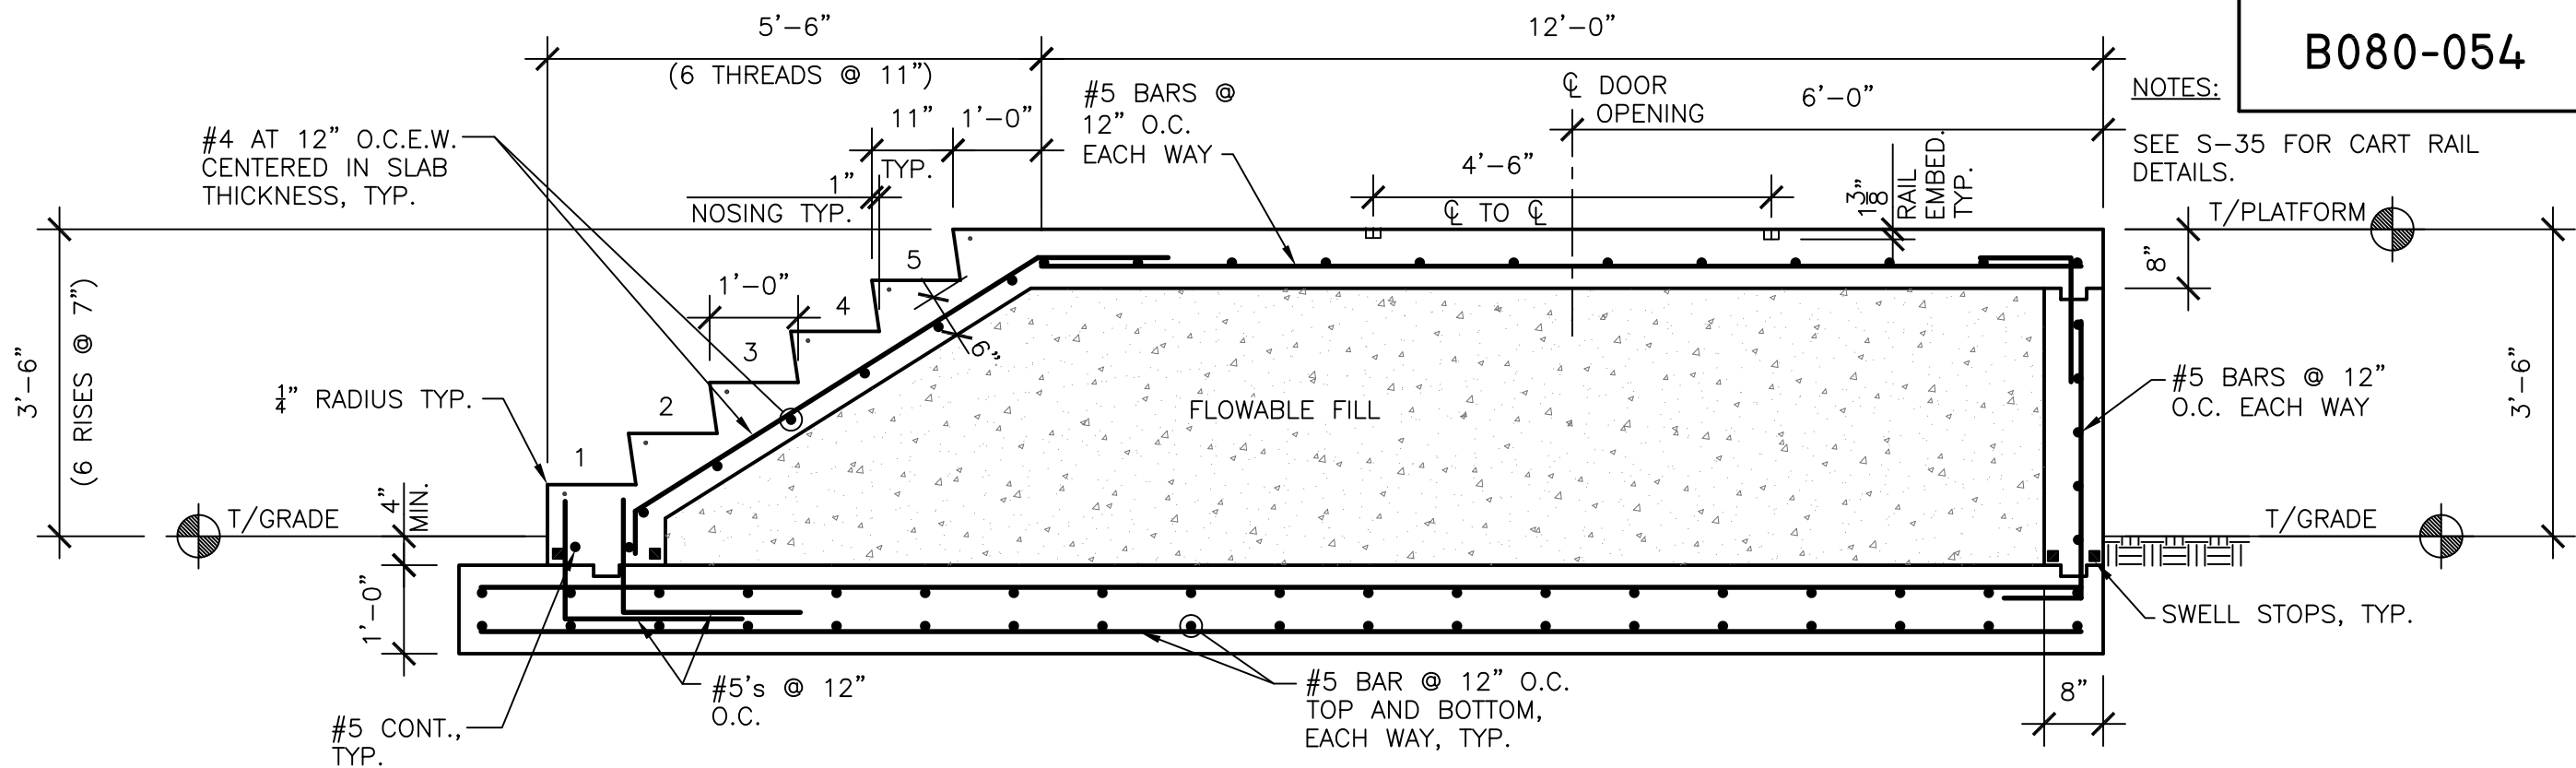

1 LIFTED ACCESS STAIR & PLATFORM SECTION
S-30 SCALE: 1/2" = 1'-0"

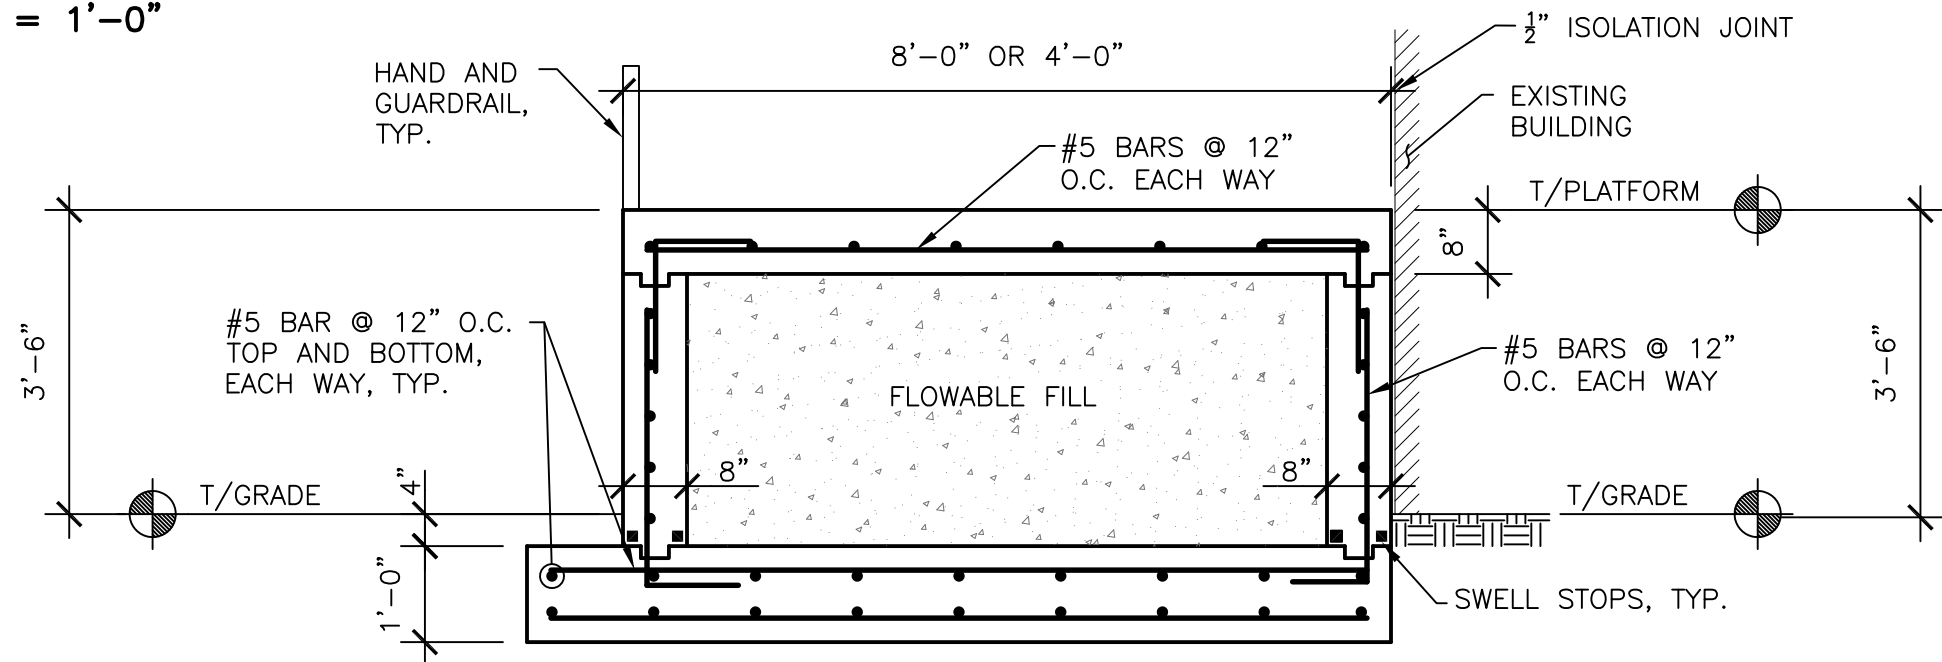

2 TYPICAL STAIR SECTION
S-30 SCALE: 1/2" = 1'-0"

billerreinhardt
ENGINEERING GROUP INC.
3434 colwell avenue suite 100, tampa, florida 33614
telephone : 813.908.7203 fax : 813.931.5200
email : info@billerreinhardt.com
State of Florida Certificate of Authorization No. 9149
ROBERT J. REINHART
FL. P.E. NO. 50076



Engineering Design
Technologies Corp.
P.O. Box 152403
Tampa, FL 33684-2403
813.289.8080
813.282.9184 FAX
engineering@edt1.com

CITY of TAMPA
WASTEWATER DEPARTMENT

KRAUSE PS REHABILITATION

SECTION


RED LINES

NO CHANGES

DRAWN: RC, KC
DESIGN: RR
C: RR
DATE: 06/03/14

SHEET S-30

Certificate of Authorization Number: 4795

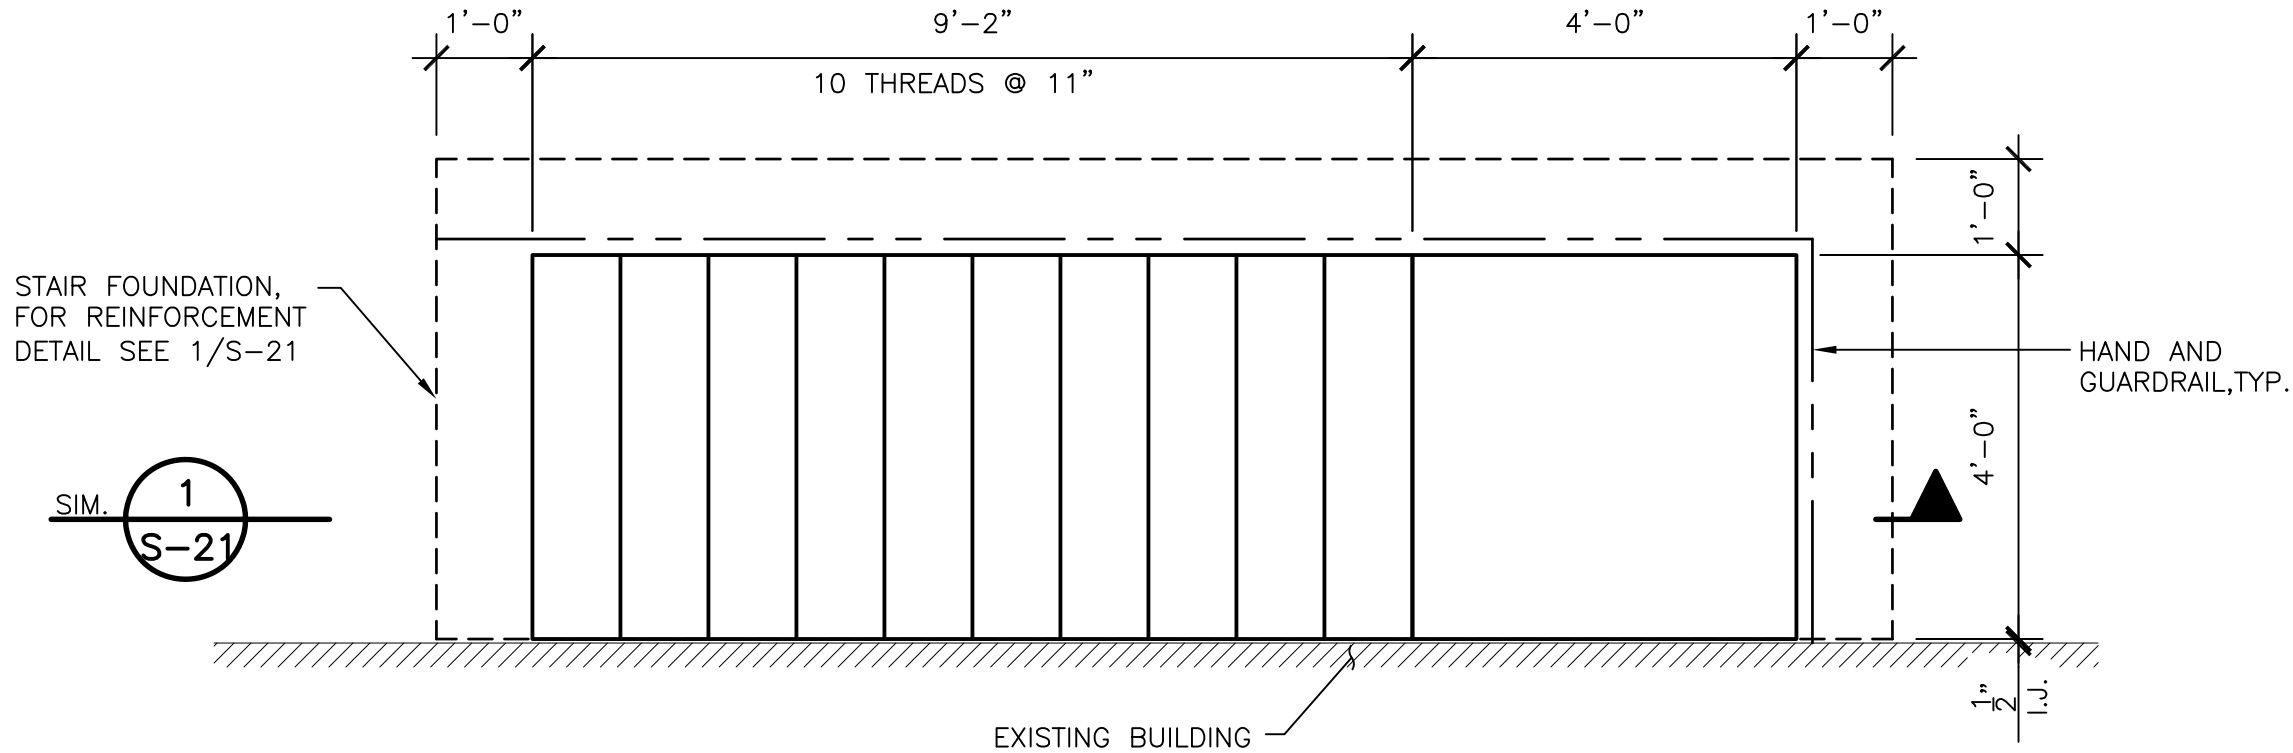

1 EXTERIOR STAIR PLAN
S-31 SCALE: 1/2" = 1'-0"

3434 colwell avenue suite 100, tampa, florida 33614
telephone : 813.908.7203 fax : 813.931.5200
email : info@billerreinhardt.com
State of Florida Certificate of Authorization No. 9149

TO THE BEST OF THE ENGINEER'S KNOWLEDGE,
THE PLANS AND SPECIFICATIONS COMPLY WITH
THE APPLICABLE MINIMUM BUILDING CODES.

ROBERT J. REINHART
FL. P.E. NO. 50076

**Engineering Design
Technologies Corp.**
P.O. Box 152403
Tampa, FL 33684-2403
813.289.8080
813.282.9184 FAX
engineering@edt1.com

Certificate of Authorization Number: 4795

CITY of TAMPA
WASTEWATER DEPARTMENT

KRAUSE PS REHABILITATION


PLAN

RED LINES
NO CHANGES

1	1/27/14
NO.	DATE

DRAWN: RC, KC
DESIGN: RR
QC: RR
DATE: 06/03/14


SHEET S-31

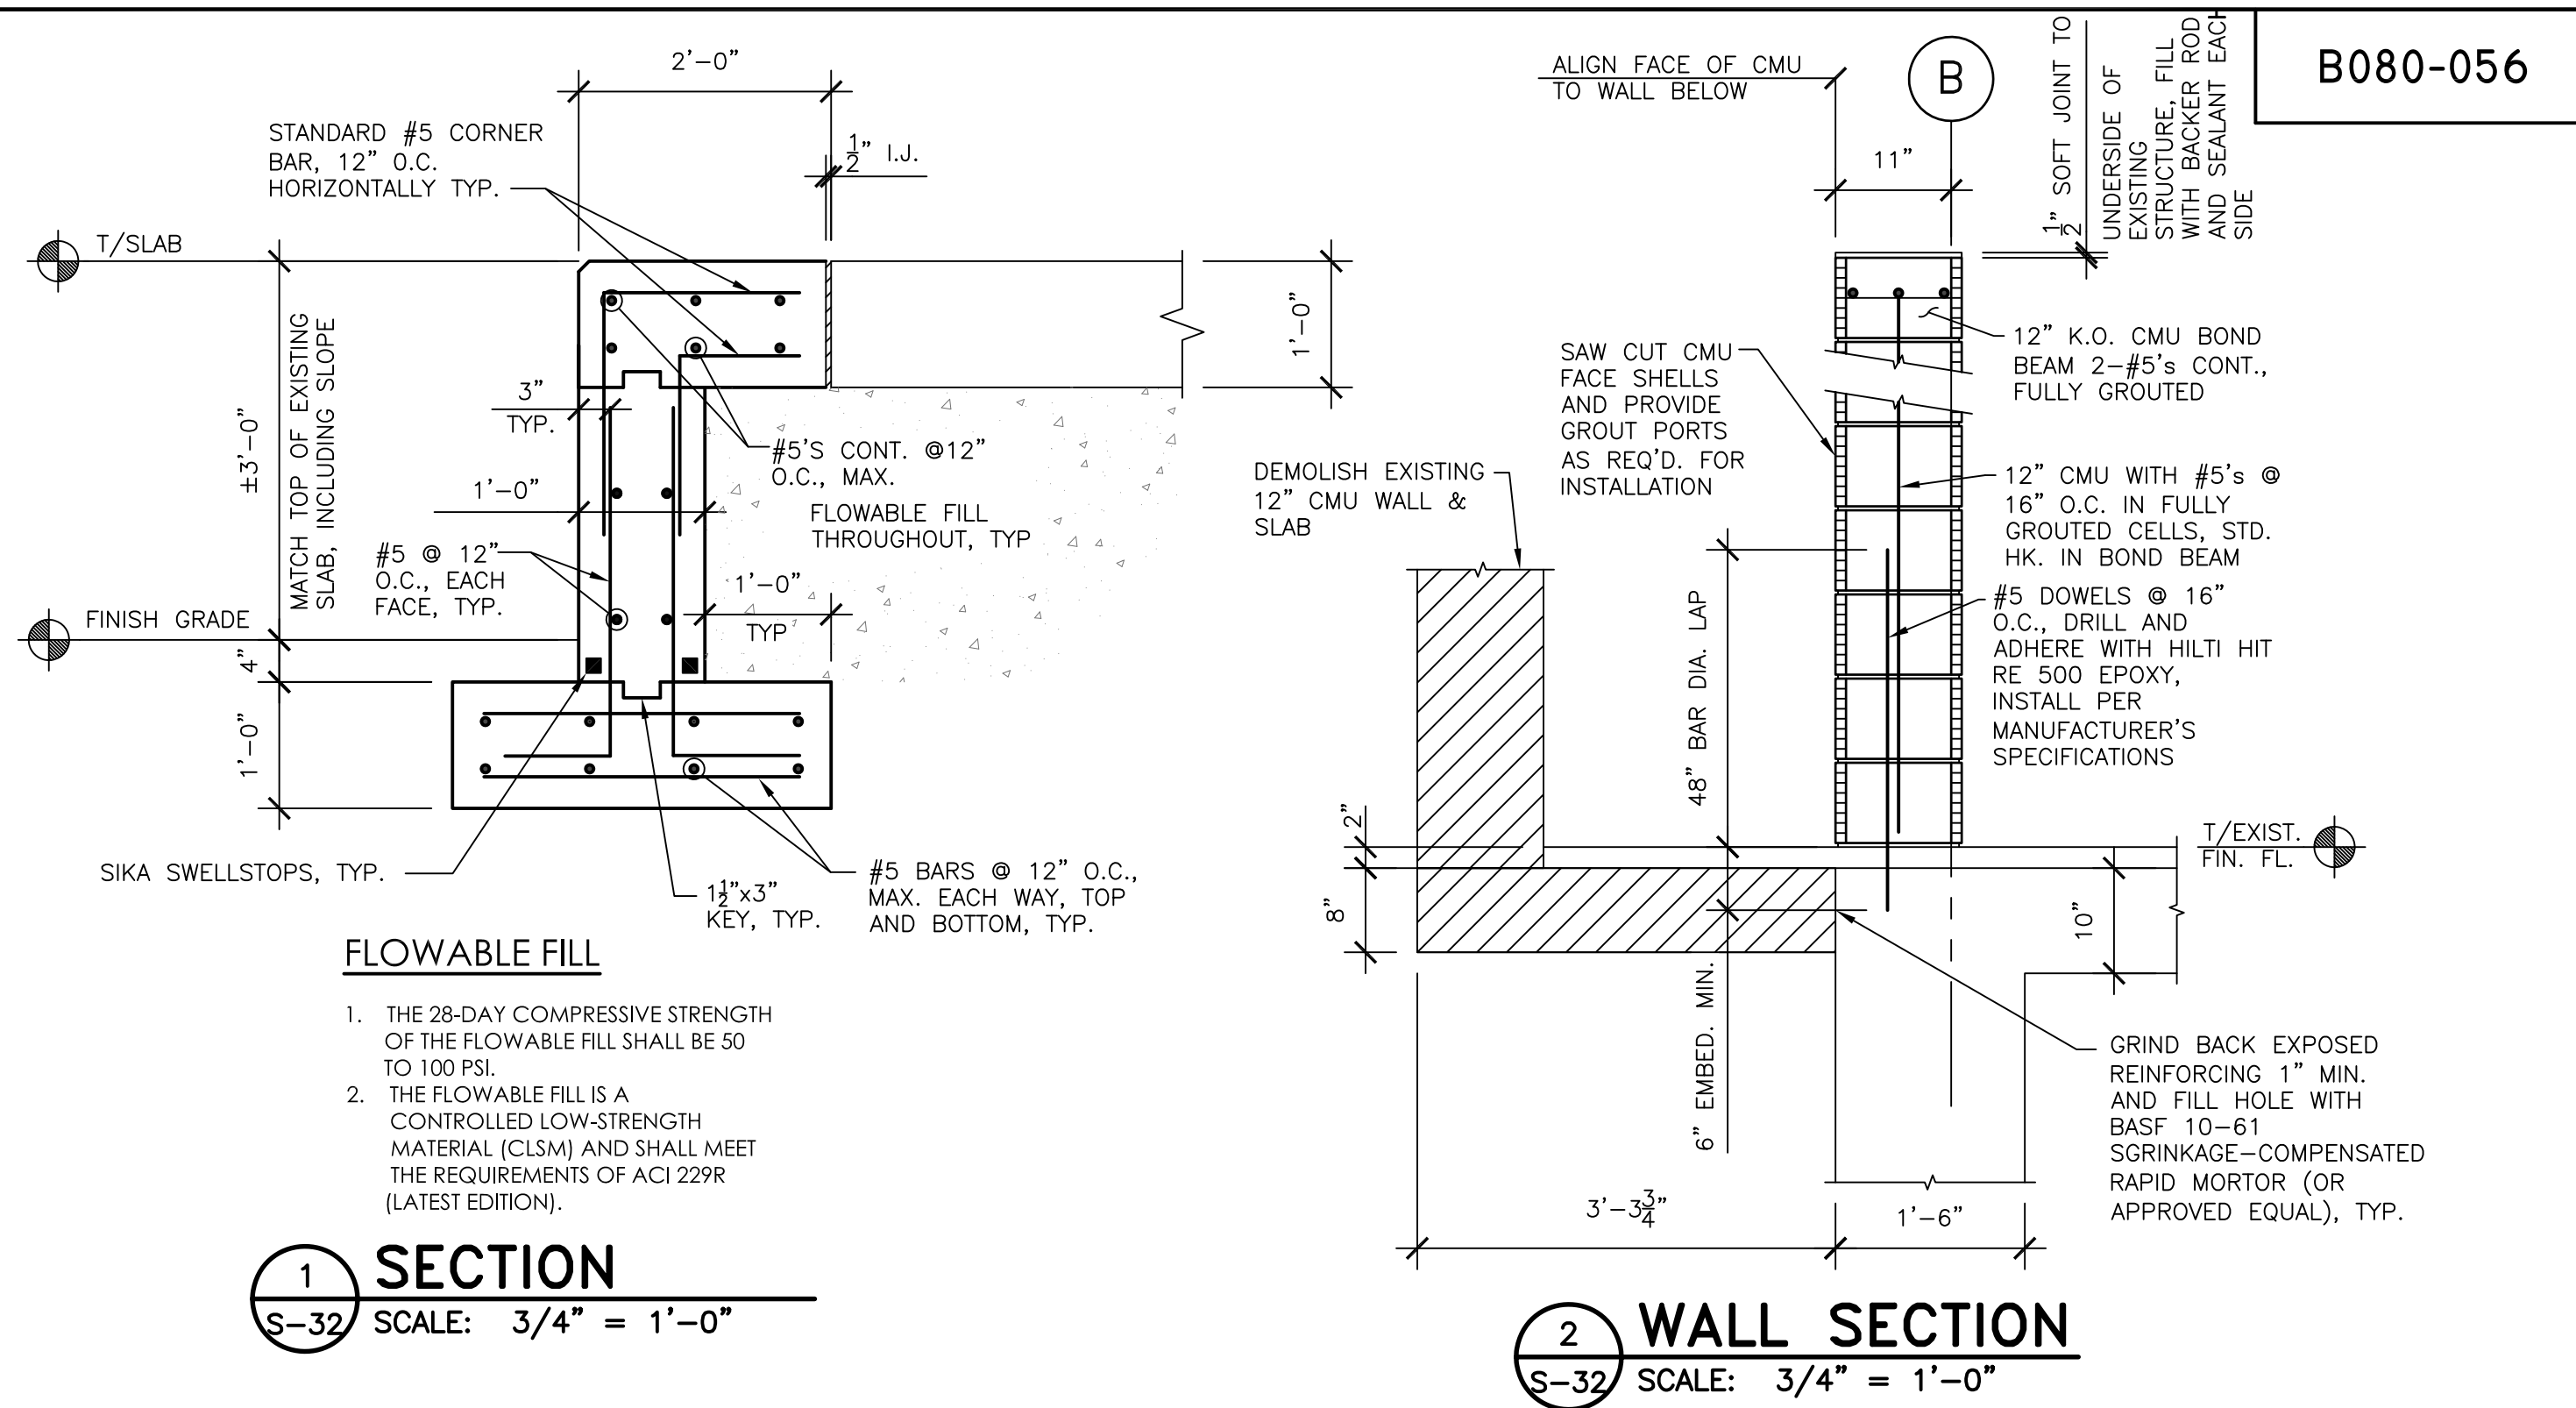

billerreinhardt
ENGINEERING GROUP INC.
3434 colwell avenue suite 100, tampa, florida 33614
telephone : 813.908.7203 fax : 813.931.5200
email : info@billerreinhardt.com
State of Florida Certificate of Authorization No. 9149

TO THE BEST OF THE ENGINEER'S KNOWLEDGE
THE PLANS AND SPECIFICATIONS COMPLY WITH
THE APPLICABLE MINIMUM BUILDING CODES


ROBERT J. REINHART
FL. P.E. NO. 50076

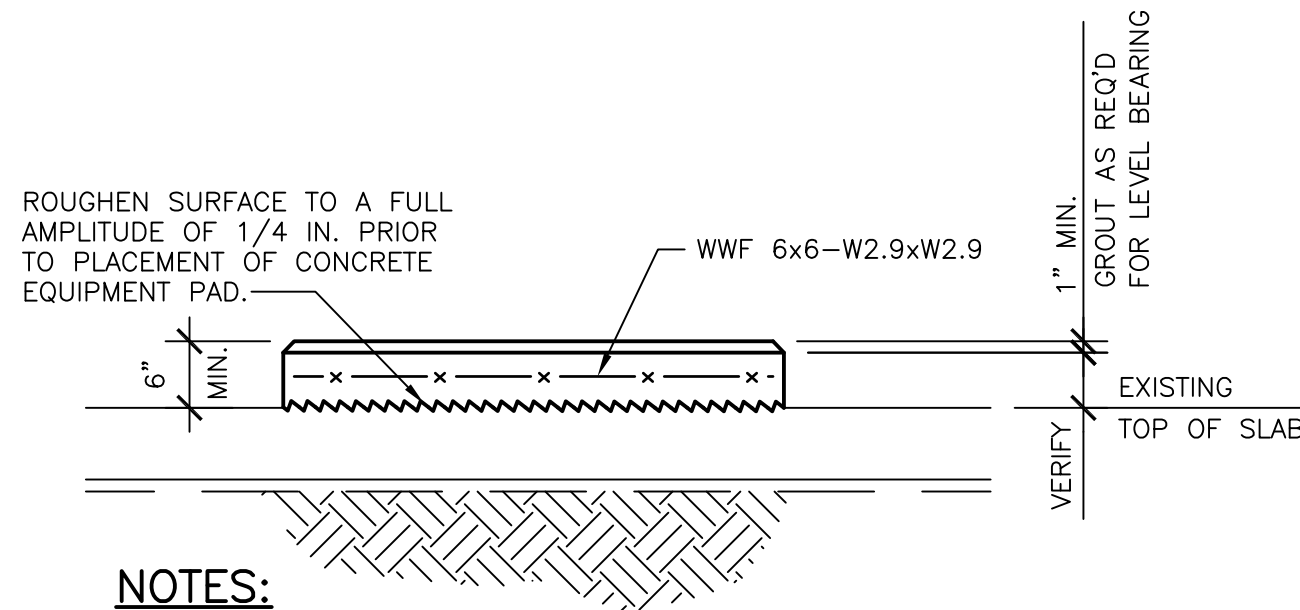

- NOTES:

1. PAD SIZE IN PLAN SHALL BE AS REQUIRED BY MECHANICAL SPECIFICATIONS OR AS REQUIRED TO FULLY SUPPORT EQUIPMENT.
2. CONTRACTOR SHALL VERIFY EQUIPMENT PAD LOCATIONS WITH FINAL MECH. DRAWINGS AND SPECIFICATIONS PRIOR TO CONSTRUCTION. EQUIPMENT SHALL BE INSTALLED AS PER THE MANUFACTURER'S INSTRUCTIONS.

1 MECHANICAL PAD
S-33 SCALE: 3/4" = 1'-0"

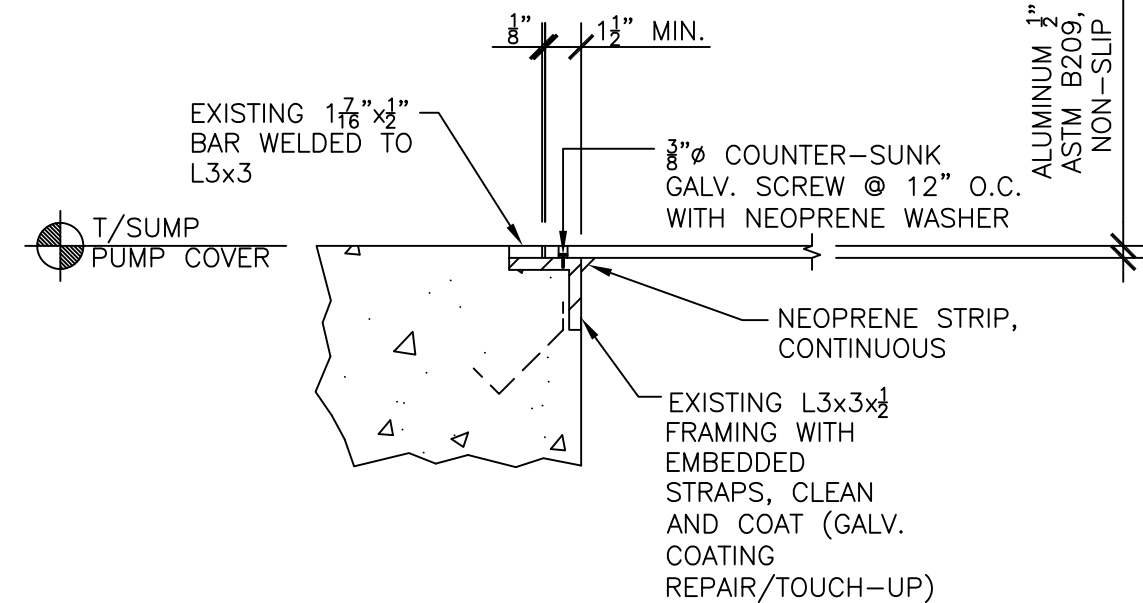

2 SUMP PUMP COVER
S-33 SCALE: 1-1/2" = 1'-0"



Certificate of Authorization Number: 4795

**- Engineering Design
Technologies Corp.**
P.O. Box 152403
Tampa, FL 33684-2403
813.289.8080
813.282.9184 FAX
engineering@edt1.com

CITY of TAMPA
WASTEWATER DEPARTMENT

KRAUSE PS REHABILITATION

SECTIONS & DETAILS

RED LINES

NO CHANGES


DRAWN: RC, KC
DESIGN: RR
QC: RR
DATE: 06/03/14

SHEET S-33




TO THE BEST OF THE ENGINEER'S KNOWLEDGE,
THE PLANS AND SPECIFICATIONS COMPLY WITH
THE APPLICABLE MINIMUM BUILDING CODES

ROBERT J. REINHART
FL. P.E. NO. 50076

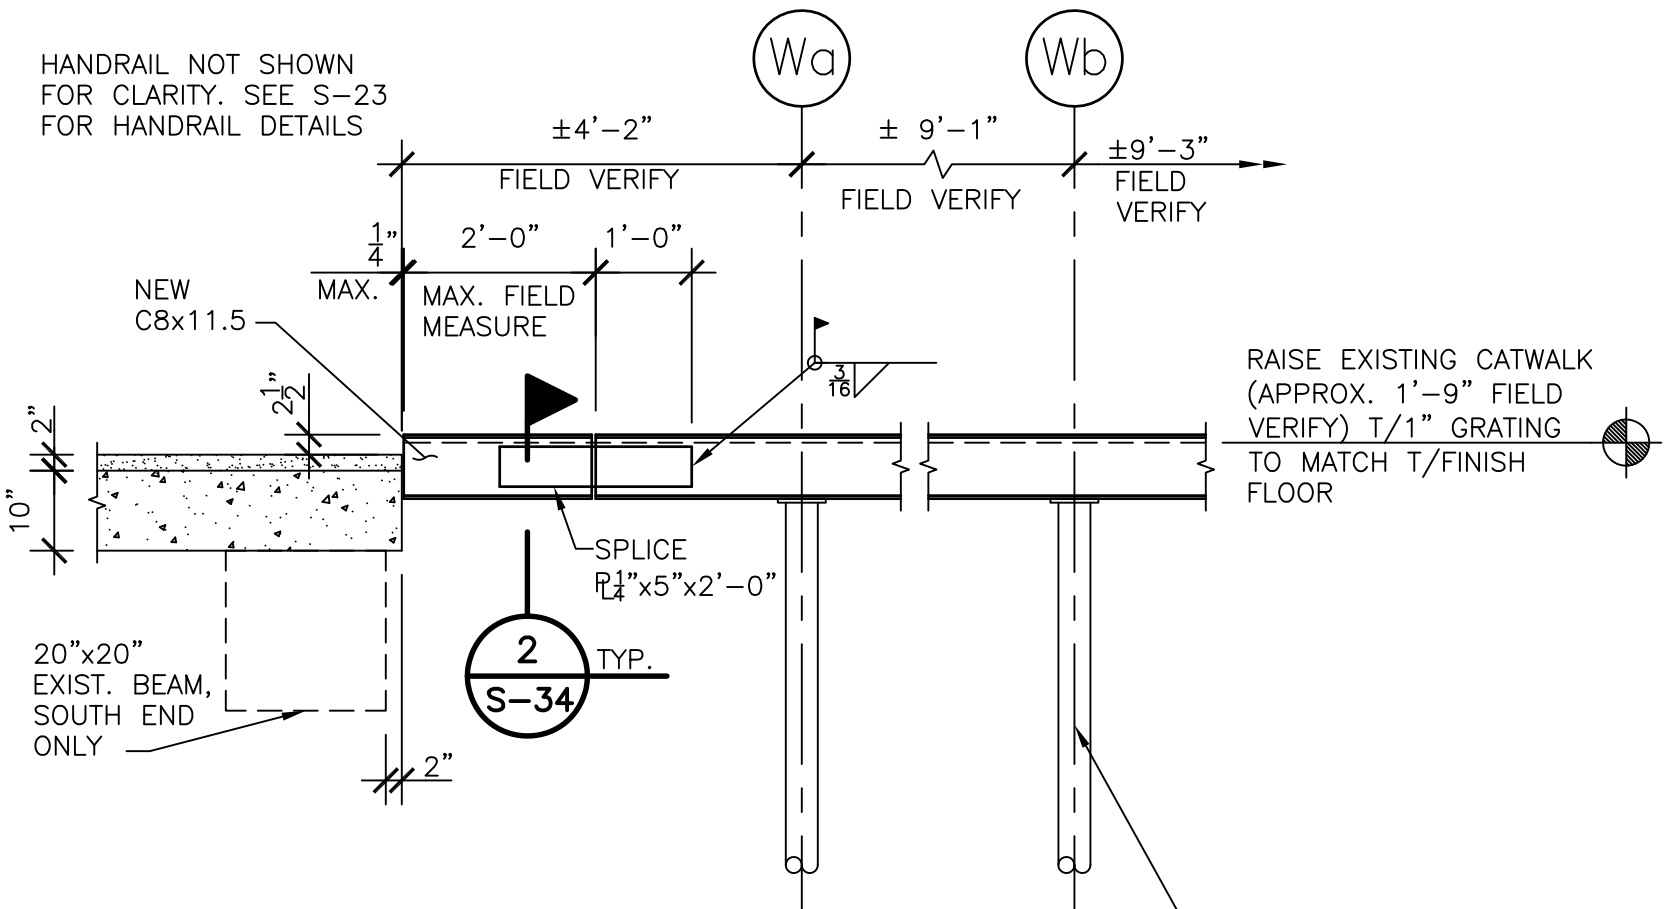

- NOTES:
1. REMOVE EXISTING CATWALK STAIRS.
 2. INSTALL NEW HANDRAIL/GUARDRAIL.
 3. CLEAN AND RECOAT STEEL COMPONENTS.
- AT 10 LOCATIONS, REMOVE AND REPLACE IN KIND ALL CATWALK SUPPORTS TO ELEVATE CATWALK FRAMING, INCLUDING BUT NOT LIMITED TO:
- COLUMN BASE AND CAP PLATES WITH ALL BOLTS AS REQ'D.
 - $2\frac{1}{2}" \phi$ EXTRA STRONG PIPE COLUMNS
 - ANGLE CROSS BRACING


1 CATWALK SECTION
S-34 SCALE: $1/2" = 1'-0"$

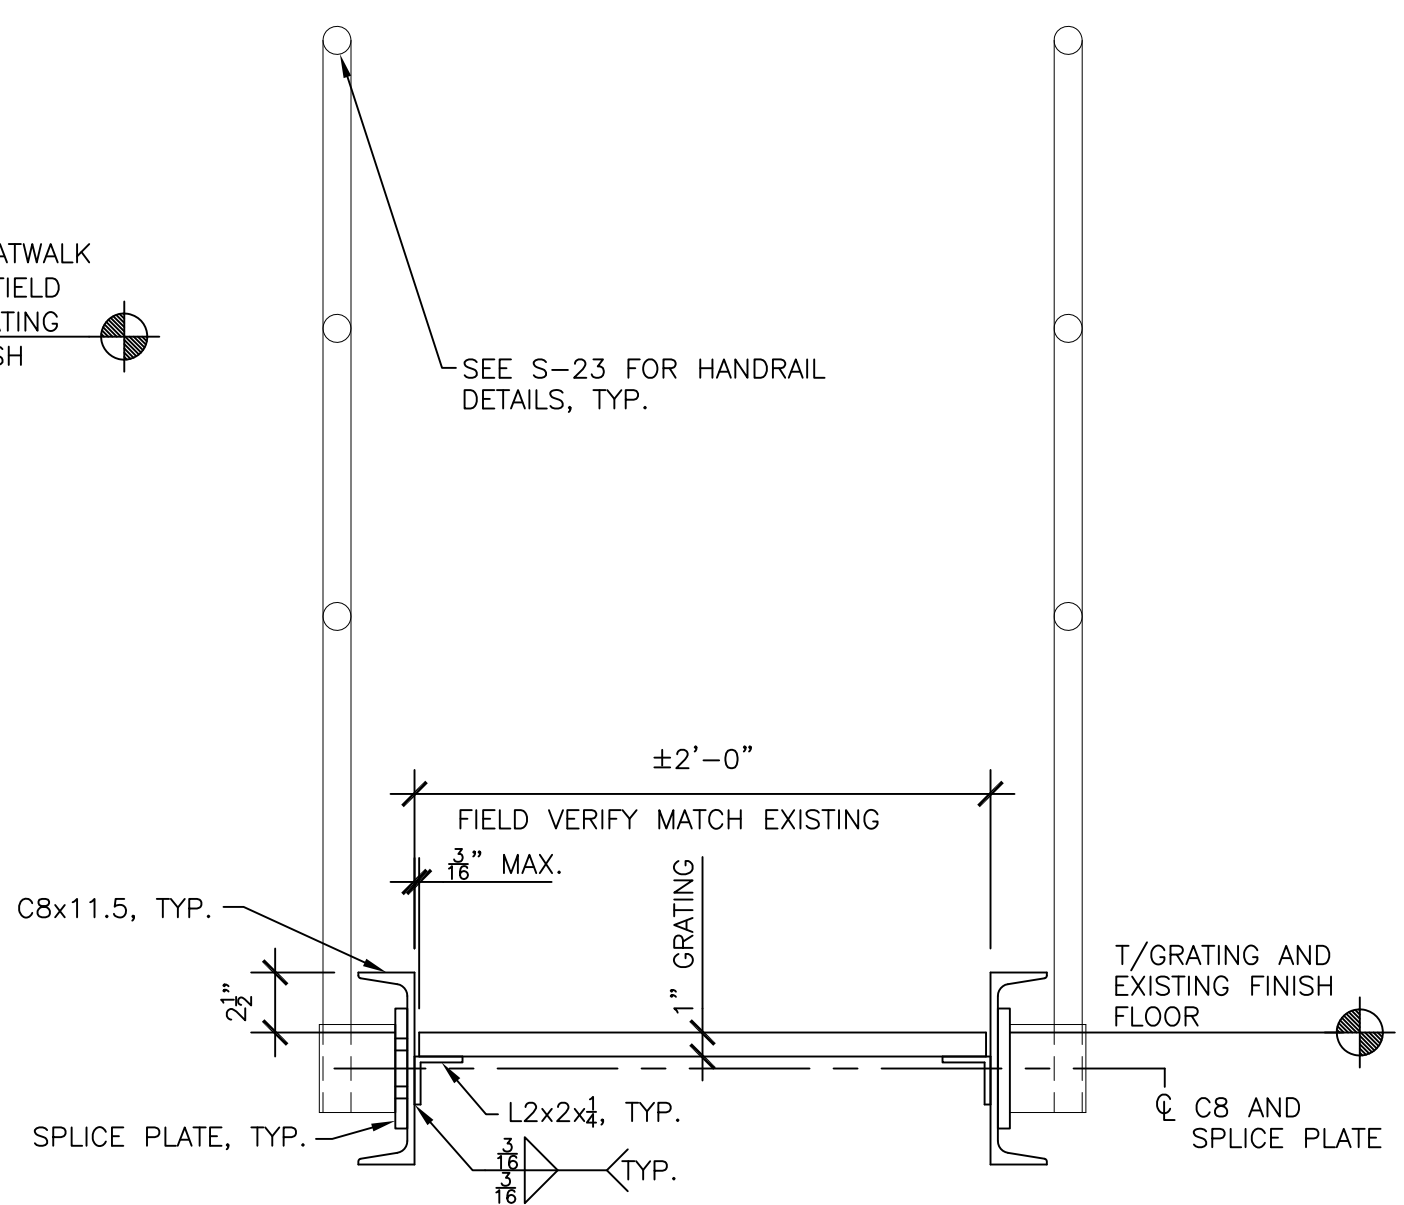


2 CATWALK SECTION
S-34 SCALE: $1-1/2" = 1'-0"$

billerreinhardt
ENGINEERING GROUP INC.
3434 colwell avenue suite 100, tampa, florida 33614
telephone : 813.908.7203 fax : 813.931.5200
email : info@billerreinhardt.com
State of Florida Certificate of Authorization No. 9149


ROBERT J. REINHART
FL. P.E. NO. 50076

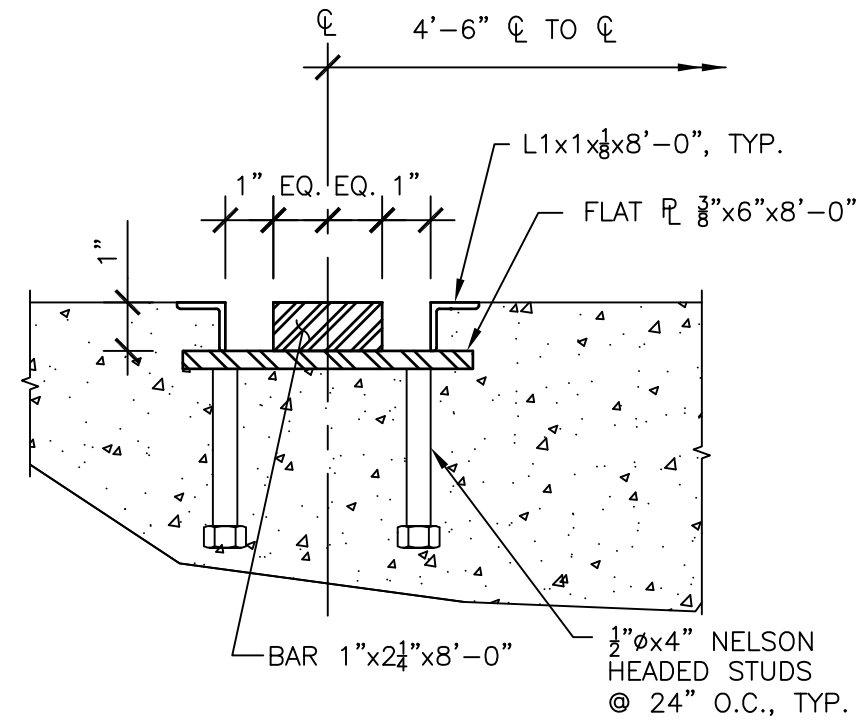

TYPICAL RAIL

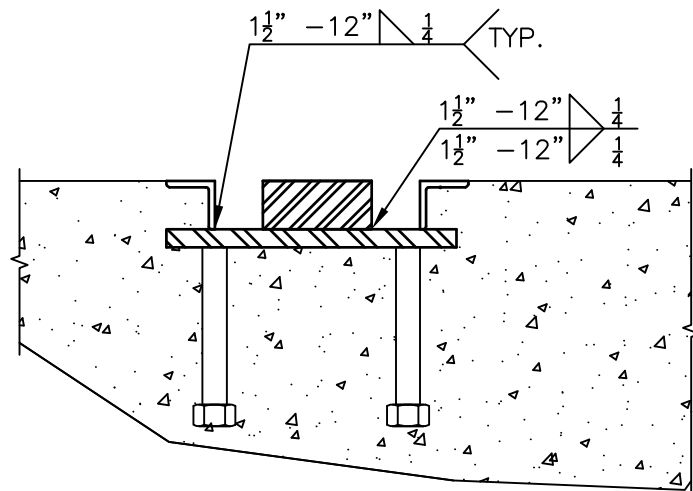

TYPICAL WELD

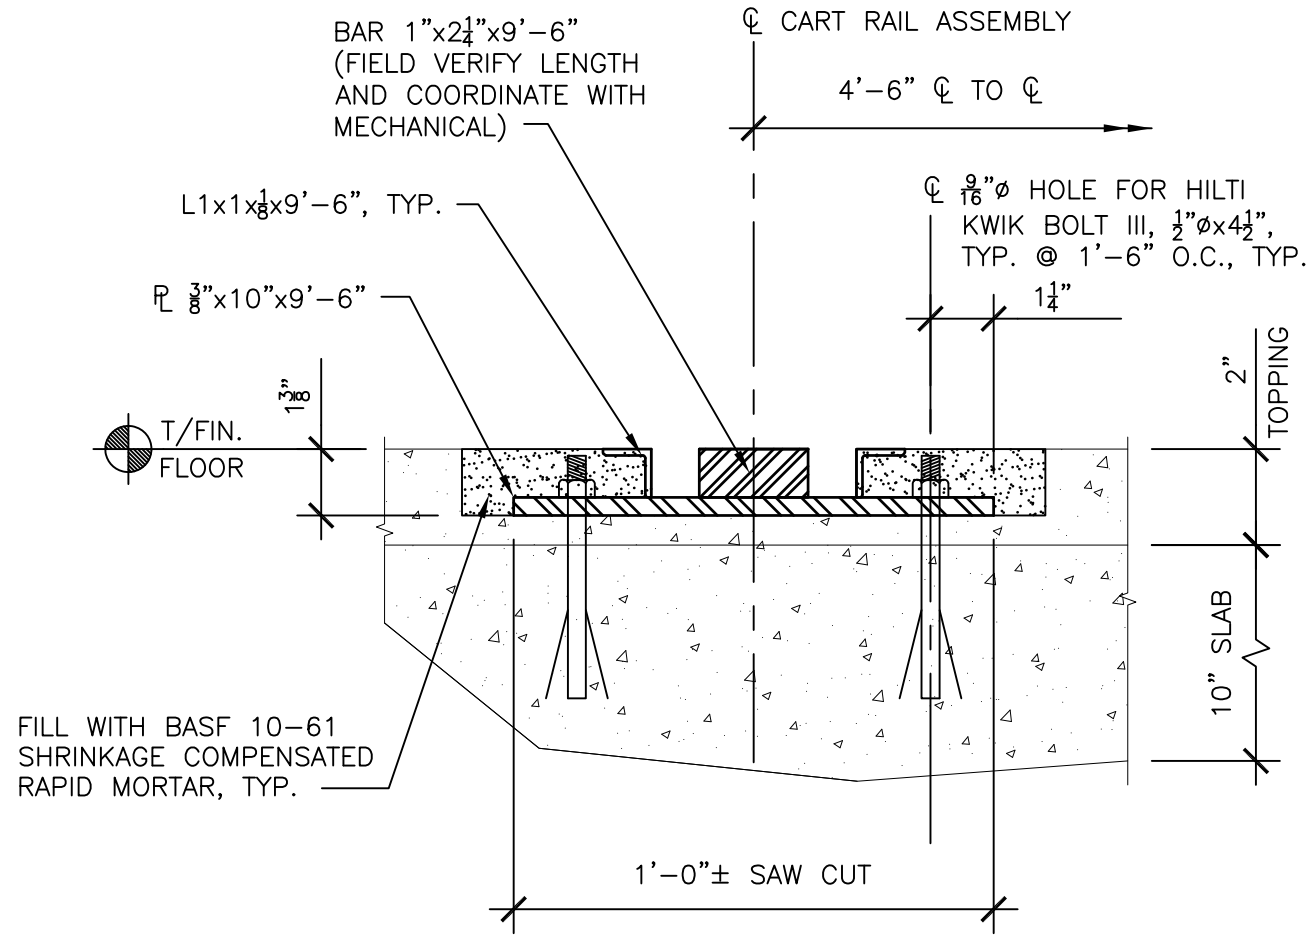

ALTERNATE © INTERIOR EXISTING SLAB

NOTE: VERIFY CART RAIL ASSEMBLIES WITH CART MANUFACTURER

1 RAIL DETAILS
S-35 SCALE: N.T.S.

billerreinhardt
ENGINEERING GROUP INC.
3434 colwell avenue suite 100, tampa, florida 33614
telephone : 813.908.7203 fax : 813.931.5200
email : info@billerreinhardt.com
State of Florida Certificate of Authorization No. 9149
ROBERT J. REINHART
FL. P.E. NO. 50076



Engineering Design
Technologies Corp.
P.O. Box 152403
Tampa, FL 33684-2403
813.289.8080
813.282.9184 FAX
engineering@edt1.com

CITY of TAMPA
WASTEWATER DEPARTMENT

KRAUSE PS REHABILITATION


SECTIONS &
DETAILS

RED LINES

NO CHANGES

DRAWN: RC, KC
DESIGN: RR
QC: RR
DATE: 06/03/14

SHEET S-35

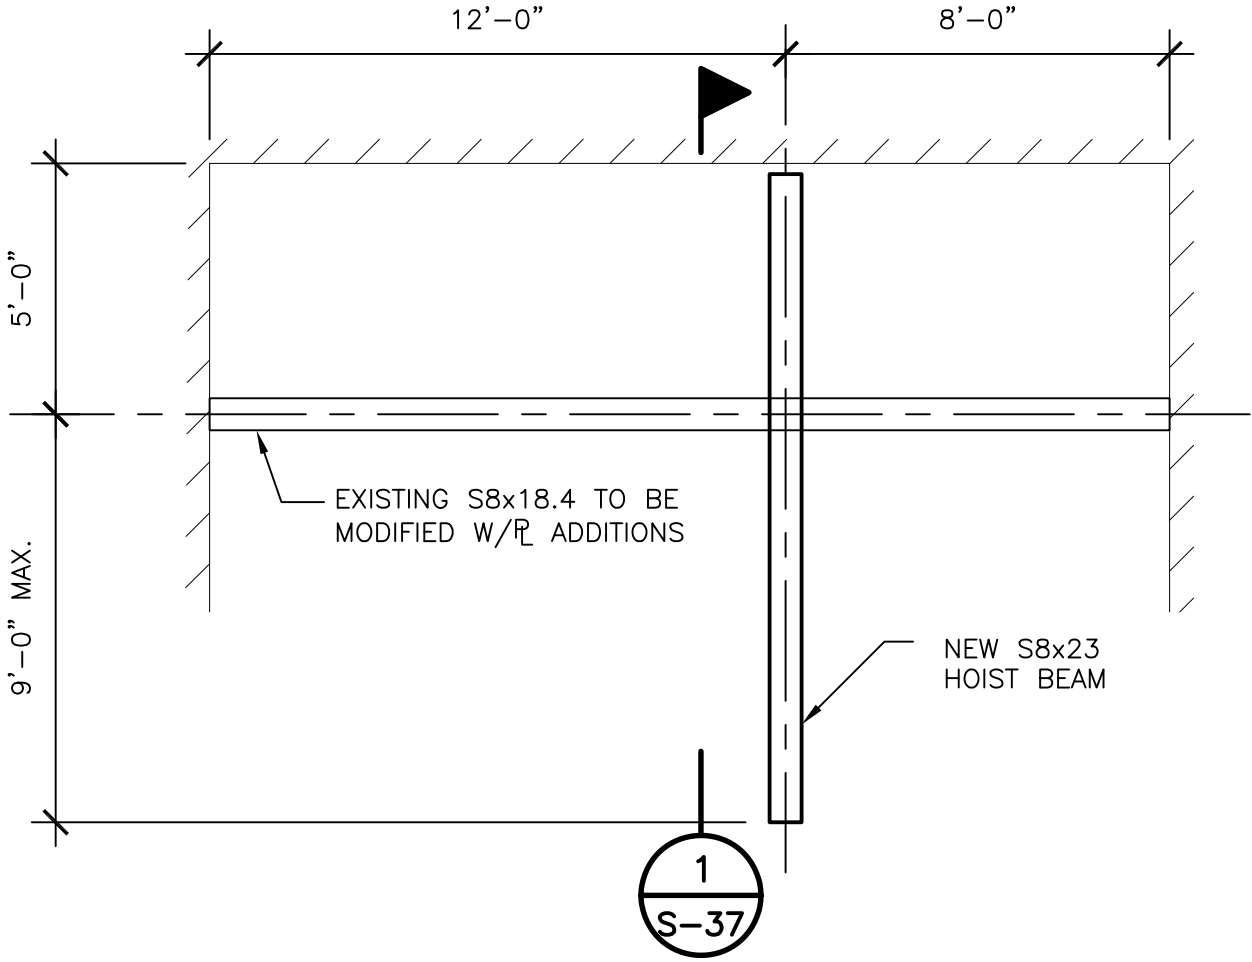

1 HOIST BEAM PLAN
S-36 SCALE: N.T.S.

3434 colwell avenue suite 100, tampa, florida 33614
telephone : 813.908.7203 fax : 813.931.5200
email : info@billerreinhardt.com
State of Florida Certificate of Authorization No. 9149

TO THE BEST OF THE ENGINEER'S KNOWLEDGE
THE PLANS AND SPECIFICATIONS COMPLY WITH
THE APPLICABLE MINIMUM BUILDING CODES

ROBERT J. REINHART
FL. P.E. NO. 50076



**Engineering Design
Technologies Corp.**
P.O. Box 152403
Tampa, FL 33684-2403
813.289.8080
813.282.9184 FAX
engineering@edt1.com

**CITY of TAMPA
WASTEWATER DEPARTMENT**

KRAUSE PS REHABILITATION

HOIST BEAM PLAN


RED LINES

NO CHANGES

DRAWN: RC, KC
DESIGN: RR
QC: RR
DATE: 06/03/14

SHEET S-36

1	1/27/15
NO.	DATE

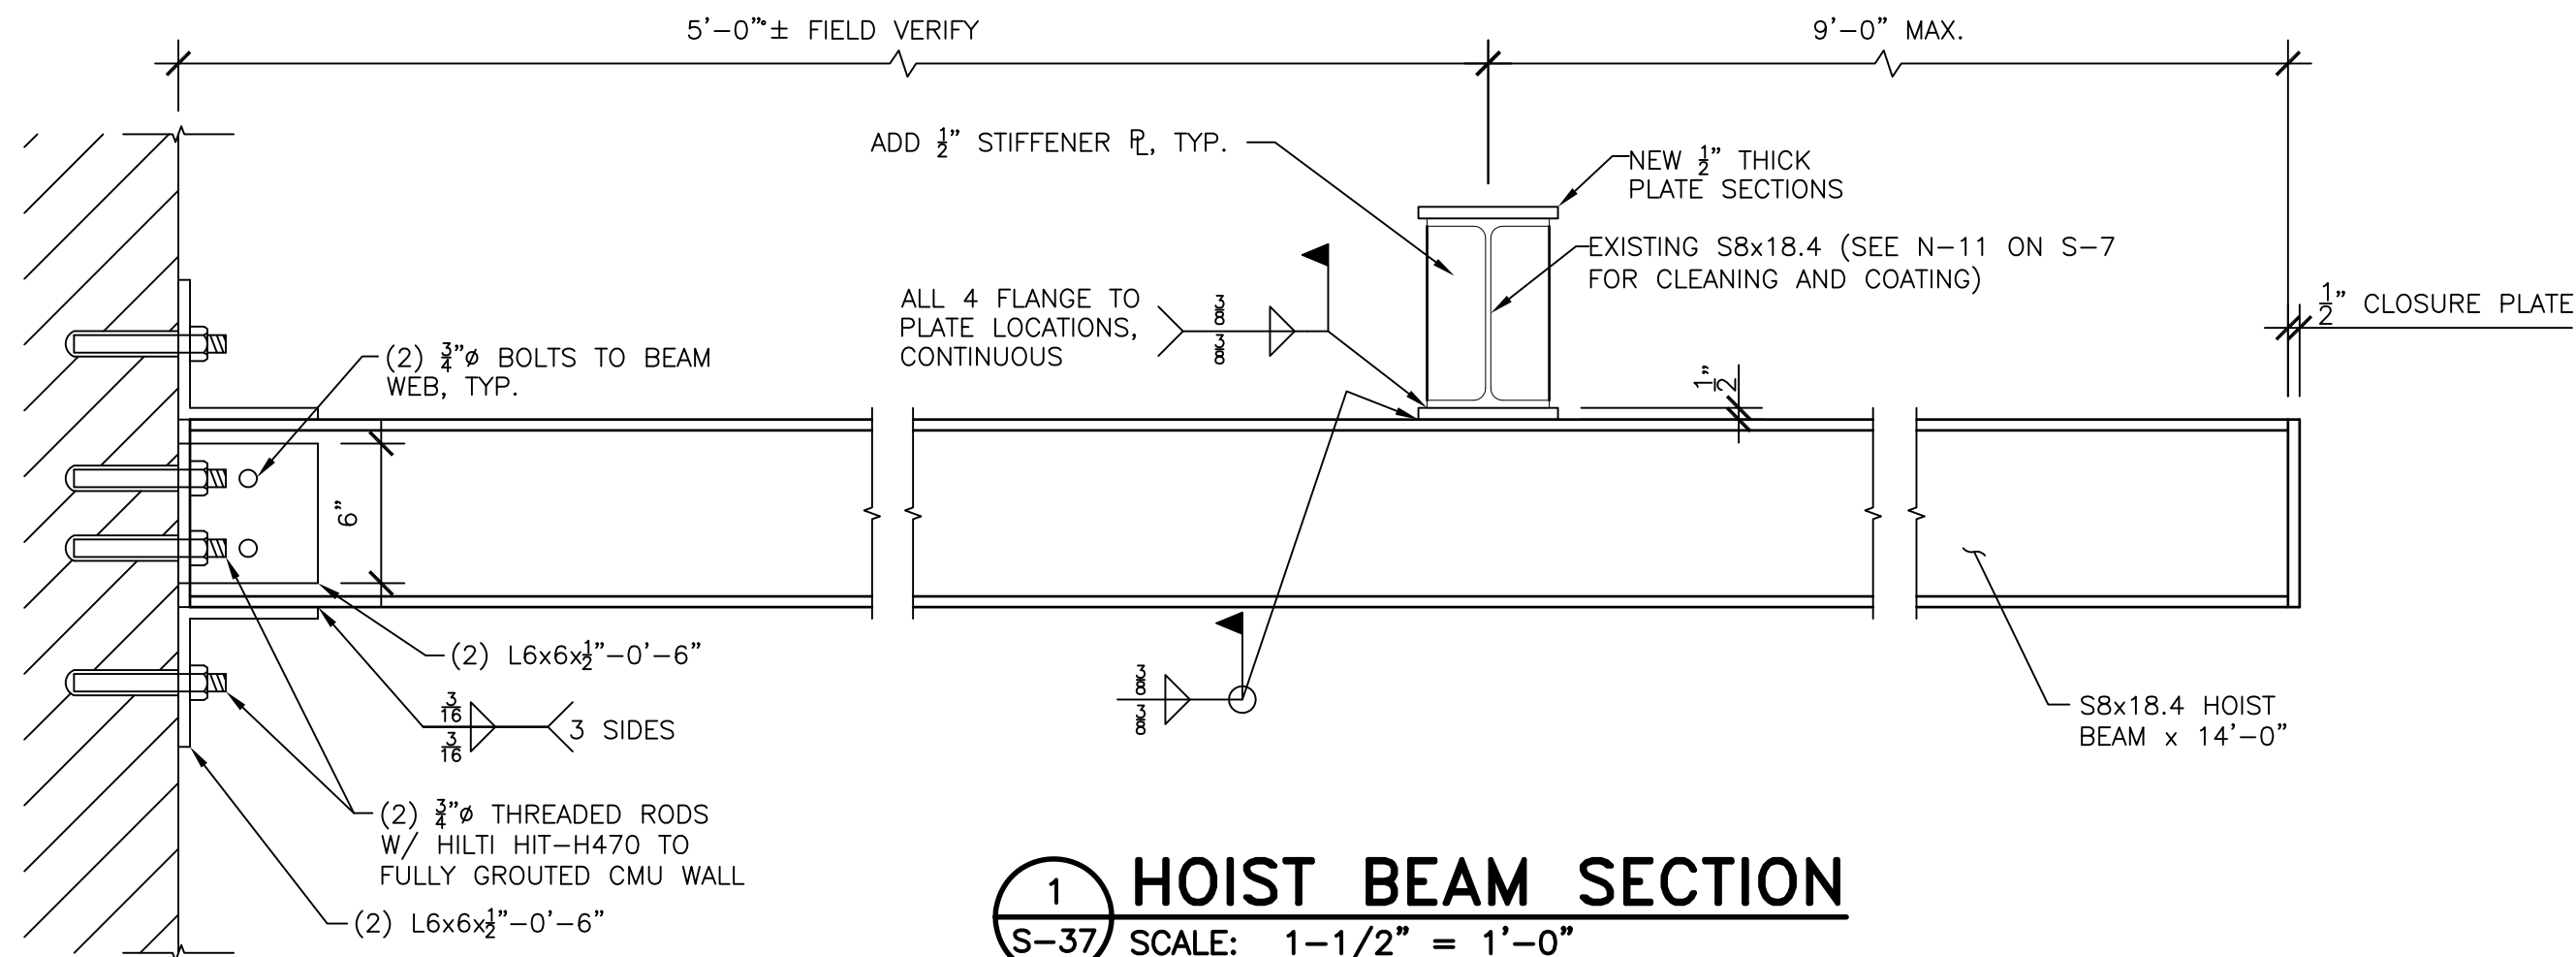

billerreinhardt
ENGINEERING GROUP INC.
3434 colwell avenue suite 100, tampa, florida 33614
telephone : 813.908.7203 fax : 813.931.5200
email : info@billerreinhardt.com
State of Florida Certificate of Authorization No. 9149

TO THE BEST OF THE ENGINEER'S KNOWLEDGE
THE PLANS AND SPECIFICATIONS COMPLY WITH
THE APPLICABLE MINIMUM BUILDING CODES

ROBERT J. REINHART
FL. P.E. NO. 50076



**Engineering Design
Technologies Corp.**
P.O. Box 152403
Tampa, FL 33684-2403
813.289.8080
813.282.9184 FAX
engineering@edt1.com

Certificate of Authorization Number: 4795

CITY of TAMPA
WASTEWATER DEPARTMENT

KRAUSE PS REHABILITATION

SECTIONS AND DETAILS

RED LINES

1 1/27/15
NO. DATE























NO CHANGES

DRAWN: RC, KC
DESIGN: RR
CHECKED: RR
DATE: 06/03/14


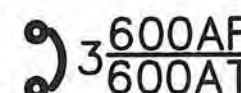

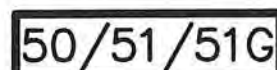











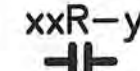








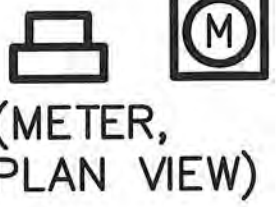
SHEET S-37

LEGEND



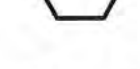


SYMBOL DESCRIPTION

	HEAVY DUTY SAFETY SWITCH
	TRANSFORMER
	FLUORESCENT OR LED FIXTURE – CEILING MTD.
	INCAND., HID OR LED FIXTURE – CEILING MTD.
	INCAND., FLUORESCENT OR LED FIXTURE – STANCHION MTD.
	INCAND., HID OR LED FIXTURE – WALL MTD.
	EMERGENCY EXIT LIGHT
	EMERGENCY LIGHT
	20A, 125V, 3–WIRE DUPLEX RECEPT. CTR. @ 18" AFF.
	20A, 125V, 3–WIRE GROUNDING DUPLEX RECEPT. CTR. @ 50" AFF.
	20A, 125V, 3–WIRE DUPLEX RECEPT. FED FROM DEDICATED CIRCUIT.
	BRANCH CIRCUIT PANELBOARD
	120V, 1Ø CIRCUIT HOMERUN TO 1–POLE BRKR.
	SLASH MARKS DENOTE NO. OF WIRES; LONG – NEUTRAL, X – GROUND.
	240V OR 480V, 1Ø CIRCUIT HOMERUN TO 2–POLE BRKR.
	208V OR 480V, 3Ø CIRCUIT HOMERUN TO 3–POLE BRKR.
	MOTOR, 75 HP
	LIMIT SWITCH – NORMALLY OPEN
	MOTOR OPERATED VALVE
	MOTOR SPACE HEATER
	RESISTANCE TEMPERATURE DETECTOR
	VIBRATION SENSOR

SYMBOL DESCRIPTION

	DOWN CONDUCTOR TO GROUND ROD
	CIRCUIT BREAKER, 600 AMPERE FRAME, 600 AMPERE TRIP
	OUTPUT REACTOR
	SOLID STATE TRIP UNIT w/ FUNCTIONS NOTED, 50 INSTANTANEOUS TRIP, 51 TIME DELAY TRIP, 51 GROUND FAULT TRIP
	CUSTOMER METERING
	LIMIT SWITCH – NORMALLY CLOSED
	LEVEL SWITCH
	LIQUID LEVEL SWITCH – NORMALLY OPEN
	LIQUID LEVEL SWITCH – NORMALLY CLOSED
	PRESSURE SWITCH – NORMALLY OPEN
	PRESSURE SWITCH – NORMALLY CLOSED
	JUNCTION BOX, PULL BOX – SIZED PER NEC
	CONDUIT – DOWN
	CONDUIT – UP
	SELECTOR SWITCH – NORMALLY OPEN
	MOTOR STARTER COIL, x DESIGNATES MOTOR ID. NO.
	RELAY COIL, x DESIGNATES ID. NO.
	RELAY CONTACT – NORMALLY OPEN, xx DESIGNATES RELAY ID. NO. & y DESIGNATES CONTACT NO.
	RELAY CONTACT – NORMALLY CLOSED, xx DESIGNATES RELAY ID. NO. & y DESIGNATES CONTACT NO.
	MOTOR OVERLOAD RELAY – x DESIGNATES MOTOR I.D. NO.
	SOLENOID VALVE
	FUSE
	KEYED NOTE
	LED PILOT LIGHT, x INDICATES COLOR, G=GREEN, R=RED, B=BLUE, A=AMBER
	TEC METER, RATING AS INDICATED ON DRAWINGS. CENTER METER 4'–6" ABOVE TOP OF PLATFORM.

SYMBOL DESCRIPTION

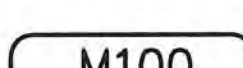	SURGE PROTECTIVE DEVICE
	PHASE MONITOR
	PUSH BUTTON
	KIRK KEY INTERLOCK
	CONDUIT BUBBLE – REFERENCE CONDUIT SCHEDULE

ABBREVIATIONS

Ø	PHASE	NC	NORMALLY CLOSED
A	AMPERES	NO	NORMALLY OPEN
AF	AMPERE FRAME	PB	PUSH BUTTON
AFD	ADJUSTABLE FREQUENCY DRIVE	PSV	PUMP SUCTION VALVE
AFF	ABOVE FINISHED FLOOR	PT	PRESSURE TRANSMITTER
AT	AMPERE TRIP	PWR	POWER
ATS	AUTOMATIC TRANSFER SWITCH	RCBP	REMOTE CIRCUIT BREAKER PANEL
C	CONDUIT	RECEPT	RECEPTACLE
CAT	CATALOG	RTD	RESISTANCE TEMPERATURE DETECTOR
CLG	CEILING	SPD	SURGE PROTECTIVE DEVICE
CKT	CIRCUIT	SW	SWITCH
CTR	CENTER	SWBD	SWITCHBOARD
DISC	DISCONNECT	TEC	TAMPA ELECTRIC COMPANY
DT	DOUBLE THROW	THRU	THROUGH
DV	PUMP DISCHARGE VALVE	TR	TRIP
DWG	DRAWING	TT	TEMPERATURE TRANSMITTER
ELEC	ELECTRICAL, ELECTRIC	TVSS	TRANSIENT VOLTAGE SURGE SUPPRESSOR
E.O.	ELECTRICALLY OPERATED	TYP	TYPICAL
ESD	EMERGENCY SHUTDOWN	UON	UNLESS OTHERWISE NOTED
EXH	EXHAUST	V	VOLT
GFCI	GROUND FAULT CIRCUIT INTERRUPTER	VIB	VIBRATION
HP	HORSEPOWER	W	WIRE
JB, JBOX	JUNCTION BOX	w/	WITH
KW	KILOWATTS	XFMR	TRANSFORMER
KVA	KILOVOLT–AMPERE	XFR	TRANSFER
LPX	LIGHTING PANEL X	XMTR	TRANSMITTER
MIN.	MINIMUM		
MCC	MOTOR CONTROL CENTER		
MLO	MAIN LUGS ONLY		
MNTD	MOUNTED		
MOV	MOTOR OPERATED VALVE		
MSH	MOTOR SPACE HEATER		

ENGINEER OF RECORD:
BOB E. HALLMAN, P.E.
FLORIDA REGISTRATION NO. 20761



Engineering Design
Technologies Corp.
P.O. Box 152403
Tampa, FL 33684-2403
813.289.8080
813.282.9184 FAX
engineering@edt1.com

CITY of TAMPA
WASTEWATER DEPARTMENT

KRAUSE PS REHABILITATION
ELECTRICAL LEGEND & ABBREVIATIONS

NO.	DATE	REVISIONS

DRAWN: RWB
DESIGN: STK
QC: BEH
DATE: 05/01/14

SHEET E-1


GENERAL NOTES:

1. CONTRACTOR SHALL SUBMIT SHOP DRAWINGS FOR APPROVAL AND SHALL RECEIVE SAID APPROVAL PRIOR TO PURCHASING EQUIPMENT OR COMMENCING CONSTRUCTION.
2. ALL SHOP DRAWINGS SUBMITTED TO ENGINEER FOR APPROVAL SHALL BE ORIGINAL COPIES. COPIES OF SHOP DRAWINGS OR DATA SHEETS TRANSMITTED BY FACSIMILE (FAX) WILL NOT BE REVIEWED.
3. AFTER CORE DRILLING HOLES THROUGH REINFORCED CONCRETE WALLS AND FLOORS, COAT EXPOSED REINFORCING STEEL CONCRETE SURFACES WITH EMACO P24 BY BASF. AFTER ROUTING CONDUIT THROUGH HOLE, FILL AND FINISH CONCRETE WITH A SHRINKAGE COMPENSATING REPAIR MORTAR WITH CORROSION INHIBITING PROPERTIES, EMACO S66 C1 BY BASF. REFERENCE STRUCTURAL DRAWINGS.
4. SHIELD AND DRAIN WIRE FOR EACH ANALOG SIGNAL (4–20 mA) CABLE SHALL BE GROUNDED AT THE PLC ONLY. THE SHIELD AND DRAIN WIRE AT EACH FIELD DEVICE SHALL BE NEATLY TRIMMED & TAPED w/ (2) LAYERS OF VINYL ELECTRICAL TAPE (SCOTCH 33+).
5. ALL CONDUCTORS SHALL BE STRANDED COPPER, #12 AWG MIN. w/ THHN INSULATION, UNLESS OTHERWISE NOTED.
6. THE WET WELL CLASSIFICATION IS CLASS I, GROUPS C & D, DIVISION 1 (HAZARDOUS AREA). NEC ARTICLES 500 & 501 ARE APPLICABLE FOR WIRING METHODS USED IN THE WET WELL.
7. ALL WIRING SHALL BE IDENTIFIED w/ NUMBERS AT ALL TERMINALS AND ON WIRING DIAGRAM. MARKERS SHALL BE THOMAS & BETTS INSTA–CODE CLIP–ON MARKERS OR APPROVED EQUAL.
8. ALL CIRCUITS SHALL HAVE GROUNDING CONDUCTORS ROUTED INSIDE THE CONDUIT w/ POWER CONDUCTORS.
9. ALL POWER CONDUCTORS AND MOTOR WINDINGS SHALL BE TESTED WITH A 600 VOLT INSULATION RESISTANCE TESTER "MEGGER". INSULATION READINGS SHALL BE A MINIMUM OF 20 MEGOHMS TO GROUND (DO NOT TEST LOW–VOLTAGE CONTROLS). INSULATION READINGS THAT ARE LESS THAN 20 MEGOHMS SHALL REQUIRE THE REPLACEMENT OF THE CONDUCTOR OR MOTOR AS APPLICABLE.
10. NEATLY COIL & TAPE SPARE CONDUCTORS w/ VINYL ELECTRICAL TAPE (SCOTCH 33+) U.O.N.
11. ALL CONDUCTOR LENGTHS SHALL BE CONTINUOUS. NO SPLICES OR CONDUCTOR TERMINATIONS SHALL BE PERMITTED UNLESS SPECIFICALLY DESIGNATED IN THE DRAWINGS.
12. LIQUIDTIGHT FLEXIBLE NON–METALLIC CONDUIT CONNECTIONS TO EACH MOTOR SHALL NOT EXCEED A LENGTH OF 36".
13. ALL THREADED CONNECTIONS SHALL BE COATED w/ COPPER SHIELD ANTI–SEIZE COMPOUND MANUFACTURED BY THOMAS & BETTS (T & B).
14. ALL UNDERGROUND CONDUITS SHALL BE BURIED w/ A MINIMUM OF 24" COVER UNLESS OTHERWISE NOTED.
15. CONDUIT ROUTING SHOWN IS DIAGRAMMATIC UNLESS OTHERWISE NOTED. CONTRACTOR SHALL OPTIMIZE THE CONDUIT ROUTING, TAKING INTO ACCOUNT THE FIELD CONDITIONS AND THE FINAL EQUIPMENT SELECTED AND APPROVED IN THE SUBMITTALS.
16. PULL BOXES SHALL BE INSTALLED AS NECESSARY TO FACILITATE WIRE PULLS AND TO AVOID EXCESSIVE PULLING TENSION ON WIRING. IN NO CASE SHALL CONDUIT LENGTHS EXCEED 150' OR THE EQUIVALENT OF FOUR QUARTER BENDS (360 DEGREES TOTAL) WITHOUT A PULL BOX. PULL BOXES SHALL BE SIZED IN ACCORDANCE WITH ARTICLE 314 OF THE NEC.
17. PROVIDE PVC SLEEVES FOR ALL METALLIC CONDUIT PENETRATIONS THROUGH CONCRETE. WHERE ALUMINUM SURFACES SUCH AS BOXES, CONDUIT OR STRUCTURAL SUPPORTS COME IN CONTACT WITH INCOMPATIBLE METALS, LIME, MORTAR, CONCRETE OR OTHER MASONRY MATERIALS, THE CONTACT AREA SHALL BE GIVEN ONE FIELD COAT OF KOPPERS METAL PASSIVATOR NO. 40 AND ONE COAT OF KOPPERS BITUMASTIC SUPER SERVICE BLACK OR TWO COATS OF ASPHALT VARNISH CONFORMING TO FED. SPEC. TT–V–51.
18. ALL CONDUIT TRENCHES SHALL BE DUG BY HAND TO AVOID DAMAGING UNDERGROUND PIPING AND UTILITIES.
19. ALL UNDERGROUND CONDUITS SHALL BE ENCASED IN STEEL REINFORCED CONCRETE. CONCRETE ENCASEMENT SHALL BE IN ACCORDANCE w/ THE DUCT BANK DETAIL.
20. THE CONTRACTOR SHALL REPLACE ALL EXISTING PAVING, STABILIZED EARTH, CURBS, DRIVEWAYS, FENCES & OTHER IMPROVEMENTS WITH THE SAME TYPE OF MATERIAL THAT WAS REMOVED DURING CONSTRUCTION OR AS DIRECTED BY THE ENGINEER.

21. CONTRACTOR SHALL MAINTAIN A CLEAR PATH FOR ALL SURFACE WATER DRAINAGE STRUCTURES & DITCHES DURING ALL PHASES OF CONSTRUCTION.
22. ALL CONDUIT SHALL BE SUPPORTED AT MAXIMUM 5'–0" INTERVALS.
23. ALL FASTENING AND MOUNTING HARDWARE SHALL BE 316 SS. CAD PLATED HARDWARE WILL NOT BE ACCEPTED.
24. ALL UNISTRUT SHALL BE 1 5/8" x 1 5/8" x 12 GA. 316 STAINLESS STEEL.
25. CONTRACTOR SHALL FIELD VERIFY ALL MECHANICAL EQUIPMENT SIZES AND RATINGS PRIOR TO CONNECTING.
26. CONTRACTOR SHALL FIELD VERIFY ALL EQUIPMENT LOCATIONS AND CONNECTIONS PRIOR TO COMMENCING CONSTRUCTION.
27. ALL PANELS, PANEL COMPONENTS, DISCONNECTS, SWITCHES & EQUIPMENT COVERPLATES SHALL BE LABELED w/ NAMEPLATES. NAMEPLATES SHALL BE THREE PLY PHENOLIC BLACK–WHITE–BLACK ENGRAVED THROUGH THE FIRST BLACK LAYER. LETTERING SHALL BE 0.5 CM (3/16") MIN. EDGES OF NAMEPLATES SHALL BE BEVELED 45°. THE NAMEPLATES SHALL BE SECURED TO EQUIPMENT WITH STAINLESS STEEL SCREWS OR RIVETS. THE USE OF GLUE IS NOT PERMITTED.
28. ALL INSTALLED COMPONENTS SHALL BE LISTED BY UNDERWRITERS LABORATORY (UL), OR SIMILAR NATIONALLY RECOGNIZED TESTING LABORATORY.
29. ALL EQUIPMENT SHALL BE INSTALLED AT AN ELEVATION ABOVE THE 100 YEAR FLOOD ELEVATION ESTABLISHED BY FEMA AND/OR LOCAL AUTHORITIES.
- ALL INSTALLATIONS SHALL BE IN ACCORDANCE WITH CITY OF TAMPA CODE 5–111.6.1.5 CITY OF TAMPA CODE CHAPTER 5 ISSUED 10/01/2005.
30. REFERENCE PLAN & SECTION DRAWINGS FOR EQUIPMENT LOCATIONS.
31. COORDINATE ALL INSTALLATIONS w/ ALL OTHER TRADES.
32. THE CONTRACTOR SHALL NOTIFY THE ENGINEER IMMEDIATELY WHEN CONFLICTS BETWEEN DRAWINGS & ACTUAL CONDITIONS ARE DISCOVERED.
33. ALL "AS BUILT" DRAWINGS PROVIDED BY THE CONTRACTOR SHALL BE SIGNED AND DATED WITH CHANGES CLEARLY NOTED IN RED. ADDITIONALLY, THE PRINTED NAME OF THE INDIVIDUAL SIGNING THE "AS BUILT" DRAWINGS ALONG WITH THAT PERSON'S COMPANY AFFILIATION SHALL BE INCLUDED. IF NO CHANGES WERE MADE DURING CONSTRUCTION, A NOTE DESIGNATING "NO CHANGES" SHALL BE INCLUDED ON THE "AS BUILT" DRAWINGS.
34. ALL EXISTING INSTALLATIONS DENOTED ON THE DRAWINGS ARE FOR CONTRACTOR'S REFERENCE ONLY. ALL EXISTING INSTALLATIONS SHALL BE FIELD VERIFIED PRIOR TO SUBMITTING A BID & PRIOR TO COMMENCING CONSTRUCTION.
35. PROVIDE A MINIMUM OF 3'–0" CLEARANCE IN FRONT OF ALL ELECTRICAL EQUIPMENT IN ACCORDANCE w/ ARTICLE 110 OF THE NEC.
36. ALL ELECTRICAL WORK SHALL BE PERFORMED IN ACCORDANCE w/ THE LATEST EDITION OF THE NEC AND APPLICABLE LOCAL ORDINANCES.
37. ALL CONDUITS ROUTED IN CONCRETE SHALL BE INSTALLED WITH A SEPARATION BETWEEN CONDUITS OF NOT LESS THAN 3 DIAMETERS (CENTER–TO–CENTER) & IN ACCORDANCE WITH AMERICAN CONCRETE INSTITUTE STANDARD NO. 318–89.
38. ALL CONDUIT EXPOSED ABOVE GRADE SHALL BE RIGID HEAVY WALL ALUMINUM, UNLESS OTHERWISE NOTED. CONDUITS EXTENDING BELOW GRADE SHALL BE RIGID HEAVY WALL ALUMINUM CONDUIT THROUGH AND INCLUDING THE FIRST 90 DEGREE ELBOW (OR EQUIVALENT SET OF FITTINGS) INSTALLED BELOW GRADE. ALL PVC CONDUIT SHALL BE SCHEDULE 80. CONNECTIONS TO PVC CONDUIT SHALL BE MADE w/ A RIGID ALUMINUM TO PVC CONDUIT ADAPTER.
- ALL CONDUIT ROUTED IN THE WET WELL SHALL BE RIGID HEAVY WALL ALUMINUM w/ 40 MIL PVC EXTERIOR COATING & 2 MIL BLUE URETHANE INTERIOR COATING. OCAL–BLUE SERIES CONDUIT MANUFACTURED BY THOMAS & BETTS OR EQUAL.

B080-063



ENGINEER OF RECORD:
BOB E. HALLMAN, P.E.
FLORIDA REGISTRATION NO. 20761

 <div>Certificate of Authorization Number: 4795</div>	<div>Engineering Design Technologies Corp.</div> <div>P.O. Box 152403</div> <div>Tampa, FL 33684-2403</div> <div>813.289.8080</div> <div>813.282.9184 FAX</div> <div>engineering@edt1.com</div>	<div>CITY of TAMPA</div> <div>WASTEWATER DEPARTMENT</div>	KRAUSE PS REHABILITATION						DRAWN: <u> RWB </u>
			ELECTRICAL GENERAL NOTES						DESIGN: <u> STK </u>
									QC: <u> BEH </u>
									DATE: <u> 05/01/14 </u>
									SHEET E-2
			NO.	DATE	REVISIONS				

B080-064

NOTES:

1. ALL EQUIPMENT, CONDUIT & WIRING INCLUDED ON THIS DRAWING ARE EXISTING. CONTRACTOR SHALL VISIT THE SITE & FAMILIARIZE HIMSELF WITH THE EXISTING CONDITIONS BEFORE SUBMITTING A BID OR COMMENCING CONSTRUCTION.
2. COORDINATE ALL DEMOLITION ACTIVITIES WITH THE CITY AND ALL TRADES.
3. ALL EXISTING INSTALLATIONS DENOTED ON THE DRAWINGS ARE FOR CONTRACTORS REFERENCE ONLY. ALL EXISTING INSTALLATIONS SHALL BE FIELD VERIFIED PRIOR TO SUBMITTING A BID AND PRIOR TO COMMENCING CONSTRUCTION.
4. COORDINATE WITH THE CITY FOR A LIST OF EQUIPMENT TO BE SALVAGED.

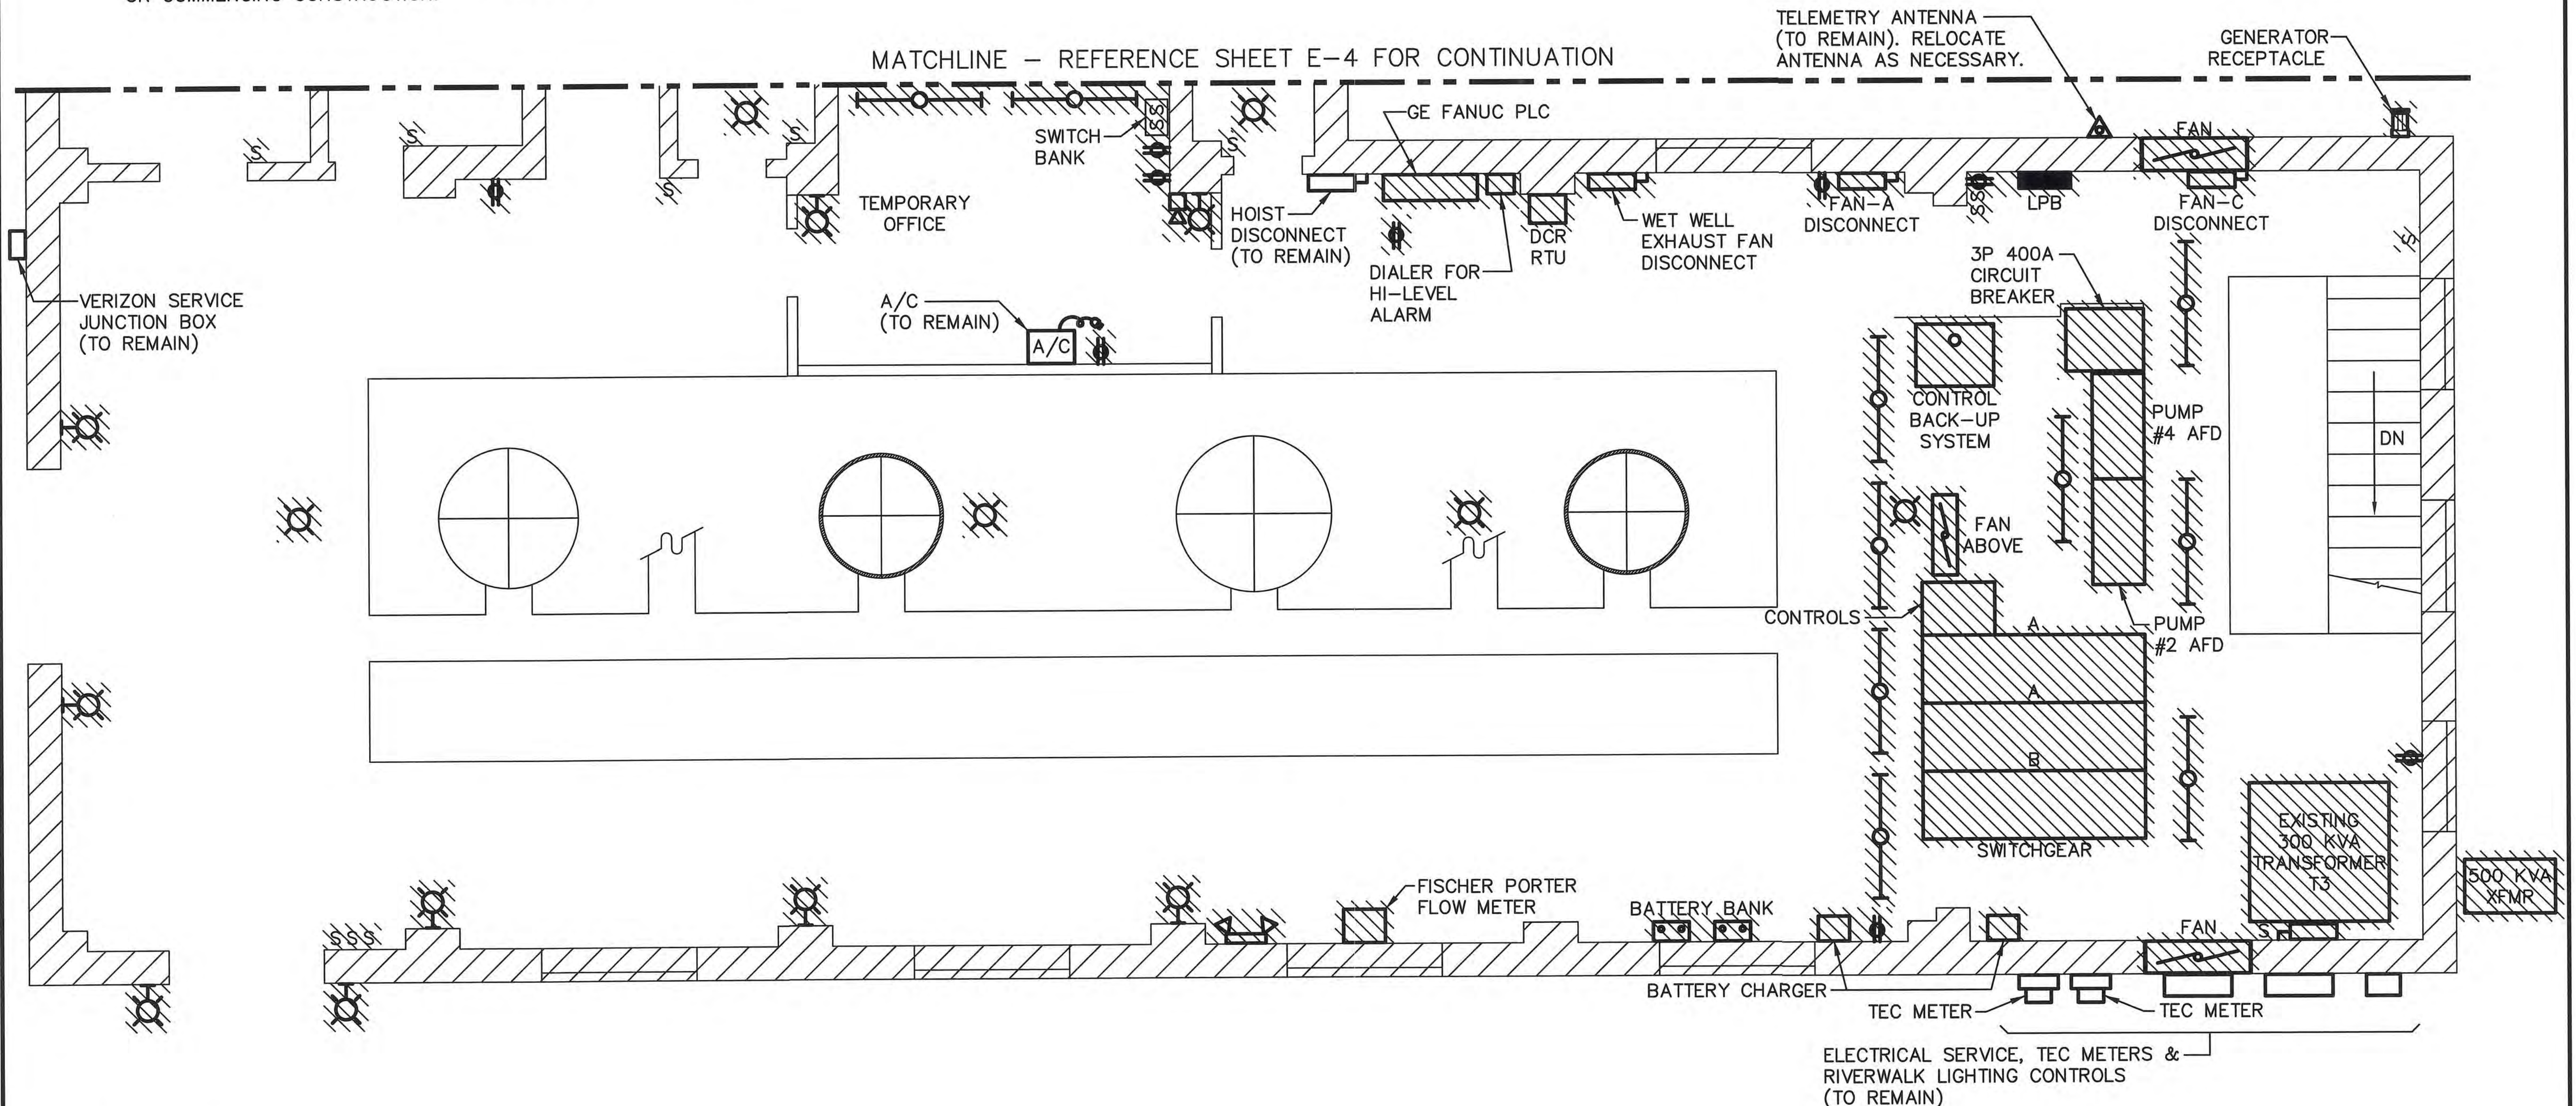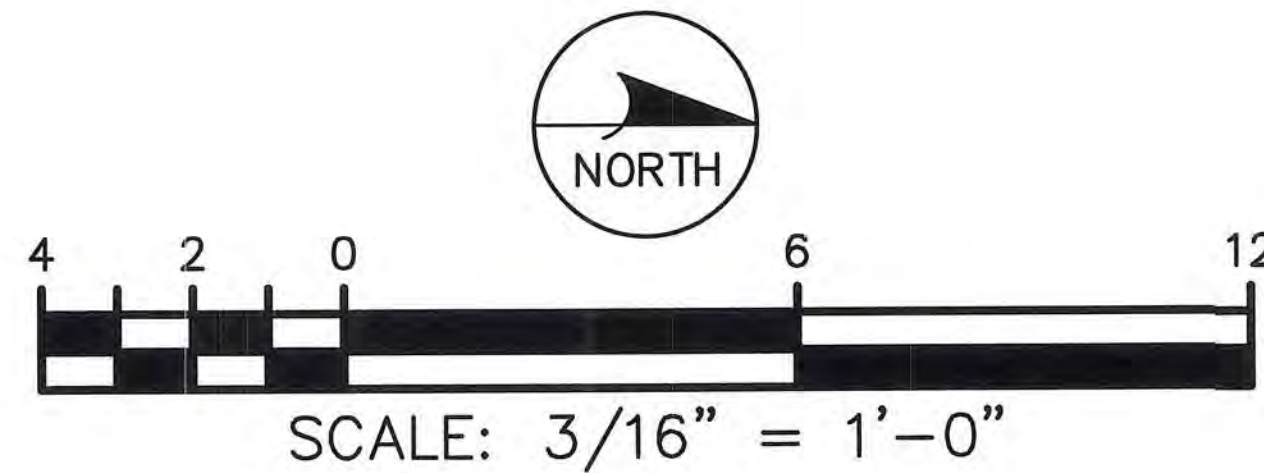

ENGINEER OF RECORD:
BOB E. HALLMAN, P.E.
FLORIDA REGISTRATION NO. 20761



**Engineering Design
Technologies Corp.**
P.O. Box 152403
Tampa, FL 33684-2403
813.289.8080
813.282.9184 FAX
engineering@edt1.com


CITY of TAMPA
WASTEWATER DEPARTMENT

KRAUSE PS REHABILITATION
ELECTRICAL DEMOLITION PLAN
(UPPER LEVEL)
(SHEET 1 OF 2)


NO.	DATE	REVISIONS

DRAWN: RWB
DESIGN: STK
QC: BEH
DATE: 05/01/14

SHEET E-3

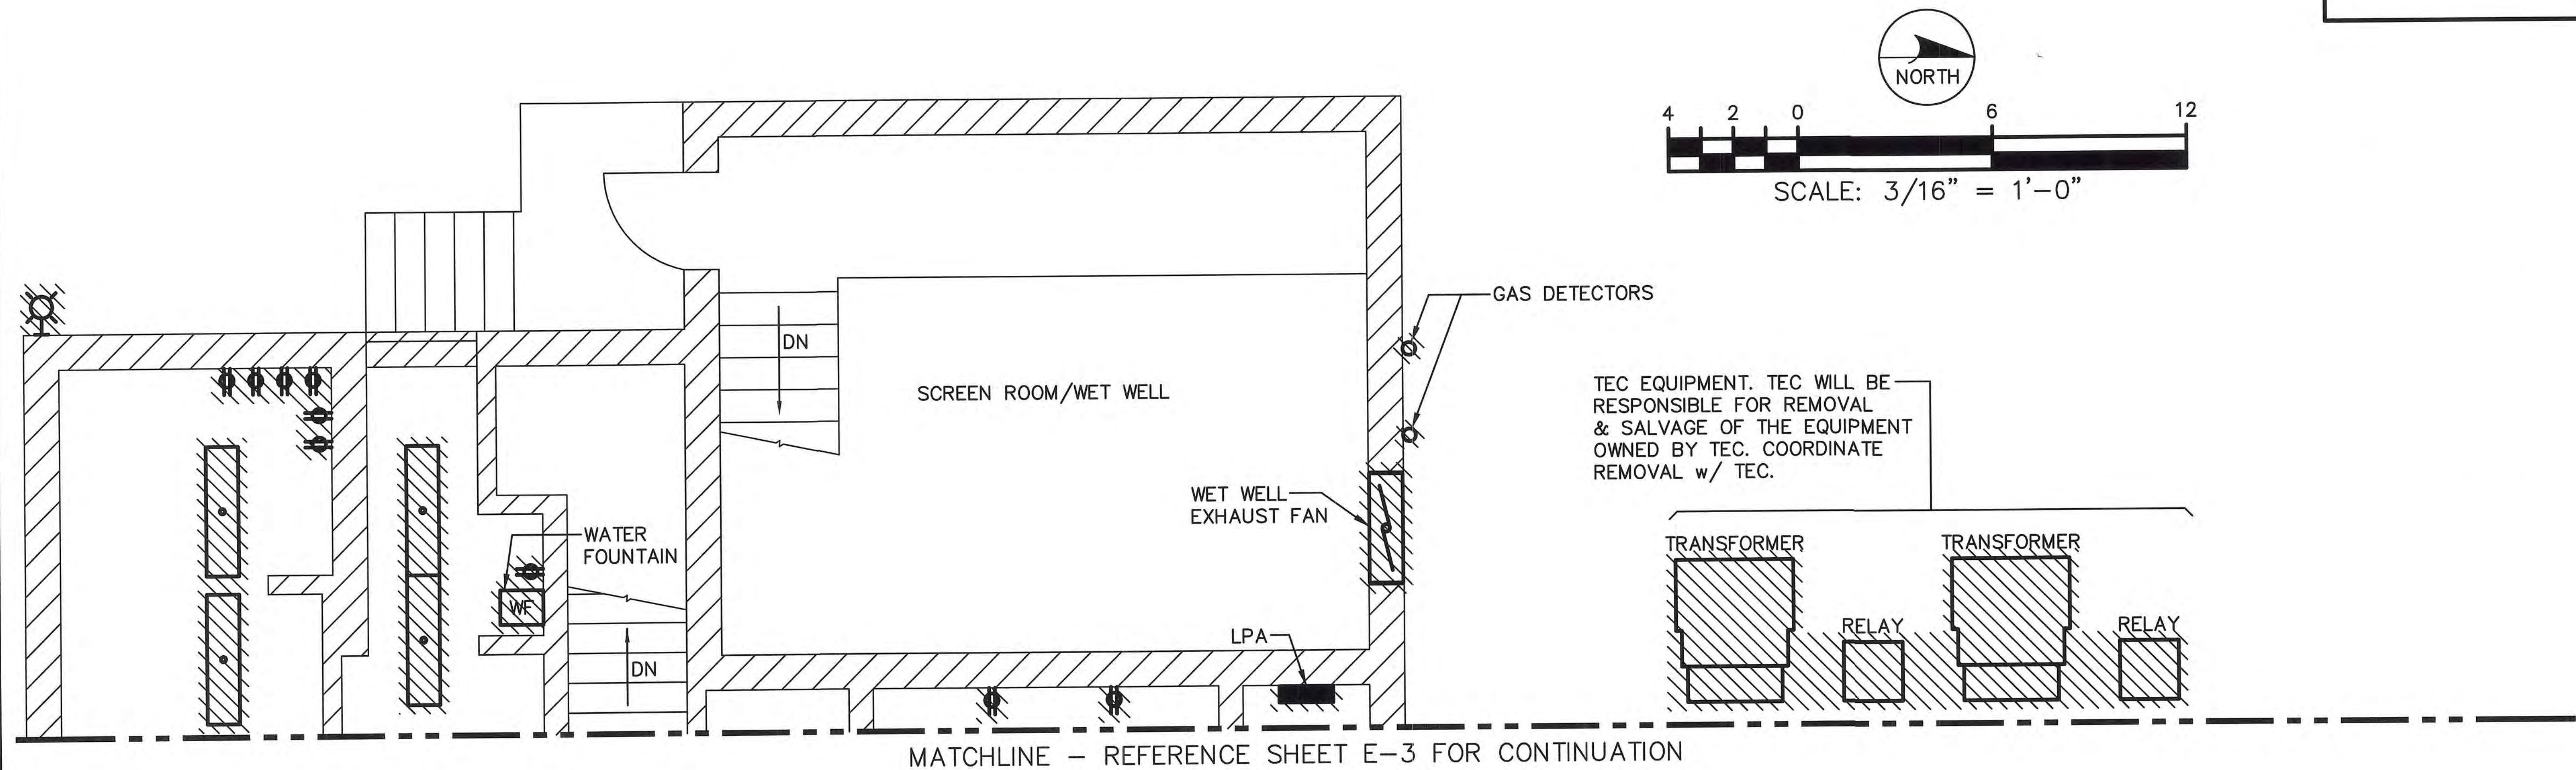

NOTES:

-  - DENOTES EXISTING EQUIPMENT TO BE REMOVED. ITEM SHALL BE REMOVED FROM PREMISES AND DISPOSED OF PROPERLY. UNLESS OTHERWISE NOTED, REMOVE ALL ASSOCIATED CONDUIT & WIRING CONNECTED TO EQUIPMENT TO BE REMOVED, INCLUDING ABANDONED CONDUIT & WIRING.
1. ALL EQUIPMENT, CONDUIT & WIRING INCLUDED ON THIS DRAWING ARE EXISTING. CONTRACTOR SHALL VISIT THE SITE & FAMILIARIZE HIMSELF WITH THE EXISTING CONDITIONS BEFORE SUBMITTING A BID OR COMMENCING CONSTRUCTION.
 2. COORDINATE ALL DEMOLITION ACTIVITIES WITH THE CITY AND ALL TRADES.
 3. ALL EXISTING INSTALLATIONS DENOTED ON THE DRAWINGS ARE FOR CONTRACTORS REFERENCE ONLY. ALL EXISTING INSTALLATIONS SHALL BE FIELD VERIFIED PRIOR TO SUBMITTING A BID AND PRIOR TO COMMENCING CONSTRUCTION.
 4. COORDINATE WITH THE CITY FOR A LIST OF EQUIPMENT TO BE SALVAGED.

ENGINEER OF RECORD:
BOB E. HALLMAN, P.E.
FLORIDA REGISTRATION NO. 20761



Engineering Design
Technologies Corp.
P.O. Box 152403
Tampa, FL 33684-2403
813.289.8080
813.282.9184 FAX
engineering@edt1.com

CITY of TAMPA
WASTEWATER DEPARTMENT



KRAUSE PS REHABILITATION
ELECTRICAL DEMOLITION PLAN
(UPPER LEVEL)
(SHEET 2 OF 2)

NO.	DATE	REVISIONS

DRAWN: RWB
DESIGN: STK
QC: BEH
DATE: 05/01/14
SHEET E-4

NOTES:

1. ALL EQUIPMENT, CONDUIT & WIRING INCLUDED ON THIS DRAWING ARE EXISTING. CONTRACTOR SHALL VISIT THE SITE & FAMILIARIZE HIMSELF WITH THE EXISTING CONDITIONS BEFORE SUBMITTING A BID OR COMMENCING CONSTRUCTION.
2. COORDINATE ALL DEMOLITION ACTIVITIES WITH THE CITY AND ALL TRADES.
3. ALL EXISTING INSTALLATIONS DENOTED ON THE DRAWINGS ARE FOR CONTRACTORS REFERENCE ONLY. ALL EXISTING INSTALLATIONS SHALL BE FIELD VERIFIED PRIOR TO SUBMITTING A BID AND PRIOR TO COMMENCING CONSTRUCTION.
4. FIELD EVALUATE EXISTING CONDITIONS IN THE LOWER LEVEL ELECTRICAL ROOM. CONTRACTOR SHALL PROVIDE A WRITTEN PLAN TO THE CITY FOR REMOVAL OF EQUIPMENT IN THIS AREA. CONSIDERATION SHOULD BE GIVEN TO SIZE & WEIGHT OF EQUIPMENT TO BE REMOVED, LIMITED ACCESS TO LOWER AREA & SUPPORTS (AND BRACING) FROM EXISTING STRUCTURE FOR HOISTING EQUIPMENT FROM THE LOWER LEVEL.
5. COORDINATE WITH THE CITY FOR A LIST OF EQUIPMENT TO BE SALVAGED.

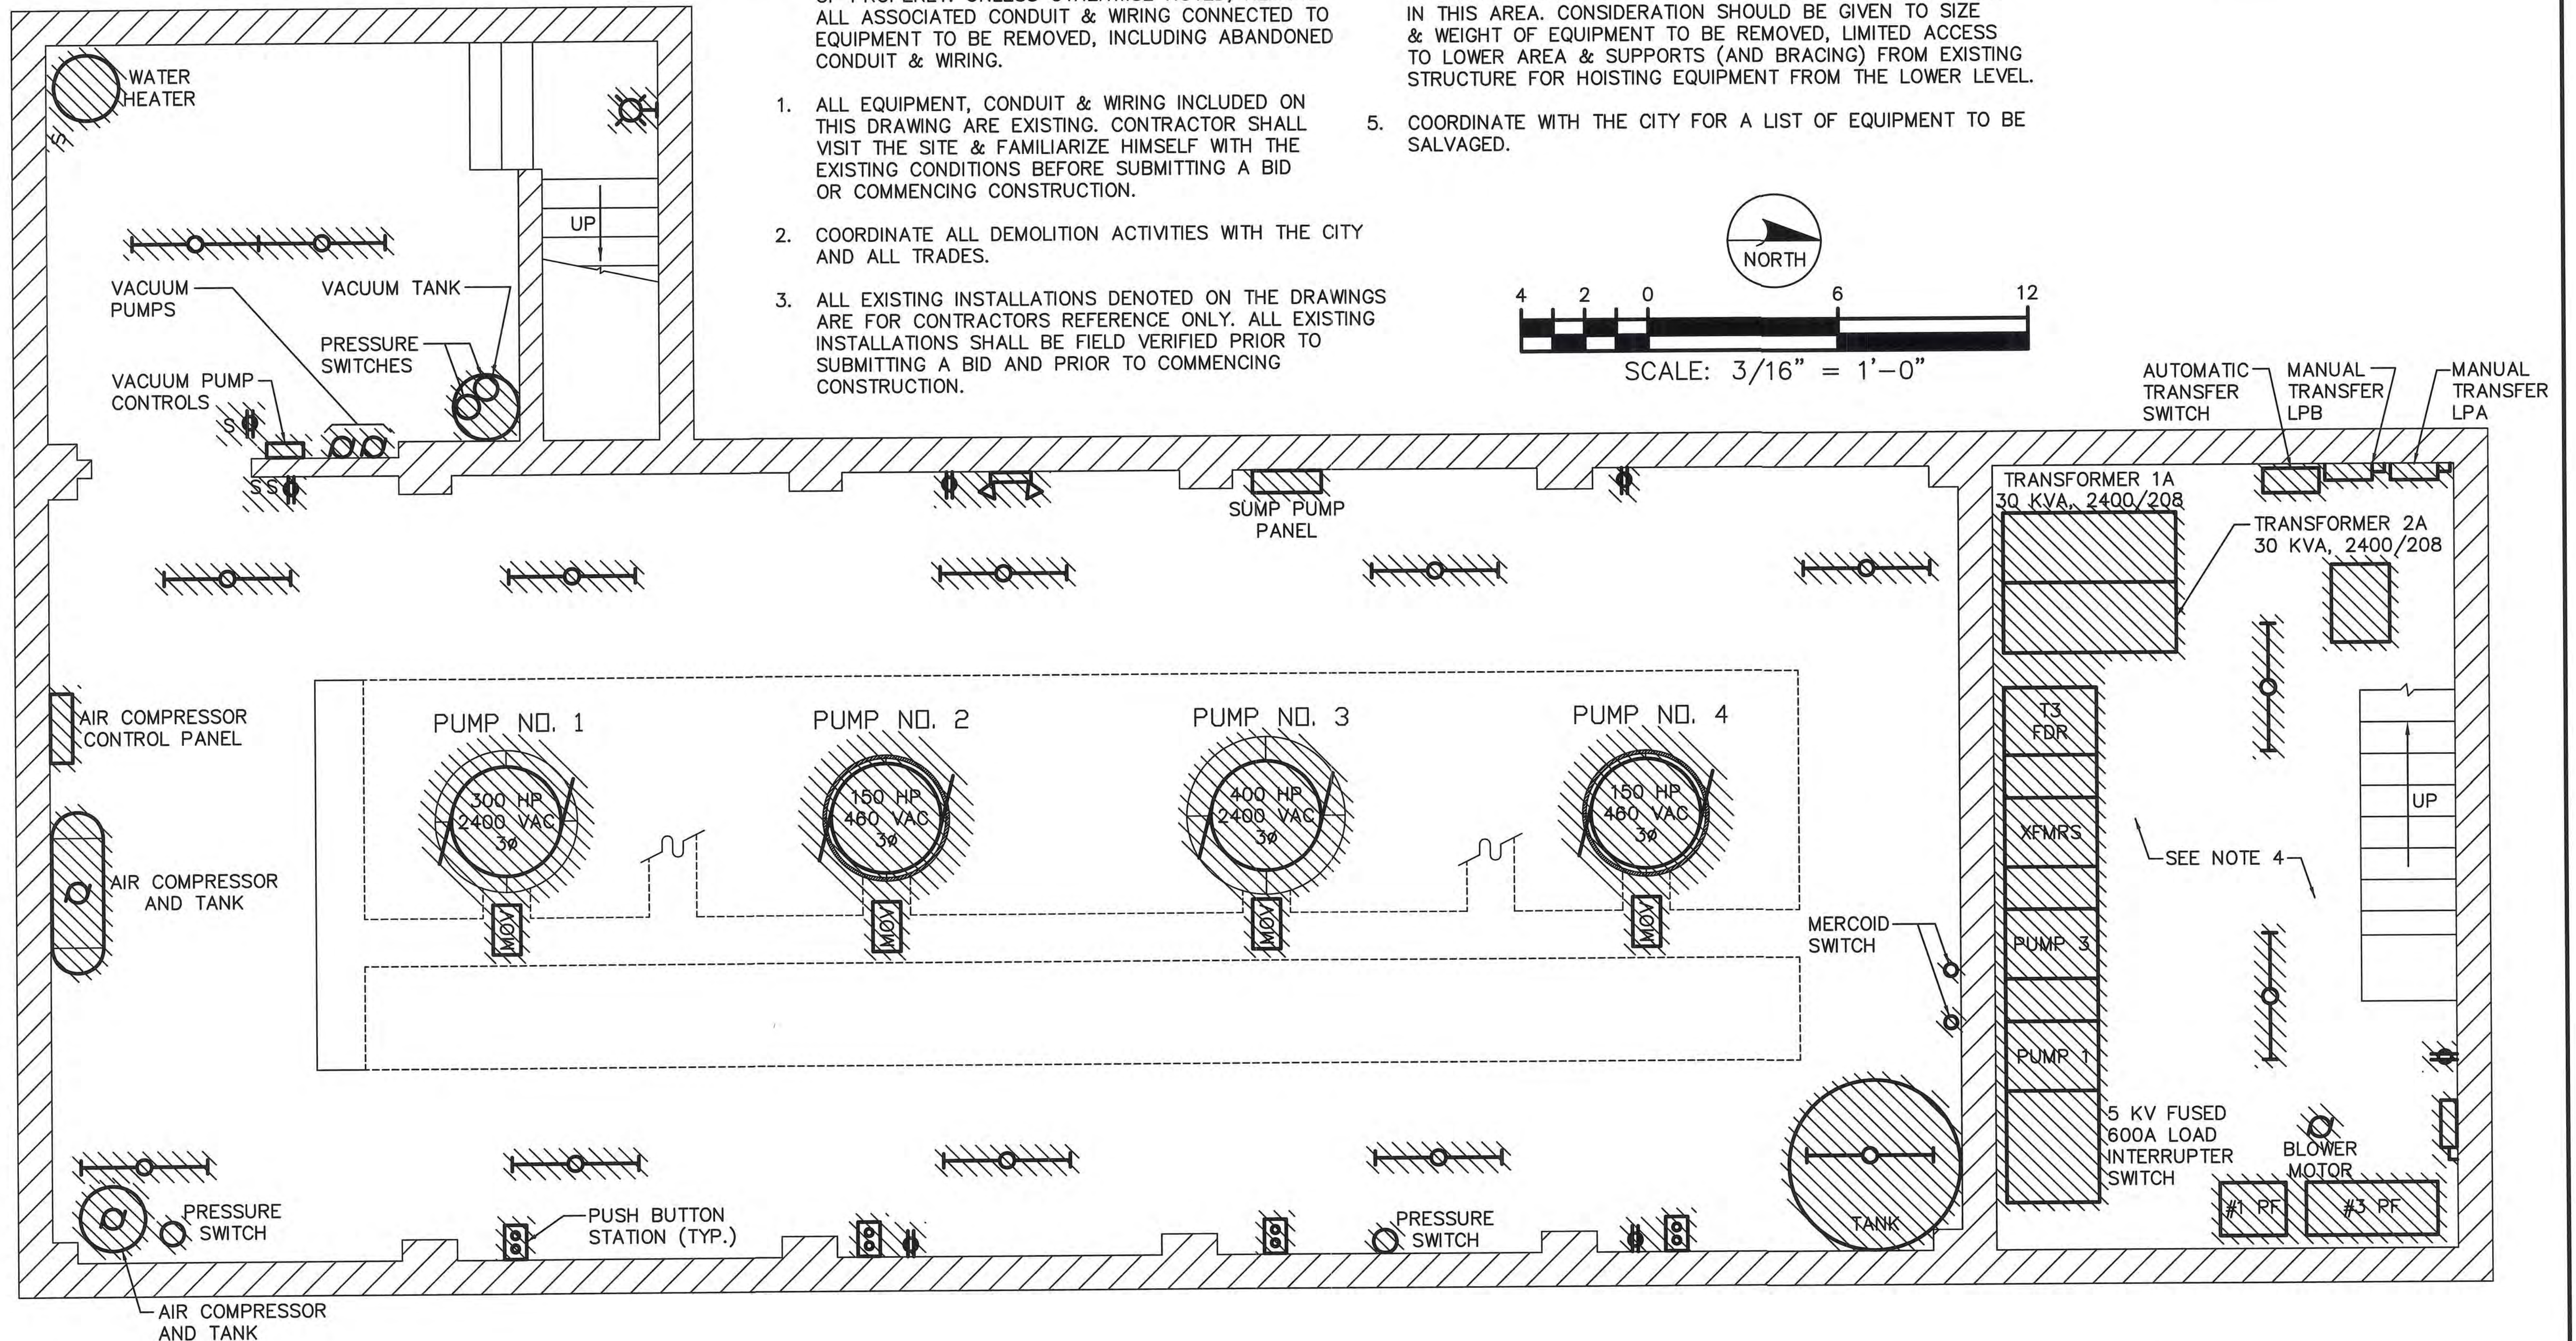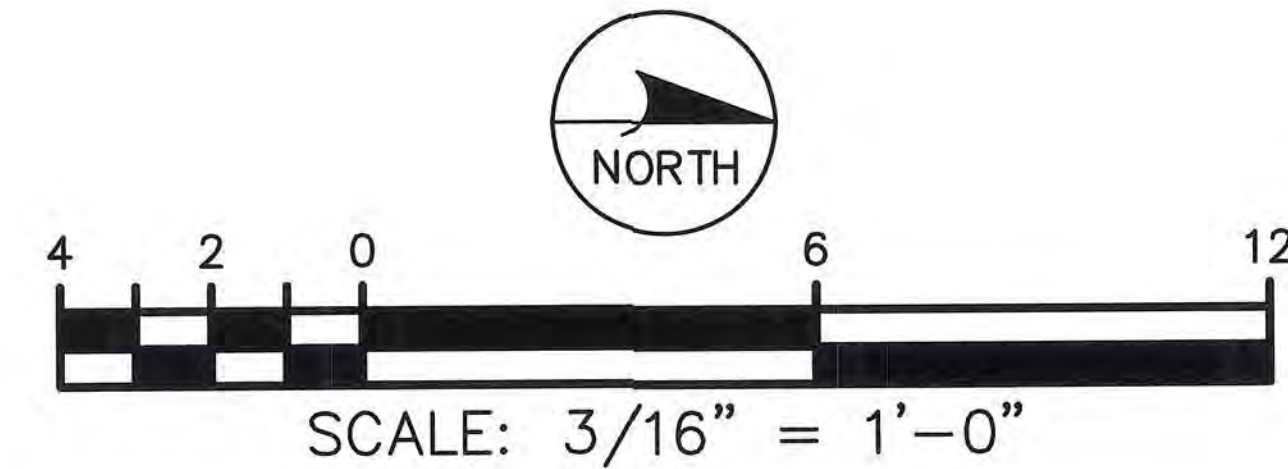

ENGINEER OF RECORD:
BOB E. HALLMAN, P.E.
FLORIDA REGISTRATION NO. 20761



**Engineering Design
Technologies Corp.**
P.O. Box 152403
Tampa, FL 33684-2403
813.289.8080
813.282.9184 FAX
engineering@edt1.com

CITY of TAMPA
WASTEWATER DEPARTMENT



KRAUSE PS REHABILITATION

**ELECTRICAL DEMOLITION PLAN
(LOWER LEVEL)**

NO.	DATE	REVISIONS

DRAWN: RWB
DESIGN: STK
QC: BEH
DATE: 05/01/14

SHEET E-5

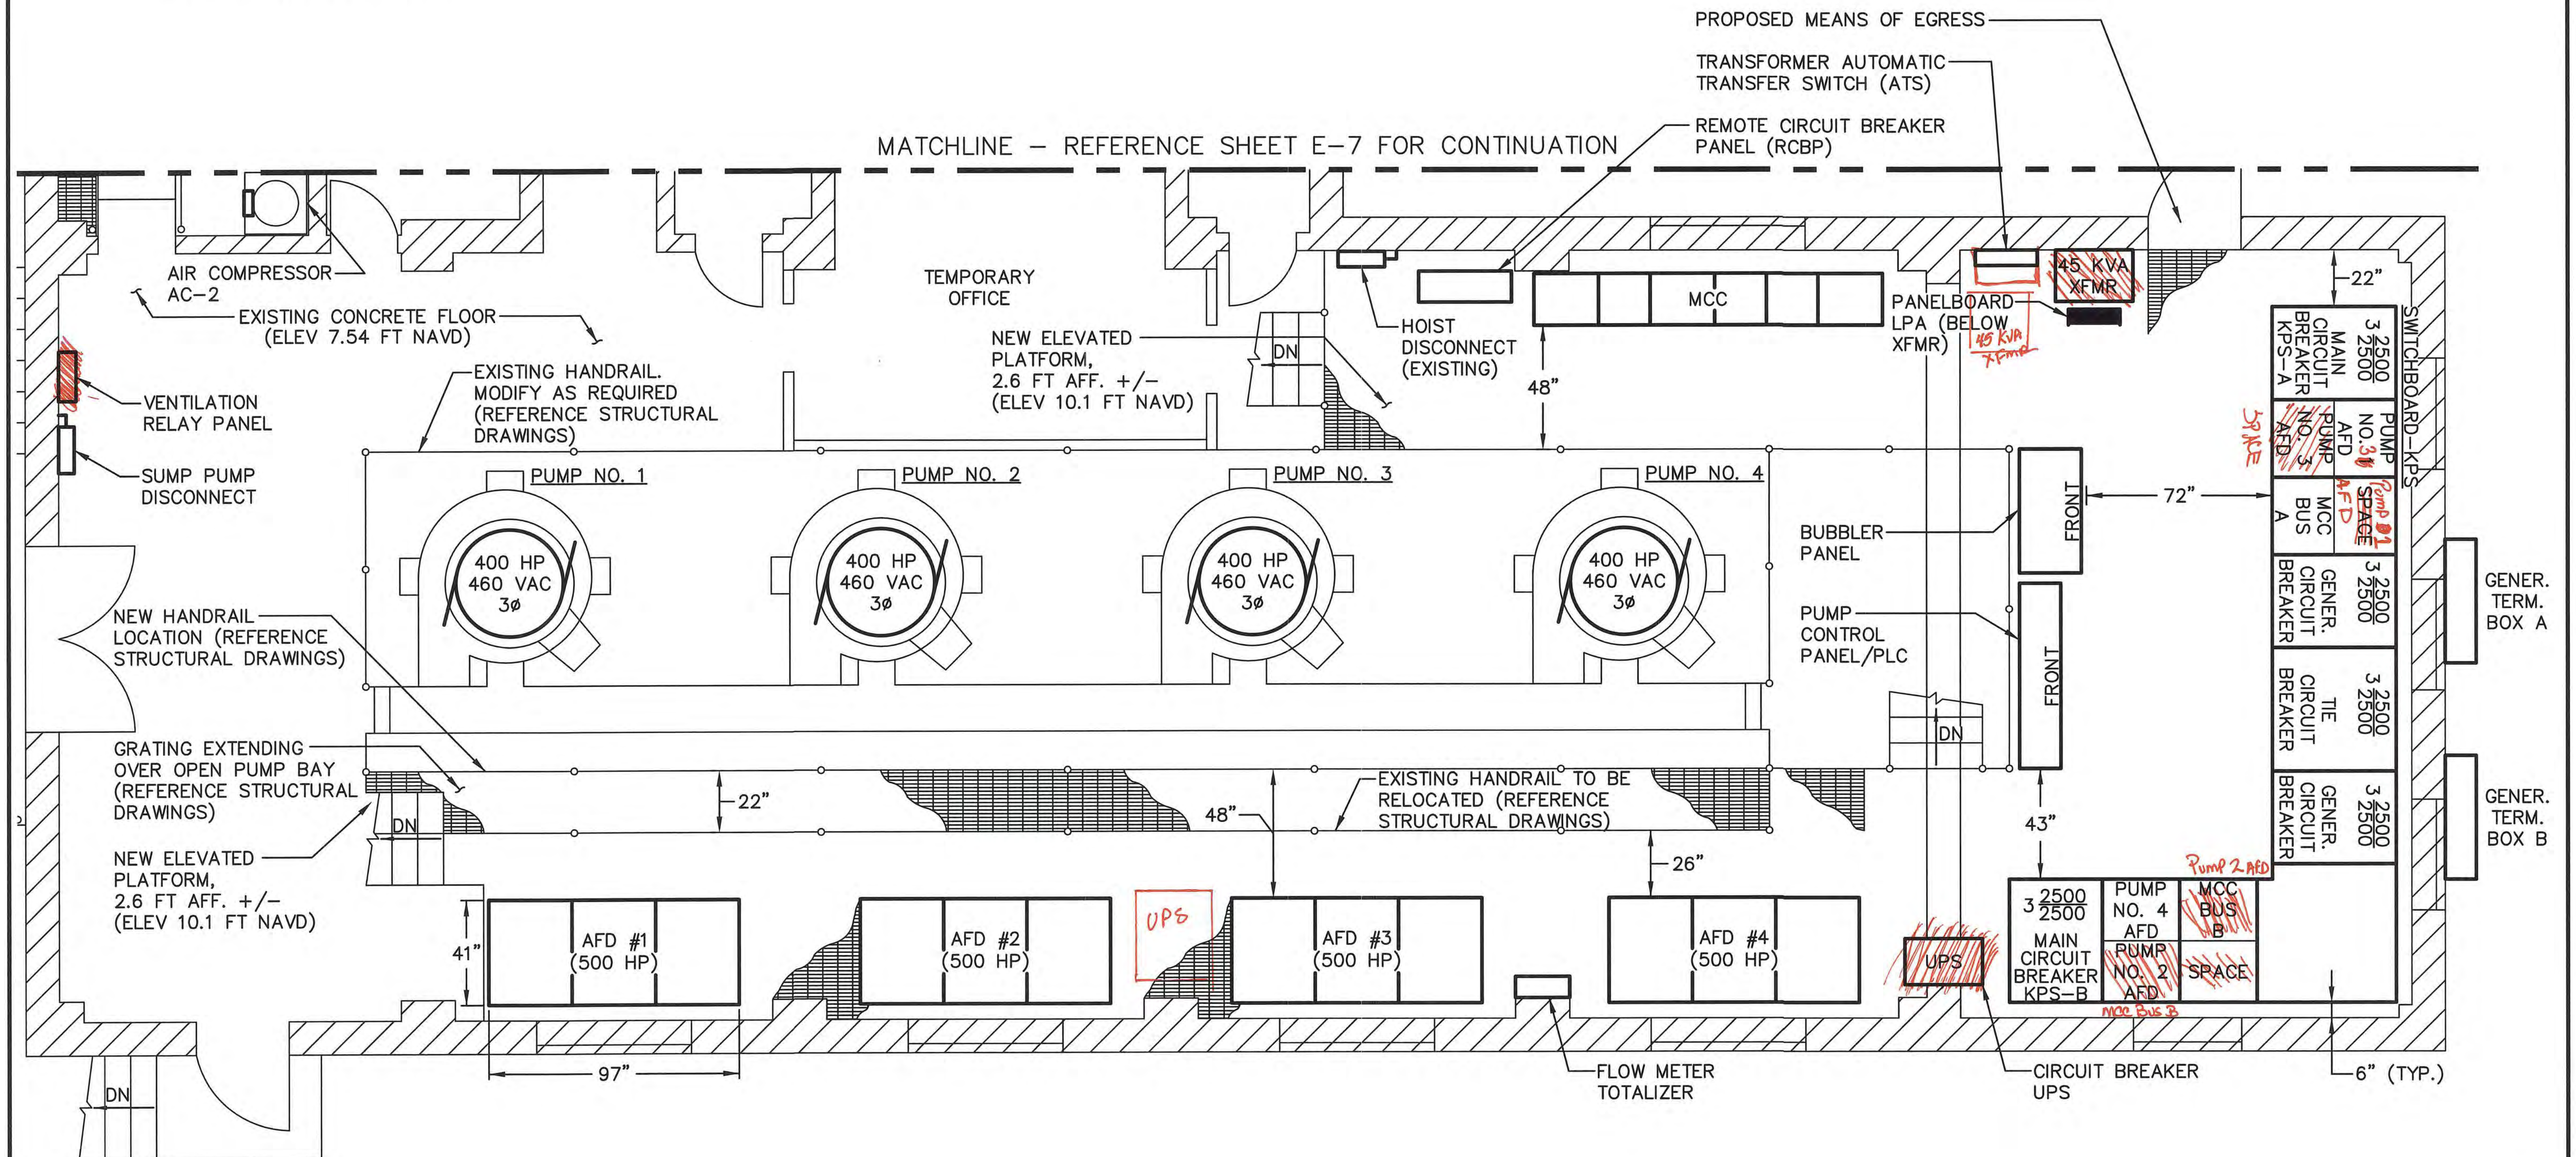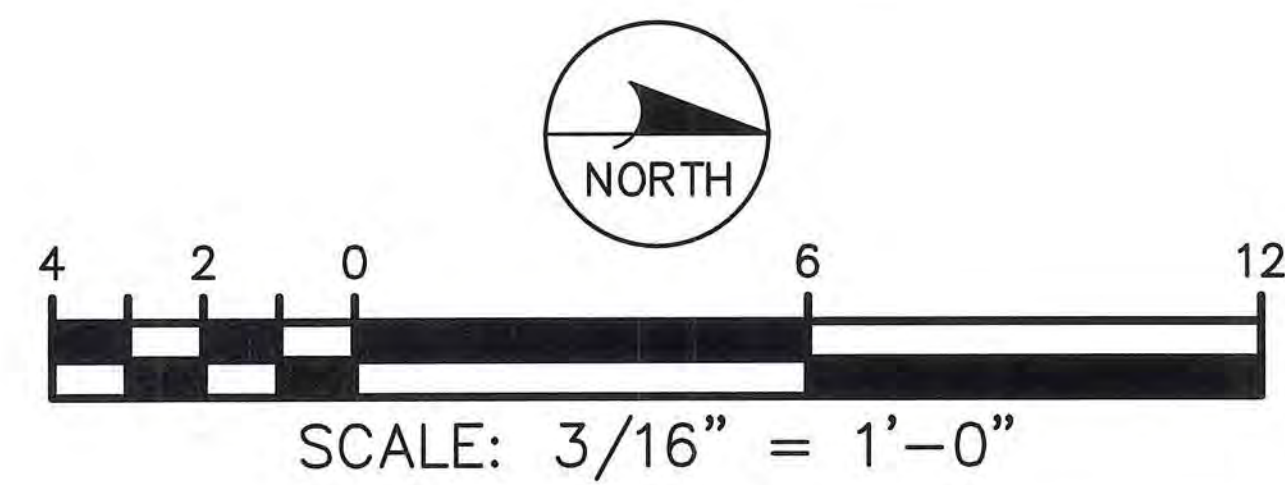

ENGINEER OF RECORD:
BOB E. HALLMAN, P.E.
FLORIDA REGISTRATION NO. 20761



**Engineering Design
Technologies Corp.**
P.O. Box 152403
Tampa, FL 33684-2403
813.289.8080
813.282.9184 FAX
engineering@edt1.com

CITY of TAMPA
WASTEWATER DEPARTMENT


KRAUSE PS REHABILITATION
ELECTRICAL EQUIPMENT LAYOUT
(UPPER LEVEL — FLOOR ELEV. 7.54' NAVD)
(SHEET 1 OF 2)

NO.	DATE	REVISIONS

DRAWN: RWB
DESIGN: STK
QC: BEH
DATE: 05/01/14


SHEET E-6

B080-068

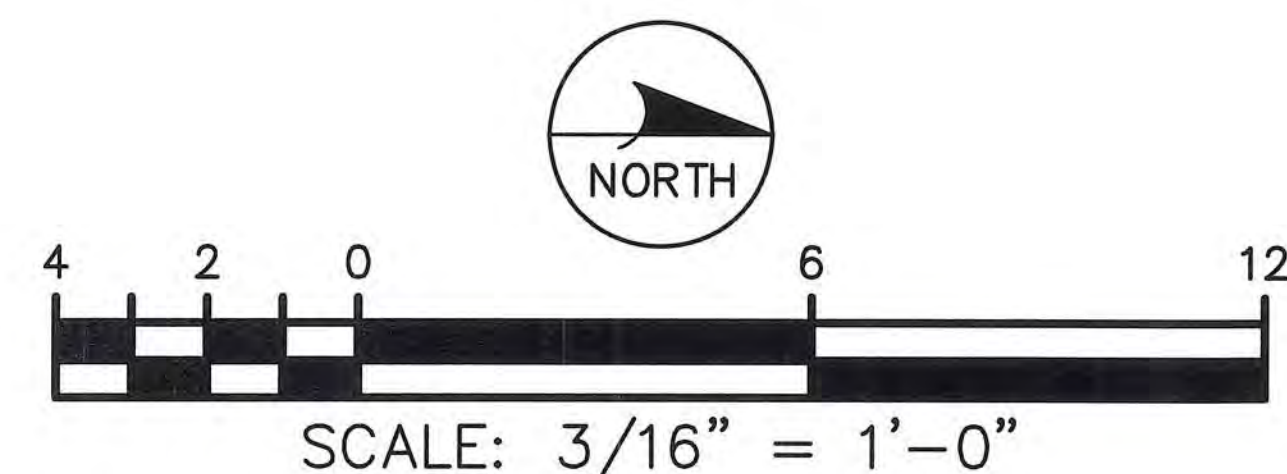

NOTES:

1. MAINTAIN MINIMUM CLEARANCE BETWEEN TRANSFORMERS AND BUILDING DOOR OPENING. COORDINATE MINIMUM CLEARANCE REQUIREMENTS WITH TEC.

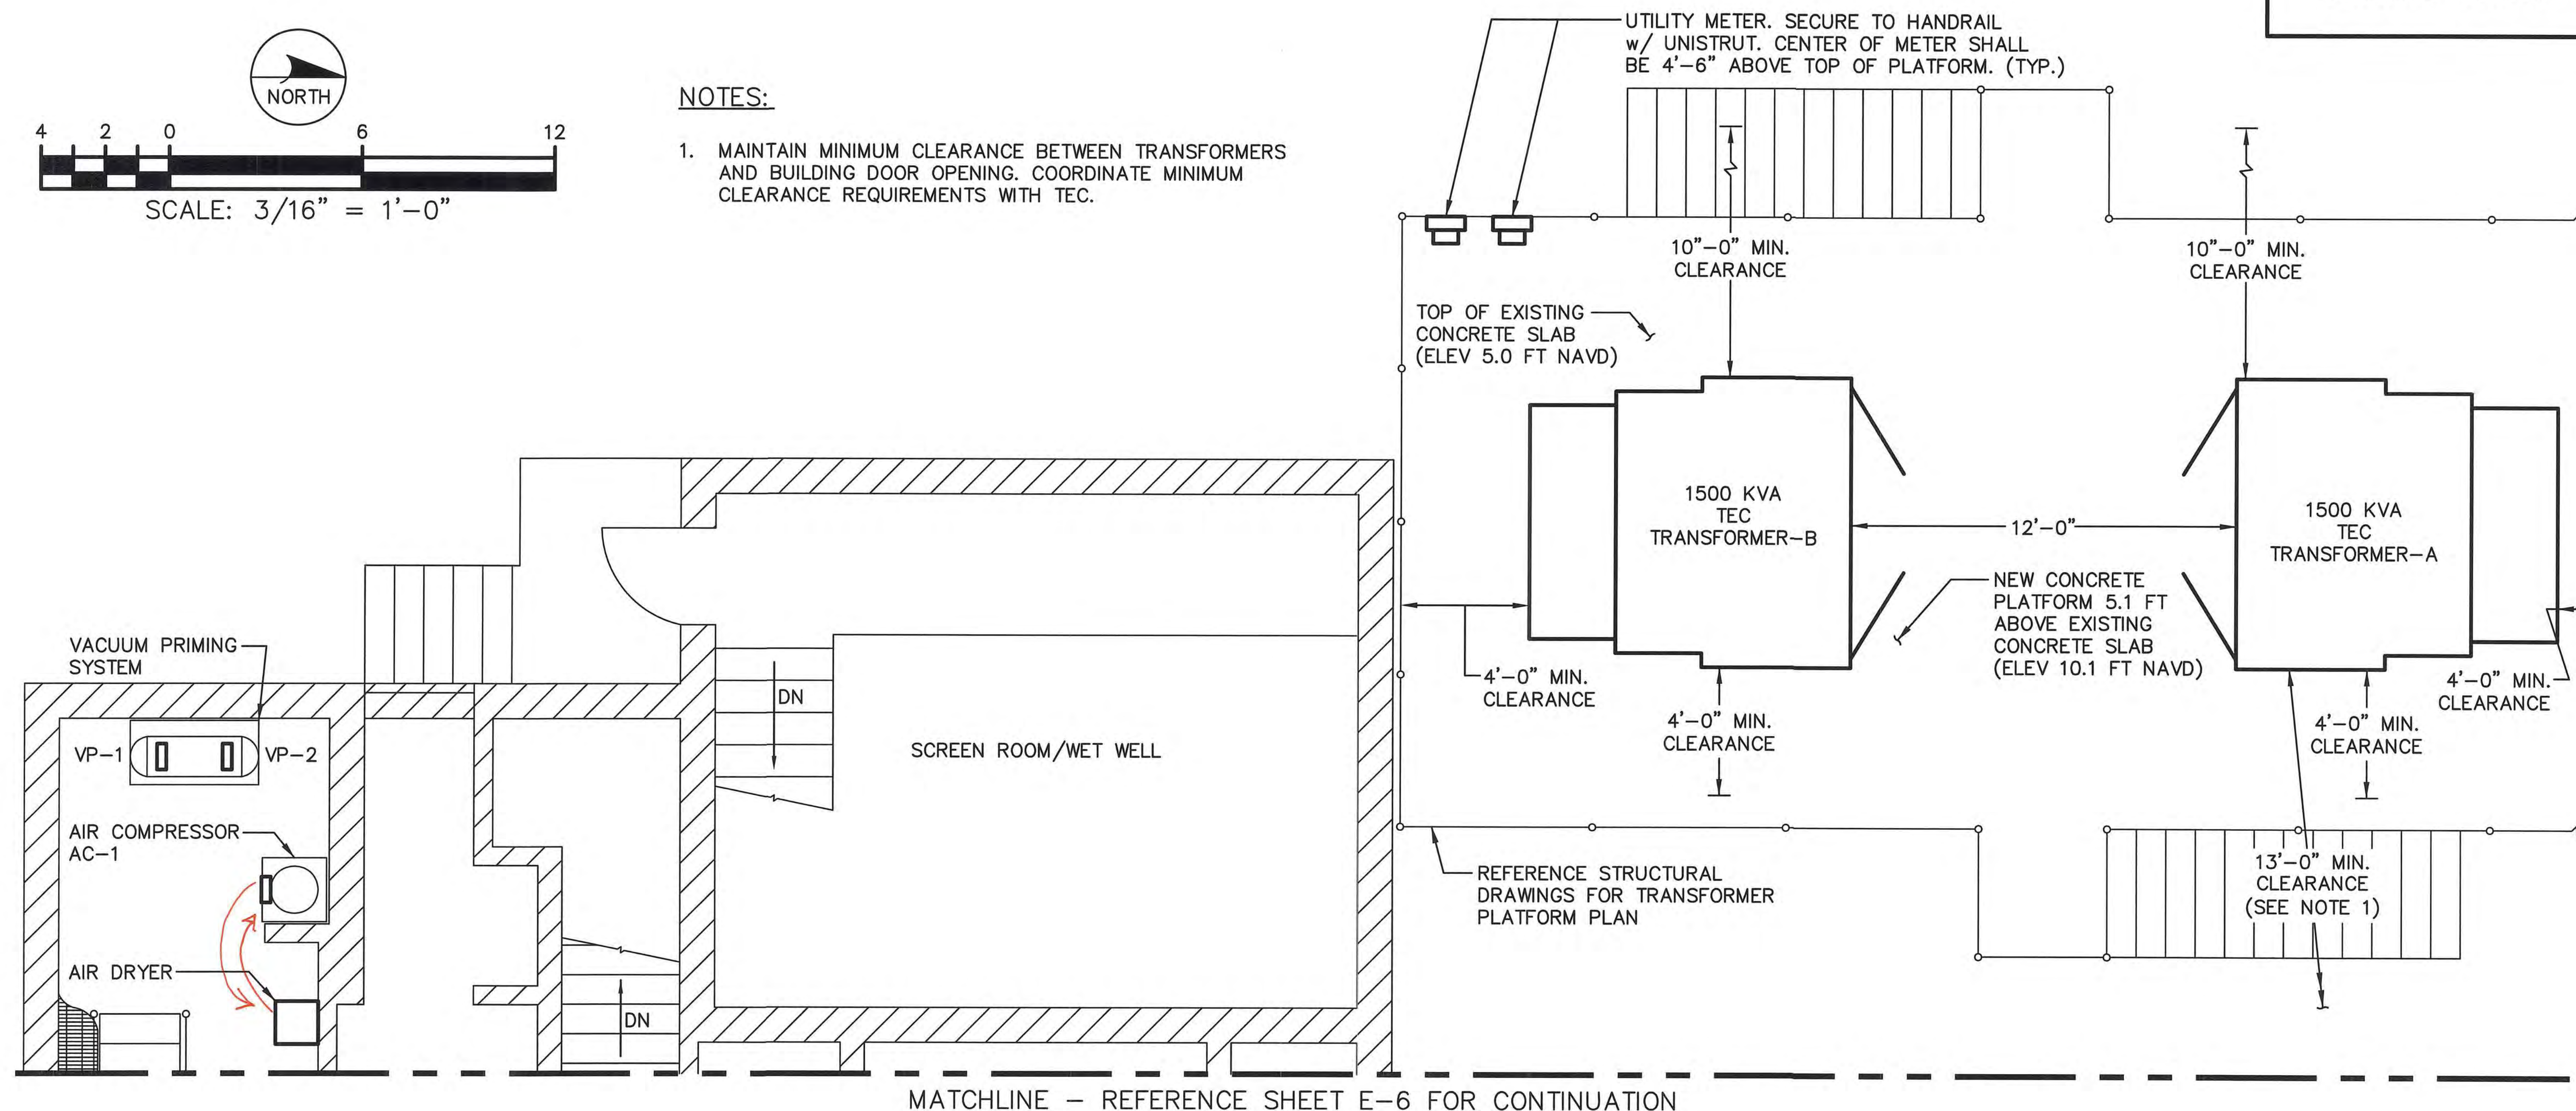

ENGINEER OF RECORD:
BOB E. HALLMAN, P.E.
FLORIDA REGISTRATION NO. 20761



**Engineering Design
Technologies Corp.**
P.O. Box 152403
Tampa, FL 33684-2403
813.289.8080
813.282.9184 FAX
engineering@edt1.com

CITY of TAMPA
WASTEWATER DEPARTMENT



KRAUSE PS REHABILITATION
ELECTRICAL EQUIPMENT LAYOUT
(UPPER LEVEL – FLOOR ELEV. 7.54' NAVD)
(SHEET 2 OF 2)

NO.	DATE	REVISIONS

DRAWN: RWB
DESIGN: STK
QC: BEH
DATE: 05/01/14

SHEET E-7

B080-069

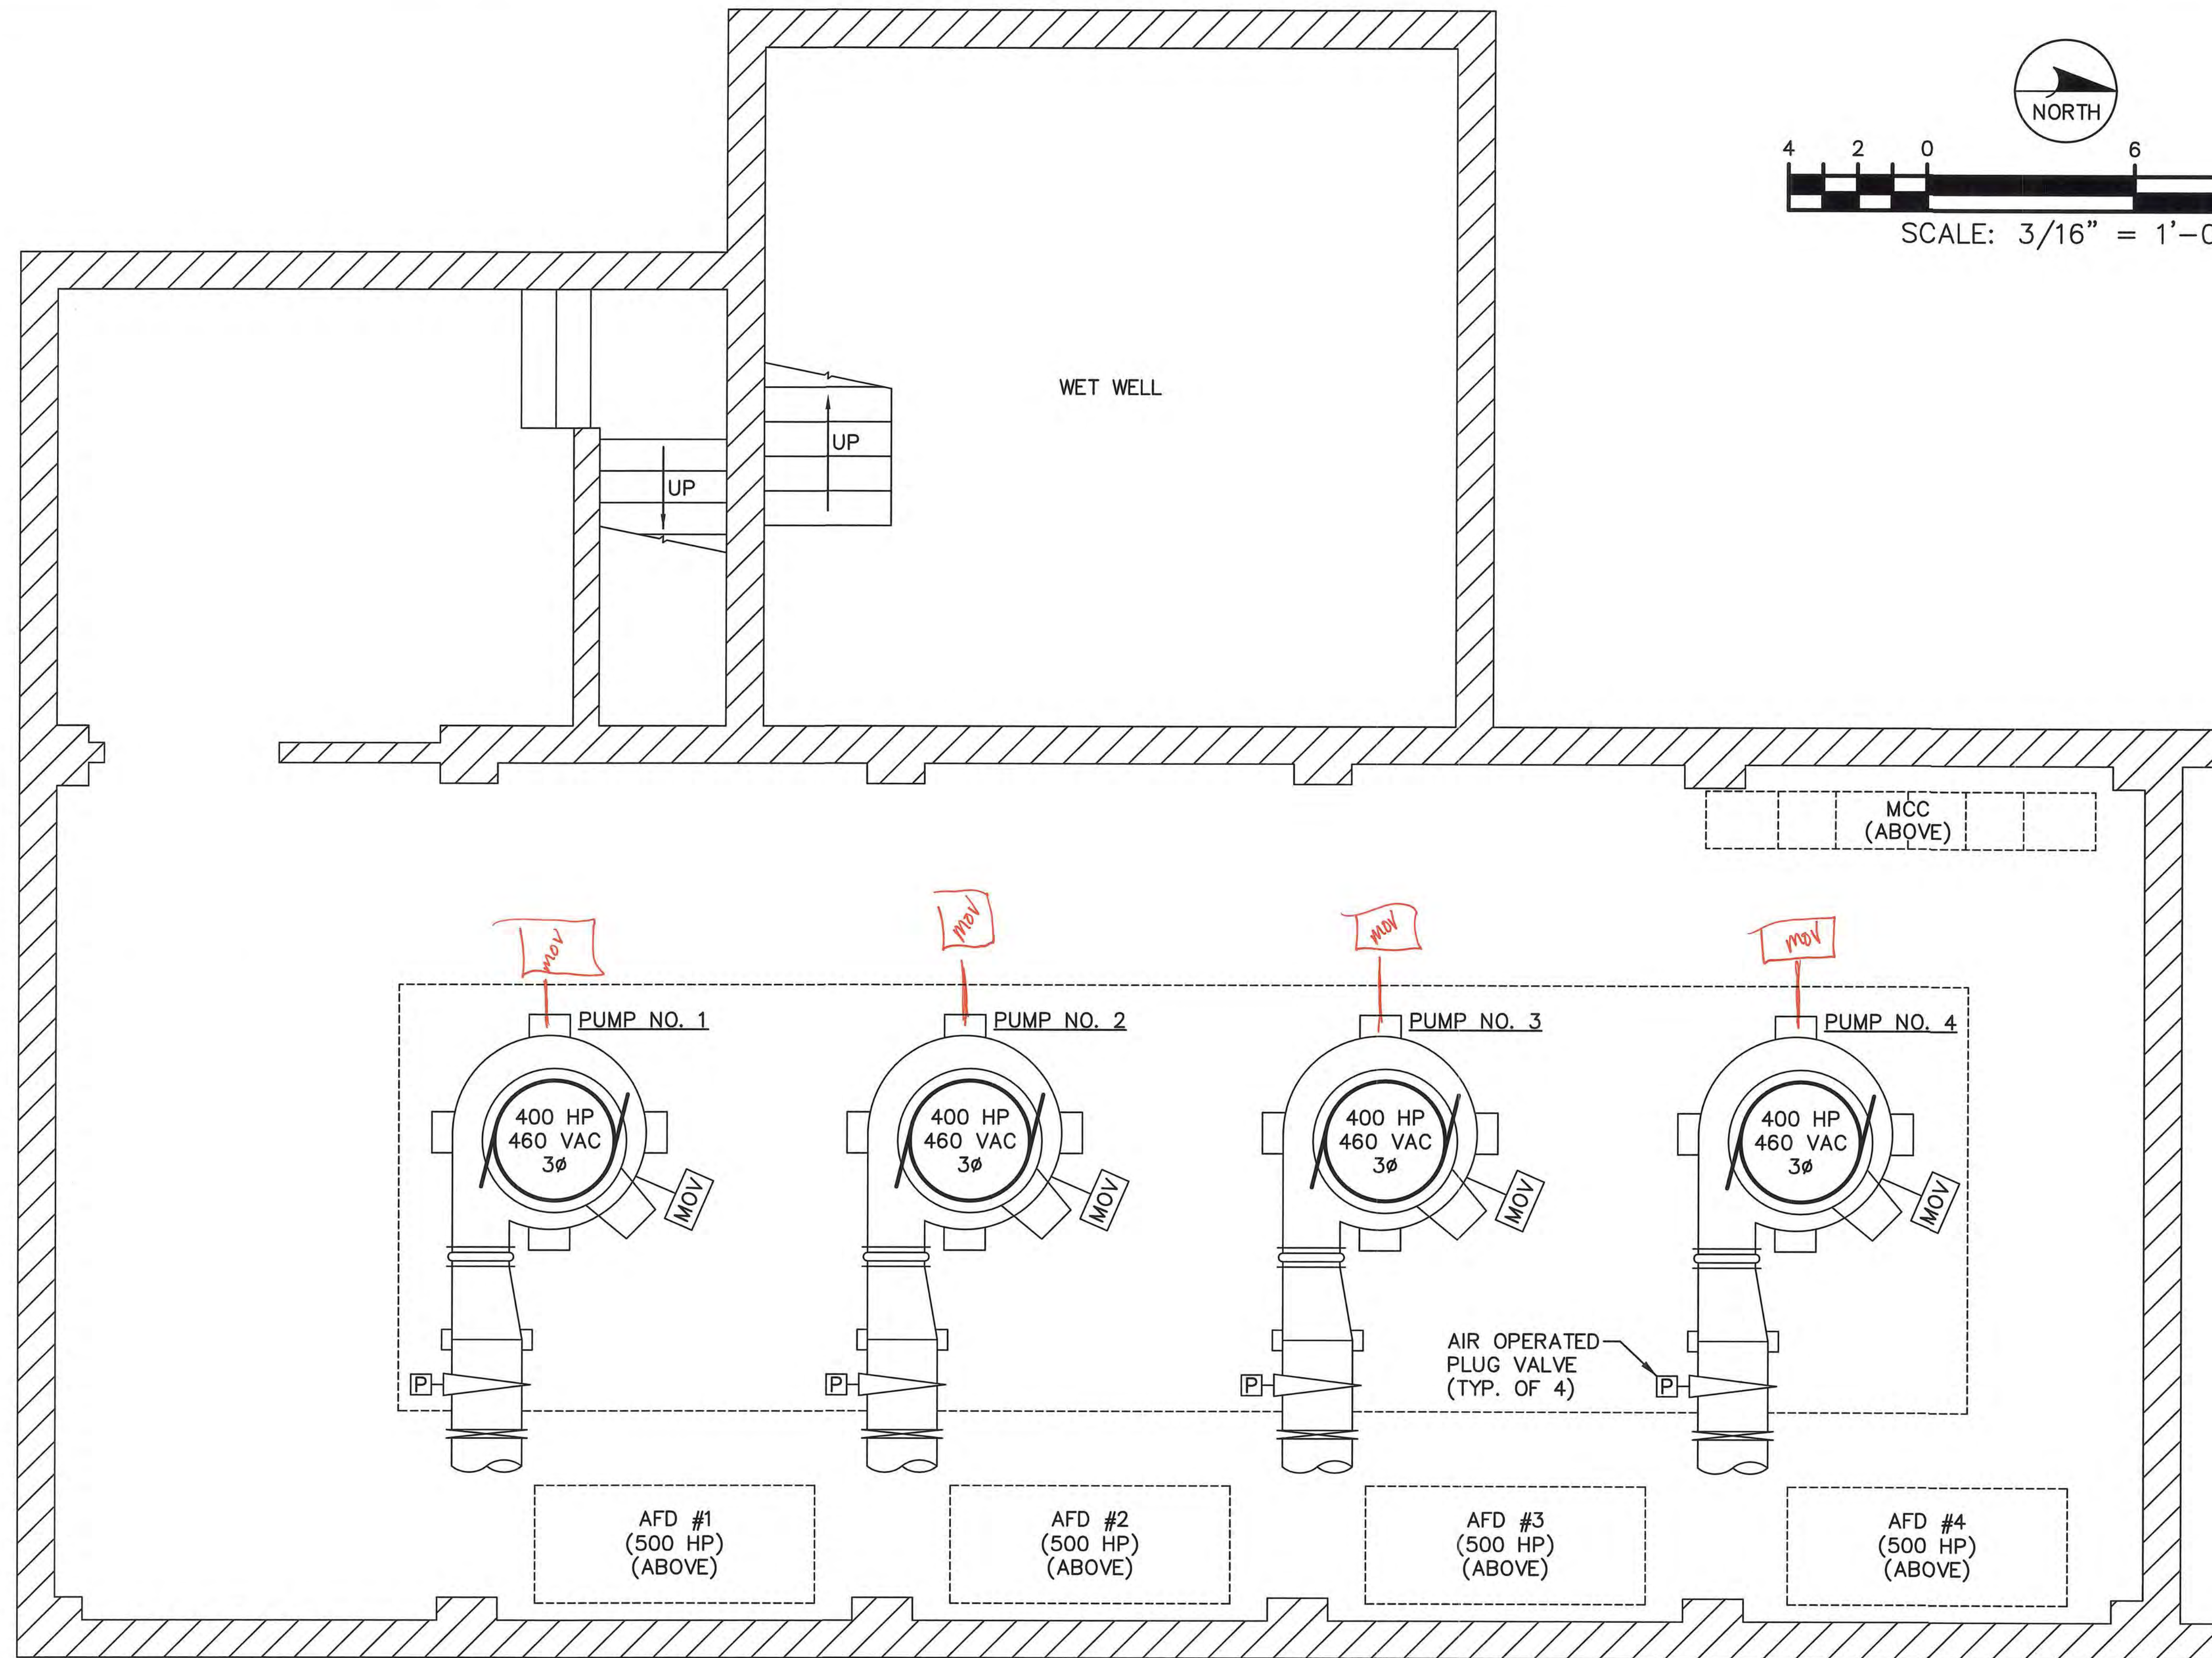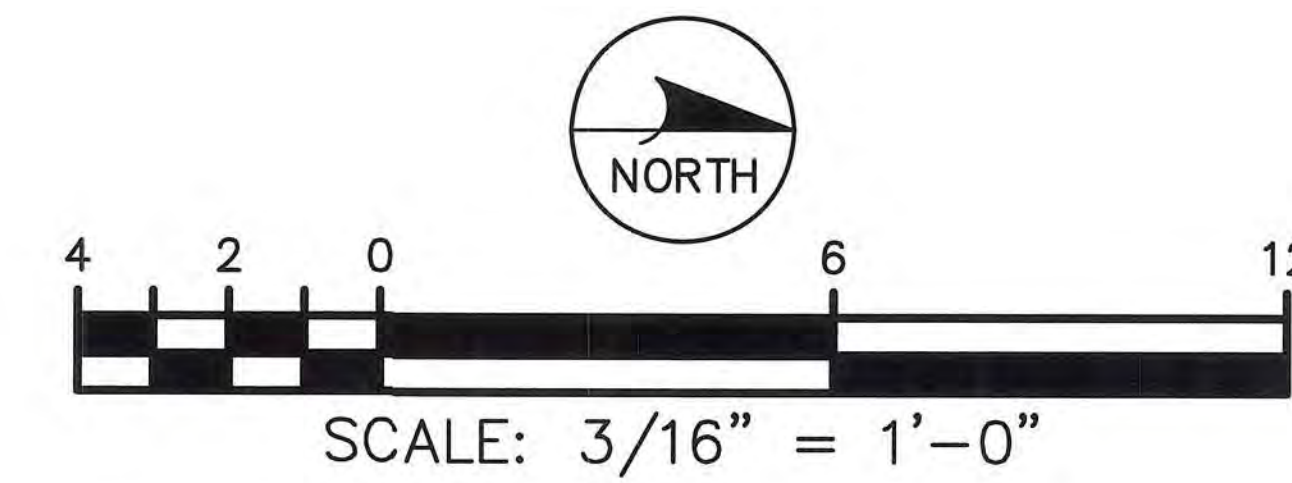

ENGINEER OF RECORD:
BOB E. HALLMAN, P.E.
FLORIDA REGISTRATION NO. 20761



**Engineering Design
Technologies Corp.**
P.O. Box 152403
Tampa, FL 33684-2403
813.289.8080
813.282.9184 FAX
engineering@edt1.com

CITY of TAMPA
WASTEWATER DEPARTMENT

KRAUSE PS REHABILITATION


**ELECTRICAL EQUIPMENT LAYOUT
(LOWER LEVEL – FLOOR ELEV. –5.99' NAVD)**

NO.	DATE	REVISIONS


DRAWN: RWB
DESIGN: STK
QC: BEH
DATE: 05/01/14

SHEET E-8

Certificate of Authorization Number: 4795

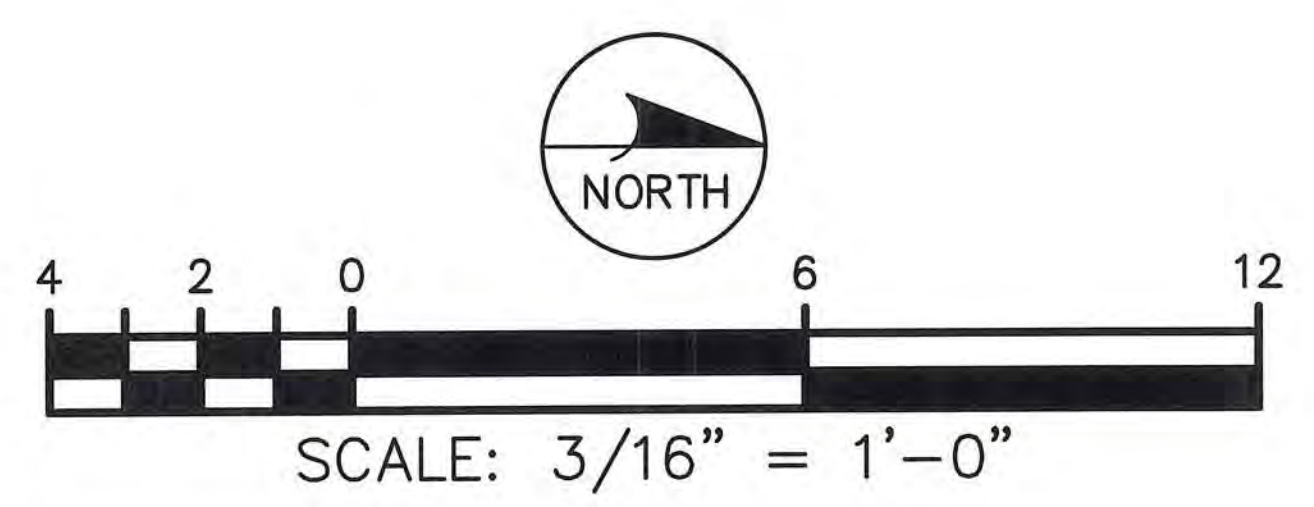

- NOTES:
1. REFERENCE OVERHEAD CONDUIT SECURING DETAIL.
 2. CONDUITS SHALL BE ROUTED SO AS NOT TO INTERFERE WITH THE TRAVELING BRIDGE CRANE.
 3. CONDUIT ROUTING SHOWN IS DIAGRAMMATIC UNLESS OTHERWISE NOTED. CONTRACTOR SHALL OPTIMIZE THE CONDUIT ROUTING, TAKING INTO ACCOUNT THE FIELD CONDITIONS AND THE FINAL EQUIPMENT SELECTED AND APPROVED IN THE SUBMITTALS.
 4. CONDUITS SHALL BE ROUTED IN LOWER LEVEL VOID BENEATH THE SWITCHBOARD PRIOR TO AREA BEING FILLED WITH CONCRETE.

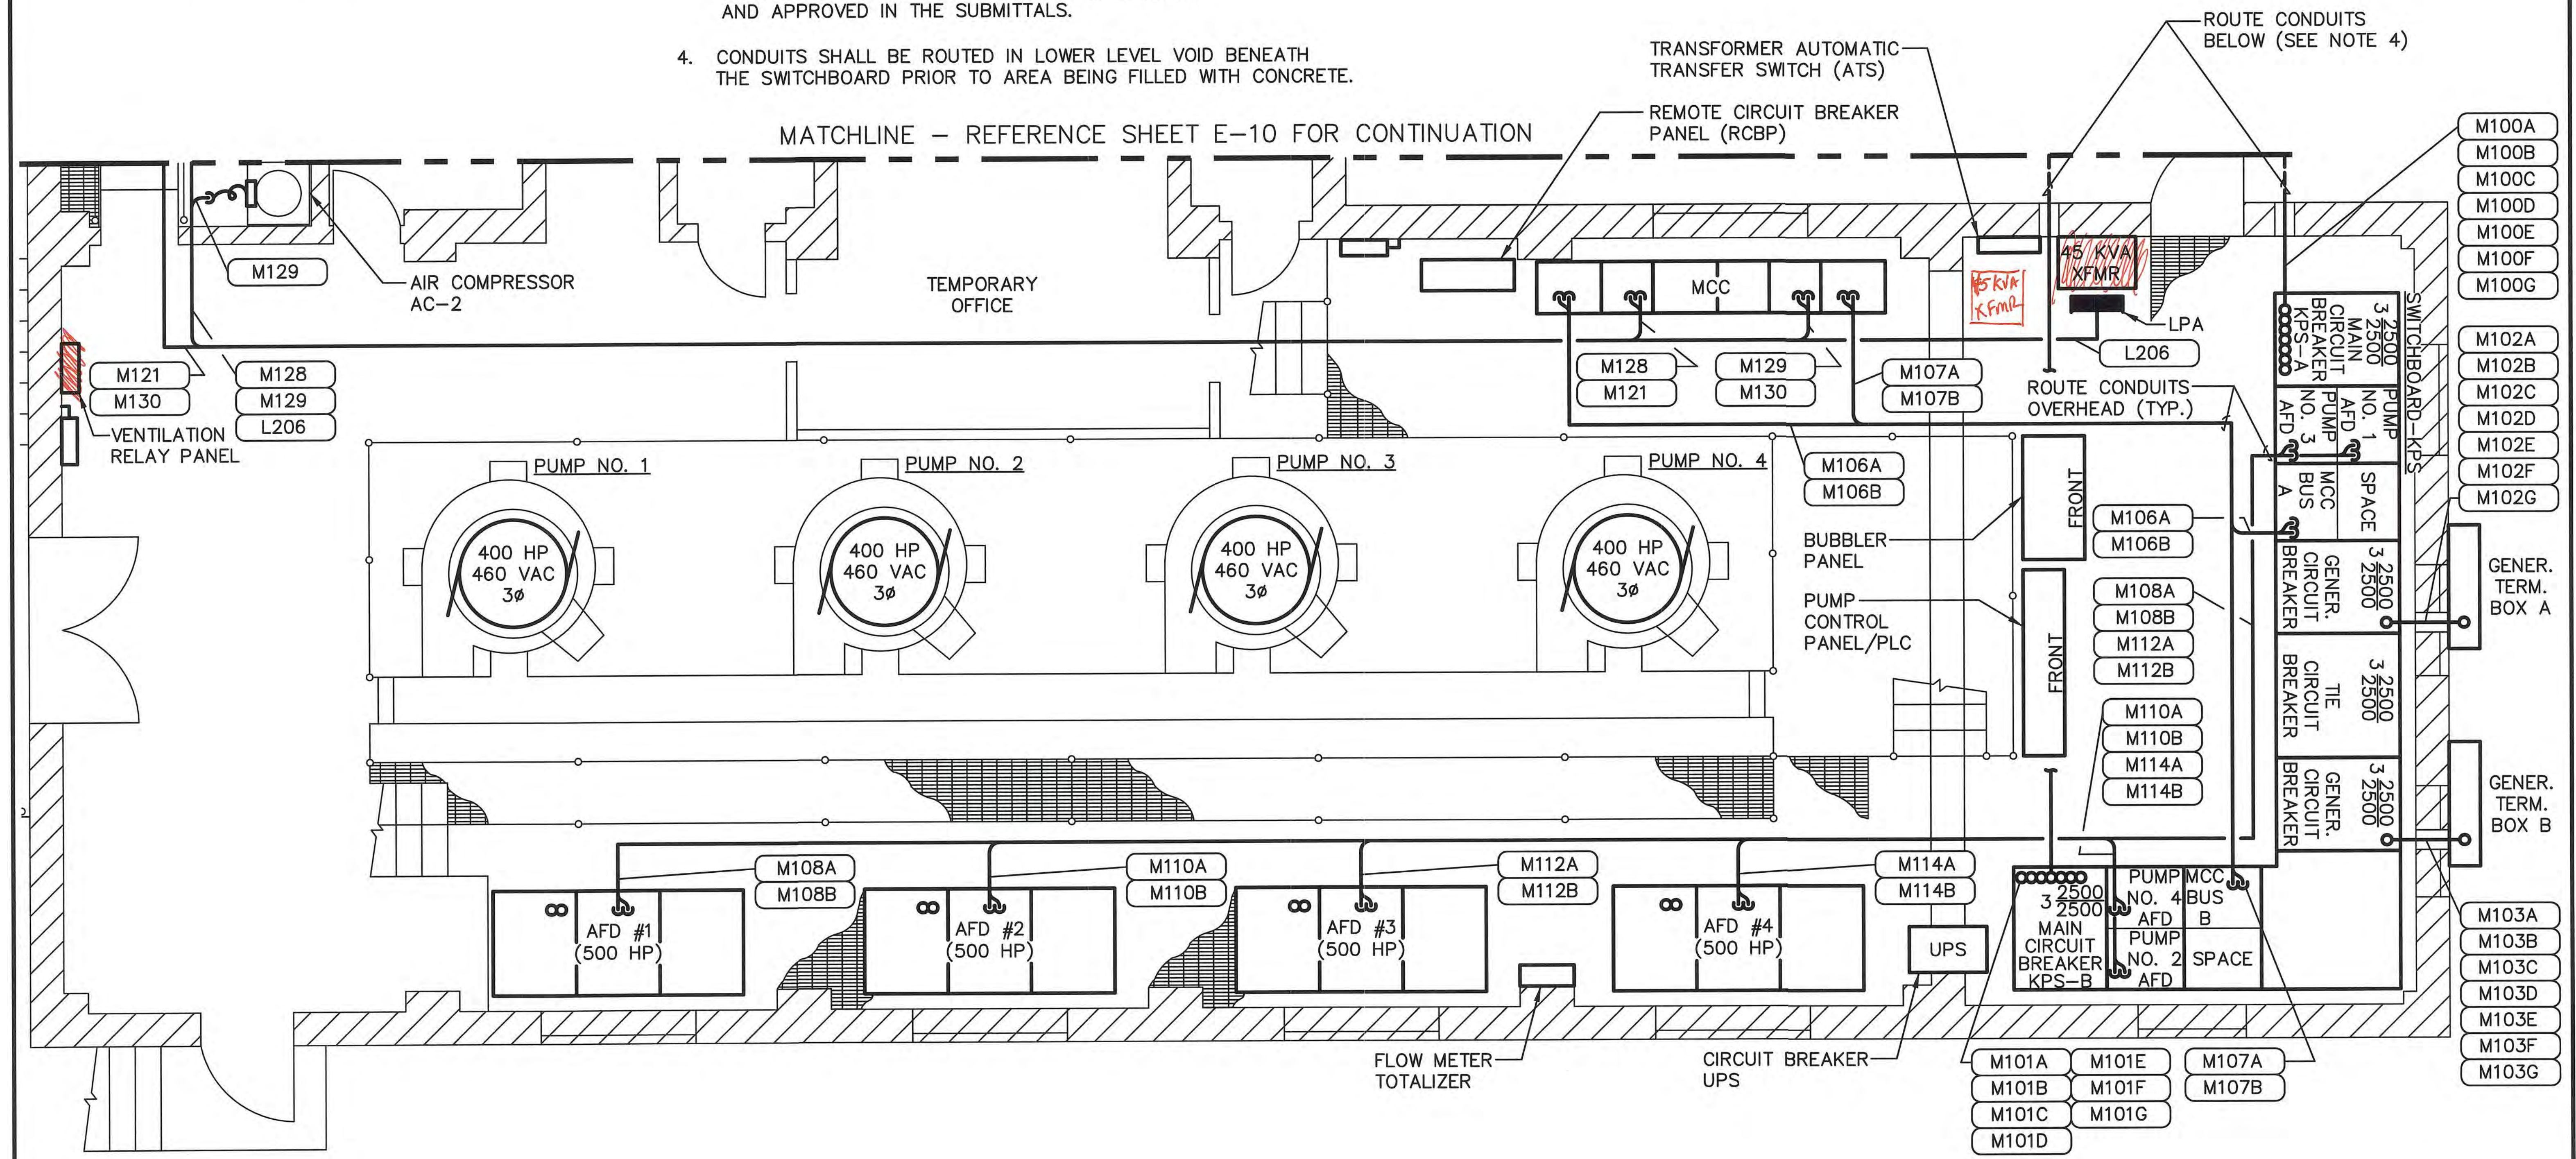

ENGINEER OF RECORD:
BOB E. HALLMAN, P.E.
FLORIDA REGISTRATION NO. 20761



Engineering Design
Technologies Corp.
P.O. Box 152403
Tampa, FL 33684-2403
813.289.8080
813.282.9184 FAX
engineering@edt1.com


CITY of TAMPA
WASTEWATER DEPARTMENT

KRAUSE PS REHABILITATION
CONDUIT ROUTING PLAN – POWER
(UPPER LEVEL – FLOOR ELEV. 7.54' NAVD)
(SHEET 1 OF 2)

NO.	DATE	REVISIONS


DRAWN: RWB
DESIGN: STK
QC: BEH
DATE: 05/01/14
SHEET E-9

B080-071

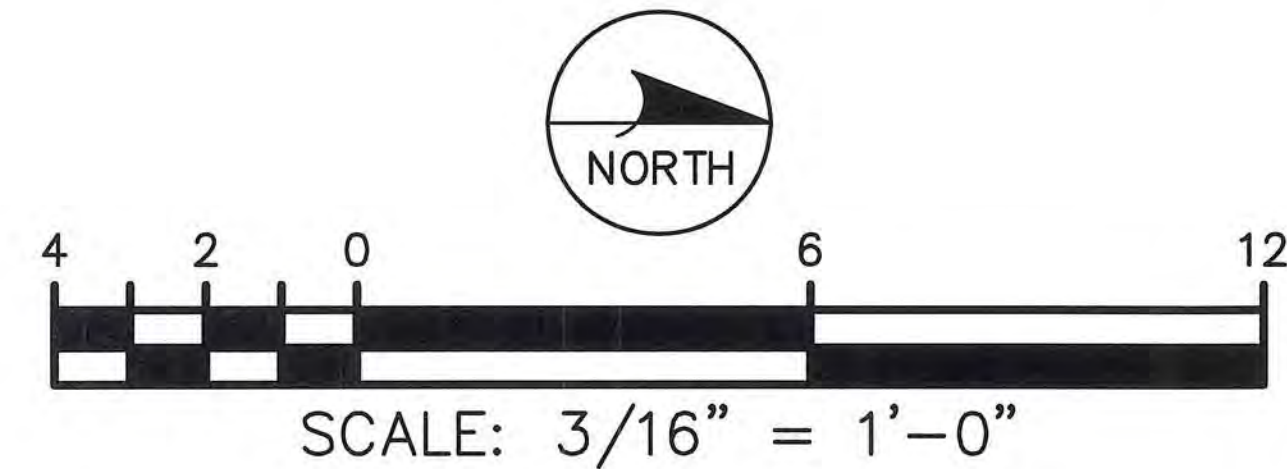

NOTES:

1. REFERENCE OVERHEAD CONDUIT SECURING DETAIL.
2. CONDUITS SHALL BE ROUTED SO AS NOT TO INTERFERE WITH THE TRAVELING BRIDGE CRANE.
3. CONDUIT ROUTING SHOWN IS DIAGRAMMATIC UNLESS OTHERWISE NOTED. CONTRACTOR SHALL OPTIMIZE THE CONDUIT ROUTING, TAKING INTO ACCOUNT THE FIELD CONDITIONS AND THE FINAL EQUIPMENT SELECTED AND APPROVED IN THE SUBMITTALS.
4. CONDUITS SHALL BE ROUTED IN LOWER LEVEL VOID BENEATH THE SWITCHBOARD PRIOR TO AREA BEING FILLED WITH CONCRETE.

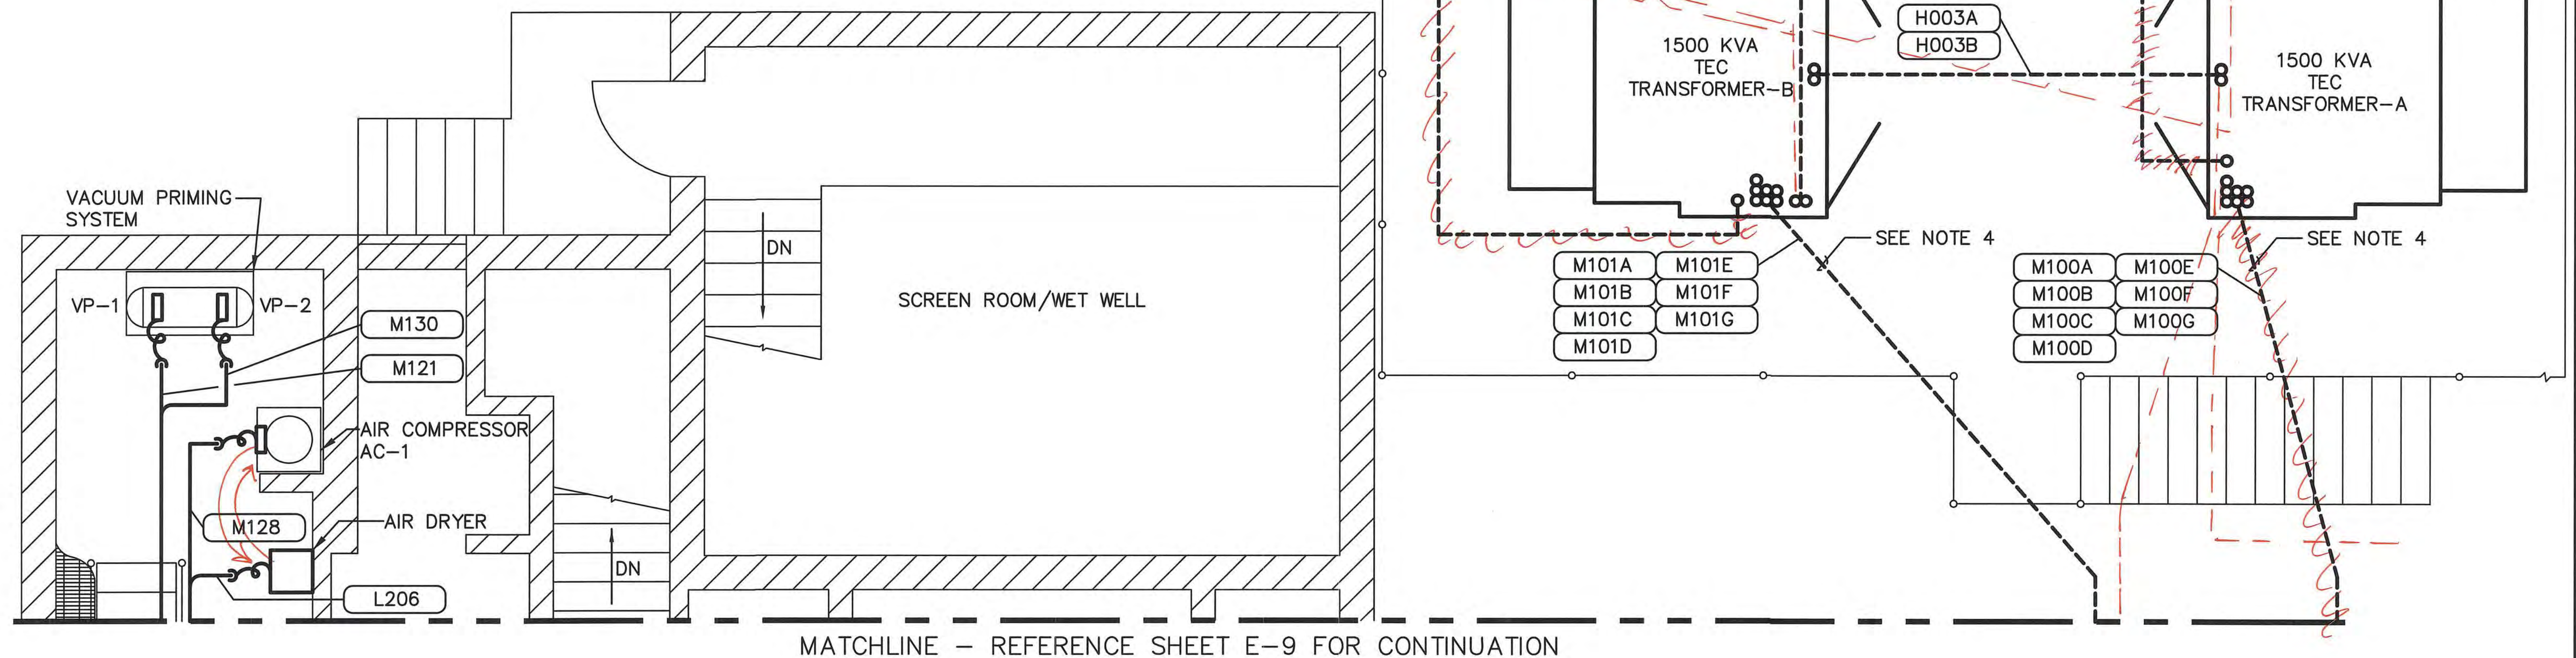

ENGINEER OF RECORD:
BOB E. HALLMAN, P.E.
FLORIDA REGISTRATION NO. 20761



**Engineering Design
Technologies Corp.**
P.O. Box 152403
Tampa, FL 33684-2403
813.289.8080
813.282.9184 FAX
engineering@edt1.com


CITY of TAMPA
WASTEWATER DEPARTMENT

KRAUSE PS REHABILITATION
CONDUIT ROUTING PLAN - POWER
(UPPER LEVEL - FLOOR ELEV. 7.54' NAVD)
(SHEET 2 OF 2)

NO.	DATE	REVISIONS

DRAWN: RWB
DESIGN: STK
QC: BEH
DATE: 05/01/14


SHEET E-10

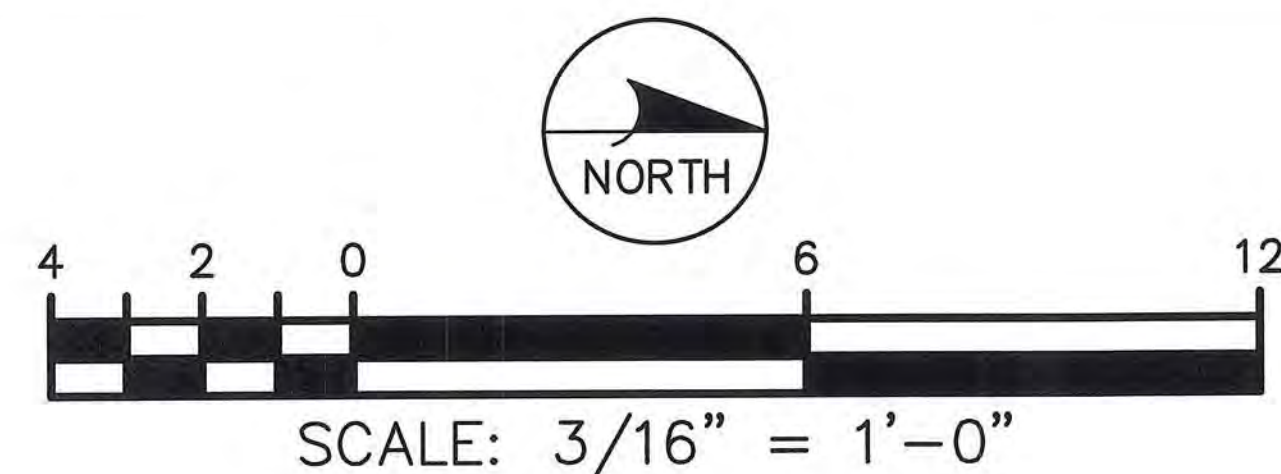

WET WELL

NOTES:

1. REFERENCE OVERHEAD CONDUIT SECURING DETAIL.
2. AFTER CORE DRILLING HOLES THROUGH REINFORCED CONCRETE WALLS AND FLOORS, COAT EXPOSED REINFORCING STEEL CONCRETE SURFACES WITH EMACO P24 BY BASF. AFTER ROUTING CONDUIT THROUGH HOLE, FILL AND FINISH CONCRETE WITH A SHRINKAGE COMPENSATING REPAIR MORTAR WITH CORROSION INHIBITING PROPERTIES, EMACO S66 C1 BY BASF. REFERENCE STRUCTURAL DRAWINGS.
3. REFERENCE PUMP/MOTOR CONNECTION DETAIL.
4. CONDUIT ROUTING SHOWN IS DIAGRAMMATIC UNLESS OTHERWISE NOTED. CONTRACTOR SHALL OPTIMIZE THE CONDUIT ROUTING, TAKING INTO ACCOUNT THE FIELD CONDITIONS AND THE FINAL EQUIPMENT SELECTED AND APPROVED IN THE SUBMITTALS.

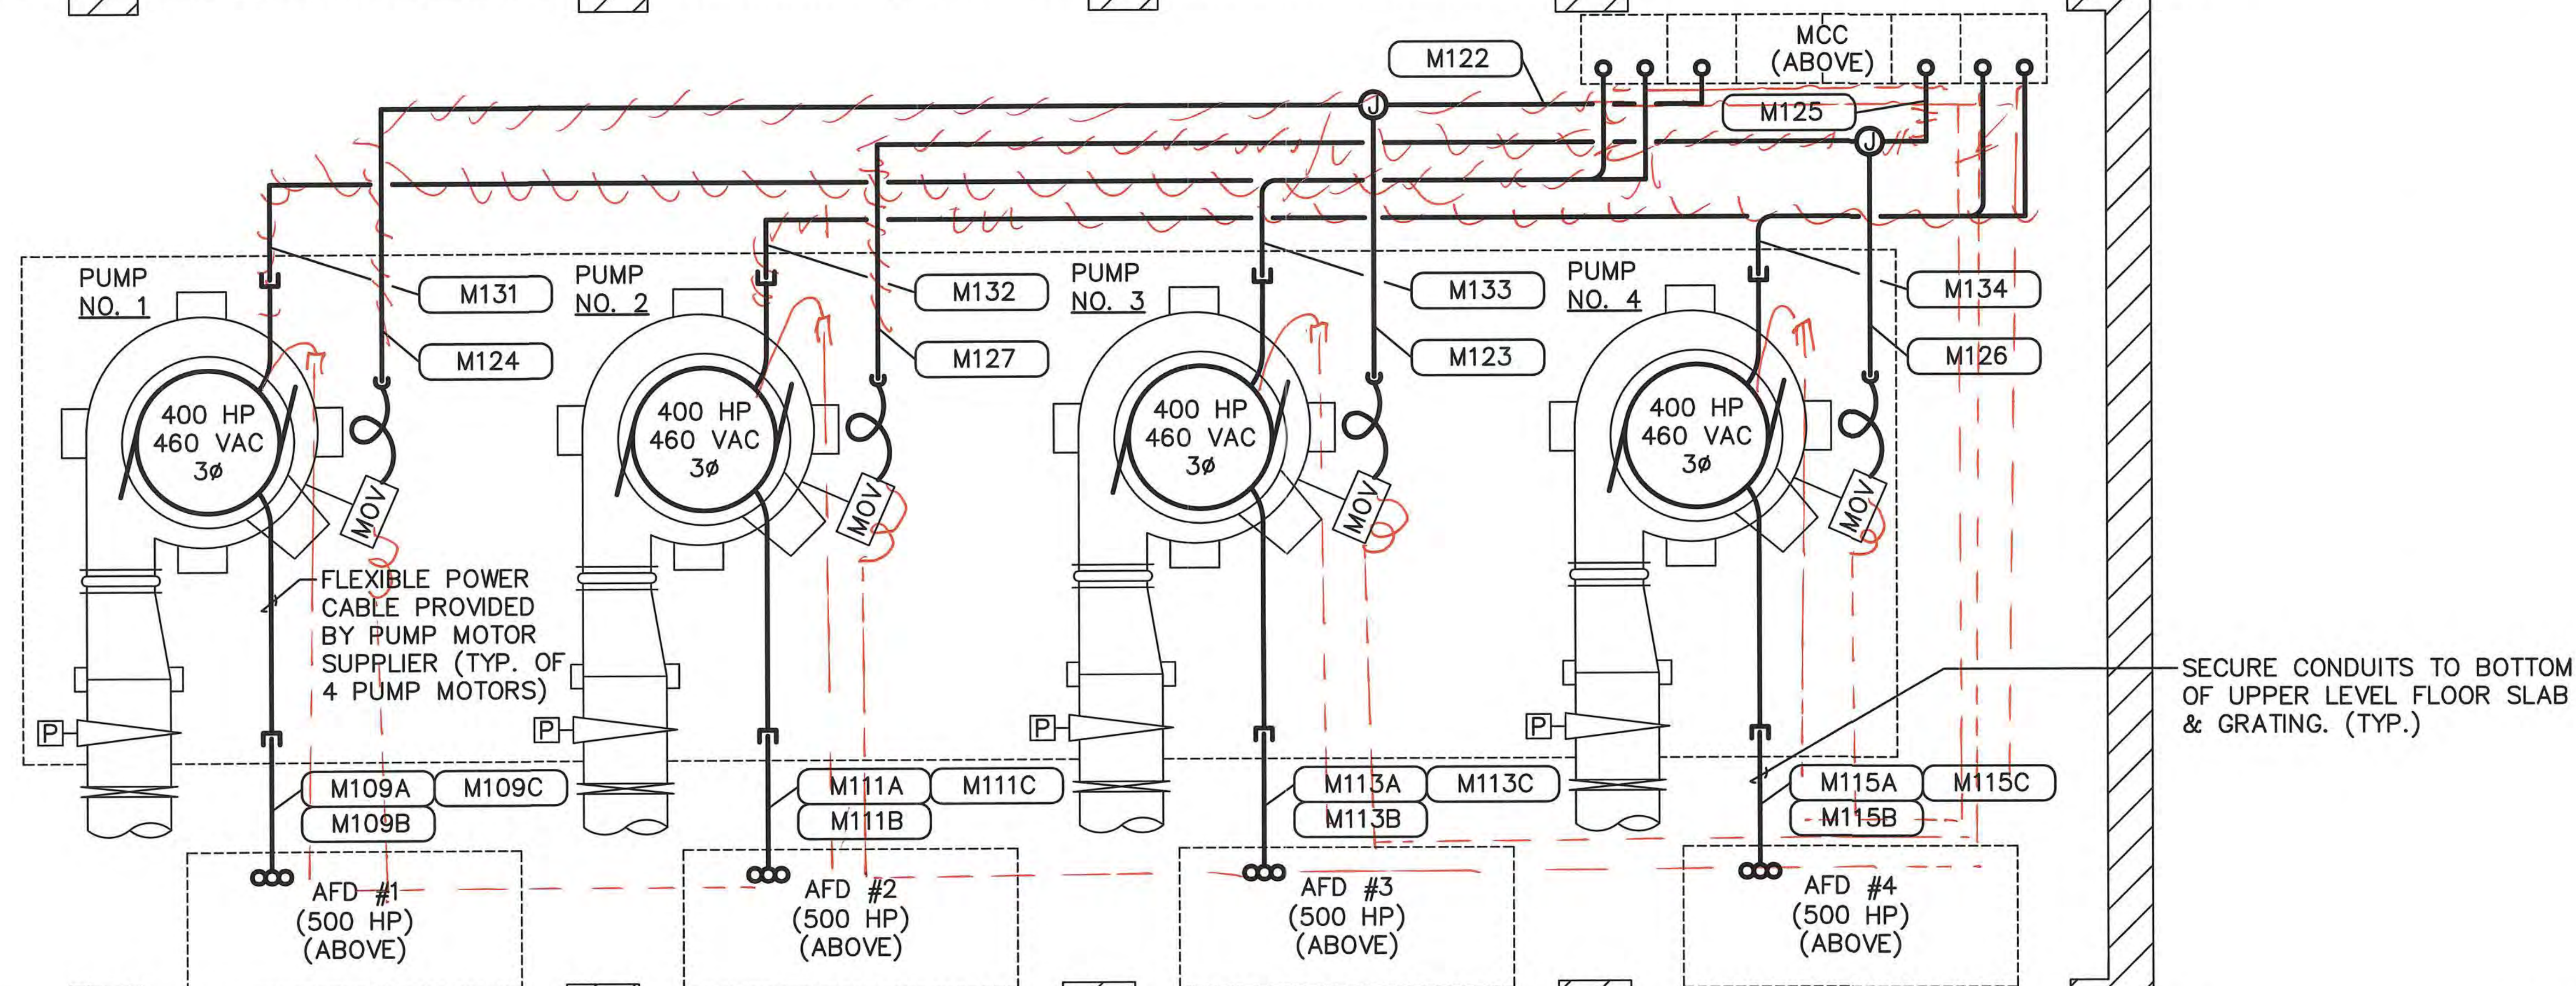

ENGINEER OF RECORD:
BOB E. HALLMAN, P.E.
FLORIDA REGISTRATION NO. 20761



**Engineering Design
Technologies Corp.**
P.O. Box 152403
Tampa, FL 33684-2403
813.289.8080
813.282.9184 FAX
engineering@edt1.com

Certificate of Authorization Number: 4795


CITY of TAMPA
WASTEWATER DEPARTMENT

KRAUSE PS REHABILITATION
CONDUIT ROUTING PLAN – POWER
(LOWER LEVEL – FLOOR ELEV. -5.99' NAVD)

NO.	DATE	REVISIONS


DRAWN: RWB
DESIGN: STK
QC: BEH
DATE: 05/01/14

SHEET E-11

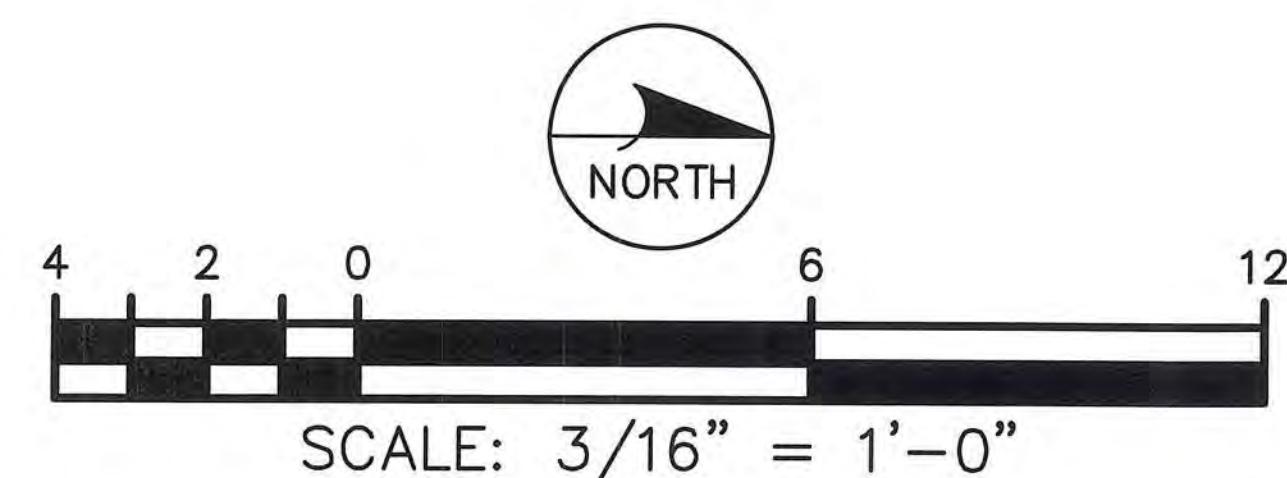

NOTES:

1. REFERENCE OVERHEAD CONDUIT SECURING DETAIL.
2. CONDUITS SHALL BE ROUTED SO AS NOT TO INTERFERE WITH THE TRAVELING BRIDGE CRANE.
3. CONDUIT ROUTING SHOWN IS DIAGRAMMATIC UNLESS OTHERWISE NOTED. CONTRACTOR SHALL OPTIMIZE THE CONDUIT ROUTING, TAKING INTO ACCOUNT THE FIELD CONDITIONS AND THE FINAL EQUIPMENT SELECTED AND APPROVED IN THE SUBMITTALS.

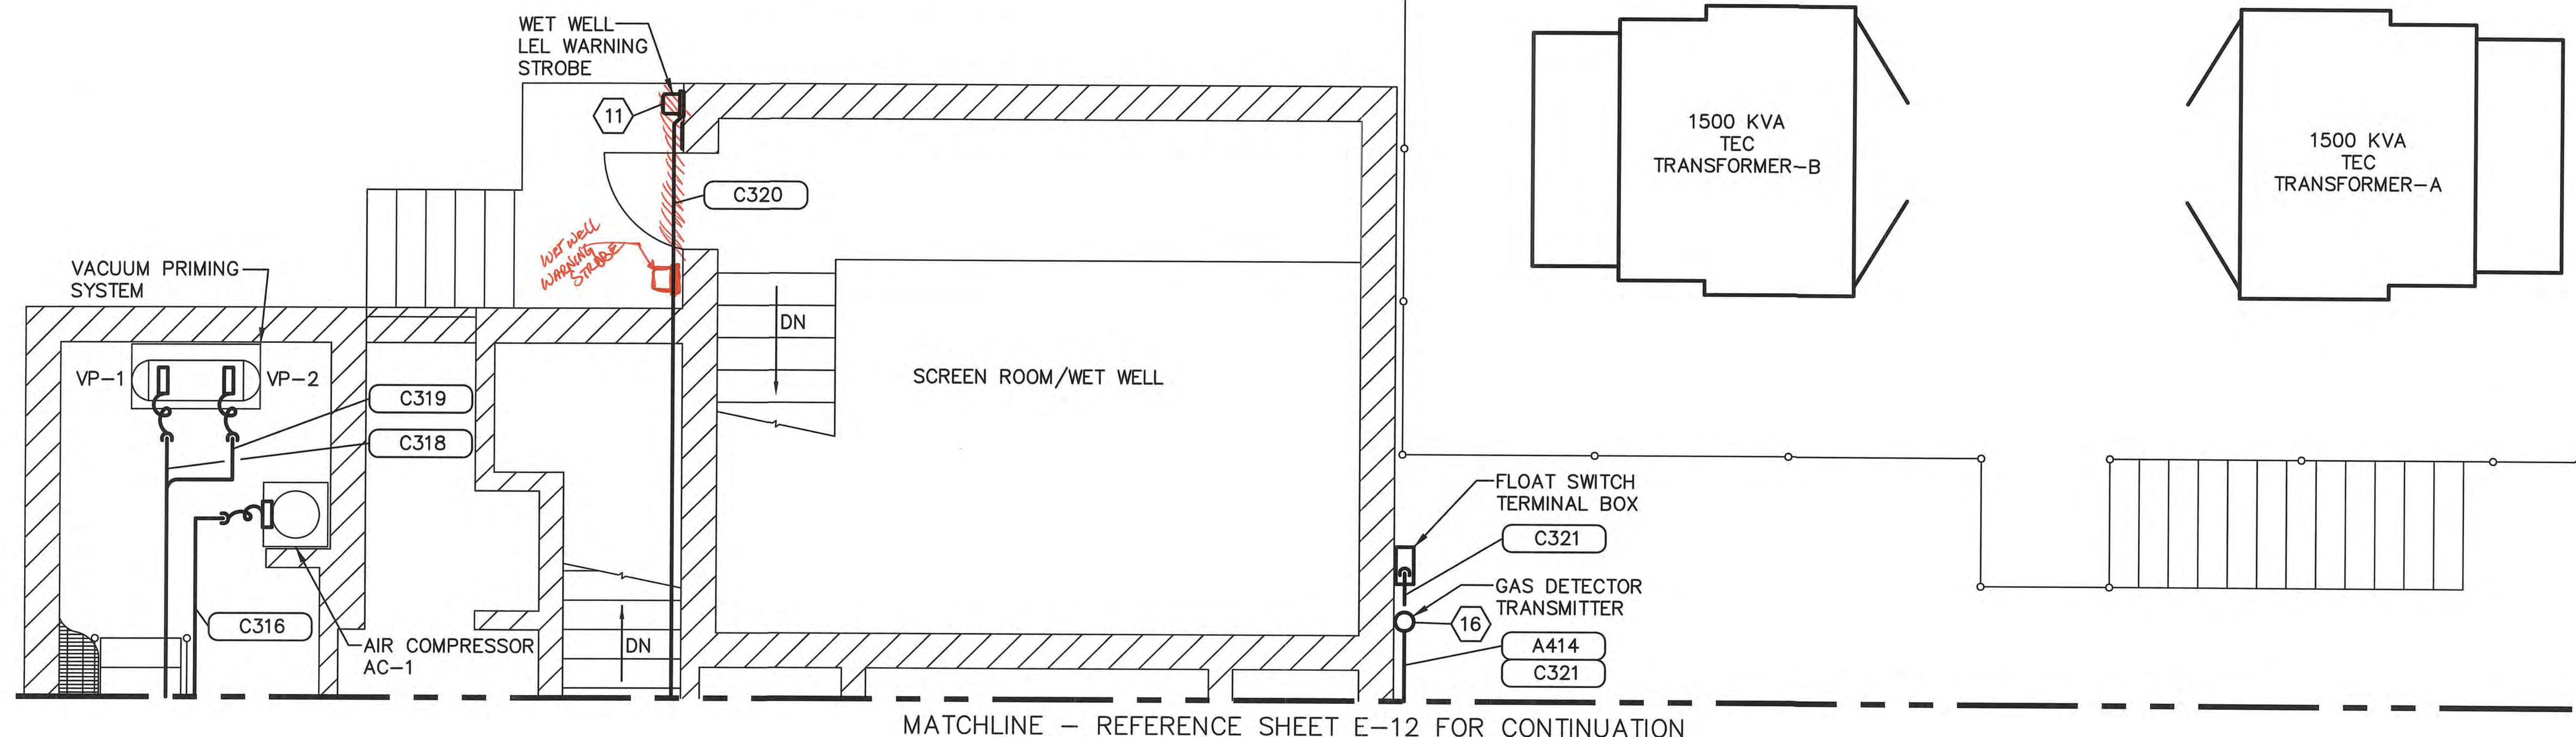

SEE KEYED NOTES ON SHEET E-23

ENGINEER OF RECORD:
BOB E. HALLMAN, P.E.
FLORIDA REGISTRATION NO. 20761



**Engineering Design
Technologies Corp.**
P.O. Box 152403
Tampa, FL 33684-2403
813.289.8080
813.282.9184 FAX
engineering@edt1.com



CITY of TAMPA
WASTEWATER DEPARTMENT

KRAUSE PS REHABILITATION
CONDUIT ROUTING PLAN - CONTROLS
(UPPER LEVEL - FLOOR ELEV. 7.54' NAVD)
(SHEET 2 OF 2)

NO.	DATE	REVISIONS

DRAWN: RWB
DESIGN: STK
QC: BEH
DATE: 05/01/14

SHEET E-13

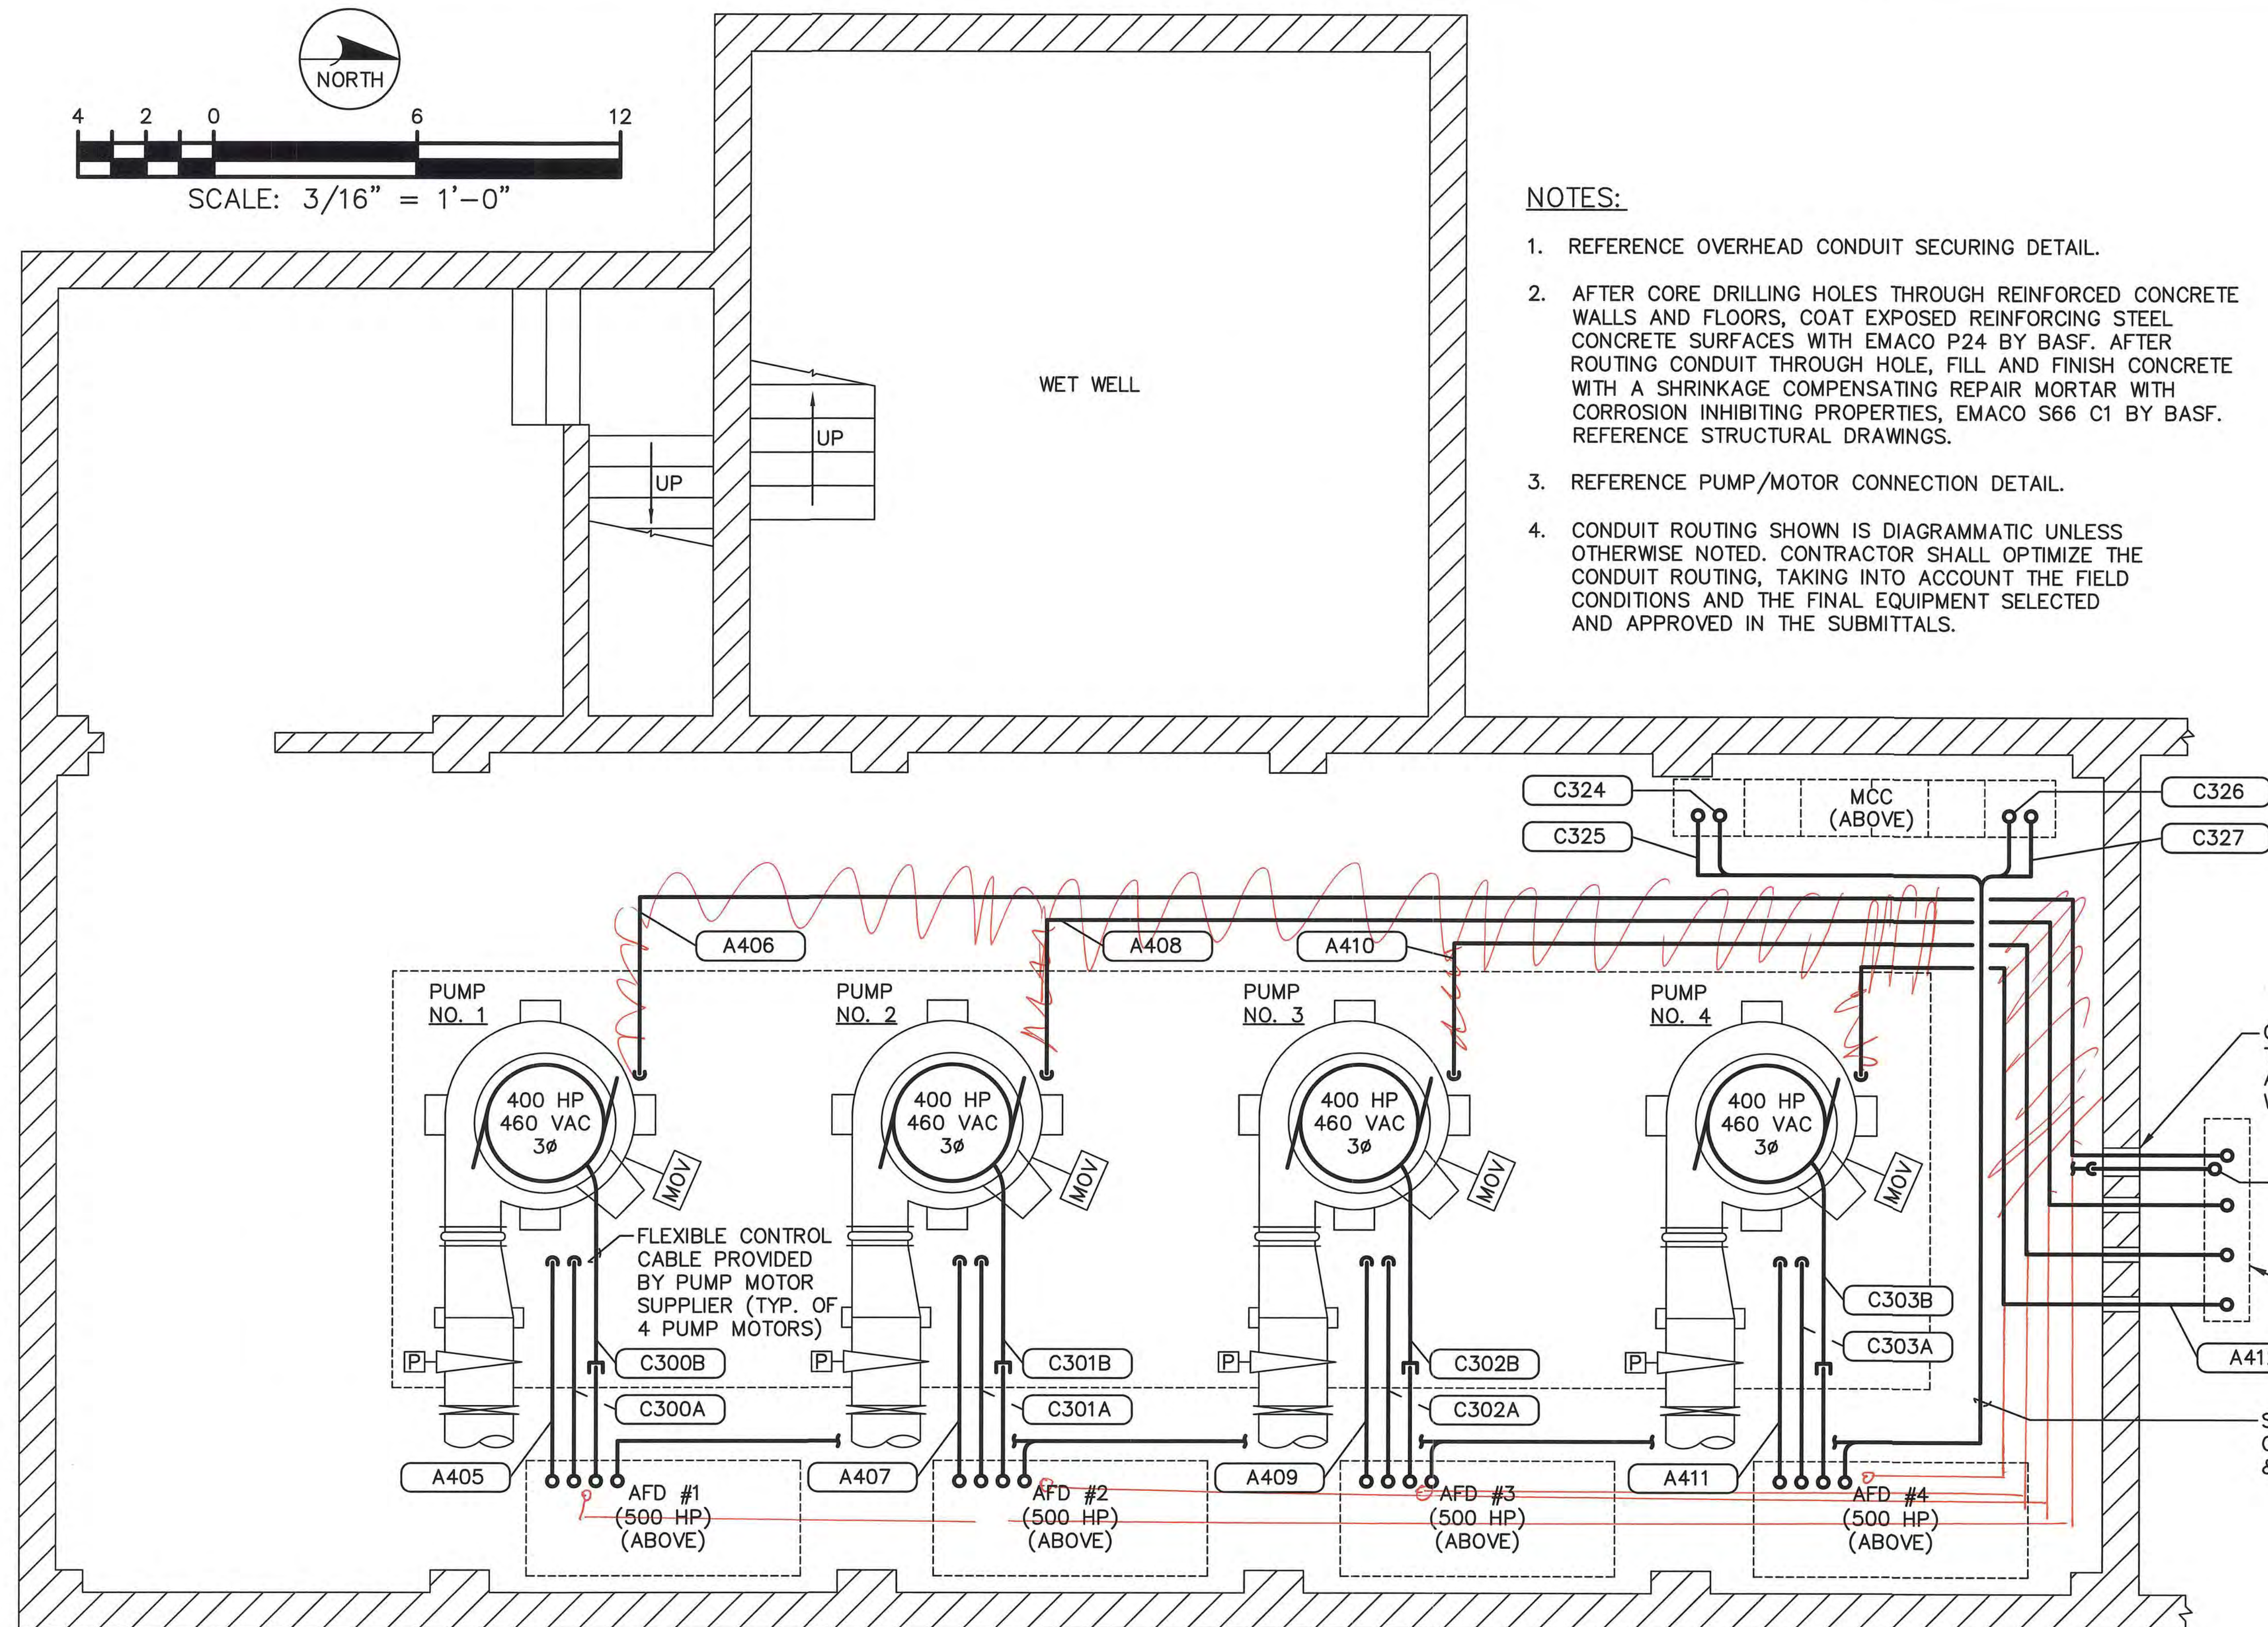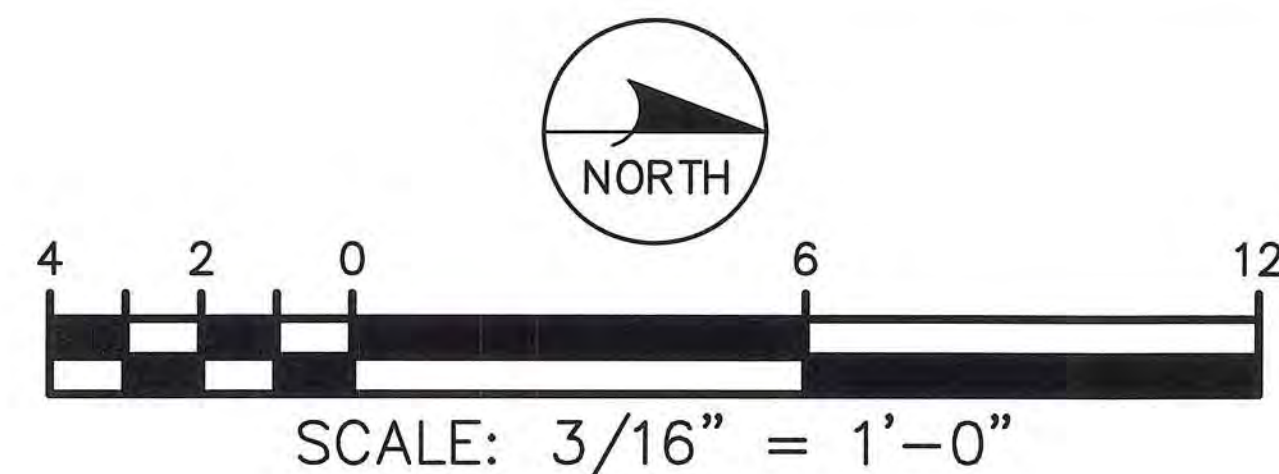

NOTES:

1. REFERENCE OVERHEAD CONDUIT SECURING DETAIL.
2. AFTER CORE DRILLING HOLES THROUGH REINFORCED CONCRETE WALLS AND FLOORS, COAT EXPOSED REINFORCING STEEL CONCRETE SURFACES WITH EMACO P24 BY BASF. AFTER ROUTING CONDUIT THROUGH HOLE, FILL AND FINISH CONCRETE WITH A SHRINKAGE COMPENSATING REPAIR MORTAR WITH CORROSION INHIBITING PROPERTIES, EMACO S66 C1 BY BASF. REFERENCE STRUCTURAL DRAWINGS.
3. REFERENCE PUMP/MOTOR CONNECTION DETAIL.
4. CONDUIT ROUTING SHOWN IS DIAGRAMMATIC UNLESS OTHERWISE NOTED. CONTRACTOR SHALL OPTIMIZE THE CONDUIT ROUTING, TAKING INTO ACCOUNT THE FIELD CONDITIONS AND THE FINAL EQUIPMENT SELECTED AND APPROVED IN THE SUBMITTALS.

ENGINEER OF RECORD:
BOB E. HALLMAN, P.E.
FLORIDA REGISTRATION NO. 20761



**Engineering Design
Technologies Corp.**
P.O. Box 152403
Tampa, FL 33684-2403
813.289.8080
813.282.9184 FAX
engineering@edt1.com

CITY of TAMPA
WASTEWATER DEPARTMENT


KRAUSE PS REHABILITATION
CONDUIT ROUTING PLAN – CONTROLS
(LOWER LEVEL – FLOOR ELEV. -5.99' NAVD)

NO.	DATE	REVISIONS


DRAWN: RWB
DESIGN: STK
QC: BEH
DATE: 05/01/14

SHEET E-14

MATCHLINE — REFERENCE SHEET E-15 FOR CONTINUATION

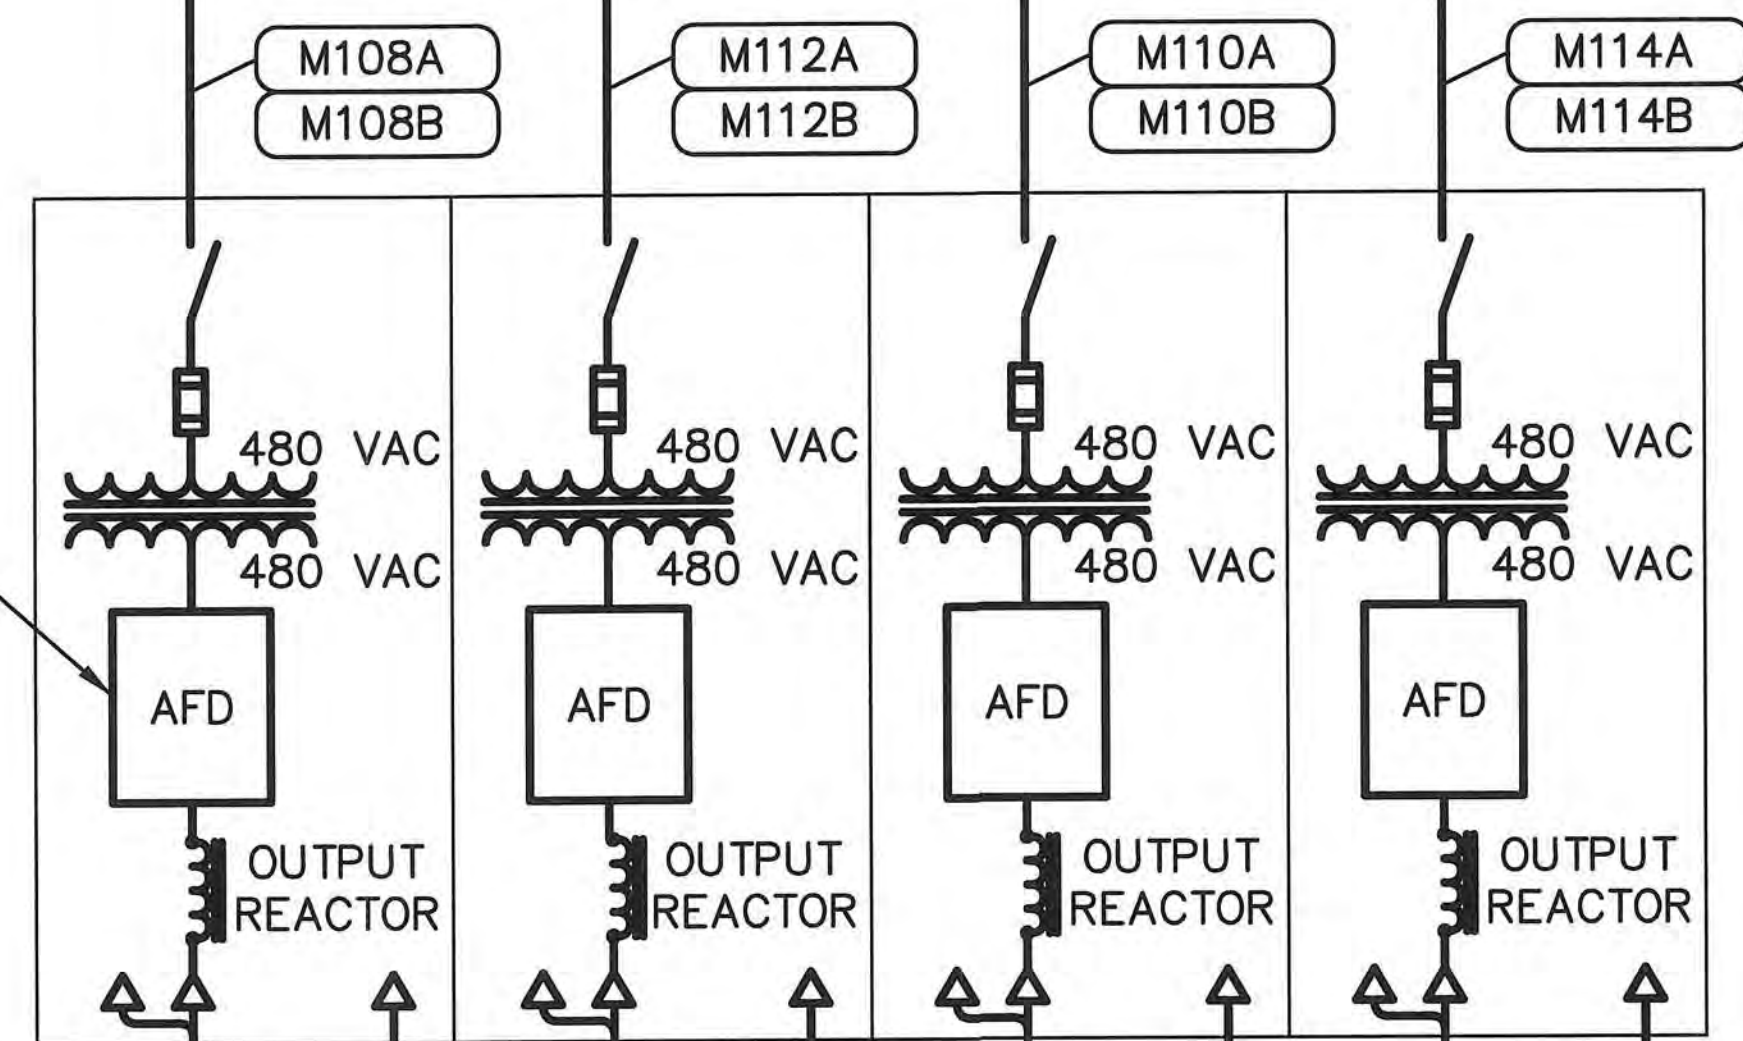500 HP 12 PULSE
AFD (590 FLA)
(TYP.)**SWITCHBOARD-KPS LOAD SUMMARY**277/480 VAC, 3 ϕ , 4W

LOAD	BUS A CONNECTED	BUS A DEMAND	BUS B CONNECTED	BUS B DEMAND	TOTAL DEMAND
MCC-KPS	73.1 KVA	59.8 KVA	84.4 KVA	33.3 KVA	93.1 KVA
PUMP NO. 1	433.4 KVA	433.4 KVA	---- KVA	---- KVA	433.4 KVA
PUMP NO. 2	---- KVA	---- KVA	433.4 KVA	433.4 KVA	433.4 KVA
PUMP NO. 3	433.4 KVA	433.4 KVA	---- KVA	---- KVA	433.4 KVA
PUMP NO. 4	---- KVA	---- KVA	433.4 KVA	---- KVA	---- KVA
TOTAL	939.9 KVA	926.6 KVA	951.2 KVA	466.7 KVA	1393.3 KVA

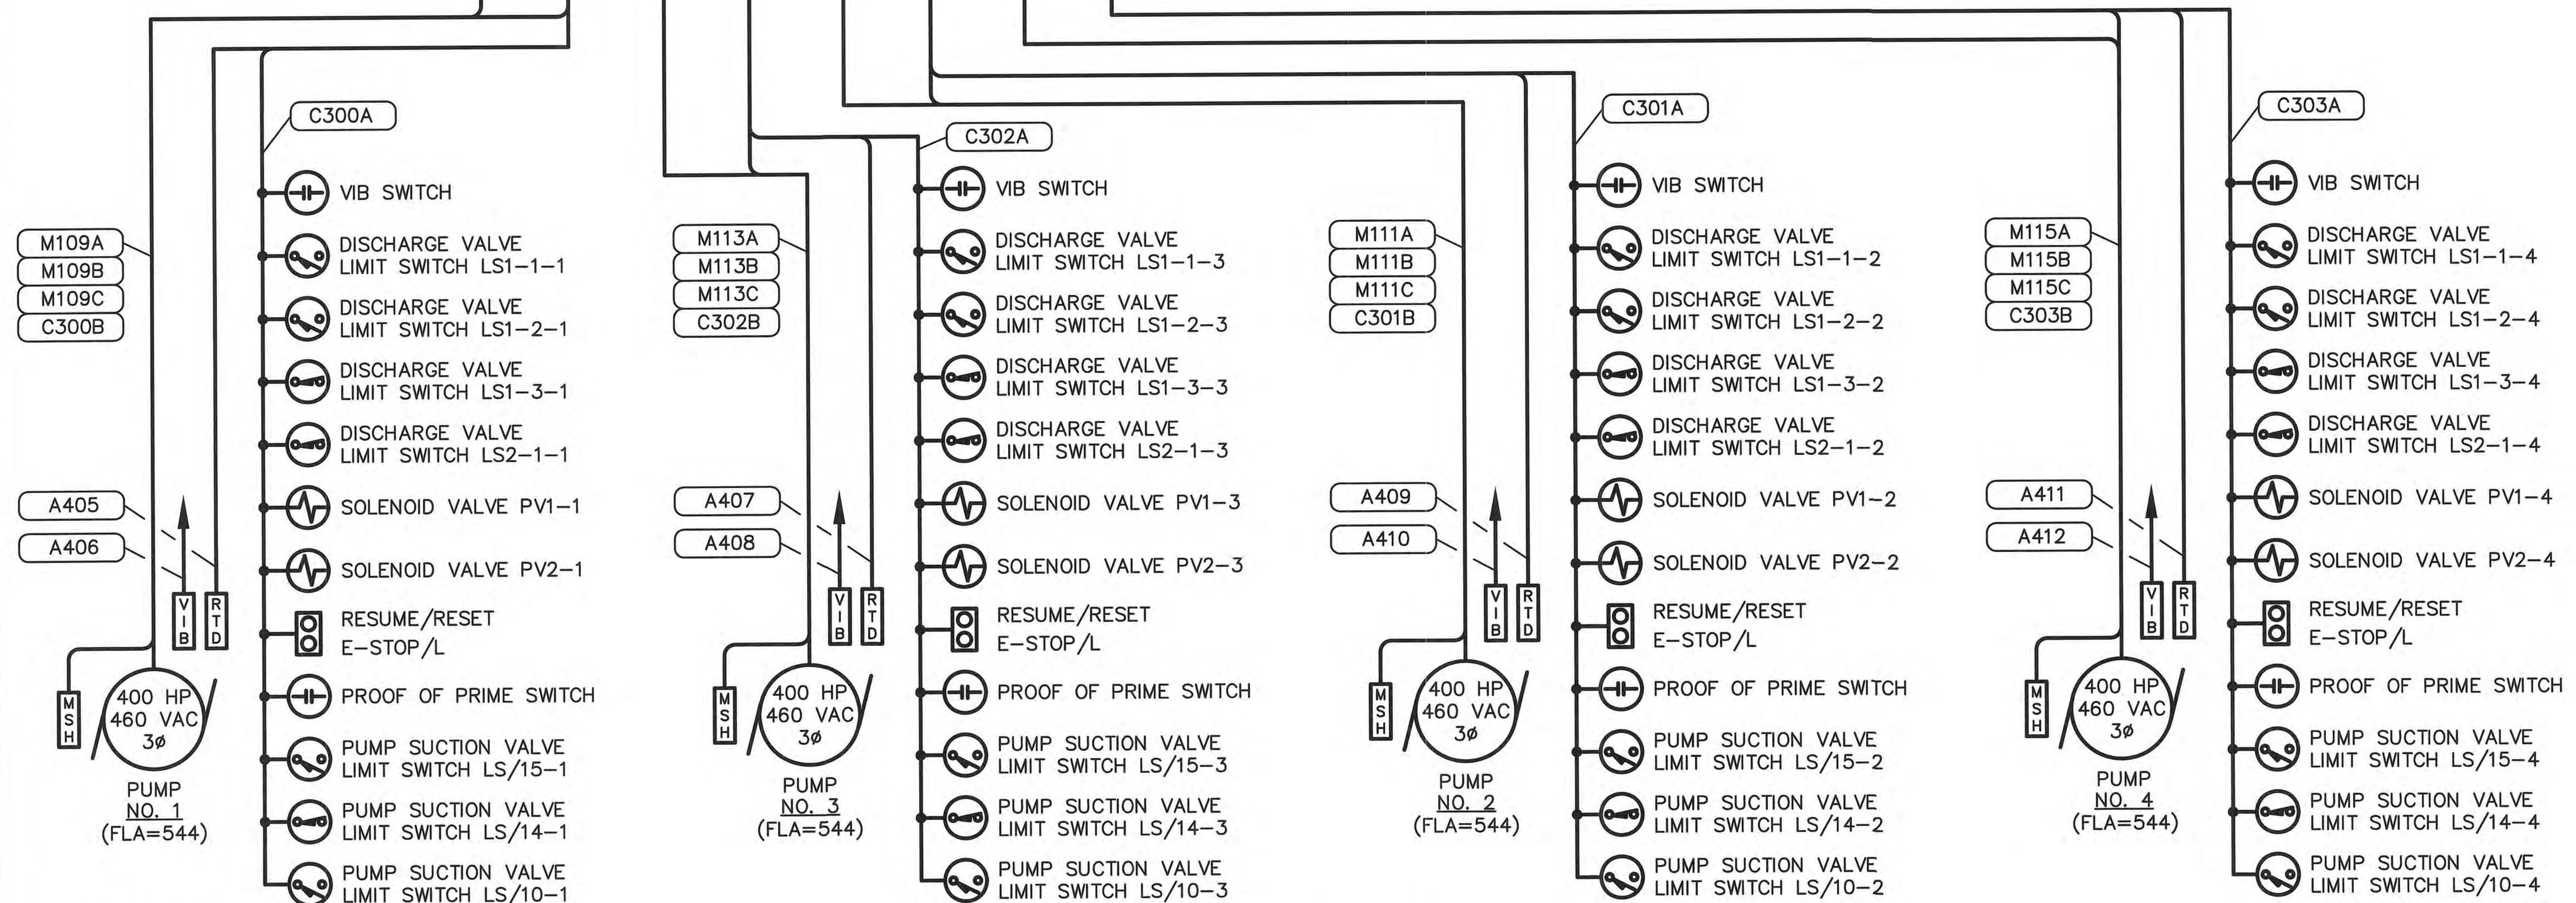**ELECTRICAL ONE-LINE DIAGRAM**ENGINEER OF RECORD:
BOB E. HALLMAN, P.E.
FLORIDA REGISTRATION NO. 20761

**Engineering Design
Technologies Corp.**
P.O. Box 152403
Tampa, FL 33684-2403
813.289.8080
813.282.9184 FAX
engineering@edt1.com

CITY of TAMPA
WASTEWATER DEPARTMENT

KRAUSE PS REHABILITATION
SWITCHBOARD-KPS
ELECTRICAL ONE-LINE DIAGRAM
(SHEET 2 OF 2)


DRAWN: RWB
DESIGN: STK
QC: BEH
DATE: 05/01/14

SHEET E-16

Certificate of Authorization Number: 4795

NO.	DATE	REVISIONS

B080-078

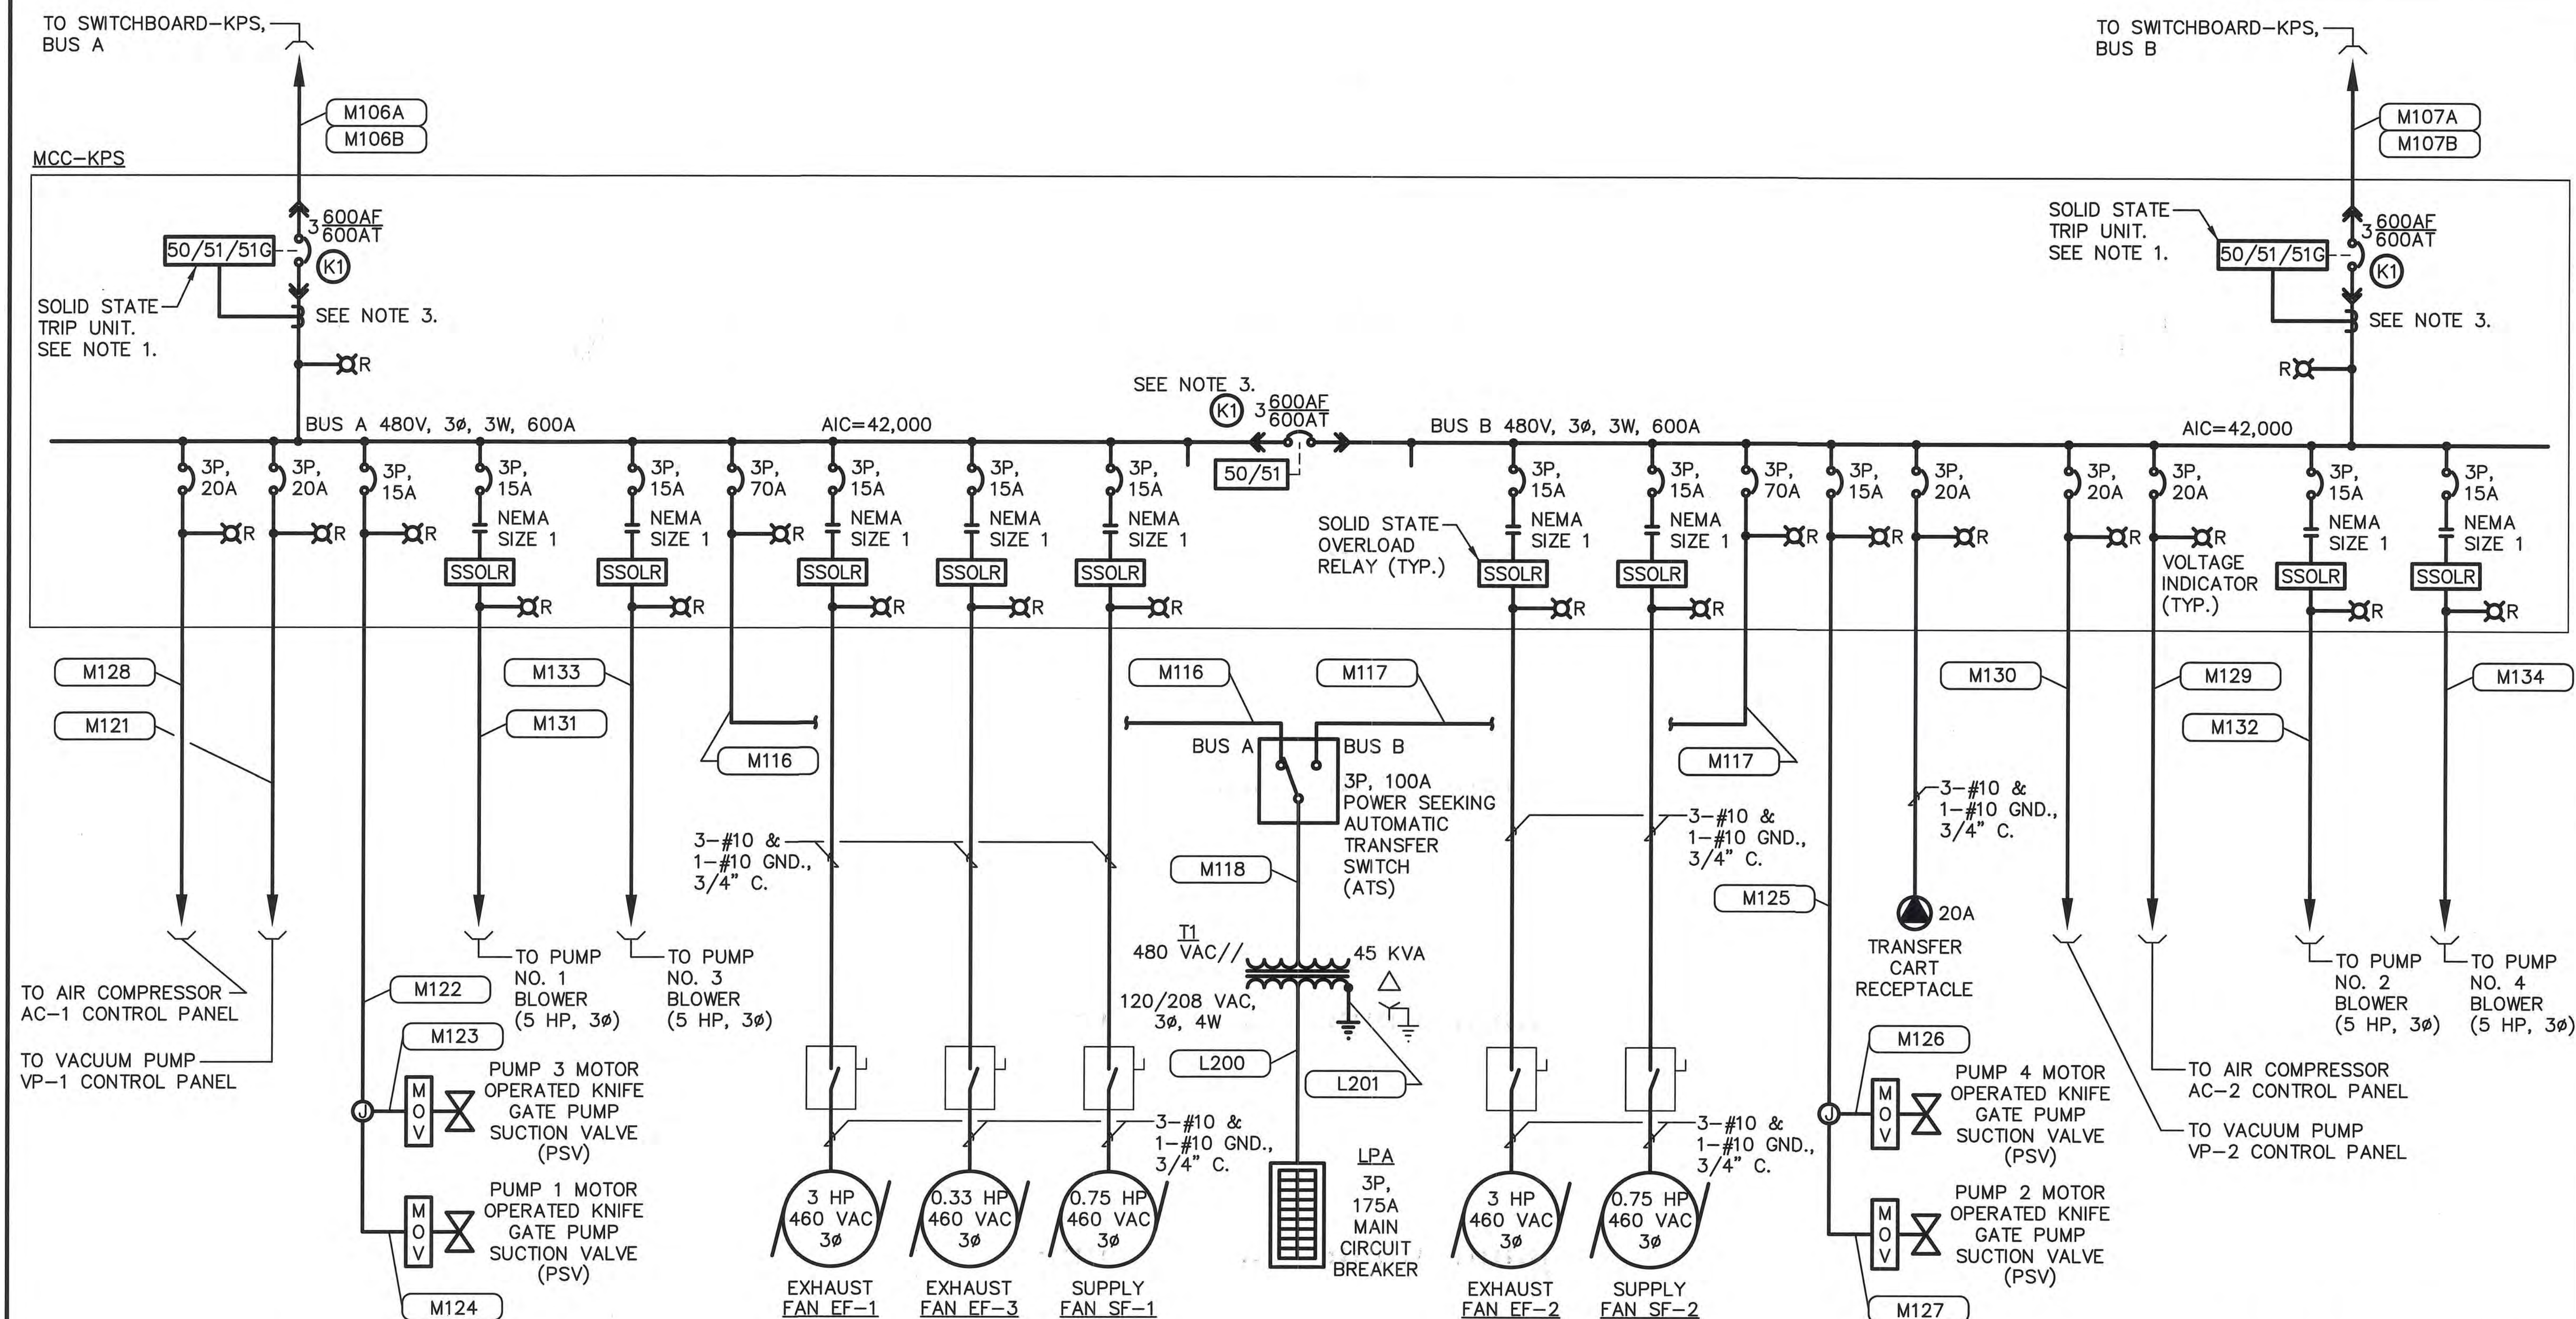

ENGINEER OF RECORD:
BOB E. HALLMAN, P.E.
FLORIDA REGISTRATION NO. 20761

MCC-KPS ELECTRICAL ONE-LINE DIAGRAM

SEE NOTES ON SHEET E-18



**Engineering Design
Technologies Corp.**
P.O. Box 152403
Tampa, FL 33684-2403
813.289.8080
813.282.9184 FAX
engineering@edt1.com

CITY of TAMPA
WASTEWATER DEPARTMENT

KRAUSE PS REHABILITATION

MCC-KPS ELECTRICAL ONE-LINE DIAGRAM (SHEET 1 OF 2)

					DRAWN: RWB
					DESIGN: STK
					QC: BEH
					DATE: 06/03/14
NO.	DATE	REVISIONS			SHEET E-17

SHEET E-17

MCC-KPS LOAD SUMMARY

277/480 VAC, 3ø, 4W

LOAD	BUS A CONNECTED	BUS A DEMAND	BUS B CONNECTED	BUS B DEMAND	TOTAL DEMAND
TRANSFORMER T1	45.0 KVA	31.7 KVA	45.0 KVA	---- KVA	31.7 KVA
AIR COMPRESSOR AC-1 CONTROL PANEL	6.1 KVA	6.1 KVA	---- KVA	---- KVA	6.1 KVA
AIR COMPRESSOR AC-2 CONTROL PANEL	---- KVA	---- KVA	6.1 KVA	6.1 KVA	6.1 KVA
VACUUM PUMP VP-1 CONTROL PANEL	1.5 KVA	1.5 KVA	---- KVA	---- KVA	1.5 KVA
VACUUM PUMP VP-2 CONTROL PANEL	---- KVA	---- KVA	1.5 KVA	1.5 KVA	1.5 KVA
PUMP 3 & PUMP 1 MOTOR OPERATED KNIFE GATE PUMP SUCTION VALVE (PSV)	1.5 KVA	1.5 KVA	---- KVA	---- KVA	1.5 KVA
PUMP 4 & PUMP 2 MOTOR OPERATED KNIFE GATE PUMP SUCTION VALVE (PSV)	---- KVA	---- KVA	1.5 KVA	1.5 KVA	1.5 KVA
EXHAUST FAN EF-1	3.8 KVA	3.8 KVA	---- KVA	---- KVA	3.8 KVA
EXHAUST FAN EF-2	---- KVA	---- KVA	3.8 KVA	3.8 KVA	3.8 KVA
EXHAUST FAN EF-3	1.5 KVA	1.5 KVA	---- KVA	---- KVA	1.5 KVA
SUPPLY FAN SF-1	1.5 KVA	1.5 KVA	---- KVA	---- KVA	1.5 KVA
SUPPLY FAN SF-2	---- KVA	---- KVA	1.5 KVA	1.5 KVA	1.5 KVA
PUMP NO. 1 BLOWER	6.1 KVA	6.1 KVA	---- KVA	---- KVA	6.1 KVA
PUMP NO. 2 BLOWER	---- KVA	---- KVA	6.1 KVA	6.1 KVA	6.1 KVA
PUMP NO. 3 BLOWER	6.1 KVA	6.1 KVA	---- KVA	---- KVA	6.1 KVA
PUMP NO. 4 BLOWER	---- KVA	---- KVA	6.1 KVA	---- KVA	---- KVA
TRANSFER CART RECEPTACLE	---- KVA	---- KVA	12.8 KVA	12.8 KVA	12.8 KVA
TOTAL	73.1 KVA	59.8 KVA	84.4 KVA	33.3 KVA	93.1 KVA


NOTES:

1. THE SOLID STATE TRIP UNIT SHALL PROVIDE THE FOLLOWING CURRENT SENSING & TRIP FUNCTIONS:
- LONG TIME PICK-UP & DELAY
- SHORT TIME PICK-UP & DELAY
- INSTANTANEOUS PICK-UP
- GROUND FAULT PICK-UP & DELAY
2. CUSTOMER METERING SHALL PROVIDE AS A MINIMUM THE READINGS FOR:
- VOLTAGE (V)
- AMPERAGE (A)
- POWER FACTOR (PF)
- KILOWATT USAGE (KW)
- KILOWATT DEMAND (KWD)
- WATTS (W)
- VARs (VR)
- VAR DEMAND (VRD)
- VAR HOURS (VRH)
- FREQUENCY (FRQ)
- THD CURRENT (THC)
- THD VOLTAGE (THV)
3. CONTRACTOR SHALL INSTALL KIRK KEY INTERLOCKS ON THE TWO (2) MAIN CIRCUIT BREAKERS AND ON THE TIE BREAKER IN MCC-KPS. THE KIRK KEY INTERLOCKS SHOWN AS K1 ON THE MAIN CIRCUIT BREAKERS SHALL BE KEYED THE SAME AS THE KIRK KEY INTERLOCK ON THE TIE BREAKER. EACH KIRK KEY LOCK SHALL BE CONFIGURED IN A L-O-R LOCKING POSITION (DEVICE LOCKED OPEN WITH KEY REMOVED) PROVIDE (2) KEYS ONLY.

ENGINEER OF RECORD:
BOB E. HALLMAN, P.E.
FLORIDA REGISTRATION NO. 20761



- ## NOTES:
1. REFERENCE OVERHEAD CONDUIT SECURING DETAIL.
 2. AFTER CORE DRILLING HOLES THROUGH REINFORCED CONCRETE WALLS AND FLOORS, COAT EXPOSED REINFORCING STEEL CONCRETE SURFACES WITH EMACO P24 BY BASF. AFTER ROUTING CONDUIT THROUGH HOLE, FILL AND FINISH CONCRETE WITH A SHRINKAGE COMPENSATING REPAIR MORTAR WITH CORROSION INHIBITING PROPERTIES, EMACO S66 C1 BY BASF. REFERENCE STRUCTURAL DRAWINGS.
 3. CONDUITS SHALL BE ROUTED IN LOWER LEVEL VOID BENEATH THE SWITCHBOARD PRIOR TO AREA BEING FILLED WITH CONCRETE.

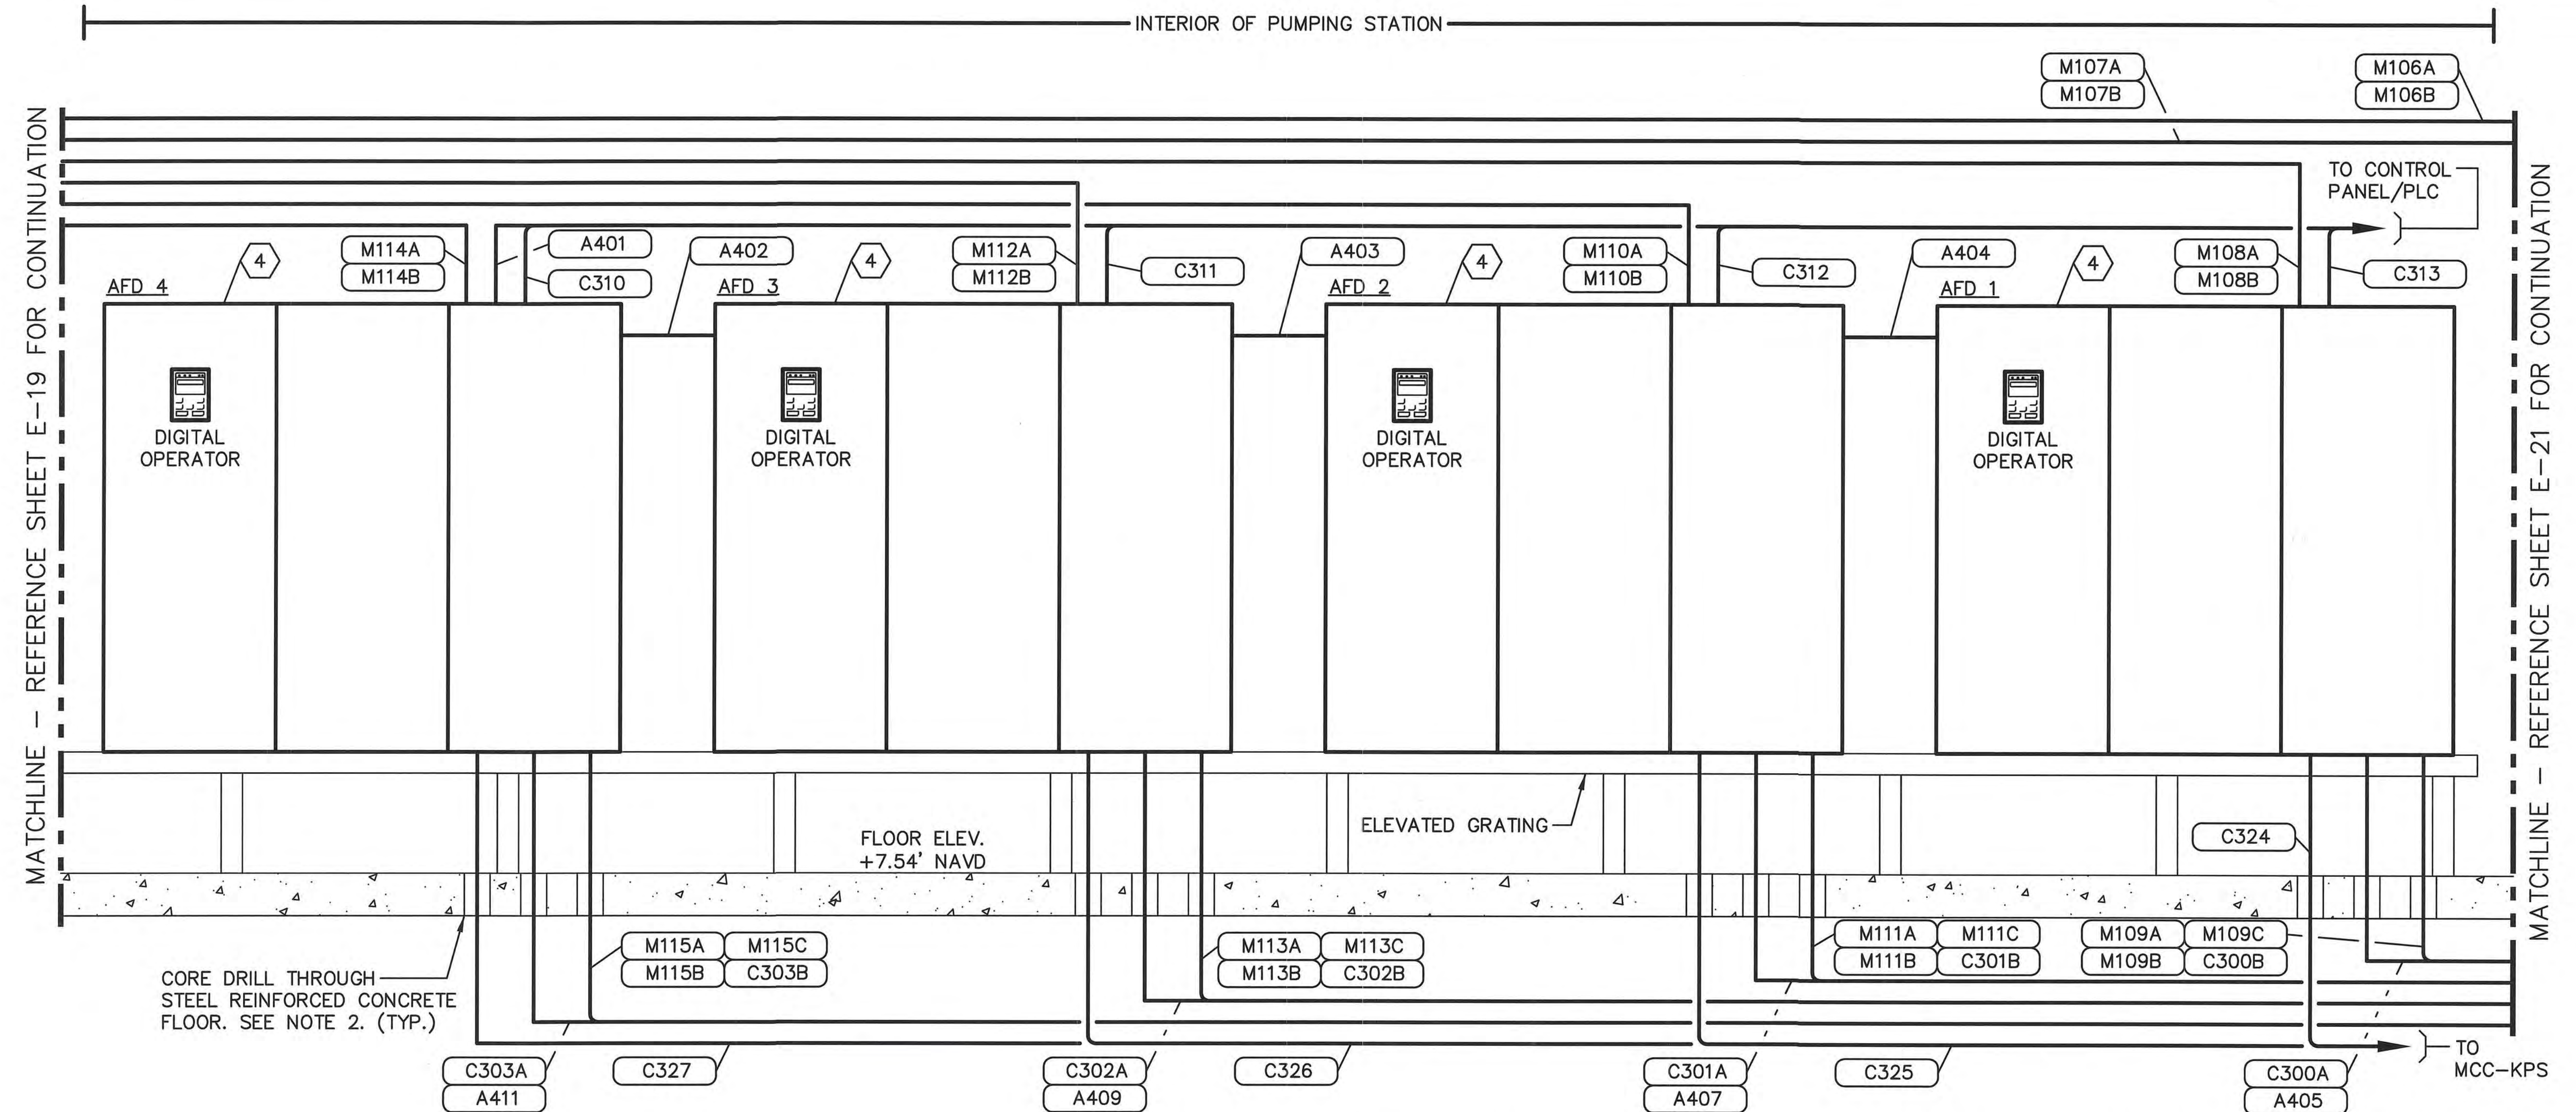

NOTES:

- REFERENCE OVERHEAD CONDUIT SECURING DETAIL.
- AFTER CORE DRILLING HOLES THROUGH REINFORCED CONCRETE WALLS AND FLOORS, COAT EXPOSED REINFORCING STEEL CONCRETE SURFACES WITH EMACO P24 BY BASF. AFTER ROUTING CONDUIT THROUGH HOLE, FILL AND FINISH CONCRETE WITH A SHRINKAGE COMPENSATING REPAIR MORTAR WITH CORROSION INHIBITING PROPERTIES, EMACO S66 C1 BY BASF. REFERENCE STRUCTURAL DRAWINGS.

ENGINEER OF RECORD:
BOB E. HALLMAN, P.E.
FLORIDA REGISTRATION NO. 20761



**Engineering Design
Technologies Corp.**
P.O. Box 152403
Tampa, FL 33684-2403
813.289.8080
813.282.9184 FAX
engineering@edt1.com

CITY of TAMPA
WASTEWATER DEPARTMENT

KRAUSE PS REHABILITATION

ELECTRICAL RISER DIAGRAM
(SHEET 2 OF 4)

NO.	DATE	REVISIONS


DRAWN: RWB
DESIGN: STK
QC: BEH
DATE: 05/01/14

SHEET E-20

NOTES:

1. REFERENCE OVERHEAD CONDUIT SECURING DETAIL.
2. AFTER CORE DRILLING HOLES THROUGH REINFORCED CONCRETE WALLS AND FLOORS, COAT EXPOSED REINFORCING STEEL CONCRETE SURFACES WITH EMACO P24 BY BASF. AFTER ROUTING CONDUIT THROUGH HOLE, FILL AND FINISH CONCRETE WITH A SHRINKAGE COMPENSATING REPAIR MORTAR WITH CORROSION INHIBITING PROPERTIES, EMACO S66 C1 BY BASF. REFERENCE STRUCTURAL DRAWINGS.
3. REFERENCE PUMP/MOTOR CONNECTION DETAIL ON SHEET E-40.

SEE KEYED NOTES ON SHEET E-23

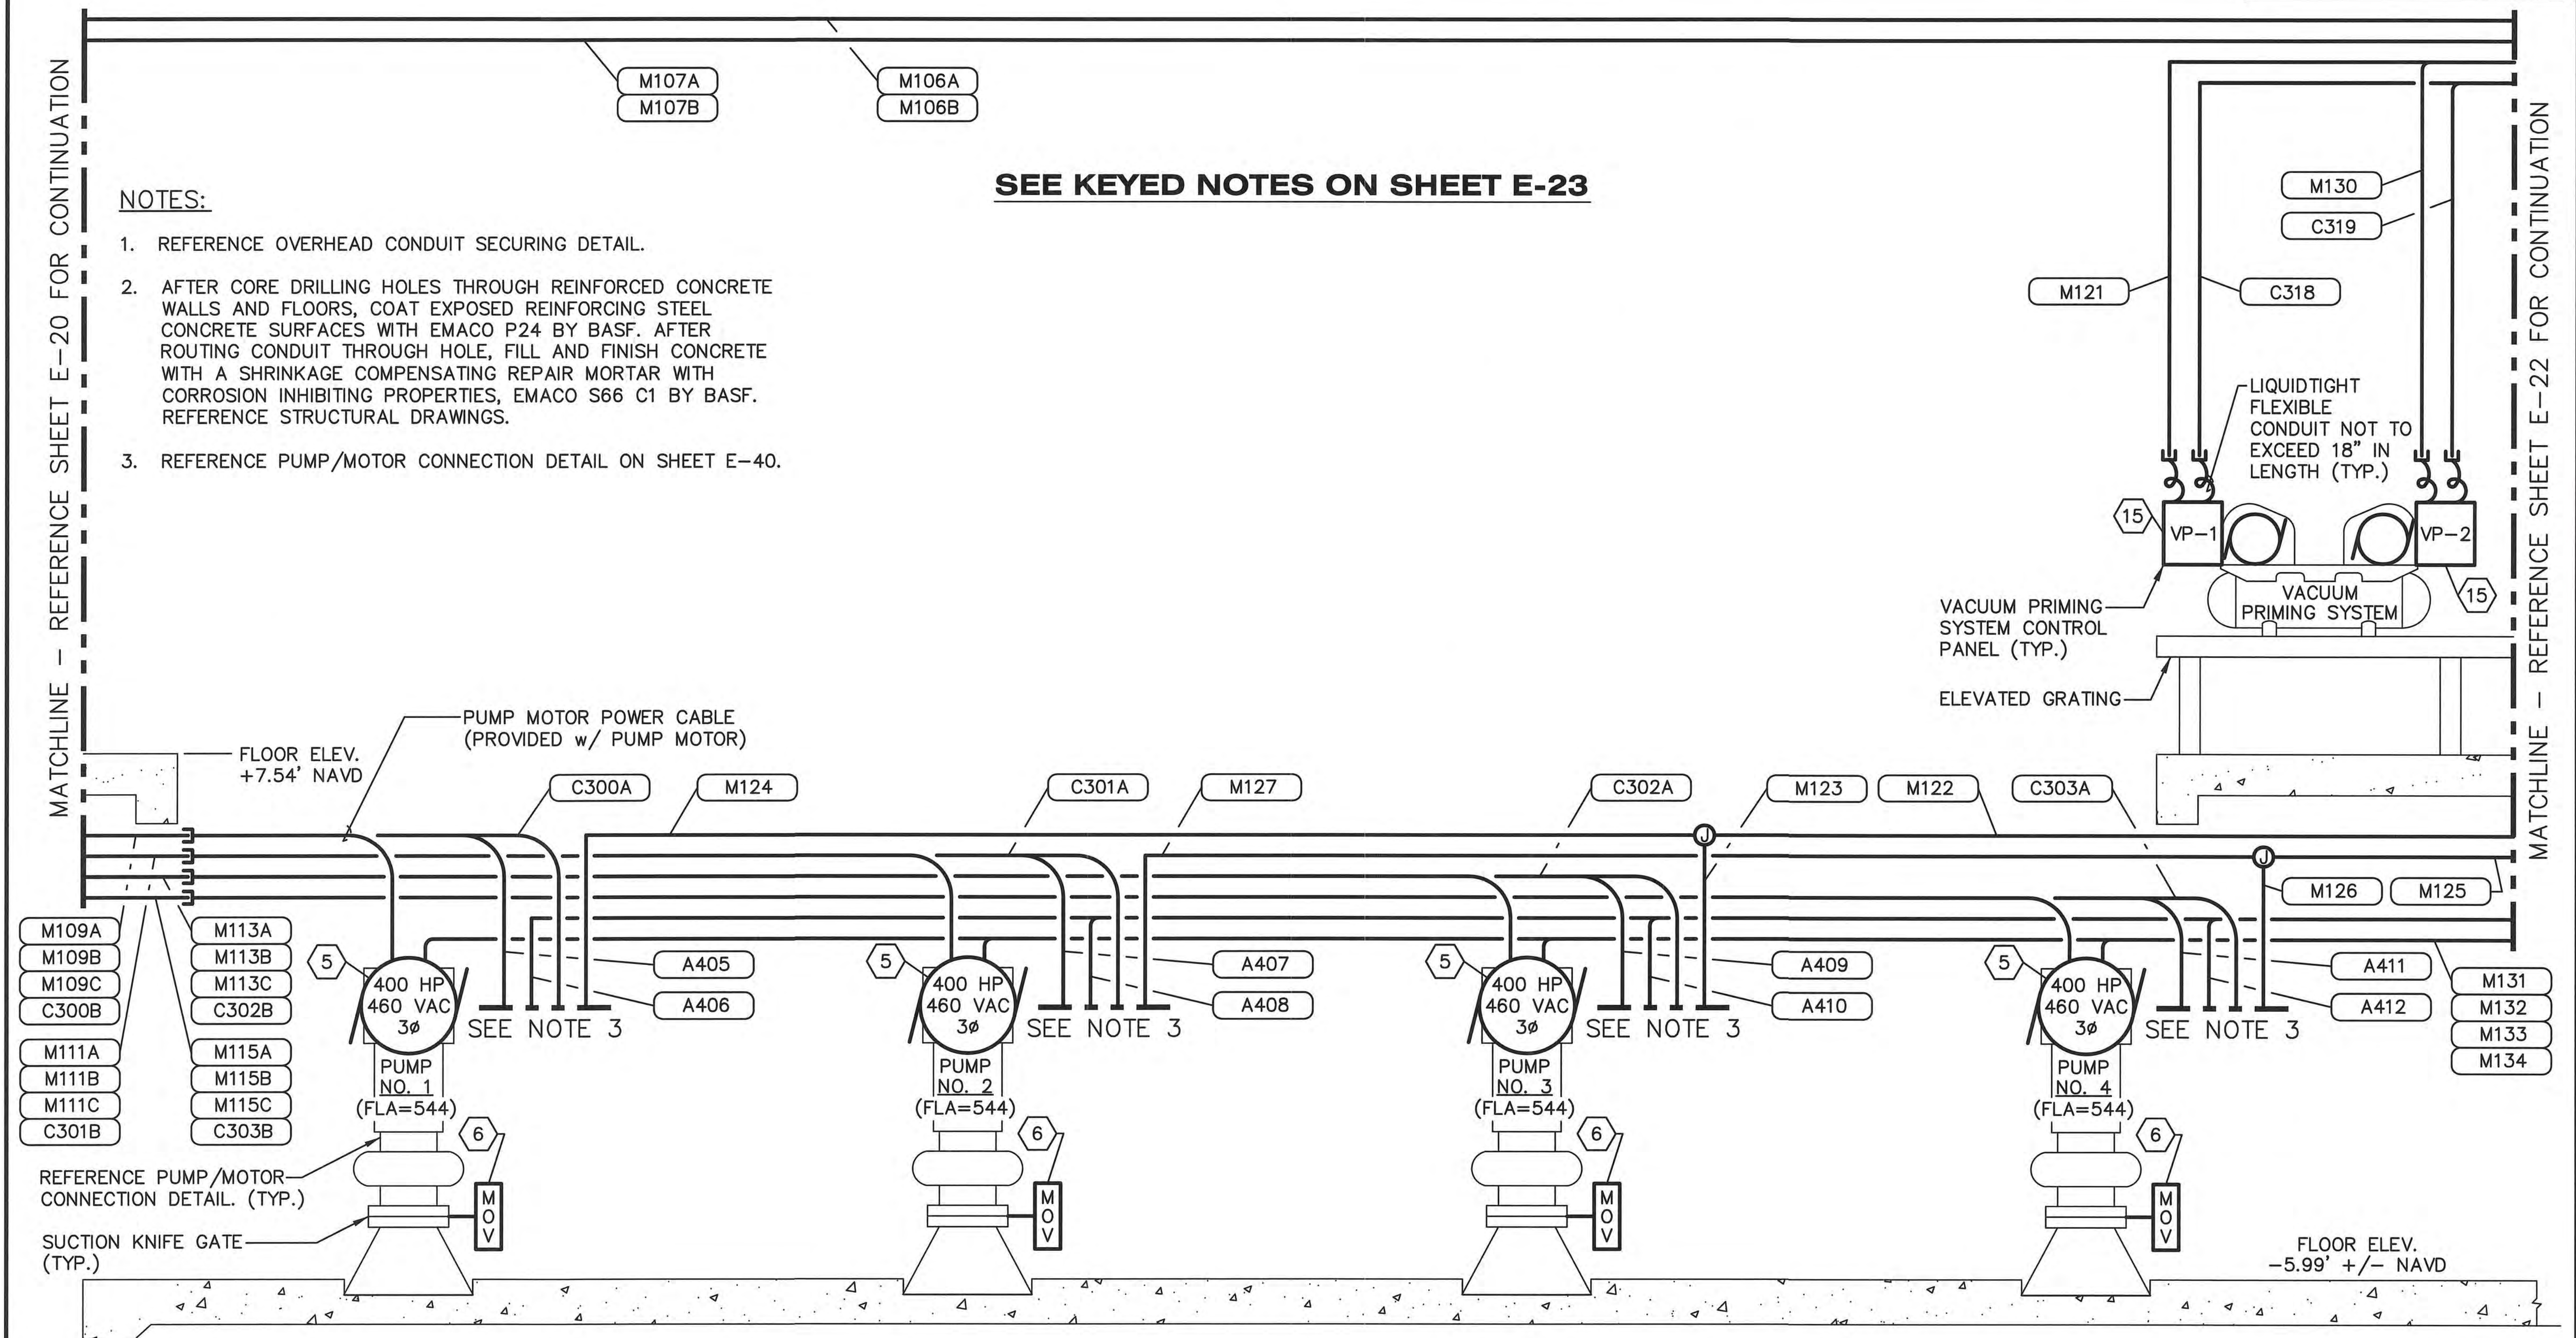

ENGINEER OF RECORD:
BOB E. HALLMAN, P.E.
FLORIDA REGISTRATION NO. 20761

ELECTRICAL RISER DIAGRAM



Engineering Design
Technologies Corp.
P.O. Box 152403
Tampa, FL 33684-2403
813.289.8080
813.282.9184 FAX
engineering@edt1.com

CITY of TAMPA
WASTEWATER DEPARTMENT


KRAUSE PS REHABILITATION

ELECTRICAL RISER DIAGRAM
(SHEET 3 OF 4)

NO.	DATE	REVISIONS

DRAWN: RWB
DESIGN: STK
QC: BEH
DATE: 05/01/14

SHEET E-21

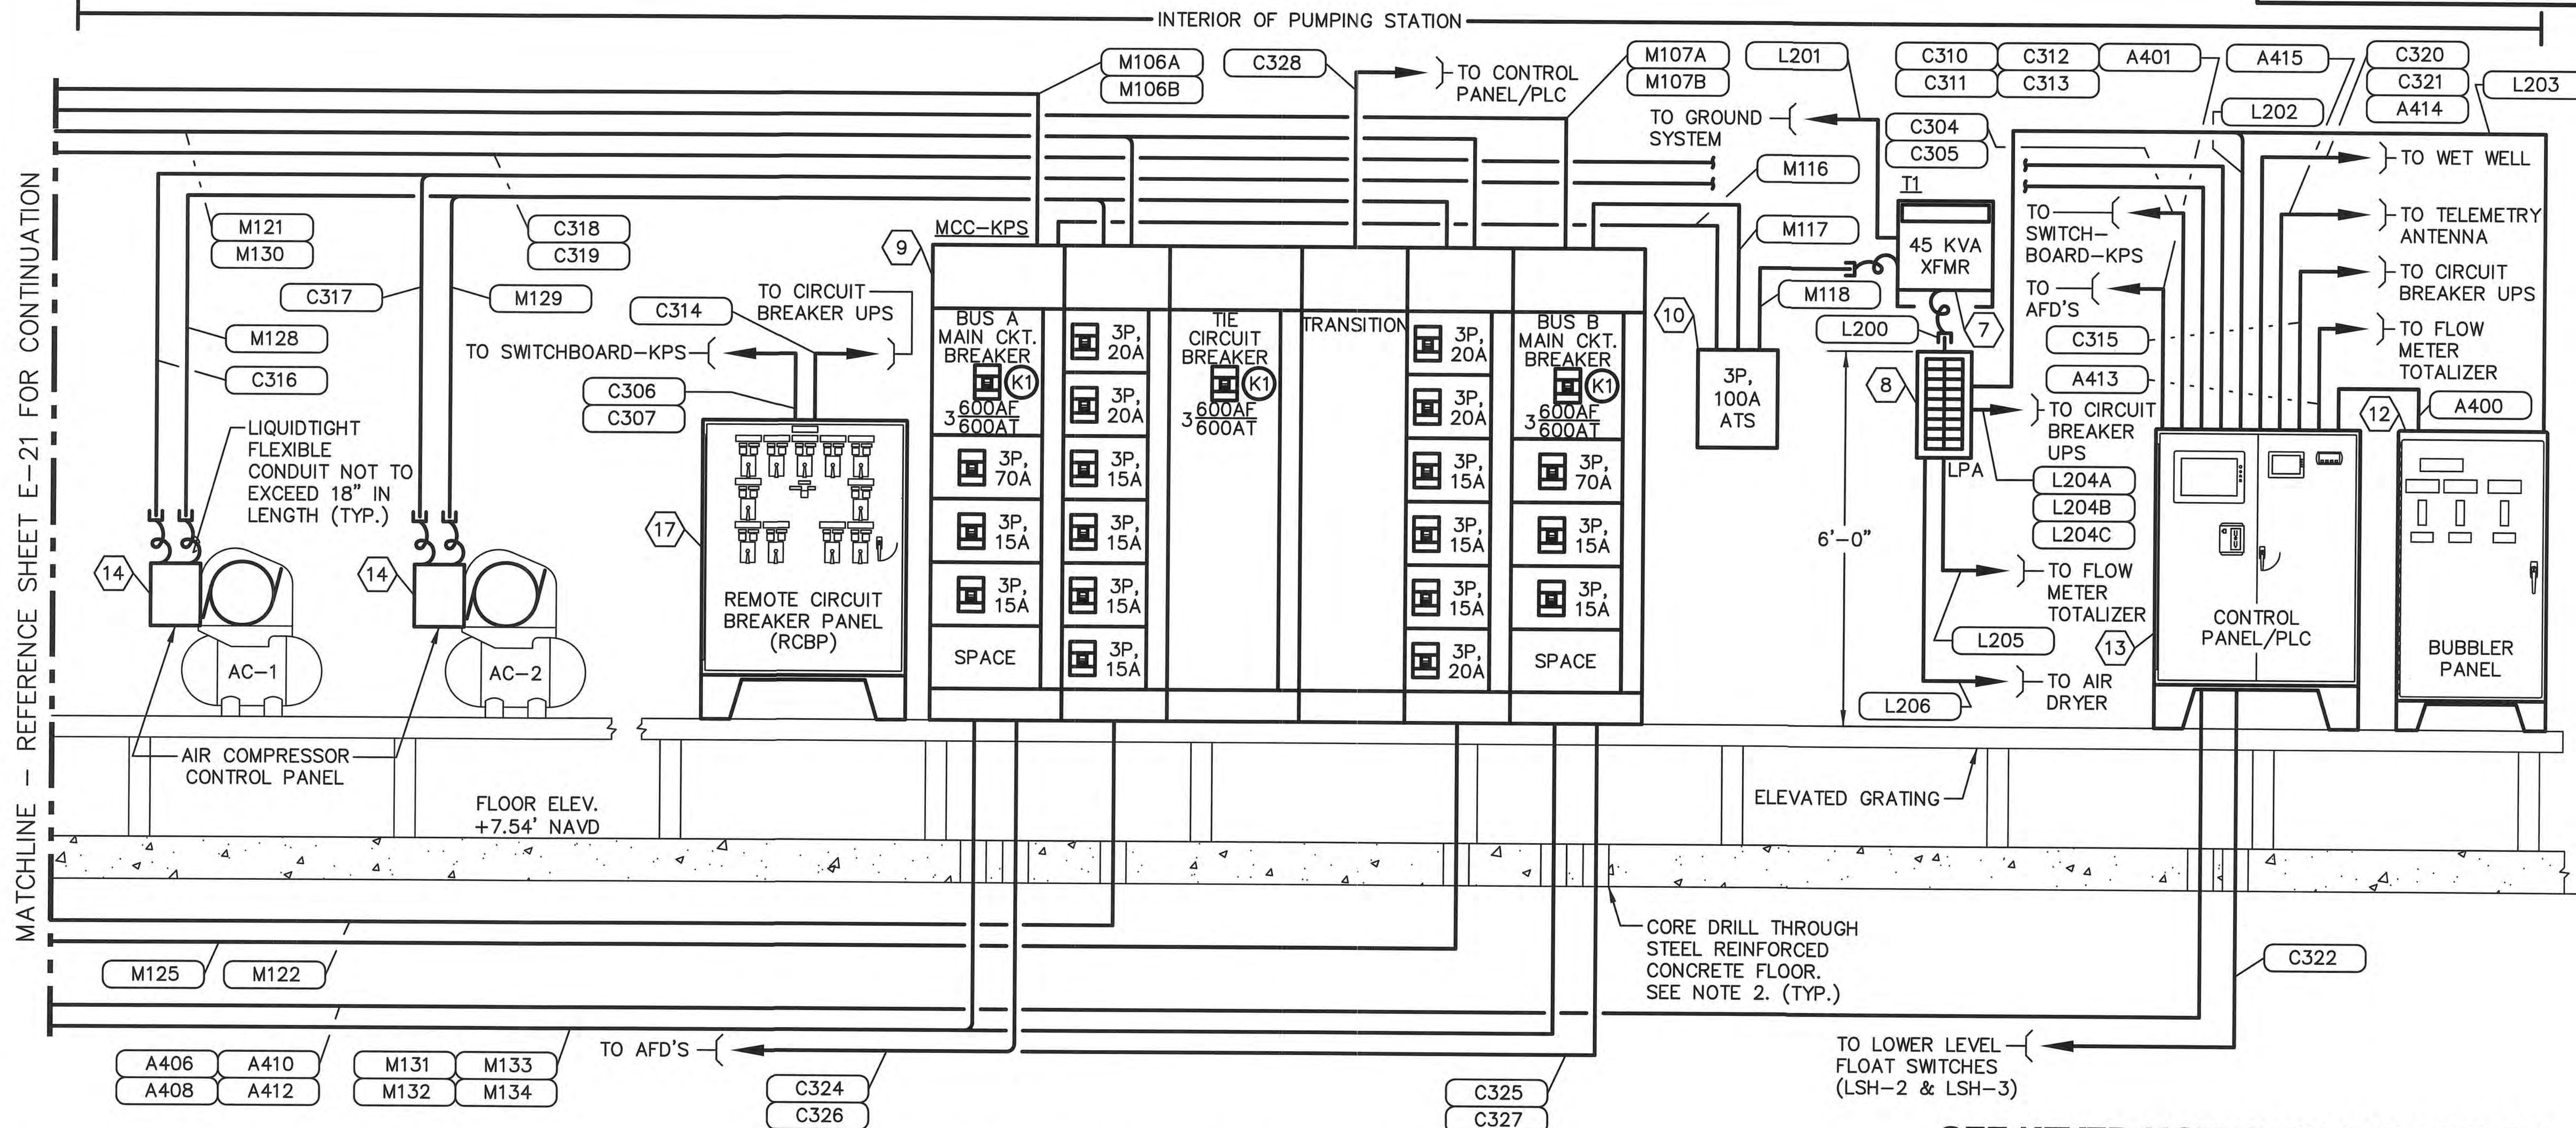

KEYED NOTES:

- 1
- TRANSFORMER RATED METER SOCKET PROVIDED & INSTALLED BY CONTRACTOR. CENTER METER 4'-6" ABOVE TOP OF PLATFORM. COORD. REQUIREMENTS WITH TEC.
- 2
- GROUND SYSTEM – MIN. (3) 3/4" DIA. x 10'-0" STAINLESS STEEL GND. RODS, MIN. 10'-0" APART, MIN. 10'-0" LENGTH STEEL PIPING (ATTACH w/ GROUNDING CLAMPS) & GROUNDING ELECTRODE AT THE BOTTOM OF CONCRETE UTILITY TRANSFORMER PLATFORM (ATTACH w/ EXOTHERMIC WELD). BOND TO EXISTING SERVICE GROUND SYSTEM w/ #4/0 BARE COPPER GROUND CONDUCTOR (ATTACH w/ EXOTHERMIC WELD). REFERENCE GROUND WELL DETAIL.
- 3
- SWITCHBOARD–KPS w/ 2500AF/2500AT 100% RATED MAIN CIRCUIT BREAKERS, 100% RATED TIE CIRCUIT BREAKER, AUTO THROVOVER SYSTEM AND DISTRIBUTION SECTIONS. REFERENCE SPECIFICATIONS.
- 4
- YASKAWA 500 HP, 590 FLA, 12–PULSE ADJUSTABLE FREQUENCY DRIVE (AFD) w/ OUTPUT REACTOR, DIGITAL OPERATOR & INTEGRAL DISCONNECT. REFERENCE SPECIFICATIONS.
- 5
- IMMERSIBLE PUMP MOTOR: 400 HP, 460 VAC, 3ø, 544 FLA. PUMP MOTOR SHALL INCLUDE A MOTOR SPACE HEATER (MSH), RESISTANCE TEMPERATURE DETECTORS (RTD) AND VIBRATION SENSORS. REFERENCE PUMP/MOTOR CONNECTION DETAIL.
- 6
- MOTOR OPERATED VALVE (MOV): 3ø, 460 VAC, LIMITORQUE MX20 SERIES. REFERENCE MECHANICAL DRAWINGS FOR ADDITIONAL DETAILS. COORDINATE ADDITIONAL REQUIREMENTS w/ VALVE SUPPLIER.
- 7
- TRANSFORMER T1: 480 VAC PRIMARY, 120/208 VAC SECONDARY, 3ø, 60 HZ, 80 DEG. C RISE, 45 KVA TRANSFORMER w/ WALL MOUNT BRACKET & COPPER WINDINGS. SQUARE D CAT. NO. EE45T3HBCU (XFMR) & WMB363364 (WALL MOUNT BRACKET). REFERENCE TRANSFORMER NEUTRAL GROUNDING DETAIL.
- 8
- PANELBOARD LPA: 120/208 VAC, 3ø, 4W, 225A, 20" WIDE, 42 CIRCUIT PANELBOARD w/ 3P, 175A MAIN CIRCUIT BREAKER, COPPER BUS & GROUND BAR KIT MOUNTED IN A NEMA 1 ENCLOSURE. SQUARE D CAT. NO. NQ442L2C (INTERIOR), NQMB2HJ (MAIN BREAKER ADAPTER KIT), MH50 (ENCLOSURE), NC50SHR (HINGED FRONT). PROVIDE 3P, 175A JDL36175 FACTORY INSTALLED MAIN CIRCUIT BREAKER. MOUNT TOP OF ENCLOSURE 6'-0" ABOVE ELEVATED GRATING. PROVIDE BOLT–ON CIRCUIT BREAKERS PER PANELBOARD SCHEDULE.
- 9
- MOTOR CONTROL CENTER (MCC–KPS) w/ 600AF/600AT 100% RATED MAIN CIRCUIT BREAKERS, 100% RATED TIE CIRCUIT BREAKER & KIRK KEY INTERLOCKS. REFERENCE SPECIFICATIONS.
- 10
- 3P, 100A POWER SEEKING AUTOMATIC TRANSFER SWITCH (ATS) w/ AUXILIARY CONTACTS, TIME DELAYS & PILOT LIGHTS MOUNTED IN A NEMA 3R ENCLOSURE. MOUNT TOP OF ENCLOSURE 6'-0" ABOVE ELEVATED GRATING. REFERENCE SPECIFICATIONS.
- 11
- VISUAL ALARM STROBE, UL LISTED, 120 VAC, SINGLE FLASH STROBE w/ ANODIZED ALUMINUM BASE AND RED POLYCARBONATE FRESNEL LENS. FEDERAL SIGNAL MODEL 131ST. MOUNT 9'-0" ABOVE FINISHED GRADE.

PROVIDE SIGN ON WALL BELOW VISUAL ALARM. SIGN SHALL BE THREE PLY PHENOLIC RED–WHITE–RED ENGRAVED THROUGH THE FIRST RED LAYER. LETTERING SHALL BE 1/2" MIN. EDGES OF SIGN SHALL BE BEVELED 45 DEG. SIGN SHALL READ AS FOLLOWS: "COMBUSTIBLE GAS WARNING – COMBUSTIBLE GAS IS PRESENT IN BUILDING WHEN LIGHT IS FLASHING – DO NOT ENTER BUILDING –".
- 12
- WET WELL BUBBLER PANEL: FREE STANDING TYPE 12 ENCLOSURE. REFERENCE BUBBLER PANEL DETAILS.
- 13
- CONTROL PANEL/PLC: MINIMUM 72" x 72" x 16" NEMA 12 ENCLOSURE. CONTROL PANEL ENCLOSURE TO CONTAIN CONTROL COMPONENTS, HMI SCREEN & PROGRAMMABLE LOGIC CONTROLLER (PLC). REFERENCE SPECIFICATIONS.

- 14
- AIR COMPRESSOR CONTROL PANEL. CONTROL PANEL SHALL BE SHOCK MOUNTED AND SHALL CONTAIN 480V/120V CONTROL TRANSFORMER, MOTOR CIRCUIT PROTECTORS (MCP), MOTOR STARTERS, PRESSURE CONTROL, THERMAL OVERLOAD ELEMENTS & COMPRESSOR/MOTOR SAFETY SHUTDOWNS FOR EACH COMPRESSOR. ALL WIRING, CONDUITS, WIRING CONNECTIONS & END DEVICES ASSOCIATED WITH THE AIR COMPRESSOR SYSTEM SHALL BE PROVIDED & INSTALLED BY THE AIR COMPRESSOR SYSTEM SUPPLIER. COORDINATE ADDITIONAL REQUIREMENTS w/ AIR COMPRESSOR SYSTEM SUPPLIER. A DUPLEX CONTROLLER/ALTERNATOR SHALL BE PROVIDED TO ALTERNATE BETWEEN THE TWO (2) COMPRESSORS AND ASSOCIATED CONTROLS.
- 15
- VACUUM PUMP CONTROL PANEL. CONTROL PANEL SHALL BE SHOCK MOUNTED AND SHALL CONTAIN 480V/120V CONTROL TRANSFORMER, MOTOR CIRCUIT PROTECTORS (MCP), MOTOR STARTERS, THERMAL OVERLOAD ELEMENTS & SAFETY SHUTDOWNS FOR VACUUM PUMP. ALL WIRING, CONDUITS, WIRING CONNECTIONS & END DEVICES ASSOCIATED WITH THE VACUUM PUMP SYSTEM SHALL BE PROVIDED & INSTALLED BY THE SYSTEM SUPPLIER. COORDINATE ADDITIONAL REQUIREMENTS w/ SYSTEM SUPPLIER. A DUPLEX CONTROLLER/ALTERNATOR SHALL BE PROVIDED TO ALTERNATE BETWEEN THE TWO (2) VACUUM PUMPS AND ASSOCIATED CONTROLS.
- 16
- WET WELL GAS DETECTOR: DET–TRONICS PIR9400 GAS SENSOR & TERMINATION BOX.
- 17
- REMOTE CIRCUIT BREAKER CONTROL PANEL (RCBP). REFERENCE REMOTE CIRCUIT BREAKER PANEL DETAILS.
- 18
- SURGE PROTECTIVE DEVICE (SPD): 277/480 VAC, 3ø, 4W. ADVANCED PROTECTION TECHNOLOGIES CAT. NO. TE04XDS204XA, OR EQUAL.

ENGINEER OF RECORD:
BOB E. HALLMAN, P.E.
FLORIDA REGISTRATION NO. 20761



Engineering Design
Technologies Corp.
P.O. Box 152403
Tampa, FL 33684-2403
813.289.8080
813.282.9184 FAX
engineering@edt1.com

CITY of TAMPA
WASTEWATER DEPARTMENT



KRAUSE PS REHABILITATION

KEYED NOTES

NO.	DATE	REVISIONS

DRAWN: RWB
DESIGN: STK
QC: BEH
DATE: 05/01/14

B080-085

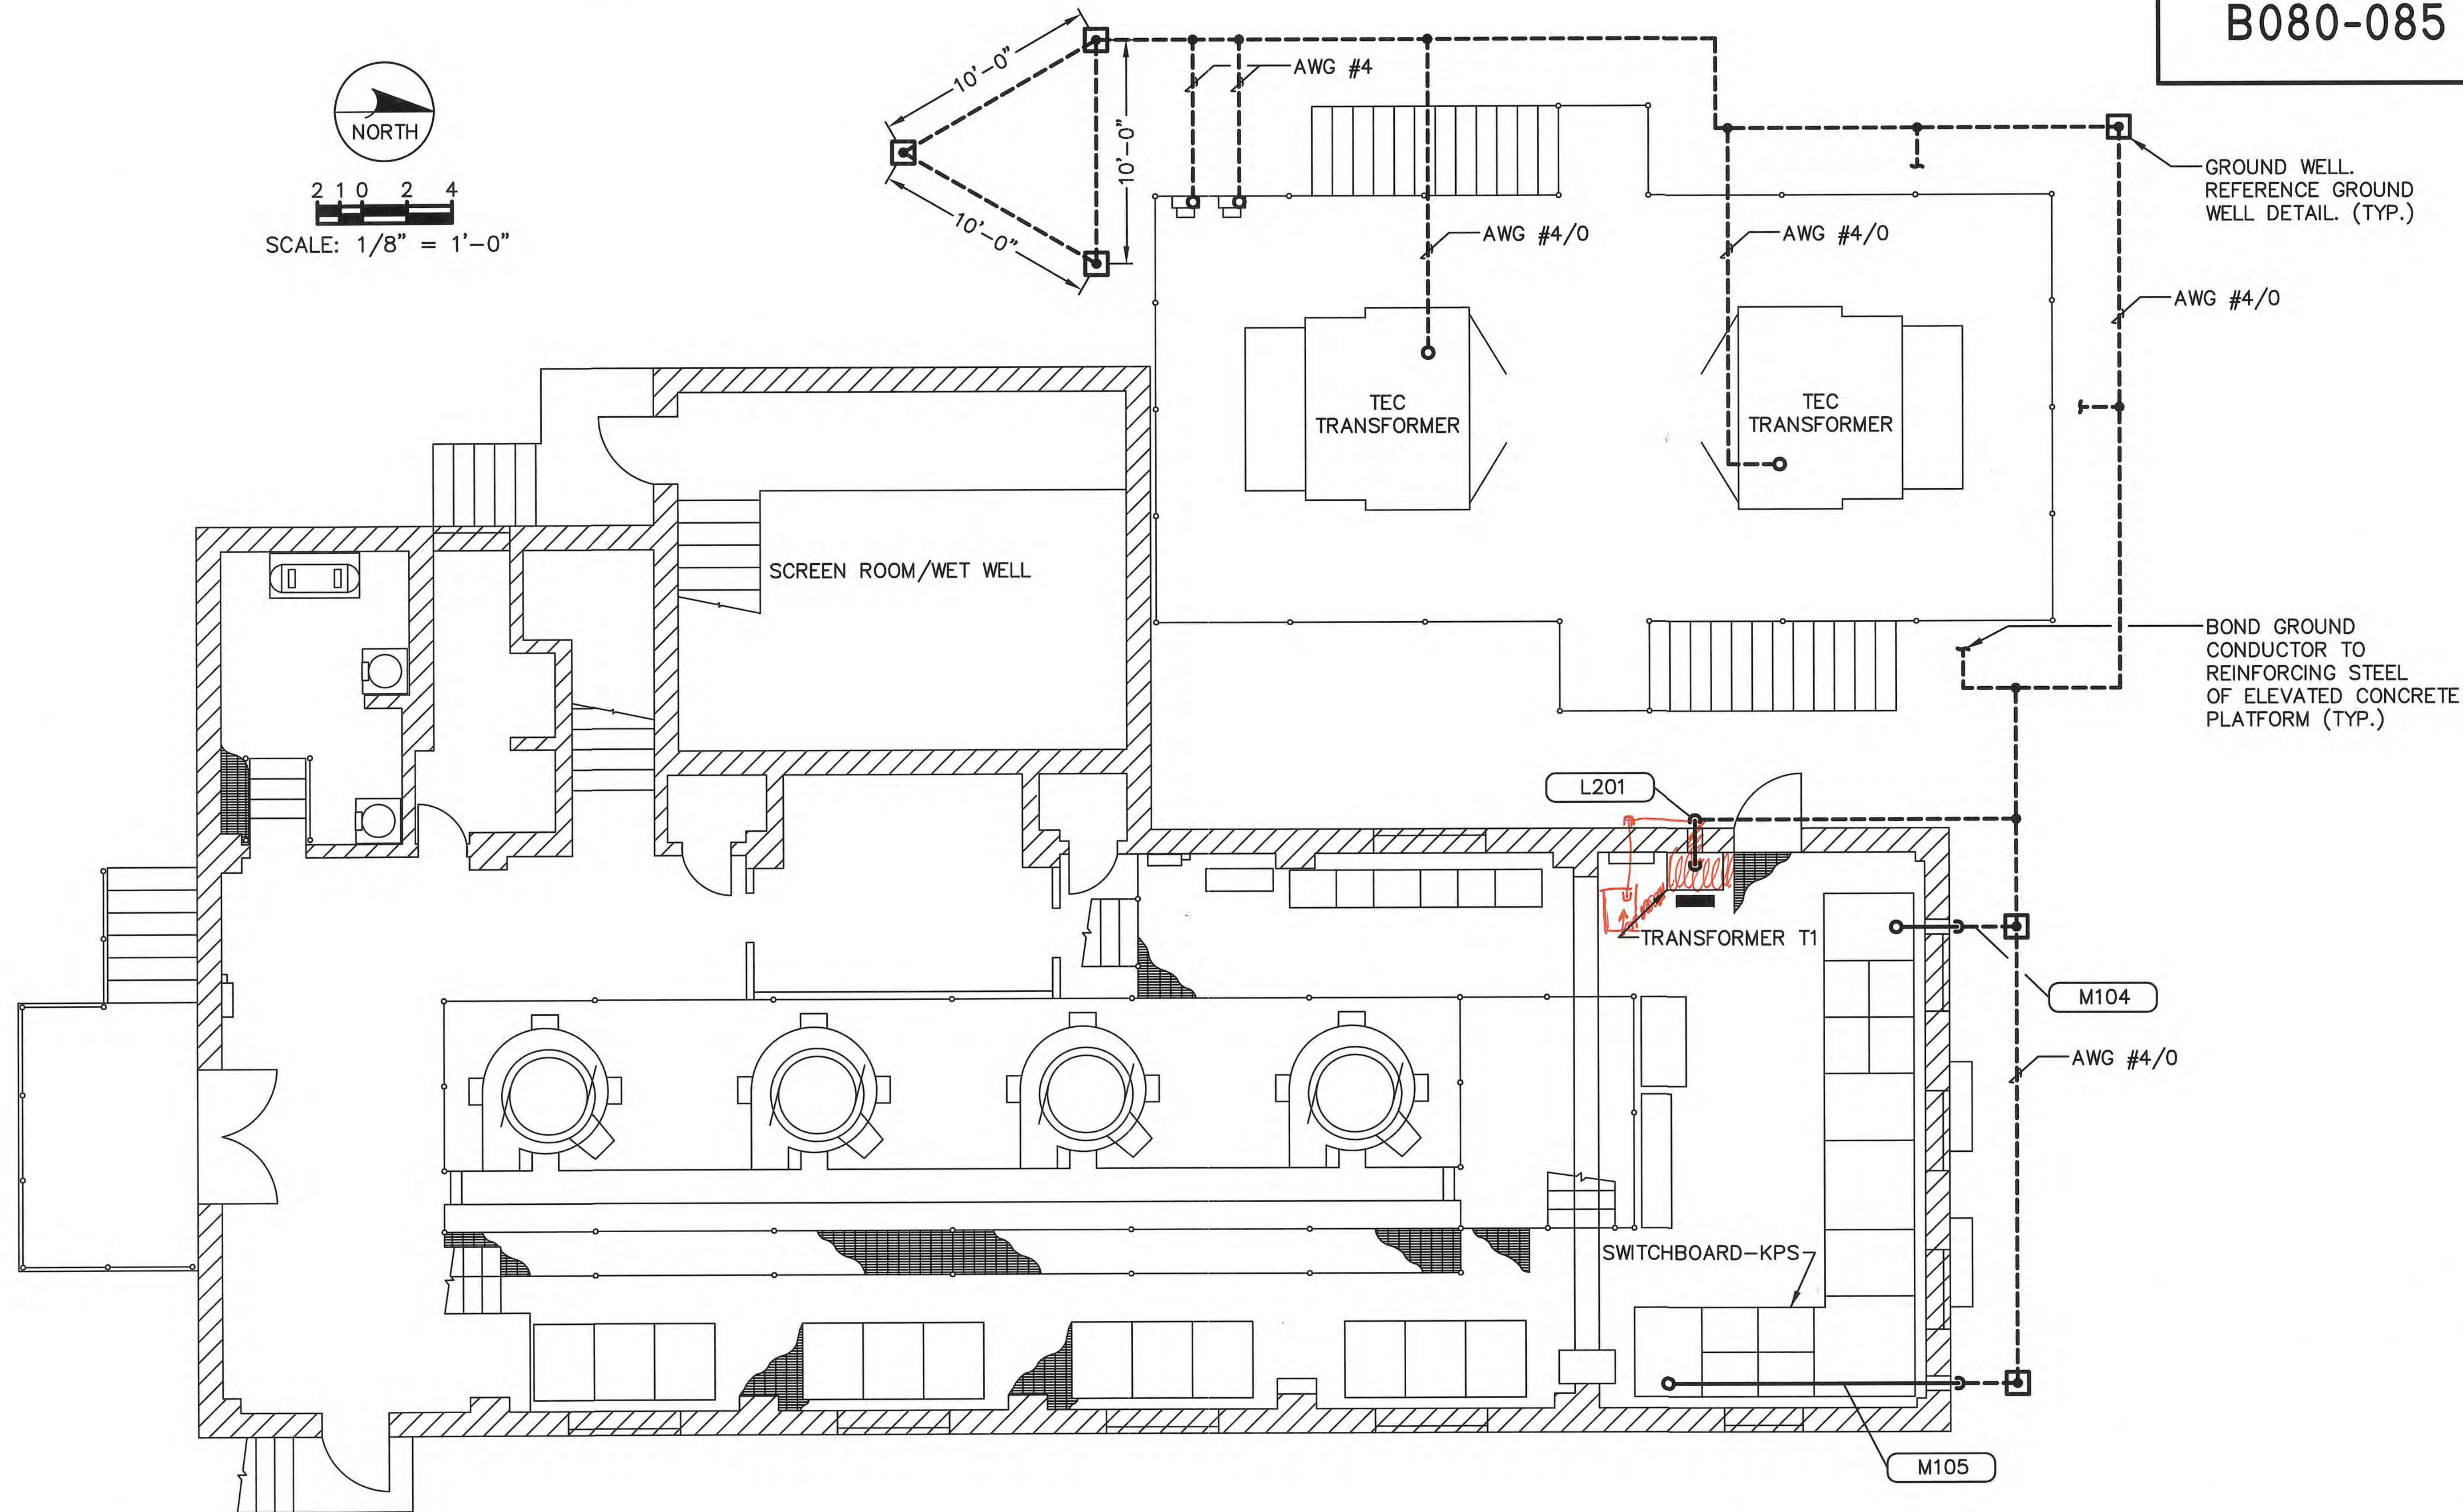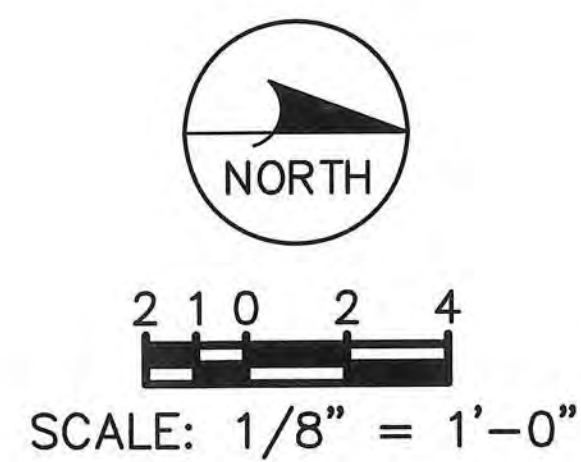

ENGINEER OF RECORD:
BOB E. HALLMAN, P.E.
FLORIDA REGISTRATION NO. 20761



**Engineering Design
Technologies Corp.**
P.O. Box 152403
Tampa, FL 33684-2403
813.289.8080
813.282.9184 FAX
engineering@edt1.com

CITY of TAMPA
WASTEWATER DEPARTMENT

KRAUSE PS REHABILITATION



GROUNDING GRID DETAILS

NO.	DATE	REVISIONS

DRAWN: RWB
DESIGN: STK
QC: BEH
DATE: 05/01/14

SHEET E-24

Certificate of Authorization Number: 4795

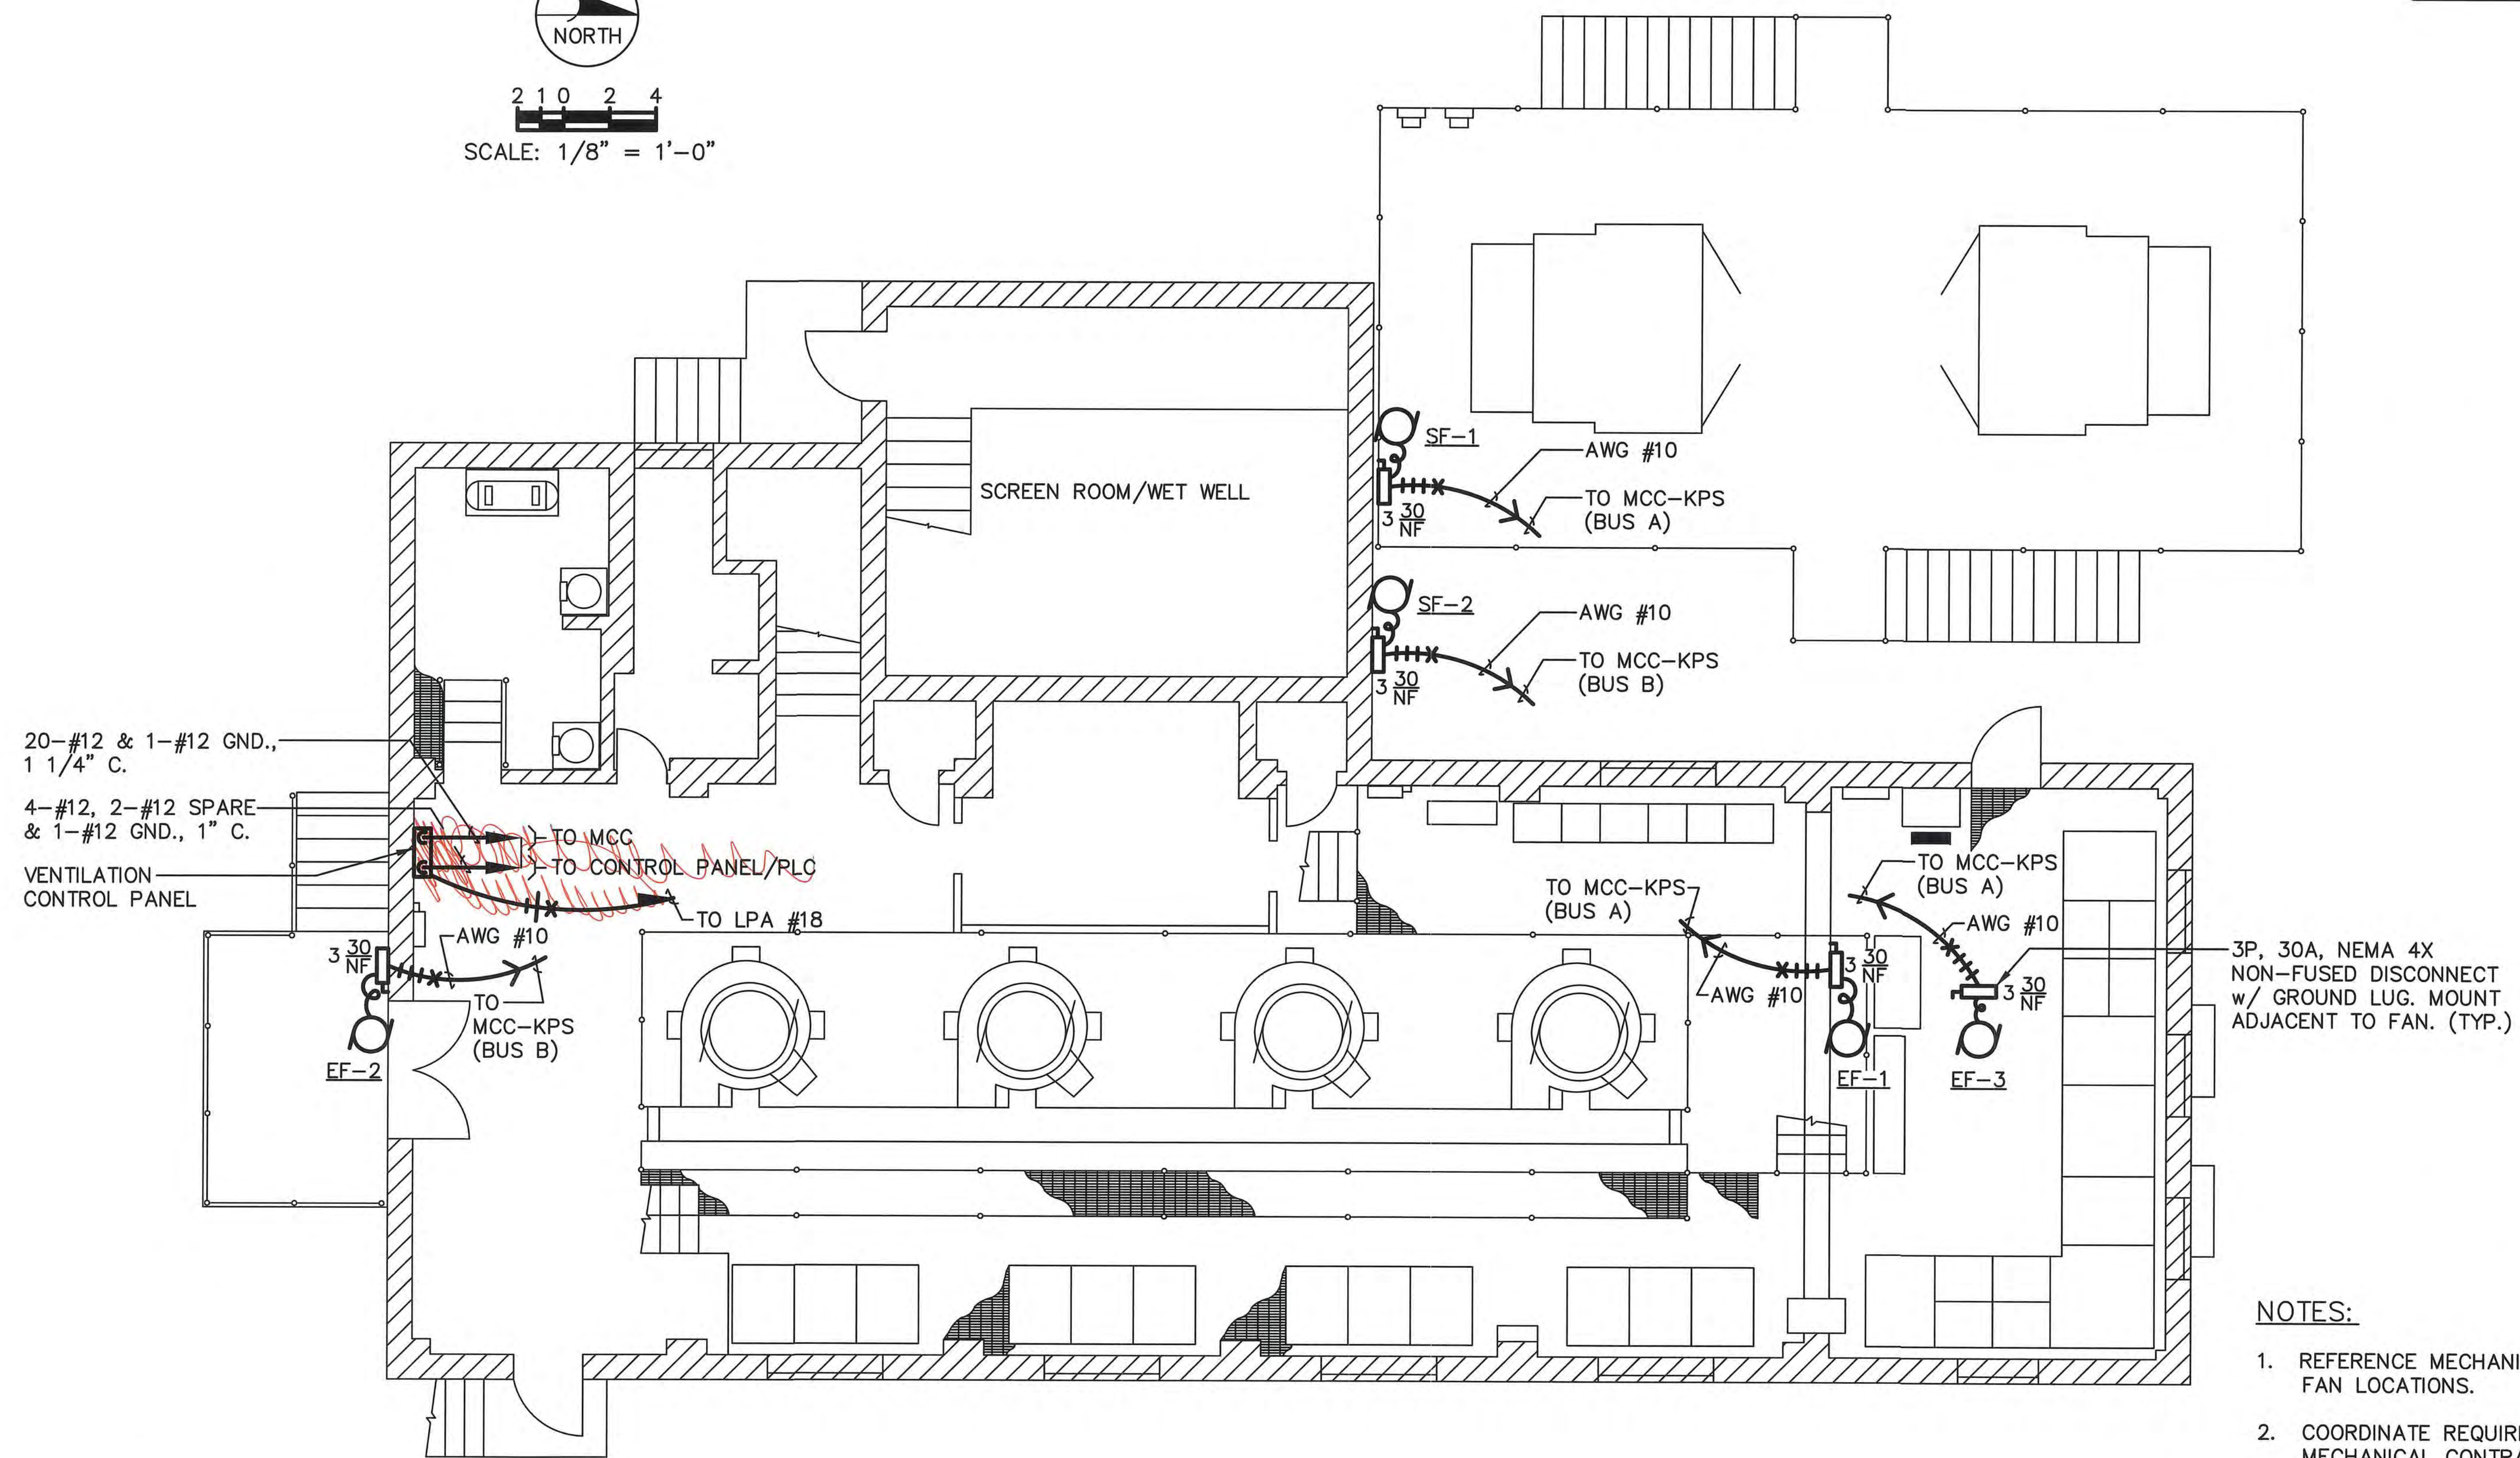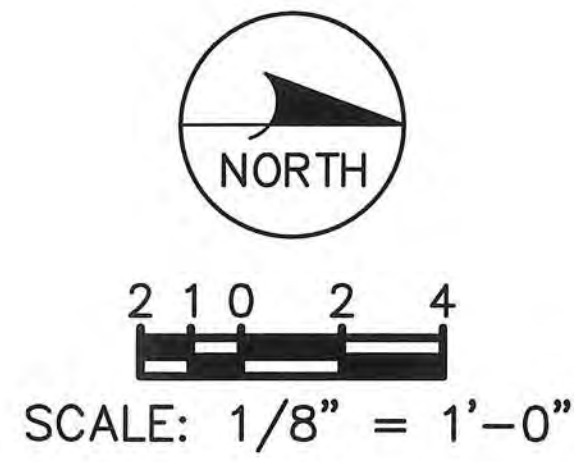

- NOTES:
- 1. REFERENCE MECHANICAL DRAWINGS FOR FAN LOCATIONS.
 - 2. COORDINATE REQUIREMENTS WITH MECHANICAL CONTRACTOR.
 - 3. A WET WELL HIGH LEL LEVEL SHALL TURN ON SUPPLY FAN SF-1 AND SUPPLY FAN SF-2.

ENGINEER OF RECORD:
BOB E. HALLMAN, P.E.
FLORIDA REGISTRATION NO. 20761



Engineering Design
Technologies Corp.
P.O. Box 152403
Tampa, FL 33684-2403
813.289.8080
813.282.9184 FAX
engineering@edt1.com



CITY of TAMPA
WASTEWATER DEPARTMENT

KRAUSE PS REHABILITATION
EXHAUST FAN & SUPPLY FAN
LAYOUT

NO.	DATE	REVISIONS

DRAWN: RWB
DESIGN: STK
QC: BEH
DATE: 05/01/14

SHEET E-26

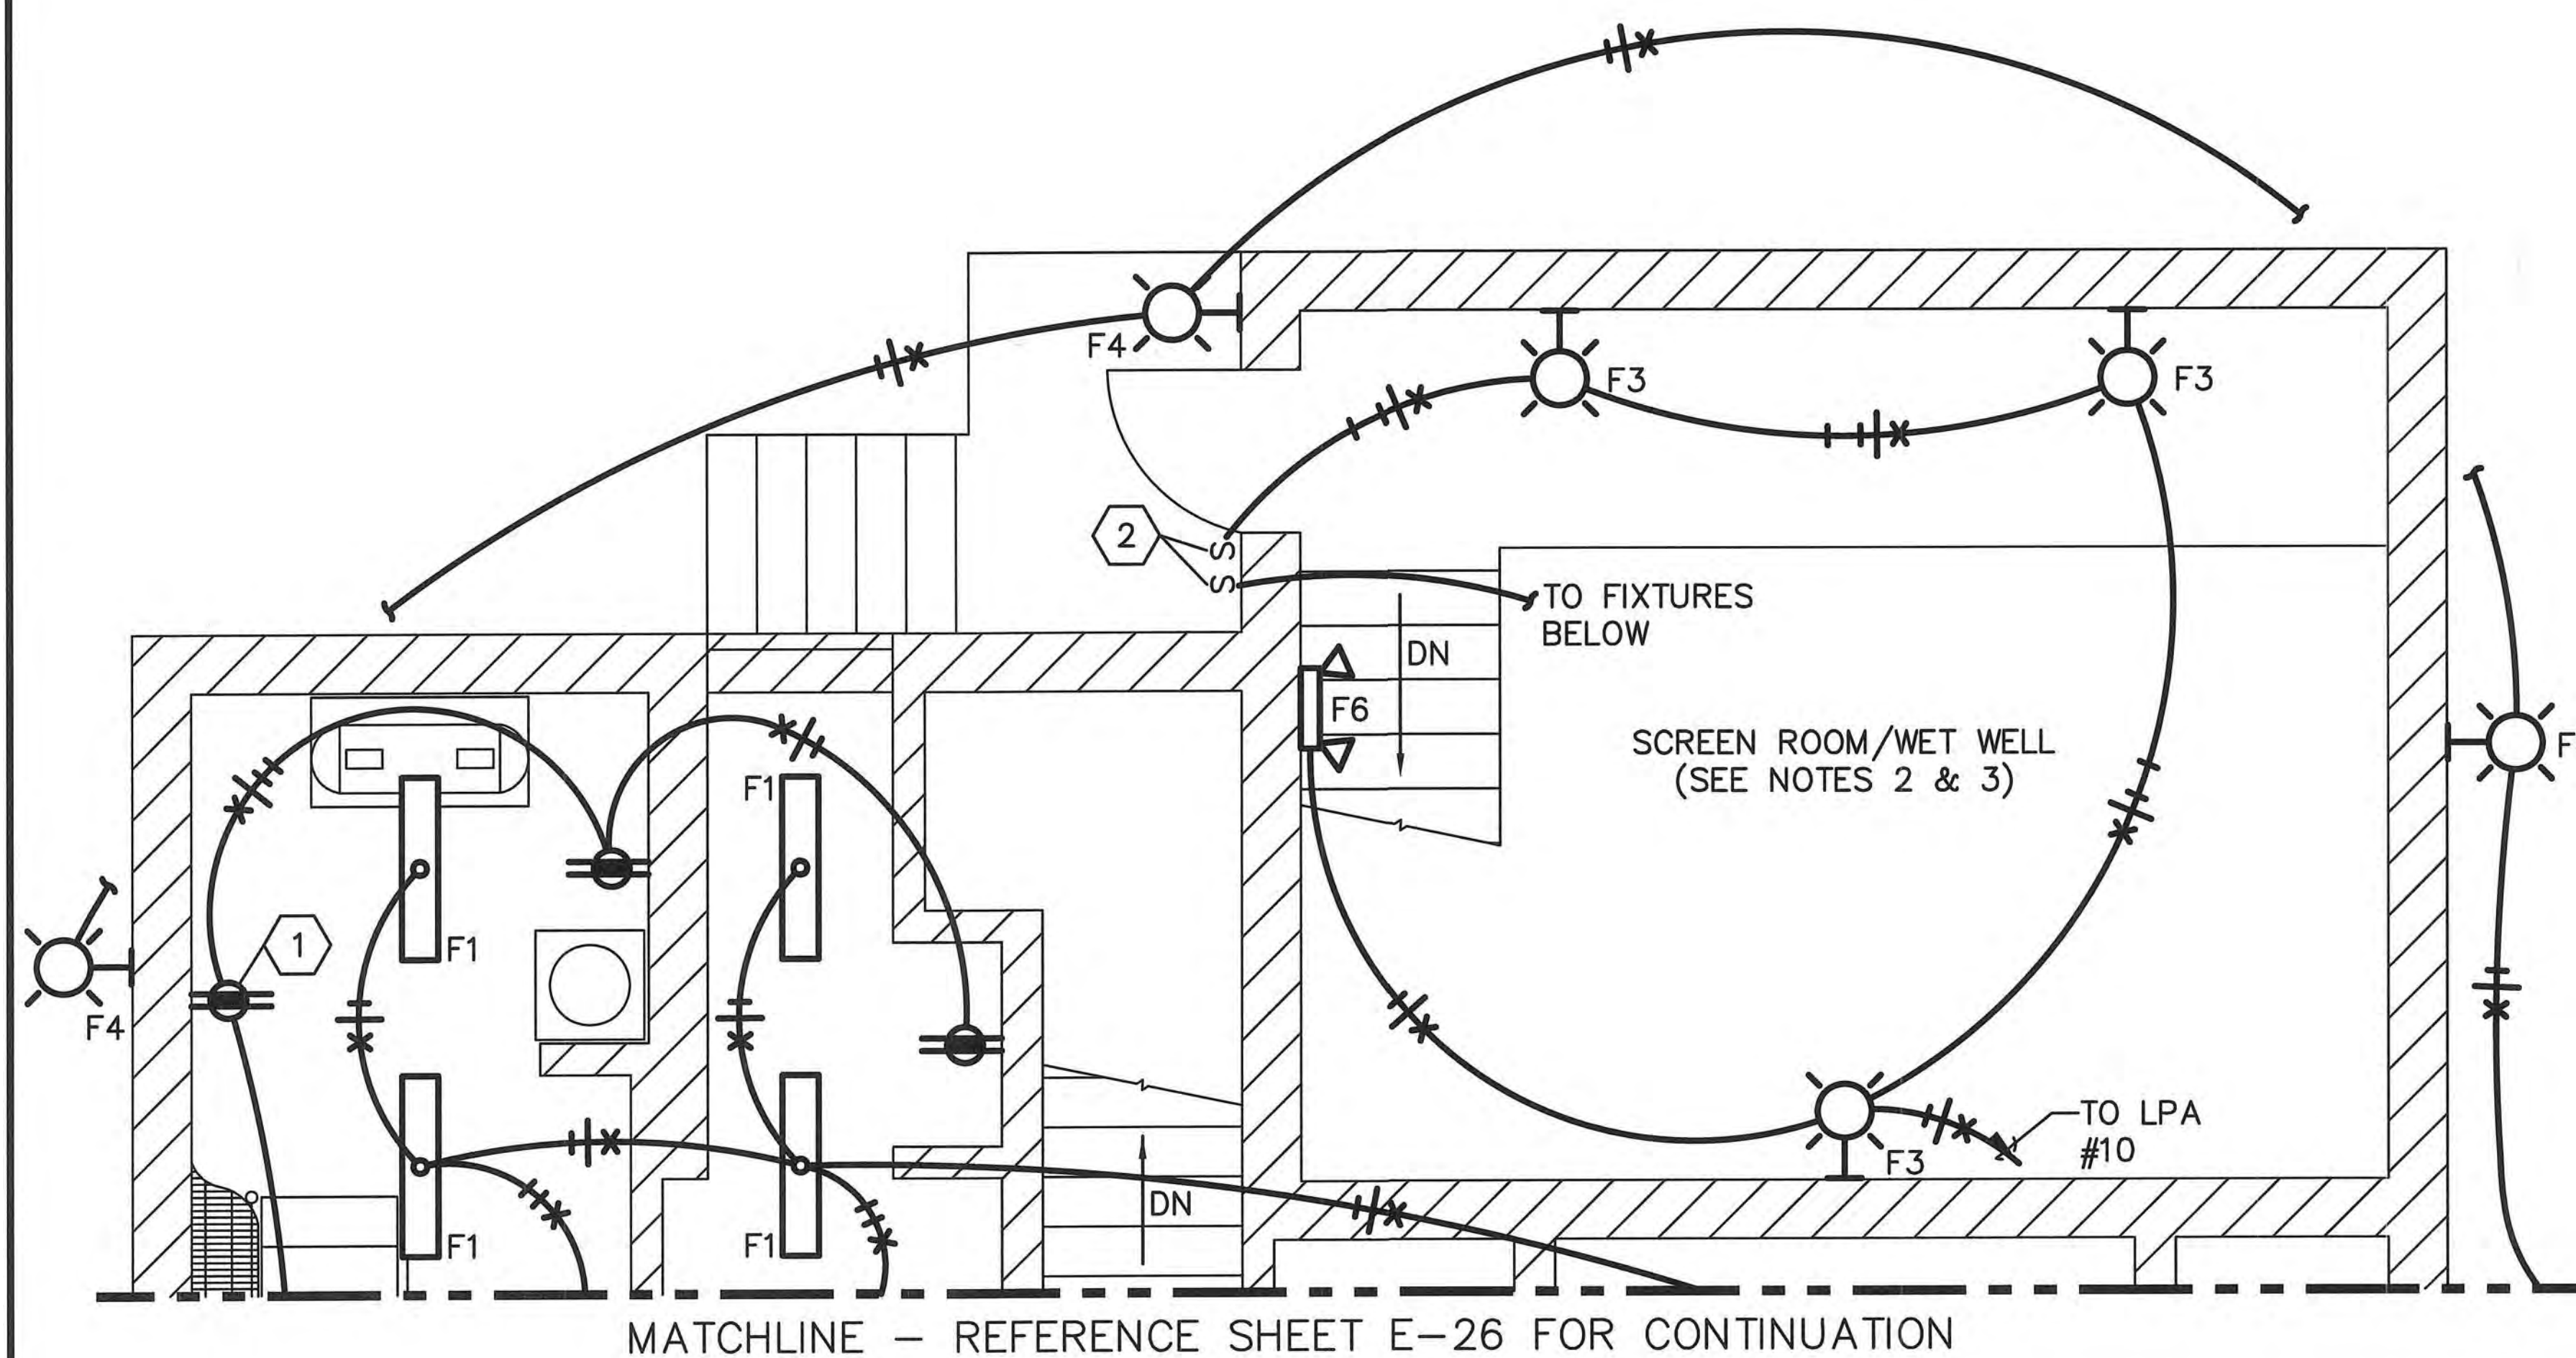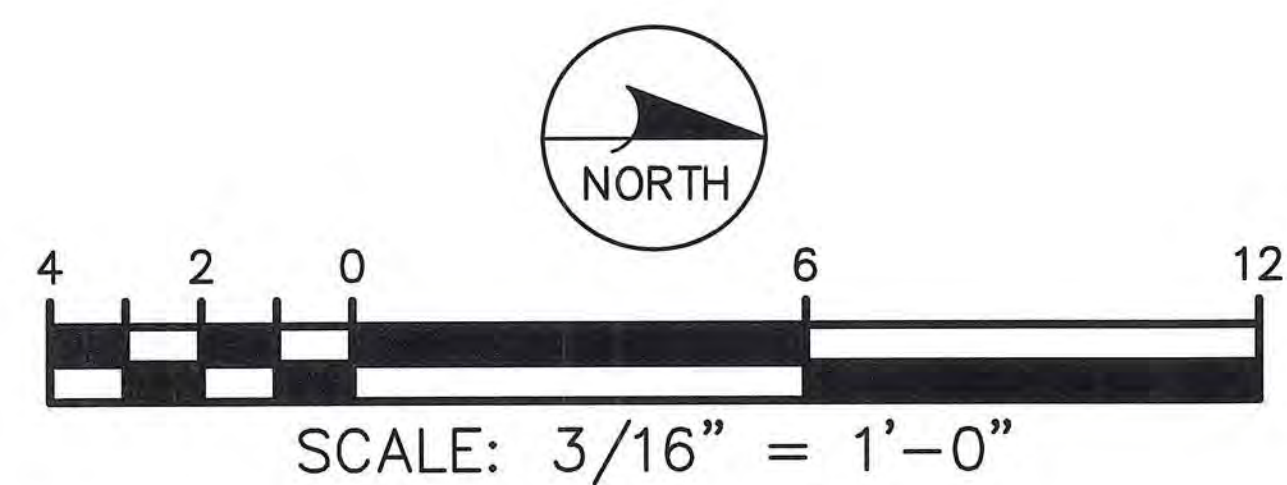**KEYED NOTES:**

- 1 20A, 125V, DUPLEX RECEPTACLE w/ ALUMINUM COVERPLATE MNTD. IN A CAST ALUMINUM BACK BOX. LEVITON CAT. NO. 5362-1 (DUPLEX RECEPTACLE), 83003 (COVERPLATE) & BELL CAT. NO. 5324-0 (BACK BOX). CENTER 50" AFF.
- 2 2P, 20A, SINGLE GANG, FACTORY SEALED LIGHT SWITCH. CROUSE-HINDS CAT. NO. EDSC318. CENTER 50" AFF.

NOTES:

1. LIGHTING FIXTURE F6 SHALL NOT BE SWITCHED.
2. ALL CONDUITS ROUTED IN THE WET WELL SHALL BE RIGID HEAVY WALL ALUMINUM w/ 40 MIL PVC EXTERIOR COATING & 2 MIL BLUE URETHANE INTERIOR COATING. OCAL-BLUE SERIES MANUFACTURED BY THOMAS & BETTS OR EQUAL.
3. THE WET WELL CLASSIFICATION IS CLASS I, GROUPS C & D, DIVISION 1 (HAZARDOUS AREA). NEC ARTICLES 500 & 501 ARE APPLICABLE FOR WIRING METHODS USED IN THE WET WELL.
4. ALL CONDUITS EXTENDING FROM THE SCREEN ROOM/WET WELL SHALL BE SEALED WITH A CONDUIT SEALING FITTING AND SEALING COMPOUND. THE SEALING FITTING SHALL BE INSTALLED IMMEDIATELY AS THE CONDUIT EXITS THE SCREEN ROOM/WET WELL. NO OTHER FITTING SHALL BE INSTALLED BETWEEN THE WALL AND THE SEALING FITTING.

ENGINEER OF RECORD:
BOB E. HALLMAK, P.E.
FLORIDA REGISTRATION NO. 20761



Certificate of Authorization Number: 4795

**Engineering Design
Technologies Corp.**
P.O. Box 152403
Tampa, FL 33684-2403
813.289.8080
813.282.9184 FAX
engineering@edt1.com

CITY of TAMPA
WASTEWATER DEPARTMENT

KRAUSE PS REHABILITATION

ELECTRICAL LIGHTING & POWER PLAN
(UPPER LEVEL - FLOOR ELEV. 7.54' NAVD)
(SHEET 2 OF 2)

NO.	DATE	REVISIONS

DRAWN: RWB
DESIGN: STK
QC: BEH
DATE: 05/01/14

SHEET E-27


B080-089

KEYED NOTES:

- 1 20A, 125V, DUPLEX RECEPTACLE w/ ALUMINUM COVERPLATE MNTD. IN A CAST ALUMINUM BACK BOX. LEVITON CAT. NO. 5362-1 (DUPLEX RECEPTACLE), 83003 (COVERPLATE) & BELL CAT. NO. 5324-0 (BACK BOX). CENTER 50" AFF.

NOTES:

1. LIGHTING FIXTURE F5 SHALL NOT BE SWITCHED.
2. ALL CONDUITS ROUTED IN THE WET WELL SHALL BE RIGID HEAVY WALL ALUMINUM w/ 40 MIL PVC EXTERIOR COATING & 2 MIL BLUE URETHANE INTERIOR COATING. OCAL-BLUE SERIES MANUFACTURED BY THOMAS & BETTS OR EQUAL.
3. THE WET WELL CLASSIFICATION IS CLASS I, GROUPS C & D, DIVISION 1 (HAZARDOUS AREA). NEC ARTICLES 500 & 501 ARE APPLICABLE FOR WIRING METHODS USED IN THE WET WELL.
4. ALL LIGHTING FIXTURE & RECEPTACLE CIRCUITS LOCATED ON THE LOWER LEVEL SHALL BE FED FROM GFCI CIRCUITS.
5. PROVIDE JUNCTION BOXES AS REQUIRED FOR LIGHTING CIRCUITS.
6. ALL CONDUITS EXTENDING FROM THE SCREEN ROOM/WET WELL SHALL BE SEALED WITH A CONDUIT SEALING FITTING AND SEALING COMPOUND. THE SEALING FITTING SHALL BE INSTALLED IMMEDIATELY AS THE CONDUIT EXITS THE SCREEN ROOM/WET WELL. NO OTHER FITTING SHALL BE INSTALLED BETWEEN THE WALL AND THE SEALING FITTING.

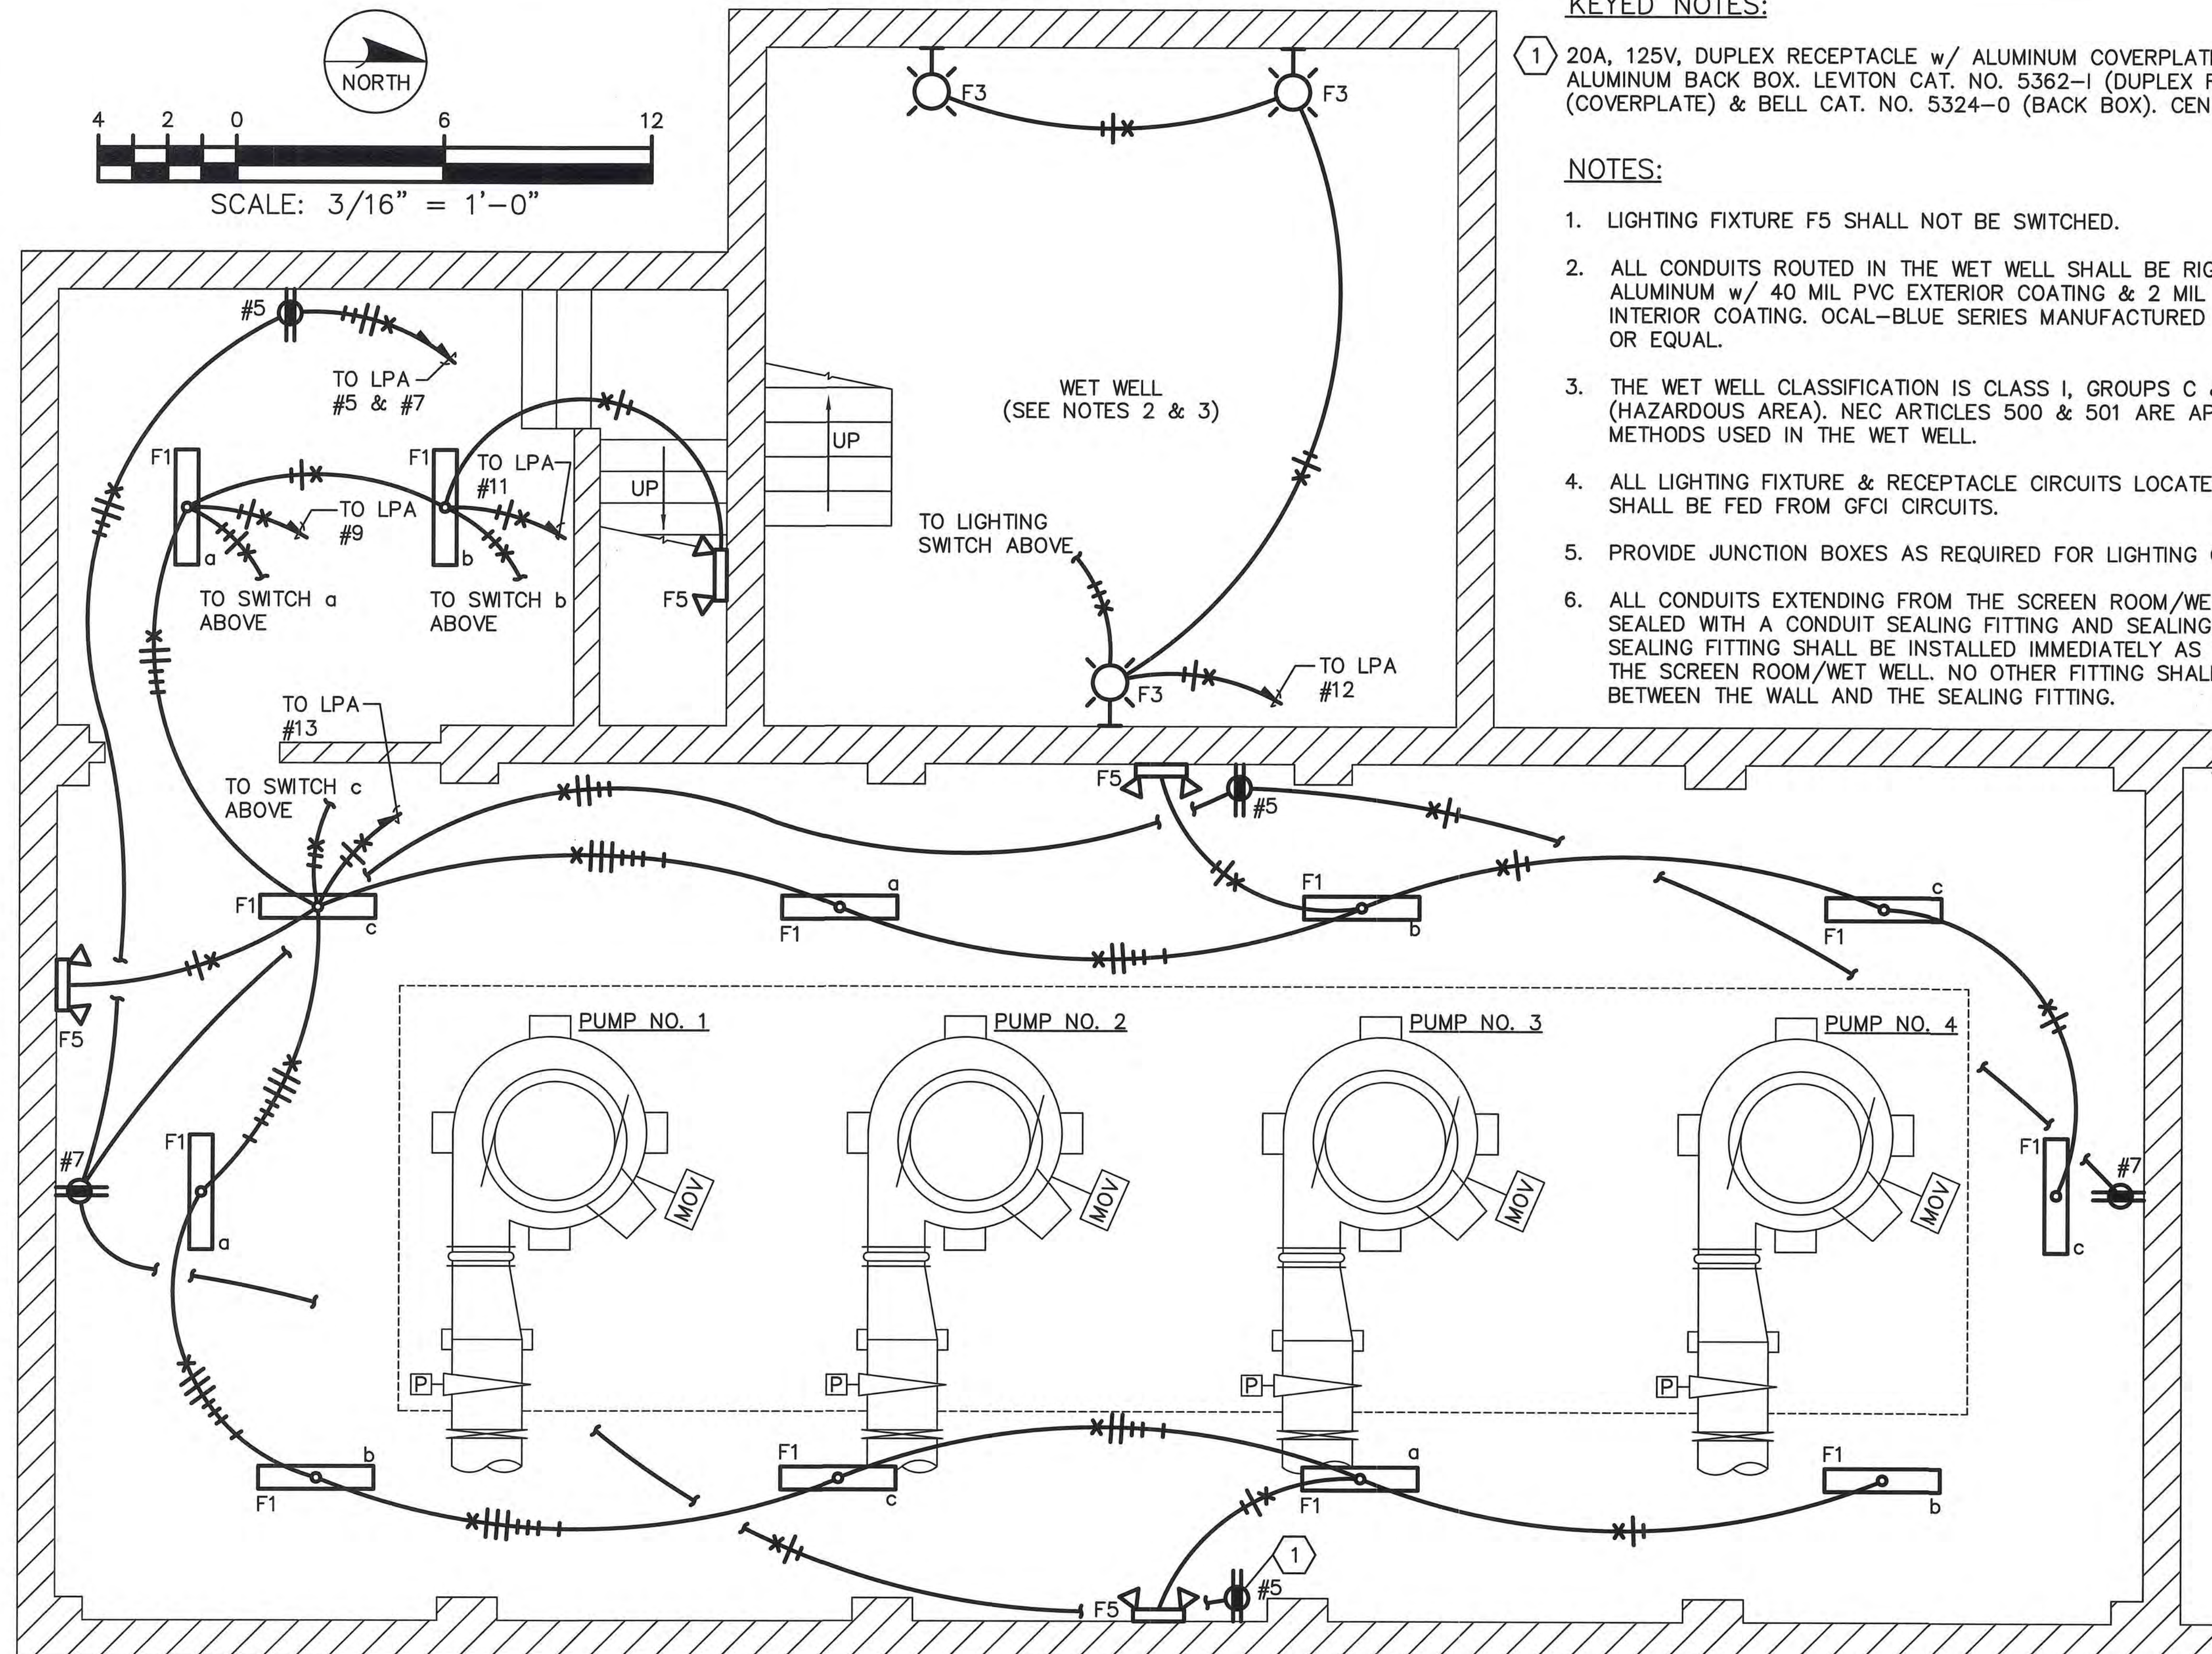

ENGINEER OF RECORD:
BOB E. HALLMAN, P.E.
FLORIDA REGISTRATION NO. 20761



Engineering Design
Technologies Corp.
P.O. Box 152403
Tampa, FL 33684-2403
813.289.8080
813.282.9184 FAX
engineering@edt1.com

CITY of TAMPA
WASTEWATER DEPARTMENT


KRAUSE PS REHABILITATION
ELECTRICAL LIGHTING & POWER PLAN
(LOWER LEVEL - FLOOR ELEV. -5.99' NAVD)

NO.	DATE	REVISIONS

DRAWN: RWB
DESIGN: STK
QC: BEH
DATE: 05/01/14

SHEET E-28

Certificate of Authorization Number: 4795

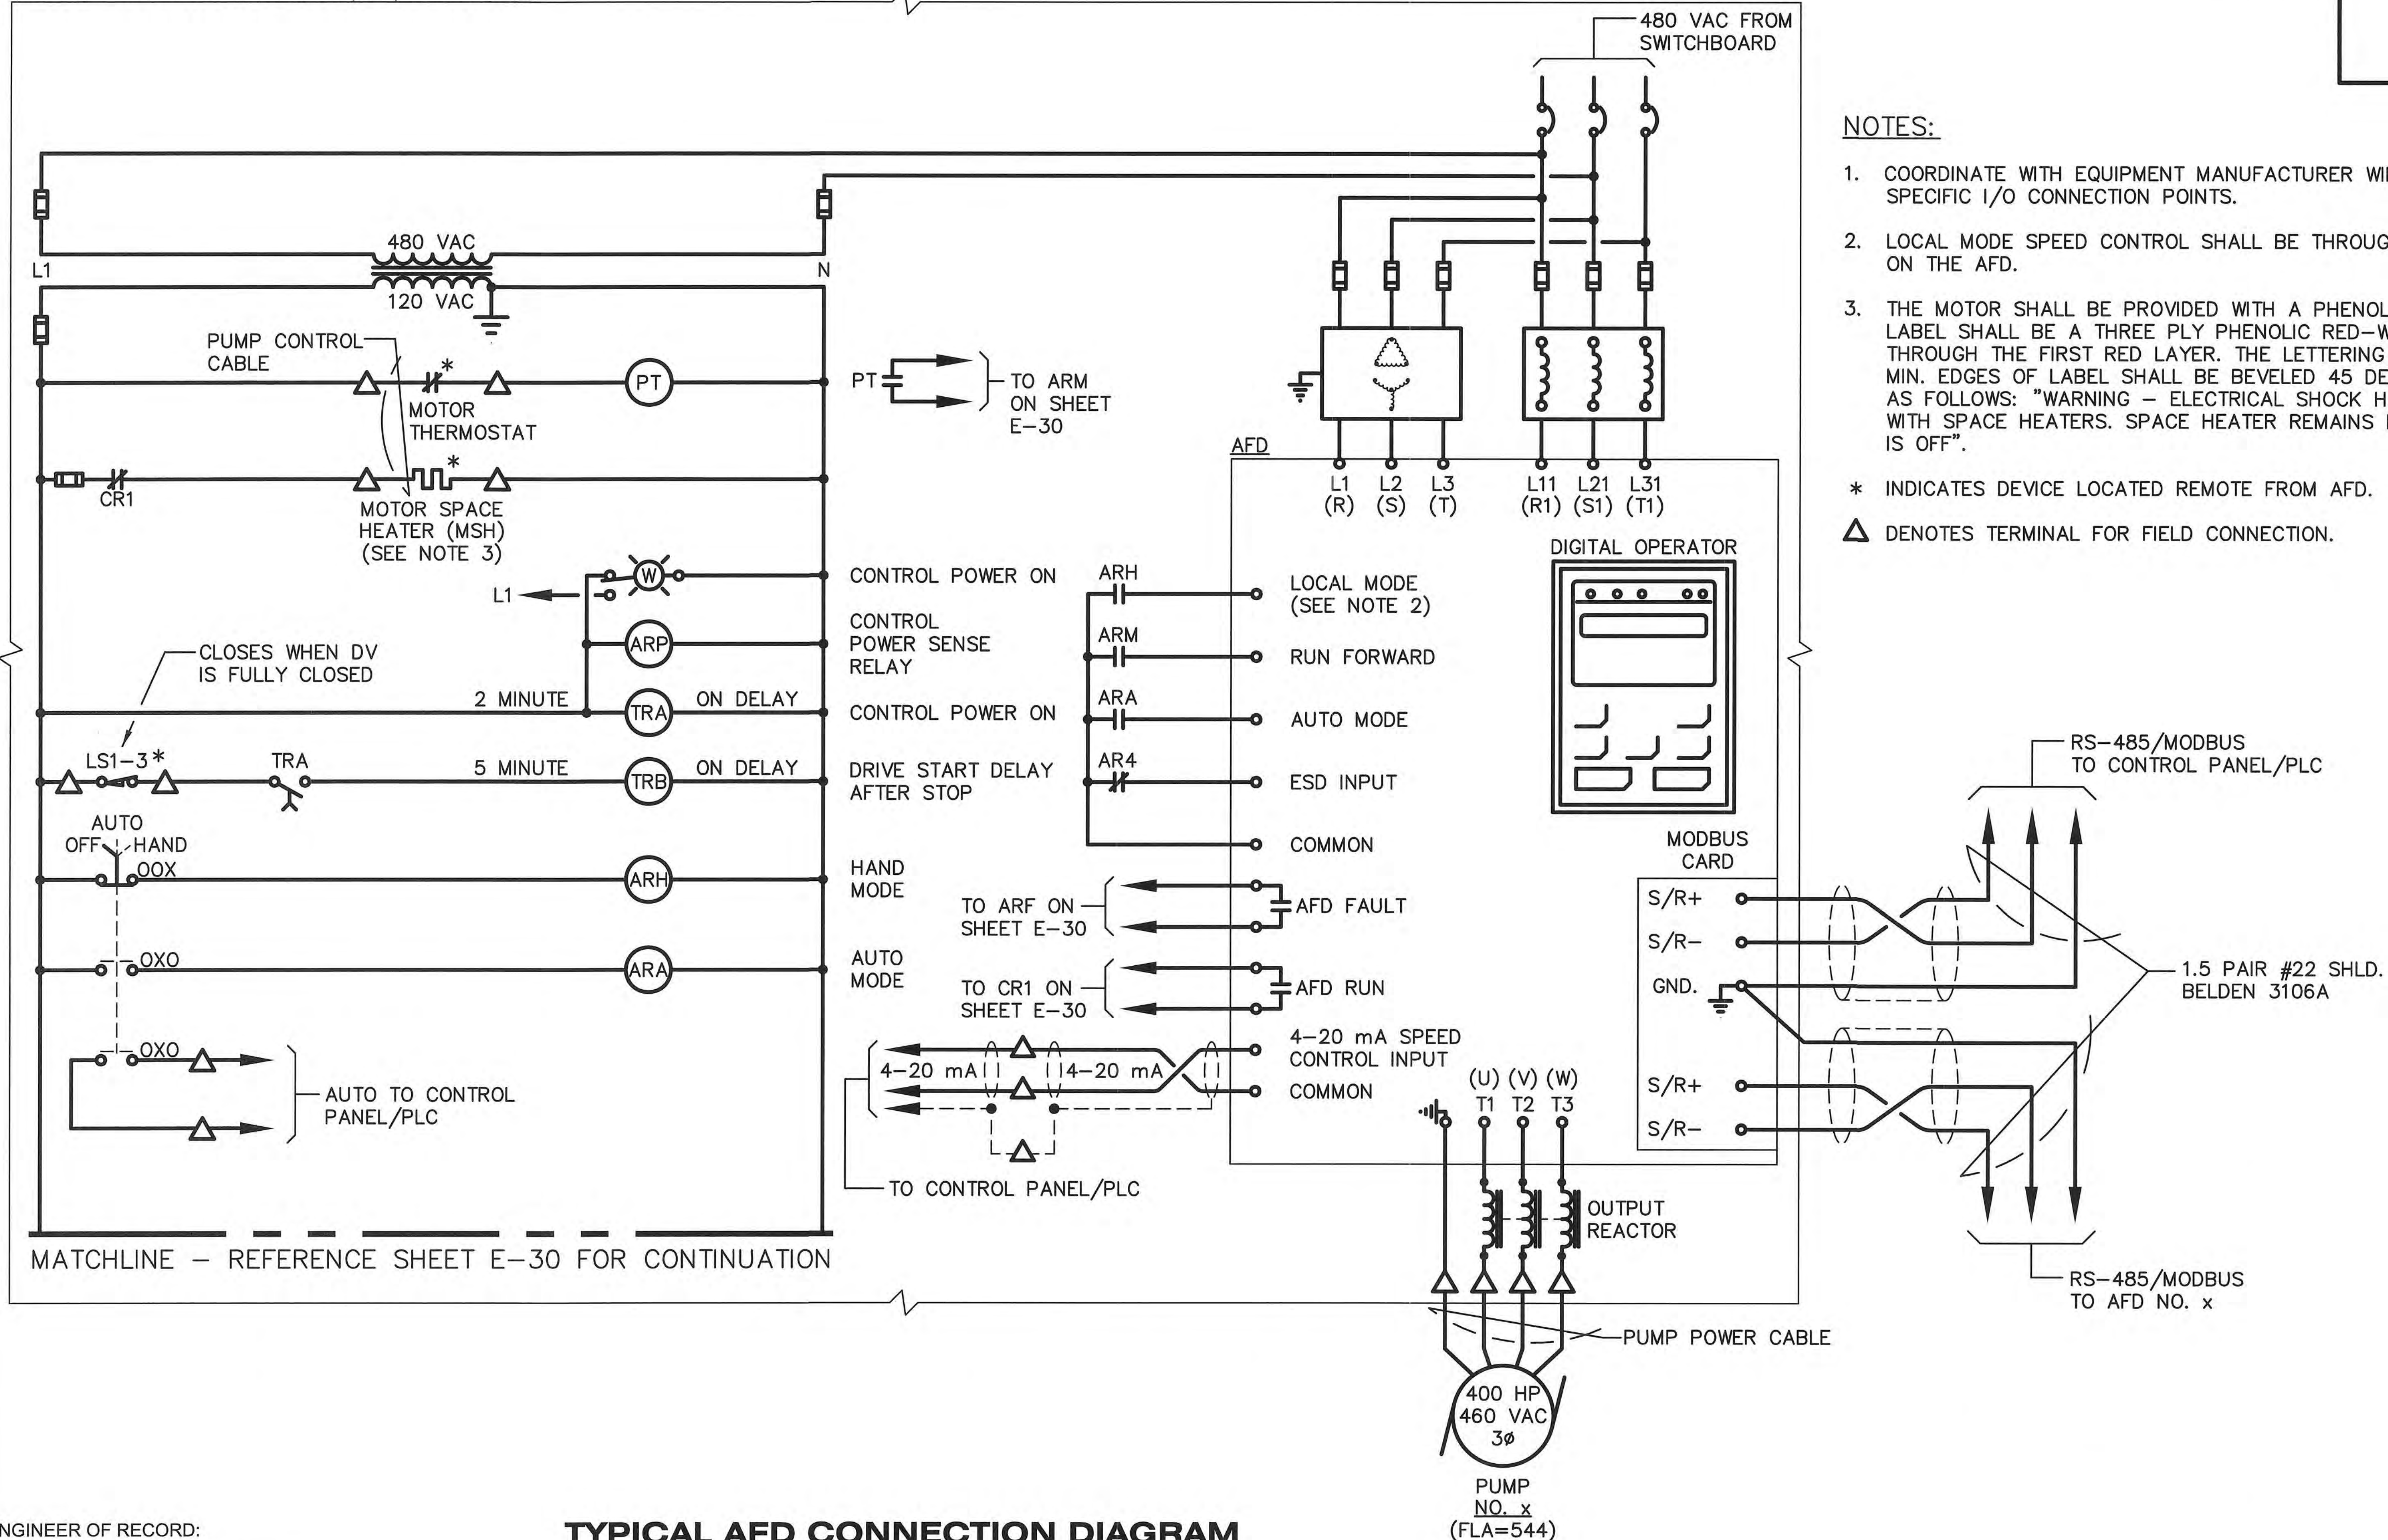

ENGINEER OF RECORD:
BOB E. HALLMAN, P.E.
FLORIDA REGISTRATION NO. 20761



**Engineering Design
Technologies Corp.**
P.O. Box 152403
Tampa, FL 33684-2403
813.289.8080
813.282.9184 FAX
engineering@edt1.com

CITY of TAMPA
WASTEWATER DEPARTMENT

KRAUSE PS REHABILITATION

**TYPICAL AFD CONNECTION DIAGRAM
(SHEET 1 OF 2)**

				DRAWN: RWB
				DESIGN: STK
				QC: BEH
				DATE: 05/01/14
				SHEET E-29
NO.	DATE	REVISIONS		

The diagram illustrates the electrical control logic for a pump system. It includes the following components and logic:

- Power Supply:** L1 (Line 1) is the main power source.
- Interlocks and Safety:**
 - VPP (Vacuum Pump Protection):** A normally closed contact that interlocks the main power.
 - PROOF OF PRIME SWITCH*:** A safety switch with a normally open contact.
 - LS/15* (Limit Switch):** A normally open contact that closes when the pump suction valve PSV is open.
 - LS1-2* (Limit Switch):** A normally open contact that opens when the DV (Discharge Valve) is fully closed.
 - AFD RUN STATUS:** A normally open contact.
 - AFD FAULT:** A normally open contact that triggers a fault condition.
 - TEMP. MONITOR (SEE NOTE 1):** A normally open contact that triggers a high temperature condition.
- Control Logic:**
 - TRB (Time Relay):** A normally open contact that is part of the start sequence.
 - PT (Pressure Transducer):** A normally open contact.
 - TR3 (Time Relay):** A normally open contact.
 - AR4 (Alarm Relay):** A normally open contact.
 - ARM (Alarm Relay):** A normally open contact that is used in several interlocking circuits.
 - ARA (Alarm Relay):** A normally open contact.
 - AR1 (Alarm Relay):** A normally open contact.
 - TRM (Time Relay):** A normally open contact used for the ON DELAY.
 - CR1 (Control Relay):** A normally open contact.
 - ETM (Emergency Stop Module):** A normally open contact.
 - TR1 (Time Relay):** A normally open contact used for the 10-minute ON DELAY.
 - TRA (Time Relay):** A normally open contact.
- Status Indicators:**
 - PRIMED:** Indicated by a lamp (A) and a bell (R).
 - PUMP READY:** Indicated by a lamp (A) and a bell (R).
 - READY:** Indicated by a lamp (A).
 - RUN:** Indicated by a lamp (A).
 - ON DELAY:** Indicated by a lamp (A).
 - RUNNING:** Indicated by a lamp (A) and a bell (R).
 - ON DELAY (10 MINUTE):** Indicated by a lamp (A).
 - AFD FAULT:** Indicated by a lamp (A).
 - PUMP/MOTOR HIGH TEMPERATURE:** Indicated by a lamp (A) and a bell (R).
 - HIGH TEMP:** Indicated by a lamp (A) and a bell (R).

The diagram illustrates a complex motor control system for a discharge valve, featuring multiple interlocking relays, limit switches, and safety components. The system is designed to ensure safe operation by preventing simultaneous conflicting actions and responding to various fault conditions.

Key Components and Functions:

- Limit Switches:**
 - LS1-1*: Opens when the discharge valve (DV) is fully closed.
 - LS2-1*: Opens when the discharge valve (DV) is fully open.
- Relays and Timers:**
 - ARS: Stop Command relay.
 - TR3: On Delay timer for the stop command.
 - AR3: Relay for normal open/close and emergency fast close.
 - AR4: Relay for emergency stop.
 - ARF: Relay for AFD fault.
 - ARTX: Relay for pump/motor high temperature.
 - TR2: Relay for discharge valve failed to open.
 - VRI: Relay for excessive vibration.
- Safety and Emergency Features:**
 - E-STOP/L:** Emergency stop button with a latching reset mechanism.
 - EMERGENCY STOP:** A dedicated stop button.
 - VIB SWITCH*:** Vibration monitoring switch with a remote reset.
- Interlocking Logic:**
 - The system prevents the discharge valve from being open and closed simultaneously.
 - It ensures that the valve cannot be opened if it is already closed or if there is a fault condition.
 - Emergency stop (E-STOP/L) and vibration (VIB) conditions immediately halt the system.

Fault Conditions Table:

Fault Condition	Indicator
AFD FAULT	ARF
PUMP/MOTOR HIGH TEMPERATURE	ARTX
DISCHARGE VALVE FAILED TO OPEN	TR2
EXCESSIVE VIBRATION	VRI



Wiring diagram for the AFD starter control circuit, showing the following components and connections:

- Emergency Stop:** A normally closed contact connected to the control circuit.
- AFD Run Status:** A normally open contact connected to the control circuit.
- AFD Fault/Failed to Start:** A normally closed contact connected to the control circuit.
- Control Power:** A normally closed contact connected to the control circuit.
- Pump Discharge Valve DV Failed to Open:** A normally open contact connected to the control circuit.
- Pump Not Ready:** A normally closed contact connected to the control circuit.
- Interlocking Contacts:**
 - ARH, ARA, ARR:** Interlocking contacts for the blower motor starter, connected in series.
 - ARM:** An interlocking contact for the pump suction valve PSV, connected in series.
 - TR2:** A normally open contact for the pump discharge valve DV, connected in series.
 - CR1:** A normally open contact for the pump suction valve PSV, connected in series.
 - AR4:** A normally open contact for the control panel/PLC, connected in series.

The diagram illustrates the logic for starting the AFD, ensuring that all safety and interlocking conditions are met before the motor can start.


△ DENOTES TERMINAL FOR FIELD CONNECTION.

SHEET E-30

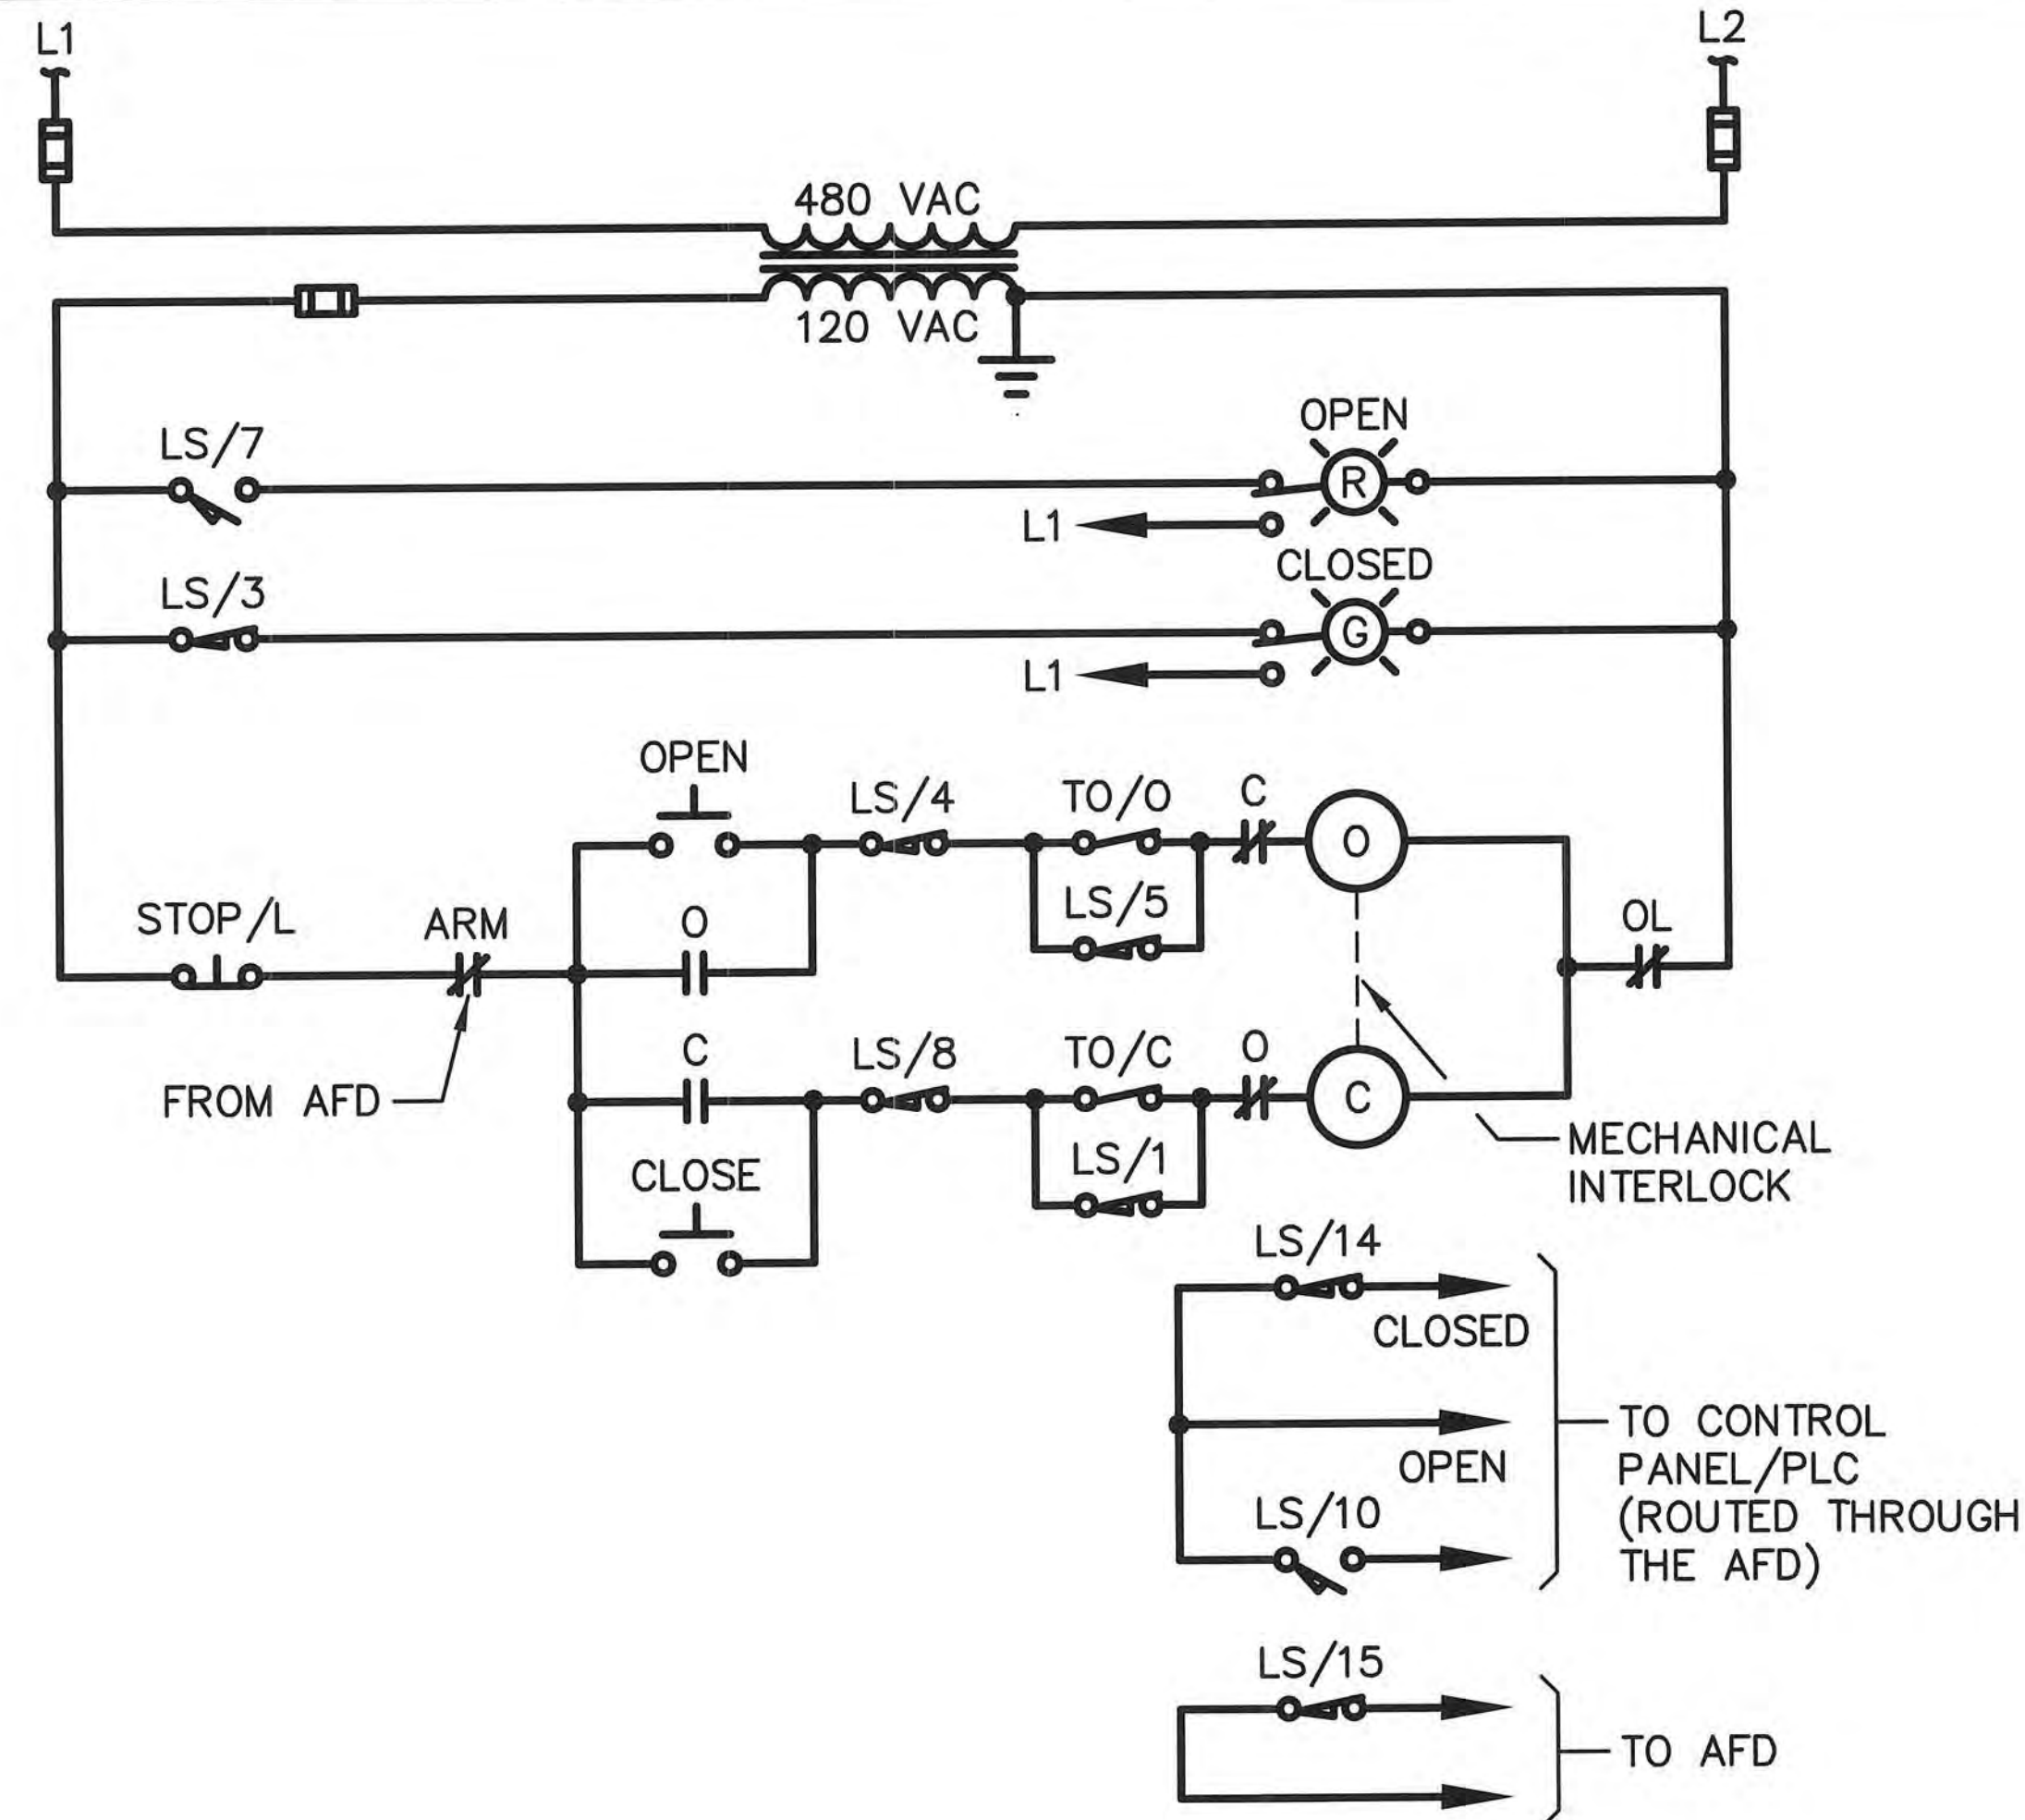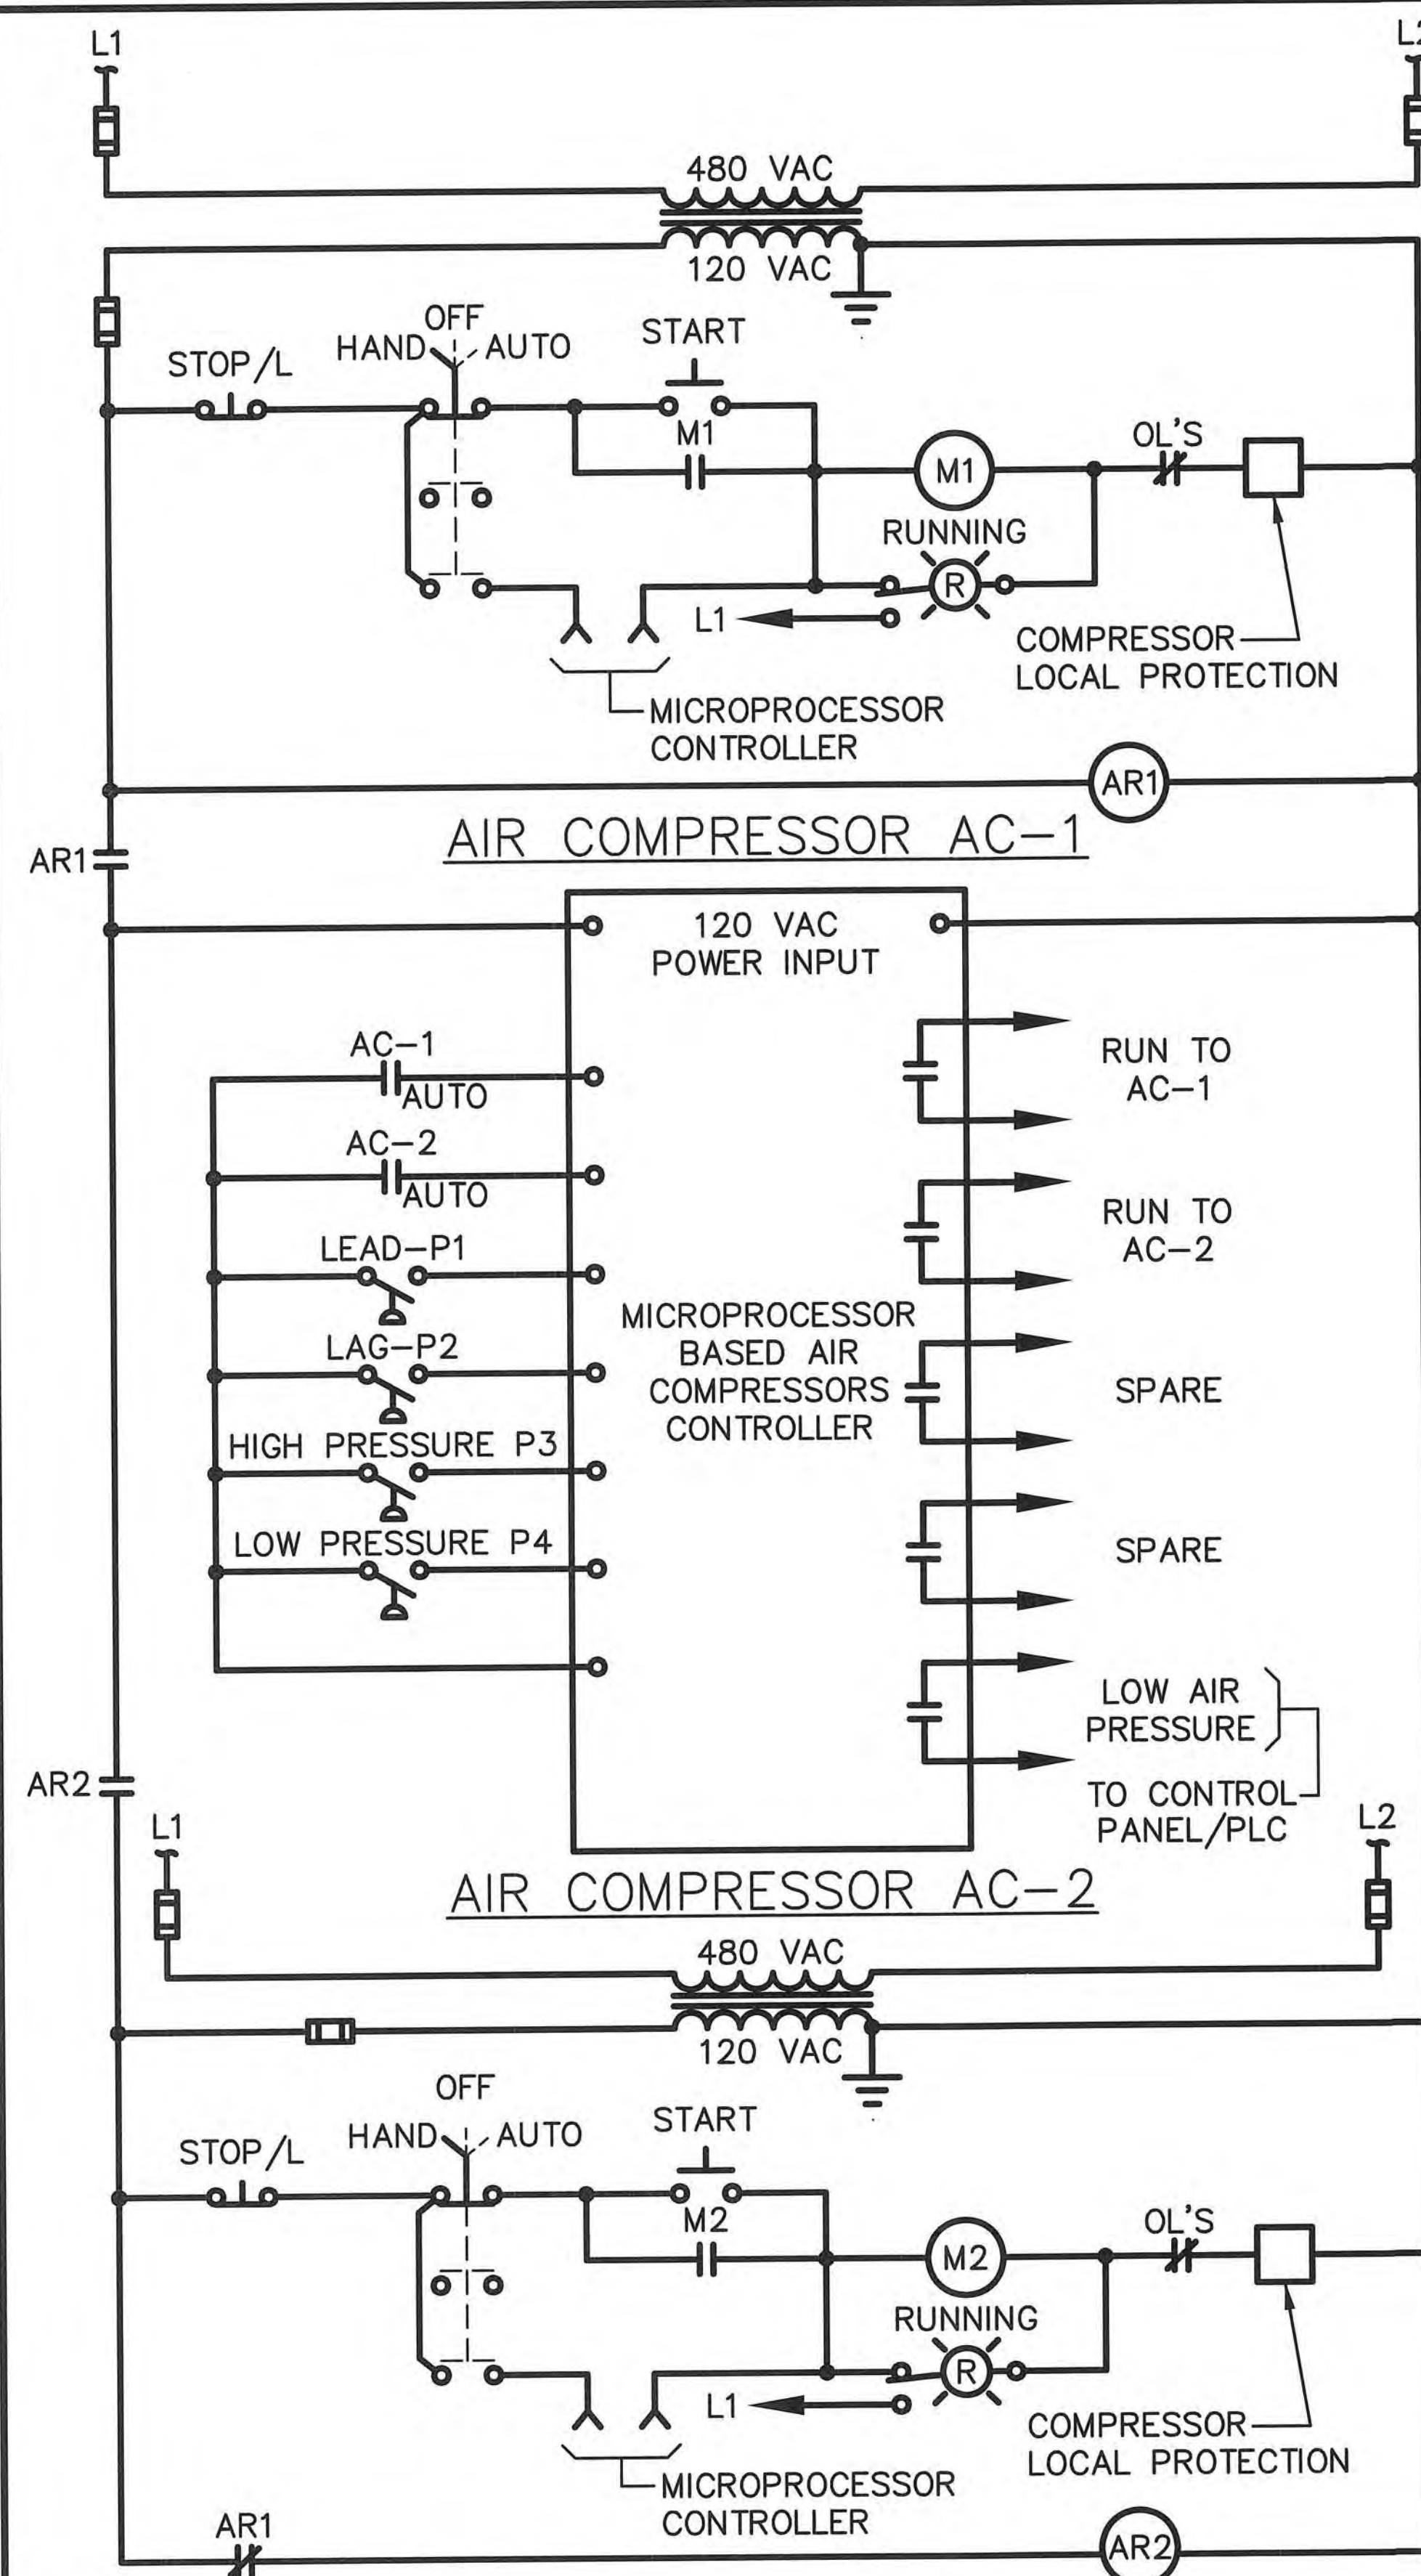

MOTOR OPERATED KNIFE GATE PUMP SUCTION VALVE (PSV)

ENGINEER OF RECORD:
BOB E. HALLMAN, P.E.
FLORIDA REGISTRATION NO. 20761

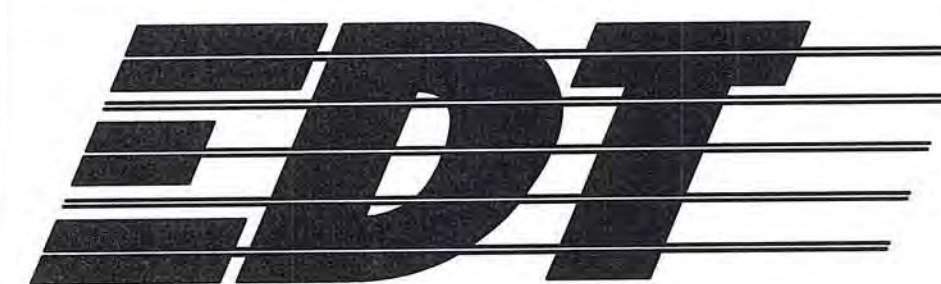

Engineering Design Technologies Corp.
P.O. Box 152403
Tampa, FL 33684-2403
813.289.8080
813.282.9184 FAX
engineering@edt1.com

Certificate of Authorization Number: 4795

CITY of TAMPA
WASTEWATER DEPARTMENT

KRAUSE PS REHABILITATION

AIR COMPRESSOR & PUMP SUCTION VALVE CONTROL DIAGRAMS

NO.	DATE	REVISIONS

DRAWN: RWB
DESIGN: STK
QC: BEH
DATE: 05/01/14

SHEET E-31

LIMIT SWITCH CONTACT DEVELOPMENT FOR PNEUMATIC DISCHARGE VALVE OPERATORS					
ROTOR NO.	CONTACT NO.	OPERATOR POSITION			CONTACT FUNCTION
		FULL OPEN	INTER-MEDIATE	FULL CLOSED	
LS1	1				VA. OPEN IND. LT
	2				START DELAY CKT.
	3				RUN CKT.
	4				SPARE
LS2	1				VA. CLOSED IND. LT
	2				SPARE
	3				SPARE
	4				SPARE

LIMIT SWITCH CONTACT DEVELOPMENT FOR MOTORIZED PUMP SUCTION VALVE OPERATORS (KNIFE GATE)					
ROTOR NO.	CONTACT NO.	OPERATOR POSITION			CONTACT FUNCTION
		FULL OPEN	INTER-MEDIATE	FULL CLOSED	
1	1				BYPASS CKT.
	2				PUMP PERMISSIVE
	3				INDICATOR LIGHT
	4				FORWARD (OPEN) LIMIT
2	5				BYPASS CKT.
	6				SPARE
	7				INDICATOR LIGHT
	8				REVERSE (CLOSED) LIMIT
3	9				AUXILIARY
	10				CONTROL PANEL/PLC
	11				AUXILIARY
	12				AUXILIARY
4	13				AUXILIARY
	14				CONTROL PANEL/PLC
	15				PUMP START CKT.
	16				AUXILIARY

ENGINEER OF RECORD:
BOB E. HALLMAN, P.E.
FLORIDA REGISTRATION NO. 20761

REMOTE CIRCUIT BREAKER PANEL

SWITCHBOARD-KPS BUS A MAIN

GENERATOR BUS A

SWITCHBOARD-KPS TIE

GENERATOR BUS B

SWITCHBOARD-KPS BUS B MAIN

SWITCHBOARD-KPS MCC BUS A

43CS

MANUAL AUTO

SWITCHBOARD-KPS MCC BUS B

PUMP NO. 1 AFD CIRCUIT BREAKER

PUMP NO. 3 AFD CIRCUIT BREAKER

PUMP NO. 2 AFD CIRCUIT BREAKER


PUMP NO. 4 AFD CIRCUIT BREAKER

PUSH-TO-TEST LED PILOT LIGHT (TYP.)


ELECTROSWITCH 8857LY SERIES 24 CONTROL SWITCH w/ 120 VAC CONTROL CIRCUIT. COORDINATE CONNECTION REQUIREMENTS w/ MANUFACTURER. (TYP.)

48" x 36" x 12" NEMA 4X SS ENCLOSURE w/ CONTINUOUS HINGE, SS BACK PANEL AND SS FLOOR STAND KIT. HOFFMAN CAT. NO. A48H3612SSLP (ENCLOSURE), A48P36SS6 (BACK PANEL) & A48K2410SS

SHEET E-33

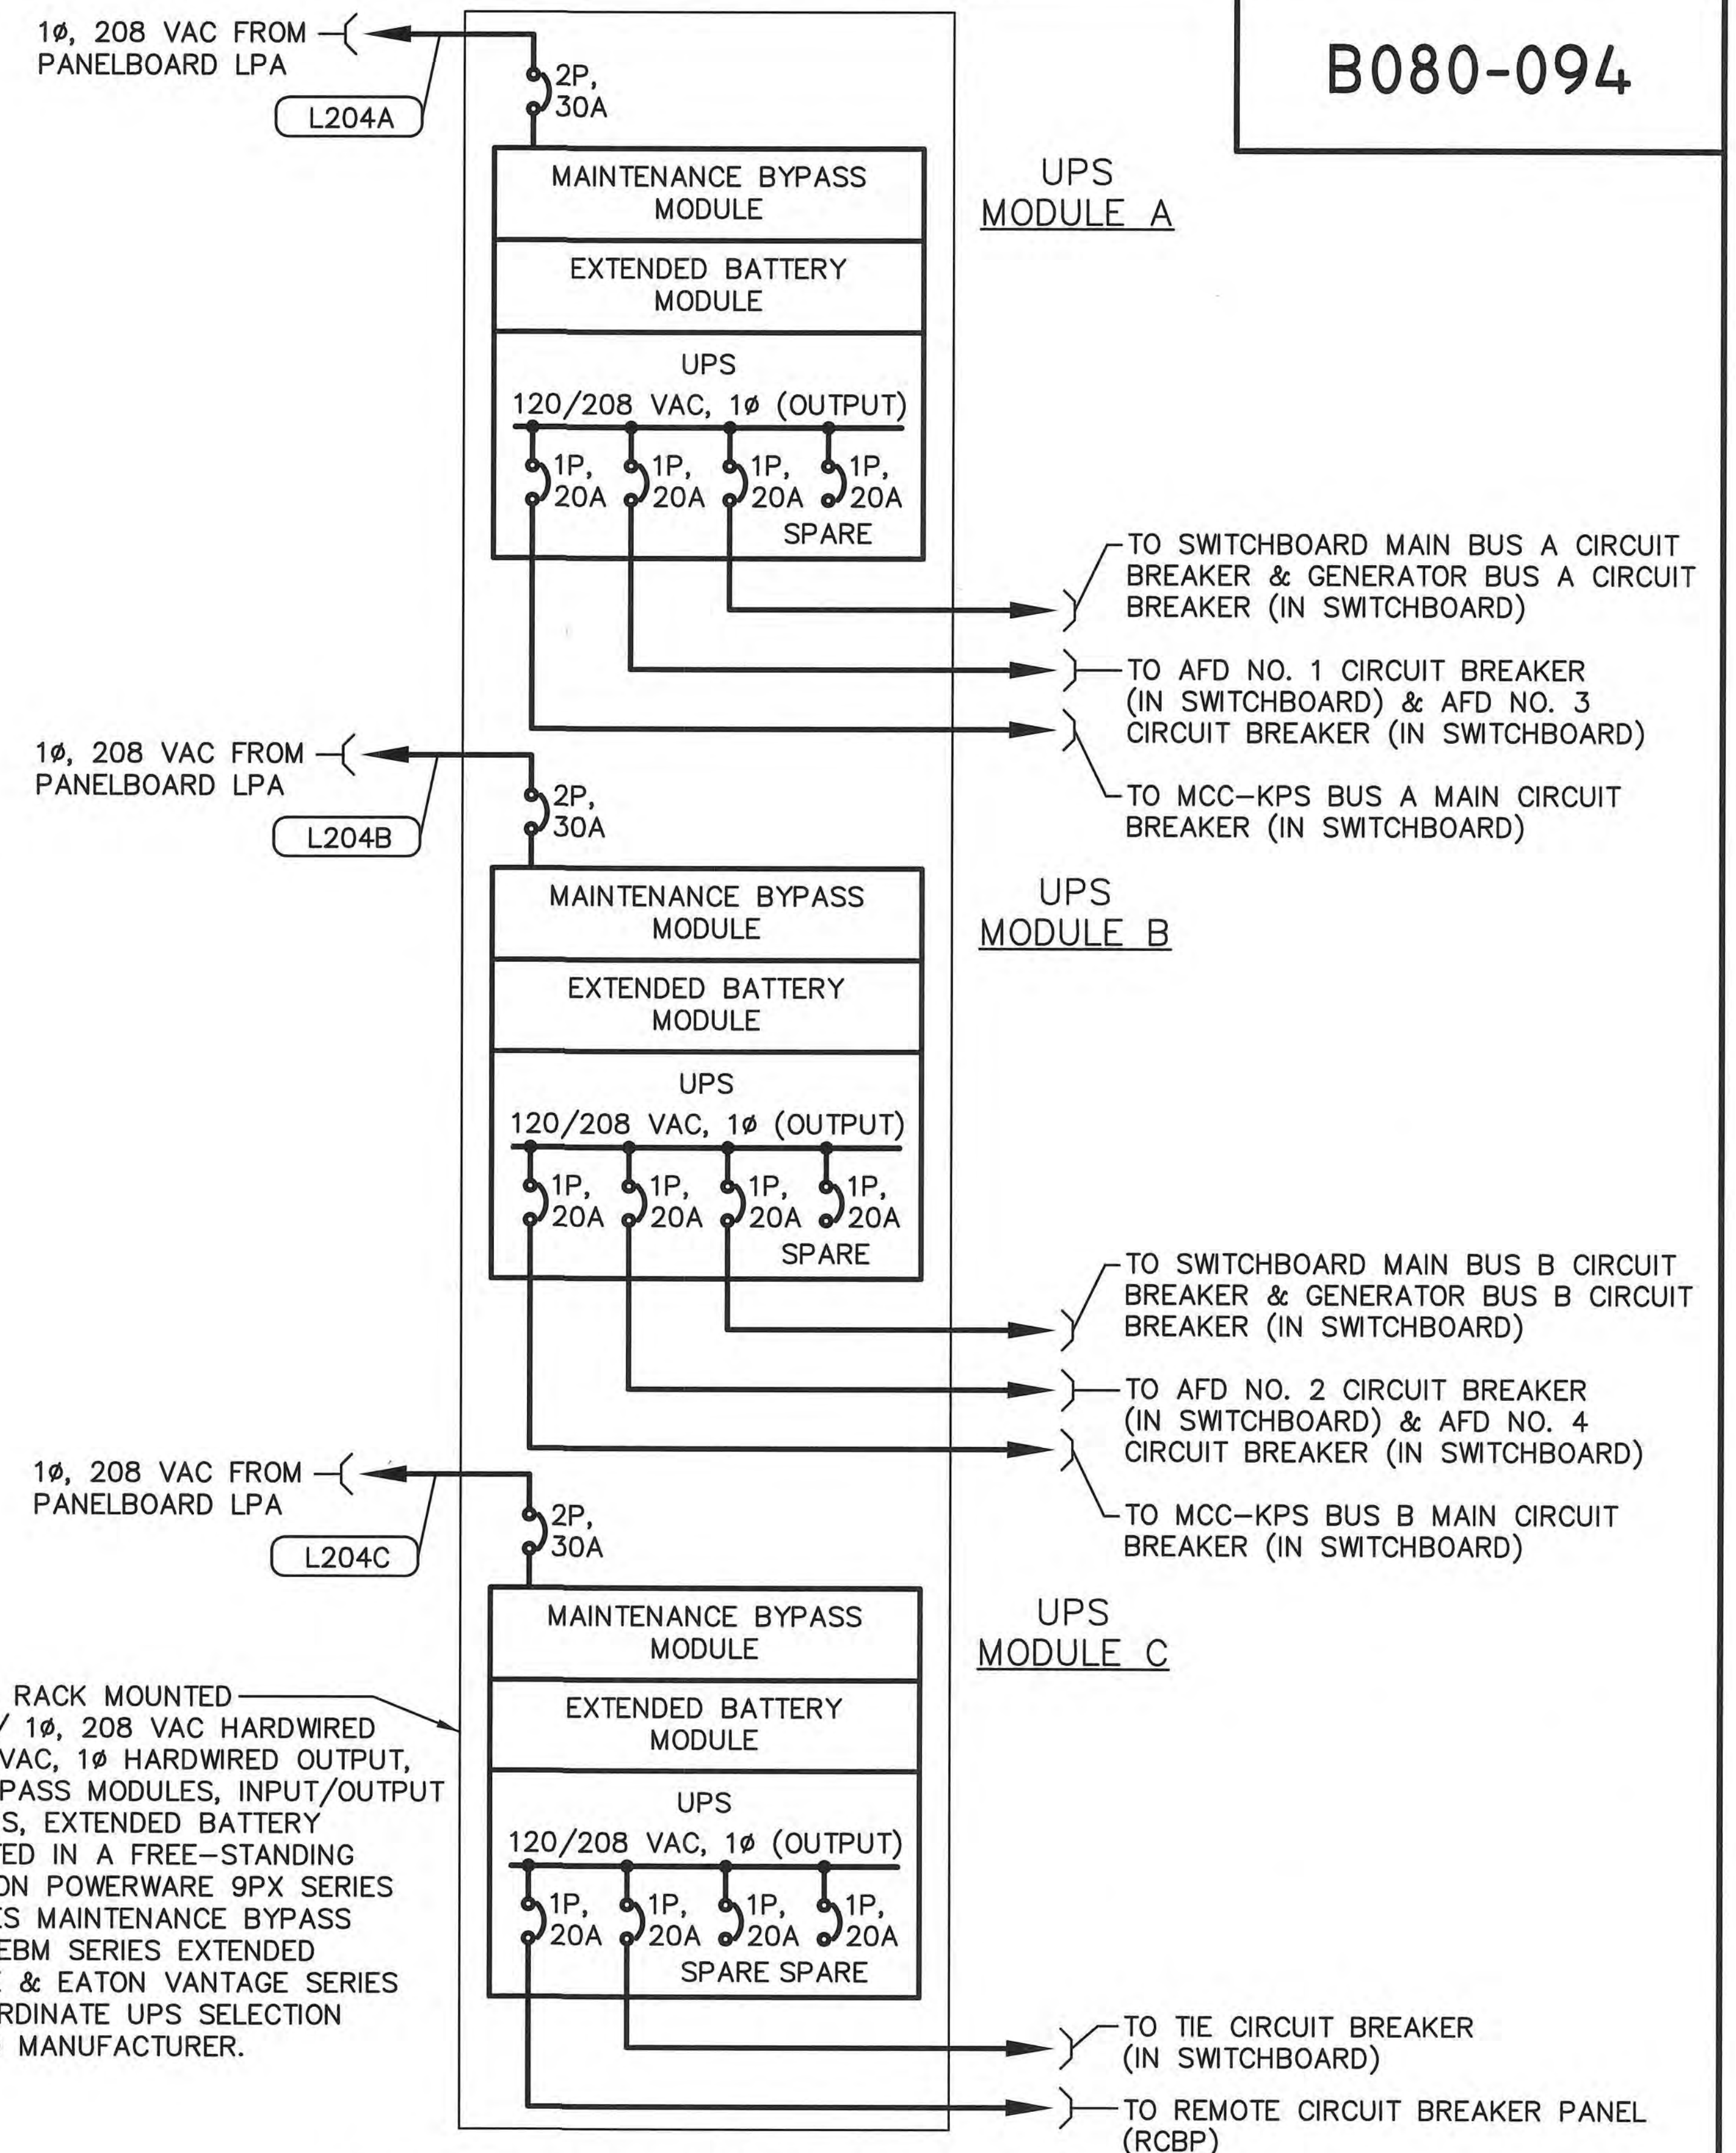

MATCHLINE - REFERENCE SHEET E-34 FOR CONTINUATION

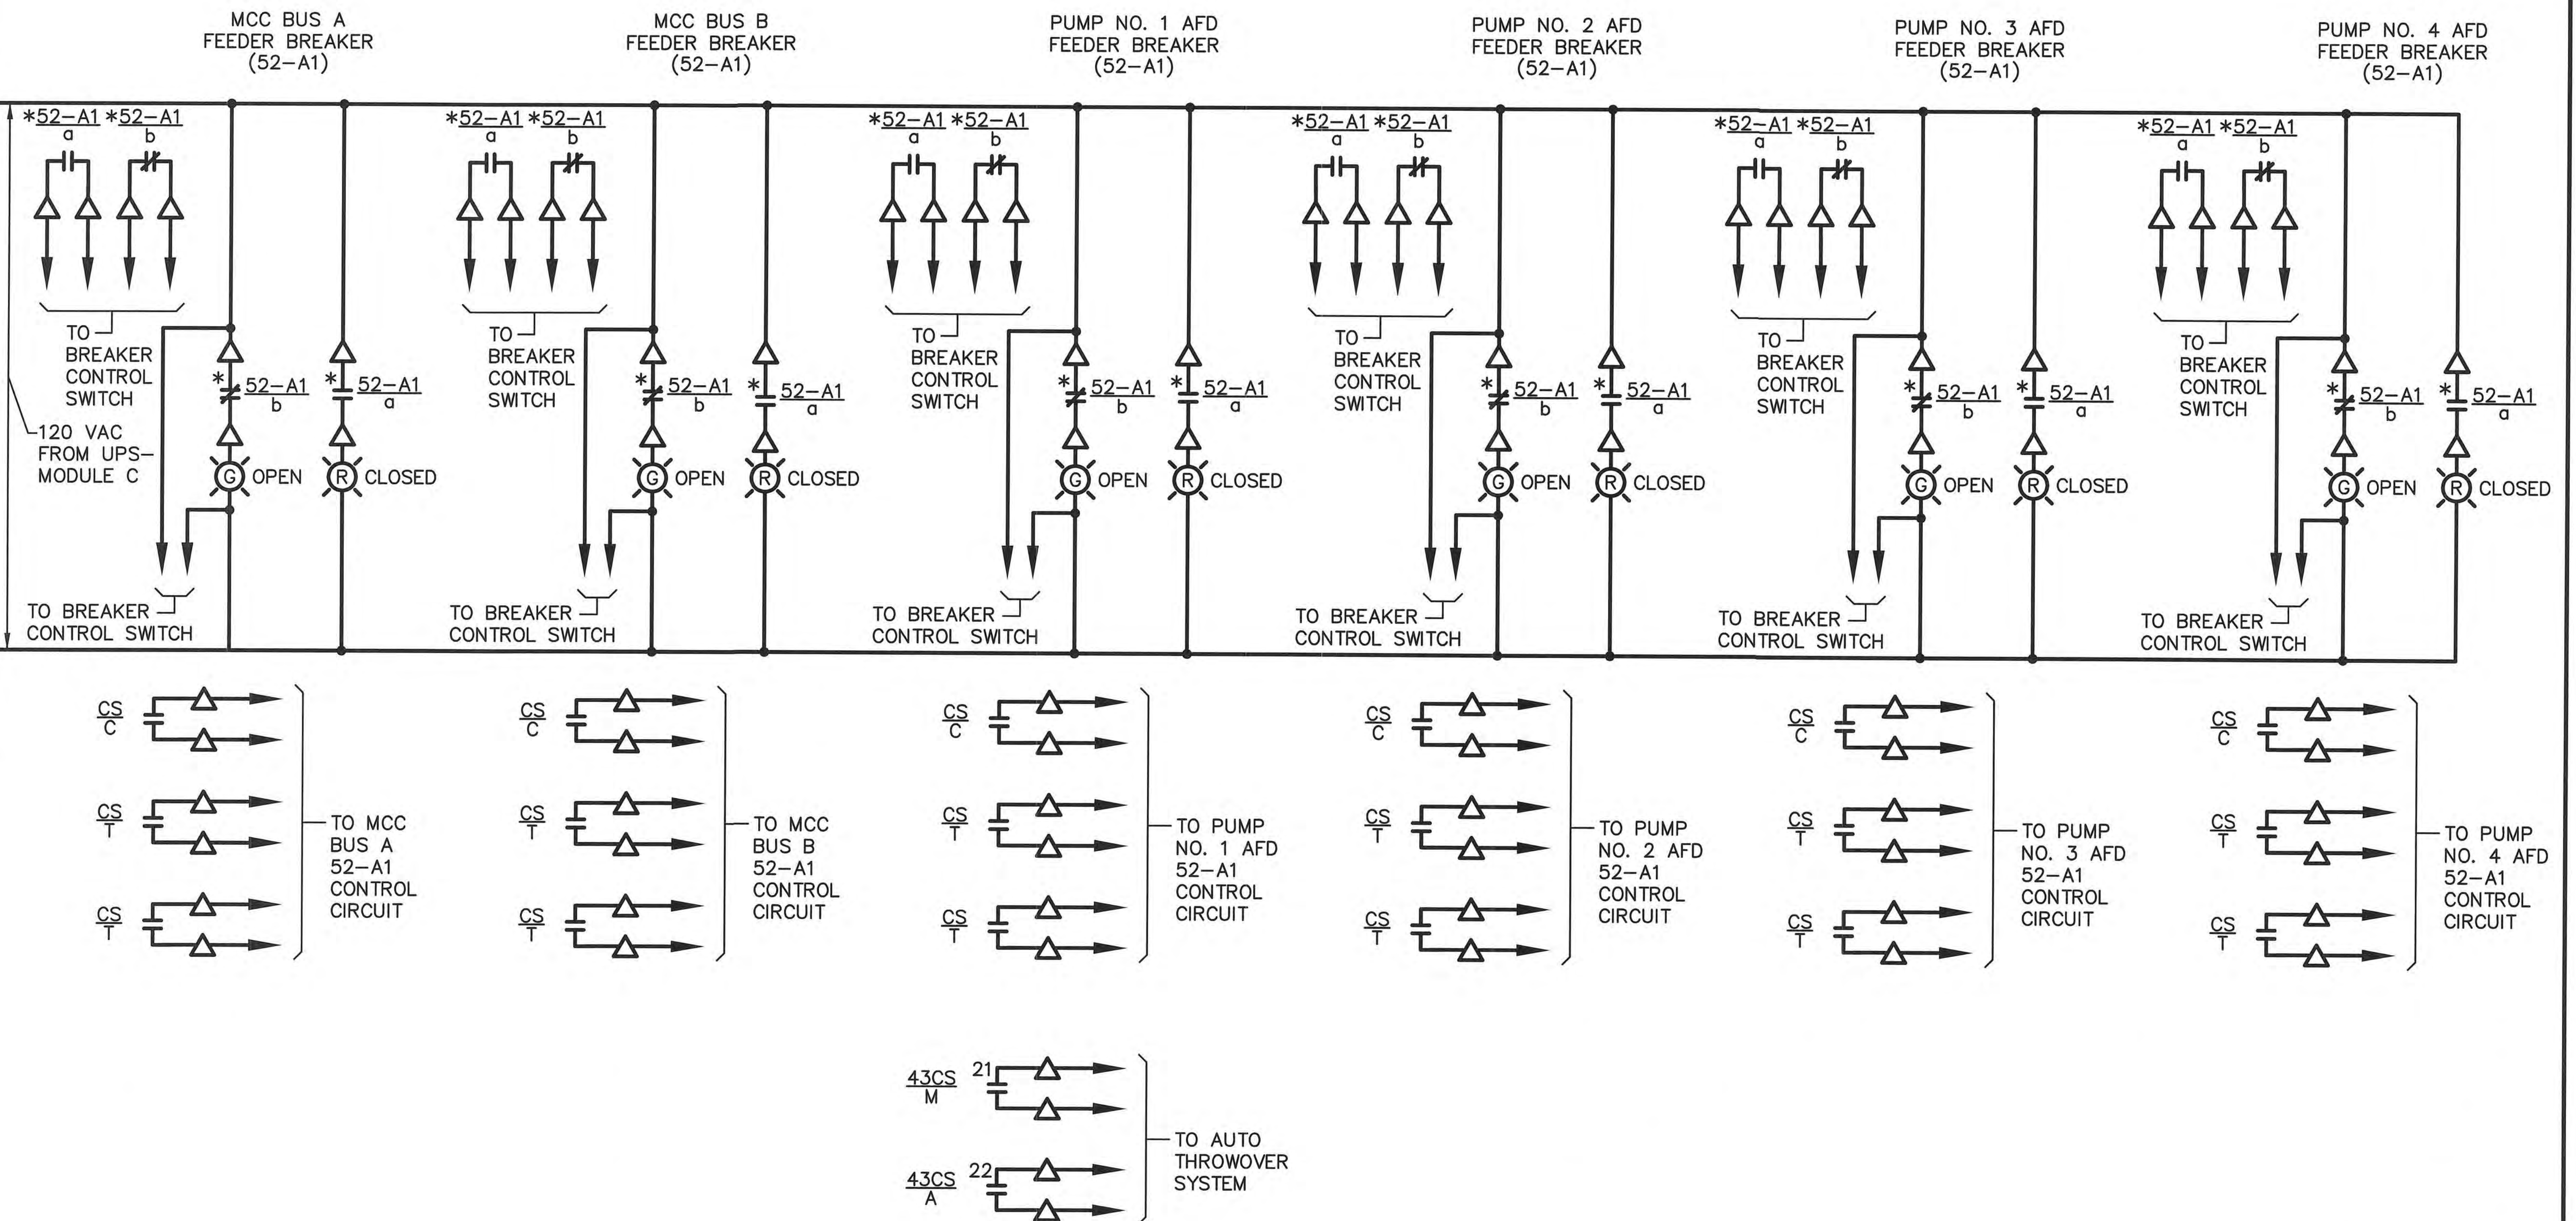

NOTES:

* INDICATES DEVICE LOCATED REMOTE FROM REMOTE CIRCUIT BREAKER PANEL.

△ DENOTES TERMINAL FOR FIELD CONNECTION.

ENGINEER OF RECORD:
BOB E. HALLMAN, P.E.
FLORIDA REGISTRATION NO. 20761



**Engineering Design
Technologies Corp.**
P.O. Box 152403
Tampa, FL 33684-2403
813.289.8080
813.282.9184 FAX
engineering@edt1.com

Certificate of Authorization Number: 4795

CITY of TAMPA
WASTEWATER DEPARTMENT

KRAUSE PS REHABILITATION



REMOTE CIRCUIT BREAKER
PANEL (RCBP) DETAILS
(SHEET 3 OF 3)

NO.	DATE	REVISIONS			


DRAWN: RWB
DESIGN: STK
QC: BEH
DATE: 05/01/14

SHEET E-35





B080-097

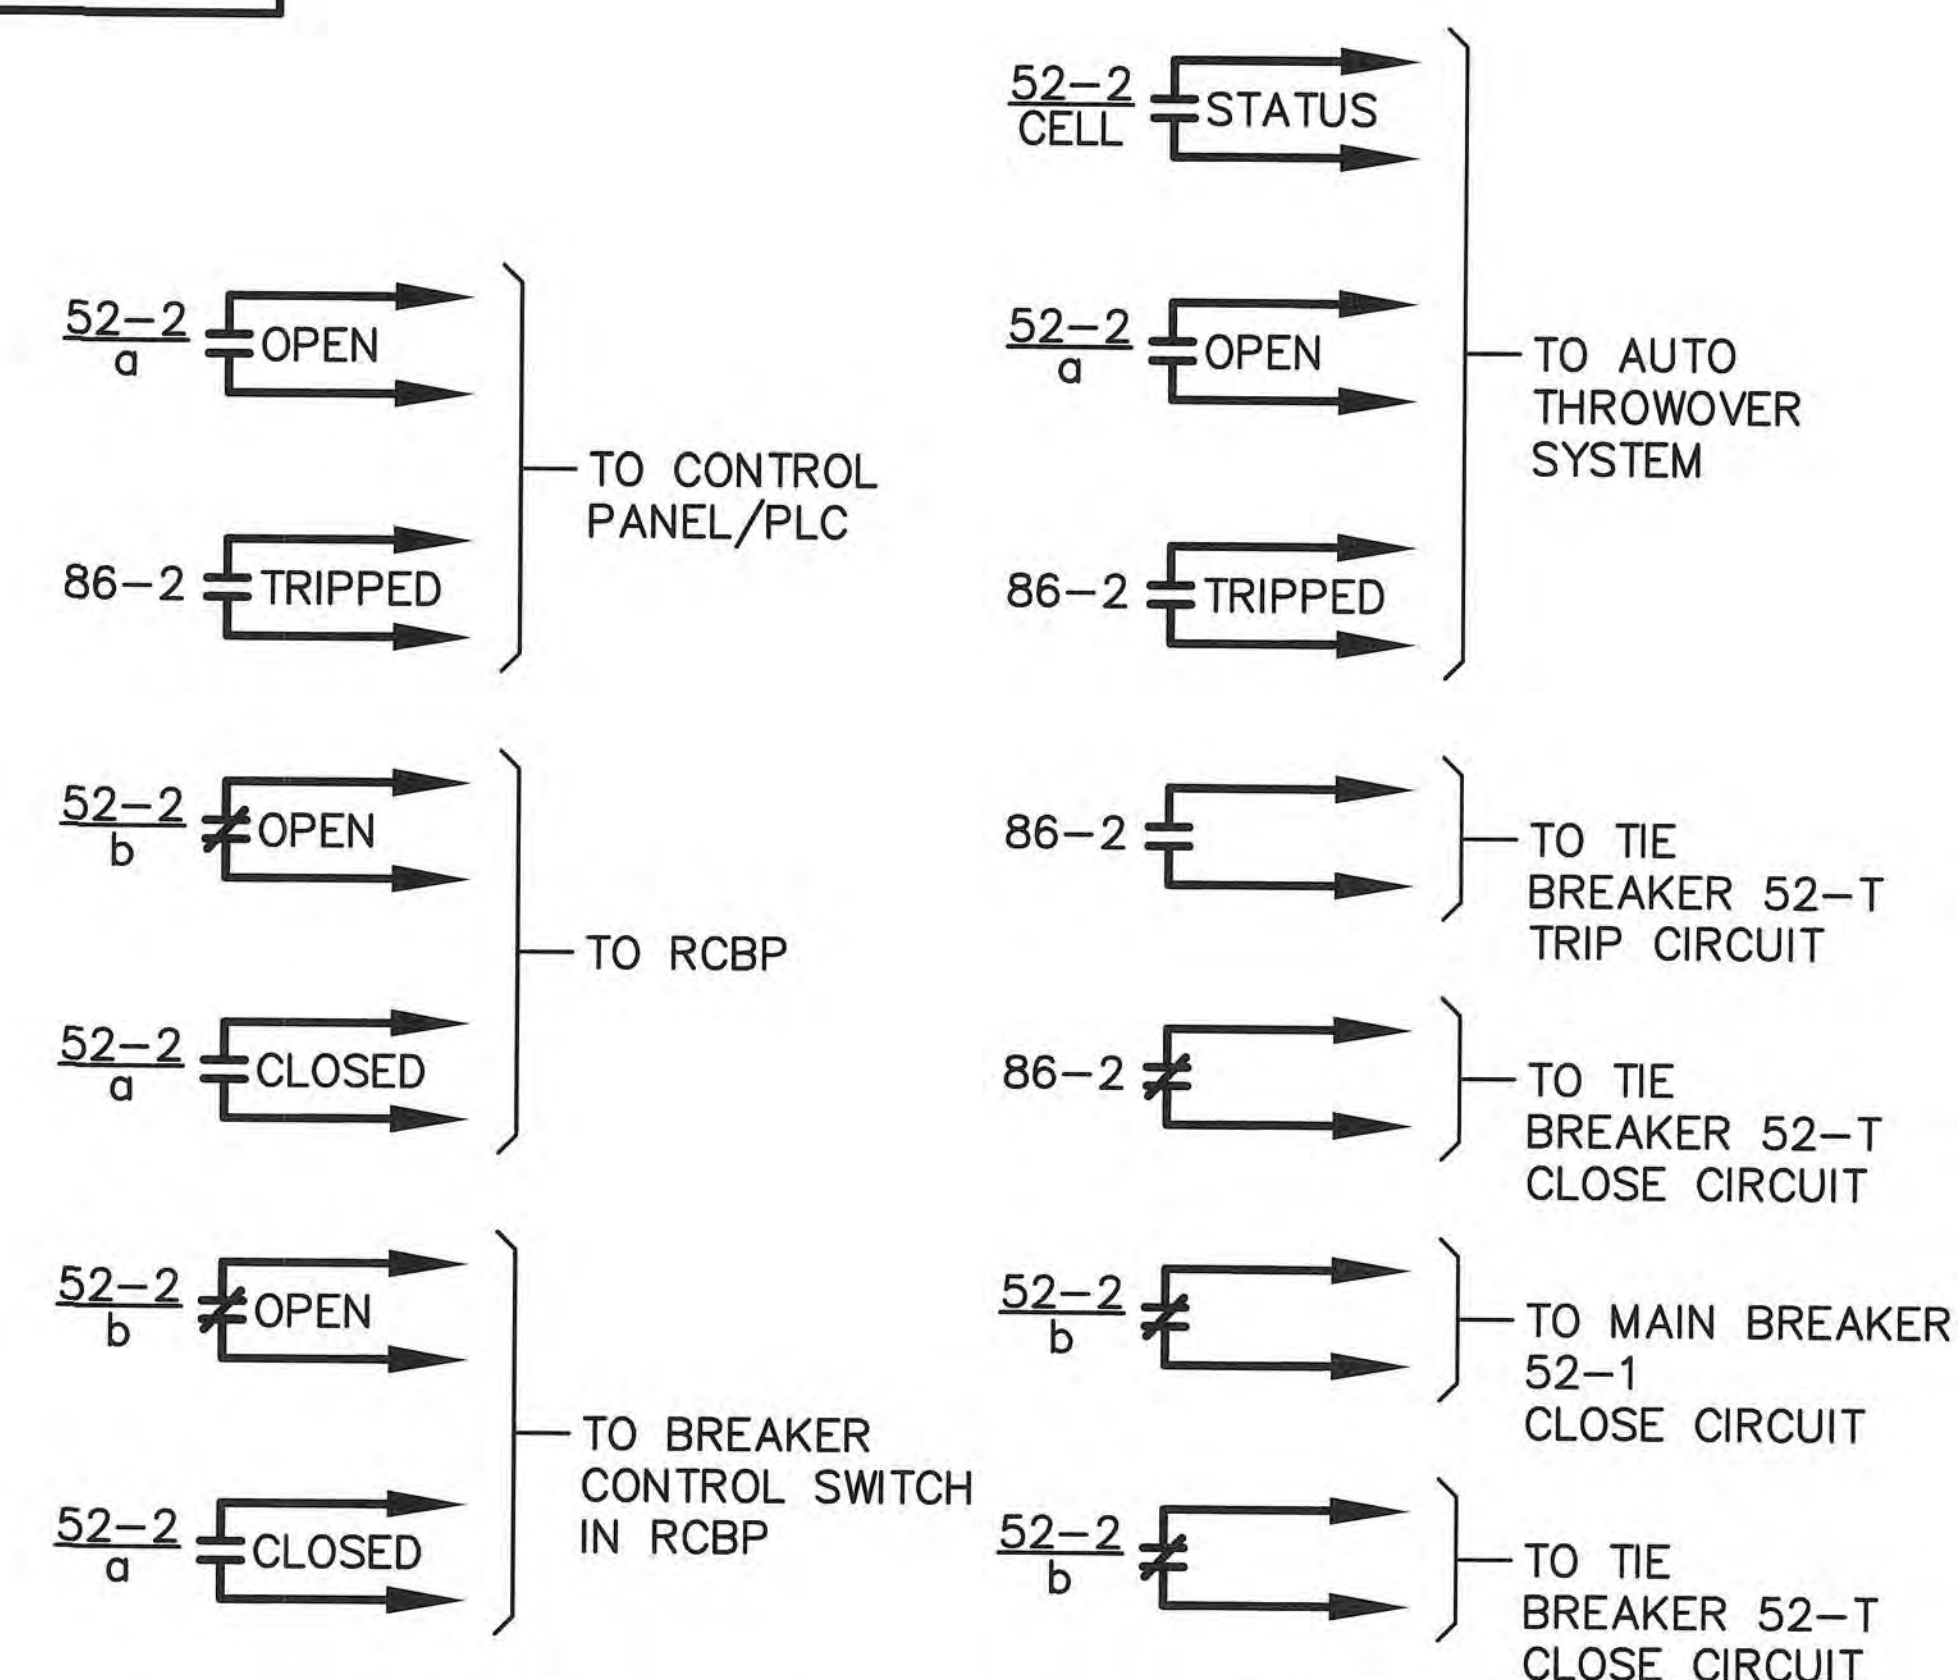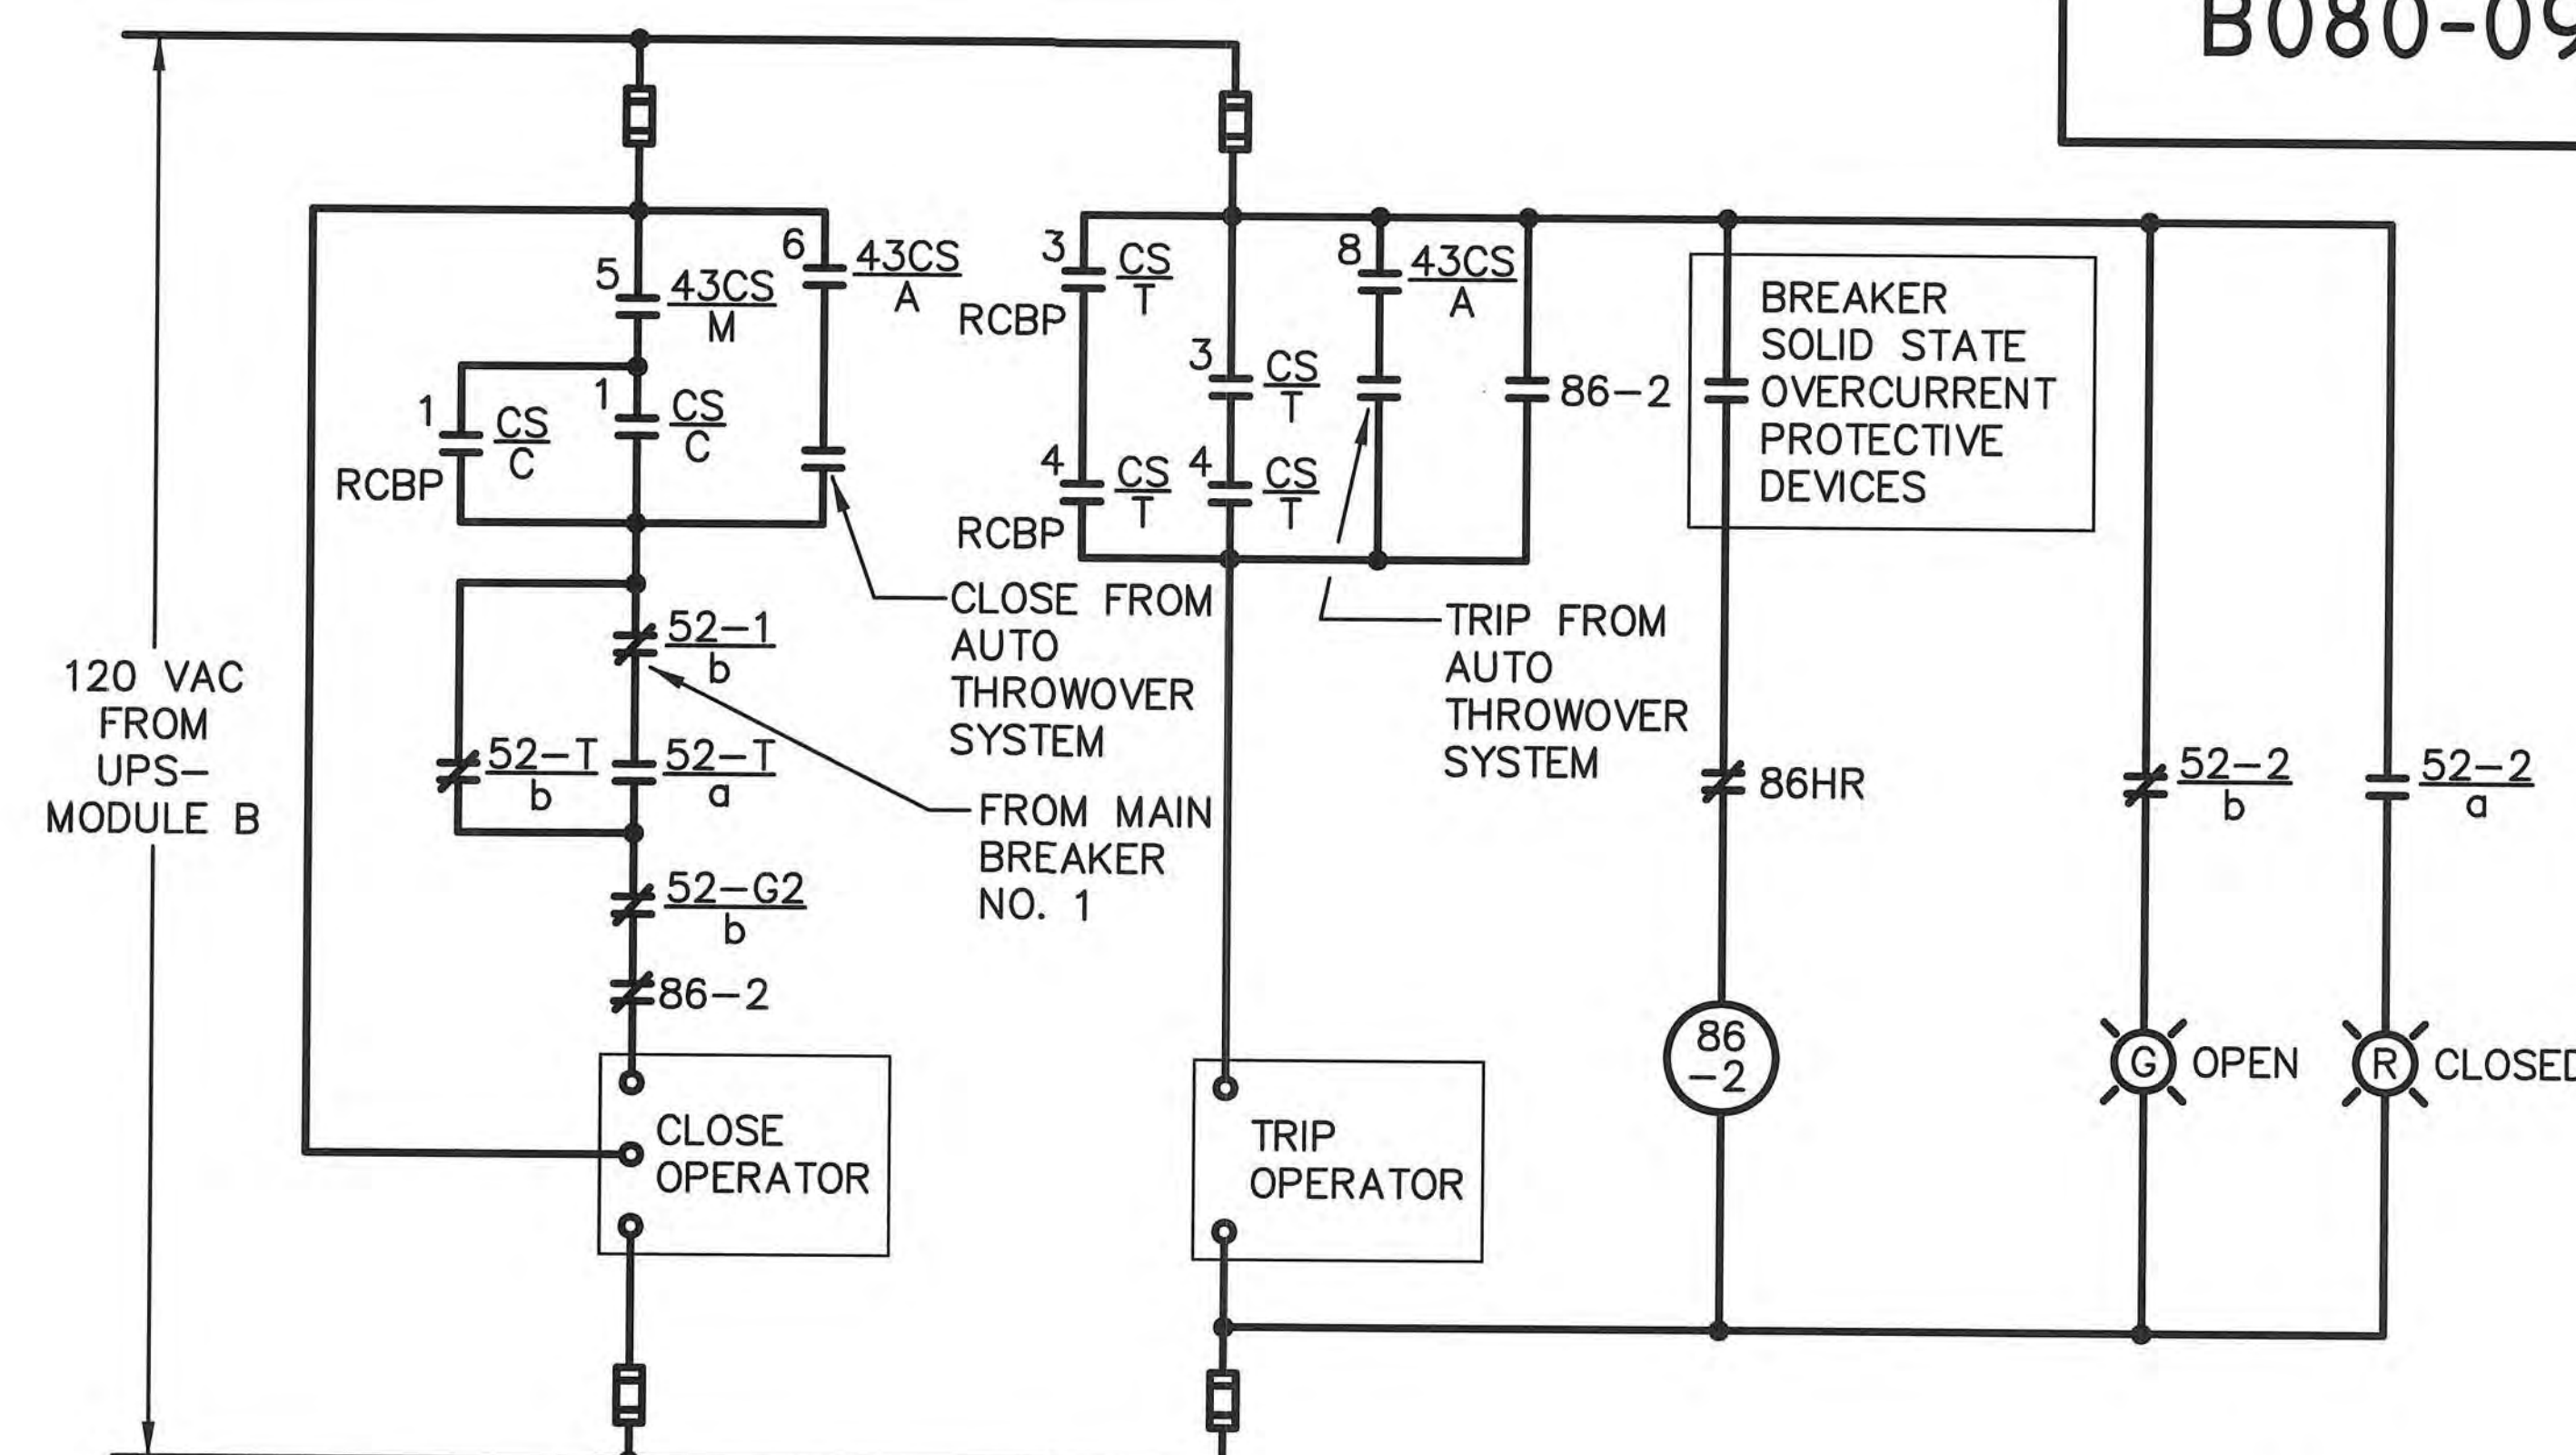

MAIN BREAKER KPS-B (52-2) CONTROL CIRCUIT

 <p>Engineering Design Technologies Corp. P.O. Box 152403 Tampa, FL 33684-2403 813.289.8080 813.282.9184 FAX engineering@edt1.com</p> <p>Certificate of Authorization Number: 4795</p>	<p>CITY of TAMPA</p> <p>WASTEWATER DEPARTMENT</p>	KRAUSE PS REHABILITATION									DRAWN: RWB DESIGN: STK QC: BEH DATE: 05/01/14
		CIRCUIT BREAKER CONTROL DIAGRAM (SHEET 1 OF 4)									
		NO.	DATE	REVISIONS				SHEET E-36			

B080-098

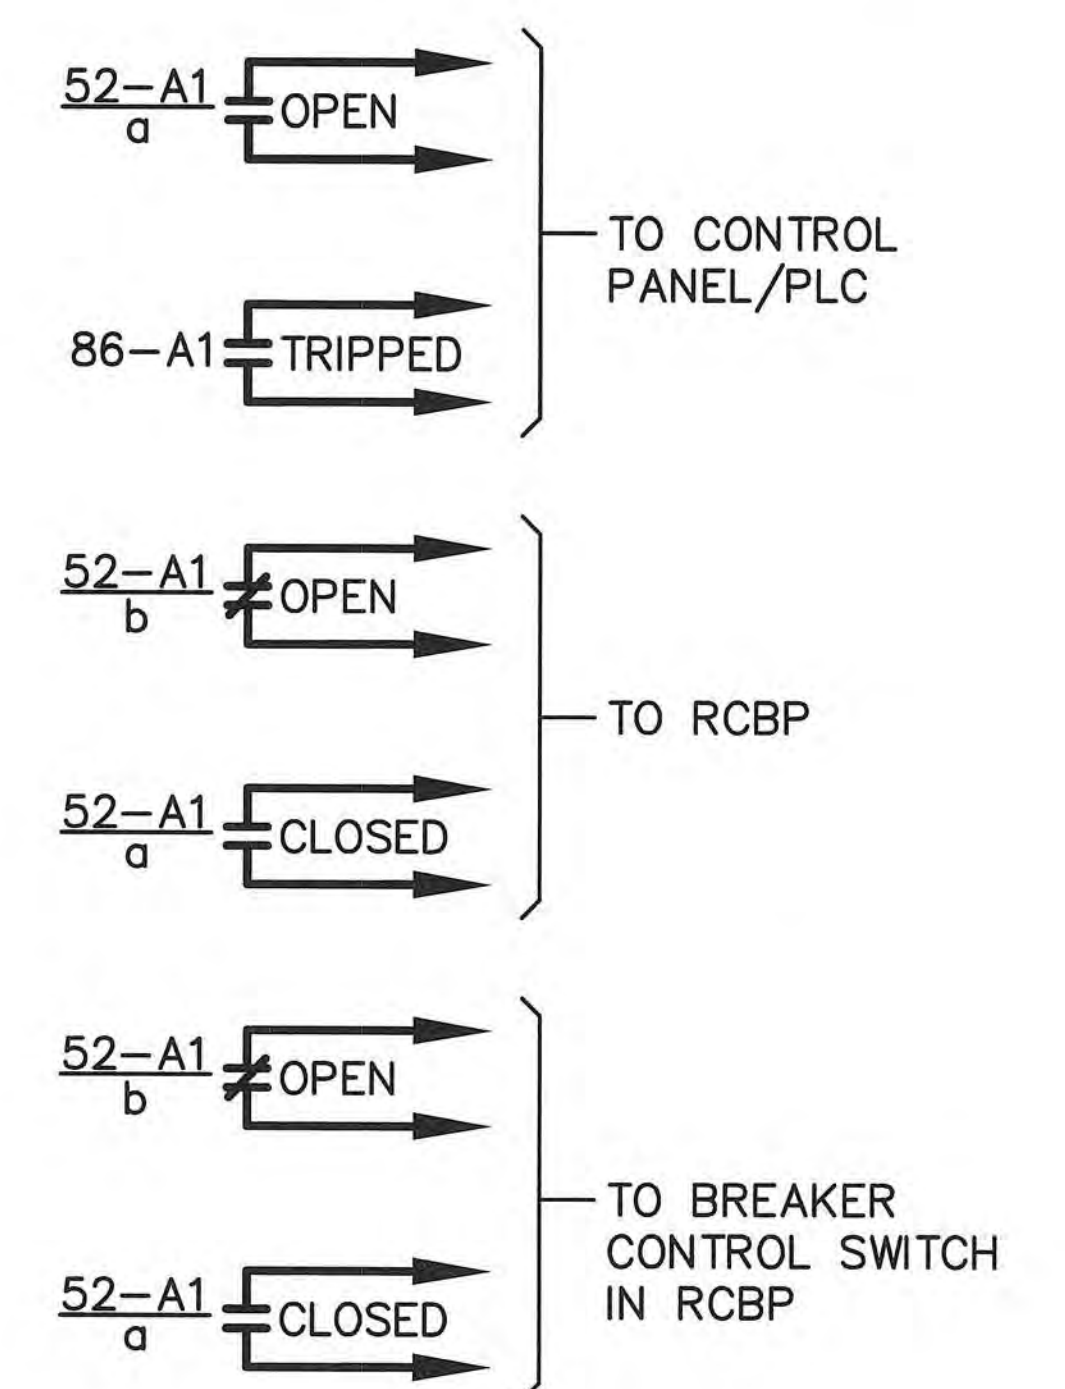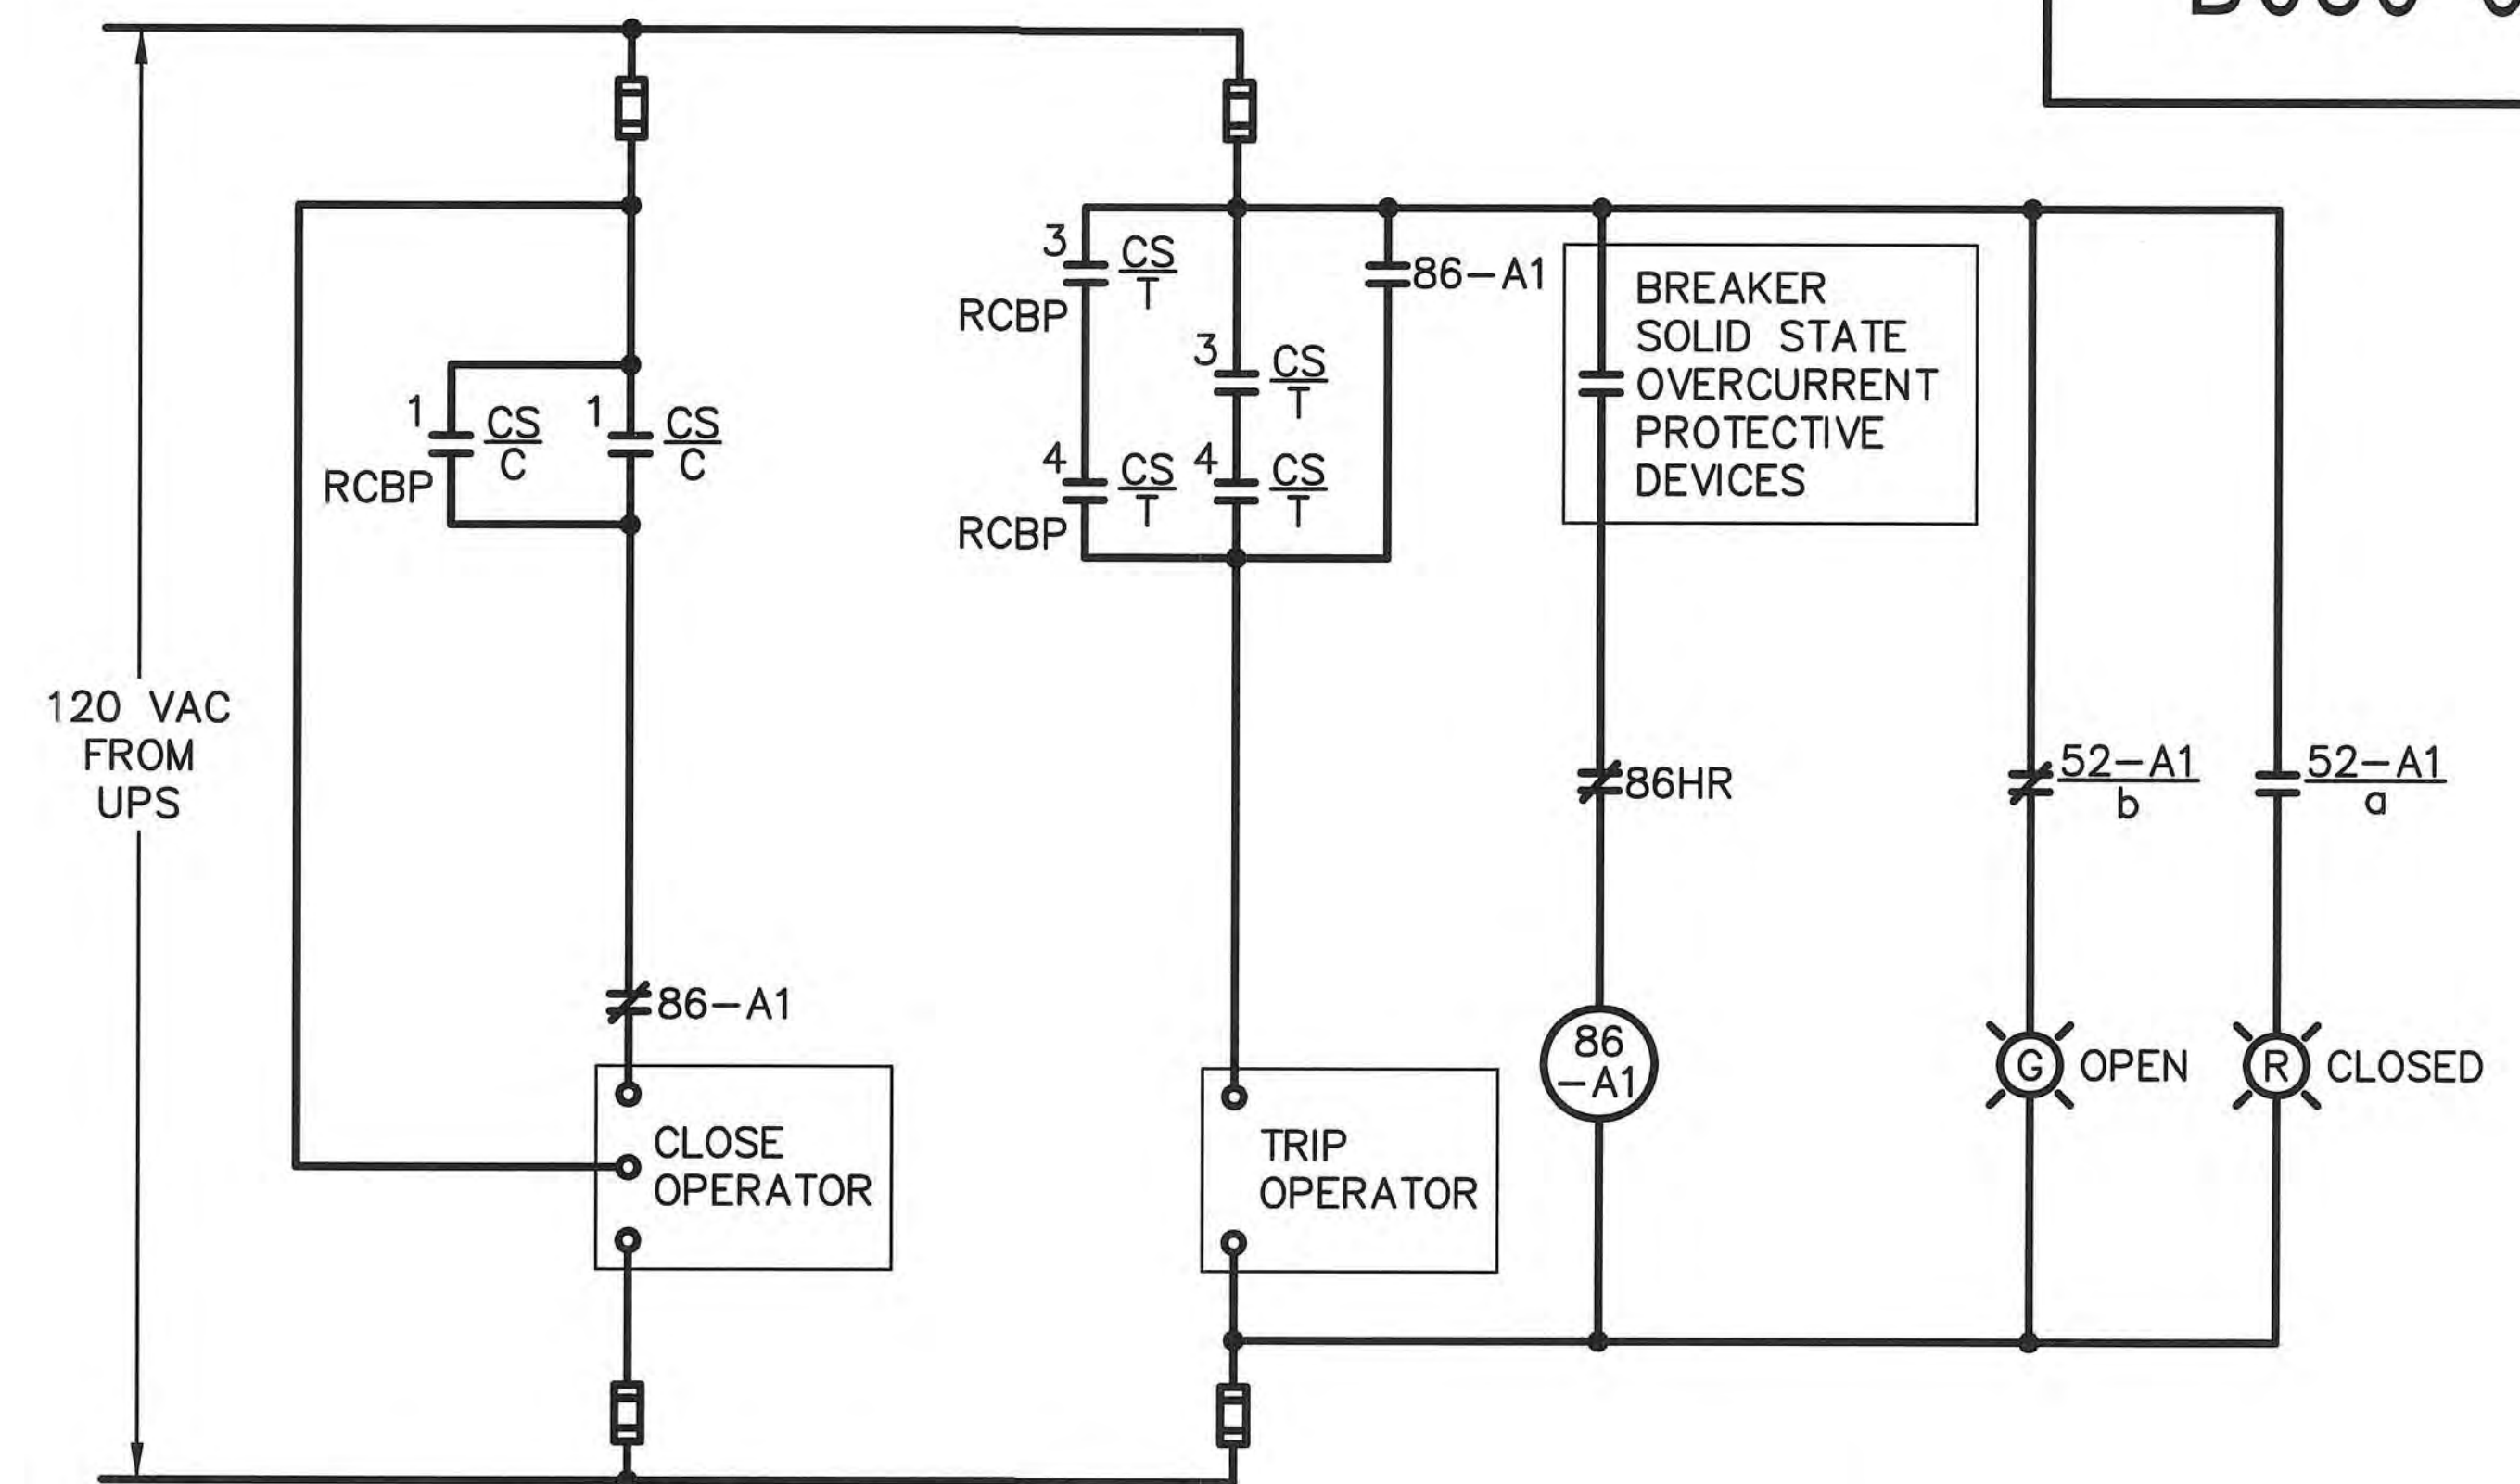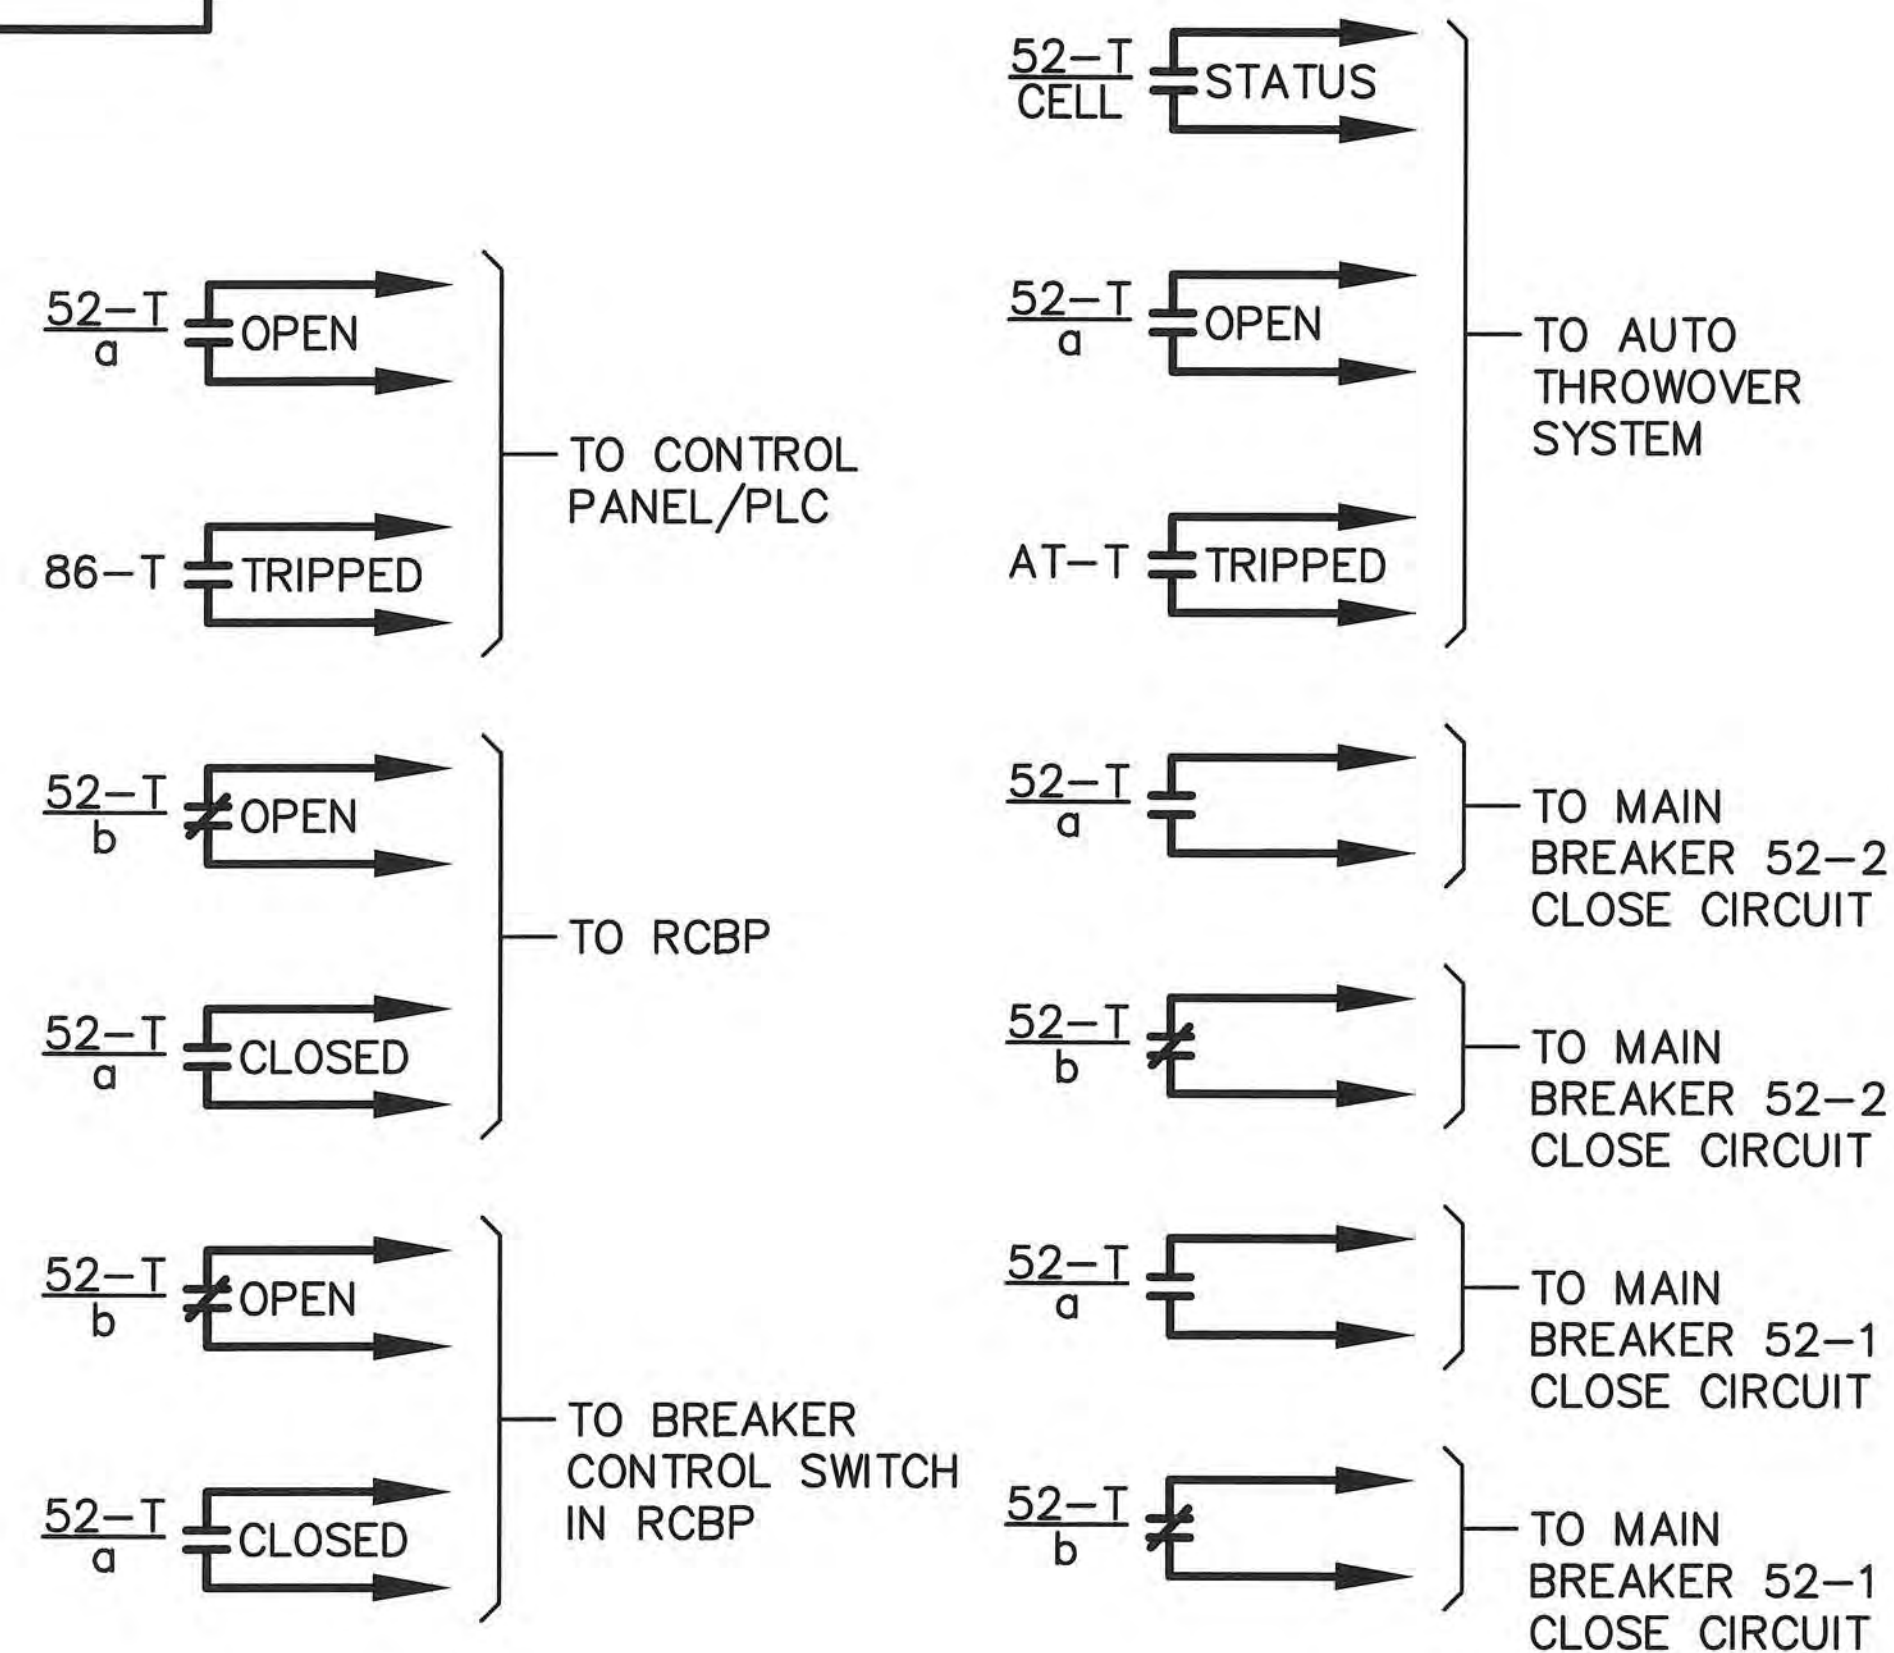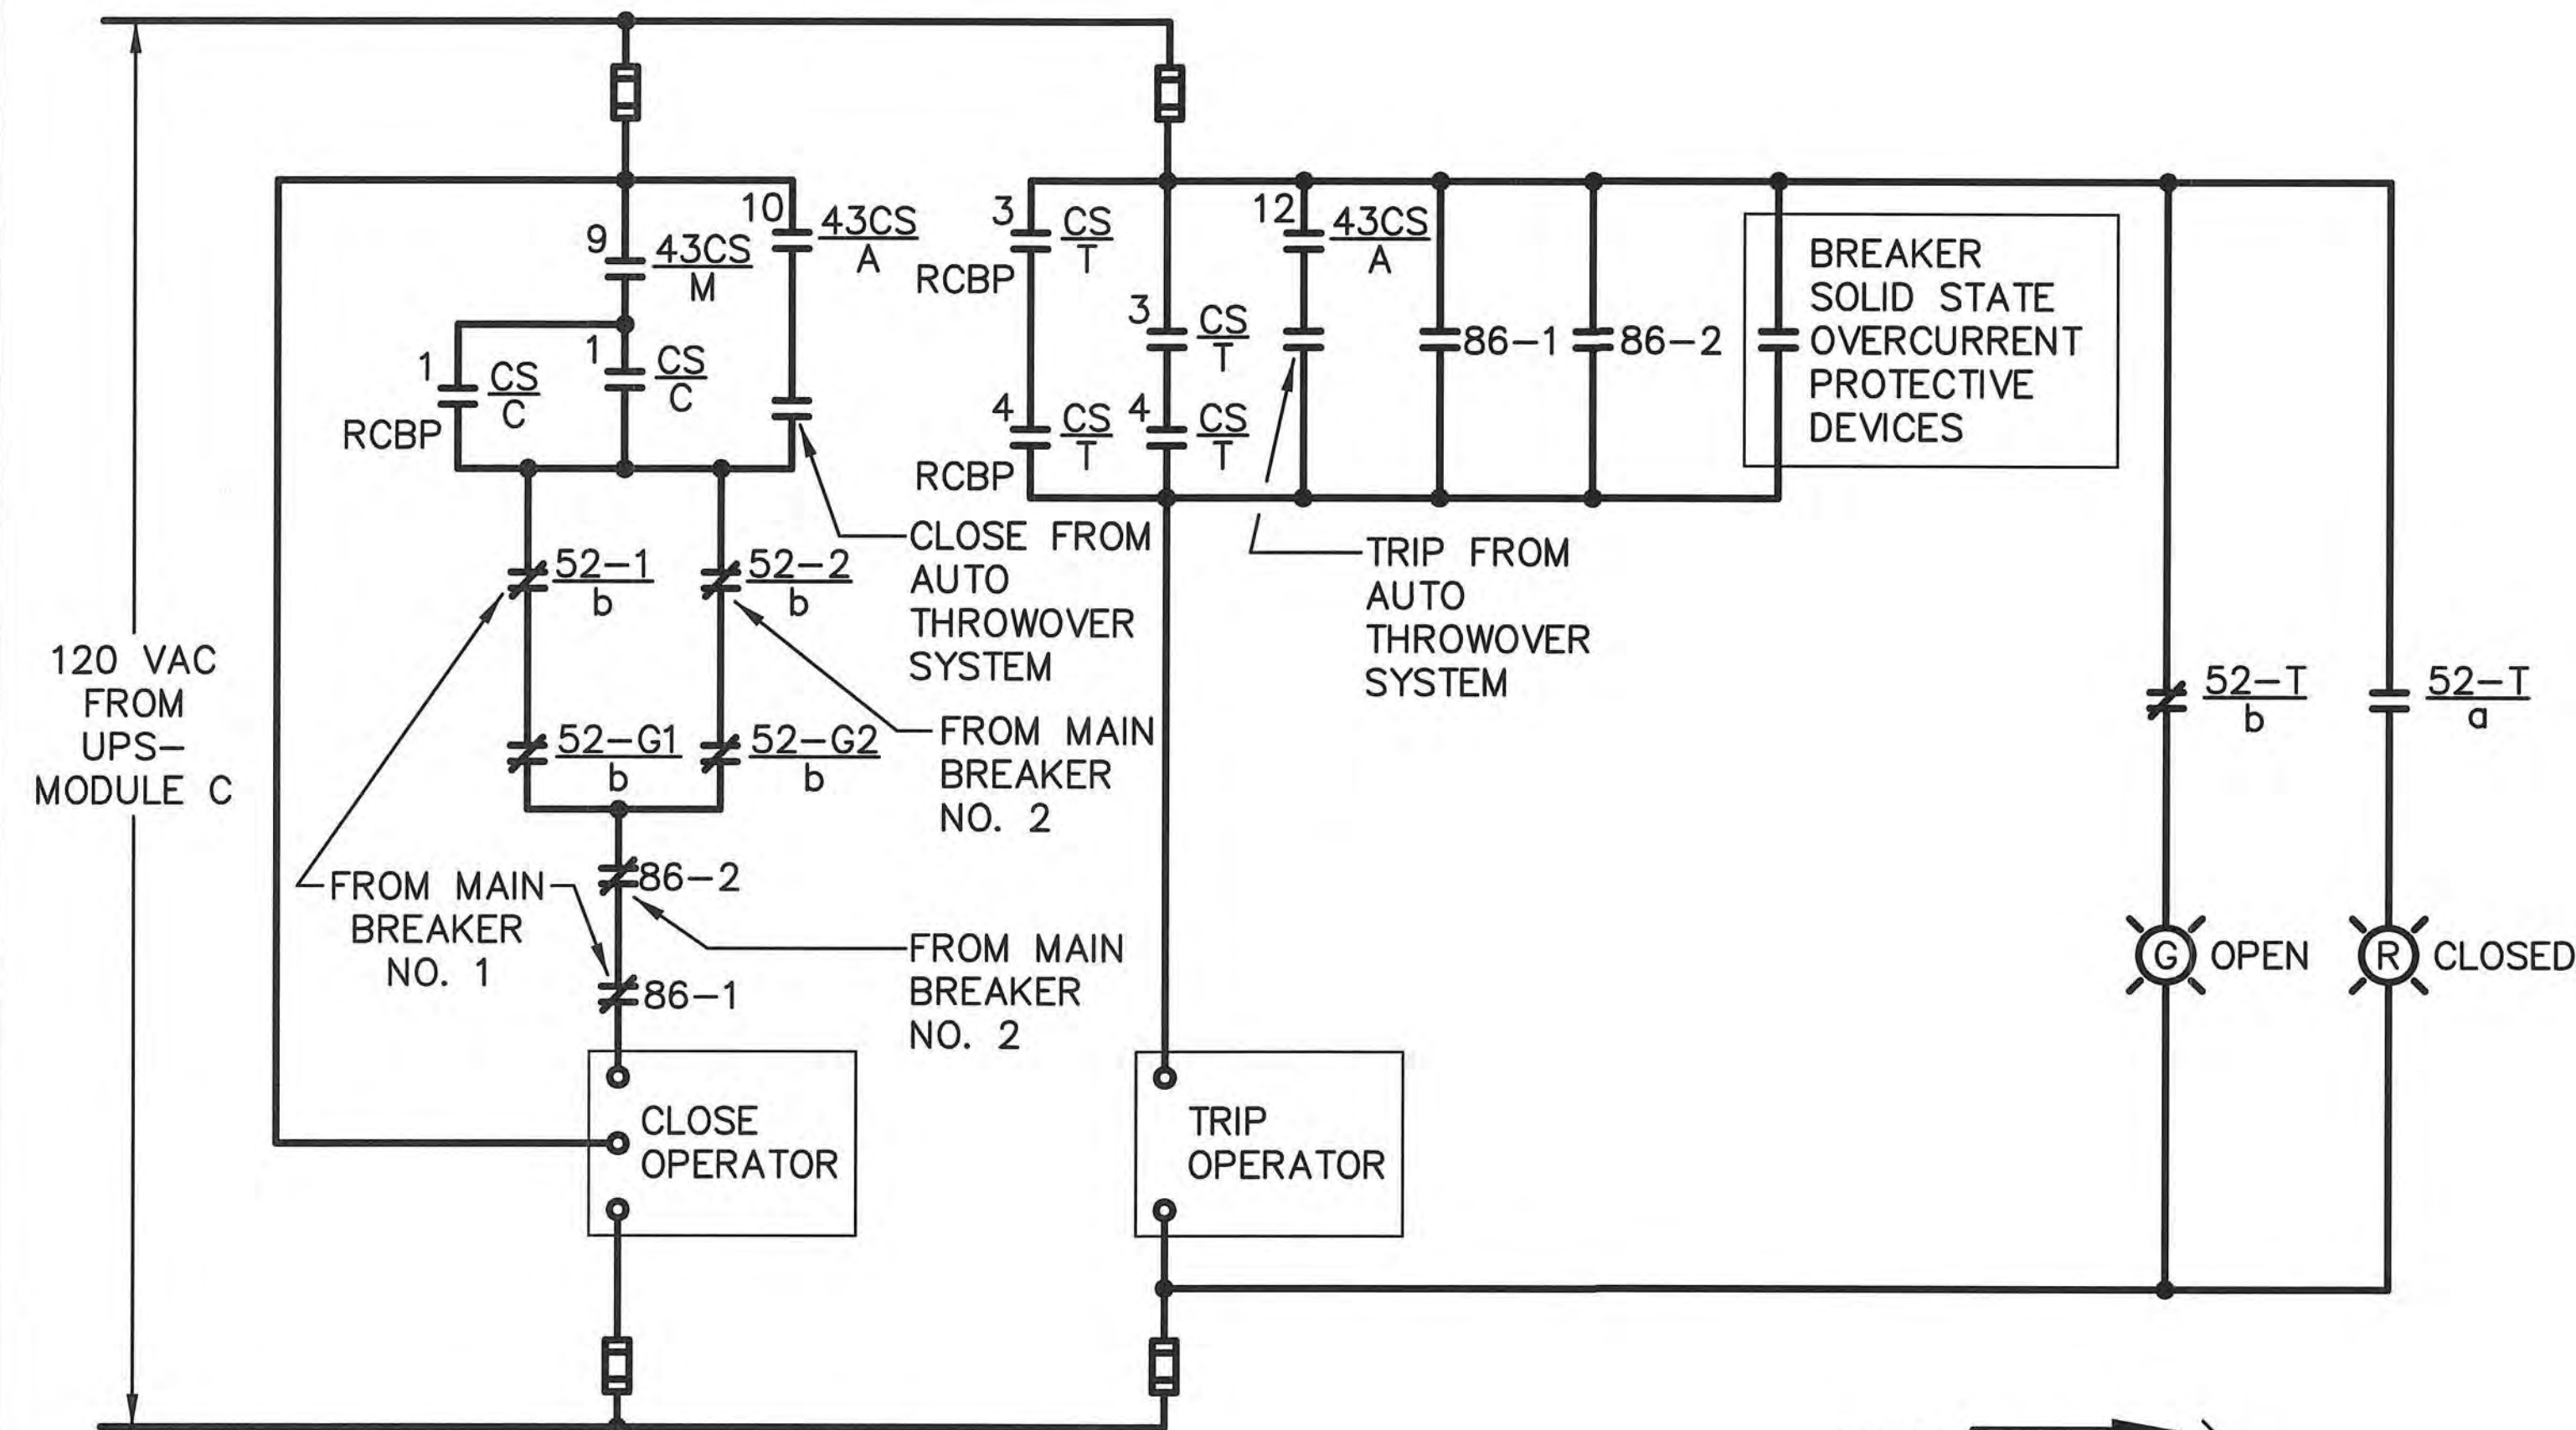

ENGINEER OF RECORD:
BOB E. HALLMAN, P.E.
FLORIDA REGISTRATION NO. 20761

TIE BREAKER CONTROL CIRCUIT

TYPICAL FEEDER BREAKER CONTROL CIRCUIT



**Engineering Design
Technologies Corp.**
P.O. Box 152403
Tampa, FL 33684-2403
813.289.8080
813.282.9184 FAX
engineering@edt1.com

CITY of TAMPA
WASTEWATER DEPARTMENT

KRAUSE PS REHABILITATION



**CIRCUIT BREAKER CONTROL DIAGRAM
(SHEET 2 OF 4)**

NO.	DATE	REVISIONS



DRAWN: RWB
DESIGN: STK
QC: BEH
DATE: 05/01/14

SHEET E-37

Certificate of Authorization Number: 4795

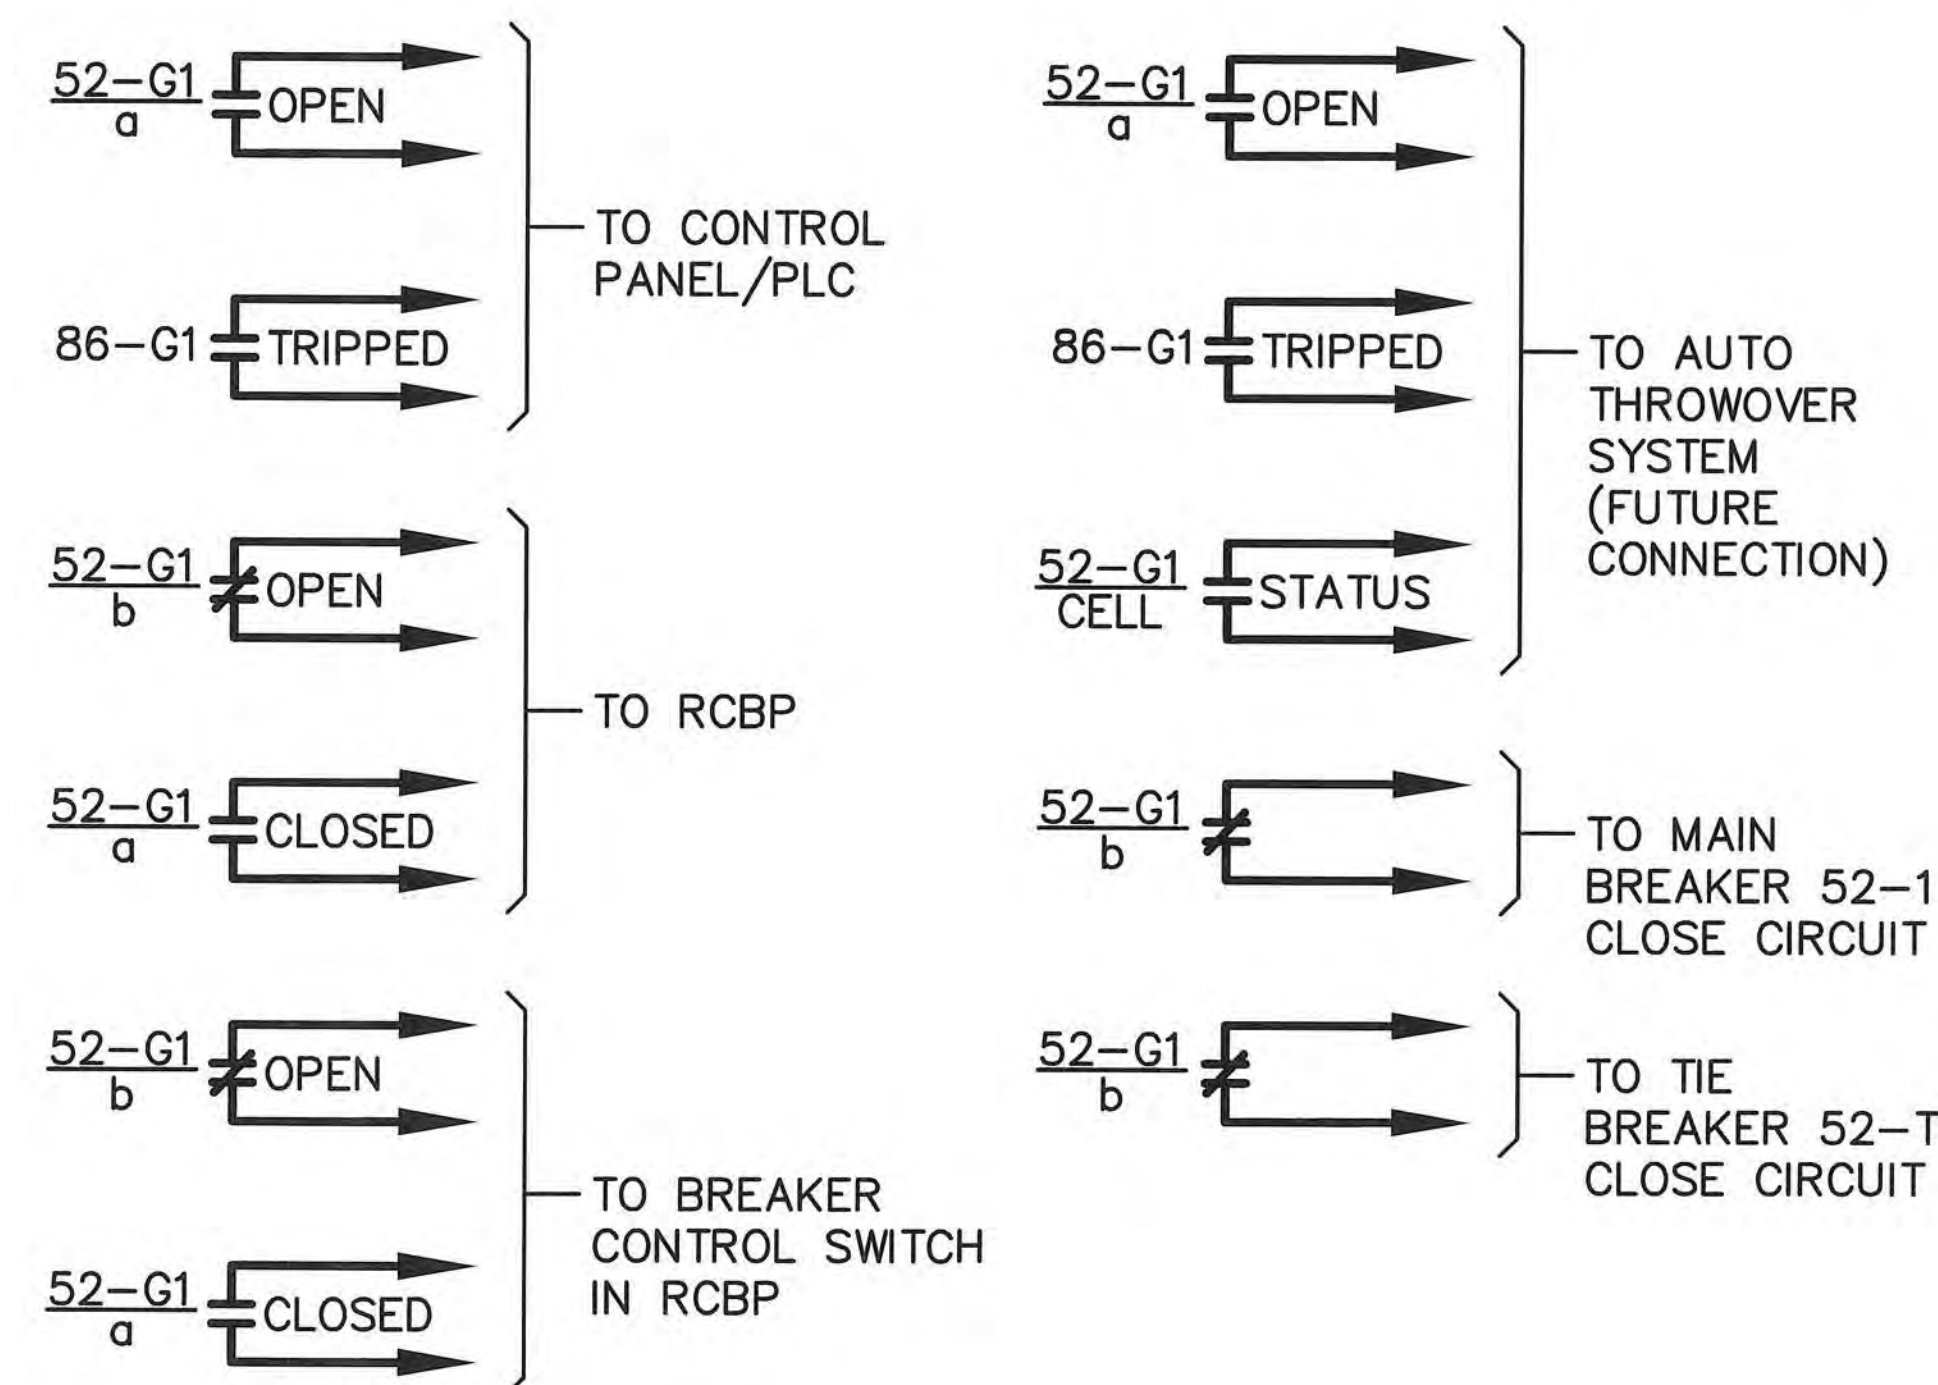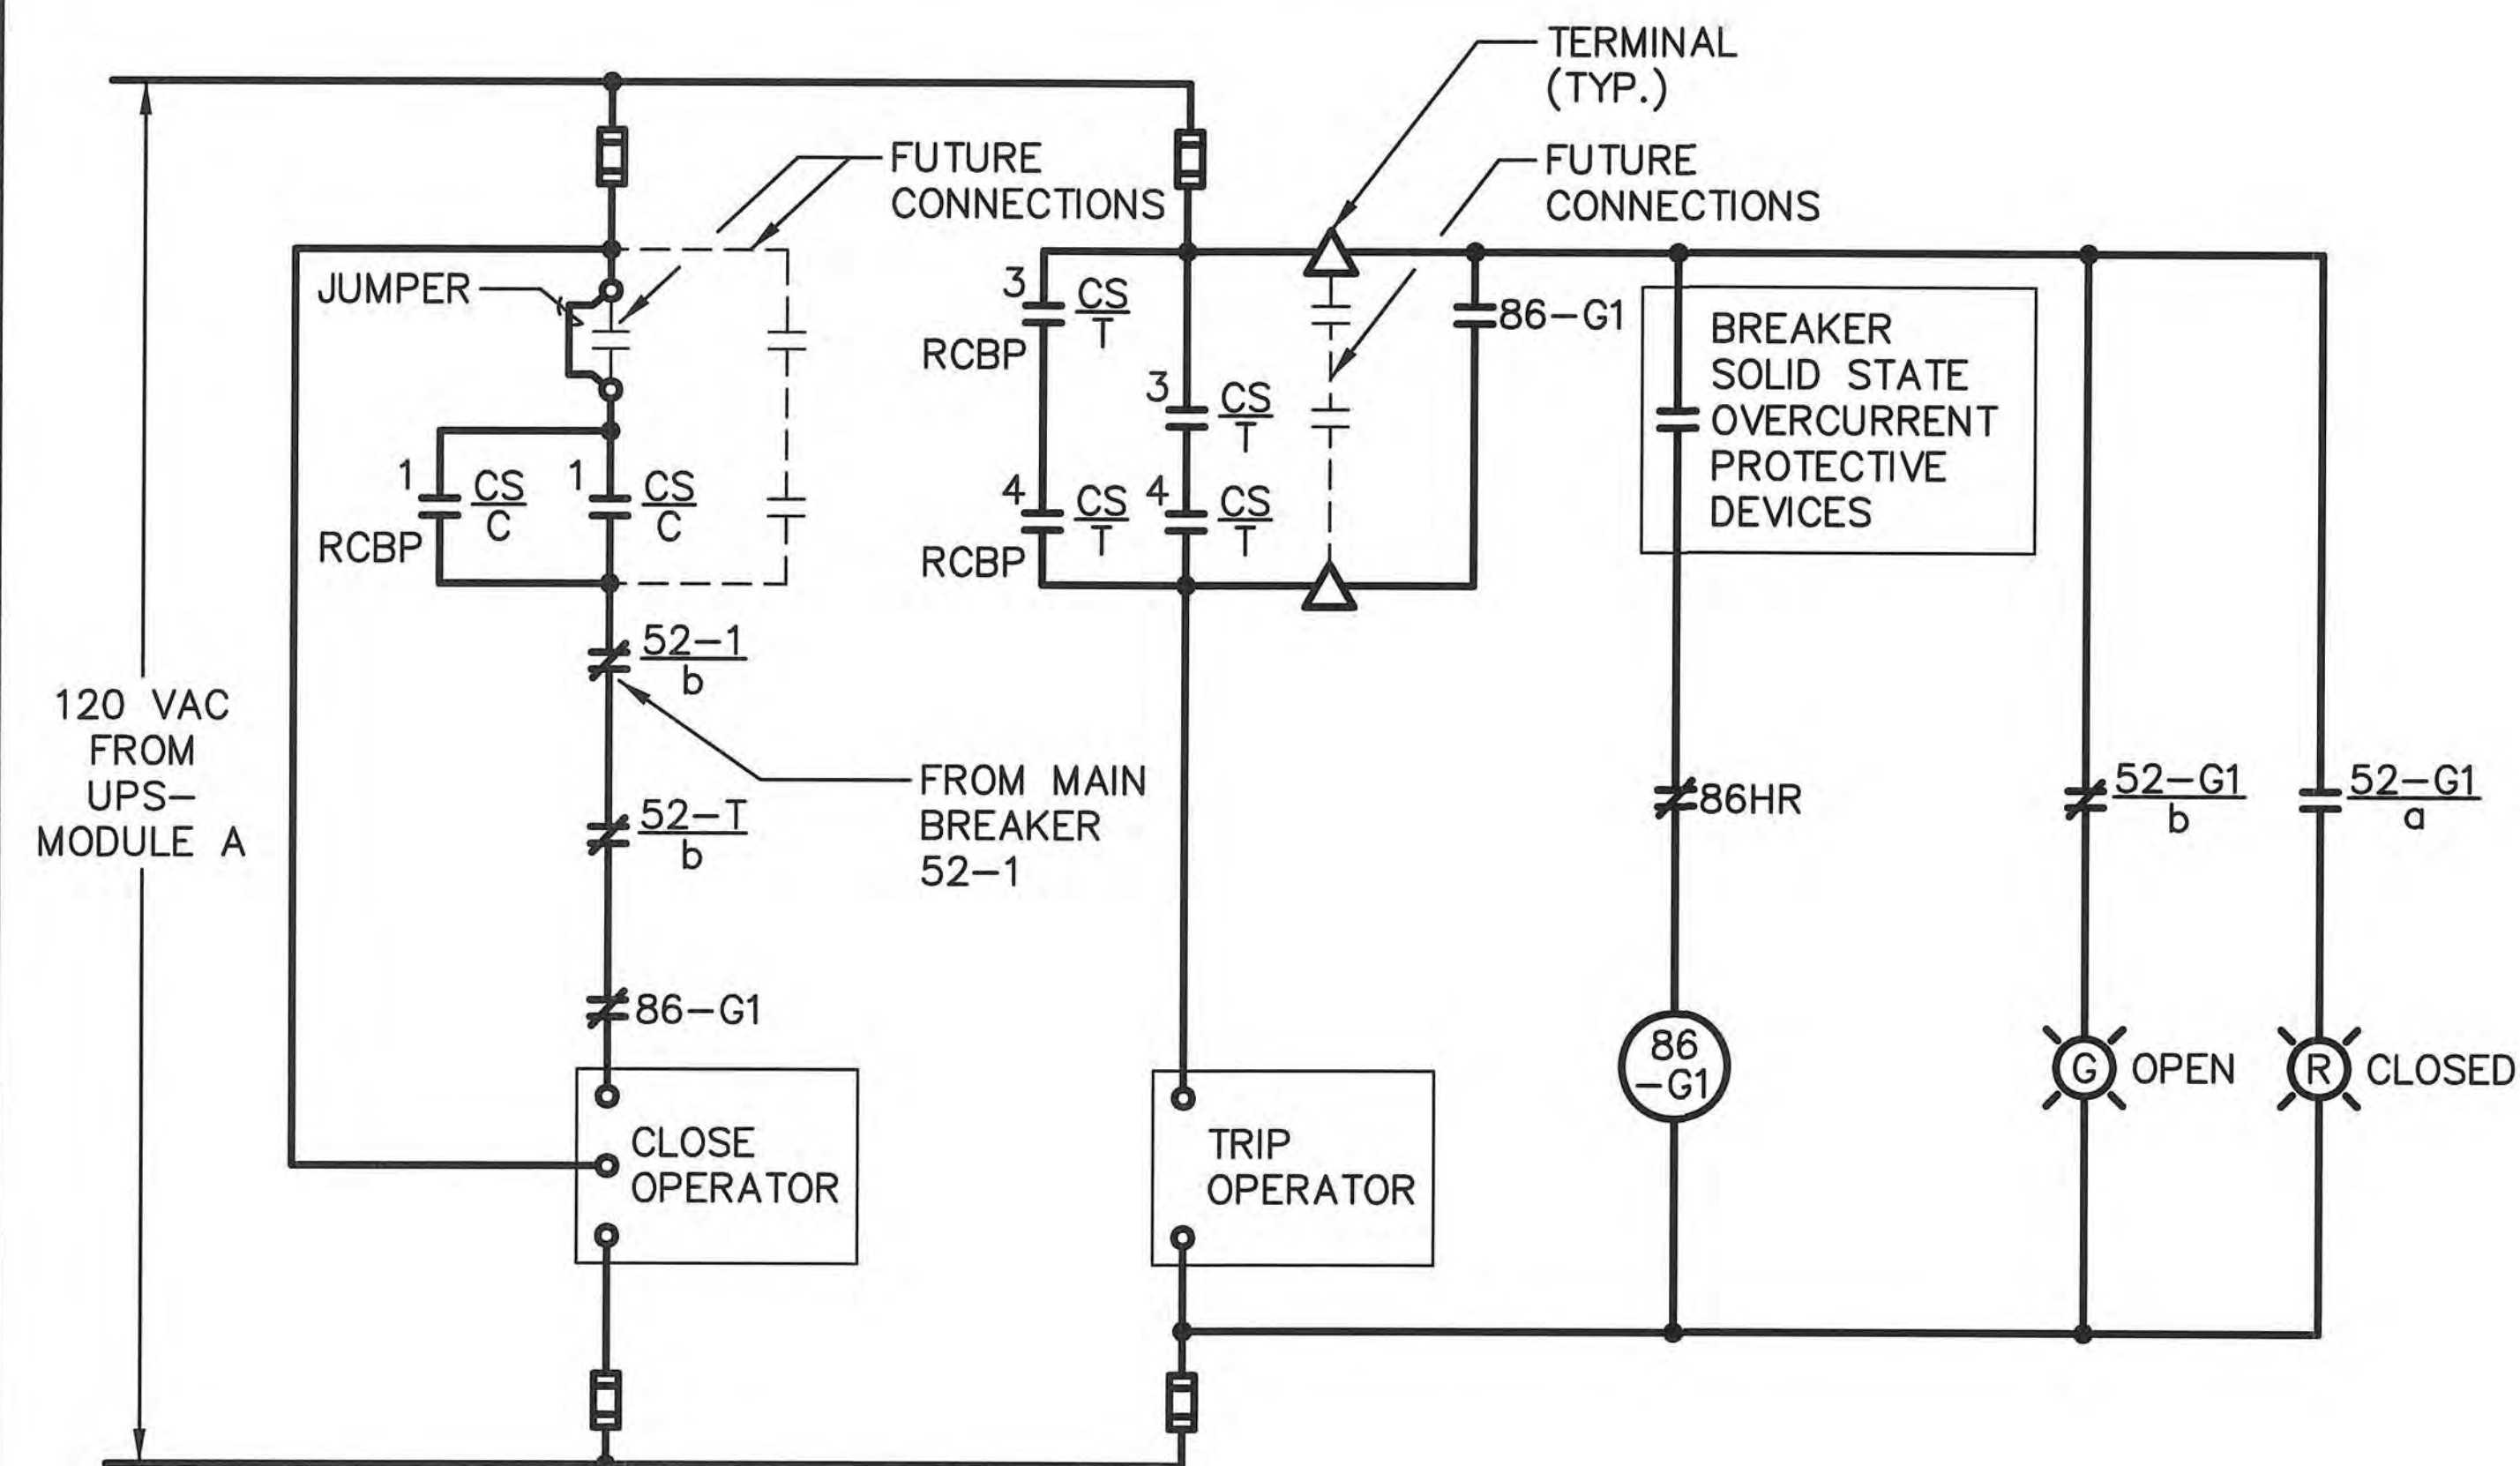

GENERATOR BREAKER 52-G1 CONTROL CIRCUIT

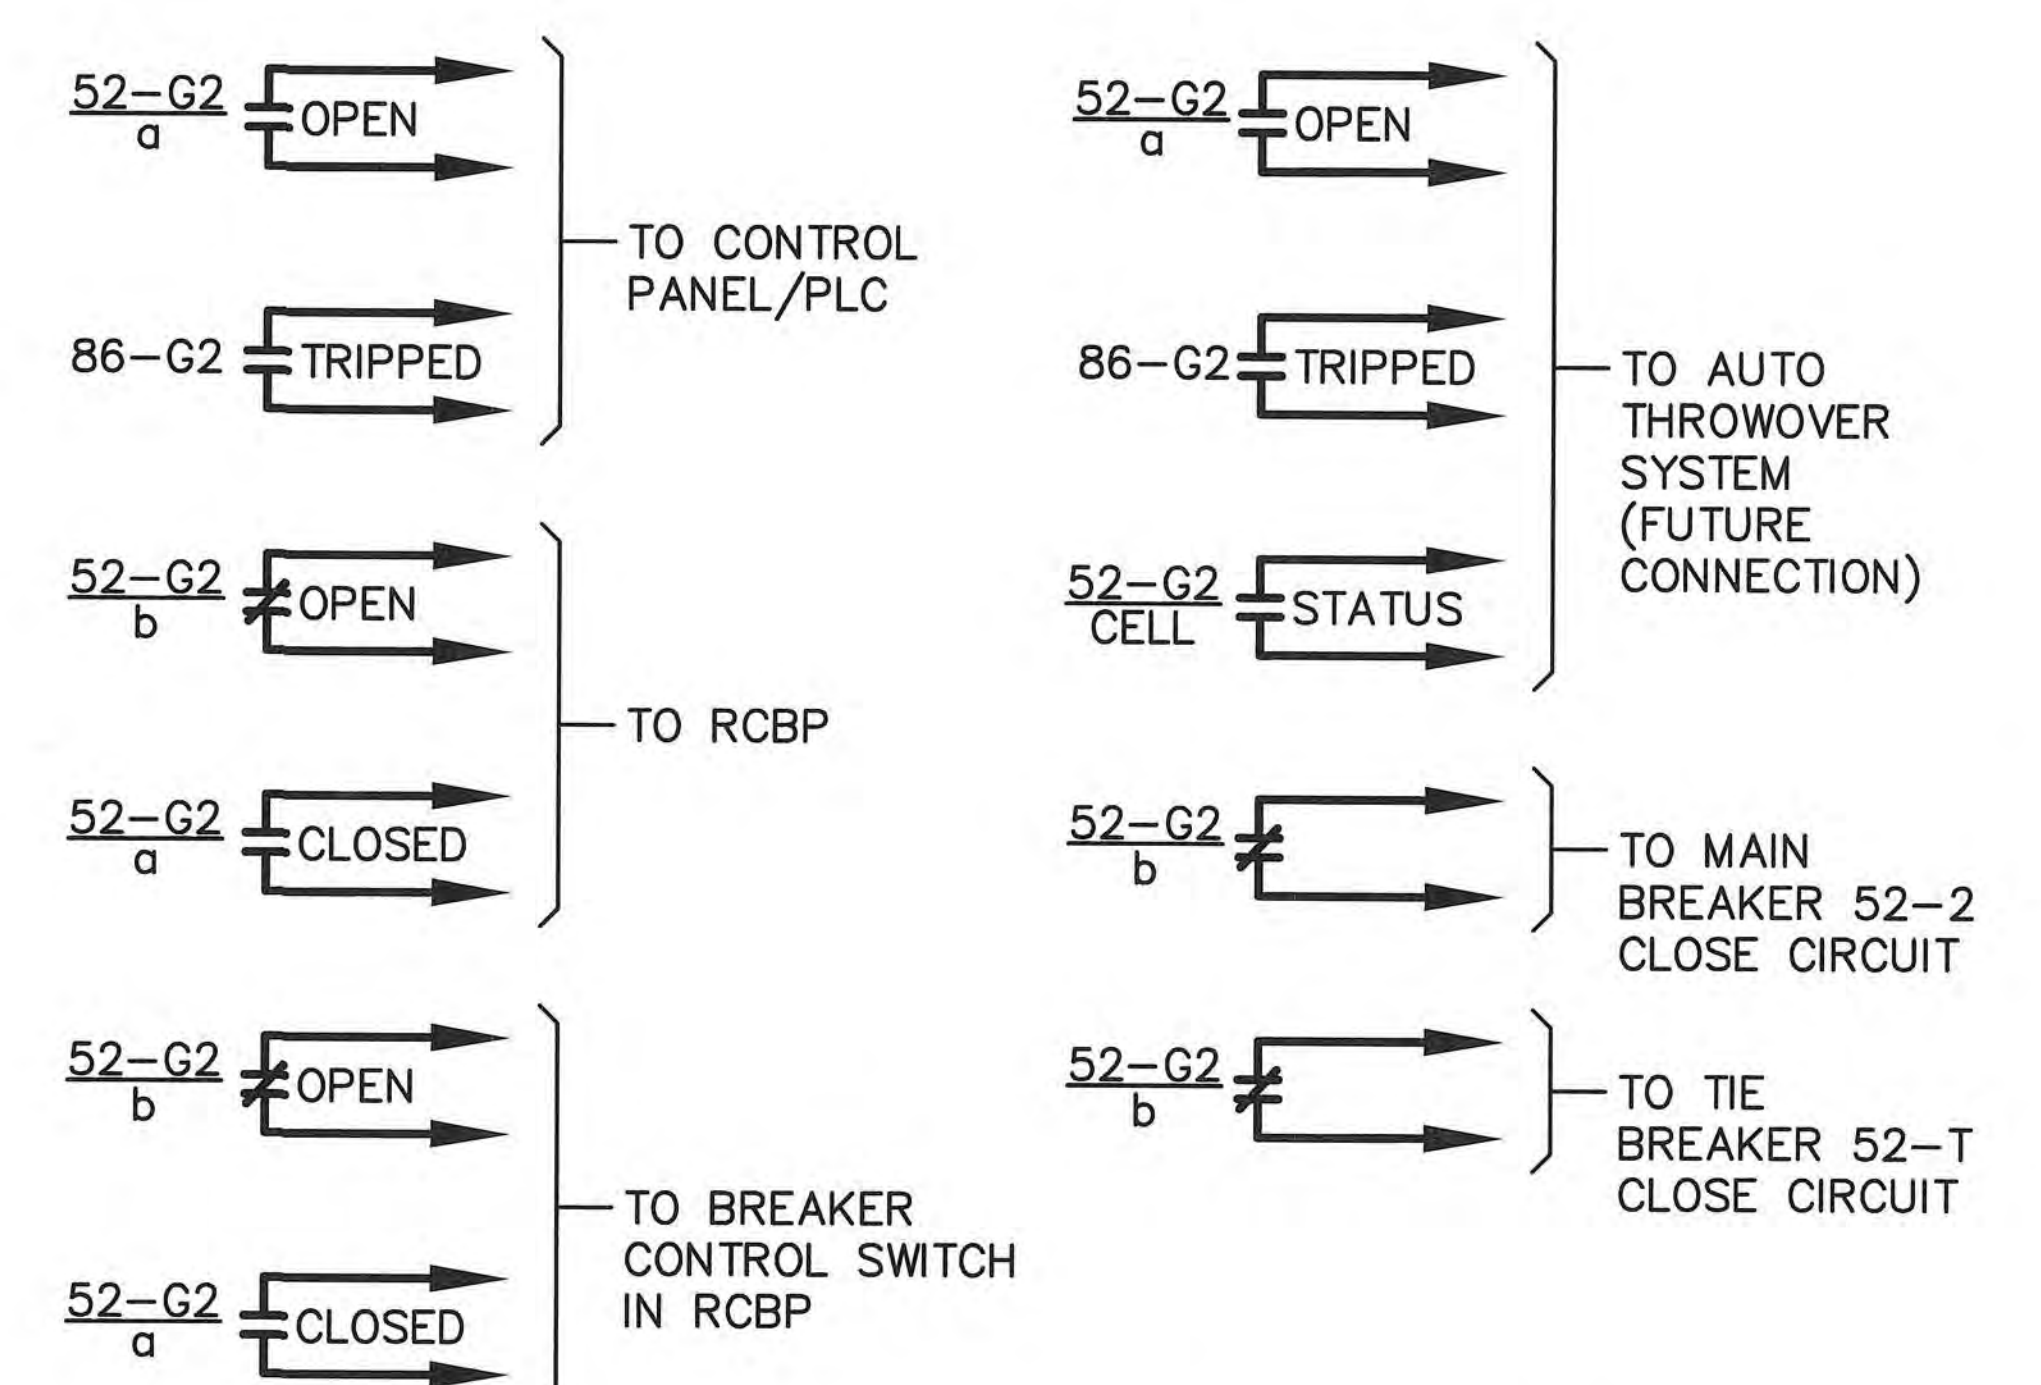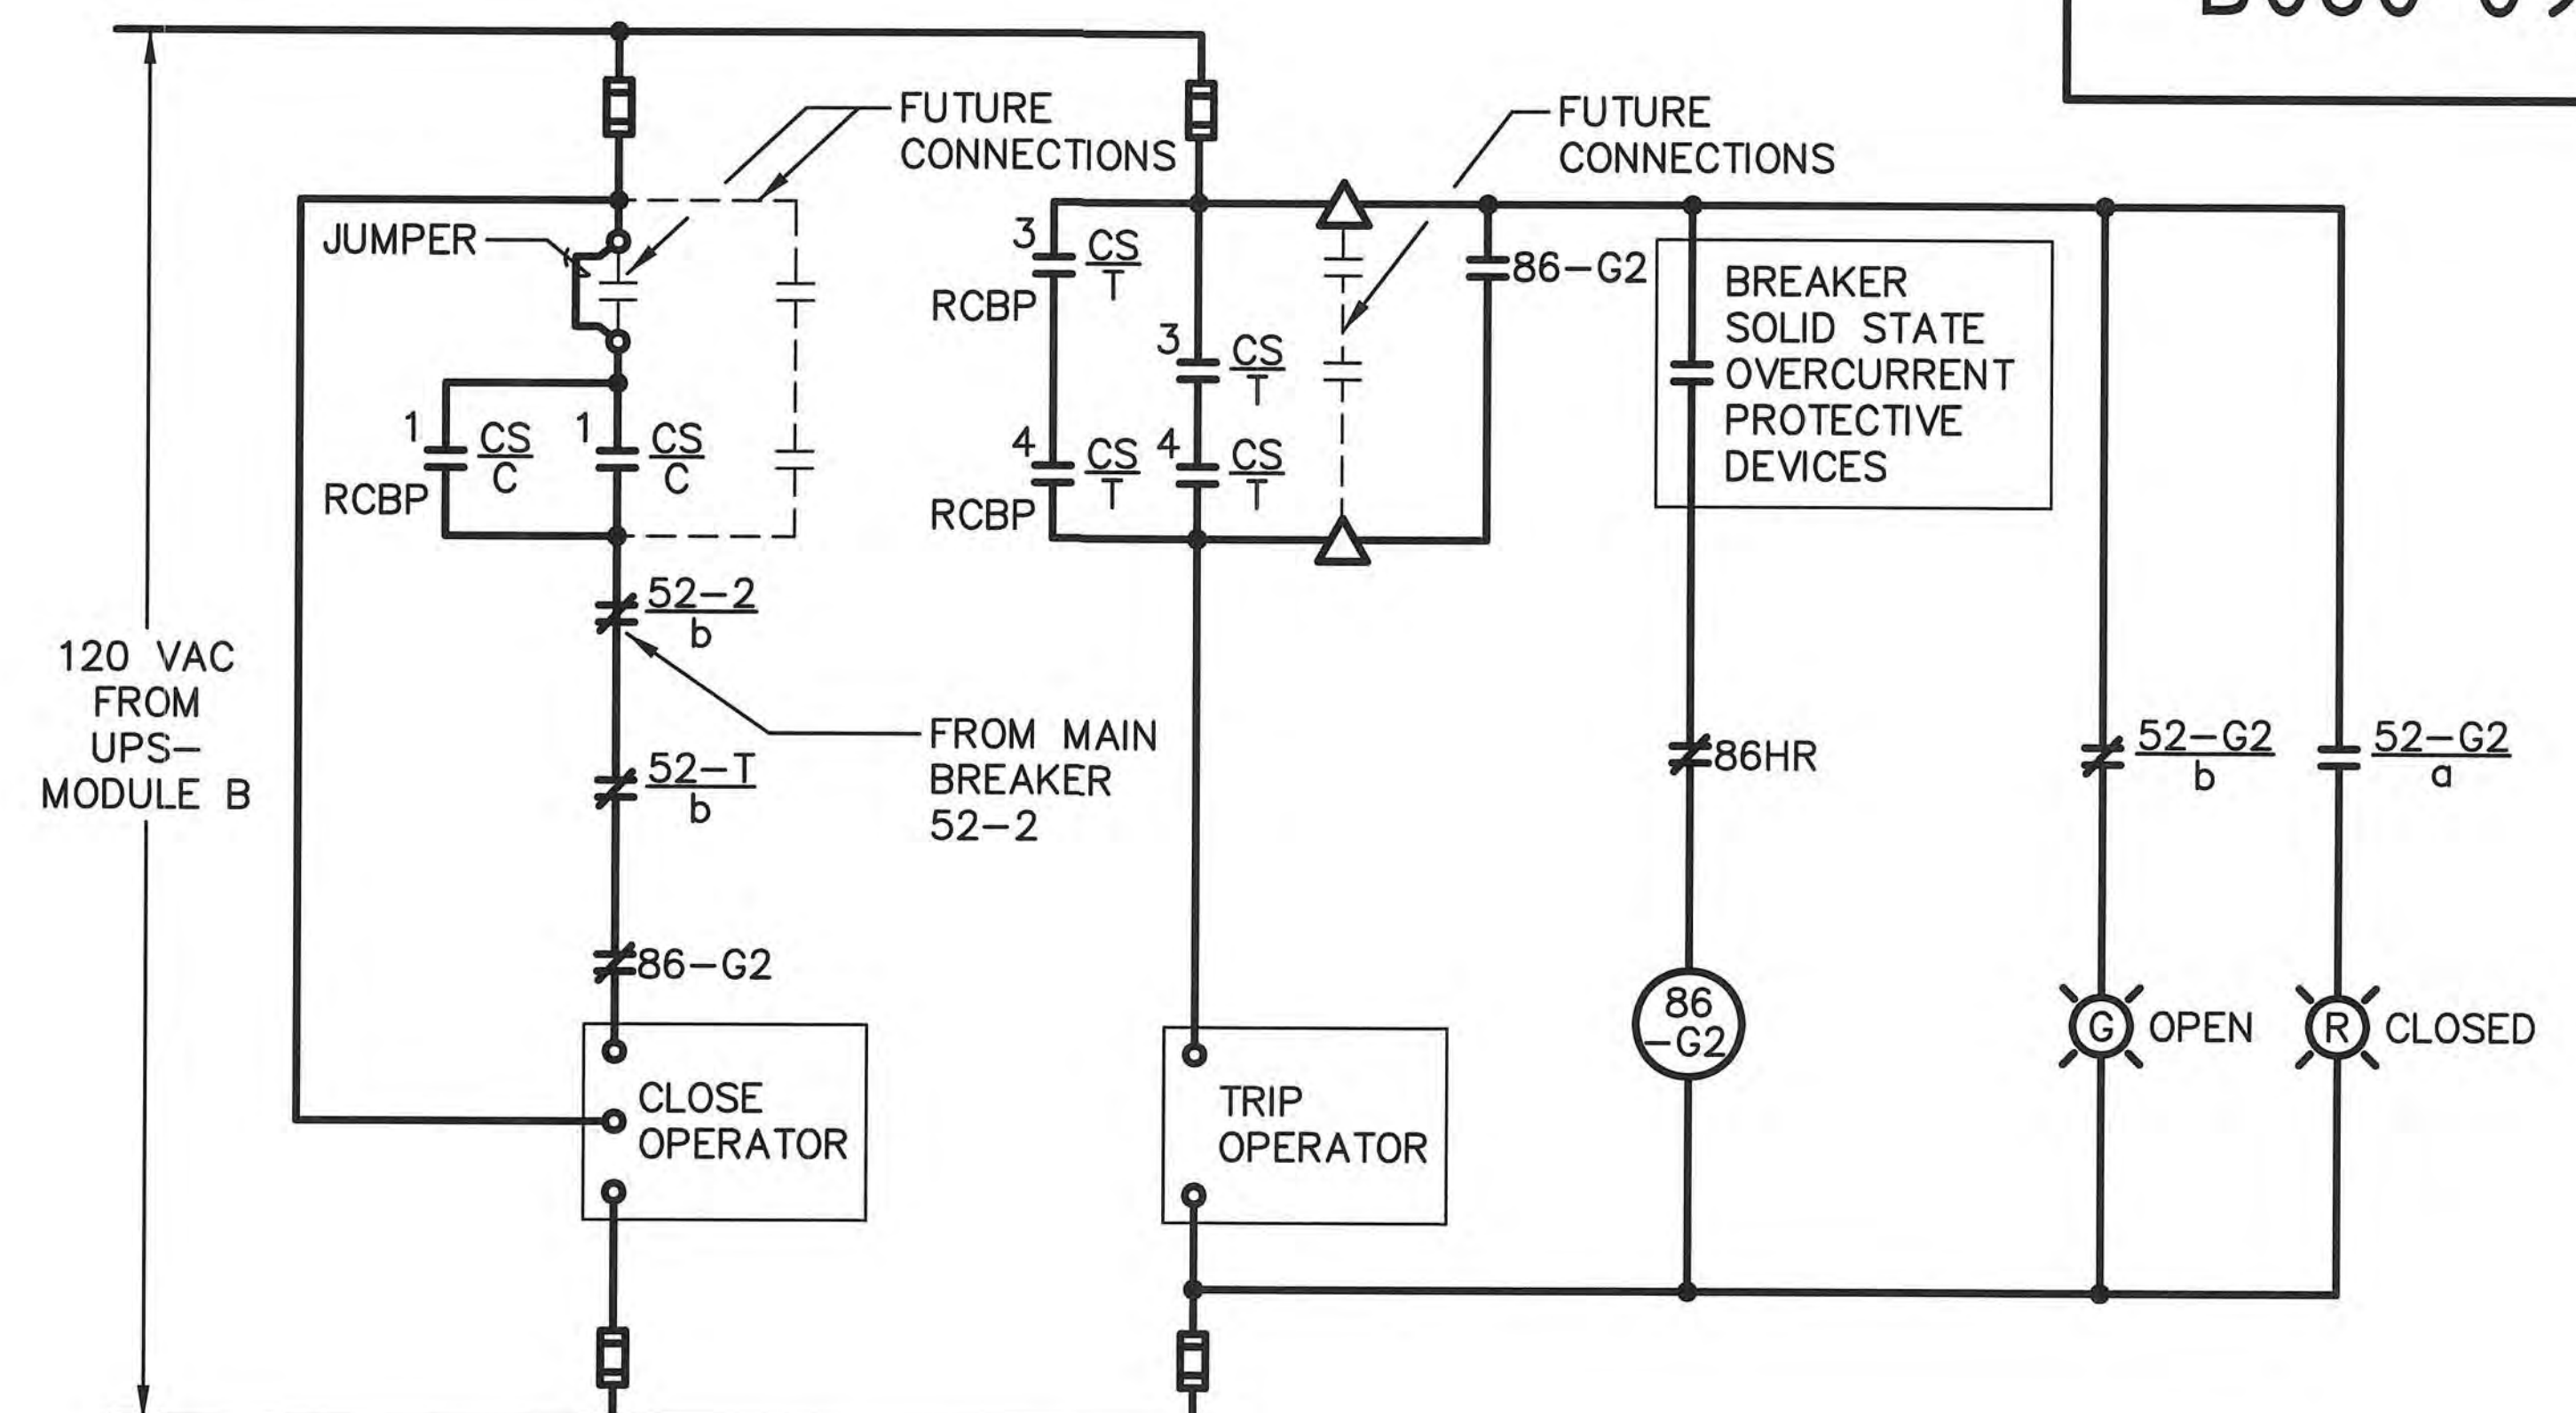

GENERATOR BREAKER 52-G2 CONTROL CIRCUIT

ENGINEER OF RECORD:
BOB E. HALLMAN, P.E.
FLORIDA REGISTRATION NO. 20761



Engineering Design
Technologies Corp.
P.O. Box 152403
Tampa, FL 33684-2403
813.289.8080
813.282.9184 FAX
engineering@edt1.com

CITY of TAMPA
WASTEWATER DEPARTMENT

KRAUSE PS REHABILITATION
CIRCUIT BREAKER CONTROL DIAGRAM
(SHEET 3 OF 4)

NO.	DATE	REVISIONS

DRAWN: RWB
DESIGN: STK
QC: BEH
DATE: 05/01/14

SHEET E-38



MAIN-TIE-MAIN BREAKERS MANUAL/AUTO TRANSFER SELECTOR SWITCH 43CS					
CONTACTS HANDLE END		POSITION		FUNCTION	
		MANUAL	AUTO		
1	2	1		MAIN BREAKER NO. 1 CLOSE CIRCUIT	
		2		MAIN BREAKER NO. 1 CLOSE CIRCUIT	
3	4	3		SPARE	
		4		MAIN BREAKER NO. 1 TRIP CIRCUIT	
5	6	5		MAIN BREAKER NO. 2 CLOSE CIRCUIT	
		6		MAIN BREAKER NO. 2 CLOSE CIRCUIT	
7	8	7		SPARE	
		8		MAIN BREAKER NO. 2 TRIP CIRCUIT	
9	10	9		TIE BREAKER CLOSE CIRCUIT	
		10		TIE BREAKER CLOSE CIRCUIT	
11	12	11		SPARE	
		12		TIE BREAKER TRIP CIRCUIT	
13	14	13		GENERATOR BREAKER NO. 1 CLOSE CIRCUIT	
		14		(FUTURE)	
15	16	15		GENERATOR BREAKER NO. 1 TRIP CIRCUIT	
		16		(FUTURE)	
17	18	17		GENERATOR BREAKER NO. 2 CLOSE CIRCUIT	
		18		(FUTURE)	
19	20	19		GENERATOR BREAKER NO. 2 TRIP CIRCUIT	
		20		(FUTURE)	
21	22	21		TO AUTO THROWOVER SYSTEM	
		22			


X - INDICATES CONTACT CLOSED (MAINTAINED CONTACT)



TYPICAL BREAKER CONTROL SWITCH CS AT SWITCHBOARD AND RCBP					
CONTACTS HANDLE END		POSITION			FUNCTION
		CLOSE	NORMAL	TRIP	
1	2	1			CLOSE CIRCUIT
		2			SPARE
3	4	3			TRIP CIRCUIT
		4			
5	6	5			SPARE
		6			

X - INDICATES CONTACT CLOSED (SPRING RETURN FROM CLOSE AND TRIP TO NORMAL)

ENGINEER OF RECORD:
BOB E. HALLMAN, P.E.
FLORIDA REGISTRATION NO. 20761

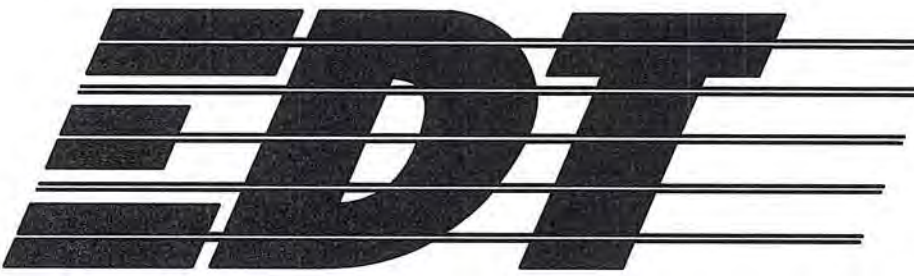


Engineering Design
Technologies Corp.
P.O. Box 152403
Tampa, FL 33684-2403
813.289.8080
813.282.9184 FAX
engineering@edt1.com

CITY of TAMPA
WASTEWATER DEPARTMENT

KRAUSE PS REHABILITATION
CIRCUIT BREAKER CONTROL DIAGRAM
(SHEET 4 OF 4)

NO.	DATE	REVISIONS

DRAWN: RWB
DESIGN: STK
QC: BEH
DATE: 05/01/14

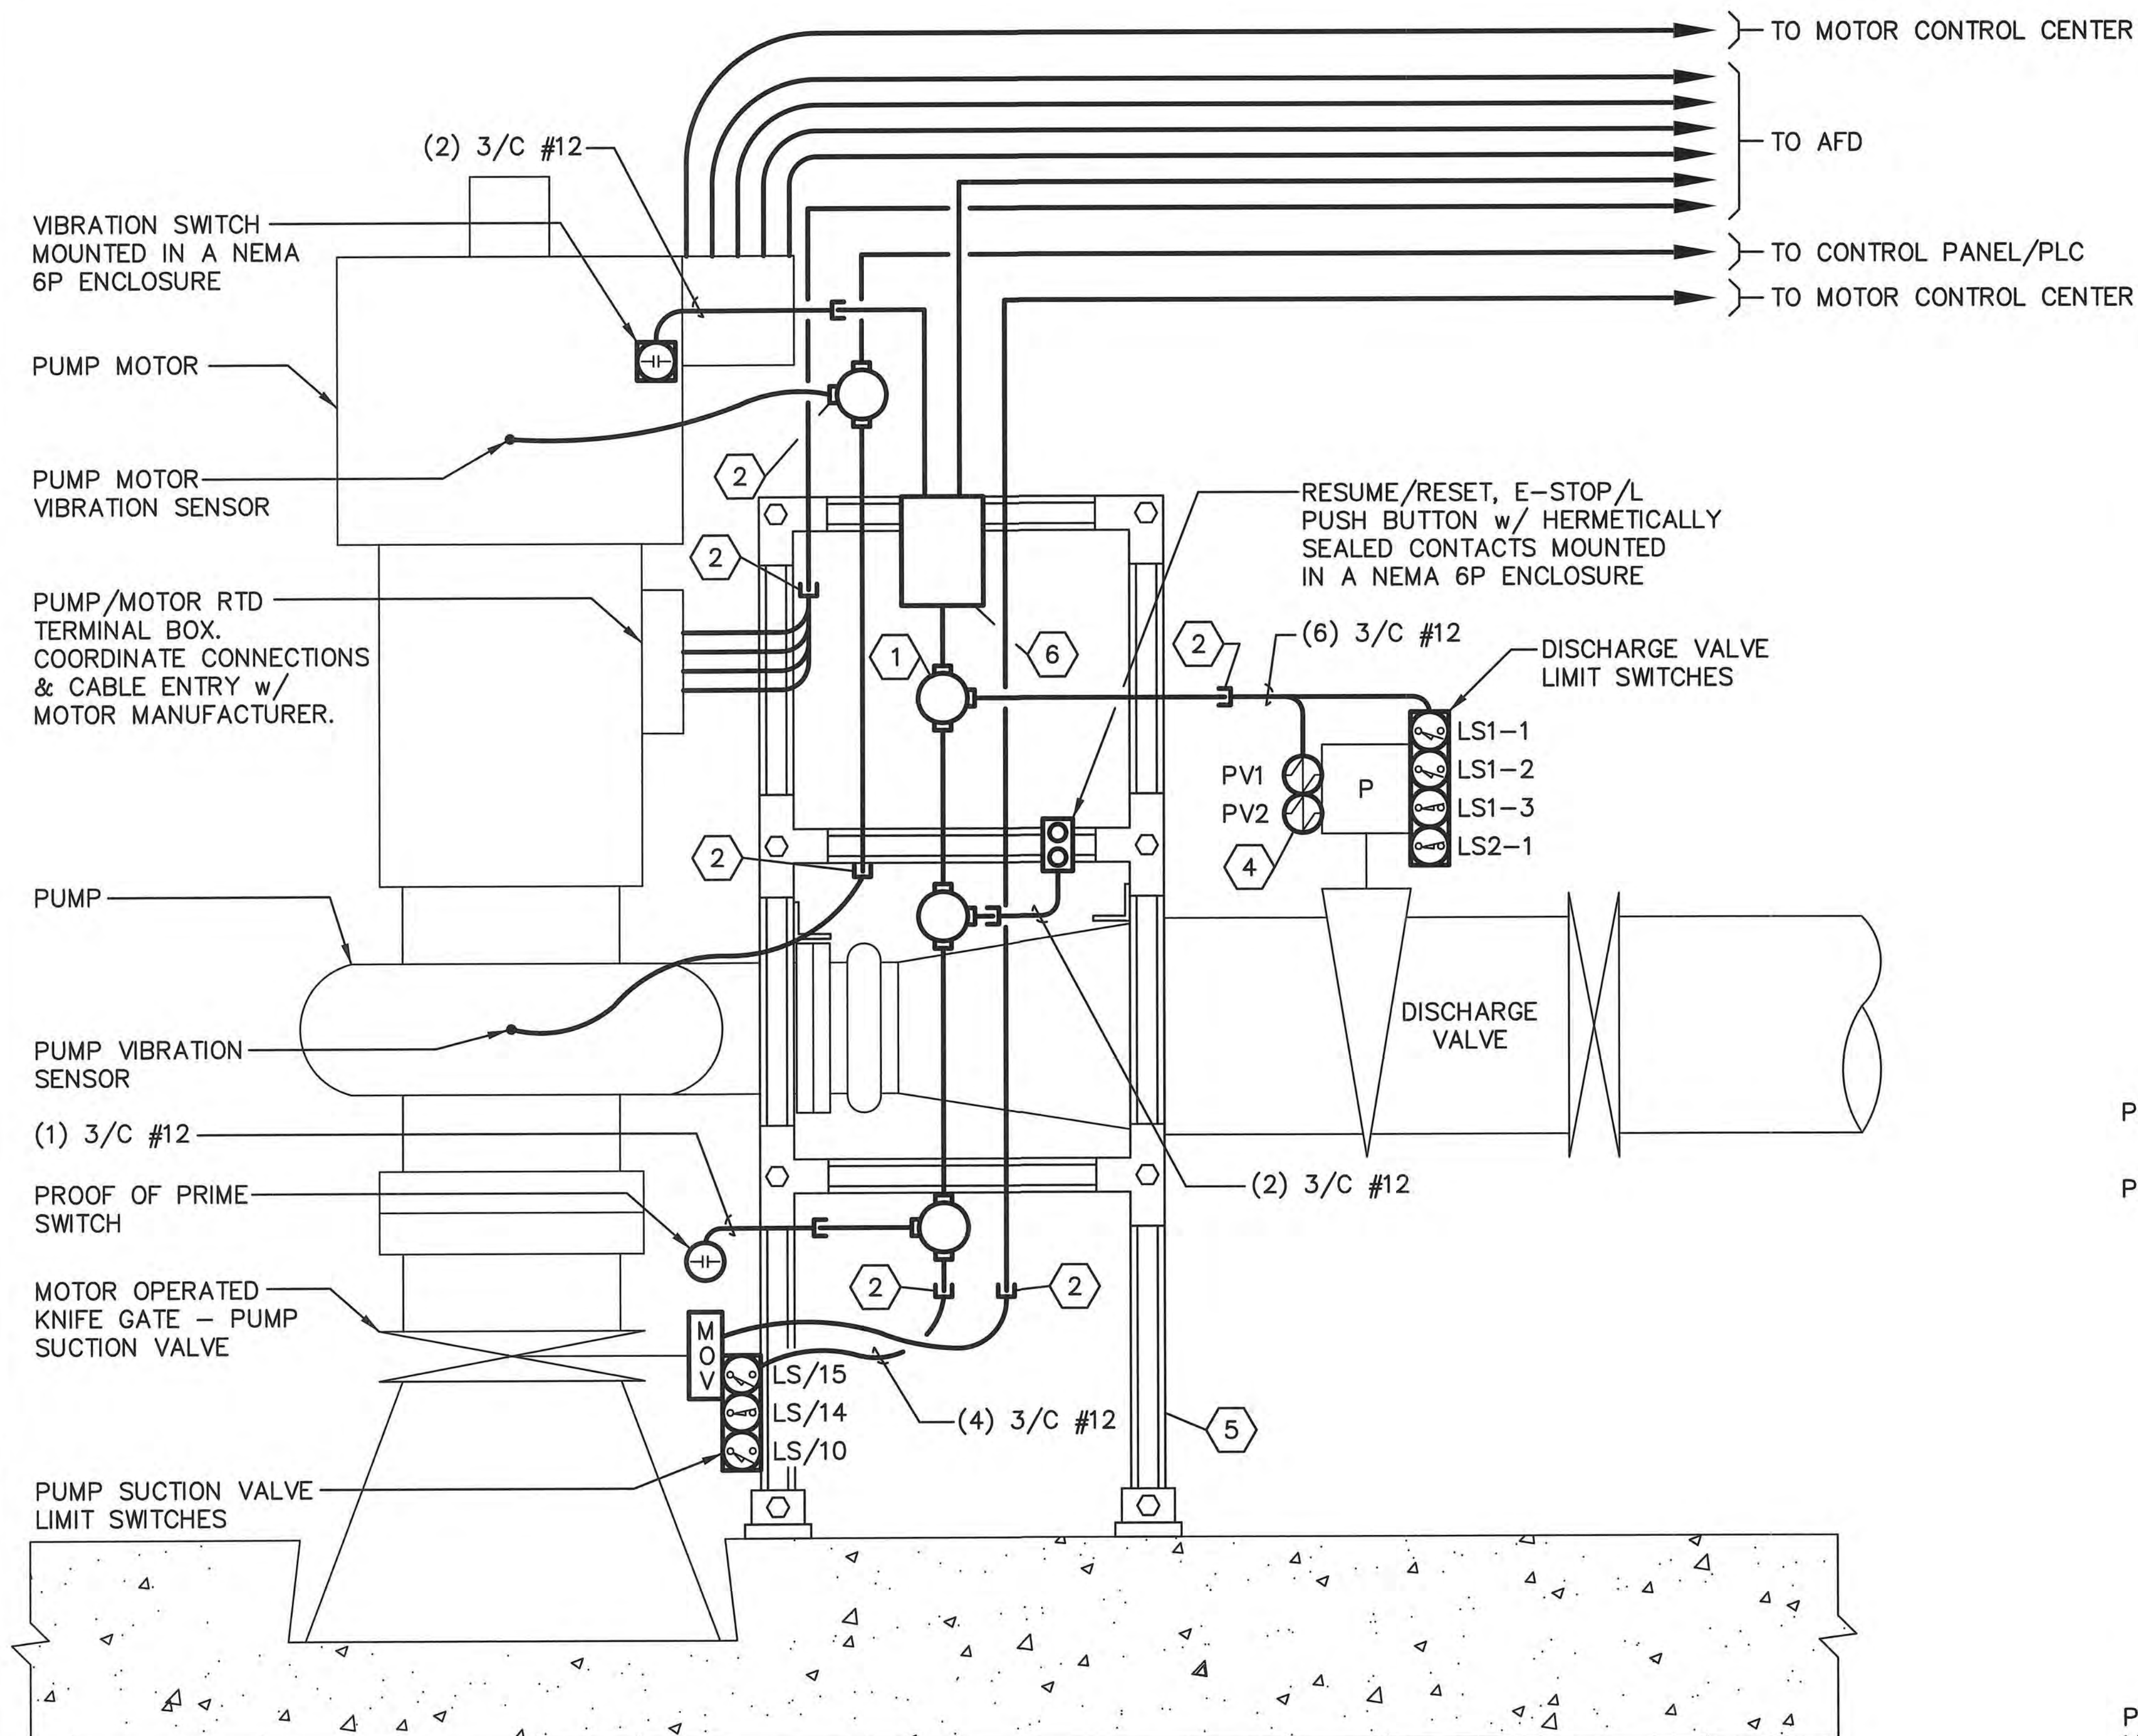

ELEVATION
(NOT TO SCALE)

ENGINEER OF RECORD:
BOB E. HALLMAN, P.E.
FLORIDA REGISTRATION NO. 20761



**Engineering Design
Technologies Corp.**
P.O. Box 152403
Tampa, FL 33684-2403
813.289.8080
813.282.9184 FAX
engineering@edt1.com

CITY of TAMPA
WASTEWATER DEPARTMENT

KRAUSE PS REHABILITATION


PUMP/MOTOR CONNECTION DETAIL

KEYED NOTES:

- 1 CROUSE-HINDS GUFX SERIES JUNCTION BOX. SIZE AS REQUIRED. (TYP.)
- 2 CORD/CABLE FITTING c/w NEOPRENE BUSHING & GLAND NUT SIZED FOR CABLE(S). CROUSE-HINDS CGB SERIES. (TYP.)
- 3 VIBRATION/TEMPERATURE SENSOR w/ INTEGRAL CABLE. CTC TA104 SERIES. COORDINATE MOUNTING AND LOCATION w/ VIBRATION/TEMPERATURE MONITORING SUPPLIER AND MOTOR MANUFACTURER. COORDINATE MOUNTING & LOCATION w/ VIBRATION/TEMPERATURE MONITORING SUPPLIER AND MOTOR MANUFACTURER.
- 4 4-WAY, N.C., FULLY PORTED, ELECTRICALLY OPERATED SOLENOID VALVE w/ WATERTIGHT, HI-SHOCK ENCLOSURE, FORGED BRASS OR BRONZE BODY, RESILIENT BUNA "N" VALVE SEAT. COORDINATE SOLENOID SELECTION AND INSTALLATION w/ VALVE SUPPLIER. (TYP. OF 2)
- 5 SS CONDUIT SUPPORT RACK CONSTRUCTED OF B-LINE 1 5/8" x 1 5/8" B22SS4 UNISTRUT, B-LINE B143SS4 CORNER PLATES, B-LINE B280SQSS4 POST BASES & B-LINE B133SS4 TEE PLATES. SECURE SUPPORT RACK TO PIPING FLANGE w/ 3" x 3" x 1/2" ANGLE. PROVIDE B-LINE B2000SS4 CONDUIT CLAMPS AS REQUIRED.
- 6 16" x 12" x 8" NEMA 4X SS ENCLOSURE w/ CONTINUOUS HINGE.

NOTES:

1. ALL ELECTRICAL CONNECTIONS SHALL BE WATERTIGHT AND SUITABLE FOR SUBMERSIBLE APPLICATIONS TO A DEPTH OF 15'. THE CABLE ENTRY INTO ALL END DEVICES SHALL BE SUITABLE TO ENSURE A WATERTIGHT AND SUBMERSIBLE SEAL.
2. ALL CABLES ROUTED TO END DEVICES SHALL BE OF A TYPE FOR EXTRA-HARD USAGE & SUITABLE FOR SUBMERSIBLE APPLICATIONS.
3. REFERENCE PUMP CABLE SUPPORT DETAIL.

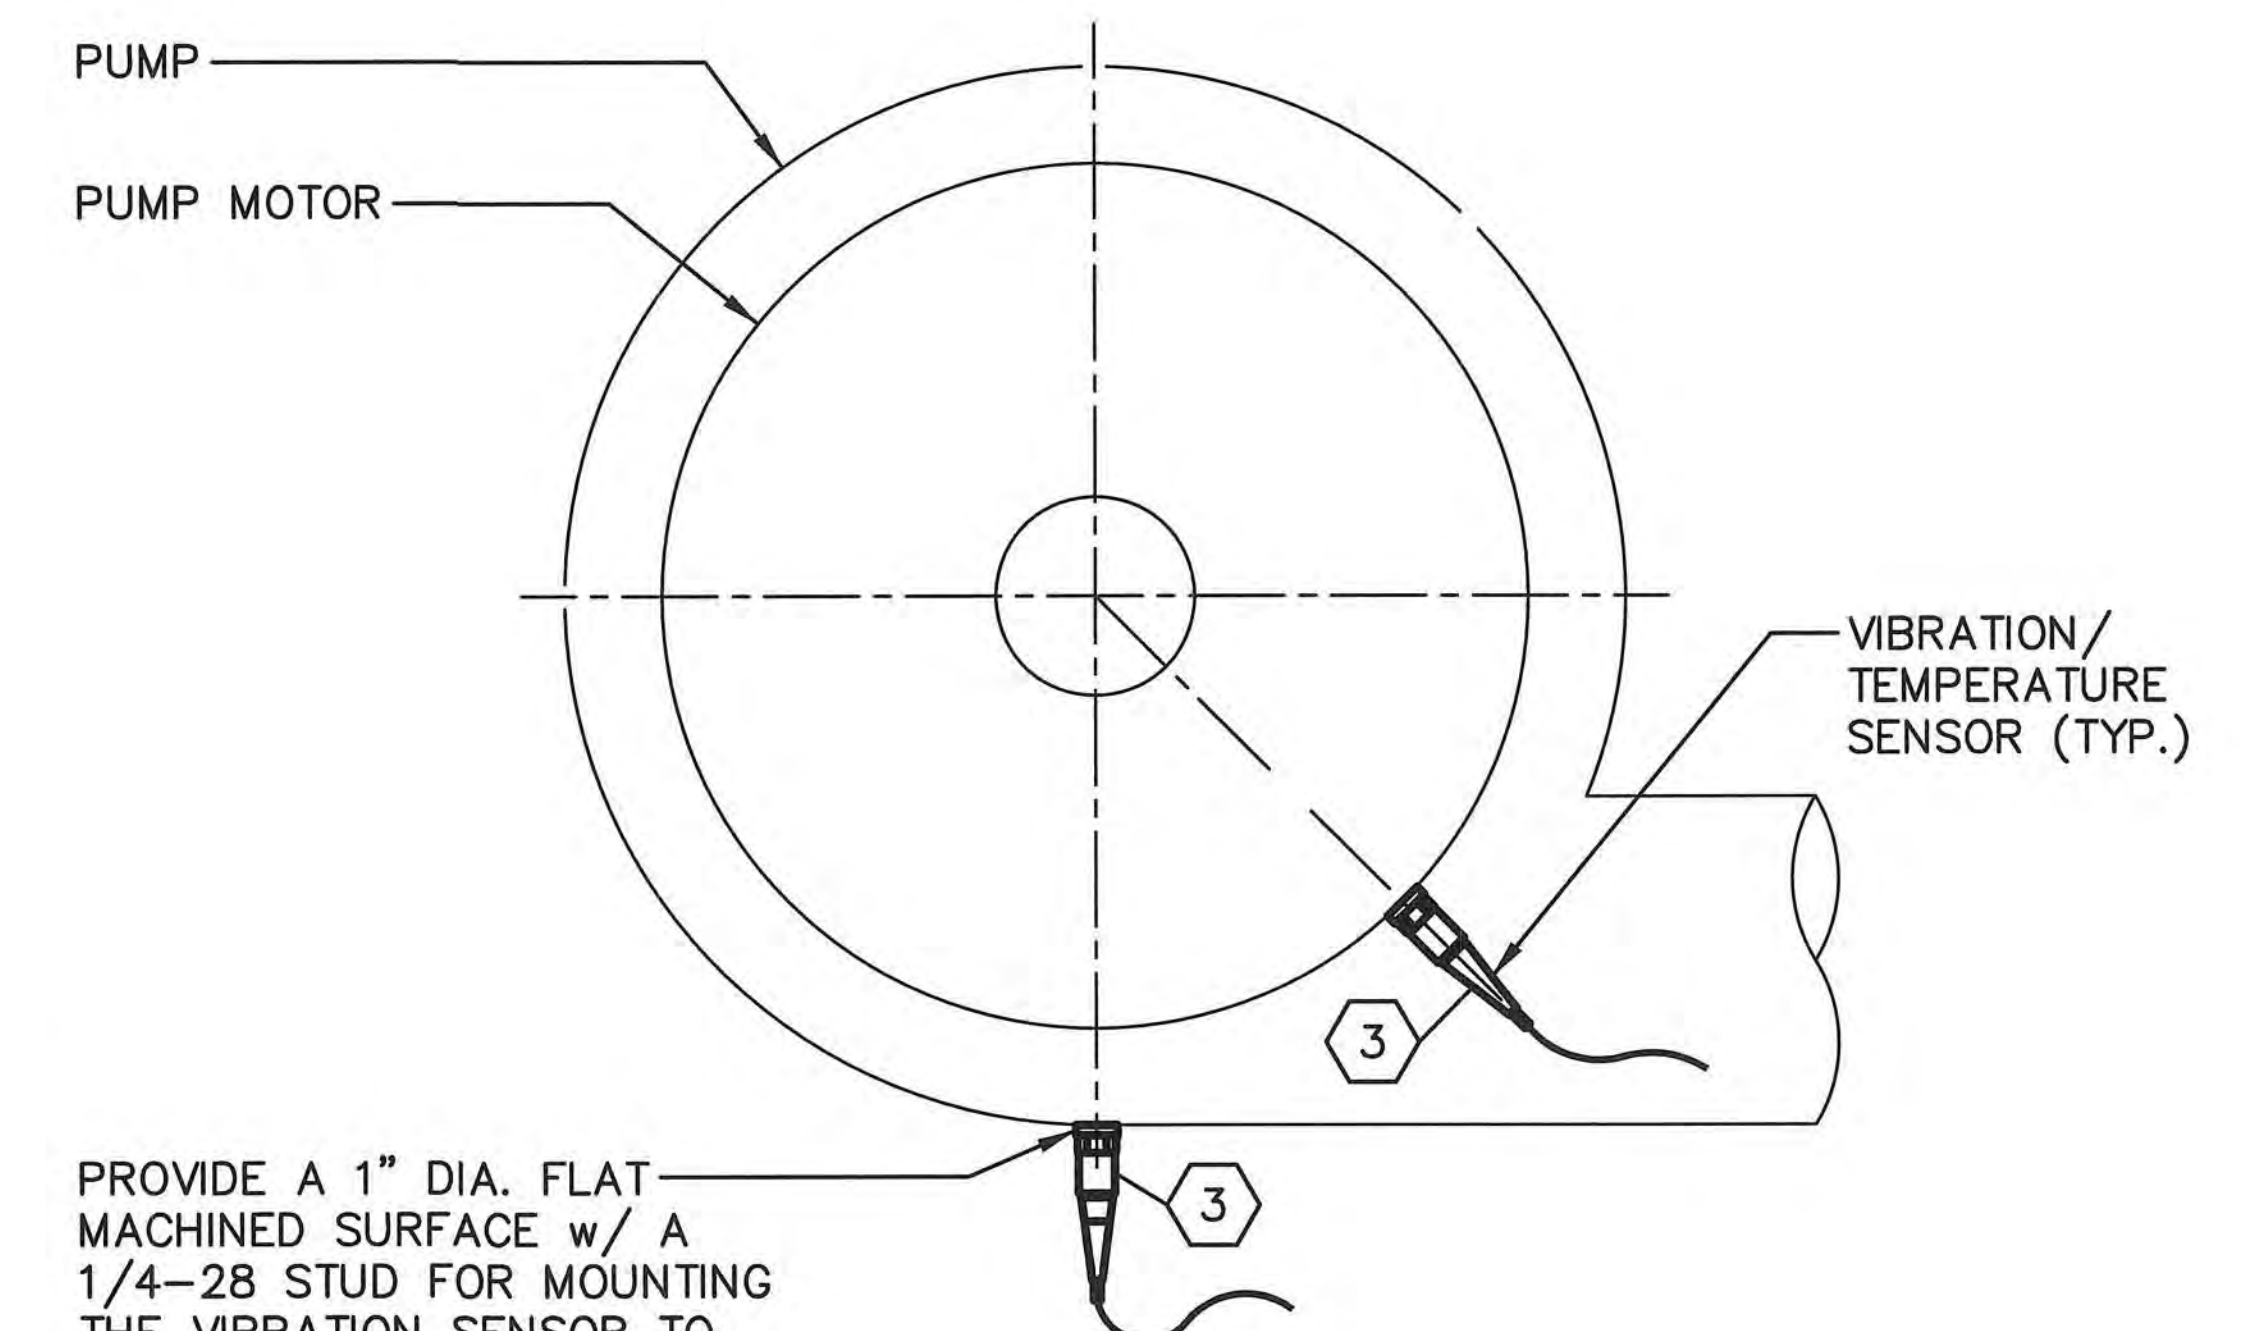


PLAN VIEW
(NOT TO SCALE)

NO.	DATE	REVISIONS

DRAWN: RWB
DESIGN: STK
QC: BEH
DATE: 05/01/14

SHEET E-40

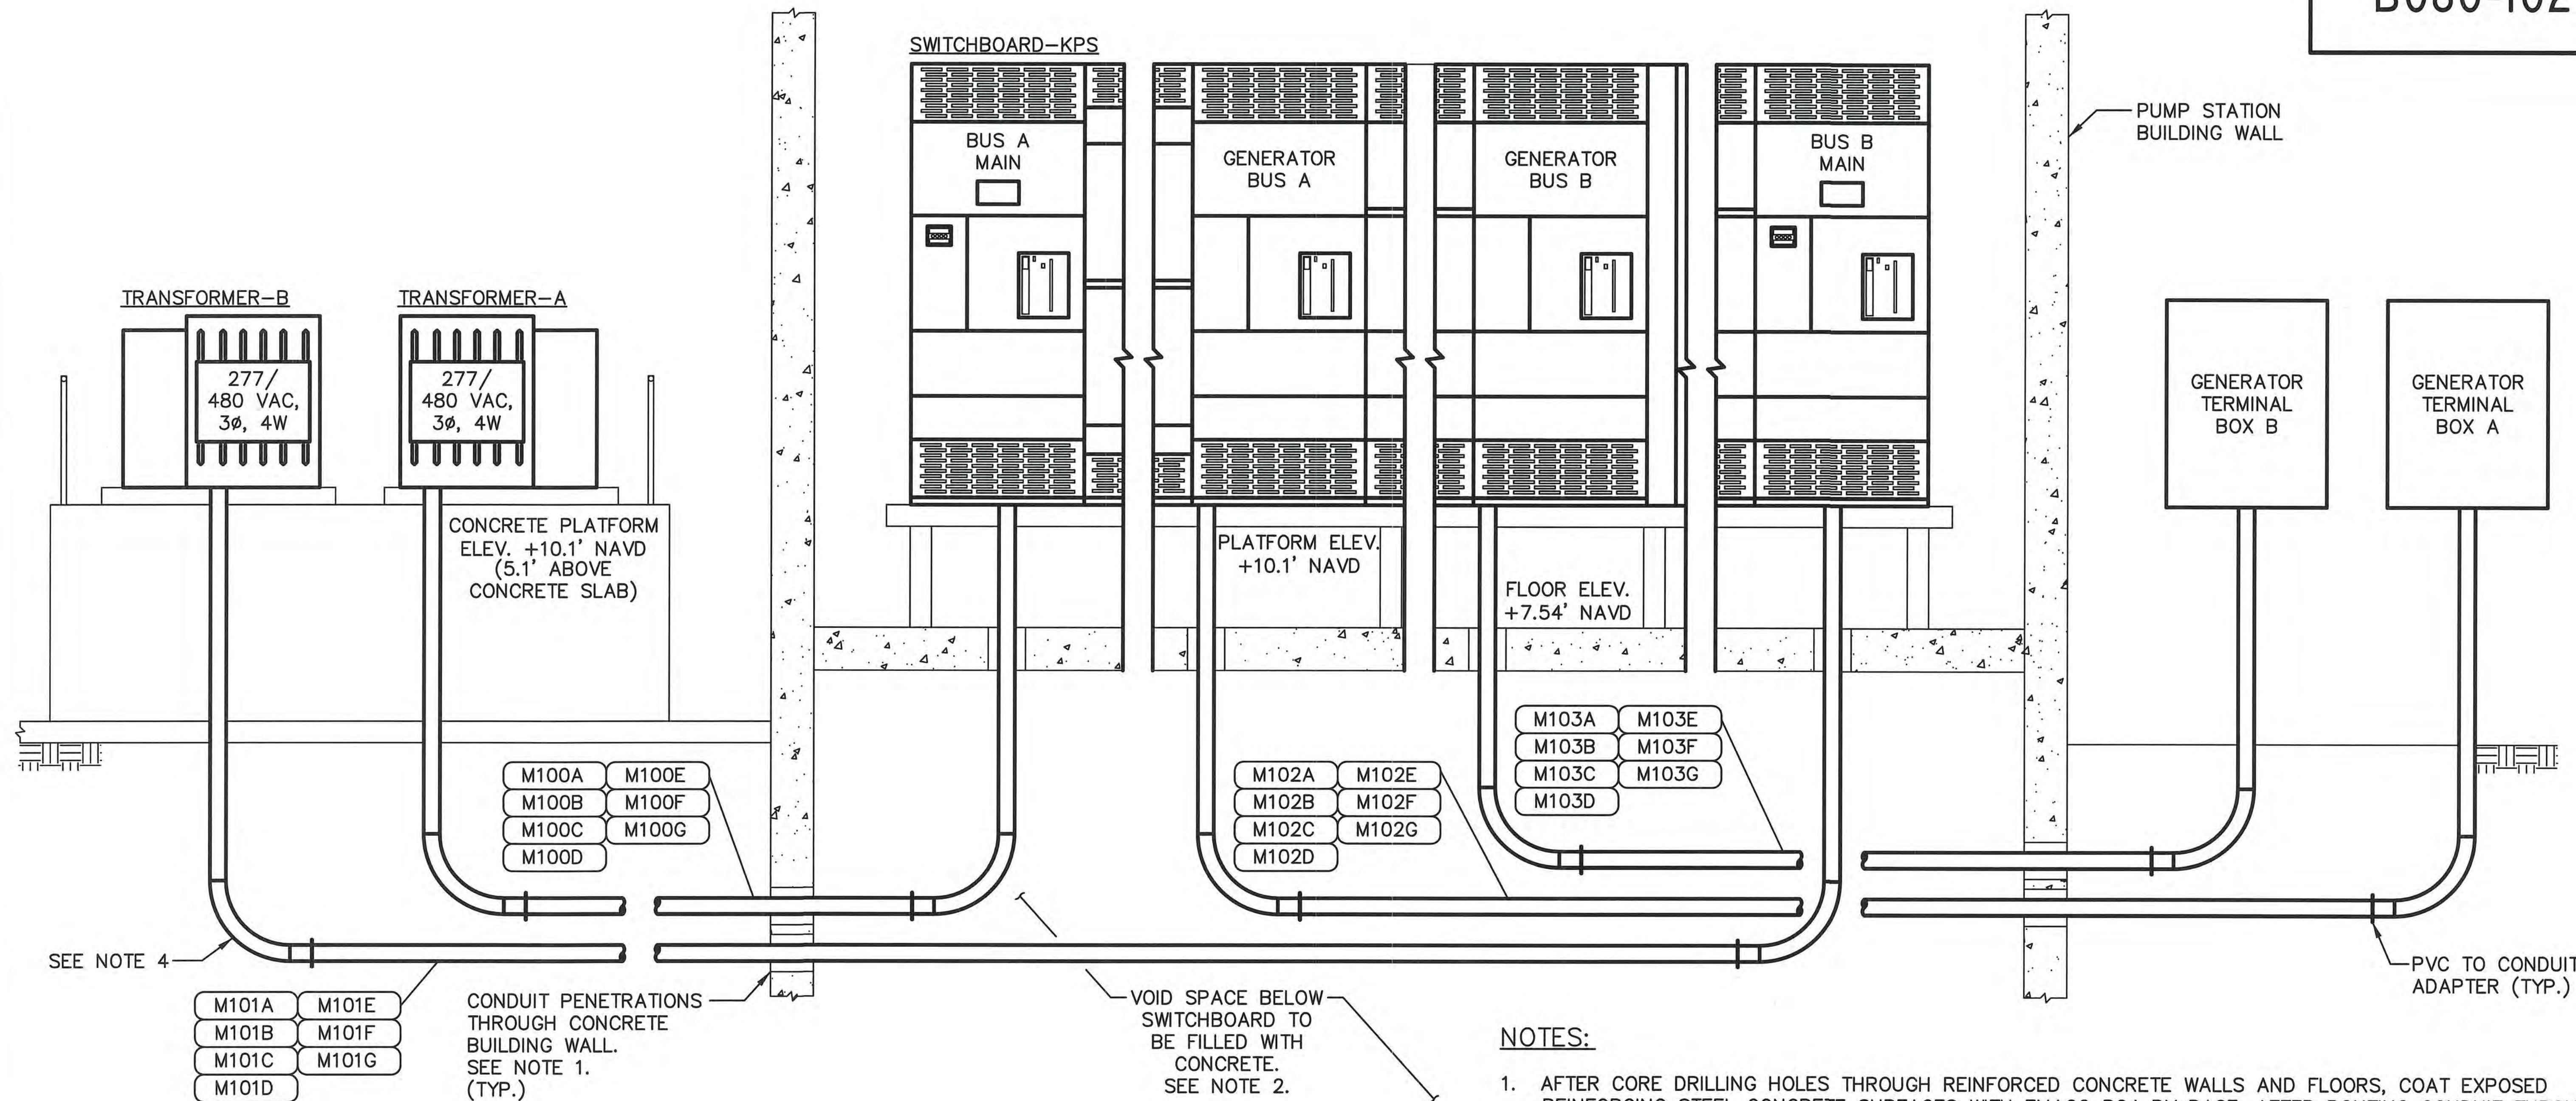

- NOTES:**
1. AFTER CORE DRILLING HOLES THROUGH REINFORCED CONCRETE WALLS AND FLOORS, COAT EXPOSED REINFORCING STEEL CONCRETE SURFACES WITH EMACO P24 BY BASF. AFTER ROUTING CONDUIT THROUGH HOLE, FILL AND FINISH CONCRETE WITH A SHRINKAGE COMPENSATING REPAIR MORTAR WITH CORROSION INHIBITING PROPERTIES, EMACO S66 C1 BY BASF. REFERENCE STRUCTURAL DRAWINGS.
 2. CONDUITS SHALL BE ROUTED IN LOWER LEVEL VOID BENEATH THE SWITCHBOARD PRIOR TO AREA BEING FILLED WITH CONCRETE.
 3. PROVIDE PVC SLEEVES FOR ALL METALLIC CONDUIT PENETRATIONS THROUGH CONCRETE. WHERE ALUMINUM SURFACES SUCH AS BOXES, CONDUIT OR STRUCTURAL SUPPORTS COME IN CONTACT WITH INCOMPATIBLE METALS, LIME, MORTAR, CONCRETE OR OTHER MASONRY MATERIALS, THE CONTACT AREA SHALL BE GIVEN ONE FIELD COAT OF KOPPERS METAL PASSIVATOR NO. 40 AND ONE COAT OF KOPPERS BITUMASTIC SUPER SERVICE BLACK OR TWO COATS OF ASPHALT VARNISH CONFORMING TO FED. SPEC. TT-V-51.
 4. ALL CONDUIT EXPOSED ABOVE GRADE SHALL BE RIGID HEAVY WALL ALUMINUM, UNLESS OTHERWISE NOTED. CONDUITS EXTENDING BELOW GRADE SHALL BE RIGID HEAVY WALL ALUMINUM CONDUIT THROUGH AND INCLUDING THE FIRST 90 DEGREE ELBOW (OR EQUIVALENT SET OF FITTINGS) INSTALLED BELOW GRADE. ALL PVC CONDUIT SHALL BE SCHEDULE 80. CONNECTIONS TO PVC CONDUIT SHALL BE MADE w/ A RIGID ALUMINUM TO PVC CONDUIT ADAPTER.

ENGINEER OF RECORD:
BOB E. HALLMAN, P.E.
FLORIDA REGISTRATION NO. 20761



**Engineering Design
Technologies Corp.**
P.O. Box 152403
Tampa, FL 33684-2403
813.289.8080
813.282.9184 FAX
engineering@edt1.com

CITY of TAMPA
WASTEWATER DEPARTMENT

KRAUSE PS REHABILITATION
SWITCHBOARD CONDUIT DETAILS

NO.	DATE	REVISIONS

DRAWN: RWB
DESIGN: STK
QC: BEH
DATE: 05/01/14

B080-103

COMBINATION POWER/SIGNAL INDUSTRIAL SURGE SUPPRESSOR MOUNTED IN A NEMA 4X ENCLOSURE. EMERSON/EDCO SLAC-12036 SERIES.

NOTE: TAPE SHIELDS OF EACH BELDEN 8719 CABLE AT FLOW METER TOTALIZER. DO NOT GROUND SHIELDS AT TOTALIZER.

CROUSE-HINDS CGB SERIES CONNECTOR. SIZE GROMMET FOR WATERTIGHT CONNECTION FOR #6 BARE GROUNDING CONDUCTOR.

TO PANELBOARD LPA TO CONTROL PANEL/PLC

AC POWER FROM PANELBOARD

SIGNALS TO CONTROL PANEL/PLC

ENLARGED VIEW

FLOW METER TOTALIZER

SECURE GROUNDING CONDUCTOR TO CONDUIT WITH BLACK TY-RAPS AT 12" INTERVALS. USE T & B TY29MX. (TYP.)

AC POWER TO FLOW METER TOTALIZER

GROUNDING CONDUCTOR TO GROUND ROD

TOTALIZED FLOW SIGNAL FROM FLOW METER TOTALIZER

FLOW RATE SIGNAL FROM FLOW METER TOTALIZER

CLASS K STRANDED, AWG #2 BARE COPPER CONDUCTOR OR BRAIDED GROUNDING STRAP. BOND TO MATING FLANGES OF MAGNETIC FLOW METER & TO 5/8" x 10'-0" STAINLESS STEEL GROUND ROD. COORDINATE GROUNDING REQUIREMENTS w/ FLOW METER MANUFACTURER.

MAGNETIC FLOW METER (MAG METER)

MECHANICAL LUG w/ HOLES SIZED TO FIT FLANGE BOLTS (TYP.)

PIPING

TO FLOW METER TOTALIZER

EXOTHERMIC WELD

REFERENCE GROUND WELL DETAIL

7/C SHIELDED CABLE, 1" C. CABLE PROVIDED BY FLOW METER MANUFACTURER. COORDINATE CABLE LENGTH, NO. OF CONDUITS, DETAILS & INSTALLATION w/ FLOW METER MANUFACTURER.

5/8" x 10'-0" STAINLESS STEEL GROUND ROD

#6 BARE COPPER CONDUCTOR. CONNECT TO GROUNDING TERMINAL INSIDE ENCLOSURE.

REFERENCE GROUND WELL DETAIL

EXOTHERMIC WELD

3/4" x 10'-0" STAINLESS STEEL GROUND ROD

TO MAGNETIC FLOW METER. REFERENCE SHEET G-4 FOR FLOW METER LOCATION.

7/C SHIELDED CABLE, 1" C. CABLE PROVIDED BY FLOW METER MANUFACTURER. COORDINATE CABLE LENGTH, NO. OF CONDUITS, DETAILS & INSTALLATION w/ FLOW METER MANUFACTURER.

MAGNETIC FLOW METER CONNECTION DETAIL

ENGINEER OF RECORD:
BOB E. HALLMAN, P.E.
FLORIDA REGISTRATION NO. 20761



Engineering Design
Technologies Corp.
P.O. Box 152403
Tampa, FL 33684-2403
813.289.8080
813.282.9184 FAX
engineering@edt1.com

CITY of TAMPA
WASTEWATER DEPARTMENT


KRAUSE PS REHABILITATION

MAGNETIC FLOW METER
CONNECTION DETAIL

NO.	DATE	REVISIONS

DRAWN: RWB
DESIGN: STK
QC: BEH
DATE: 05/01/14

SHEET E-42

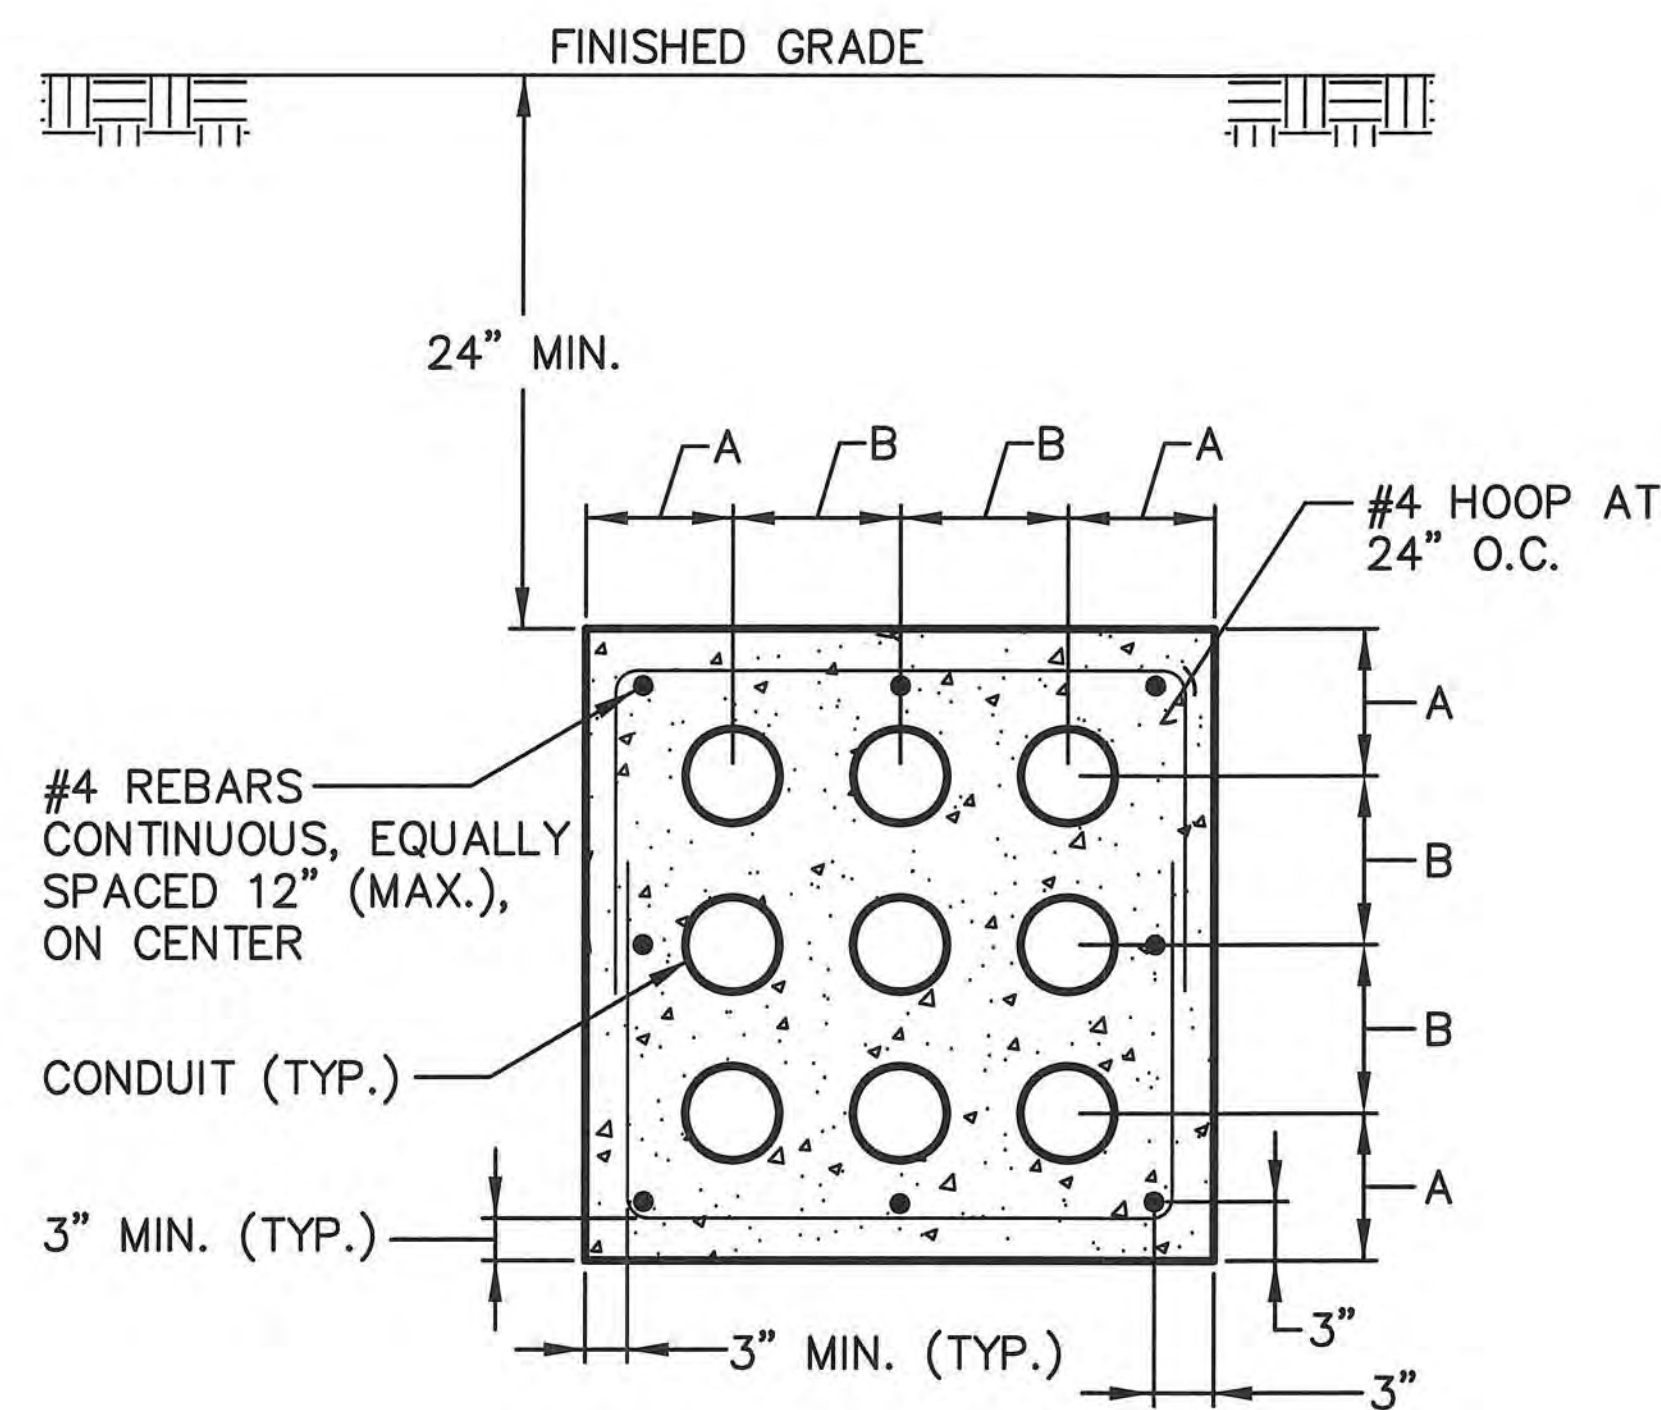


DUCT BANK CONDUIT SPACING DIMENSIONS											
CONDUIT SIZE	DIMENSION A	CONDUIT SIZE									
		3/4"	1"	1 1/4"	1 1/2"	2"	2 1/2"	3"	3 1/2"	4"	
		DIMENSION B									
3/4"	3 5/8"	3 1/8"	3 1/4"	3 3/8"	3 1/2"	3 3/4"	4"	4 3/8"	4 5/8"	4 7/8"	
1"	3 3/4"	3 1/4"	3 3/8"	3 1/2"	3 5/8"	3 7/8"	4 1/4"	4 1/2"	4 3/4"	5"	
1 1/4"	3 7/8"	3 3/8"	3 1/2"	3 3/4"	3 7/8"	4 1/8"	4 3/8"	4 5/8"	4 7/8"	5 1/8"	
1 1/2"	4"	3 1/2"	3 5/8"	3 7/8"	4"	4 1/4"	4 1/2"	4 3/4"	5"	5 1/4"	
2"	4 1/4"	3 3/4"	3 7/8"	4 1/8"	4 1/4"	4 3/8"	4 5/8"	5"	5 1/4"	5 1/2"	
2 1/2"	4 1/2"	4"	4 1/8"	4 3/8"	4 1/2"	4 5/8"	4 7/8"	5 1/4"	5 1/2"	5 3/4"	
3"	4 3/4"	4 3/8"	4 1/2"	4 5/8"	4 3/4"	5"	5 1/4"	5 1/2"	5 3/4"	6"	
3 1/2"	5"	4 5/8"	4 3/4"	4 7/8"	5"	5 1/4"	5 1/2"	5 3/4"	6"	6 1/4"	
4"	5 1/4"	4 7/8"	5"	5 1/8"	5 1/4"	5 1/2"	5 3/4"	6"	6 1/4"	6 1/2"	

NOTES:

1. CONCRETE SHALL BE 3000 PSI. MINIMUM COMPRESSION STRENGTH.
2. TOP OF DUCT BANK SHALL BE DYED RED.
3. TOP OF DUCT BANK SHALL BE 24" BELOW FINISHED GRADE.
4. 4" CONDUIT BEND RADIUS SHALL BE A MINIMUM OF 48".
5. ALL EMPTY CONDUITS SHALL INCLUDE A PULL WIRE AND SHALL BE CAPPED.
6. DUCT BANKS MAY BE RE-ARRANGED FOR CONVENIENCE OF EGRESS.
7. REFERENCE ELECTRICAL DRAWINGS FOR CONDUIT SIZE.
8. THIS DETAIL IS FOR LAYOUT PURPOSES ONLY. FOR THE ACTUAL NUMBER OF CONDUITS & FEEDERS SEE PLAN DRAWINGS.

1 DUCT BANK DETAIL

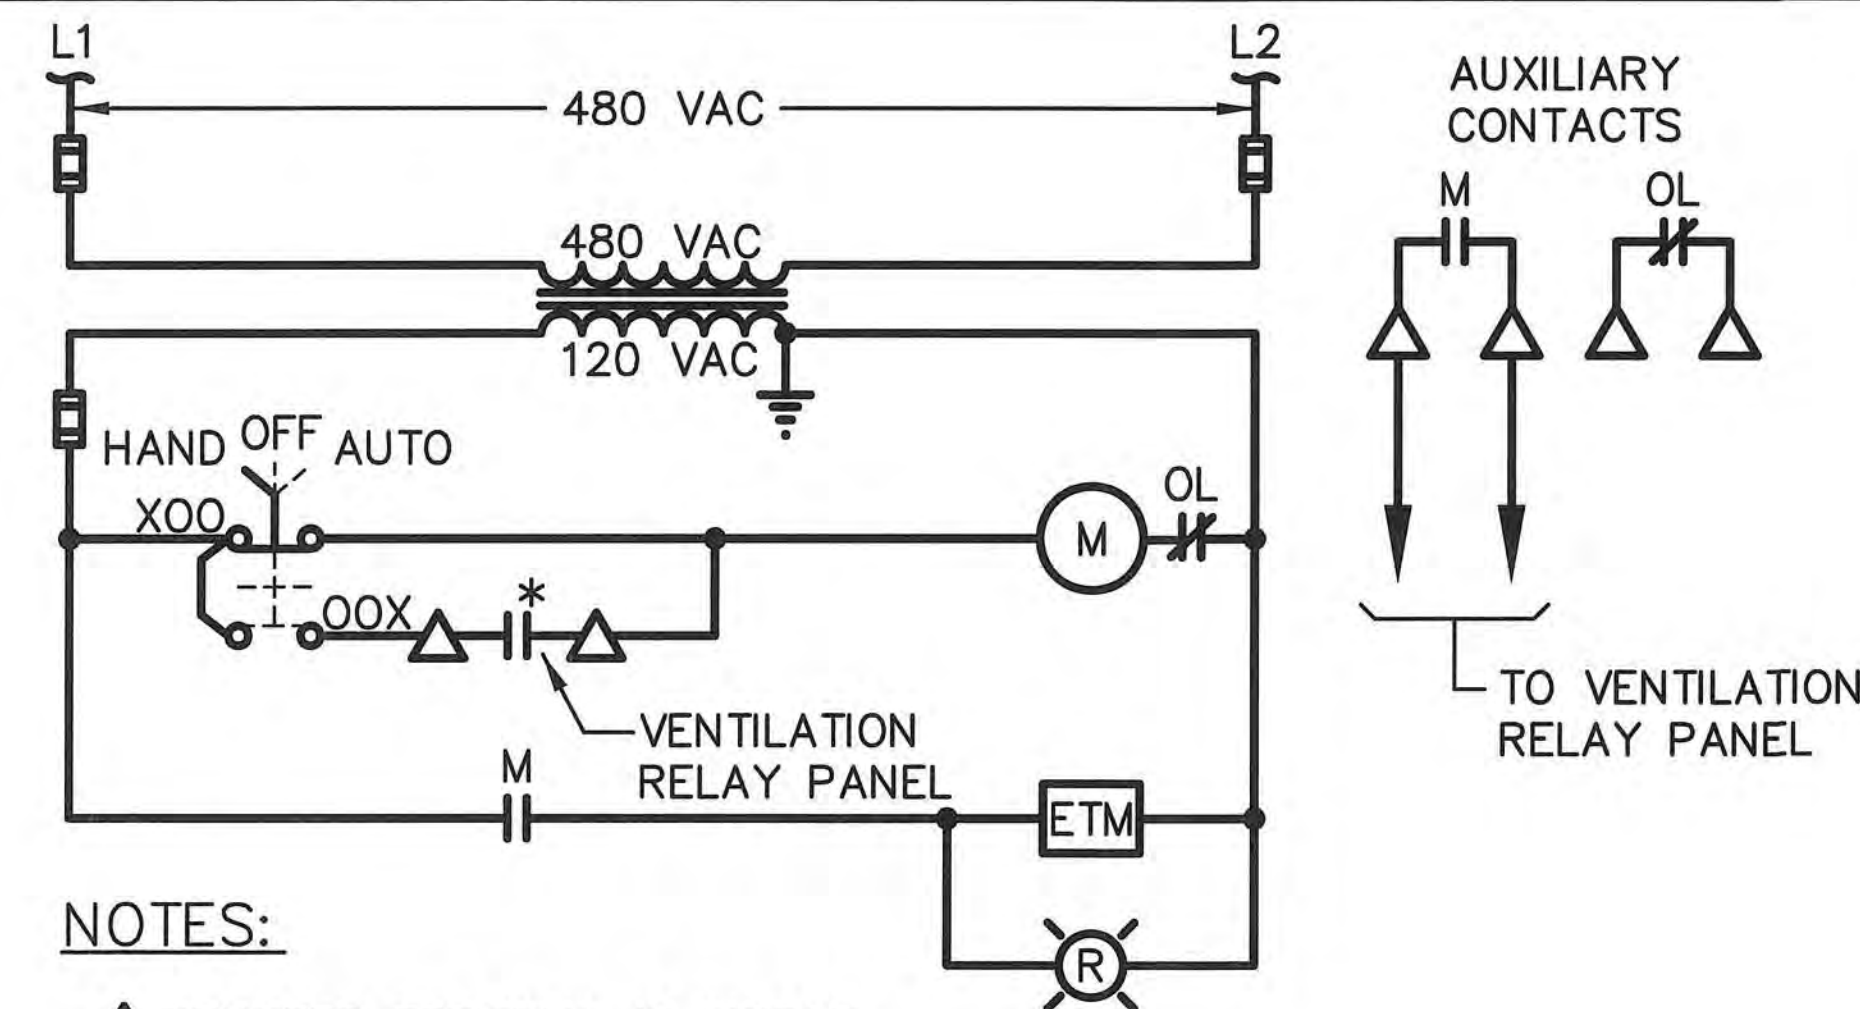


NOTES:

- Δ DENOTES TERMINAL IN MOTOR STARTER FOR FIELD CONNECTION.
- * DEVICE LOCATED REMOTE FROM STARTER

4 SUPPLY FAN - MOTOR CONTROL CIRCUIT DIAGRAM

(TYPICAL FOR SF-1 & SF-2)

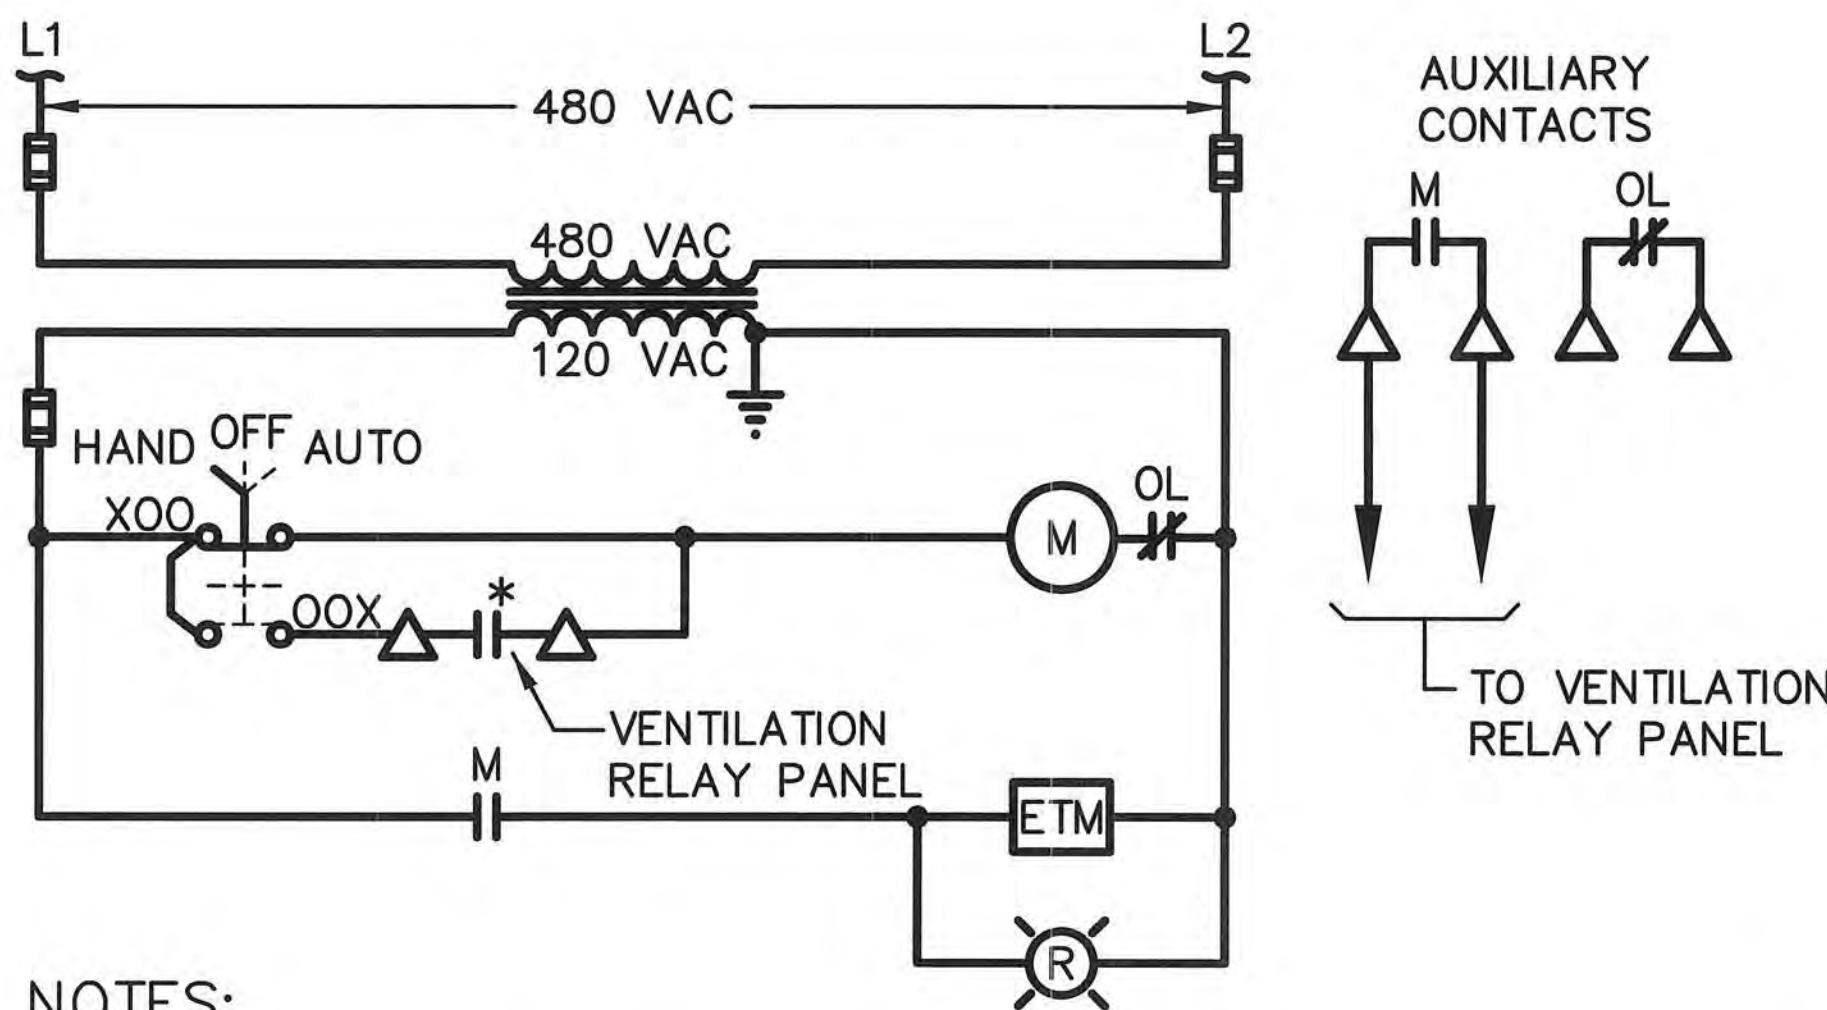


NOTES:

- Δ DENOTES TERMINAL IN MOTOR STARTER FOR FIELD CONNECTION.
- * DEVICE LOCATED REMOTE FROM STARTER

5 EXHAUST FAN - MOTOR CONTROL CIRCUIT DIAGRAM

(TYPICAL FOR EF-1, EF-2 & EF-3)

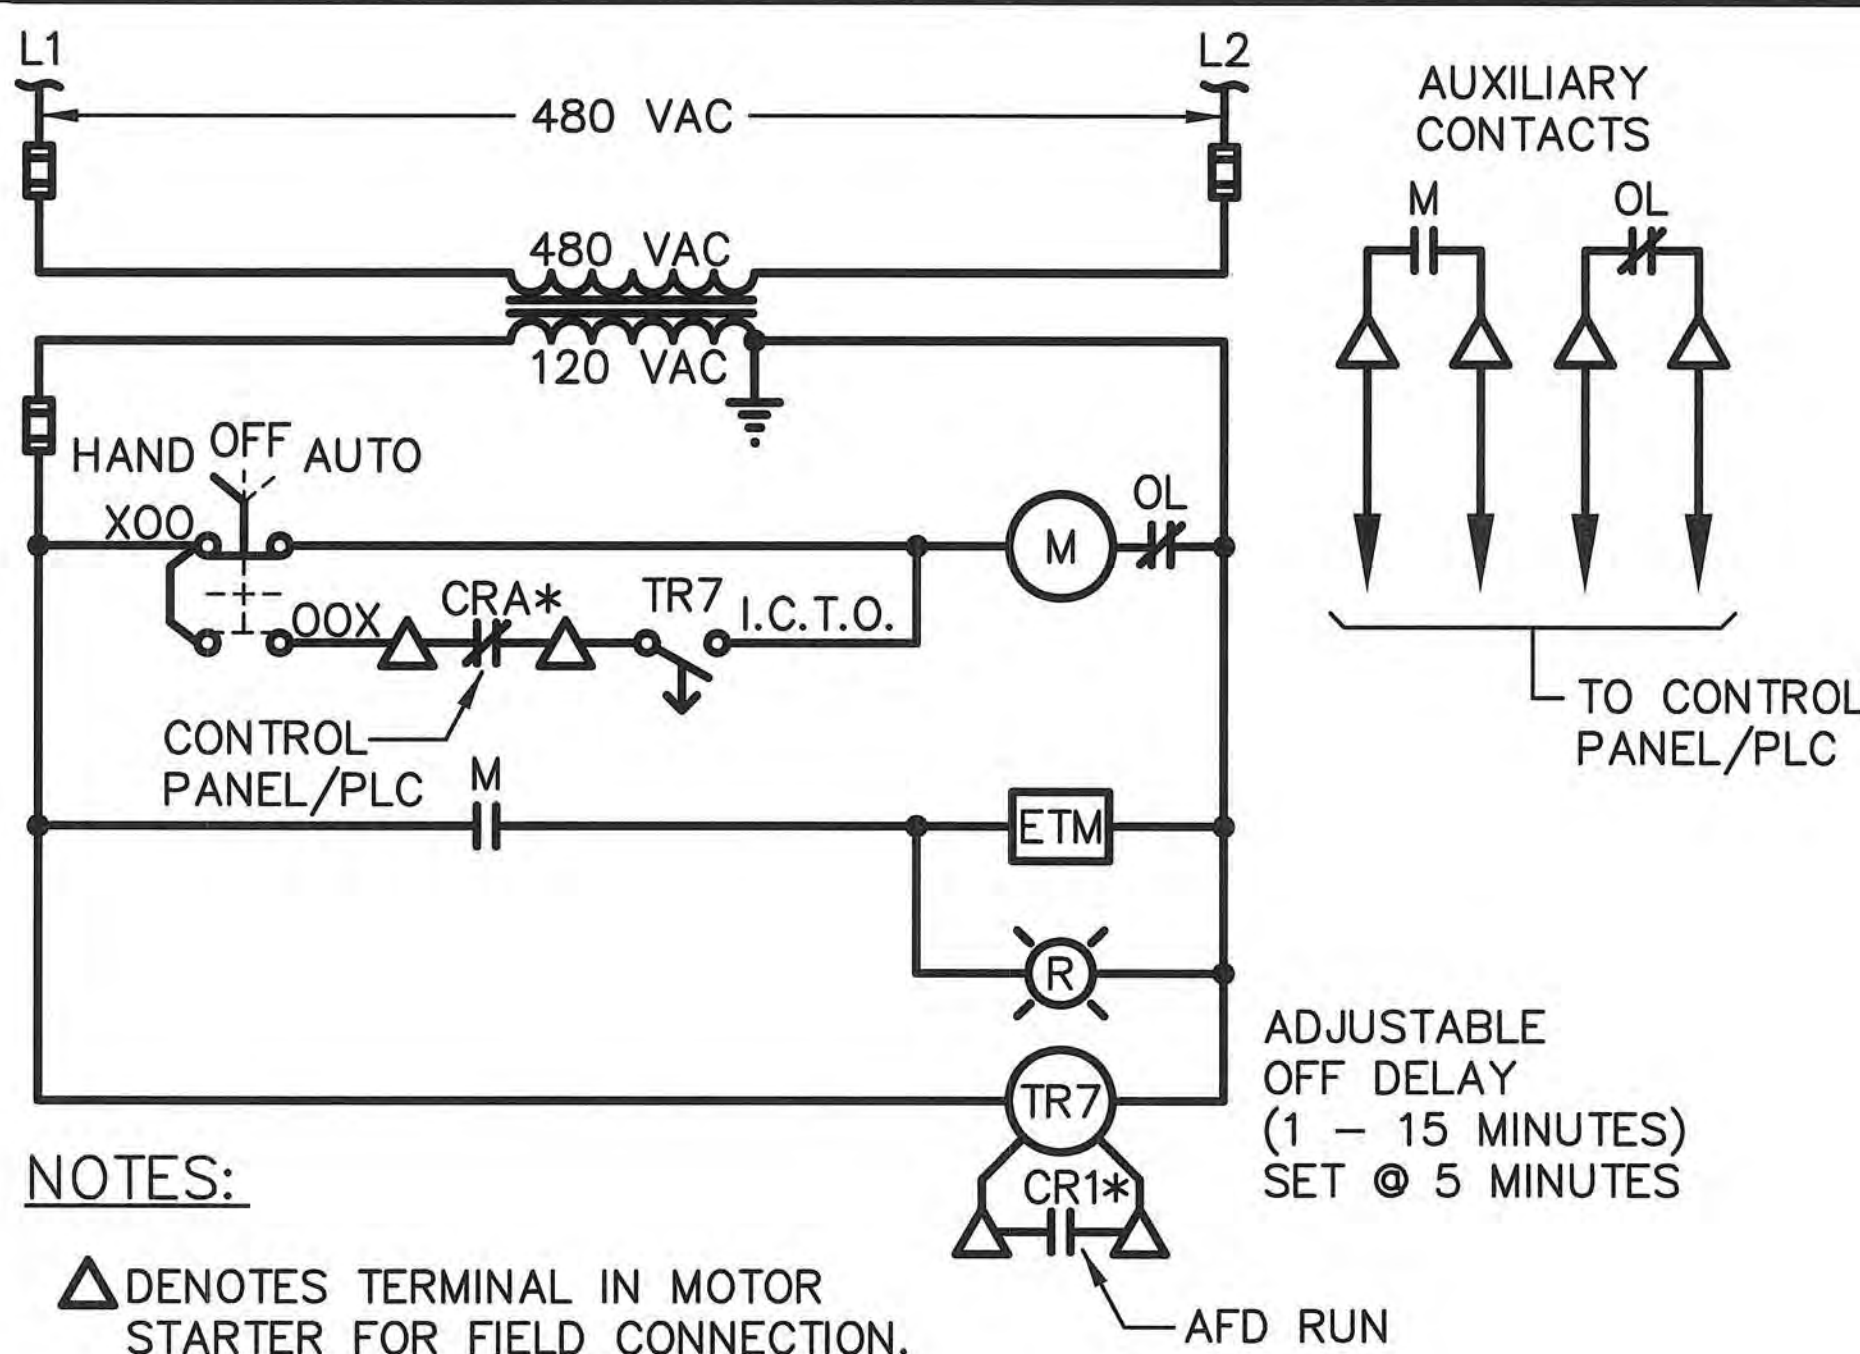

NOTES:

- Δ DENOTES TERMINAL IN MOTOR STARTER FOR FIELD CONNECTION.
- * DEVICE LOCATED REMOTE FROM STARTER

6 PUMP BLOWER - MOTOR CONTROL CIRCUIT DIAGRAM

(TYPICAL FOR PUMP NO. 1 - PUMP NO.4 BLOWERS)

ENGINEER OF RECORD:
BOB E. HALLMAN, P.E.
FLORIDA REGISTRATION NO. 20761



Engineering Design
Technologies Corp.
P.O. Box 152403
Tampa, FL 33684-2403
813.289.8080
813.282.9184 FAX
engineering@edt1.com

CITY of TAMPA
WASTEWATER DEPARTMENT

KRAUSE PS REHABILITATION

ELECTRICAL DETAILS


NO.	DATE	REVISIONS

DRAWN: RWB
DESIGN: STK
QC: BEH
DATE: 05/01/14


B080-105

NOTES:


1. TO TEC SWITCHES. EXTEND CONDUITS 3' BEYOND PROPERTY LINE AND STAKE LOCATION. COORDINATE LOCATION WITH TEC.

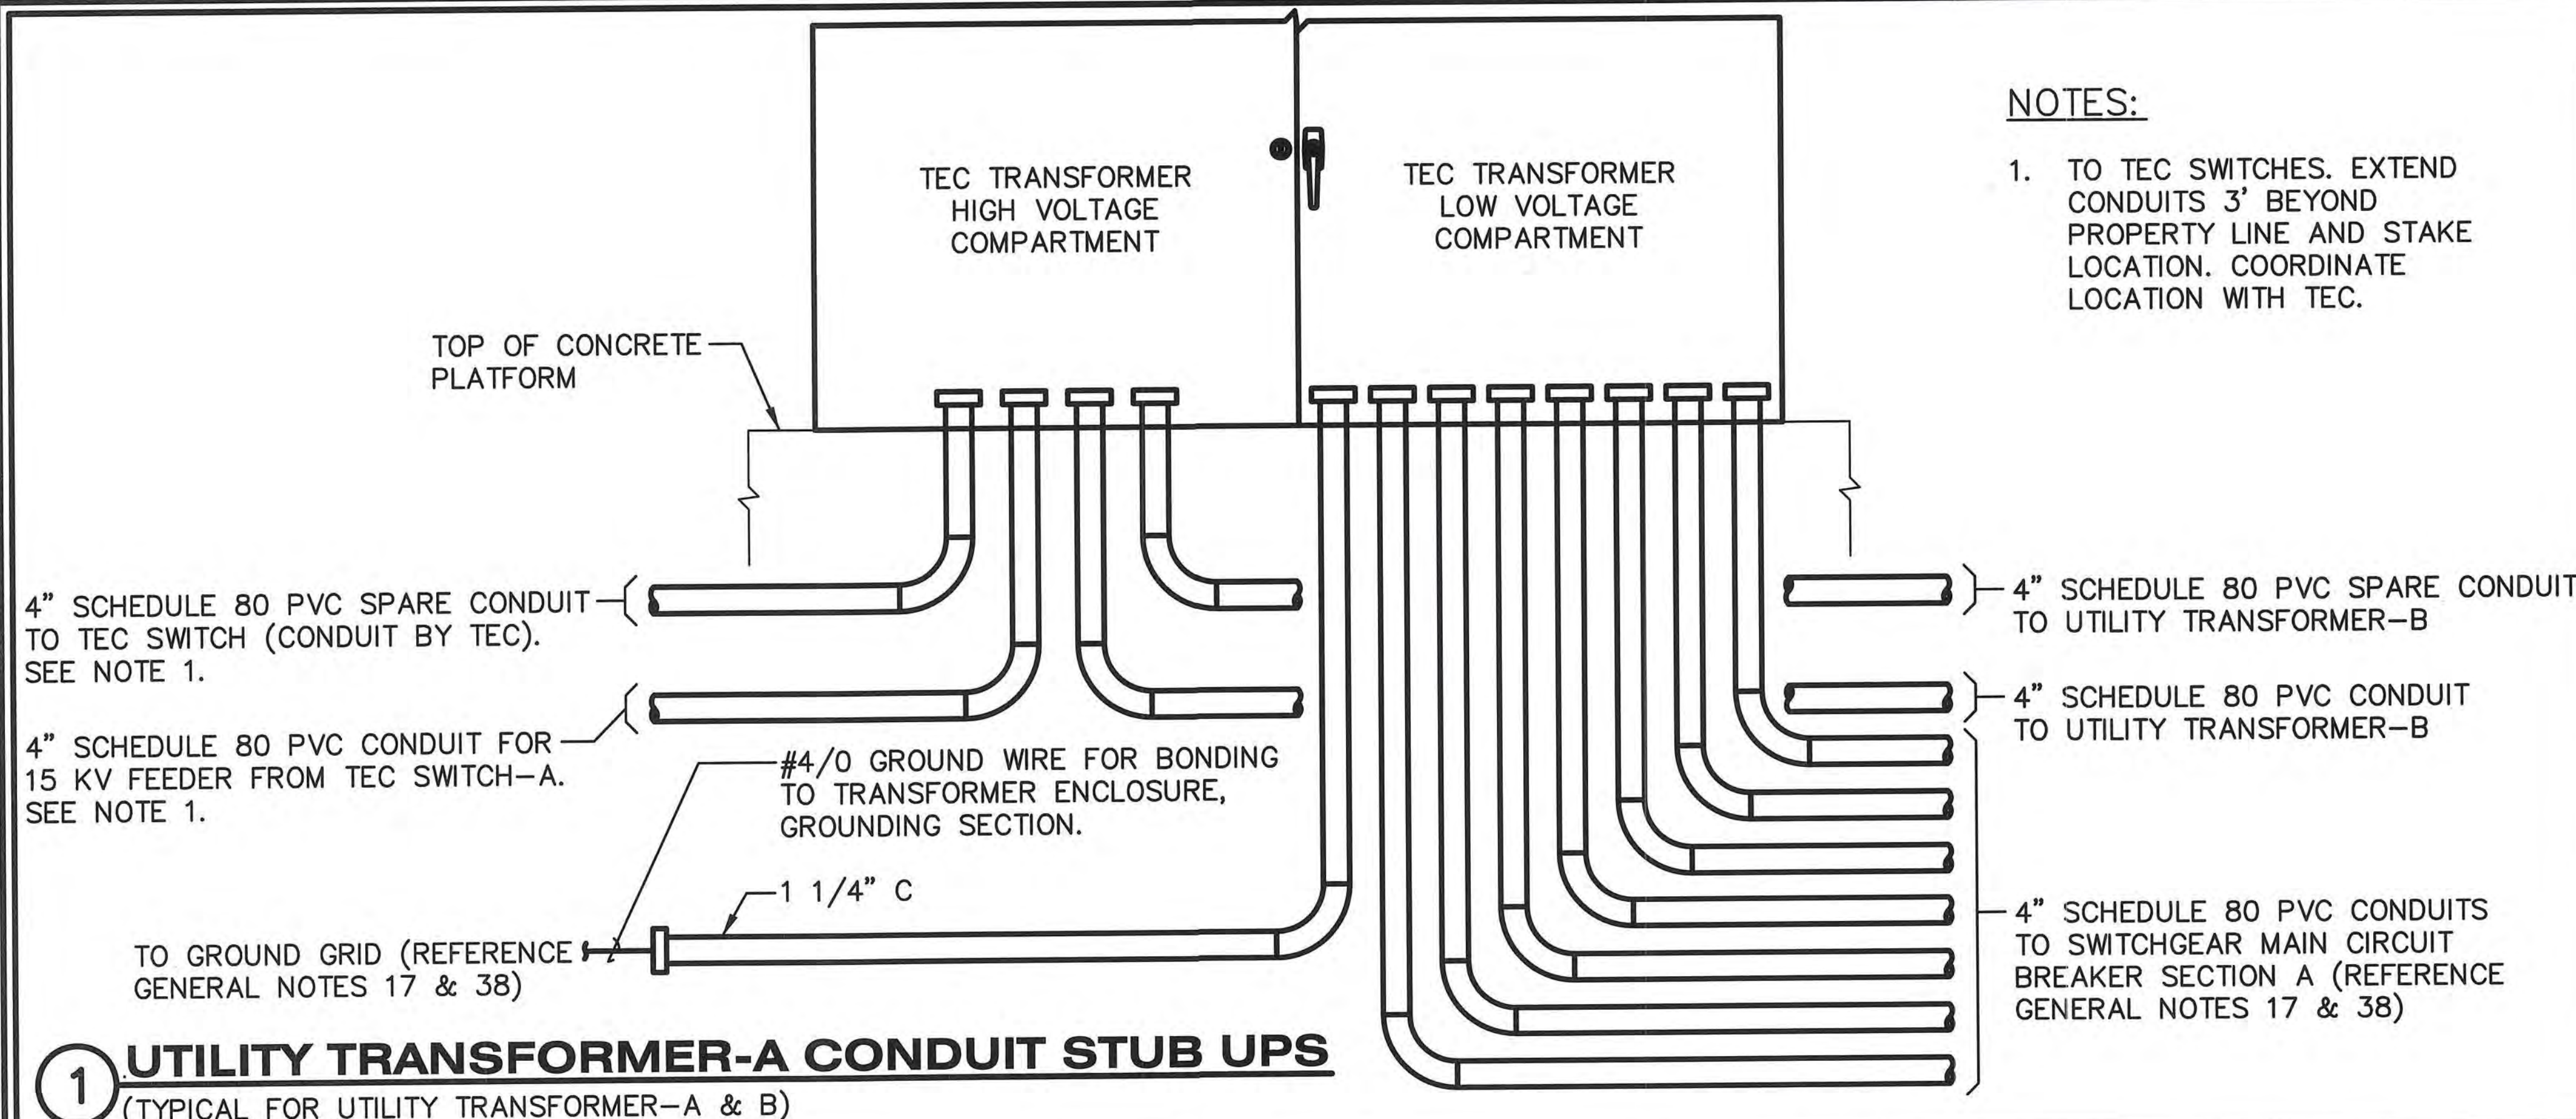

1 UTILITY TRANSFORMER-A CONDUIT STUB UPS
(TYPICAL FOR UTILITY TRANSFORMER-A & B)

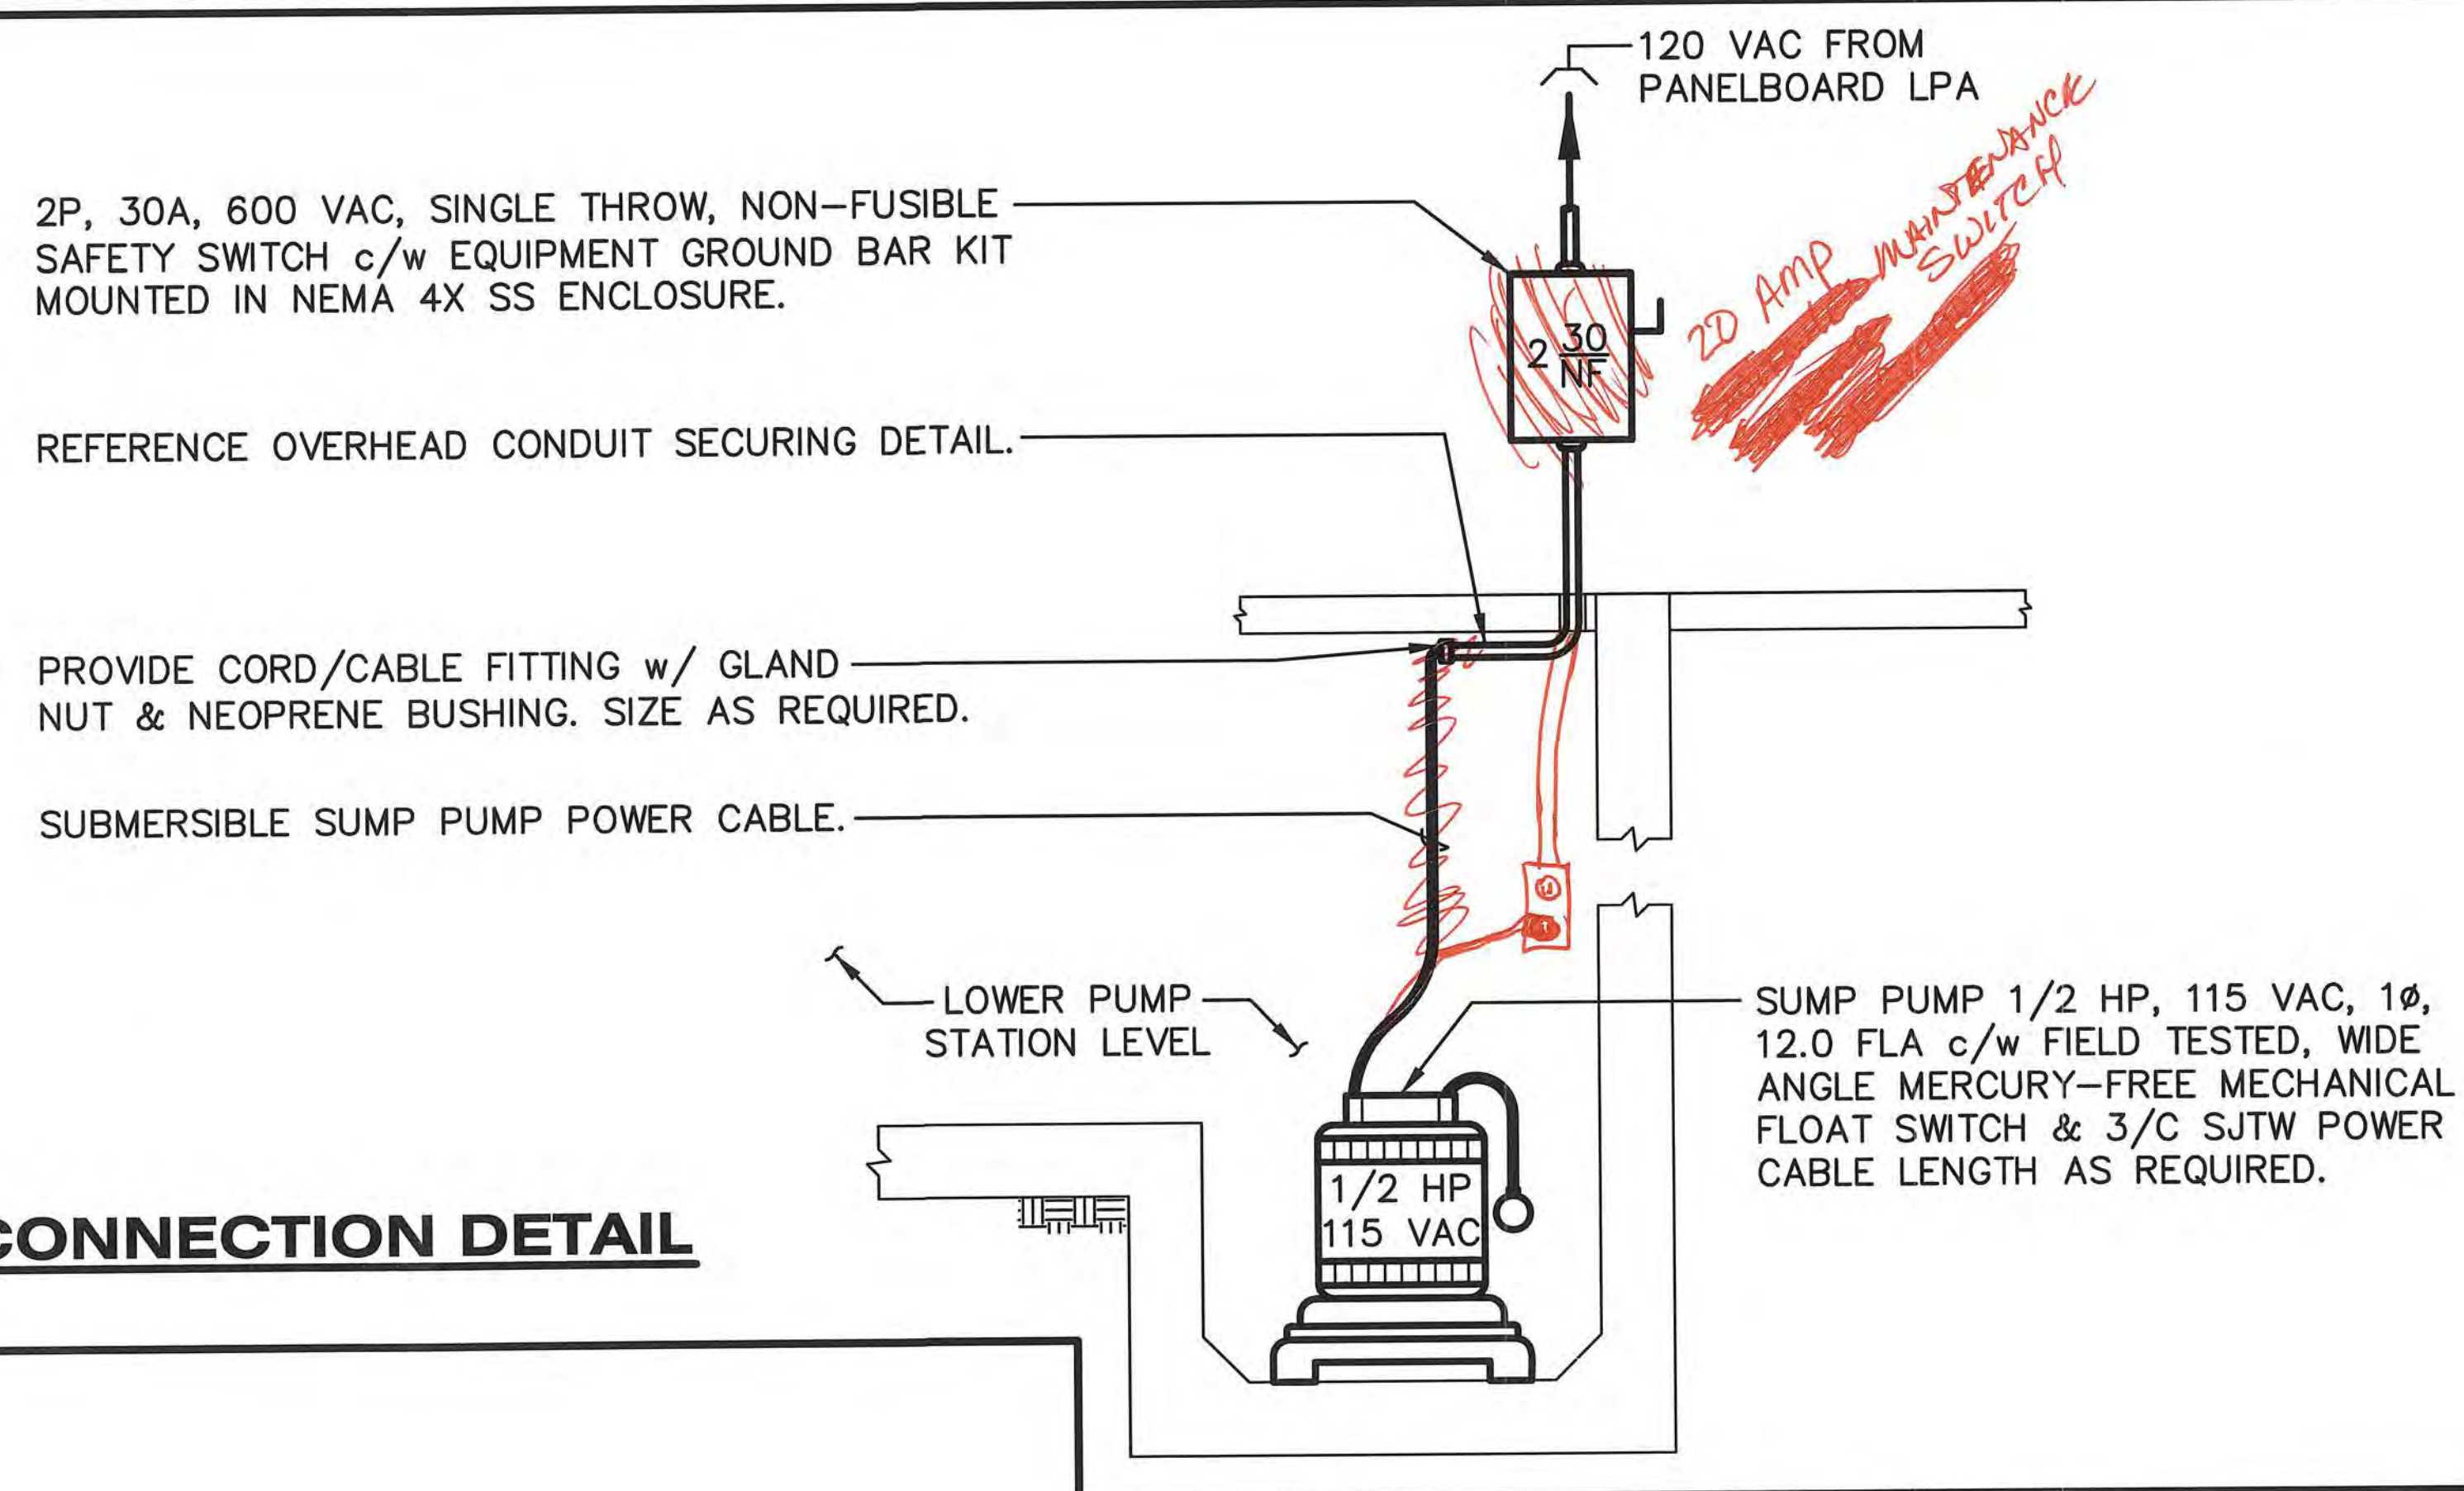

4 SUMP PUMP CONNECTION DETAIL

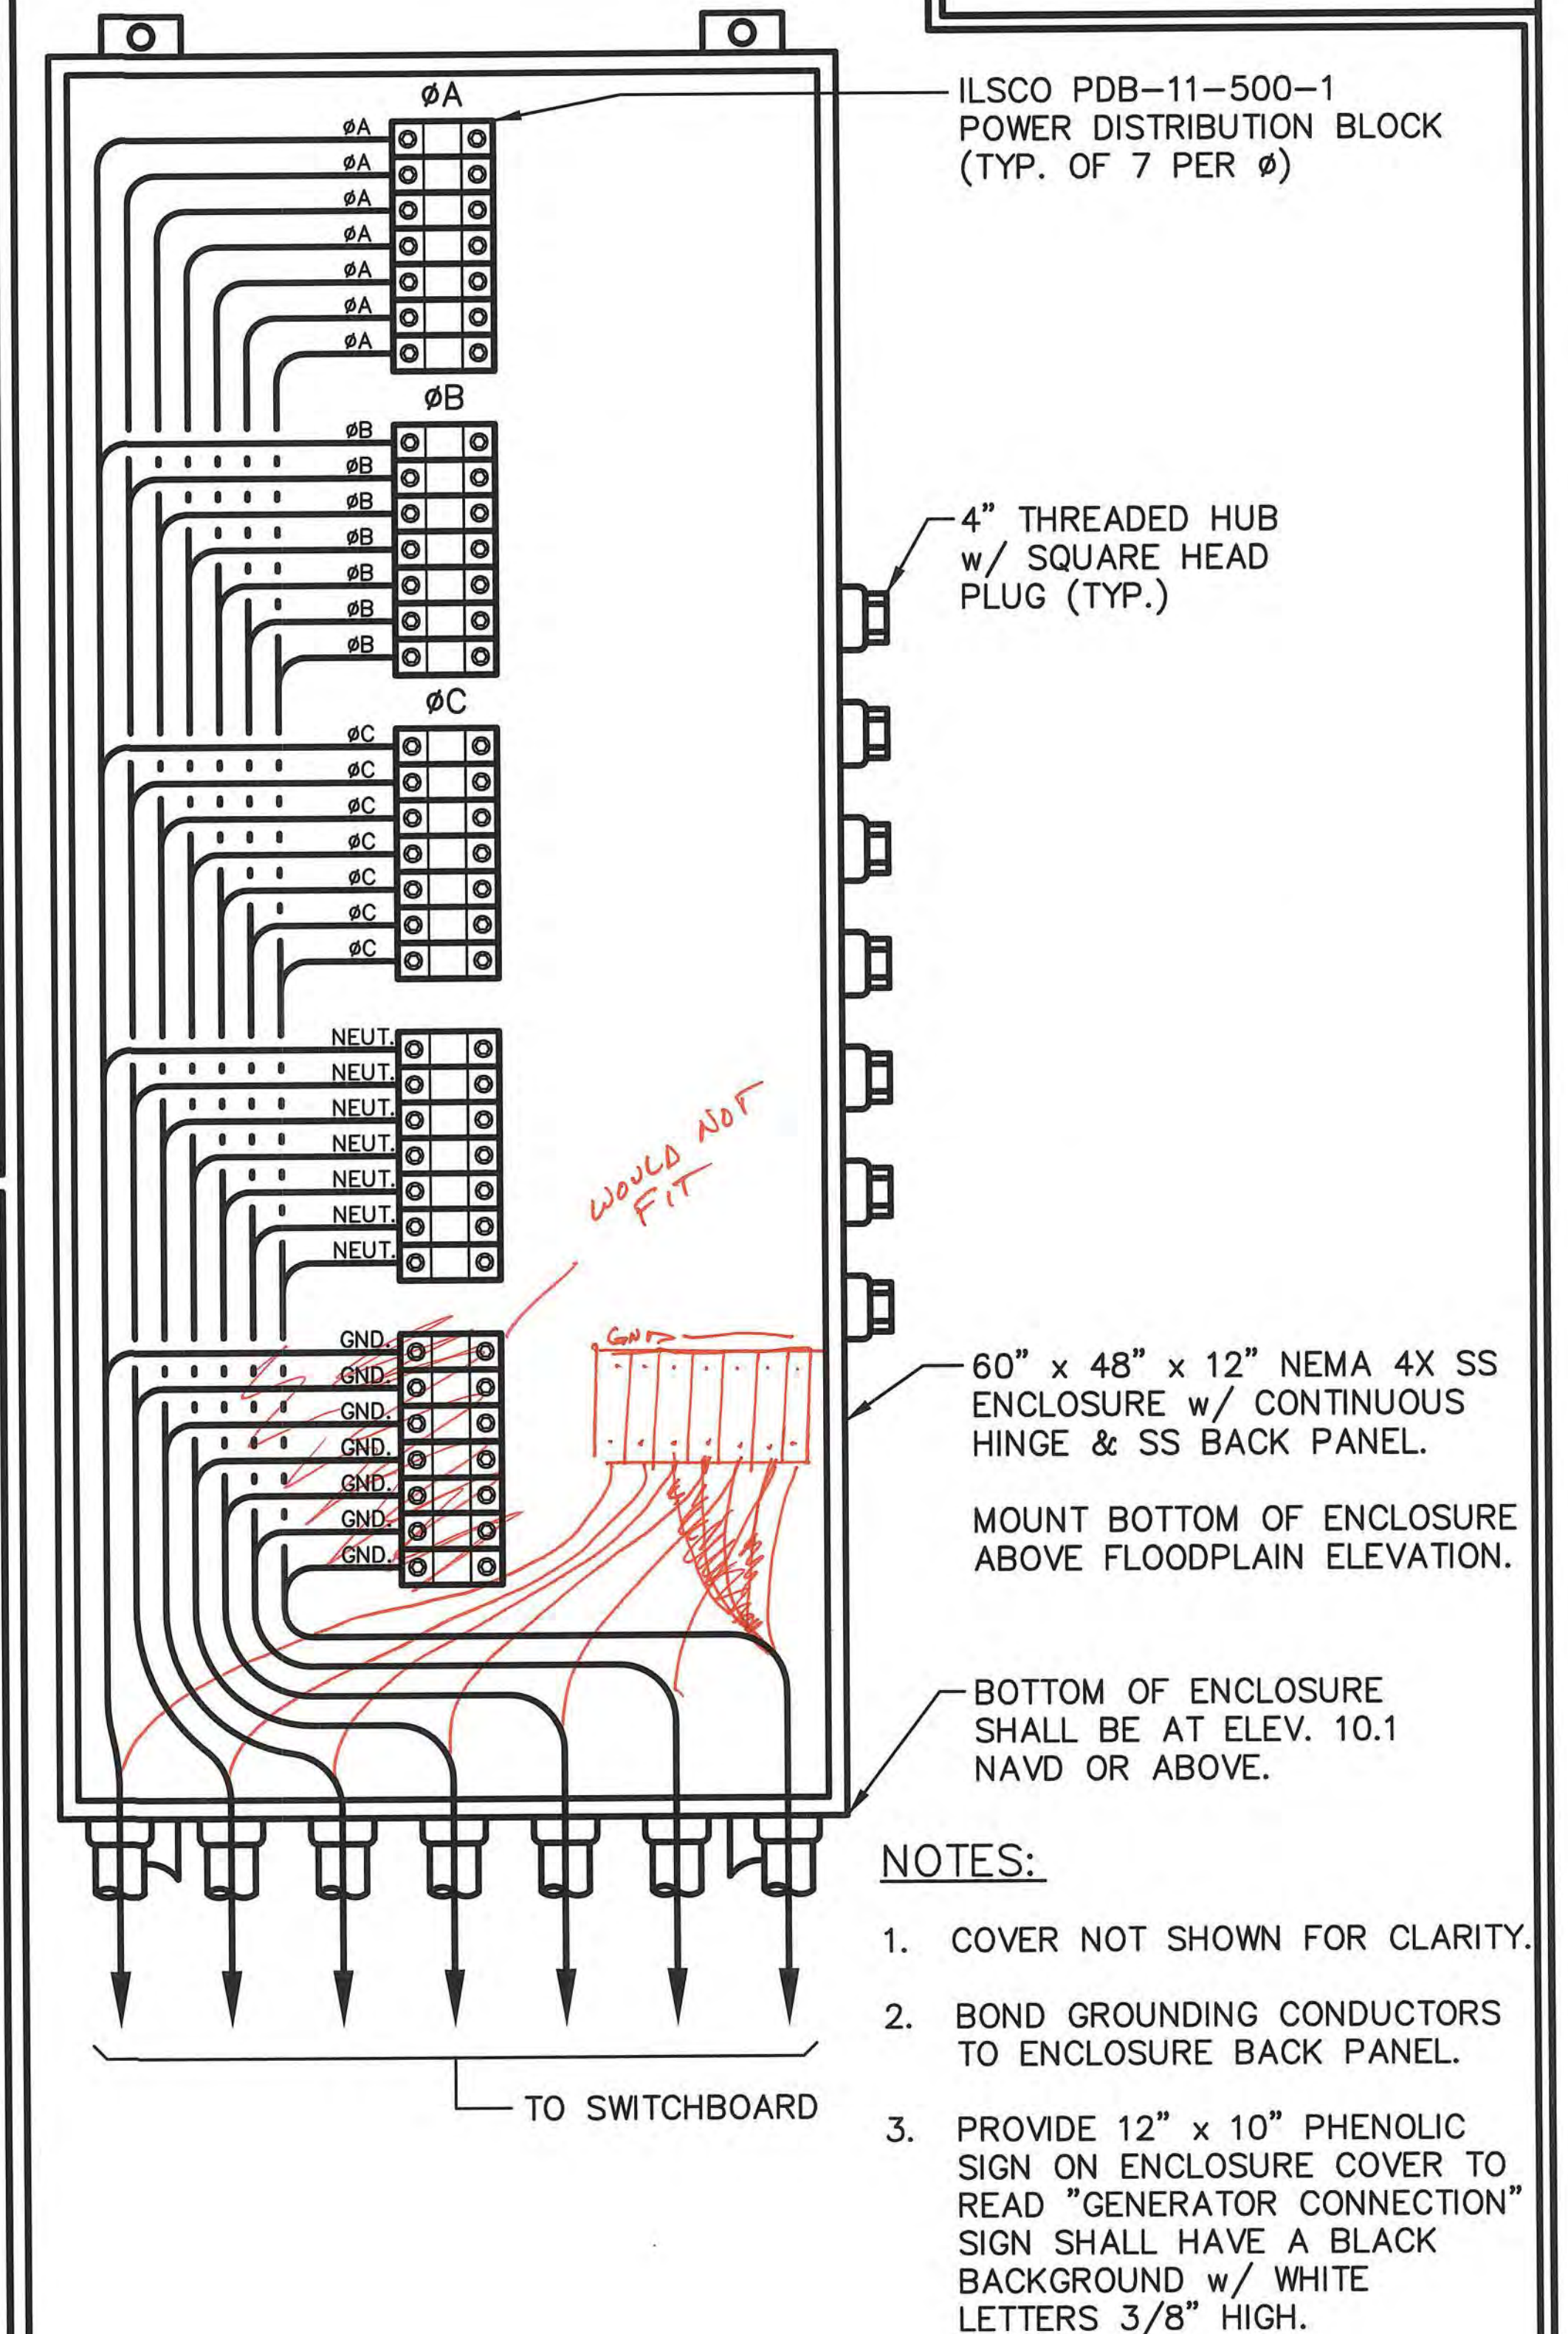

6 TYPICAL GENERATOR TERMINAL BOX DETAIL
TYPICAL FOR BUS A AND BUS B GENERATORS

NOTES:

1. COVER NOT SHOWN FOR CLARITY.
2. BOND GROUNDING CONDUCTORS TO ENCLOSURE BACK PANEL.
3. PROVIDE 12" x 10" PHENOLIC SIGN ON ENCLOSURE COVER TO READ "GENERATOR CONNECTION" SIGN SHALL HAVE A BLACK BACKGROUND w/ WHITE LETTERS 3/8" HIGH.

ENGINEER OF RECORD:
BOB E. HALLMAN, P.E.
FLORIDA REGISTRATION NO. 20761



Engineering Design
Technologies Corp.
P.O. Box 152403
Tampa, FL 33684-2403
813.289.8080
813.282.9184 FAX
engineering@edt1.com

CITY of TAMPA
WASTEWATER DEPARTMENT


KRAUSE PS REHABILITATION

ELECTRICAL DETAILS

DRAWN: RWB
DESIGN: STK
QC: BEH
DATE: 05/01/14

SHEET E-44

NO.	DATE	REVISIONS

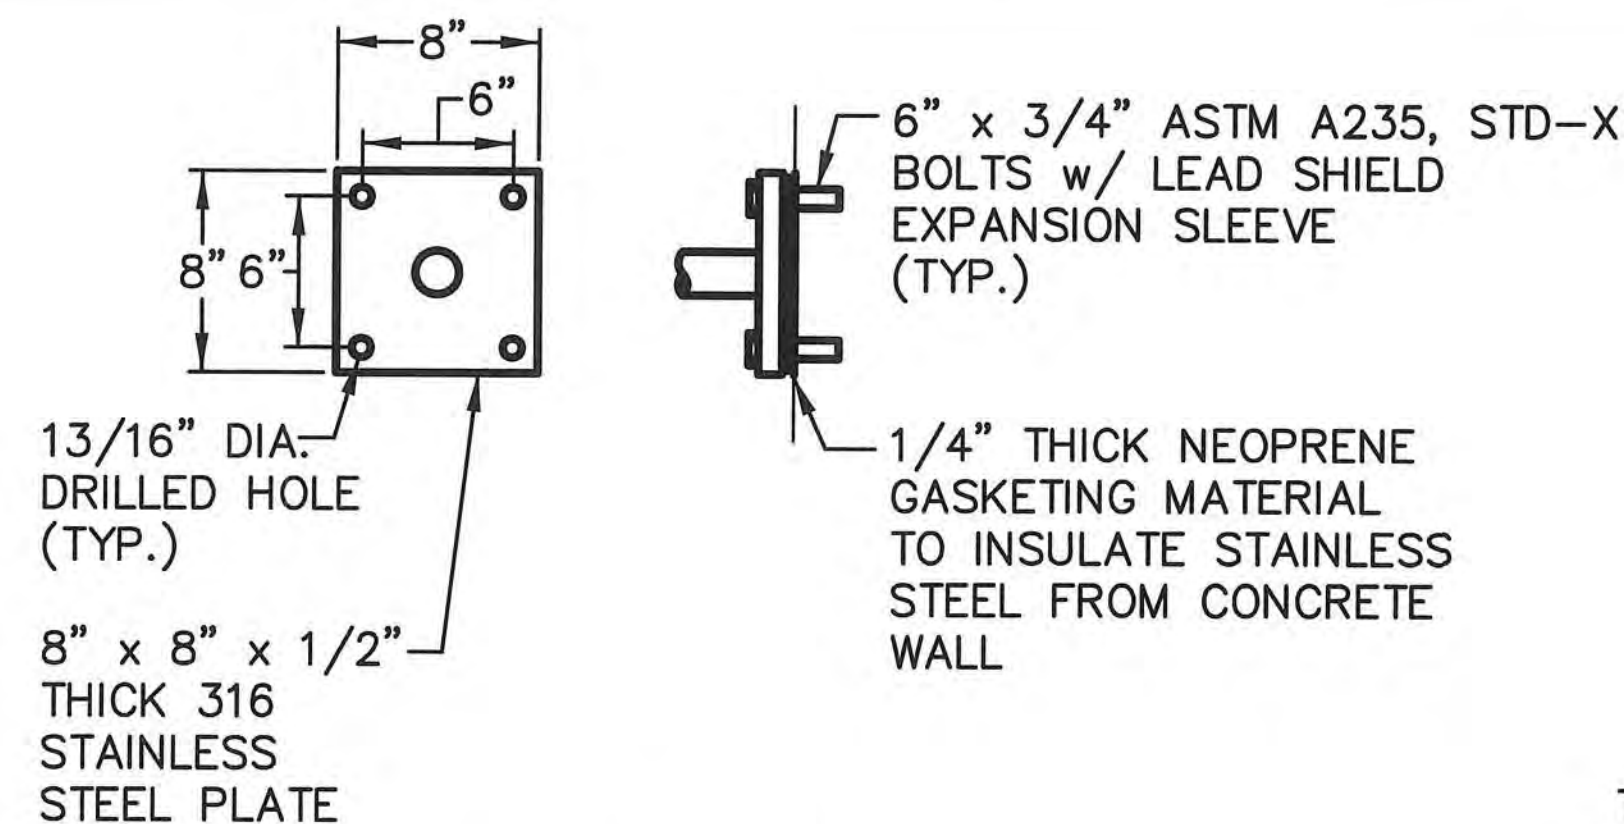


ANCHOR PLATE DETAIL

NOTES:

1. ALL SHAPES SHALL BE FABRICATED OF 316 STAINLESS STEEL.
2. ALL JOINTS SHALL BE WELDED.
3. COORDINATE FLOAT ACTIVATION ELEVATIONS WITH CITY.

1 FLOAT SWITCH MOUNTING DETAIL

(TYP. FOR PUMP STATION LOWER LEVEL FLOAT SWITCHES & WET WELL FLOAT SWITCH)

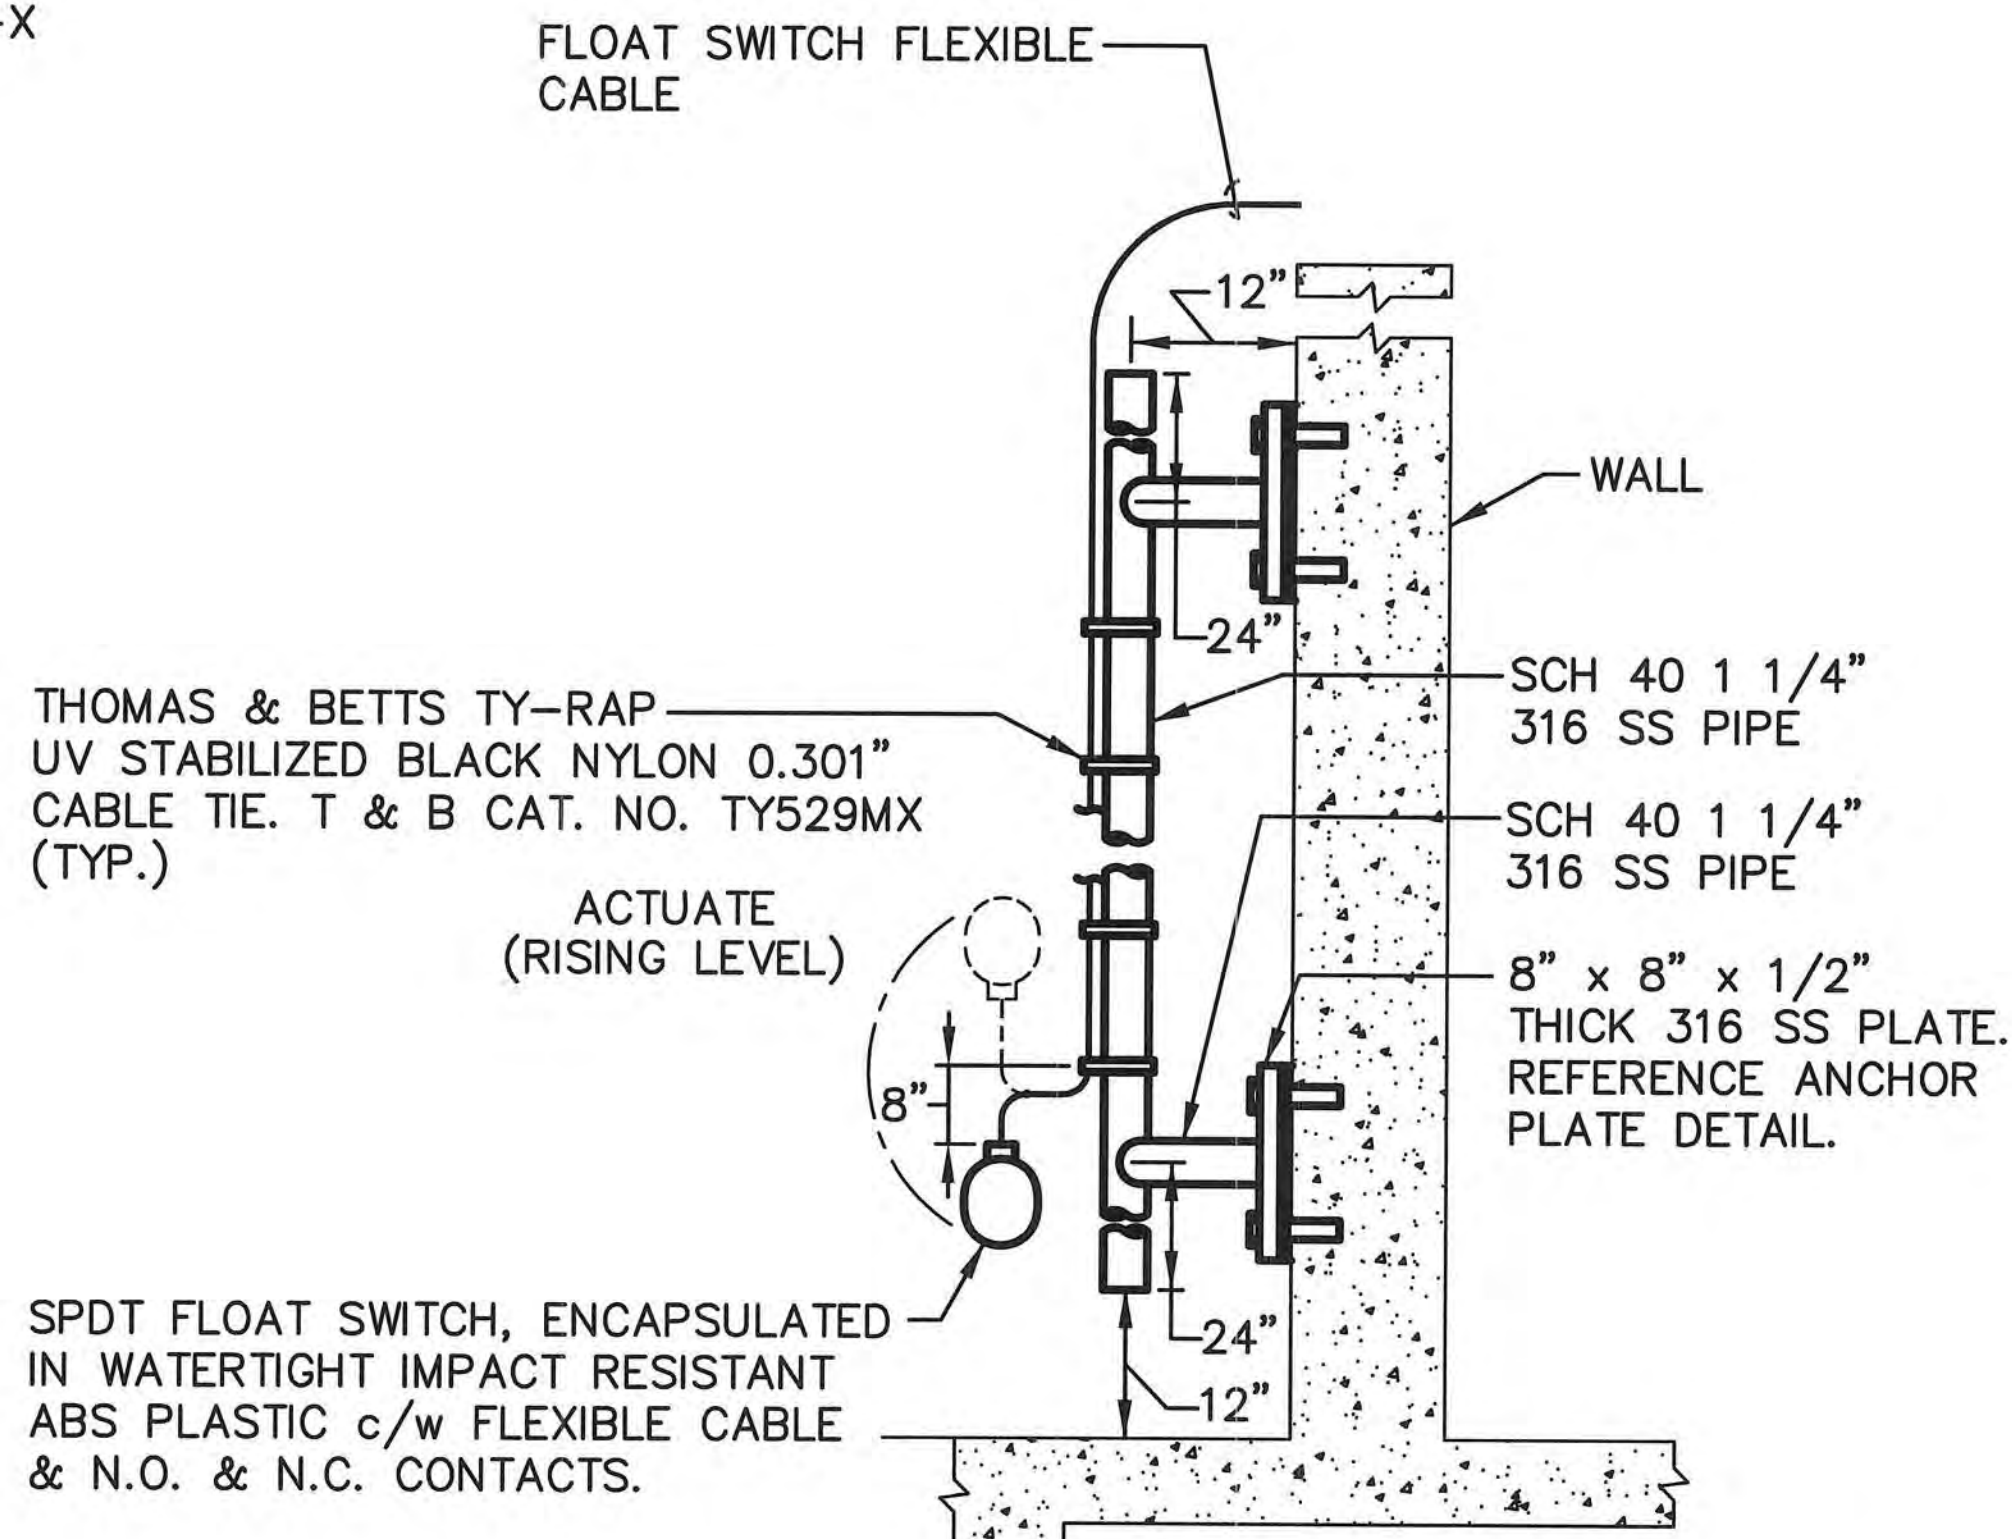

3

NOTES:

1. COVER NOT SHOWN FOR CLARITY.
2. BOND GROUNDING CONDUCTORS TO ENCLOSURE BACK PANEL.
3. ALL CONDUCTORS AND ASSOCIATED TERMINALS THAT ARE PART OF THE INTRINSICALLY SAFE CIRCUIT SHALL BE CLEARLY IDENTIFIED WITH PERMANENTLY AFFIXED LABELS READING "INTRINSIC SAFETY WIRING".
4. LIGHT BLUE COLORED WIRING INSULATION SHALL BE RESERVED FOR INTRINSICALLY SAFE WIRING.
5. INTRINSICALLY SAFE WIRING AND TERMINALS SHALL BE SEPARATED FROM OTHER WIRING BY NOT LESS THAN 2".


CROUSE-HINDS EYS SERIES SEALING FITTING

INTRINSICALLY SAFE WIRING

8" x 6" x 4" NEMA 4X SS ENCLOSURE w/ CONTINUOUS HINGE & BACK PANEL. HOFFMAN CAT. NO. A-8064CHNFSS (ENCLOSURE) & A-8P6 (BACK PANEL). MOUNT THE BOTTOM OF ENCLOSURE ABOVE FLOODPLAIN ELEVATION.

PROVIDE 30A, 600 VAC TERMINALS AS REQUIRED. SQUARE D CAT. NO. 9080 GM6

PROVIDE DUCT SEAL IN CONDUIT TO MINIMIZE PASSAGE OF GAS/MOISTURE.

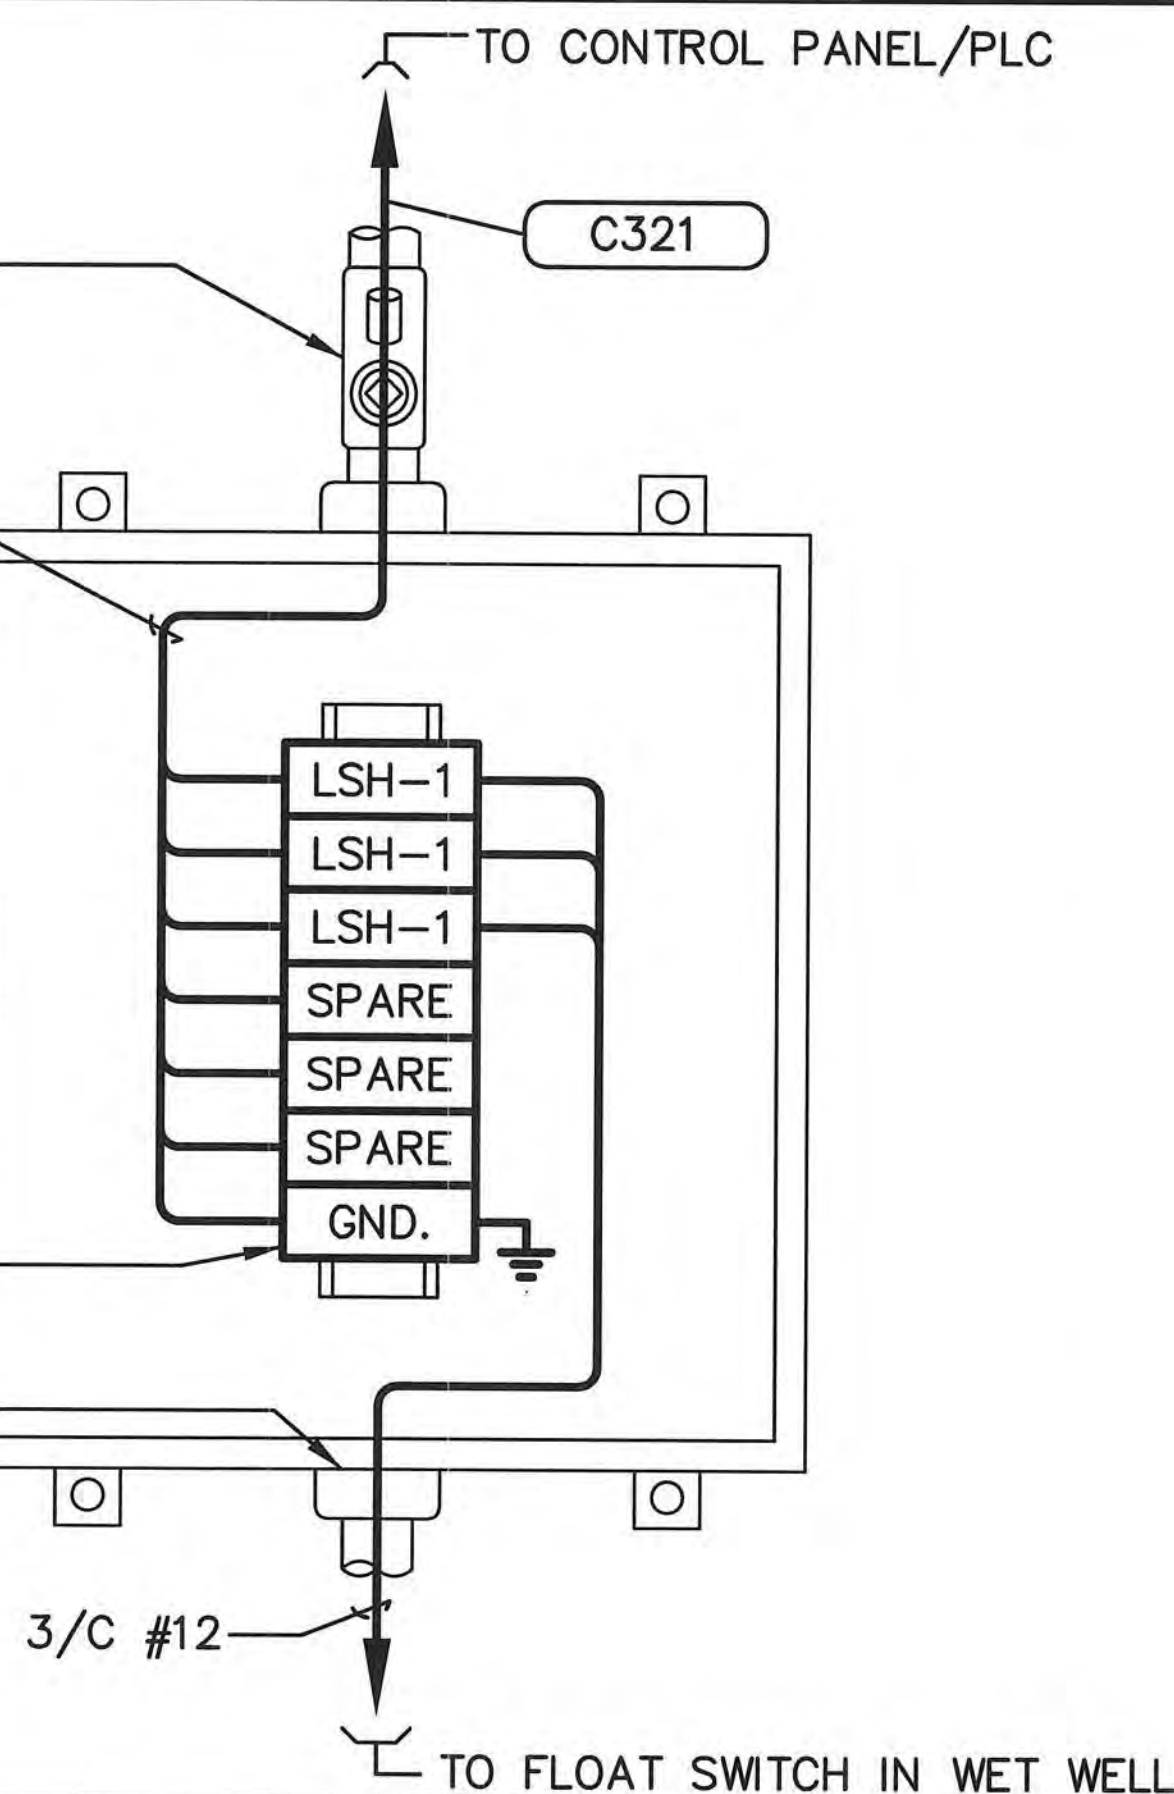

4 FLOAT SWITCH TERMINAL BOX DETAIL

6

ENGINEER OF RECORD:
BOB E. HALLMAN, P.E.
FLORIDA REGISTRATION NO. 20761



Engineering Design
Technologies Corp.
P.O. Box 152403
Tampa, FL 33684-2403
813.289.8080
813.282.9184 FAX
engineering@edt1.com

CITY of TAMPA
WASTEWATER DEPARTMENT

KRAUSE PS REHABILITATION


ELECTRICAL DETAILS

NO.	DATE	REVISIONS


DRAWN: RWB
DESIGN: STK
QC: BEH
DATE: 05/01/14

SHEET E-45


Certificate of Authorization Number: 4795

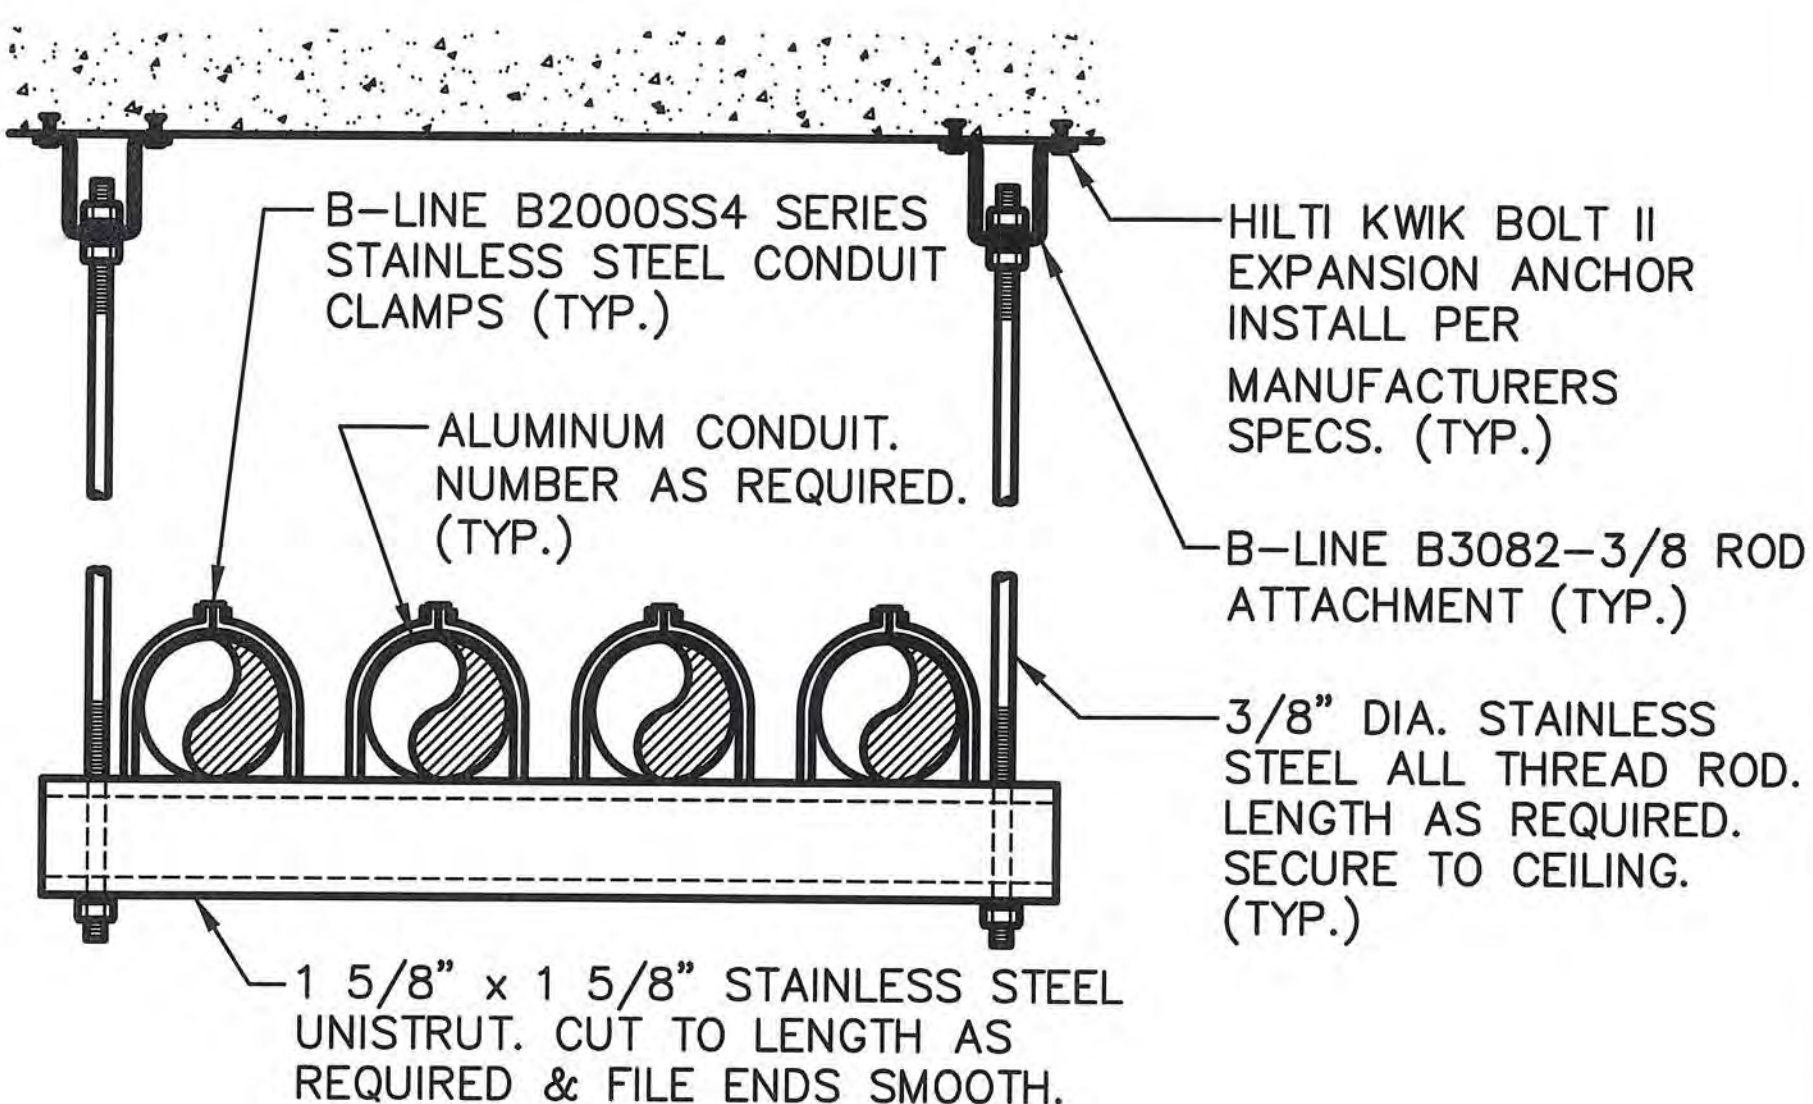


1 OVERHEAD CONDUIT SECURING DETAIL

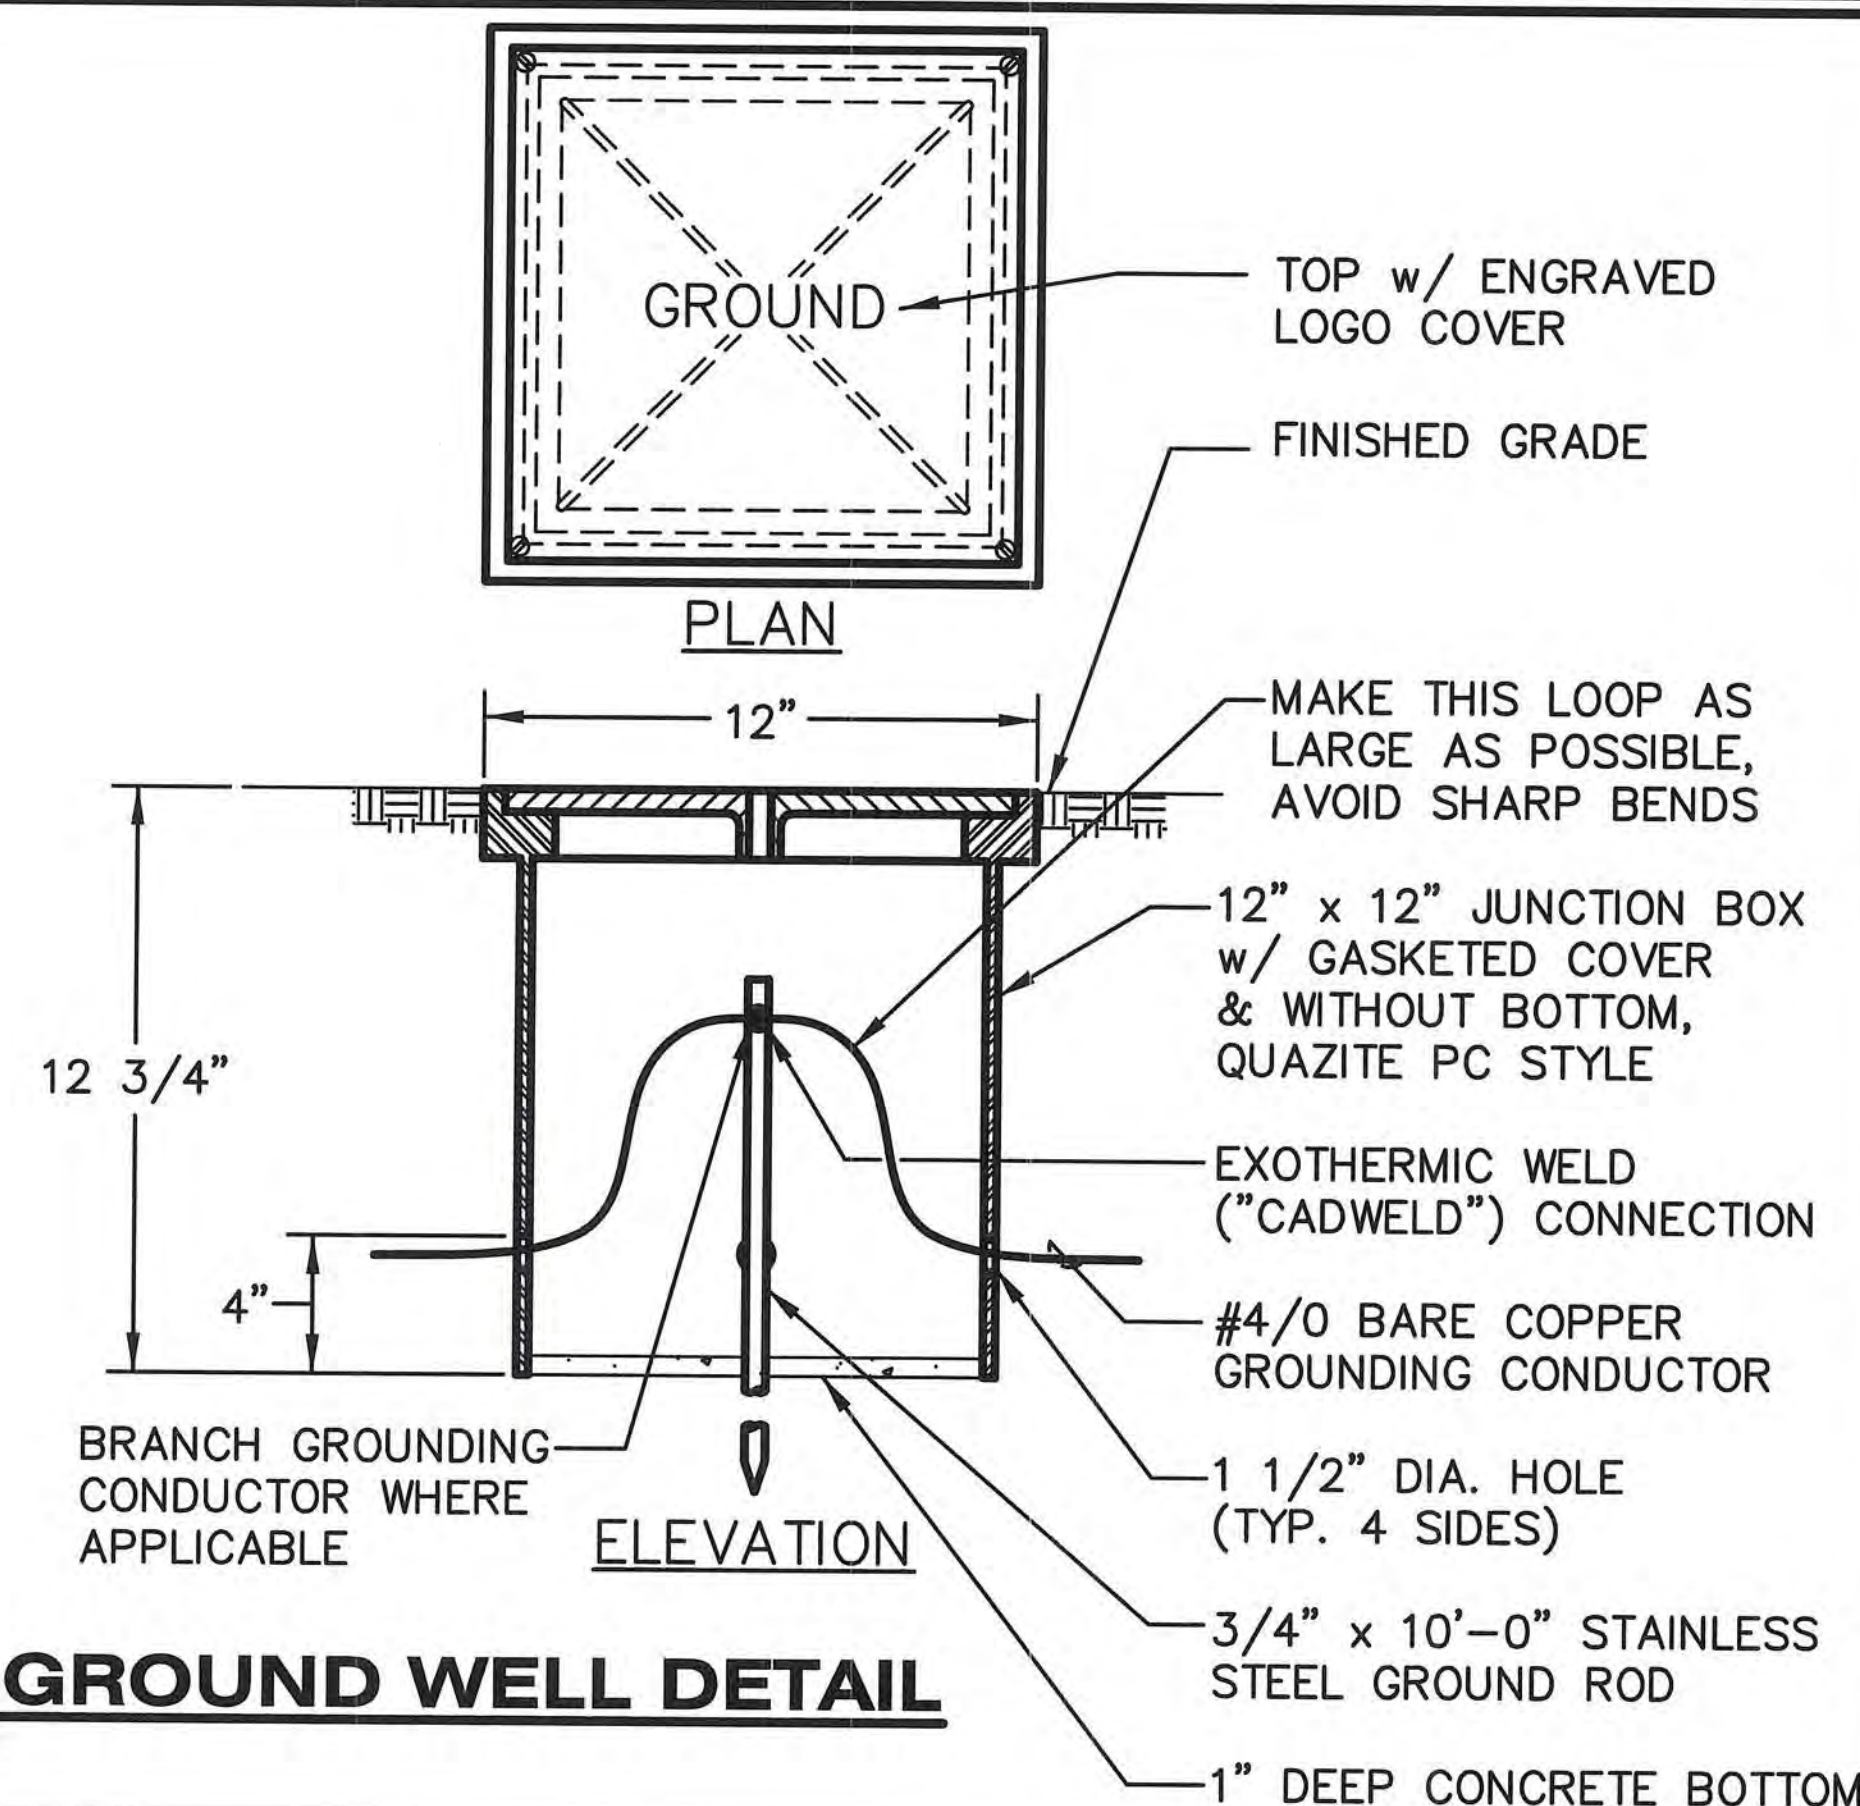


2 GROUND WELL DETAIL

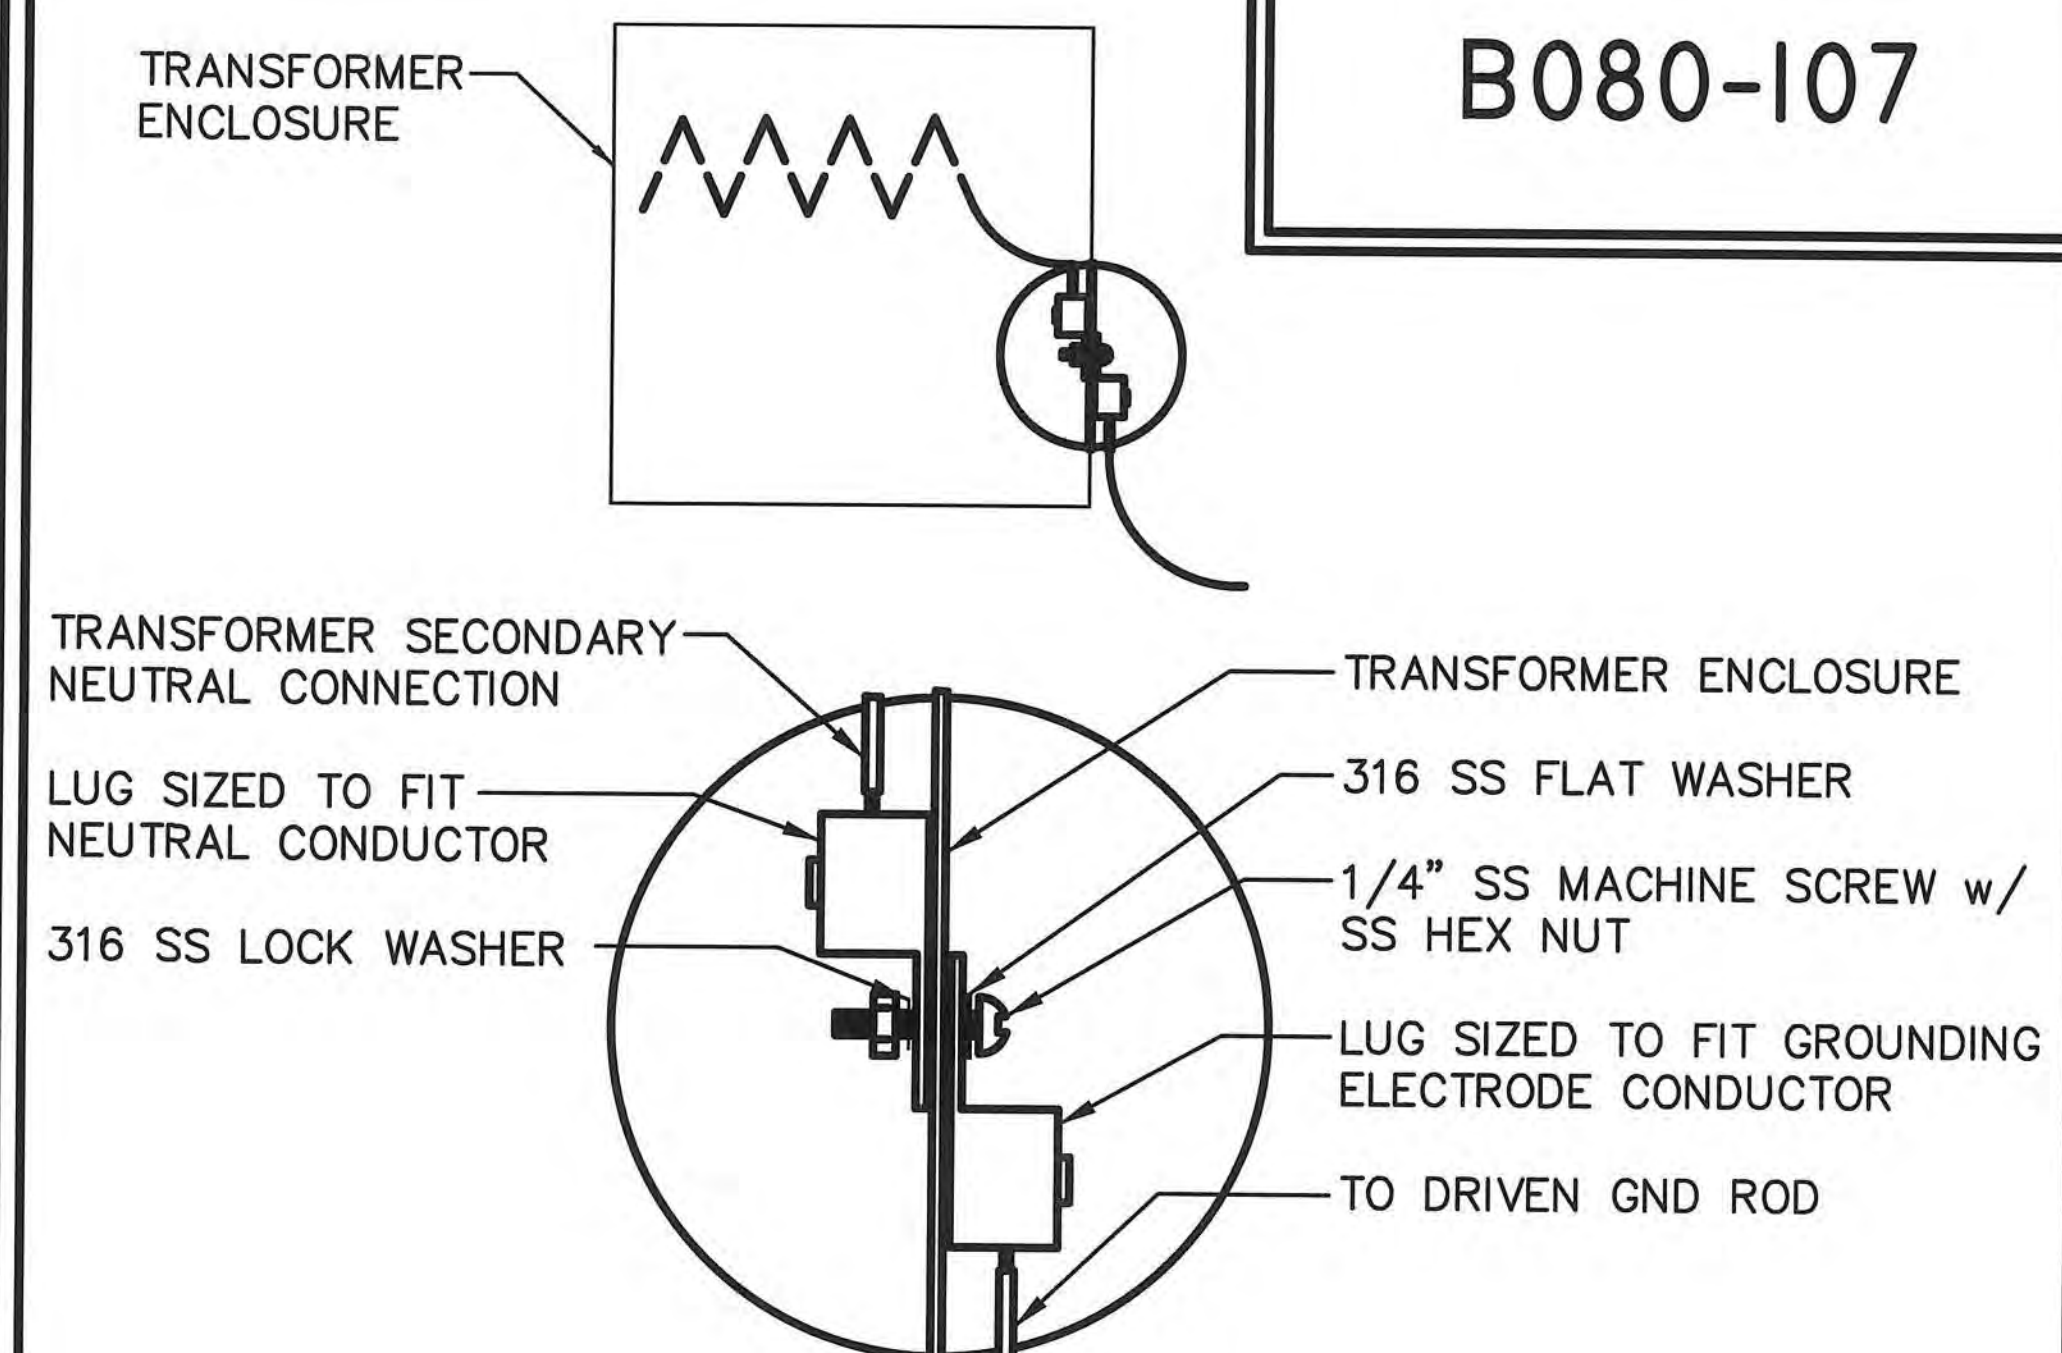


3 45 KVA TRANSFORMER NEUTRAL GROUNDING DETAIL

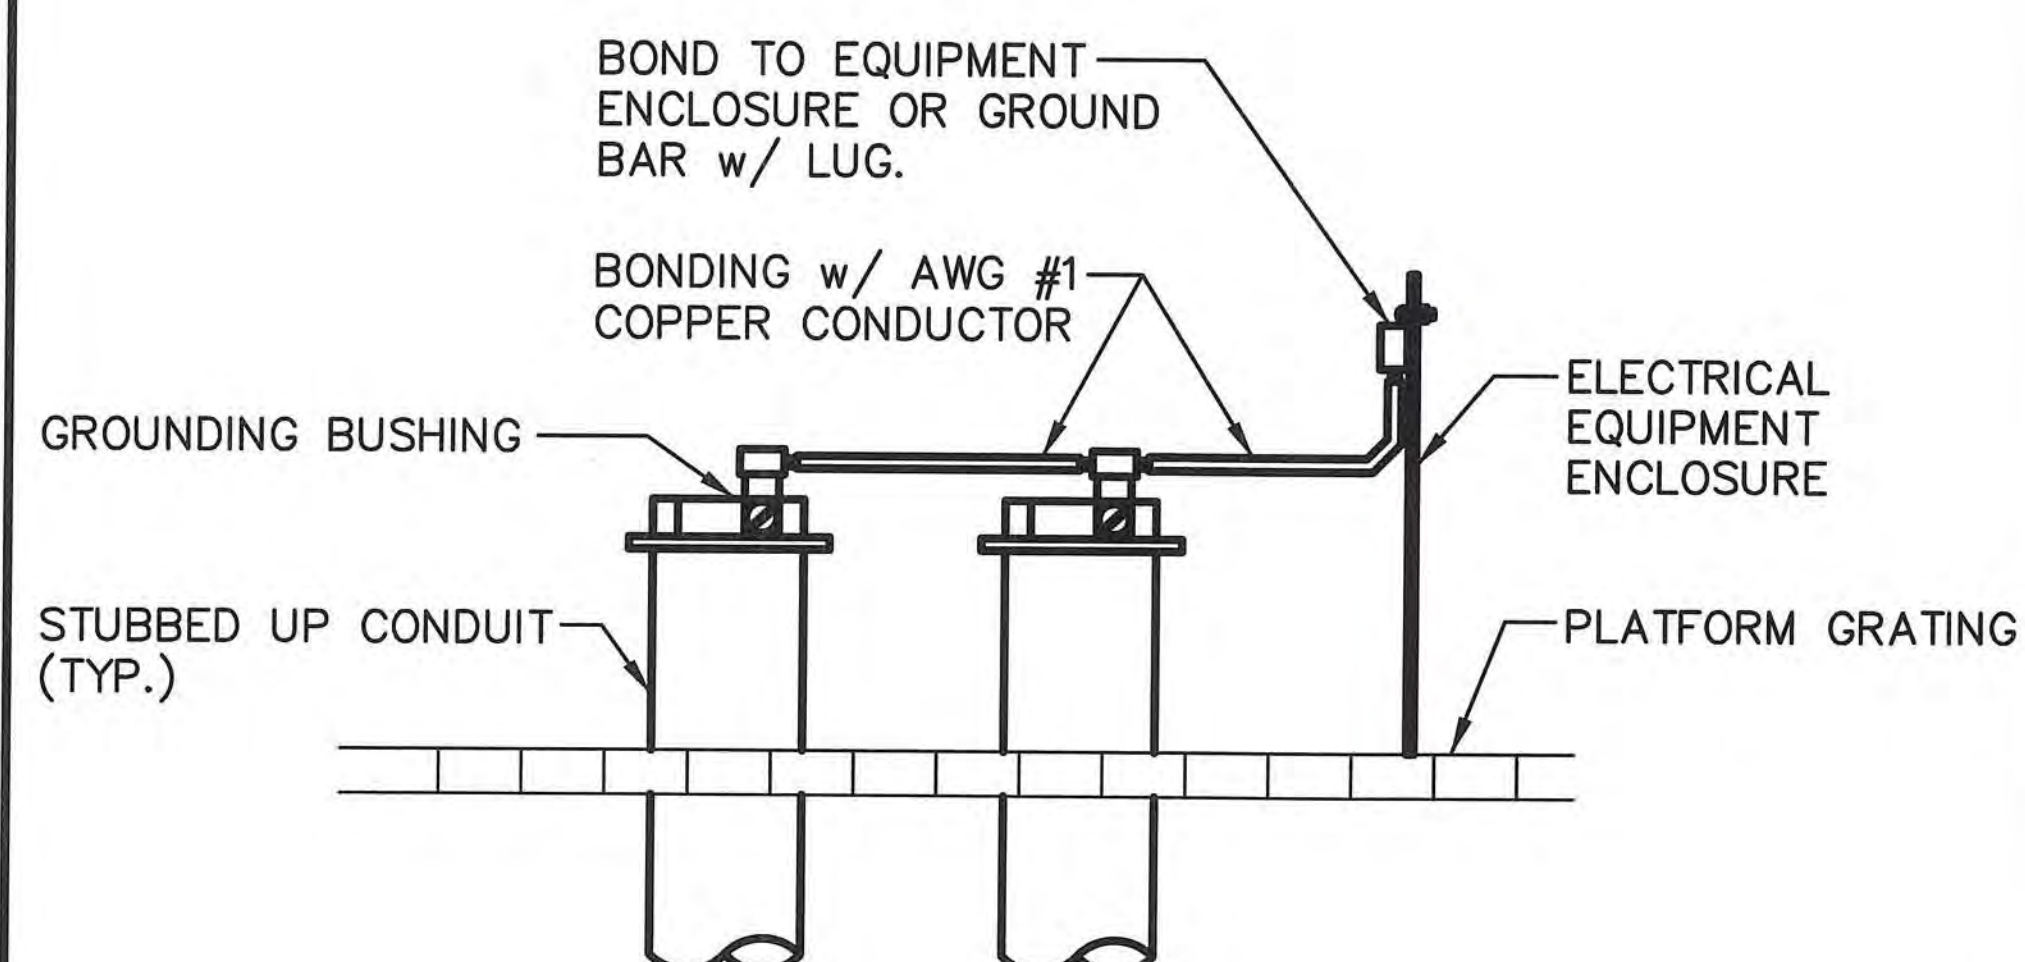

4 CONDUIT BONDING CONNECTIONS ON STUBBED UP CONDUITS BELOW EQUIPMENT

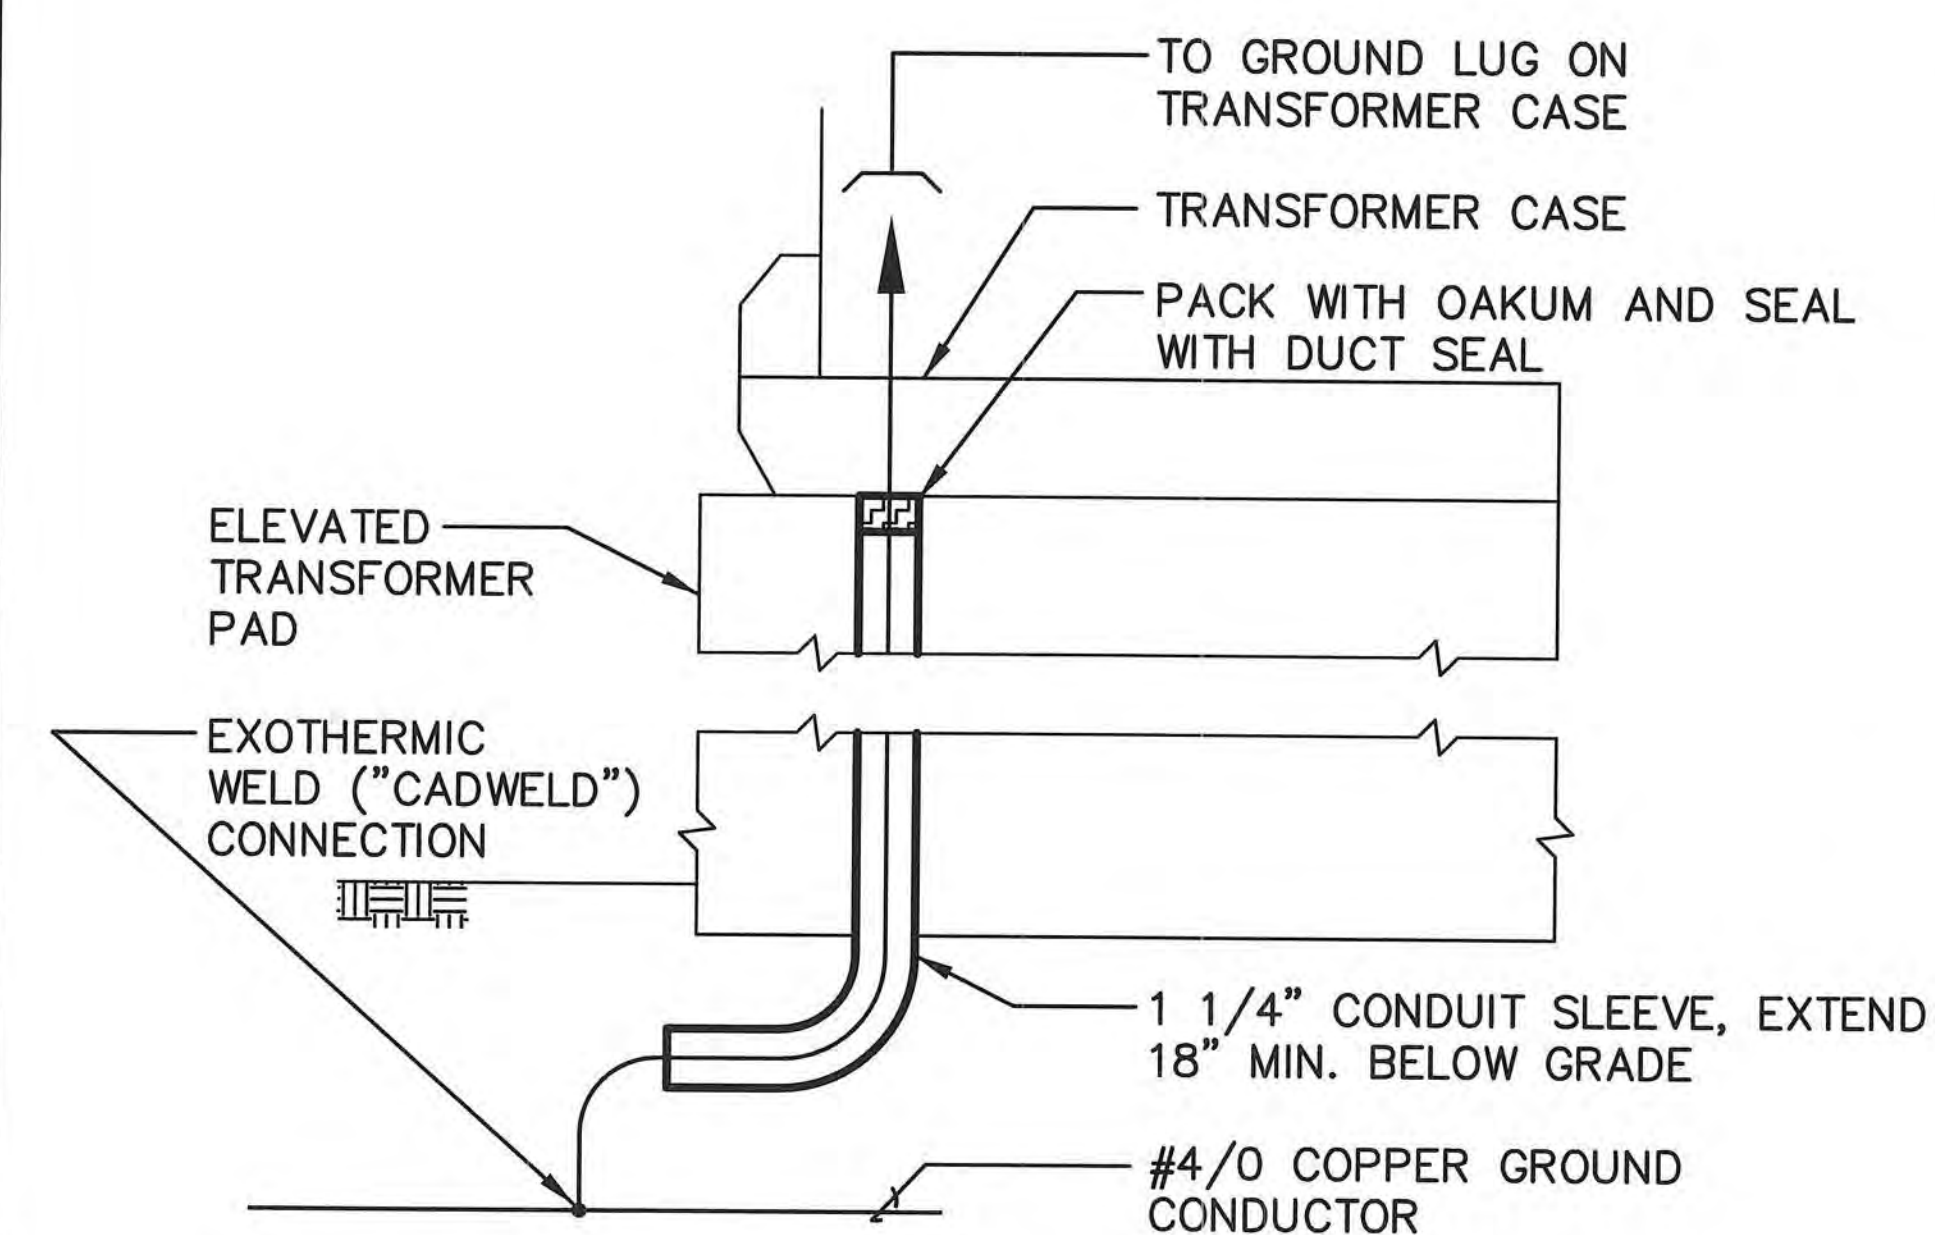

5 GROUND LOOP CONNECTION TO UTILITY TRANSFORMER CASE
(TYPICAL FOR UTILITY TRANSFORMER - A & B)

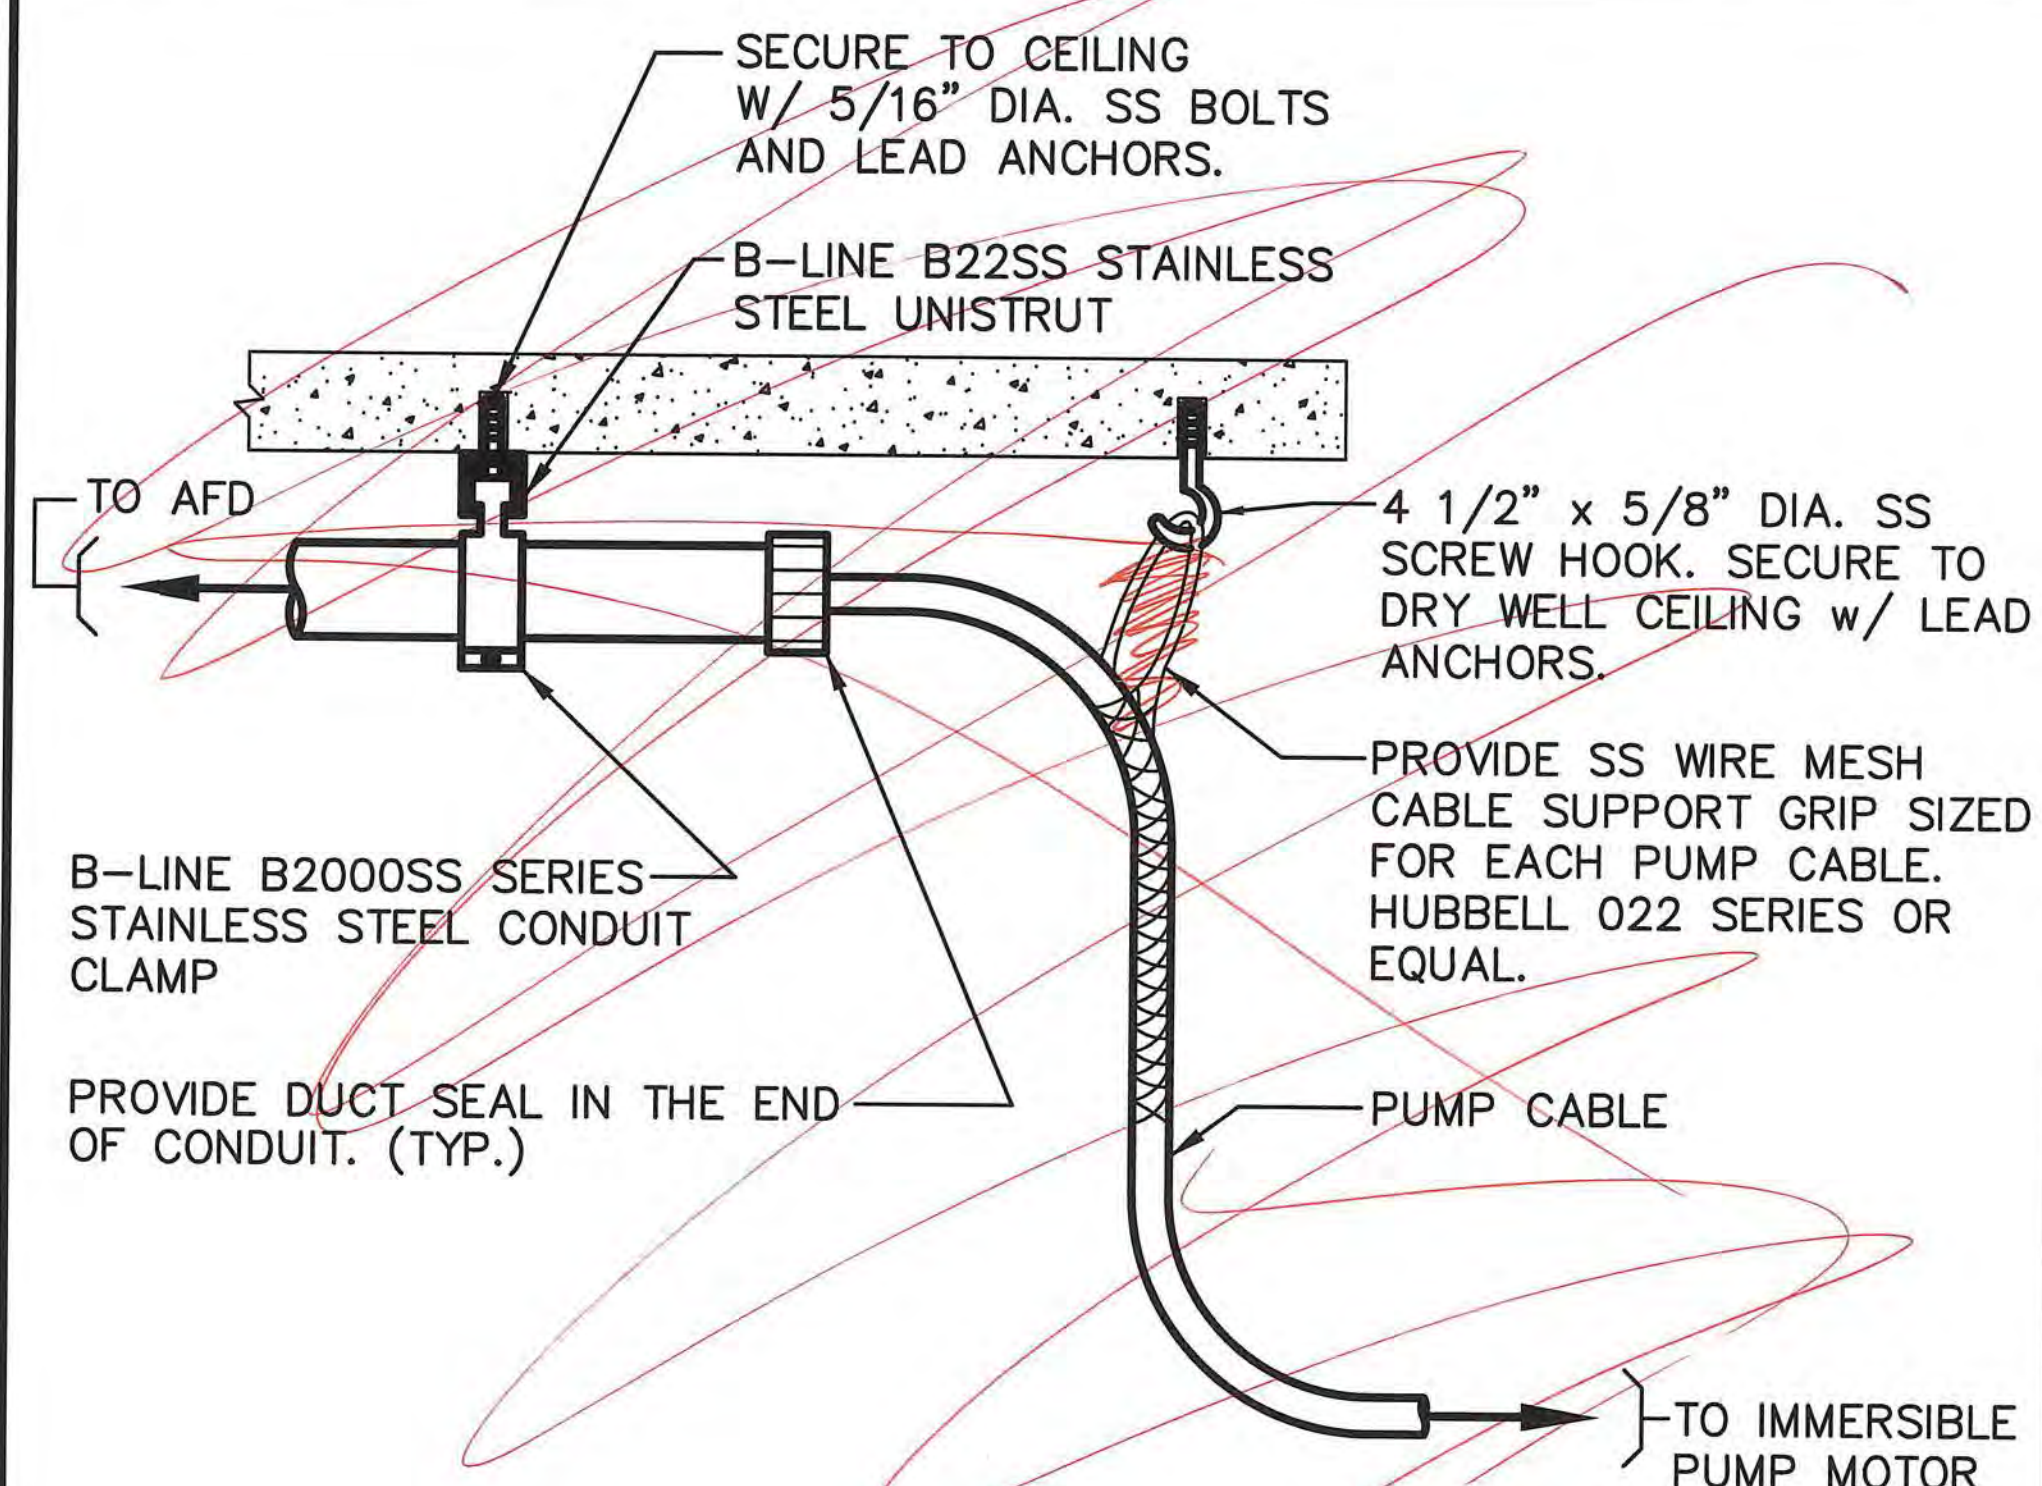

6 PUMP CABLE SUPPORT DETAIL

ENGINEER OF RECORD:
BOB E. HALLMAN, P.E.
FLORIDA REGISTRATION NO. 20761



Engineering Design
Technologies Corp.
P.O. Box 152403
Tampa, FL 33684-2403
813.289.8080
813.282.9184 FAX
engineering@edt1.com

CITY of TAMPA
WASTEWATER DEPARTMENT

KRAUSE PS REHABILITATION

ELECTRICAL DETAILS

NO.	DATE	REVISIONS

DRAWN: RWB
DESIGN: STK
QC: BEH
DATE: 05/01/14

SHEET E-46

PANEL "LPA"

bus amps			LOAD	poles	amps	bus ABC		poles	amps	LOAD	bus amps			
A	B	C									A	B	C	
7			CONTROL PANEL/PLC	1	20	1	●	2	1	15	FLOW METER TOTALIZER	5		
	4		BUBBLER PANEL	1	15	3	●	4	3	20	TRAVELING BRIDGE CRANE		12	
		5	LOWER LEVEL RECEPTACLES*	1	20	5	●		┌	┌				12
3			LOWER LEVEL RECEPTACLES*	1	20	7	●		┌	┌		12		
	2		LOWER LEVEL LIGHTING*	1	20	9	●	10	1	20	WET WELL UPPER LEVEL LIGHTING		1	
		2	LOWER LEVEL LIGHTING*	1	20	11	●	12	1	20	WET WELL LOWER LEVEL LIGHTING*			1
2			LOWER LEVEL LIGHTING*	1	20	13	●	14	1	20	EXTERIOR LIGHTING	4		
	9		HIGH BAY PUMP LIGHTING	1	20	15	●	16	1	20	OFFICE A/C RECEPTACLE		10	
		5	UPPER LEVEL LIGHTING	1	20	17	●	18	1	15	VENTILATION RELAY PANEL			2
9			UPPER LEVEL RECEPTACLES	1	20	19	●	20	1	20	SUMP PUMP	12		
	9		UPPER LEVEL RECEPTACLES	1	20	21	●	22	1	20	HIGH BAY LIGHTING		8	
		2	AIR DRYER	1	15	23	●	24	2	30	CIRCUIT BREAKER UPS—MODULE A			21
							●		┌	┌		21		
							●	28	2	30	CIRCUIT BREAKER UPS—MODULE B		21	
							●		┌	┌				21
							●	32	2	30	CIRCUIT BREAKER UPS—MODULE C	21		
							●		┌	┌			21	
							●							
							●							
			SPARE	1	20		●		1	20	SPARE			
			SPARE	1	20		●		1	20	SPARE			

BRANCH POLES: 42

CABINET: SURFACE

3P, 175A MAIN BREAKER

FEED IS TO BE TOP

MAIN LUGS: 1 SET; SIZE: #2/0 AWG/CU

CIRCUIT DIRECTORY						DATE 8-26-1916	
PANEL LPA 175A MCB 120/208 VOLT				3 PHASE 4 WIRE			
CONTROL PANEL PLC	20	1	2	20	FLOW METER TOTALIZER		
BUBBLER PANEL	15	3	4				
LOWER LEVEL RECEPTS	20	5	6	20	BRIDGE CRANE		
LOWER LEVEL RECEPTS	20	7	8				
LOWER LEVEL LIGHTS	20	9	10	20	WET WELL UPPER LEVEL LTS		
LOWER LEVEL LIGHTS	20	11	12	20	WET WELL LOWER LEVEL LTS		
LOWER LEVEL LIGHTS	20	13	14	20	EXTERIOR LIGHTING		
SUMP PUMP	20	15	16	20	HIGH BAY LIGHTING		
UPPER LEVEL LIGHTS	20	17	18	20	HIGH BAY PUMP LIGHTING		
UPPER LEVEL RECEPTS	20	19	20	30	CIRCUIT BREAKER UPS		
COMPRESSOR/BATH LGTS	20	21	22		MODULE-A		
AIR DRYER	15	23	24	30	CIRCUIT BREAKER UPS		
UPPER LEVEL RECEPTS	20	25	26		MODULE-B		
SPACE		27	28	30	CIRCUIT BREAKER UPS		
SPACE		29	30		MODULE-C		
SPACE		31	32	20	SPARE		
SPACE		33	34		SPARE		
SPACE		35	36		SPARE		
SAPCE		37	38		SPARE		
SPARE	20	39	40	20	SPARE		
SPARE	20	41	42	20	SPARE		

SHEET E-47

LUMINAIRE SCHEDULE

MARK	WATTS	LAMP	VOLTS	DESCRIPTION	MOUNTING	REMARKS
F1	56	LED	120	40" LED IN AN EPOXY COATED COPPER-FREE ALUMINUM HOUSING w/ DIFFUSED LENS. CROUSE-HINDS CAT. NO. LL48-60W-765/-F-IN	CEILING MOUNT	
F2	169	LED	120	18", HIGH BAY LED FIXTURE w/ 72 HIGH OUTPUT LEDS MOUNTED IN A RUGGED CAST ALUMINUM GREY HOUSING w/ HINGE AND LATCH MOUNTING SYSTEM. HUBBELL CAT. NO. HBL-72-1-A-2-5K-W-070-ND-GR	MOUNT ON 3' PENDANT. BOTTOM OF FIXTURE SHALL NOT INTERFERE w/ TRAVELING BRIDGE CRANE	
F3	36	LED	120	LED LIGHTING FIXTURE MOUNTED IN AN EPOXY POWDER COATED, COPPER-FREE, ALUMINUM HOUSING w/ GLOBE & GUARD, SUITABLE FOR USE IN CLASS I, DIVISION 1 ENVIRONMENTS. CROUSE-HINDS CAT. NO. EVLEDBX2C701	WALL MOUNT 8'-0" AFF	PROVIDE GLOBE & GUARD
F4	60	LED	120	9", LED FIXTURE, IDA COMPLIANT, BRONZE, DIE CAST ALUMINUM HOUSING w/ POLYCARBONATE SHIELD & PHOTO CONTROL BUTTON. HUBBELL CAT. NO. LMC-18LU-5K-1-PC1-LMC-SPC	BUILDING EXTERIOR. BOTTOM OF FIXTURE SHALL BE 10'-0" ABOVE FINISHED GRADE	IDA (DARK-SKY) COMPLIANT
F5	4	LED	120	EMERGENCY LIGHTING FIXTURE w/ 2 LED LAMP HEADS & MAINTENANCE FREE NIMH BATTERY, 90 MINUTE RATED OUTPUT. DUAL-LIGHT CAT. NO. EV4D-I-02L	WALL MOUNT 8'-0" AFF OR 8'-0" ABOVE STRUCTURAL PLATFORM	
F6	9	LED	120	EMERGENCY LIGHTING FIXTURE w/ 2 LED LAMP HEADS, STAINLESS STEEL HOUSING & NICAD BATTERY, SUITABLE FOR USE IN A CLASS I, DIVISION 1 ENVIRONMENT. CROUSE-HINDS CAT. NO. N2LPS12222SS	WALL MOUNT 8'-0" AFF	
X1	15	LED	120	EXIT LIGHTING FIXTURE w/ LED LAMPS, RED FACE, UNIVERSAL MOUNT & MAINTENANCE FREE NICKEL CADMIUM BATTERY. COMPASS LIGHTING. CAT. NO. CER.	ABOVE DOOR	

ENGINEER OF RECORD:
BOB E. HALLMAN, P.E.
FLORIDA REGISTRATION NO. 20761



Engineering Design Technologies Corp.
P.O. Box 152403
Tampa, FL 33684-2403
813.289.8080
813.282.9184 FAX
engineering@edt1.com

CITY of TAMPA
WASTEWATER DEPARTMENT

KRAUSE PS REHABILITATION

LUMINAIRE SCHEDULE

NO.	DATE	REVISIONS

DRAWN: RWB
DESIGN: STK
QC: BEH
DATE: 05/01/14


SHEET E-48

PROPOSED CONDUIT / CONDUCTOR SCHEDULE

B080-II0

CONDUIT NO.	COND. SIZE	NO. WIRES	NO. SEALS	WIRE SIZE	FROM	TO	REMARKS
H001A	6"	1		PULL WIRE	TEC SWITCH--A	TEC TRANSFORMER--A	EXTEND CONDUIT 3' BEYOND PROPERTY LINE AND STUB UP. COORDINATE REQUIREMENTS w/ TEC.
H001B	6"	1		PULL WIRE			
H002A	6"	1		PULL WIRE	TEC SWITCH--B	TEC TRANSFORMER--B	EXTEND CONDUIT 3' BEYOND PROPERTY LINE AND STUB UP. COORDINATE REQUIREMENTS w/ TEC.
H002B	6"	1		PULL WIRE			
H003A	4"	1		PULL WIRE	TEC TRANSFORMER--A	TEC TRANSFORMER--B	COORDINATE REQUIREMENTS w/ TEC
H003B	4"	1		PULL WIRE			
M100A	4"	3		500 KCMIL	TEC TRANSFORMER--A	SWITCHBOARD--KPS (BUS A)	COORDINATE TRANSFORMER CONNECTIONS w/ TEC
		1		250 KCMIL NEUT.			
M100B	4"	3		500 KCMIL	TEC TRANSFORMER--A	SWITCHBOARD--KPS (BUS A)	COORDINATE TRANSFORMER CONNECTIONS w/ TEC
		1		250 KCMIL NEUT.			
M100C	4"	3		500 KCMIL	TEC TRANSFORMER--A	SWITCHBOARD--KPS (BUS A)	COORDINATE TRANSFORMER CONNECTIONS w/ TEC
		1		250 KCMIL NEUT.			
M100D	4"	3		500 KCMIL	TEC TRANSFORMER--A	SWITCHBOARD--KPS (BUS A)	COORDINATE TRANSFORMER CONNECTIONS w/ TEC
		1		250 KCMIL NEUT.			
M100E	4"	3		500 KCMIL	TEC TRANSFORMER--A	SWITCHBOARD--KPS (BUS A)	COORDINATE TRANSFORMER CONNECTIONS w/ TEC
		1		250 KCMIL NEUT.			
M100F	4"	3		500 KCMIL	TEC TRANSFORMER--A	SWITCHBOARD--KPS (BUS A)	COORDINATE TRANSFORMER CONNECTIONS w/ TEC
		1		250 KCMIL NEUT.			
M100G	4"	3		500 KCMIL	TEC TRANSFORMER--A	SWITCHBOARD--KPS (BUS A)	COORDINATE TRANSFORMER CONNECTIONS w/ TEC
		1		250 KCMIL NEUT.			
M101A	4"	3		500 KCMIL	TEC TRANSFORMER--B	SWITCHBOARD--KPS (BUS B)	COORDINATE TRANSFORMER CONNECTIONS w/ TEC
		1		250 KCMIL NEUT.			
M101B	4"	3		500 KCMIL	TEC TRANSFORMER--B	SWITCHBOARD--KPS (BUS B)	COORDINATE TRANSFORMER CONNECTIONS w/ TEC
		1		250 KCMIL NEUT.			
M101C	4"	3		500 KCMIL	TEC TRANSFORMER--B	SWITCHBOARD--KPS (BUS B)	COORDINATE TRANSFORMER CONNECTIONS w/ TEC
		1		250 KCMIL NEUT.			
M101D	4"	3		500 KCMIL	TEC TRANSFORMER--B	SWITCHBOARD--KPS (BUS B)	COORDINATE TRANSFORMER CONNECTIONS w/ TEC
		1		250 KCMIL NEUT.			

ENGINEER OF RECORD:
BOB E. HALLMAN, P.E.
FLORIDA REGISTRATION NO. 20761



Engineering Design Technologies Corp.
P.O. Box 152403
Tampa, FL 33684-2403
813.289.8080
813.282.9184 FAX
engineering@edt1.com

CITY of TAMPA
WASTEWATER DEPARTMENT

KRAUSE PS REHABILITATION
CONDUIT SCHEDULE

NO.	DATE			REVISIONS	

DRAWN: RWB
DESIGN: STK
QC: BEH
DATE: 05/01/14

SHEET E-49

PROPOSED CONDUIT / CONDUCTOR SCHEDULE

B080-III

CONDUIT NO.	COND. SIZE	NO. WIRES	NO. SEALS	WIRE SIZE	FROM	TO	REMARKS
M101E	4"	3		500 KCMIL	TEC TRANSFORMER-B	SWITCHBOARD-KPS (BUS B)	COORDINATE TRANSFORMER CONNECTIONS w/ TEC
		1		250 KCMIL NEUT.			
M101F	4"	3		500 KCMIL	TEC TRANSFORMER-B	SWITCHBOARD-KPS (BUS B)	COORDINATE TRANSFORMER CONNECTIONS w/ TEC
		1		250 KCMIL NEUT.			
M101G	4"	3		500 KCMIL	TEC TRANSFORMER-B	SWITCHBOARD-KPS (BUS B)	COORDINATE TRANSFORMER CONNECTIONS w/ TEC
		1		250 KCMIL NEUT.			
M102A	4"	3		500 KCMIL	GENERATOR BUS A TERMINAL BOX	SWITCHBOARD-KPS (BUS A)	FUTURE EMERGENCY GENERATOR A
		1		250 KCMIL NEUT.			
		1		400 KCMIL GND.			
M102B	4"	3		500 KCMIL	GENERATOR BUS A TERMINAL BOX	SWITCHBOARD-KPS (BUS A)	FUTURE EMERGENCY GENERATOR A
		1		250 KCMIL NEUT.			
		1		400 KCMIL GND.			
M102C	4"	3		500 KCMIL	GENERATOR BUS A TERMINAL BOX	SWITCHBOARD-KPS (BUS A)	FUTURE EMERGENCY GENERATOR A
		1		250 KCMIL NEUT.			
		1		400 KCMIL GND.			
M102D	4"	3		500 KCMIL	GENERATOR BUS A TERMINAL BOX	SWITCHBOARD-KPS (BUS A)	FUTURE EMERGENCY GENERATOR A
		1		250 KCMIL NEUT.			
		1		400 KCMIL GND.			
M102E	4"	3		500 KCMIL	GENERATOR BUS A TERMINAL BOX	SWITCHBOARD-KPS (BUS A)	FUTURE EMERGENCY GENERATOR A
		1		250 KCMIL NEUT.			
		1		400 KCMIL GND.			
M102F	4"	3		500 KCMIL	GENERATOR BUS A TERMINAL BOX	SWITCHBOARD-KPS (BUS A)	FUTURE EMERGENCY GENERATOR A
		1		250 KCMIL NEUT.			
		1		400 KCMIL GND.			
		1		250 KCMIL NEUT.			
		1		400 KCMIL GND.			
M103F	4"	3		500 KCMIL	GENERATOR BUS B TERMINAL BOX	SWITCHBOARD-KPS (BUS B)	FUTURE EMERGENCY GENERATOR B
		1		250 KCMIL NEUT.			
		1		400 KCMIL GND.			
M103G	4"	3		500 KCMIL	GENERATOR BUS B TERMINAL BOX	SWITCHBOARD-KPS (BUS B)	FUTURE EMERGENCY GENERATOR B
		1		250 KCMIL NEUT.			
		1		400 KCMIL GND.			
M104	1 1/4"	1		250 KCMIL	CB-KPS-A (SWITCHBOARD-KPS)	SERVICE GROUND SYSTEM	GROUNDING ELECTRODE CONDUCTOR

ENGINEER OF RECORD:
BOB E. HALLMAN, P.E.
FLORIDA REGISTRATION NO. 20761



Engineering Design
Technologies Corp.
P.O. Box 152403
Tampa, FL 33684-2403
813.289.8080
813.282.9184 FAX
engineering@edt1.com

CITY of TAMPA
WASTEWATER DEPARTMENT

KRAUSE PS REHABILITATION

CONDUIT SCHEDULE

NO.	DATE				REVISIONS

DRAWN: RWB
DESIGN: STK
QC: BEH
DATE: 05/01/14

PROPOSED CONDUIT / CONDUCTOR SCHEDULE							
CONDUIT NO.	COND. SIZE	NO. WIRES	NO. SEALS	WIRE SIZE	FROM	TO	REMARKS
M105	1 1/4"	1		250 KCMIL	CB-KPS-B (SWITCHBOARD-KPS)	SERVICE GROUND SYSTEM	GROUNDING ELECTRODE CONDUCTOR
M106A	4"	3		350 KCMIL	SWITCHBOARD-KPS (BUS A)	MCC-KPS (BUS A)	MCC BUS A POWER
		1		#1/0 GND.			
M106B	4"	3		350 KCMIL	SWITCHBOARD-KPS (BUS A)	MCC-KPS (BUS A)	MCC BUS A POWER
		1		#1/0 GND.			
M107A	4"	3		350 KCMIL	SWITCHBOARD-KPS (BUS B)	MCC-KPS (BUS B)	MCC BUS B POWER
		1		#1/0 GND.			
M107B	4"	3		350 KCMIL	SWITCHBOARD-KPS (BUS B)	MCC-KPS (BUS B)	MCC BUS B POWER
		1		#1/0 GND.			
M108A	4"	3		500 KCMIL	SWITCHBOARD-KPS (BUS A)	PUMP NO. 1 AFD	PUMP NO. 1 AFD POWER
		1		#2/0 GND.			
M108B	4"	3		500 KCMIL	SWITCHBOARD-KPS (BUS A)	PUMP NO. 1 AFD	PUMP NO. 1 AFD POWER
		1		#2/0 GND.			
M109A	4"	1		4/C 250 KCMIL	PUMP NO. 1 AFD	PUMP NO. 1	PUMP NO. 1 POWER. CABLE PROVIDED BY PUMP SUPPLIER.
M109B	4"	1		4/C 250 KCMIL	PUMP NO. 1 AFD	PUMP NO. 1	PUMP NO. 1 POWER. CABLE PROVIDED BY PUMP SUPPLIER.
M109C	4"	1		4/C 250 KCMIL	PUMP NO. 1 AFD	PUMP NO. 1	PUMP NO. 1 POWER. CABLE PROVIDED BY PUMP SUPPLIER.
M110A	4"	3		500 KCMIL	SWITCHBOARD-KPS (BUS A)	PUMP NO. 2 AFD	PUMP NO. 2 AFD POWER
		1		#2/0 GND.			
M110B	4"	3		500 KCMIL	SWITCHBOARD-KPS (BUS A)	PUMP NO. 2 AFD	PUMP NO. 2 AFD POWER
		1		#2/0 GND.			
M111A	4"	1		4/C 250 KCMIL	PUMP NO. 2 AFD	PUMP NO. 2	PUMP NO. 2 POWER. CABLE PROVIDED BY PUMP SUPPLIER.
M111B	4"	1		4/C 250 KCMIL	PUMP NO. 2 AFD	PUMP NO. 2	PUMP NO. 2 POWER. CABLE PROVIDED BY PUMP SUPPLIER.
M111C	4"	1		4/C 250 KCMIL	PUMP NO. 2 AFD	PUMP NO. 2	PUMP NO. 2 POWER. CABLE PROVIDED BY PUMP SUPPLIER.
M112A	4"	3		500 KCMIL	SWITCHBOARD-KPS (BUS B)	PUMP NO. 3 AFD	PUMP NO. 3 AFD POWER
		1		#2/0 GND.			
M112B	4"	3		500 KCMIL	SWITCHBOARD-KPS (BUS B)	PUMP NO. 3 AFD	PUMP NO. 3 AFD POWER
		1		#2/0 GND.			
M113A	4"	1		4/C 250 KCMIL	PUMP NO. 3 AFD	PUMP NO. 3	PUMP NO. 3 POWER. CABLE PROVIDED BY PUMP SUPPLIER.

ENGINEER OF RECORD:
BOB E. HALLMAN, P.E.
FLORIDA REGISTRATION NO. 20761



Engineering Design
Technologies Corp.
P.O. Box 152403
Tampa, FL 33684-2403
813.289.8080
813.282.9184 FAX
engineering@edt1.com

CITY of TAMPA
WASTEWATER DEPARTMENT

KRAUSE PS REHABILITATION


CONDUIT SCHEDULE

NO.	DATE	REVISIONS

DRAWN: RWB
DESIGN: STK
QC: BEH
DATE: 05/01/14

PROPOSED CONDUIT / CONDUCTOR SCHEDULE							
CONDUIT NO.	COND. SIZE	NO. WIRES	NO. SEALS	WIRE SIZE	FROM	TO	REMARKS
M113B	4"	1		4/C 250 KCMIL	PUMP NO. 3 AFD	PUMP NO. 3	PUMP NO. 3 POWER. CABLE PROVIDED BY PUMP SUPPLIER.
M113C	4"	1		4/C 250 KCMIL			PUMP NO. 3 POWER. CABLE PROVIDED BY PUMP SUPPLIER.
M114A	4"	3		500 KCMIL	SWITCHBOARD-KPS (BUS B)	PUMP NO. 4 AFD	PUMP NO. 4 AFD POWER
		1		#2/0 GND.			
M114B	4"	3		500 KCMIL	SWITCHBOARD-KPS (BUS B)	PUMP NO. 4 AFD	PUMP NO. 4 AFD POWER
		1		#2/0 GND.			
M115A	4"	1		4/C 250 KCMIL	PUMP NO. 4 AFD	PUMP NO. 4	PUMP NO. 4 POWER. CABLE PROVIDED BY PUMP SUPPLIER.
M115B	4"	1		4/C 250 KCMIL	PUMP NO. 4 AFD	PUMP NO. 4	PUMP NO. 4 POWER. CABLE PROVIDED BY PUMP SUPPLIER.
M115C	4"	1		4/C 250 KCMIL	PUMP NO. 4 AFD	PUMP NO. 4	PUMP NO. 4 POWER. CABLE PROVIDED BY PUMP SUPPLIER.
M116	1"	3		#6	MCC-KPS (BUS A)	AUTOMATIC TRANSFER SWITCH (NORMAL)	TRANSFORMER T1 POWER
		1		#8 GND.			
M117	1"	3		#6	MCC-KPS (BUS B)	AUTOMATIC TRANSFER SWITCH (ALTERNATE)	TRANSFORMER T1 POWER
		1		#8 GND.			
M118	1"	3		#6	AUTOMATIC TRANSFER SWITCH	TRANSFORMER T1	TRANSFORMER T1 POWER
		1		#8 GND.			
M119	2"	1		PULL WIRE	TEC TRANSFORMER-A	TEC METER (TRANSFORMER-A)	COORDINATE REQUIREMENTS w/ TEC
M120	2"	1		PULL WIRE	TEC TRANSFORMER-B	TEC METER (TRANSFORMER-B)	COORDINATE REQUIREMENTS w/ TEC
M121	3/4"	3		#10	MCC-KPS	VACUUM PUMP VP-1 CONTROL PANEL	VACUUM PUMP VP-1 POWER
		1		#10 GND.			
M122	1 1/4"	2		4/C #10	MCC-KPS	JUNCTION BOX	PUMP NO. 1 MOV & PUMP NO. 3 MOV POWER. SUBMERSIBLE CABLES.
M123	1"	1		4/C #10	JUNCTION BOX	PUMP 3 MOV	PUMP NO. 3 MOV POWER. SUBMERSIBLE CABLE.
M124	1"	1		4/C #10	JUNCTION BOX	PUMP 1 MOV	PUMP NO. 1 MOV POWER. SUBMERSIBLE CABLE.
M125	1 1/4"	2		4/C #10	MCC-KPS	JUNCTION BOX	PUMP NO. 2 MOV & PUMP NO. 4 MOV POWER. SUBMERSIBLE CABLES.
M126	1"	1		4/C #10	JUNCTION BOX	PUMP 4 MOV	PUMP NO. 4 MOV POWER. SUBMERSIBLE CABLE.

ENGINEER OF RECORD:
BOB E. HALLMAN, P.E.
FLORIDA REGISTRATION NO. 20761

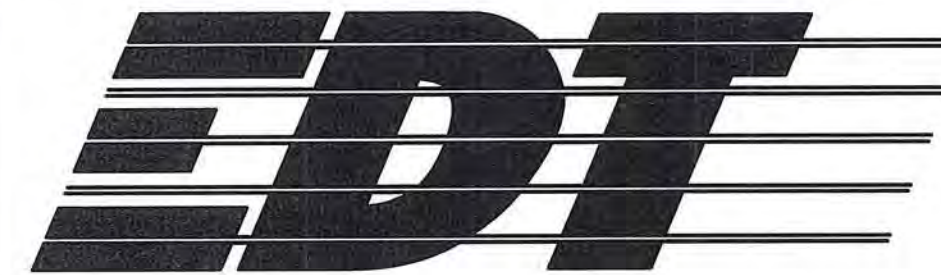 <div>Engineering Design Technologies Corp. P.O. Box 152403 Tampa, FL 33684-2403 813.289.8080 813.282.9184 FAX engineering@edt1.com</div>	<div>CITY of TAMPA</div> <div>WASTEWATER DEPARTMENT</div>	<div>KRAUSE PS REHABILITATION</div> <div>CONDUIT SCHEDULE</div>				DRAWN: <u>RWB</u>		
						DESIGN: <u>STK</u>		
						QC: <u>BEH</u>		
						DATE: <u>05/01/14</u>		
			NO.	DATE	REVISIONS	SHEET E-52		

PROPOSED CONDUIT / CONDUCTOR SCHEDULE

B080-II4

CONDUIT NO.	COND. SIZE	NO. WIRES	NO. SEALS	WIRE SIZE	FROM	TO	REMARKS
M127	1"	1		4/C #10	JUNCTION BOX	PUMP 2 MOV	PUMP NO. 2 MOV POWER. SUBMERSIBLE CABLE.
M128	3/4"	3		#10	MCC-KPS	AIR COMPRESSOR AC-1 CONTROL PANEL	AIR COMPRESSOR AC-1 POWER
		1		#10 GND.			
M129	3/4"	3		#10	MCC-KPS	AIR COMPRESSOR AC-2 CONTROL PANEL	AIR COMPRESSOR AC-2 POWER
		1		#10 GND.			
M130	3/4"	3		#10	MCC-KPS	VACUUM PUMP VP-2 CONTROL PANEL	VACUUM PUMP VP-2 POWER
		1		#10 GND.			
M131	1"	1		4/C #10	MCC-KPS	PUMP NO. 1 BLOWER	PUMP NO. 1 BLOWER. CABLE PROVIDED BY PUMP SUPPLIER.
M132	1"	1		4/C #10	MCC-KPS	PUMP NO. 2 BLOWER	PUMP NO. 2 BLOWER. CABLE PROVIDED BY PUMP SUPPLIER.
M133	1"	1		4/C #10	MCC-KPS	PUMP NO. 3 BLOWER	PUMP NO. 3 BLOWER. CABLE PROVIDED BY PUMP SUPPLIER.
M134	1"	1		4/C #10	MCC-KPS	PUMP NO. 4 BLOWER	PUMP NO. 4 BLOWER. CABLE PROVIDED BY PUMP SUPPLIER.
L200	2"	3		#2/0	TRANSFORMER T1	PANELBOARD LPA	PANELBOARD LPA POWER
		1		#2/0 NEUT.			
		1		#4 GND.			
L201	3/4"	1		#1	TRANSFORMER T1	GROUND SYSTEM	GROUNDING ELECTRODE CONDUCTOR
L202	3/4"	1		#12	PANELBOARD LPA	CONTROL PANEL/PLC	CONTROL PANEL/PLC POWER
		1		#12 NEUT.			
		1		#12 GND.			
L203	3/4"	1		#12	PANELBOARD LPA	WET WELL BUBBLER PANEL	WET WELL BUBBLER PANEL POWER
		1		#12 NEUT.			
		1		#12 GND.			
L204A	3/4"	2		#10	PANELBOARD LPA	CIRCUIT BREAKER UPS	CIRCUIT BREAKER UPS-MODULE A POWER
		1		#10 NEUT.			
		1		#10 GND.			
L204B	3/4"	2		#10	PANELBOARD LPA	CIRCUIT BREAKER UPS	CIRCUIT BREAKER UPS-MODULE B POWER
		1		#10 NEUT.			
		1		#10 GND.			
L204C	3/4"	2		#10	PANELBOARD LPA	CIRCUIT BREAKER UPS	CIRCUIT BREAKER UPS-MODULE C POWER
		1		#10 NEUT.			
		1		#10 GND.			
L205	3/4"	1		#12	PANELBOARD LPA	FLOW METER TOTALIZER	FLOW METER TOTALIZER POWER
		1		#12 NEUT.			
		1		#12 GND.			
L206	3/4"	1		#12	PANELBOARD LPA	AIR DRYER	AIR DRYER POWER
		1		#12 NEUT.			
		1		#12 GND.			

ENGINEER OF RECORD:
BOB E. HALLMAN, P.E.
FLORIDA REGISTRATION NO. 20761



Engineering Design
Technologies Corp.
P.O. Box 152403
Tampa, FL 33684-2403
813.289.8080
813.282.9184 FAX
engineering@edt1.com

CITY of TAMPA
WASTEWATER DEPARTMENT

KRAUSE PS REHABILITATION

CONDUIT SCHEDULE


NO.	DATE	REVISIONS

DRAWN: RWB
DESIGN: STK
QC: BEH
DATE: 05/01/14

SHEET E-53

PROPOSED CONDUIT / CONDUCTOR SCHEDULE							
CONDUIT NO.	COND. SIZE	NO. WIRES	NO. SEALS	WIRE SIZE	FROM	TO	REMARKS
C300A	3"	15		3/C #12	PUMP NO. 1 AFD	PUMP NO. 1 CONTROLS	CONTROL & STATUS. SUBMERSIBLE CABLES.
C300B	1"	1		4/C #12			PUMP NO. 1 SPACE HEATER & THERMOSTAT. CABLE PROVIDED BY PUMP SUPPLIER.
C301A	3"	15		3/C #12	PUMP NO. 2 AFD	PUMP NO. 2 CONTROLS	CONTROL & STATUS. SUBMERSIBLE CABLES.
C301B	1"	1		4/C #12			PUMP NO. 2 SPACE HEATER & THERMOSTAT. CABLE PROVIDED BY PUMP SUPPLIER.
C302A	3"	15		3/C #12	PUMP NO. 3 AFD	PUMP NO. 3 CONTROLS	CONTROL & STATUS. SUBMERSIBLE CABLES.
C302B	1"	1		4/C #12			PUMP NO. 3 SPACE HEATER & THERMOSTAT. CABLE PROVIDED BY PUMP SUPPLIER.
C303A	3"	15		3/C #12	PUMP NO. 4 AFD	PUMP NO. 4 CONTROLS	CONTROL & STATUS. SUBMERSIBLE CABLES.
C303B	1"	1		4/C #12			PUMP NO. 4 SPACE HEATER & THERMOSTAT. CABLE PROVIDED BY PUMP SUPPLIER.
C304	1 1/2"	24 6 1		#12 #12 SPARE #12 GND.	CONTROL PANEL/PLC	SWITCHBOARD-KPS (BUS A)	CIRCUIT BREAKER STATUS
C305	1 1/2"	20 6 1		#12 #12 SPARE #12 GND.			CIRCUIT BREAKER STATUS
C306	3 1/2"	102 12 1		#12 #12 SPARE #12 GND.	SWITCHBOARD-KPS (BUS A)	REMOTE CIRCUIT BREAKER PANEL (RCBP)	CIRCUIT BREAKER CONTROL & STATUS
C307	3 1/2"	100 12 1		#12 #12 SPARE #12 GND.	SWITCHBOARD-KPS (BUS B)	REMOTE CIRCUIT BREAKER PANEL (RCBP)	CIRCUIT BREAKER CONTROL & STATUS
C308	1 1/4"	3 3 1		#10 #10 NEUT. #10 GND.	SWITCHBOARD-KPS (BUS A)	CIRCUIT BREAKER UPS-MODULE A	BUS A CIRCUIT BREAKER POWER
C309	1 1/4"	3 3 1		#10 #10 NEUT. #10 GND.	SWITCHBOARD-KPS (BUS B)	CIRCUIT BREAKER UPS-MODULE B	BUS B CIRCUIT BREAKER POWER
C310	1 1/2"	22 6 1		#12 #12 SPARE #12 GND.	CONTROL PANEL/PLC	PUMP NO. 4 AFD	CONTROL & STATUS
C311	1 1/2"	22 6 1		#12 #12 SPARE #12 GND.	CONTROL PANEL/PLC	PUMP NO. 3 AFD	CONTROL & STATUS
C312	1 1/2"	22 6 1		#12 #12 SPARE #12 GND.	CONTROL PANEL/PLC	PUMP NO. 2 AFD	CONTROL & STATUS
C313	1 1/2"	22 6 1		#12 #12 SPARE #12 GND.	CONTROL PANEL/PLC	PUMP NO. 1 AFD	CONTROL & STATUS

ENGINEER OF RECORD:
BOB E. HALLMAN, P.E.
FLORIDA REGISTRATION NO. 20761

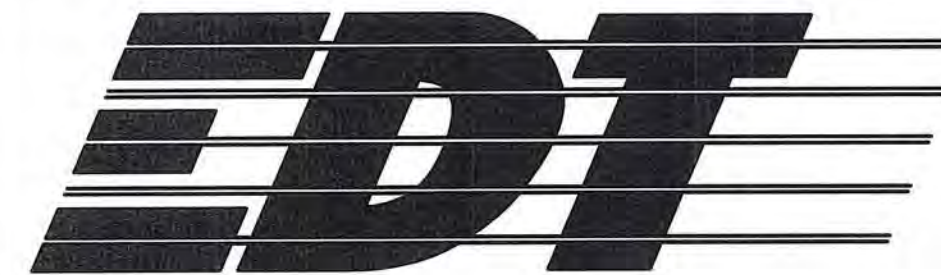

Engineering Design Technologies Corp.
P.O. Box 152403
Tampa, FL 33684-2403
813.289.8080
813.282.9184 FAX
engineering@edt1.com

CITY of TAMPA
WASTEWATER DEPARTMENT

KRAUSE PS REHABILITATION
CONDUIT SCHEDULE

NO.	DATE							REVISIONS	

DRAWN: RWB
DESIGN: STK
QC: BEH
DATE: 05/01/14
SHEET E-54

B080-116

ENGINEER OF RECORD:
BOB E. HALLMAN, P.E.
FLORIDA REGISTRATION NO. 20761



KRAUSE PS REHABILITATION

CONDUIT SCHEDULE

DRAWN: RWB
DESIGN: STK
QC: BEH
DATE: 05/01/14


SHEET E-55

PROPOSED CONDUIT / CONDUCTOR SCHEDULE

CONDUIT NO.	COND. SIZE	NO. WIRES	NO. SEALS	WIRE SIZE	FROM	TO	REMARKS
A400	3/4"	2		2/C #16 SHLD.	CONTROL PANEL/PLC	WET WELL BUBBLER PANEL	WET WELL LEVEL. BELDEN 8719.
A401	1 1/4"	2		1.5 PR. #22 SHLD.	CONTROL PANEL/PLC	PUMP NO. 4 AFD	ANALOG & RS-485. BELDEN 3106A, BELDEN 8719.
		4		2/C #16 SHLD.			
A402	1 1/4"	2		1.5 PR. #22 SHLD.	PUMP NO. 4 AFD	PUMP NO. 3 AFD	ANALOG & RS-485. BELDEN 3106A, BELDEN 8719.
		3		2/C #16 SHLD.			
A403	1"	2		1.5 PR. #22 SHLD.	PUMP NO. 3 AFD	PUMP NO. 2 AFD	ANALOG & RS-485. BELDEN 3106A, BELDEN 8719.
		2		2/C #16 SHLD.			
A404	1"	2		1.5 PR. #22 SHLD.	PUMP NO. 2 AFD	PUMP NO. 1 AFD	ANALOG & RS-485. BELDEN 3106A, BELDEN 8719.
		1		2/C #16 SHLD.			
A405	1 1/2"	9		3/C #16 SHLD.	PUMP NO. 1 AFD	PUMP NO. 1 RTD'S	PUMP TEMPERATURE. BELDEN 8618.
A406	3/4"	2		2/C #16 SHLD.	CONTROL PANEL/PLC	PUMP NO. 1 VIBRATION SENSORS	PUMP VIBRATION. BELDEN 8719.
A407	1 1/2"	9		3/C #16 SHLD.	PUMP NO. 2 AFD	PUMP NO. 2 RTD'S	PUMP TEMPERATURE. BELDEN 8618.
A408	3/4"	2		2/C #16 SHLD.	CONTROL PANEL/PLC	PUMP NO. 2 VIBRATION SENSORS	PUMP VIBRATION. BELDEN 8719.
A409	1 1/2"	9		3/C #16 SHLD.	PUMP NO. 3 AFD	PUMP NO. 3 RTD'S	PUMP TEMPERATURE. BELDEN 8618.
A410	3/4"	2		2/C #16 SHLD.	CONTROL PANEL/PLC	PUMP NO. 3 VIBRATION SENSORS	PUMP VIBRATION. BELDEN 8719.
A411	1 1/2"	9		3/C #16 SHLD.	PUMP NO. 4 AFD	PUMP NO. 4 RTD'S	PUMP TEMPERATURE. BELDEN 8618.
A412	3/4"	2		2/C #16 SHLD.	CONTROL PANEL/PLC	PUMP NO. 4 VIBRATION SENSORS	PUMP VIBRATION. BELDEN 8719.
A413	3/4"	2		2/C #16 SHLD.	CONTROL PANEL/PLC	FLOW METER TOTALIZER	FLOW RATE & SCALED PULSE. BELDEN 8719.
A414	3/4"	1		2/C #16 SHLD.	CONTROL PANEL/PLC	GAS DETECTOR TRANSMITTER	WET WELL GAS PERCENTAGE. BELDEN 8719.
A415	2"	1		0.625 OHM HELIAX CABLE	CONTROL PANEL/PLC	TELEMETRY ANTENNA	COMMUNICATION - HELIAX 2DF 4.5 - 50A. PROVIDE CONNECTORS AS REQUIRED.

- NOTES:
1. THE SHIELD & DRAIN WIRES FOR ANALOG CABLES SHALL BE GROUNDED AT THE PLC ONLY. THE SHIELD & DRAIN WIRE AT THE END DEVICE SHALL BE NEATLY TRIMMED & TAPED w/ 2 LAYERS OF VINYL ELECTRICAL TAPE (SCOTCH 33+).

ENGINEER OF RECORD:
BOB E. HALLMAN, P.E.
FLORIDA REGISTRATION NO. 20761

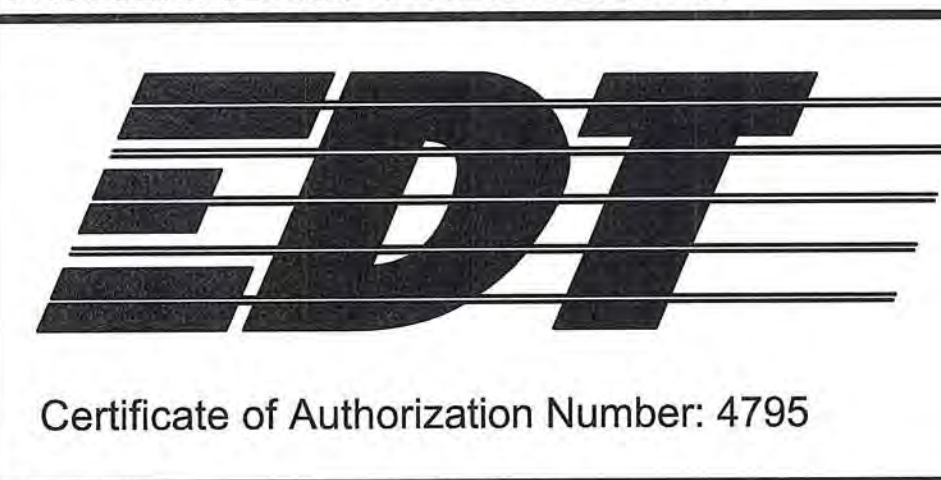

Engineering Design Technologies Corp.
P.O. Box 152403
Tampa, FL 33684-2403
813.289.8080
813.282.9184 FAX
engineering@edt1.com

CITY of TAMPA
WASTEWATER DEPARTMENT

KRAUSE PS REHABILITATION
CONDUIT SCHEDULE

NO.	DATE	REVISIONS			



DRAWN: RWB
DESIGN: STK
QC: BEH
DATE: 05/01/14

SHEET E-56

BILL OF MATERIALS

B080-II8

MARK	DESCRIPTION	RATING	MANUFACTURER	CATALOG NUMBER	REMARKS
BYP	UPS BYPASS SWITCH	2P, 16A, 120 VAC	ENTRELEC	VY AR 16 SC SERIES	DIN RAIL MOUNTED
CB1 – CB3	DIN RAIL MOUNT SUPPLEMENTARY PROTECTOR	1P, 10A, 120 VAC	SIEMENS	5SY4110–7	PROVIDE 1–POLE COMB BUSBAR ON LINE SIDE.
CB4	DIN RAIL MOUNT SUPPLEMENTARY PROTECTOR	1P, 2A, 120 VAC	SIEMENS	5SY4102–7	PROVIDE 1–POLE COMB BUSBAR ON LINE SIDE.
CCB	CONTROL CIRCUIT BREAKER	1P, 20A, 120 VAC	SIEMENS	BQXD SERIES	INSULATE UNUSED CONNECTION POSITIONS.
ENC	CONTROL PANEL ENCLOSURE	72" x 72" x 16"	HOFFMAN	A727216ULP	w/ A72P72SS6 BACK PANEL
EP–GFCI	ETHERNET PORT/GFCI	120 VAC, 5A	GRACE ENGINEERING	P–R2–K3RF0	PROVIDE ETHERNET CONNECTION TO PLC.
GB–AC	AC GROUND BLOCK	240 VAC, 225A	SIEMENS	EGK	PROVIDE MOUNTING HARDWARE.
GB–DC	DC GROUND BLOCK	240 VAC, 225A	SIEMENS	EGK	PROVIDE MOUNTING HARDWARE.
HMI–1	HUMAN MACHINE INTERFACE – ANNUNCIATOR	24 VDC, 15"	MAPLE SYSTEMS	HMI5150X	ANNUNCIATOR
HMI–2	HUMAN MACHINE INTERFACE – PUMP CONTROL	24 VDC, 7"	MAPLE SYSTEMS	HMI5070NH	PUMP CONTROL
ISR–1	INTRINSICALLY SAFE RELAY	120 VAC	DIVERSIFIED ELECTRONICS	ISO–120–AAE	DUAL CHANNEL
LEL	WET WELL LEL DISPLAY	120 VAC	PRECISION DIGITAL	PD765–6R2–10	w/ 2 PROGRAMMABLE RELAYS & 24 VDC POWER SUPPLY
NB	NEUTRAL BLOCK	240 VAC, 225A	SIEMENS	CNLK18	PROVIDE MOUNTING HARDWARE.
PCSR	PUMP CONTROLLER/SCADA/RADIO	----	MOTOROLA	ACE 3600 SERIES	REFERENCE SPECIFICATIONS.
PS1	24 VDC POWER SUPPLY	INPUT 1Ø, 120 VAC, 1.3A OUTPUT 24 VDC, 2.5A	SOLA	SDN 2.5–24–100	PROVIDE MOUNTING TRACK AND ACCESSORIES.
REC	DUPLEX RECEPTACLE	20A, 125 VAC	LEVITON	5362–I	PROVIDE ALUMINUM BACK BOX & ALUMINUM COVERPLATE.
SS1 – SS2	DIN RAIL MOUNT SURGE SUPPRESSOR	1Ø, 120 VAC, 60 HZ	PHOENIX CONTACT	2807586	PROVIDE MOUNTING TRACK & BASE. (2817741)
UPS	UNINTERRUPTIBLE POWER SUPPLY	120 VAC, 500 VA/300W	SOLA	SDU500	DIN RAIL MOUNTED

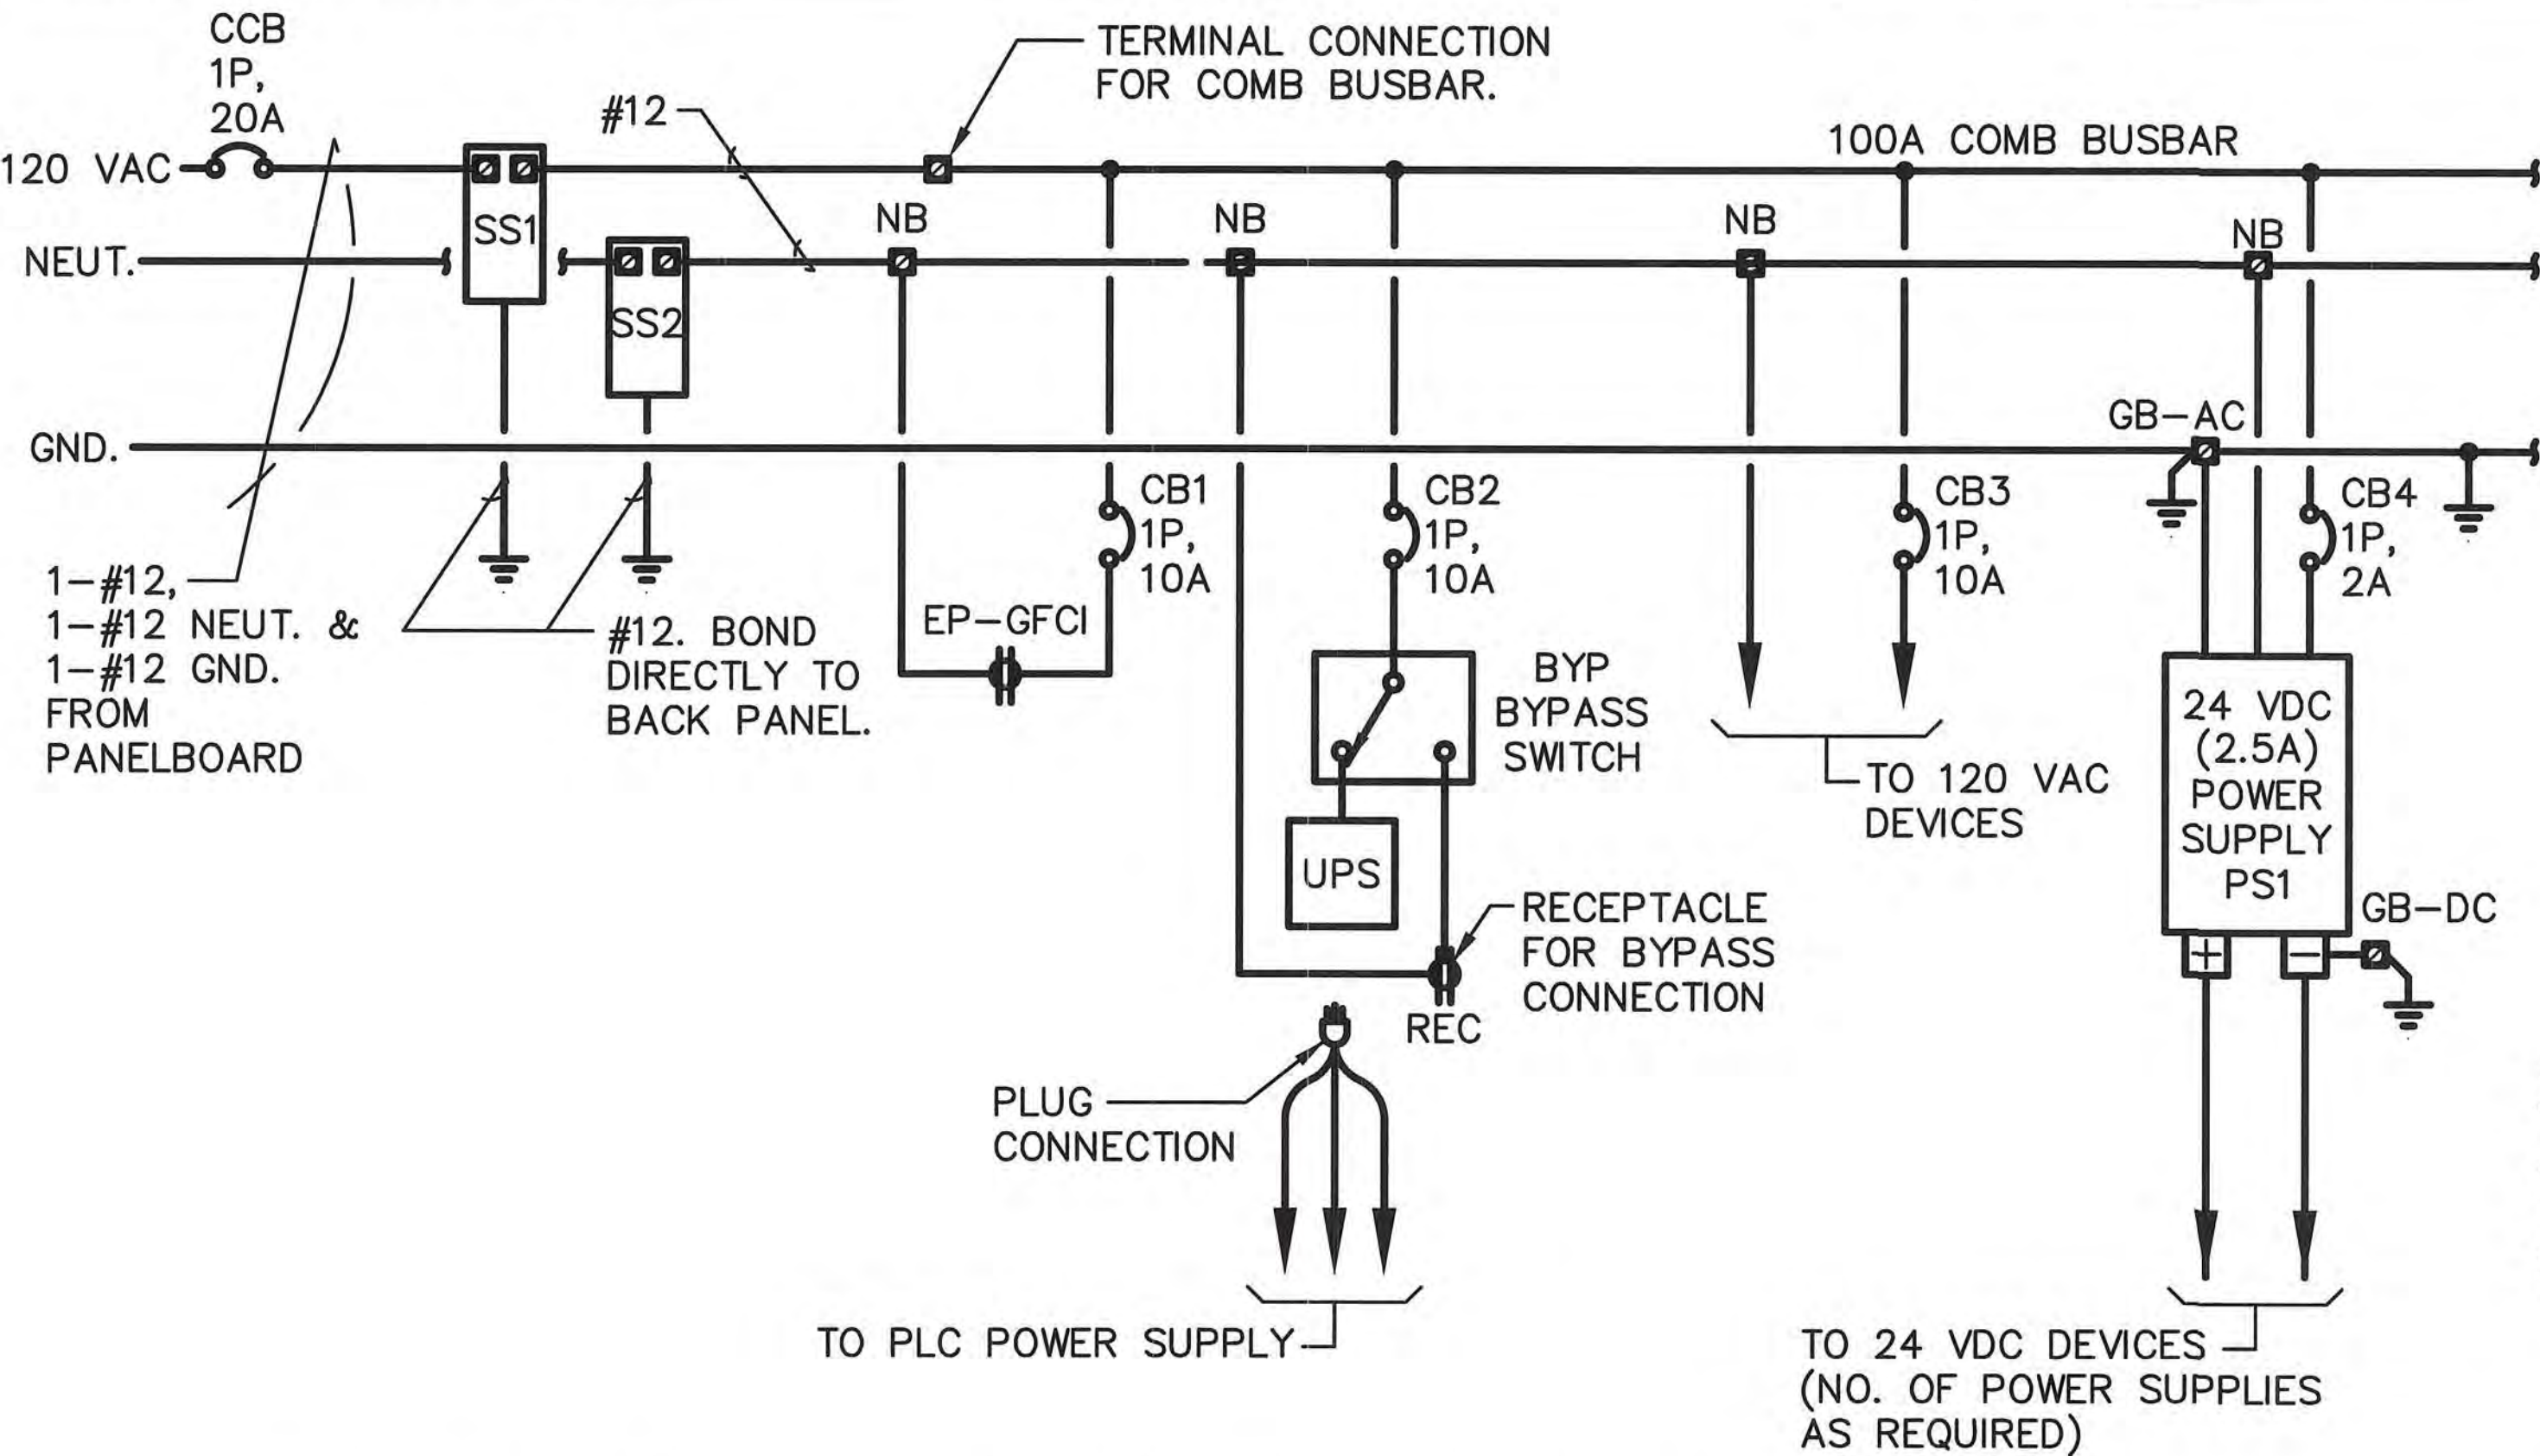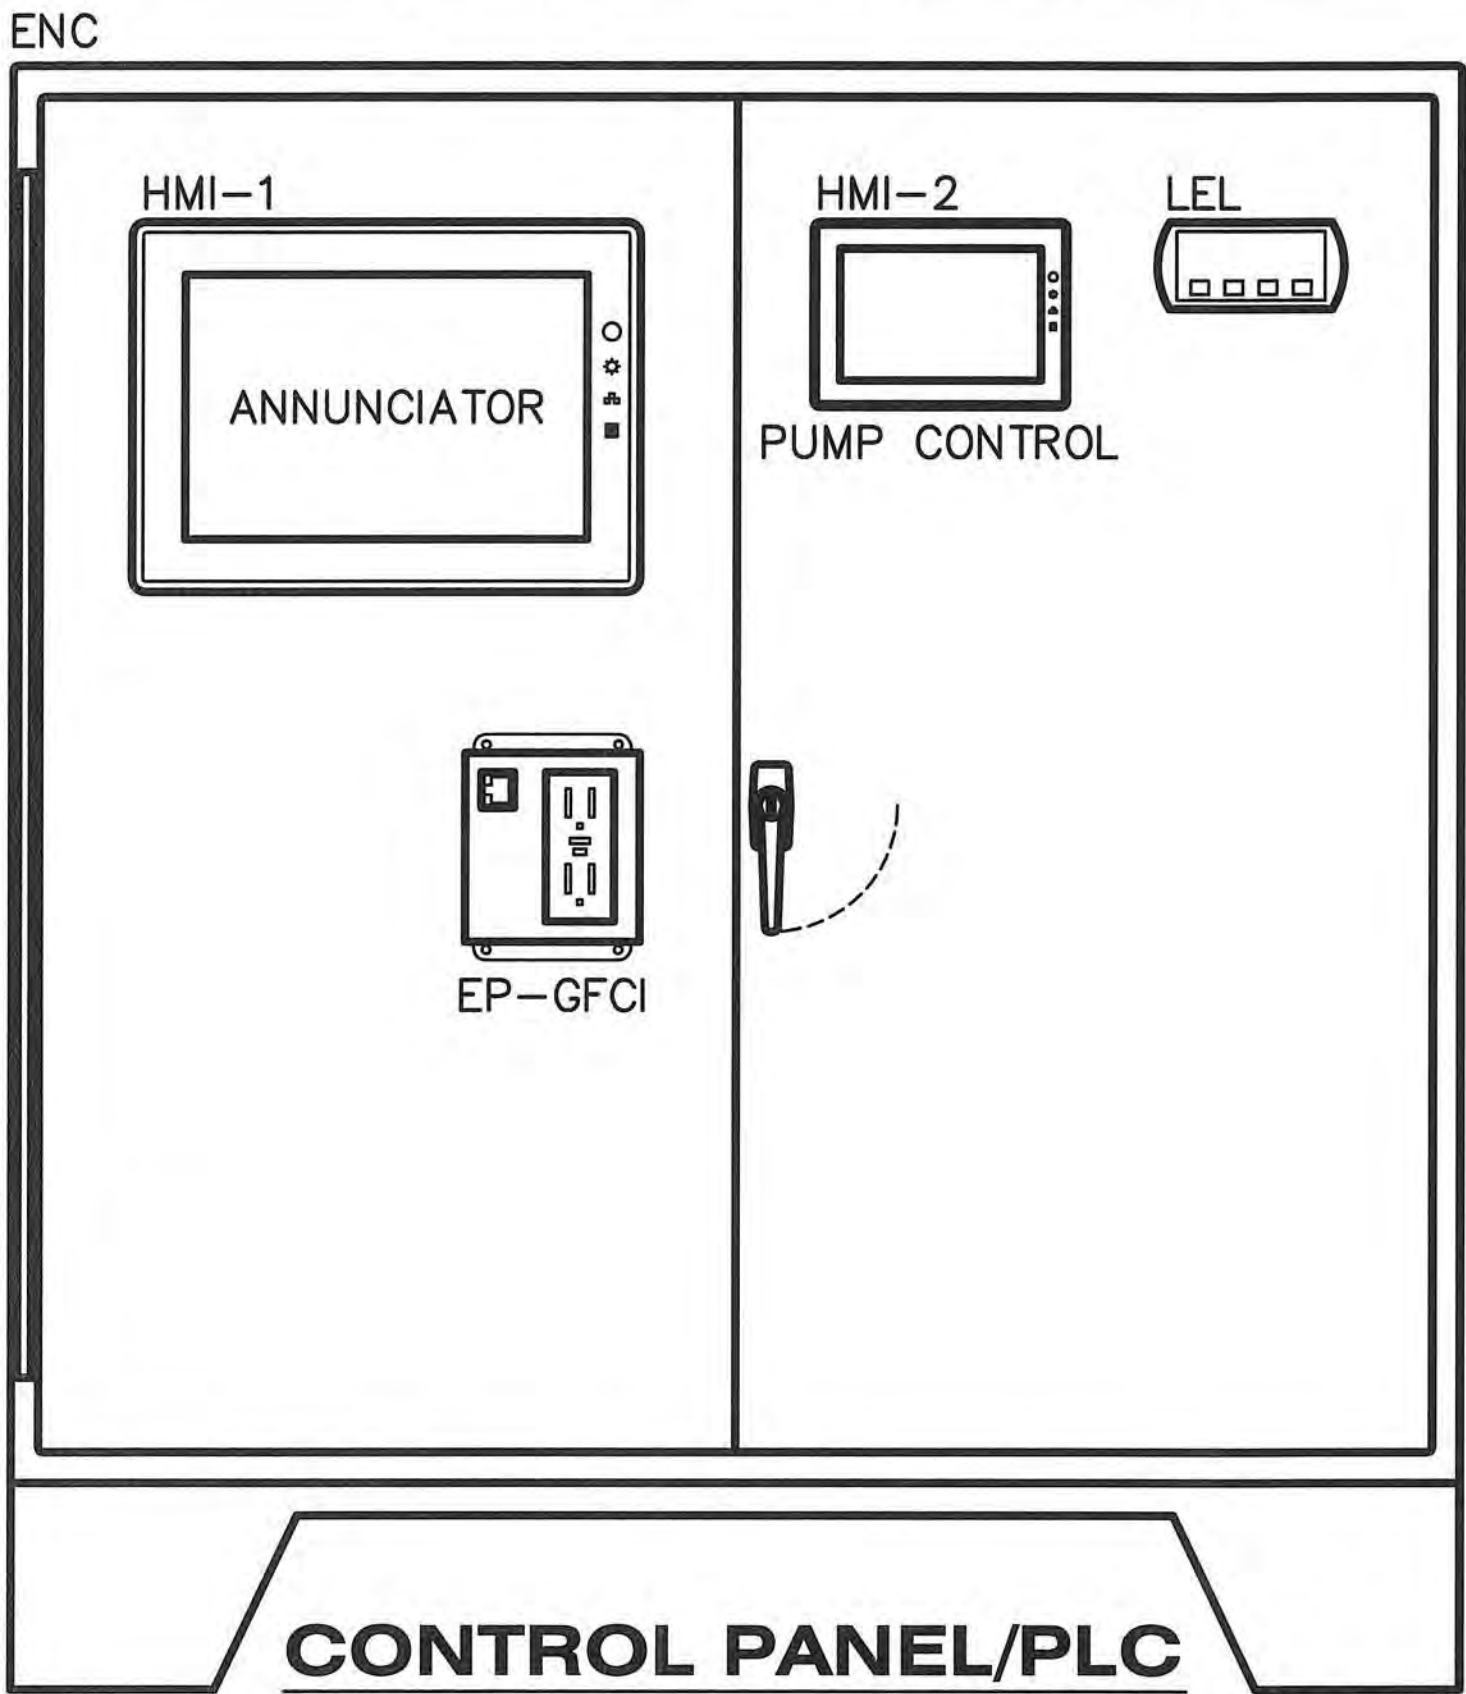

NOTES:

- REFERENCE PLC INTERCONNECTION DIAGRAMS.
- THE SHIELD AND DRAIN WIRE FOR EACH SHIELDED CABLE SHALL BE GROUNDED AT THE CONTROL PANEL/PLC ONLY. THE SHIELD AND DRAIN WIRE AT THE PUMP CONTROL JUNCTION BOX SHALL BE NEATLY TRIMMED & TAPED w/ (2) LAYERS OF VINYL ELECTRICAL TAPE (SCOTCH 33+).

Δ DENOTES TERMINAL FOR FIELD CONNECTION.

CONTROL PANEL/PLC POWER CONNECTIONS

ENGINEER OF RECORD:
BOB E. HALLMAN, P.E.
FLORIDA REGISTRATION NO. 20761



Engineering Design
Technologies Corp.
P.O. Box 152403
Tampa, FL 33684-2403
813.289.8080
813.282.9184 FAX
engineering@edt1.com

CITY of TAMPA
WASTEWATER DEPARTMENT


KRAUSE PS REHABILITATION

CONTROL PANEL/PLC
POWER CONNECTIONS


NO.	DATE			REVISIONS	

DRAWN: RWB
DESIGN: STK
QC: BEH
DATE: 05/01/14

SHEET I-1


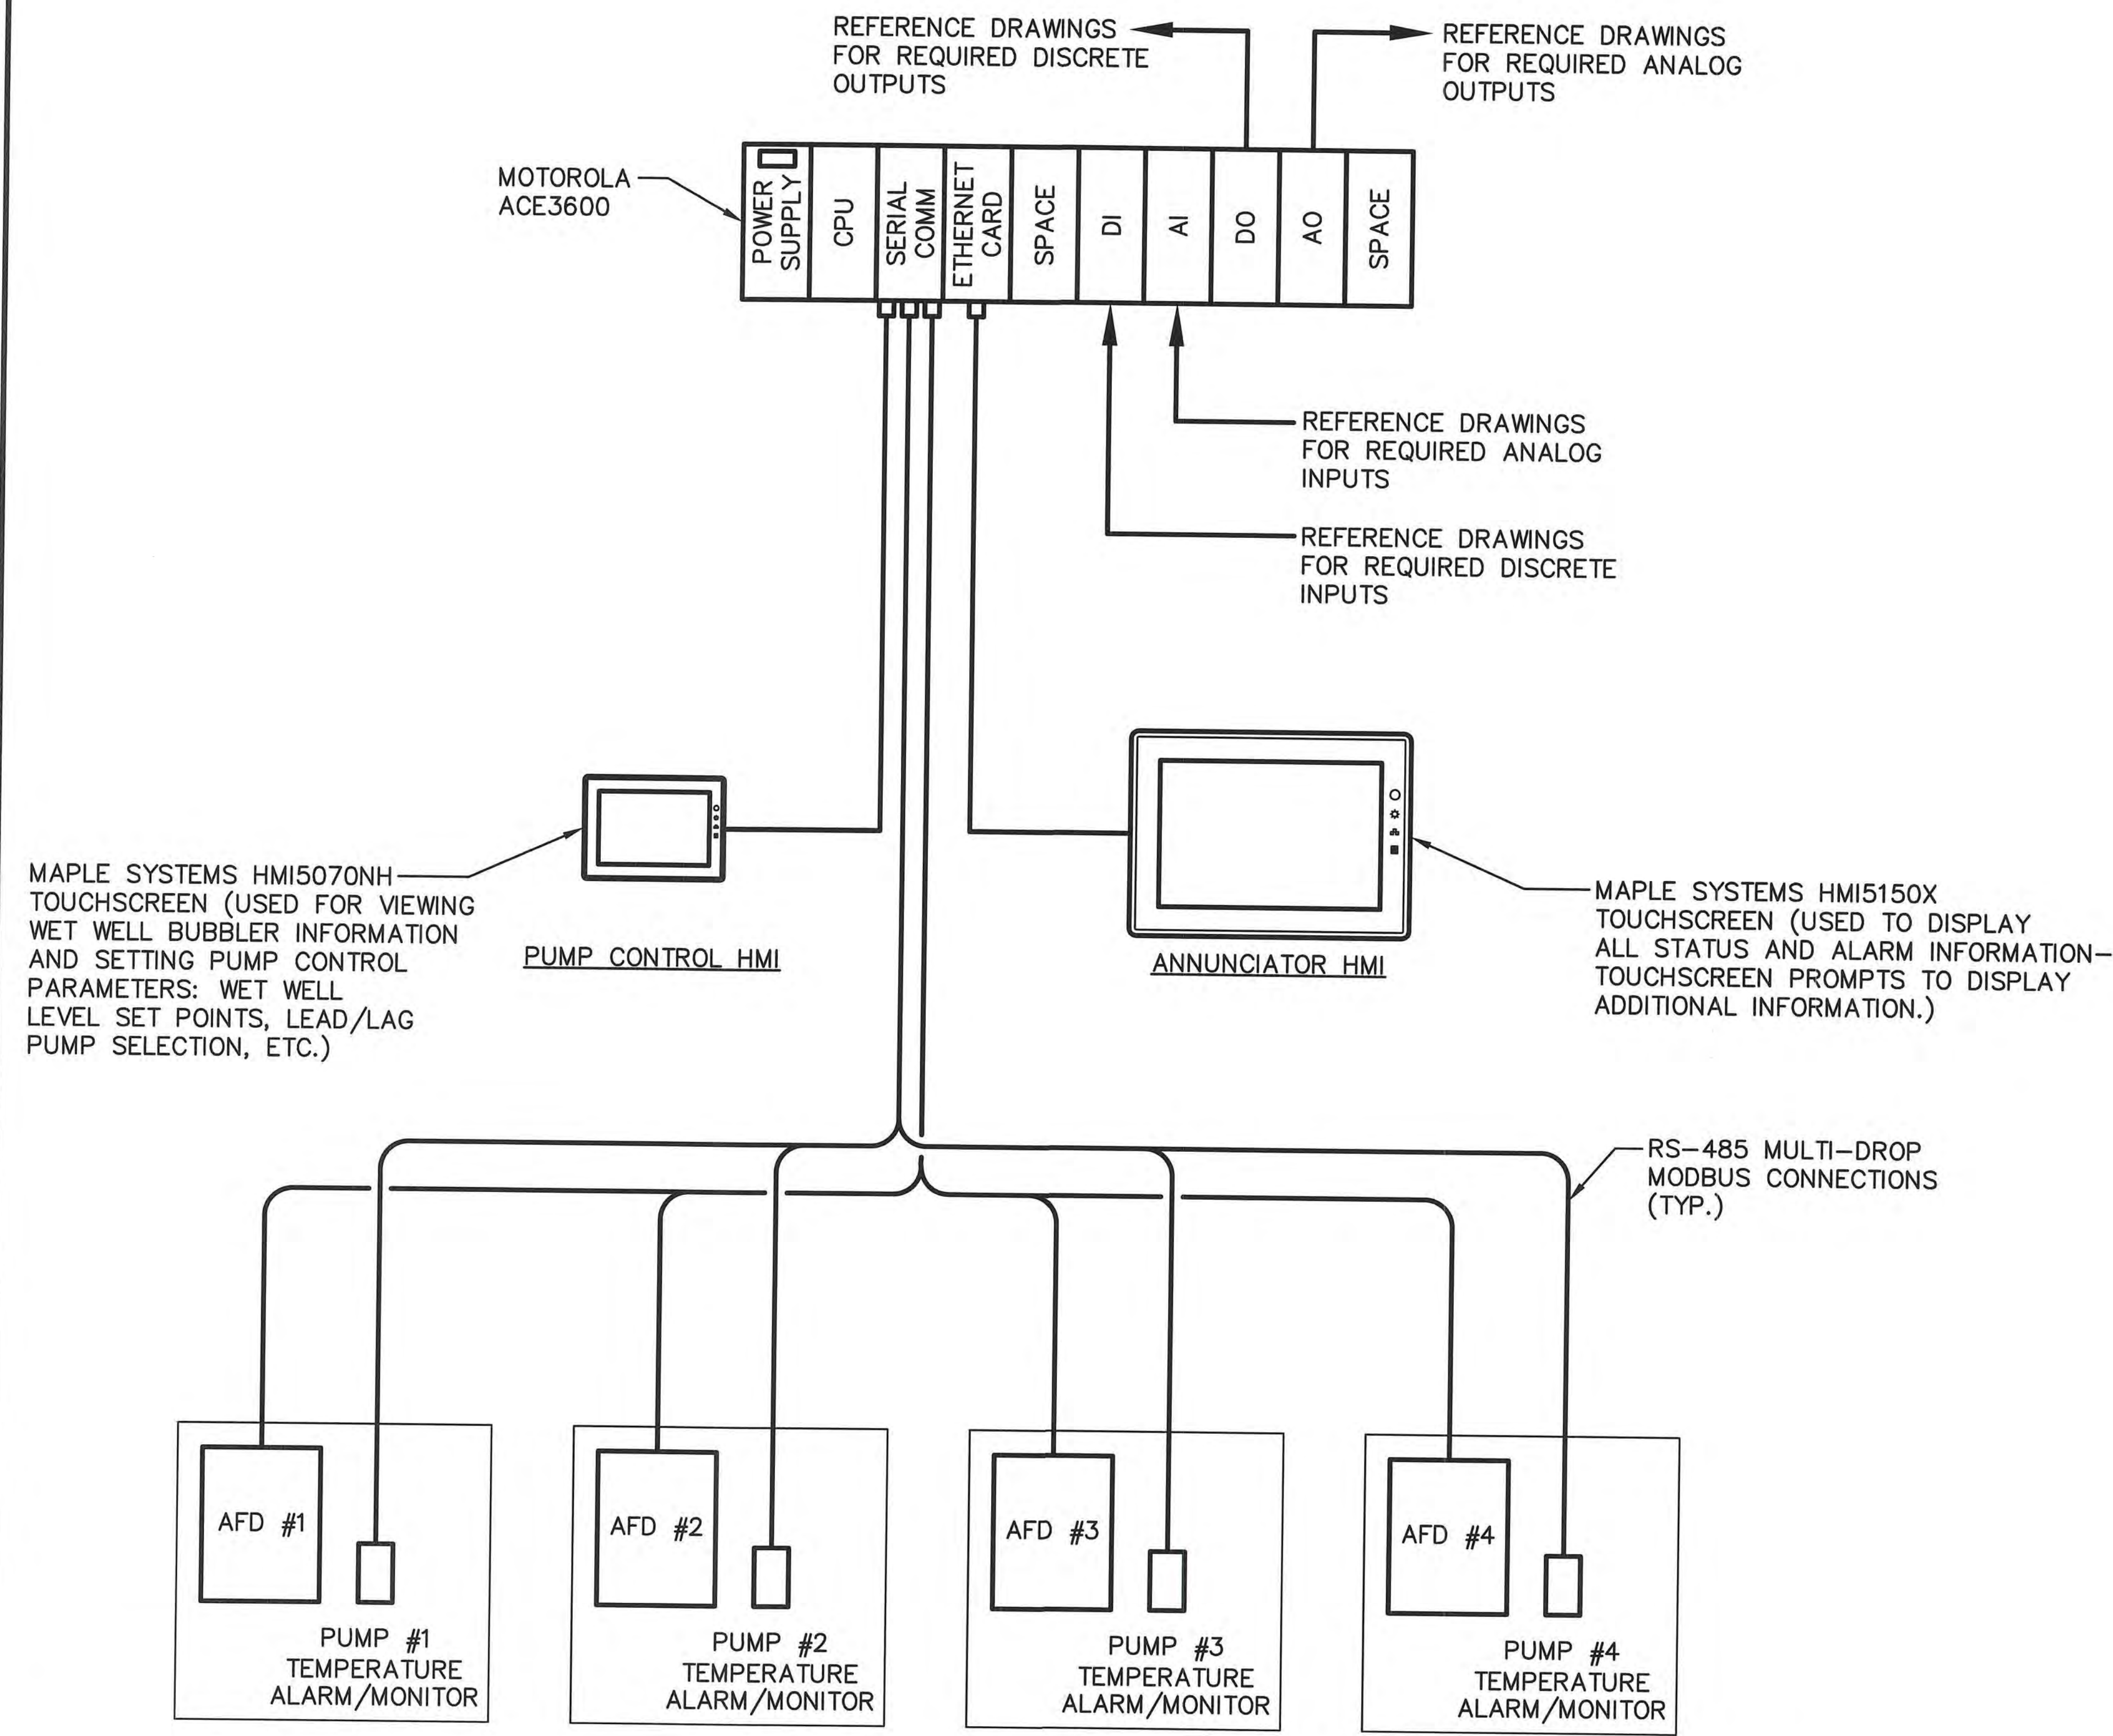


PROPOSED ANNUNCIATOR RISER DIAGRAM

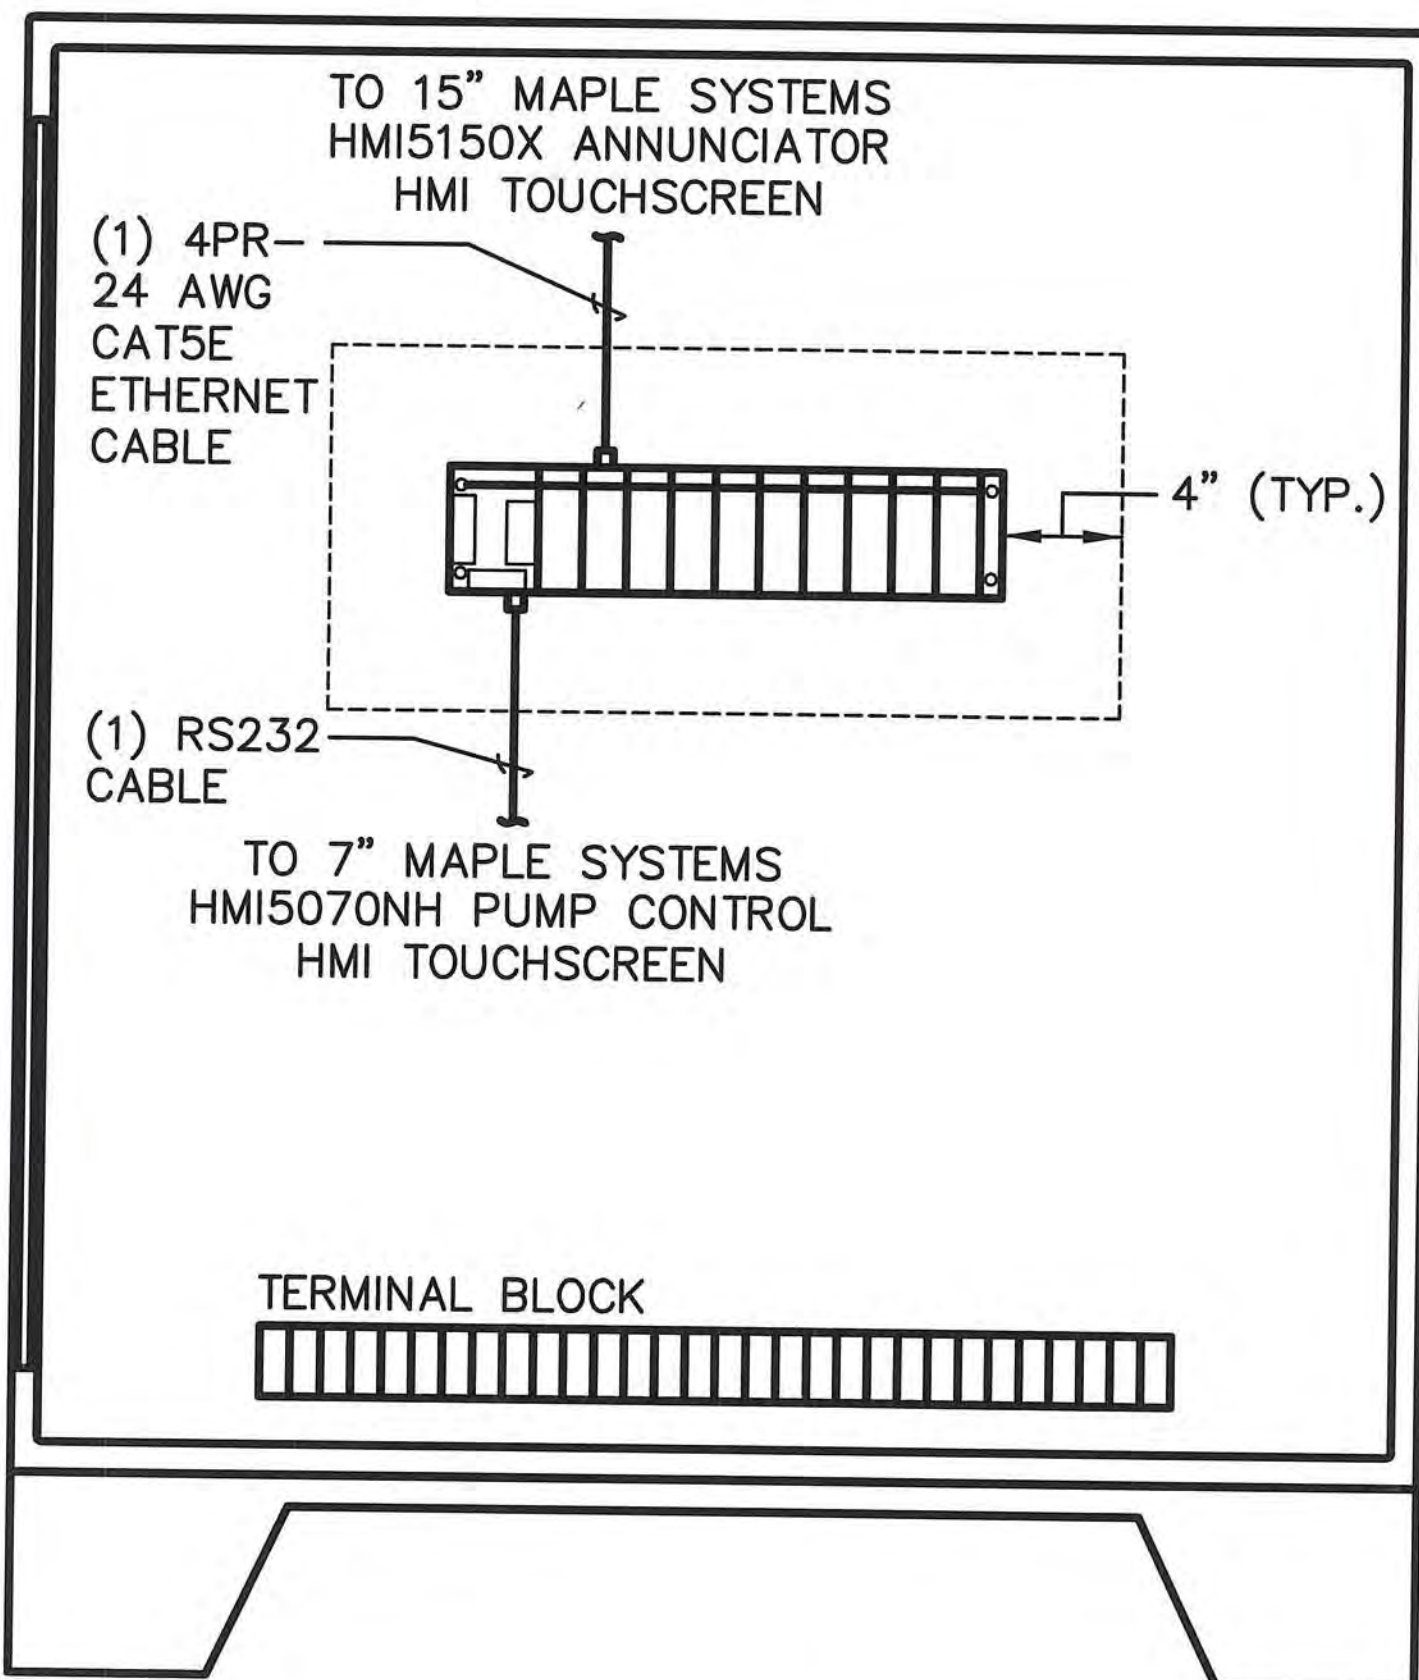

PARTIAL EQUIPMENT BACK PANEL LAYOUT

ENGINEER OF RECORD:
BOB E. HALLMAN, P.E.
FLORIDA REGISTRATION NO. 20761

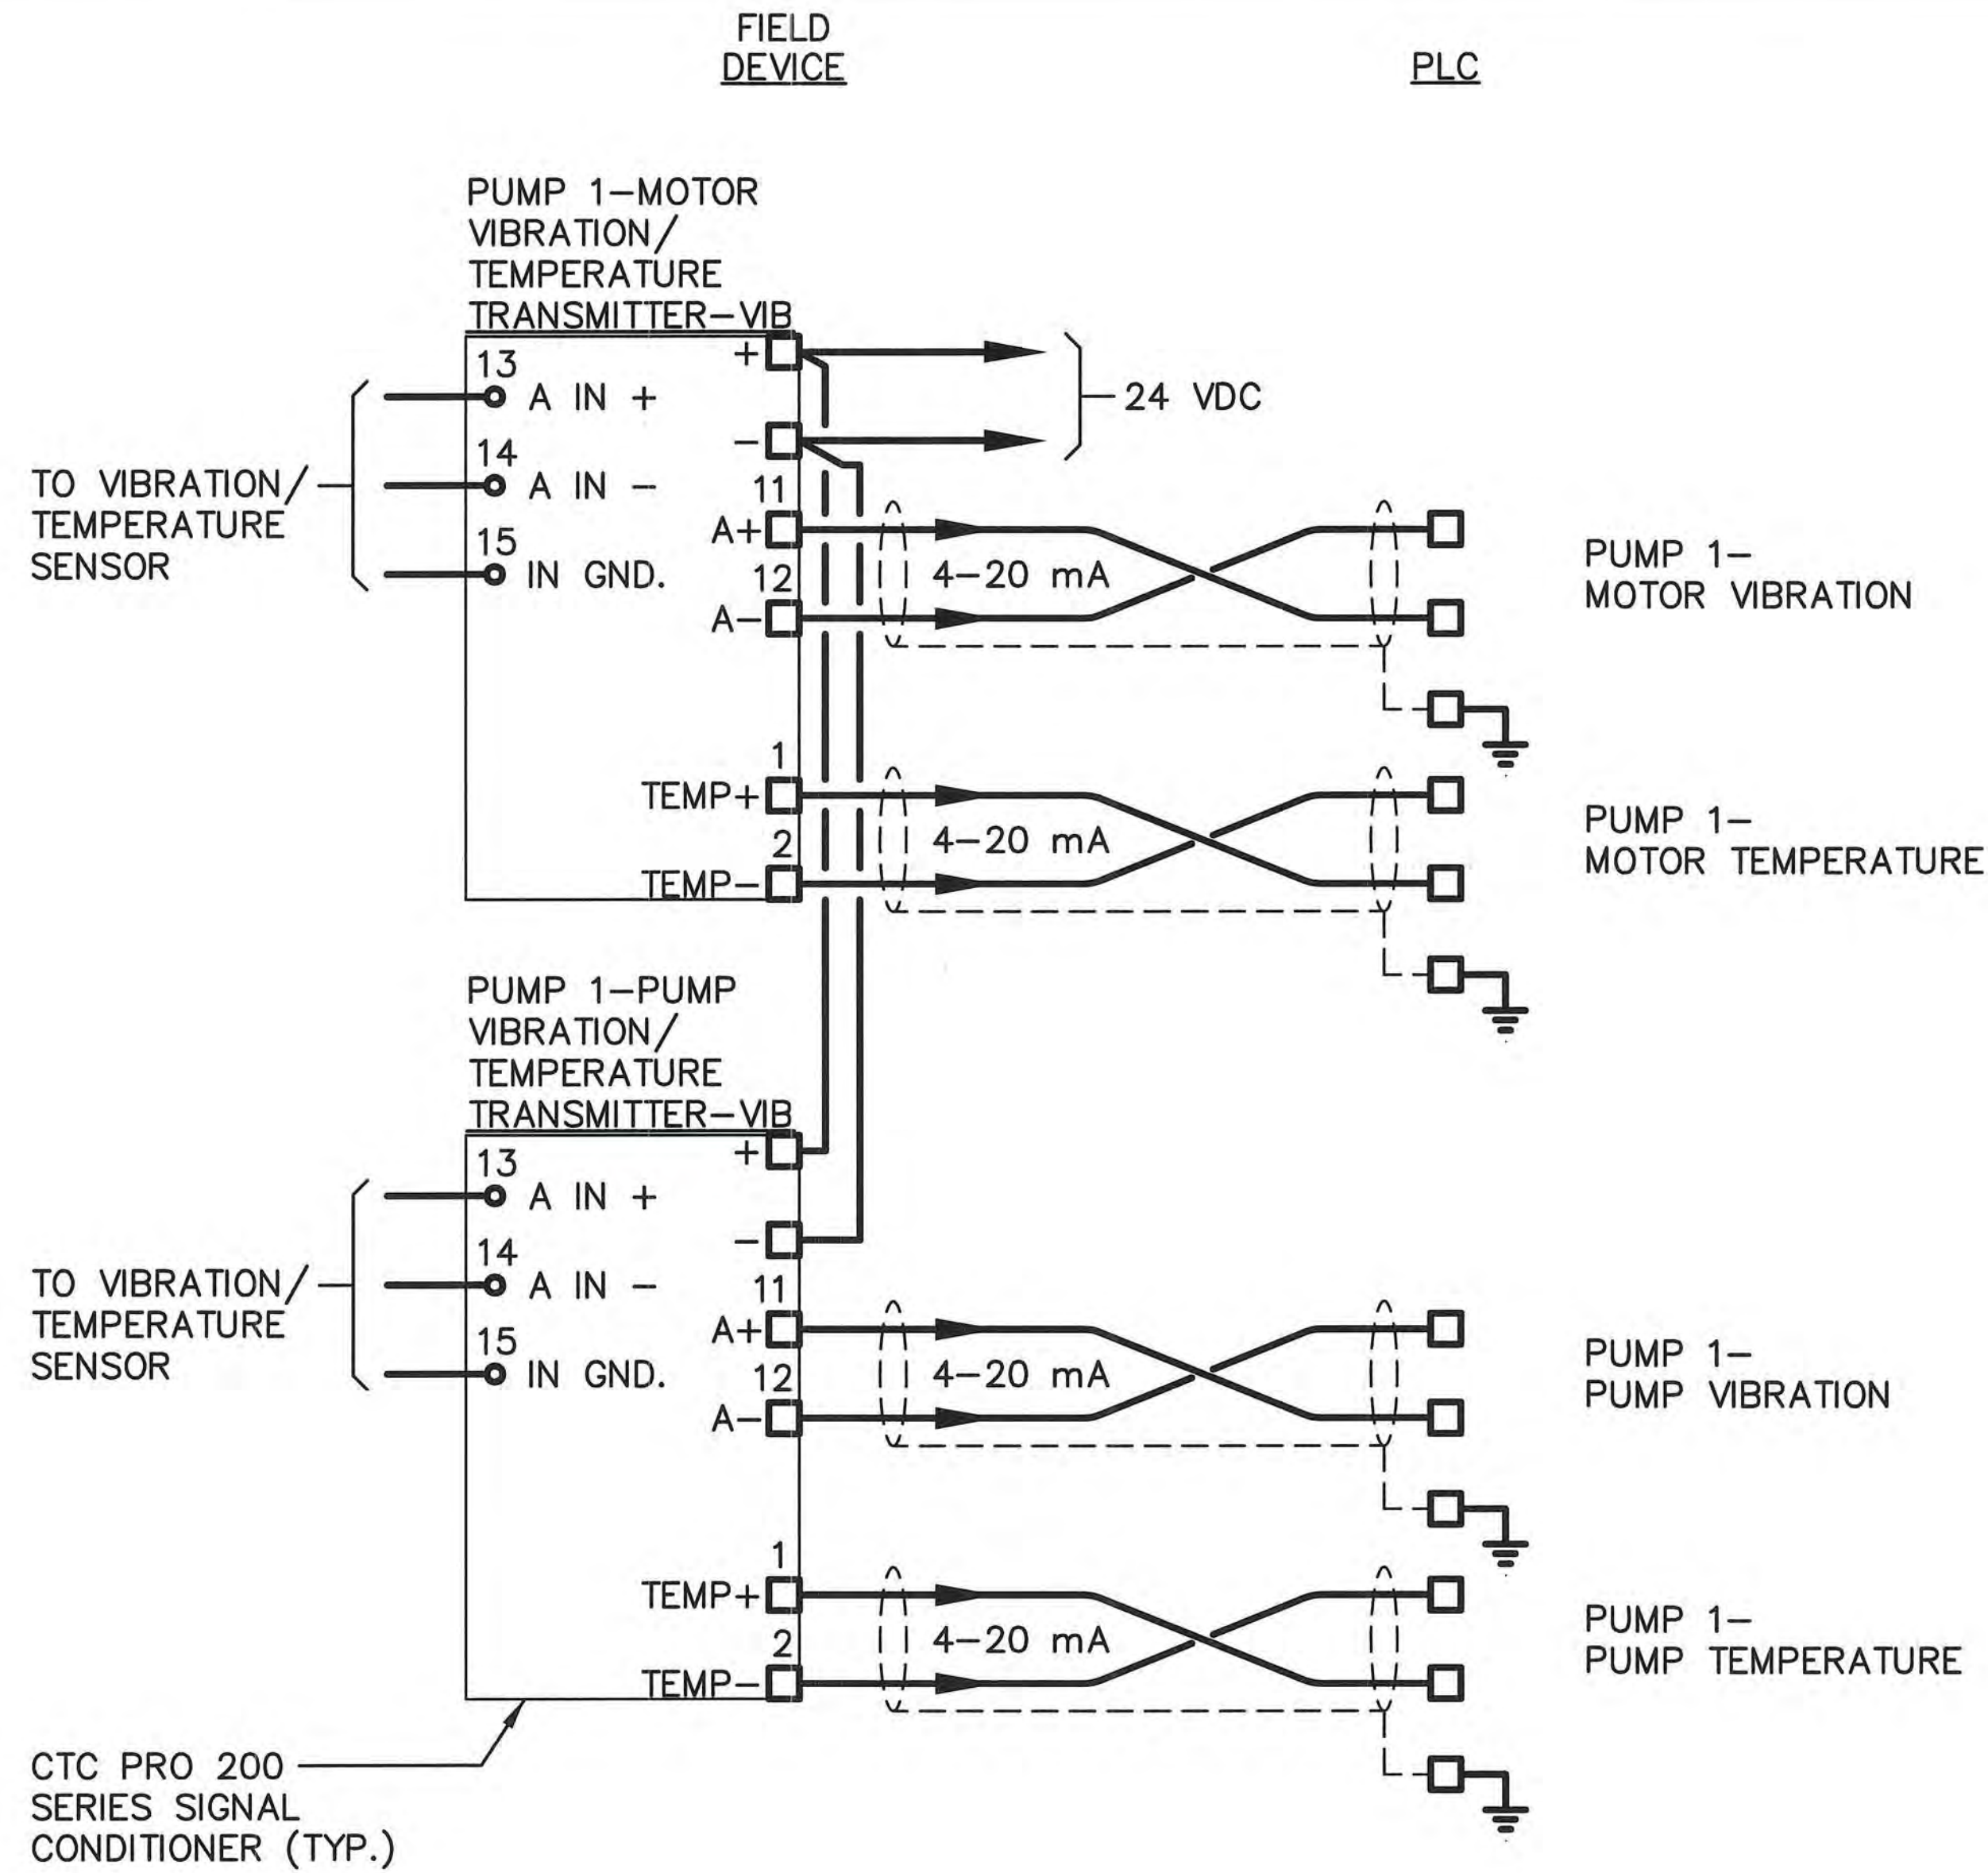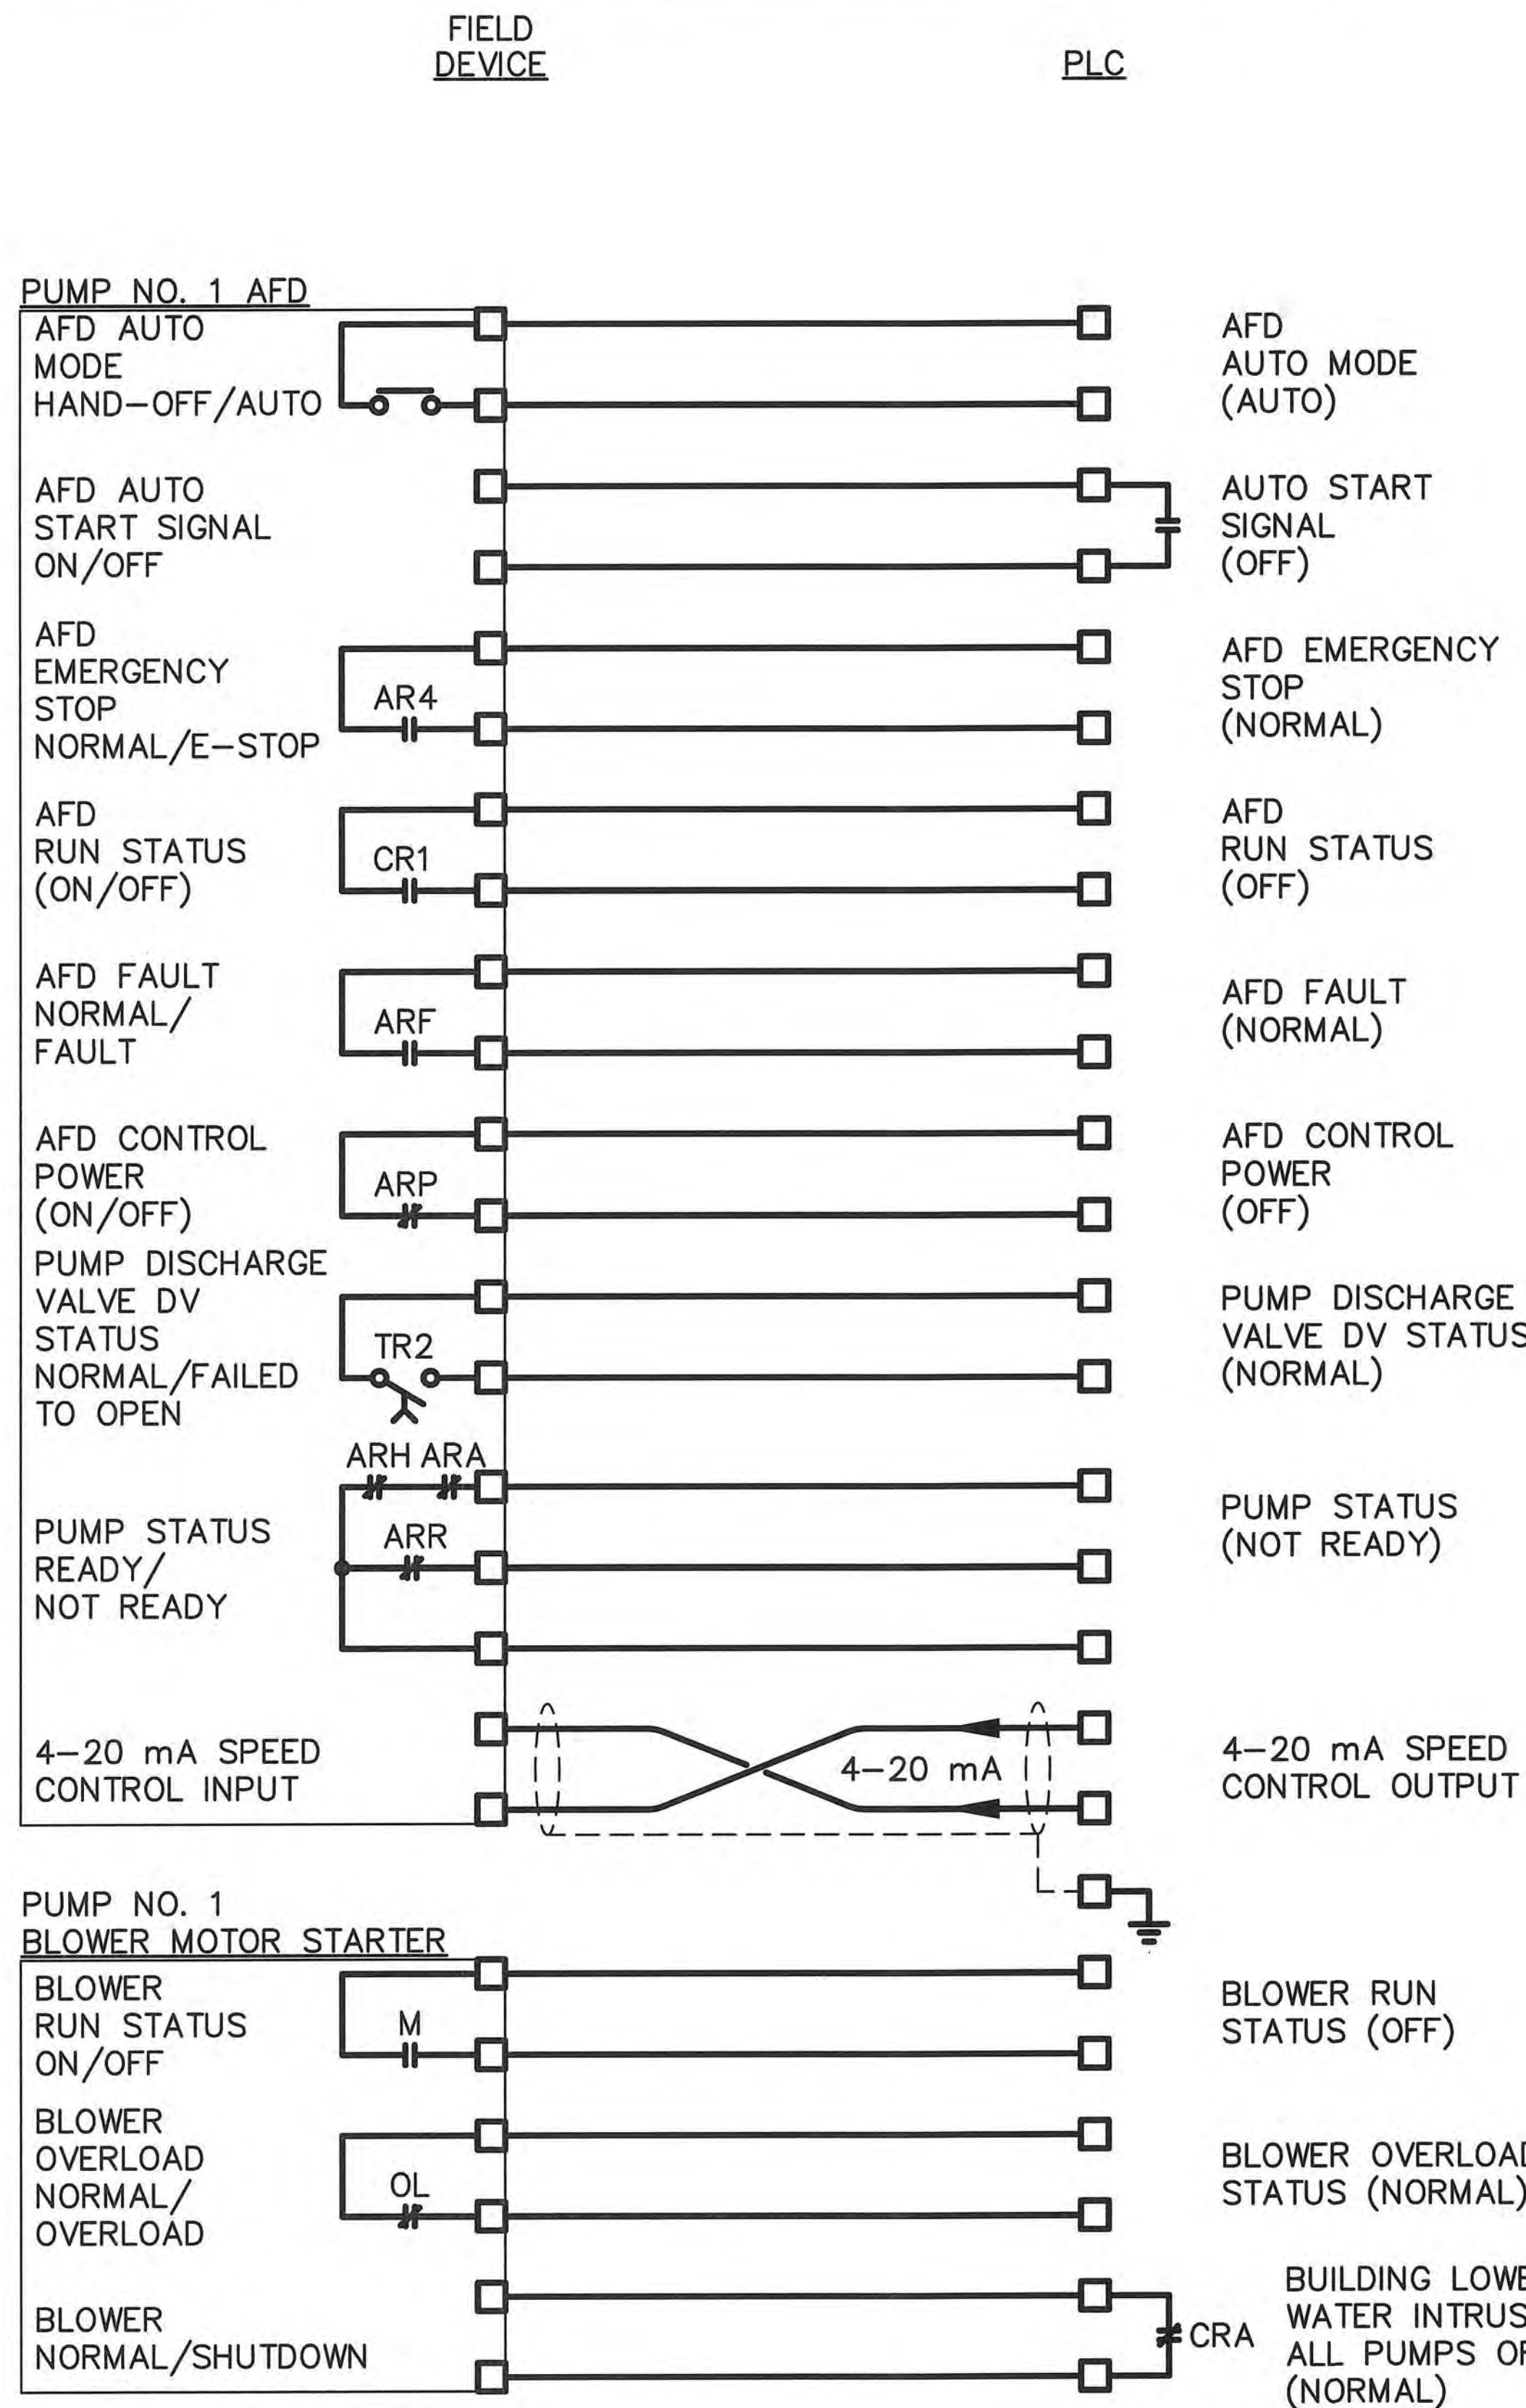

NOTES:

- CONTACTS ARE SHOWN IN DE-ENERGIZED STATE.
- THE STATUS FOR FIELD CONTACT POSITIONS ARE DENOTED IN PARENTHESIS.
- THE SHIELD & DRAIN WIRES FOR ANALOG CABLES SHALL BE GROUNDED AT THE PLC ONLY. THE SHIELD & DRAIN WIRE AT THE END DEVICE SHALL BE NEATLY TRIMMED & TAPED w/ 2 LAYERS OF VINYL ELECTRICAL TAPE (SCOTCH 33+).
- A TIME DELAY OF 20 SECONDS SHALL BE PROVIDED BEFORE THE STARTING OF ANY MOTOR AFTER A LOSS OF UTILITY POWER.

ENGINEER OF RECORD:
BOB E. HALLMAN, P.E.
FLORIDA REGISTRATION NO. 20761




**Engineering Design
Technologies Corp.**
P.O. Box 152403
Tampa, FL 33684-2403
813.289.8080
813.282.9184 FAX
engineering@edt1.com

CITY of TAMPA
WASTEWATER DEPARTMENT

KRAUSE PS REHABILITATION
PLC INTERCONNECTION DIAGRAM
(SHEET 1 OF 6)

NO.	DATE	REVISIONS

DRAWN: RWB
DESIGN: STK
QC: BEH
DATE: 05/01/14

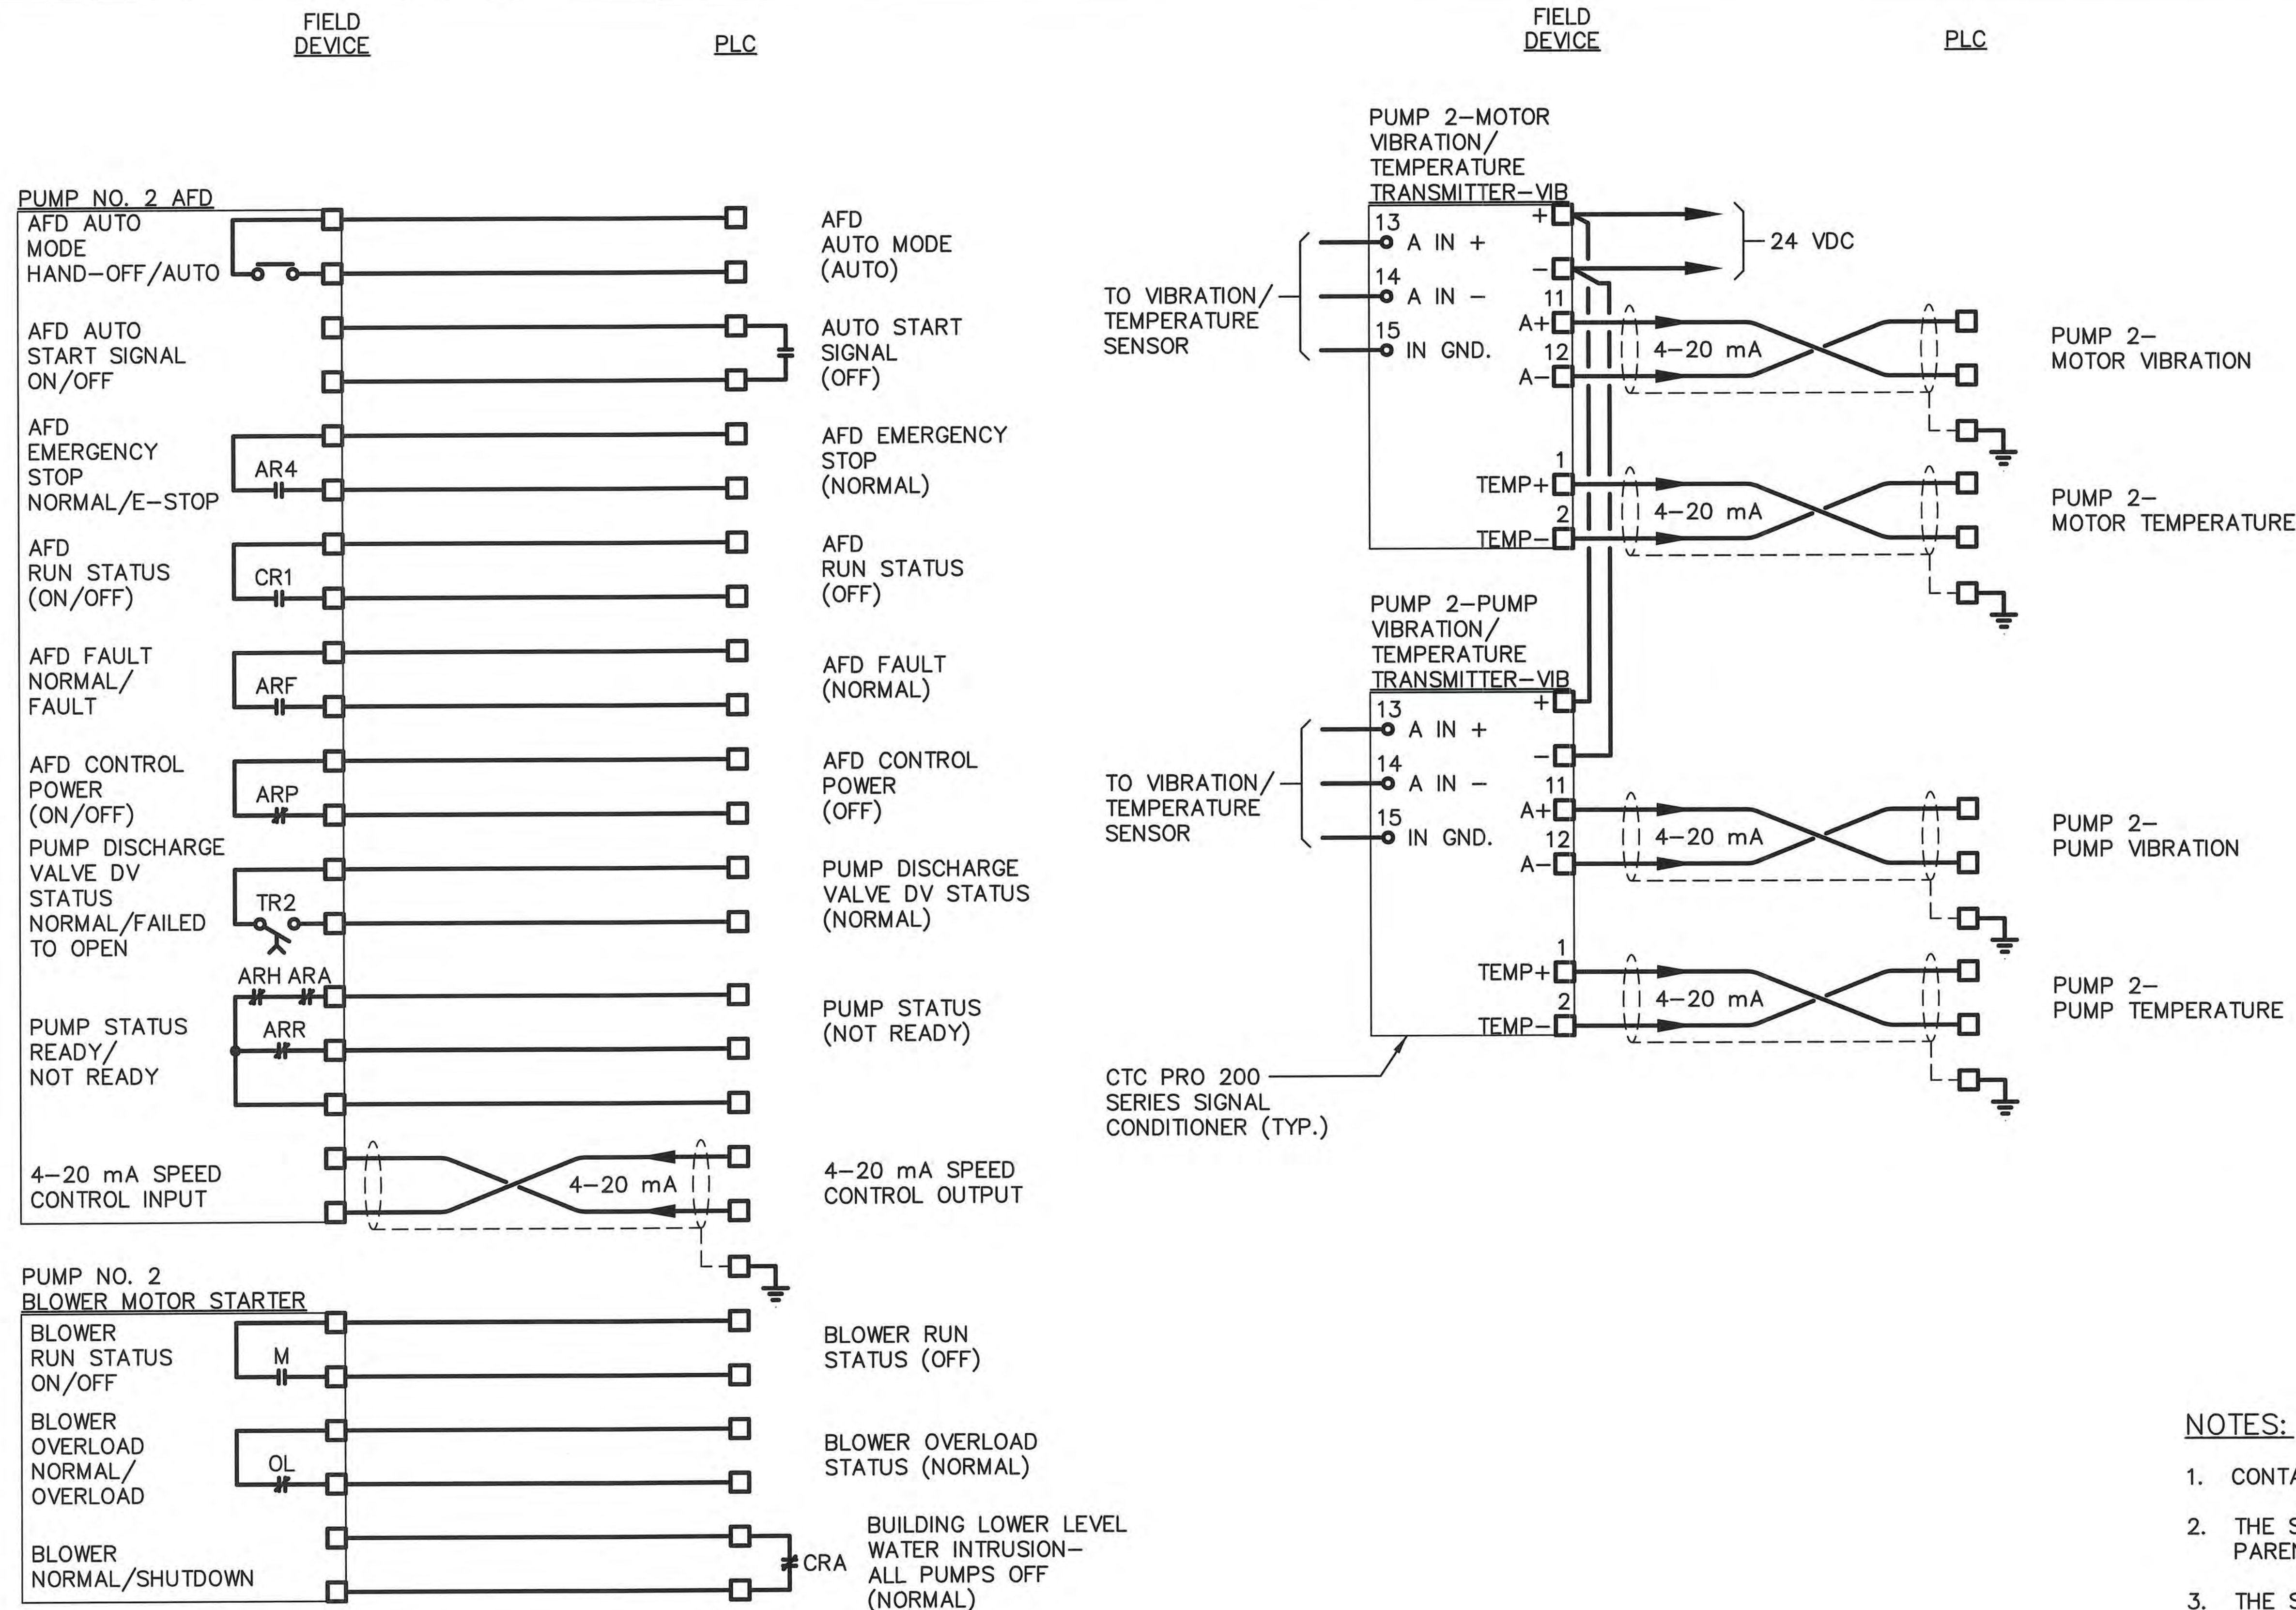**NOTES:**

- CONTACTS ARE SHOWN IN DE-ENERGIZED STATE.
- THE STATUS FOR FIELD CONTACT POSITIONS ARE DENOTED IN PARENTHESIS.
- THE SHIELD & DRAIN WIRES FOR ANALOG CABLES SHALL BE GROUNDED AT THE PLC ONLY. THE SHIELD & DRAIN WIRE AT THE END DEVICE SHALL BE NEATLY TRIMMED & TAPED w/ 2 LAYERS OF VINYL ELECTRICAL TAPE (SCOTCH 33+).
- A TIME DELAY OF 20 SECONDS SHALL BE PROVIDED BEFORE THE STARTING OF ANY MOTOR AFTER A LOSS OF UTILITY POWER.

ENGINEER OF RECORD:
BOB E. HALLMAN, P.E.
FLORIDA REGISTRATION NO. 20761



**Engineering Design
Technologies Corp.**
P.O. Box 152403
Tampa, FL 33684-2403
813.289.8080
813.282.9184 FAX
engineering@edt1.com



CITY of TAMPA
WASTEWATER DEPARTMENT

KRAUSE PS REHABILITATION**PLC INTERCONNECTION DIAGRAM
(SHEET 2 OF 6)**

NO.	DATE	REVISIONS

DRAWN: RWB
DESIGN: STK
QC: BEH
DATE: 05/01/14

SHEET I-4

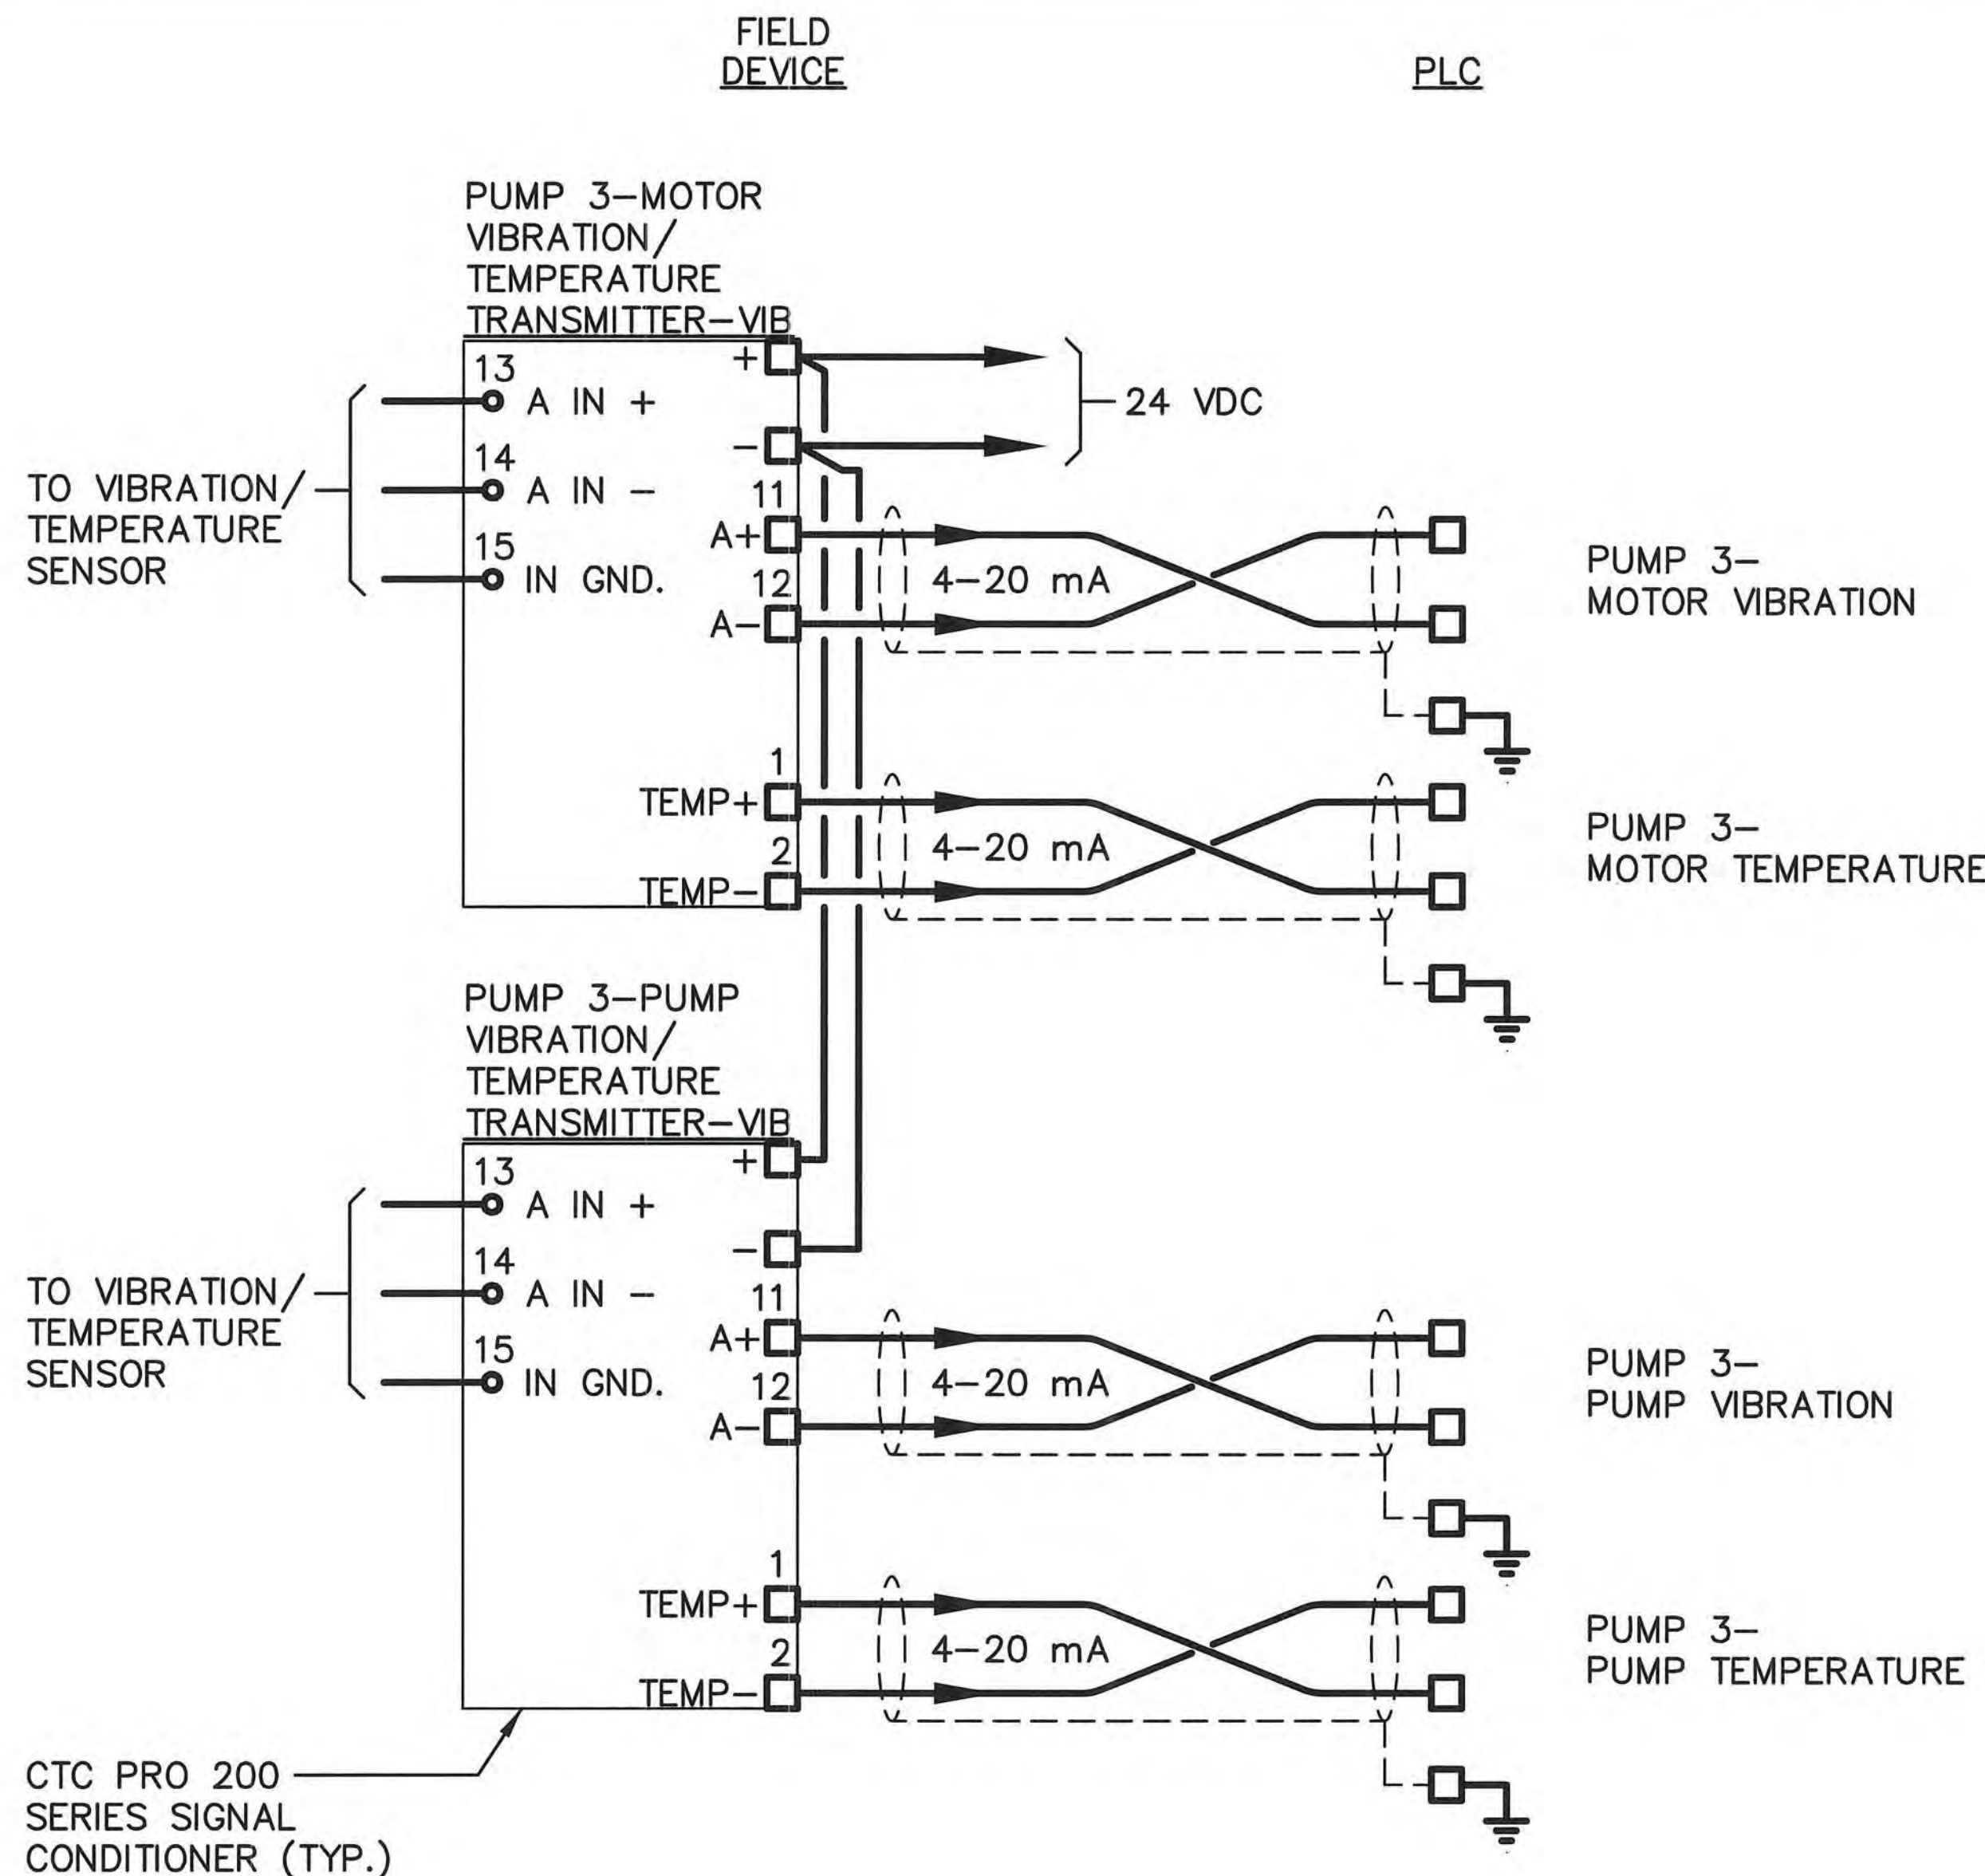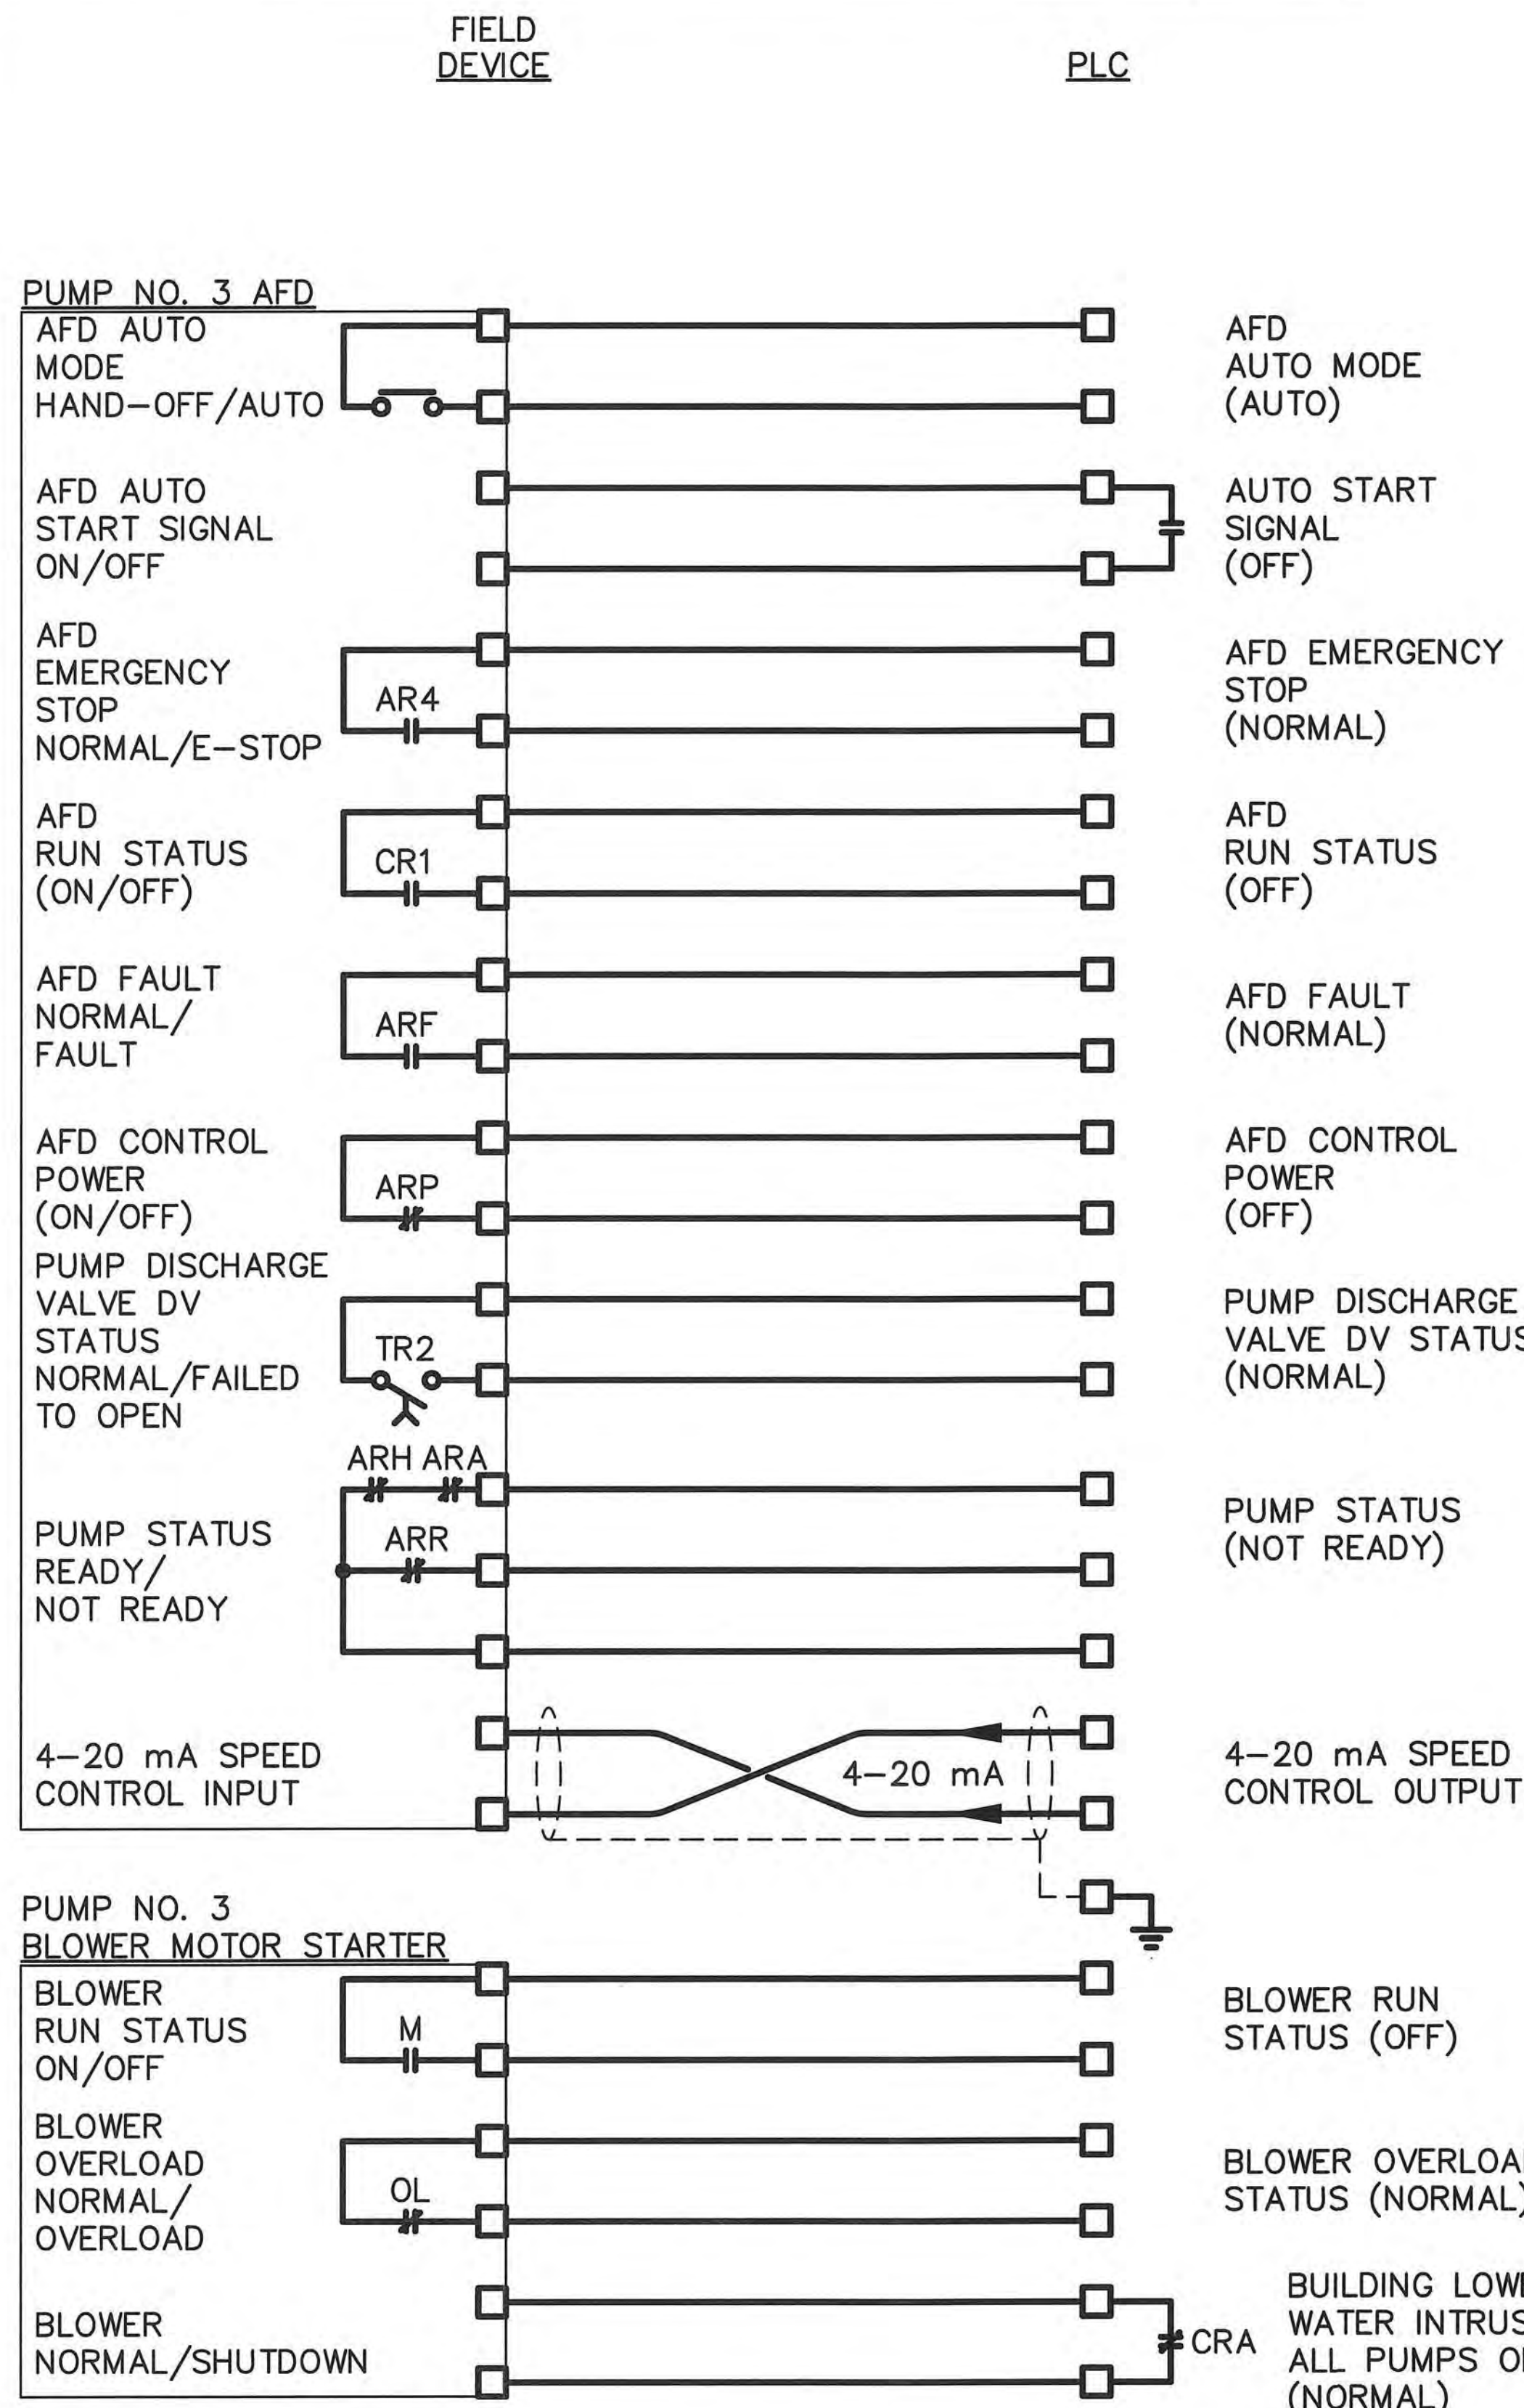

NOTES:

- CONTACTS ARE SHOWN IN DE-ENERGIZED STATE.
- THE STATUS FOR FIELD CONTACT POSITIONS ARE DENOTED IN PARENTHESIS.
- THE SHIELD & DRAIN WIRES FOR ANALOG CABLES SHALL BE GROUNDED AT THE PLC ONLY. THE SHIELD & DRAIN WIRE AT THE END DEVICE SHALL BE NEATLY TRIMMED & TAPED w/ 2 LAYERS OF VINYL ELECTRICAL TAPE (SCOTCH 33+).
- A TIME DELAY OF 20 SECONDS SHALL BE PROVIDED BEFORE THE STARTING OF ANY MOTOR AFTER A LOSS OF UTILITY POWER.

ENGINEER OF RECORD:
BOB E. HALLMAN, P.E.
FLORIDA REGISTRATION NO. 20761



Engineering Design
Technologies Corp.
P.O. Box 152403
Tampa, FL 33684-2403
813.289.8080
813.282.9184 FAX
engineering@edt1.com



CITY of TAMPA
WASTEWATER DEPARTMENT

KRAUSE PS REHABILITATION
PLC INTERCONNECTION DIAGRAM
(SHEET 3 OF 6)

NO.	DATE	REVISIONS

DRAWN: RWB
DESIGN: STK
QC: BEH
DATE: 05/01/14


SHEET I-5

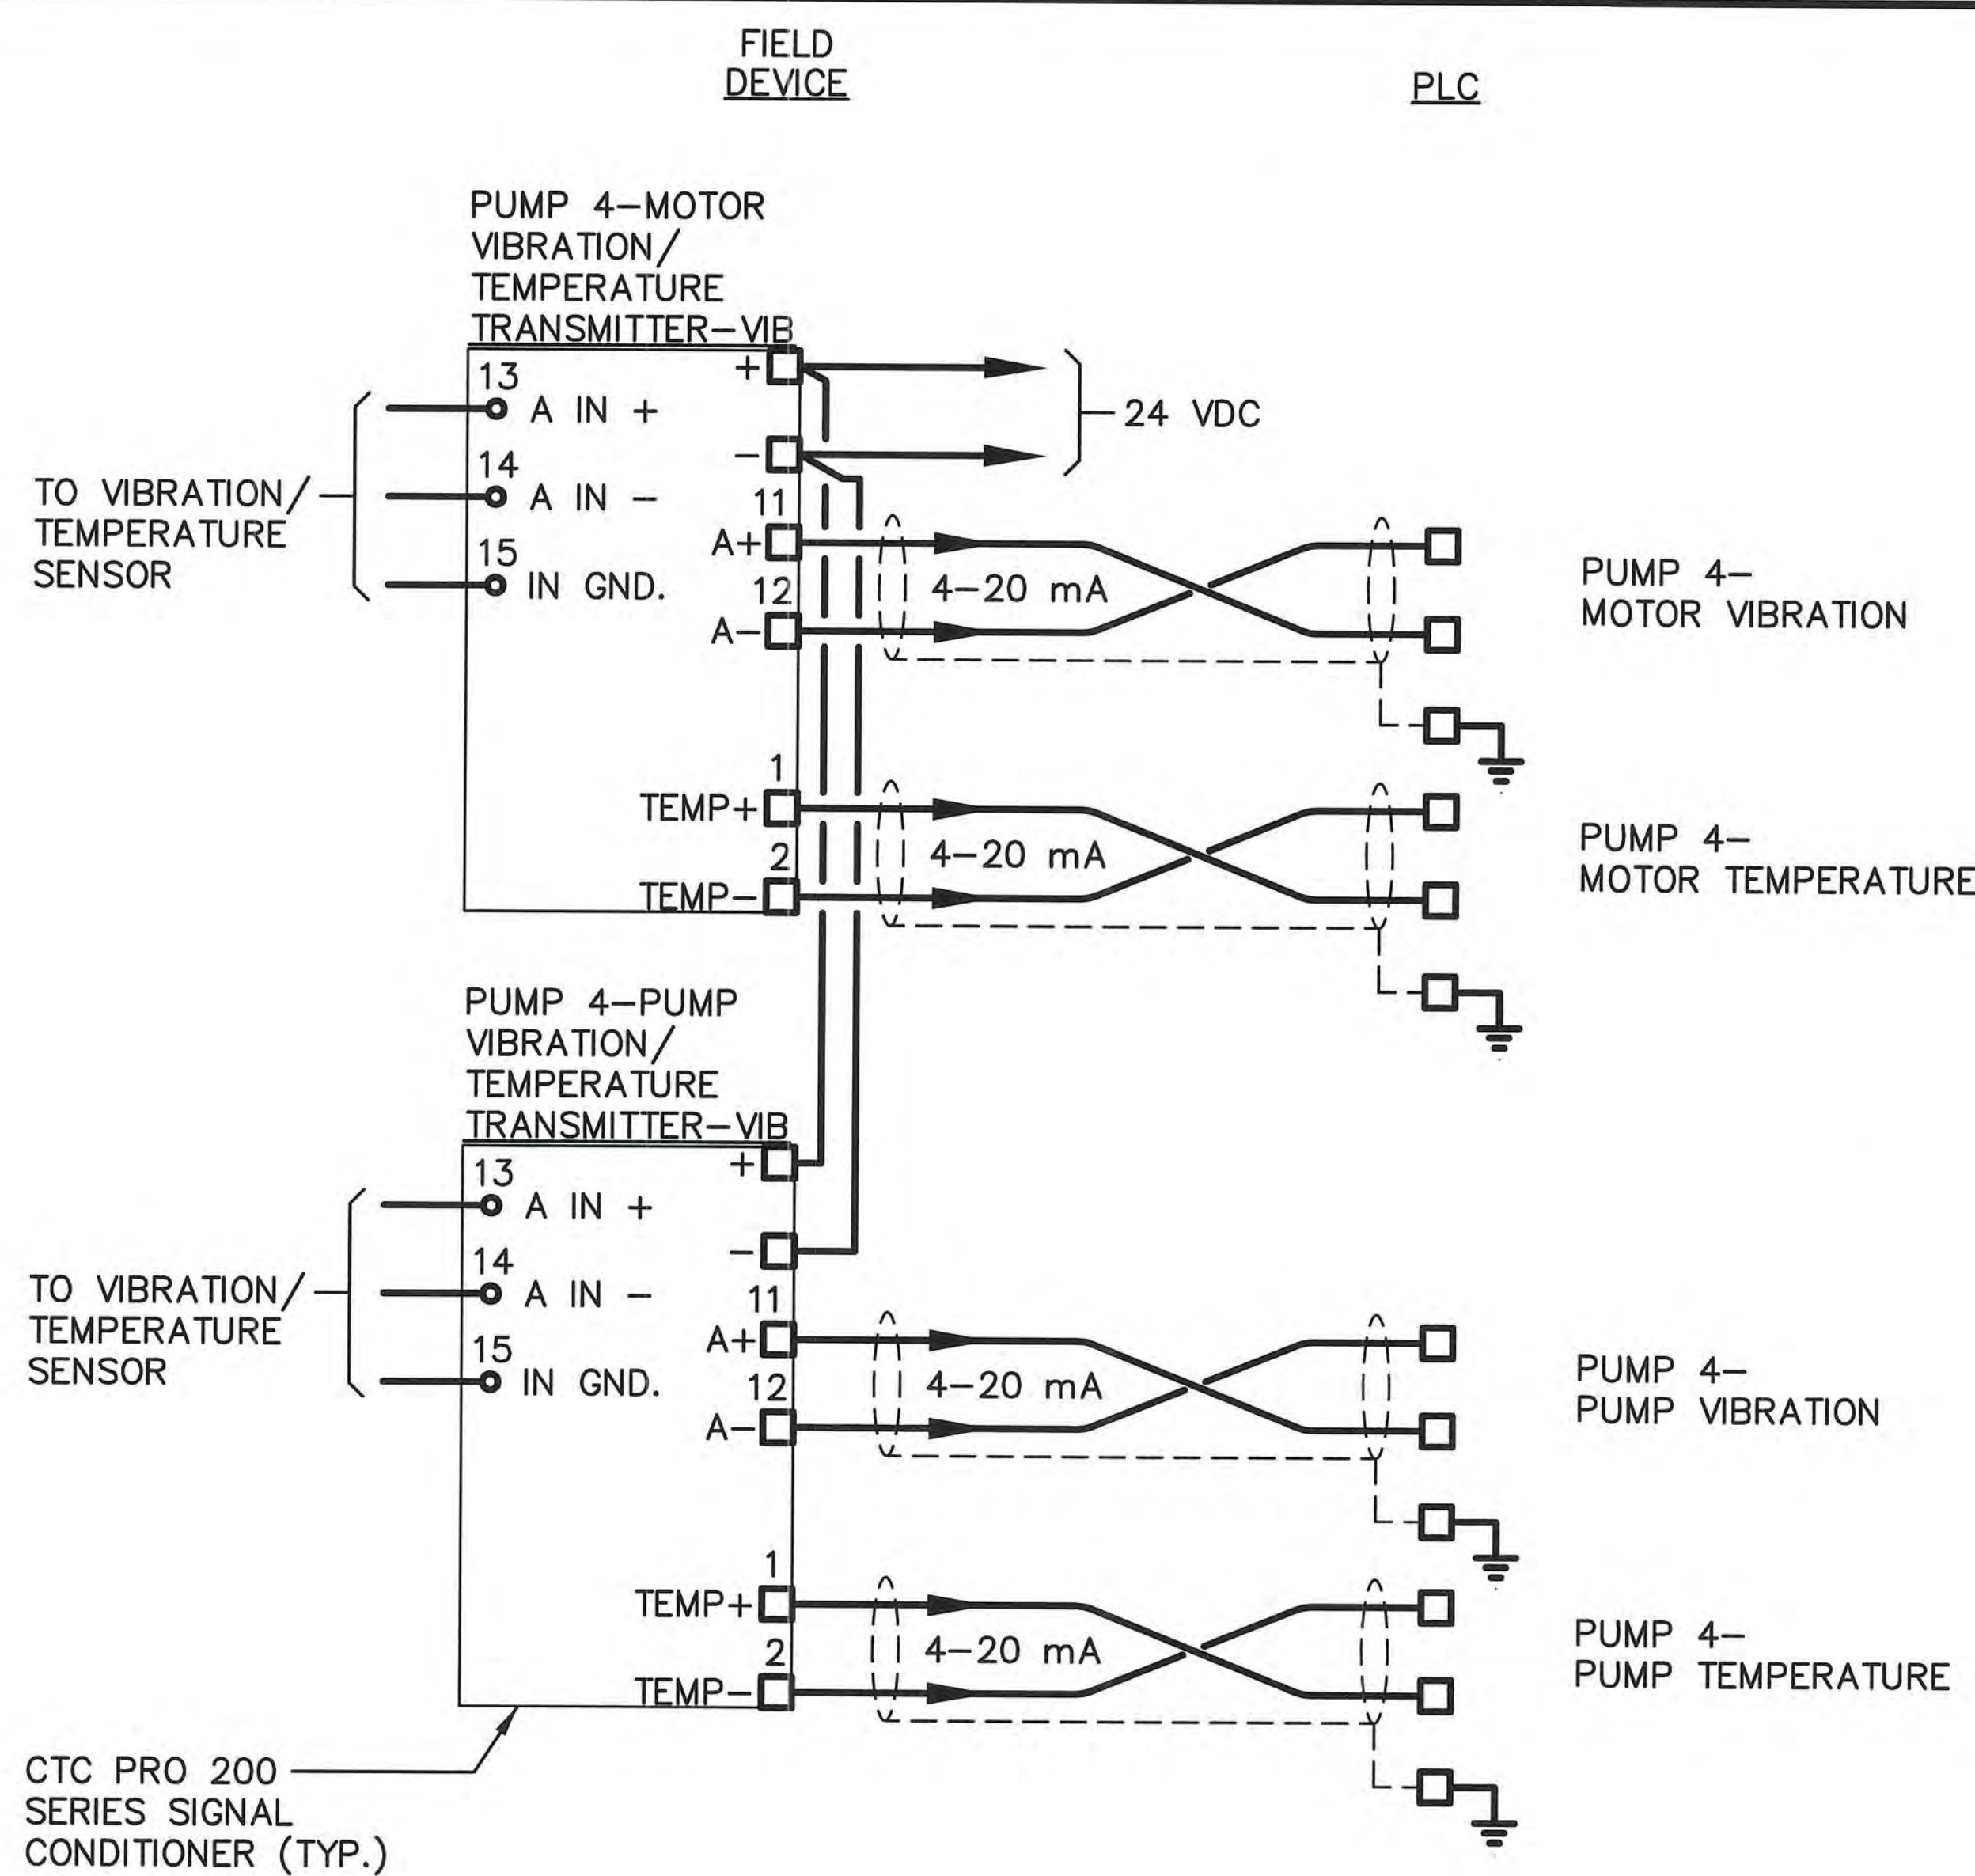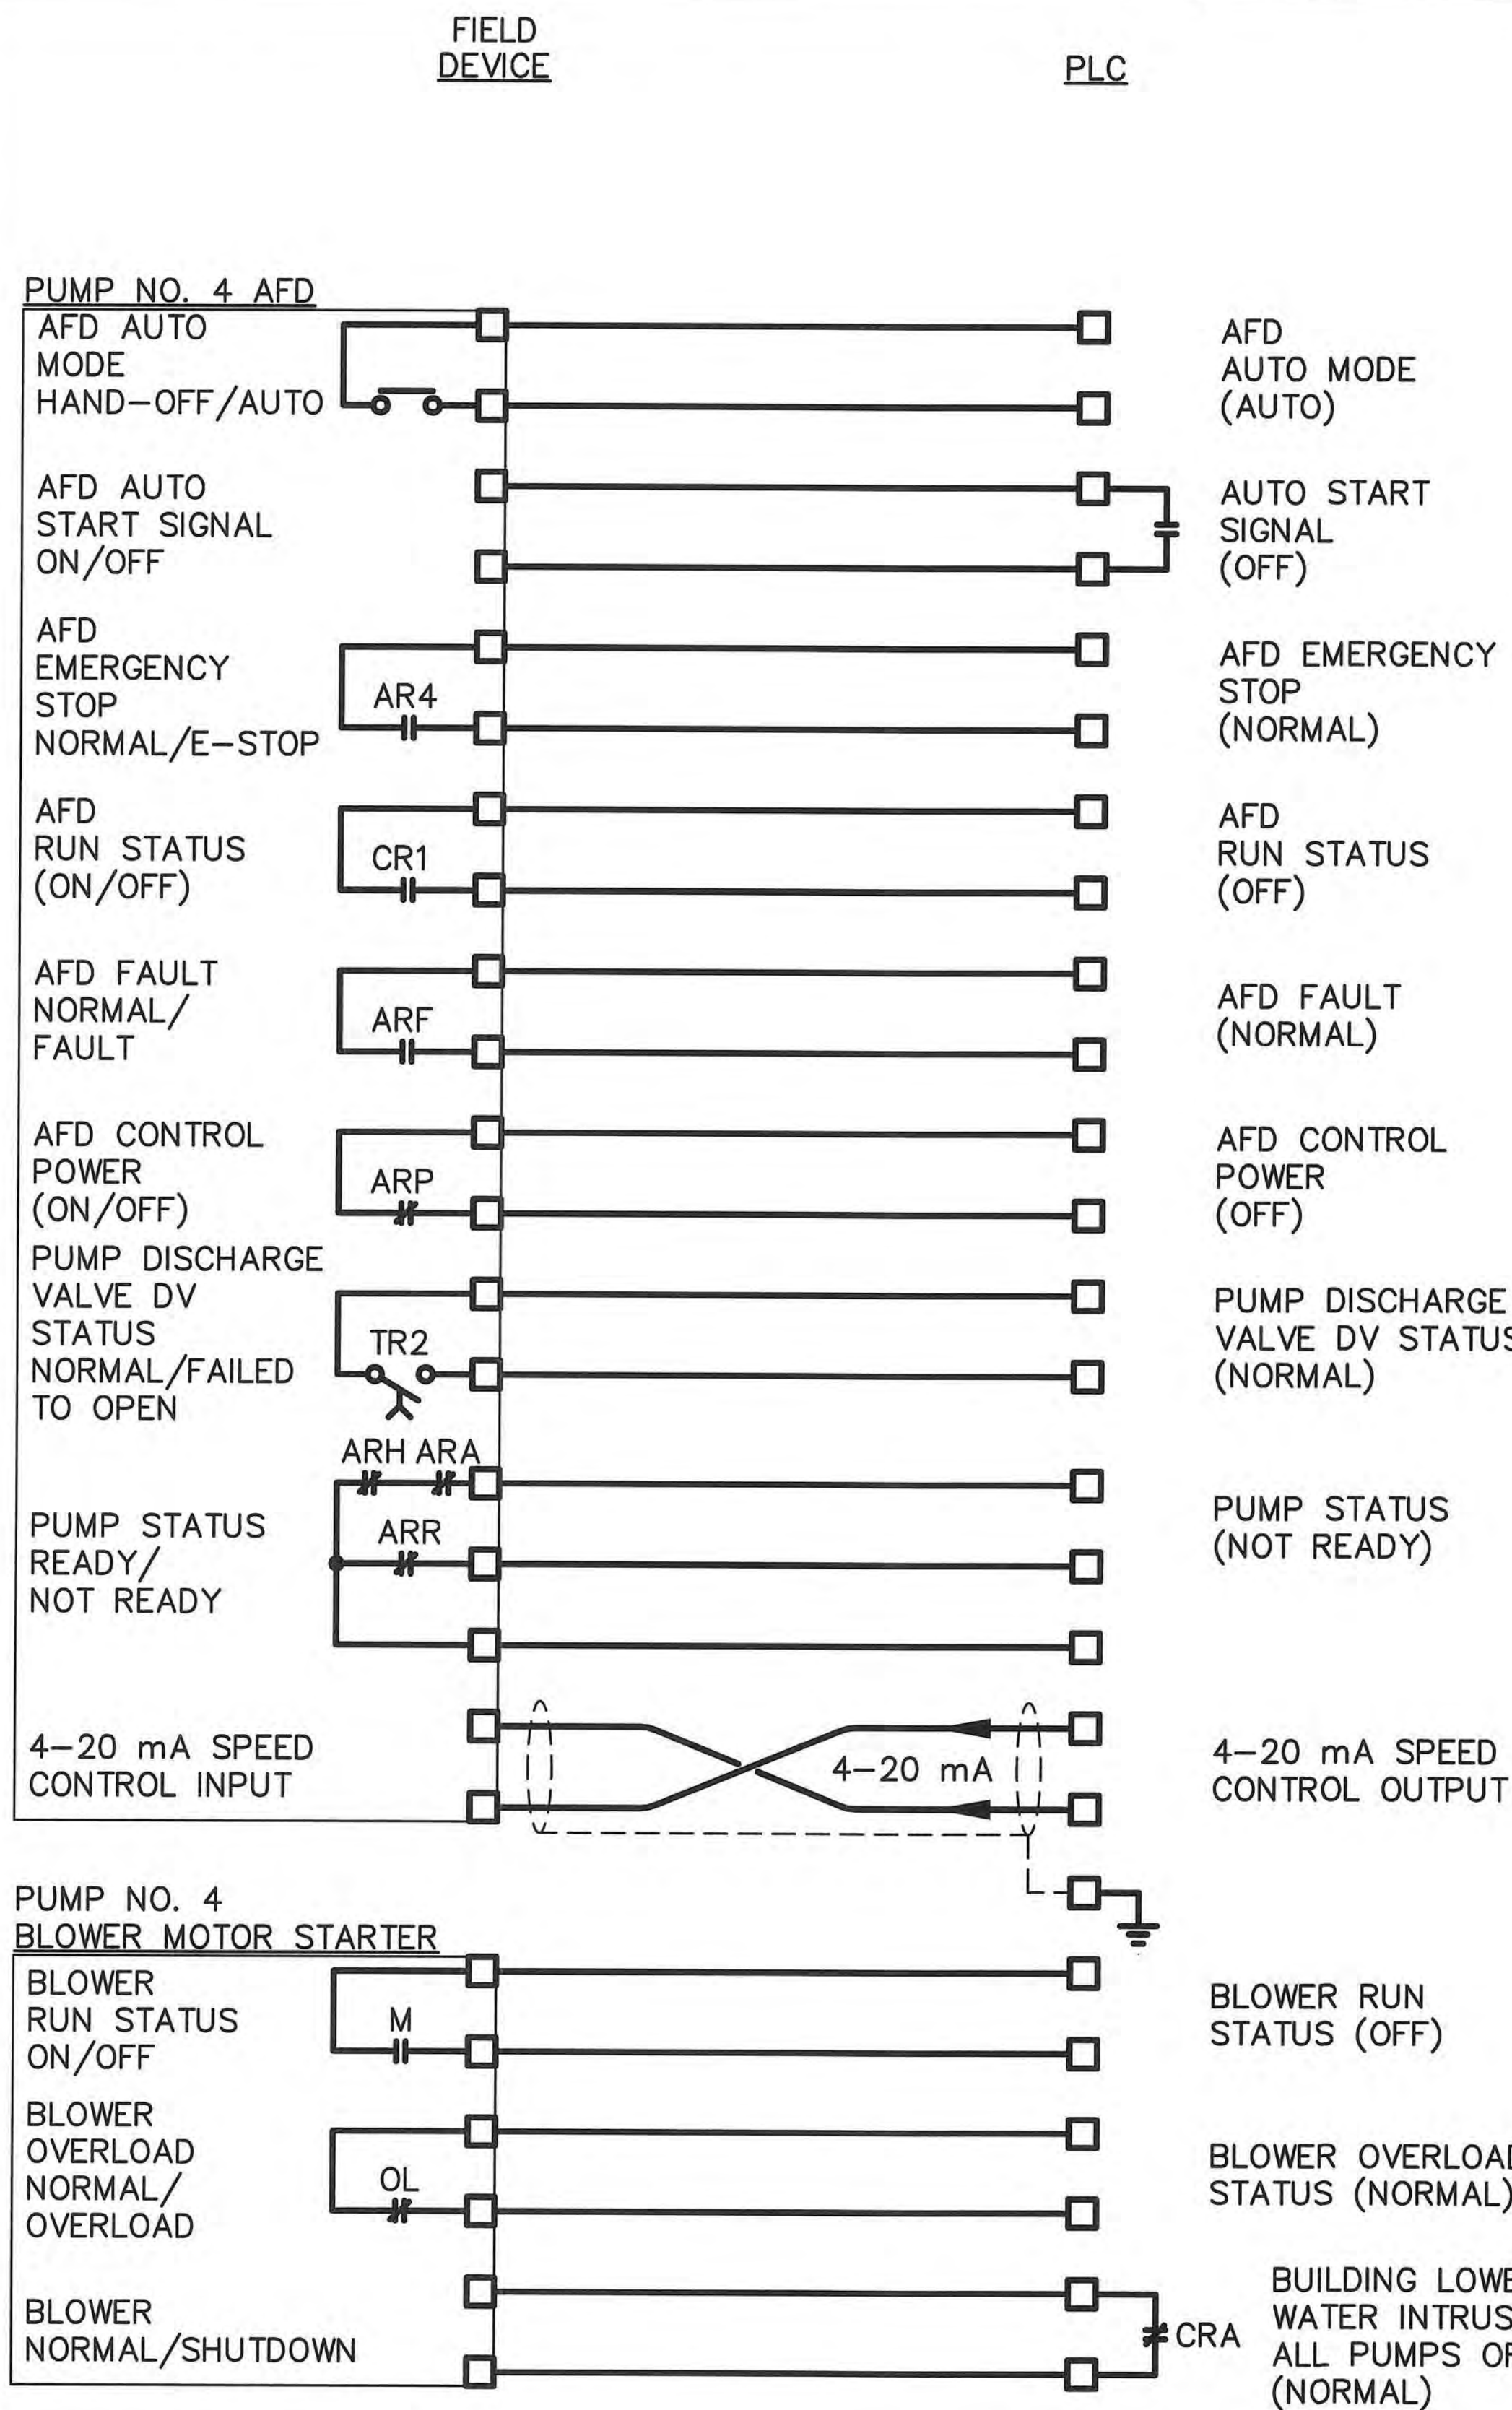

NOTES:

- CONTACTS ARE SHOWN IN DE-ENERGIZED STATE.
- THE STATUS FOR FIELD CONTACT POSITIONS ARE DENOTED IN PARENTHESIS.
- THE SHIELD & DRAIN WIRES FOR ANALOG CABLES SHALL BE GROUNDED AT THE PLC ONLY. THE SHIELD & DRAIN WIRE AT THE END DEVICE SHALL BE NEATLY TRIMMED & TAPED w/ 2 LAYERS OF VINYL ELECTRICAL TAPE (SCOTCH 33+).
- A TIME DELAY OF 20 SECONDS SHALL BE PROVIDED BEFORE THE STARTING OF ANY MOTOR AFTER A LOSS OF UTILITY POWER.

ENGINEER OF RECORD:
BOB E. HALLMAN, P.E.
FLORIDA REGISTRATION NO. 20761

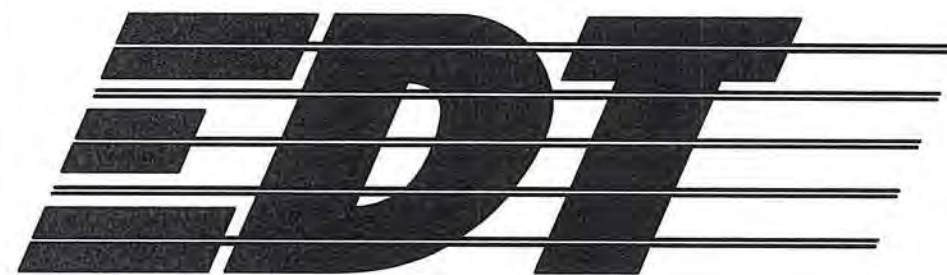



Engineering Design Technologies Corp.
P.O. Box 152403
Tampa, FL 33684-2403
813.289.8080
813.282.9184 FAX
engineering@edt1.com

CITY of TAMPA
WASTEWATER DEPARTMENT

KRAUSE PS REHABILITATION
PLC INTERCONNECTION DIAGRAM
(SHEET 4 OF 6)

NO.	DATE	REVISIONS

DRAWN: RWB
DESIGN: STK
QC: BEH
DATE: 05/01/14

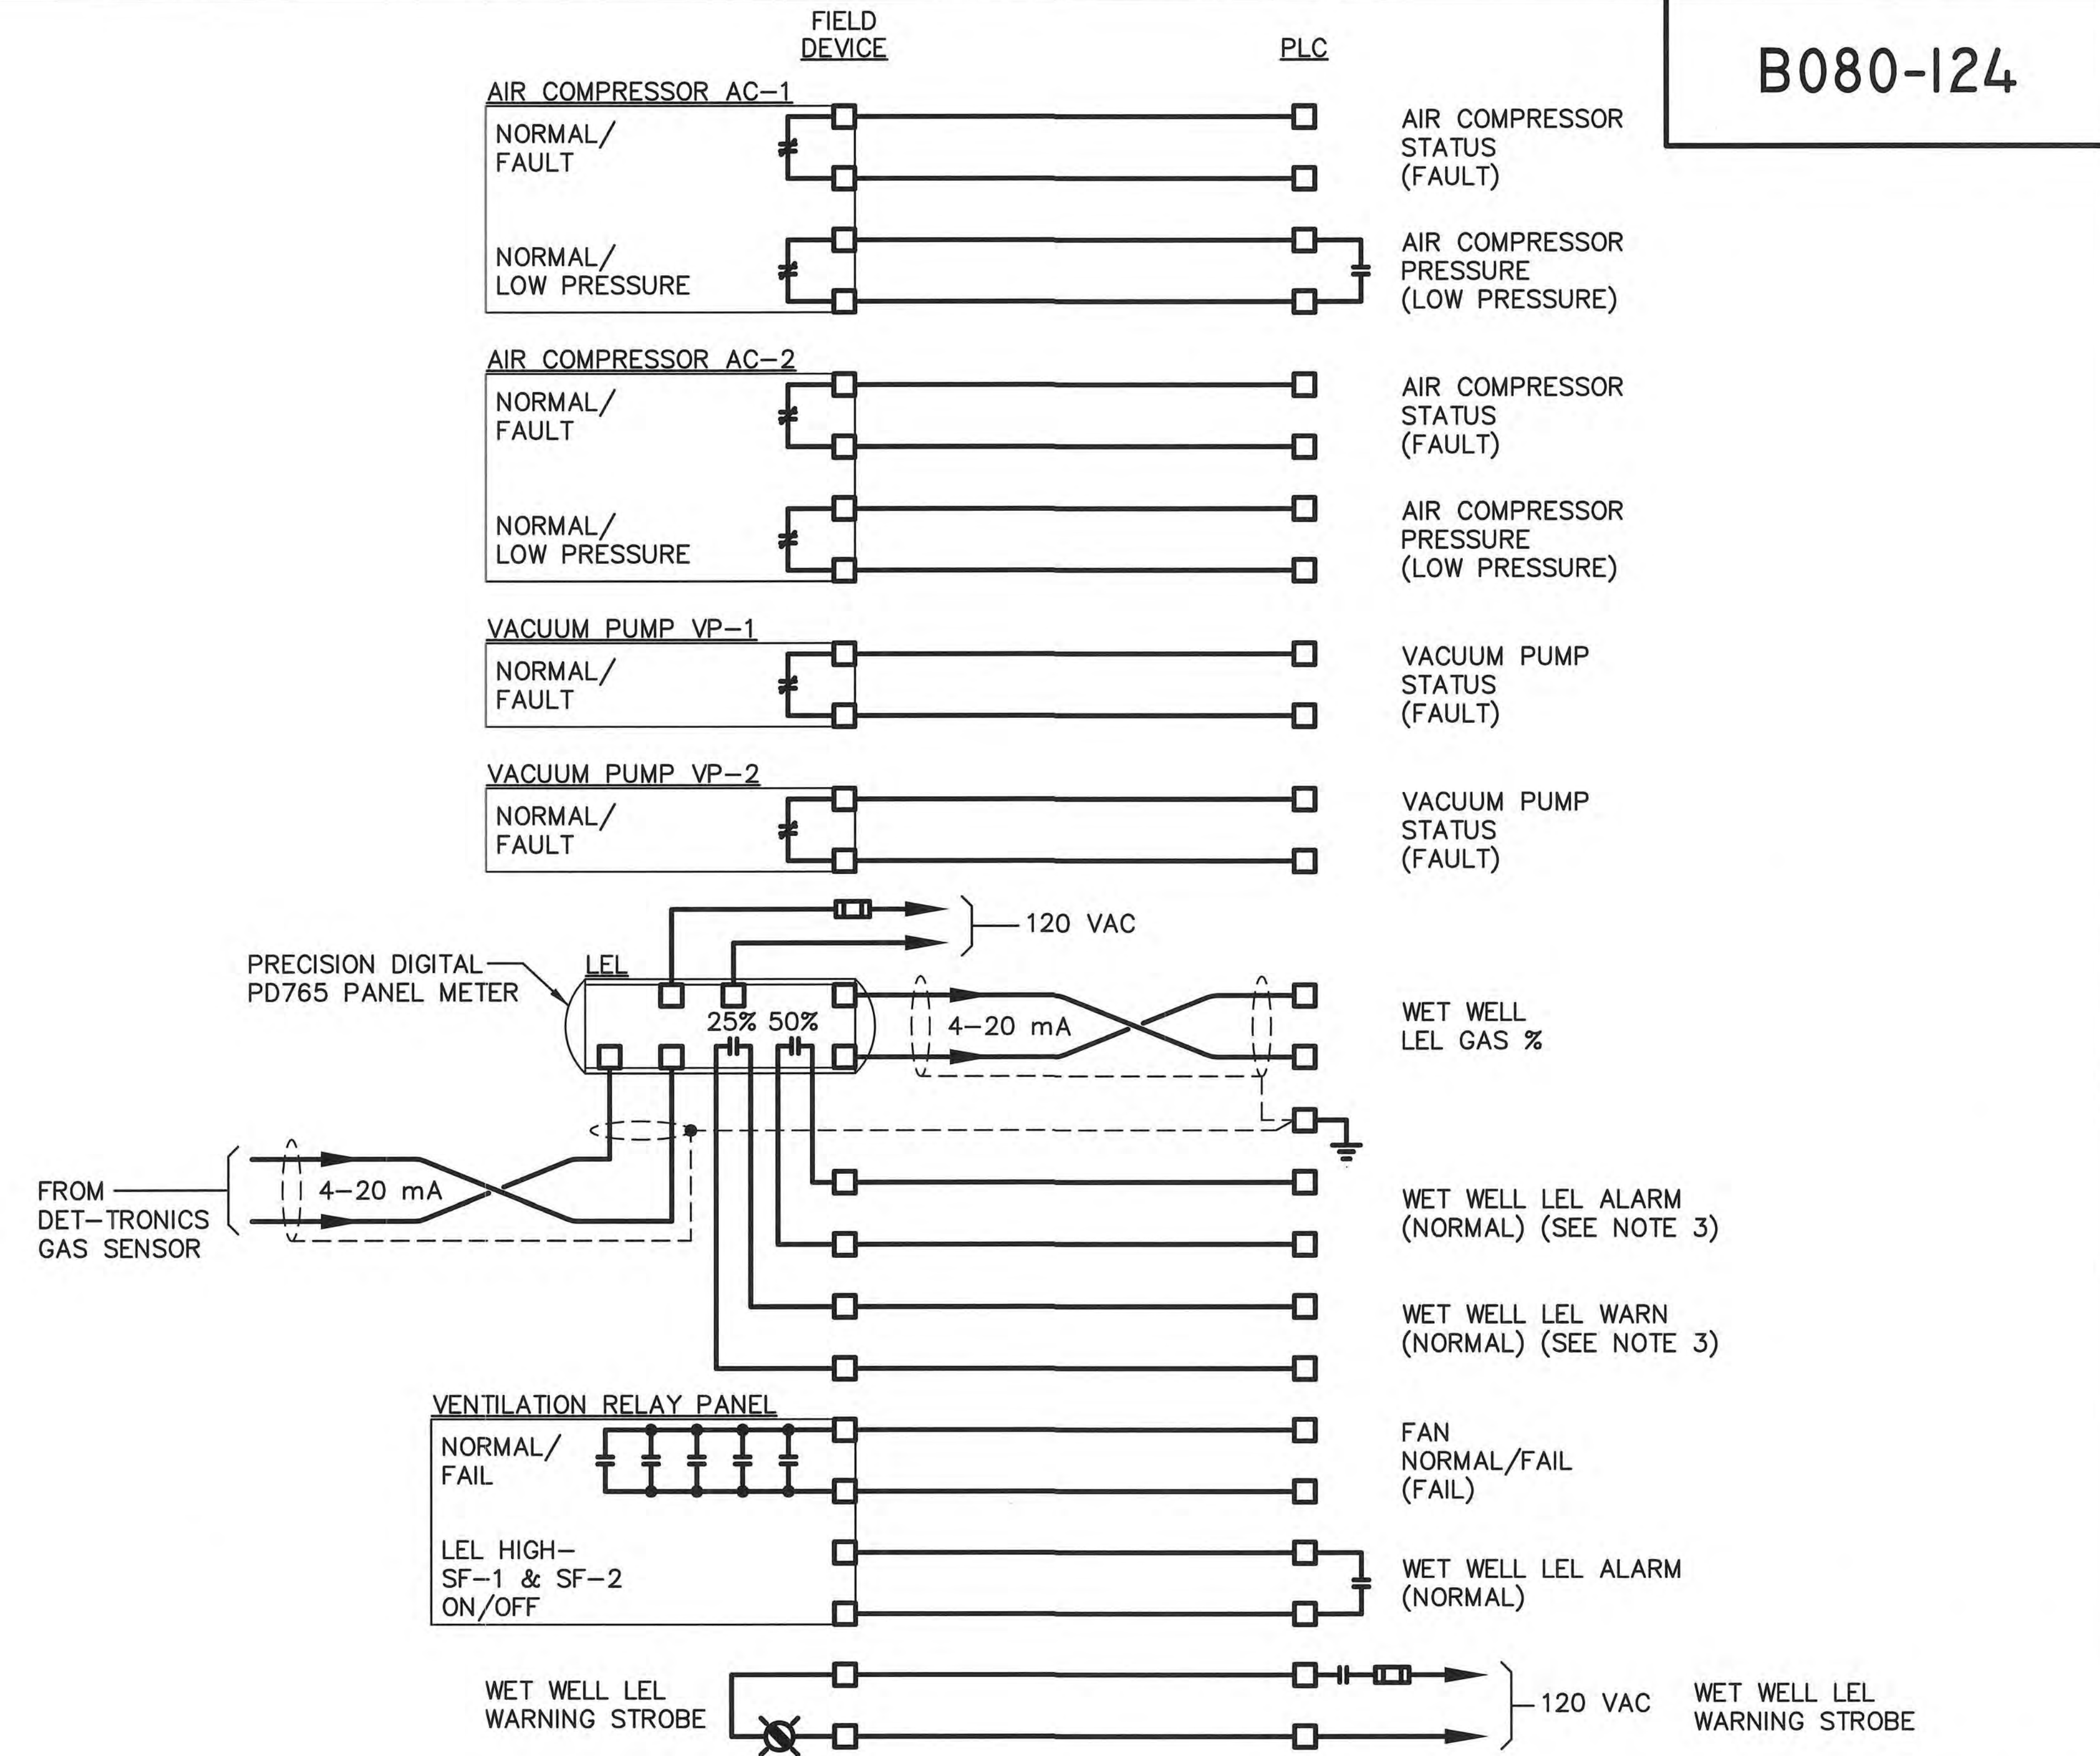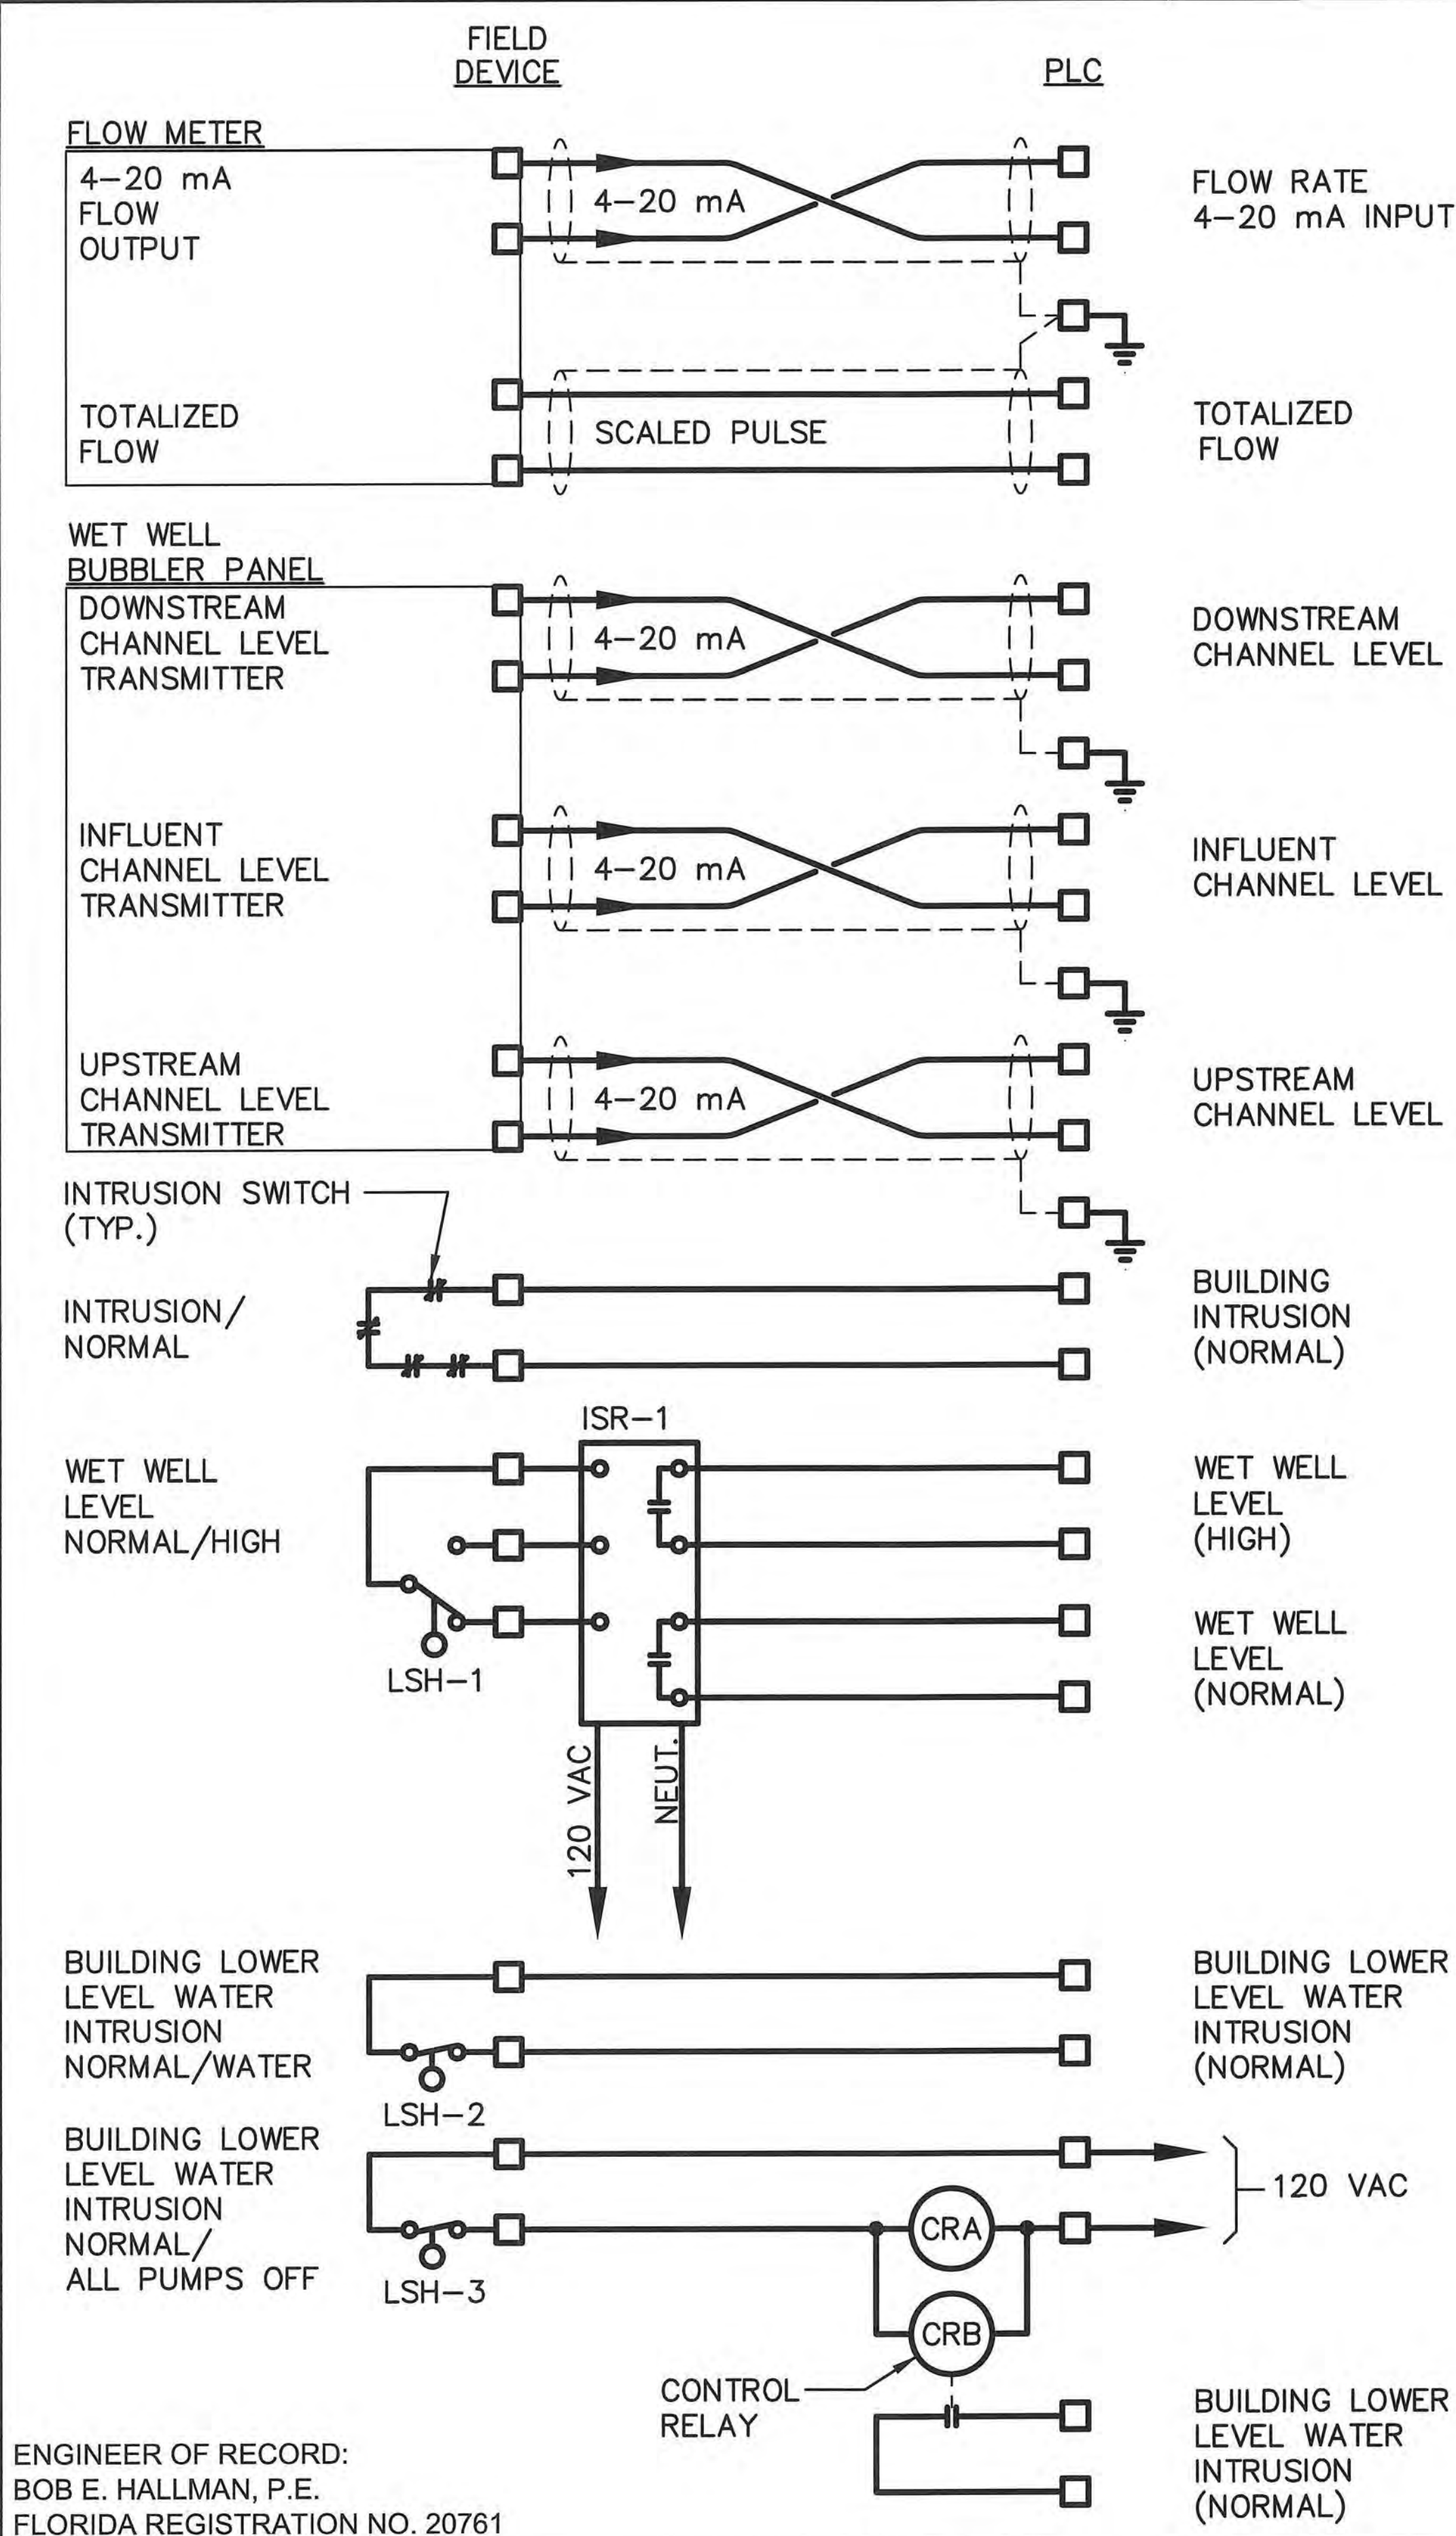

- NOTES:
- CONTACTS ARE SHOWN IN DE-ENERGIZED STATE.
 - THE STATUS FOR FIELD CONTACT POSITIONS ARE DENOTED IN PARENTHESIS.
 - LEL WARN SHALL BE SET AT 25% OR GREATER LEL. LEL ALARM SHALL BE SET AT 50% OR GREATER LEL.
 - THE SHIELD & DRAIN WIRES FOR ANALOG CABLES SHALL BE GROUNDED AT THE PLC ONLY. THE SHIELD & DRAIN WIRE AT THE END DEVICE SHALL BE NEATLY TRIMMED & TAPED w/ 2 LAYERS OF VINYL ELECTRICAL TAPE (SCOTCH 33+).
 - A TIME DELAY OF 20 SECONDS SHALL BE PROVIDED BEFORE THE STARTING OF ANY MOTOR AFTER A LOSS OF UTILITY POWER.

ENGINEER OF RECORD:
BOB E. HALLMAN, P.E.
FLORIDA REGISTRATION NO. 20761





Engineering Design
Technologies Corp.
P.O. Box 152403
Tampa, FL 33684-2403
813.289.8080
813.282.9184 FAX
engineering@edt1.com

CITY of TAMPA
WASTEWATER DEPARTMENT

KRAUSE PS REHABILITATION
PLC INTERCONNECTION DIAGRAM
(SHEET 5 OF 6)

NO.	DATE	REVISIONS

DRAWN: RWB
DESIGN: STK
QC: BEH
DATE: 05/01/14
SHEET I-7

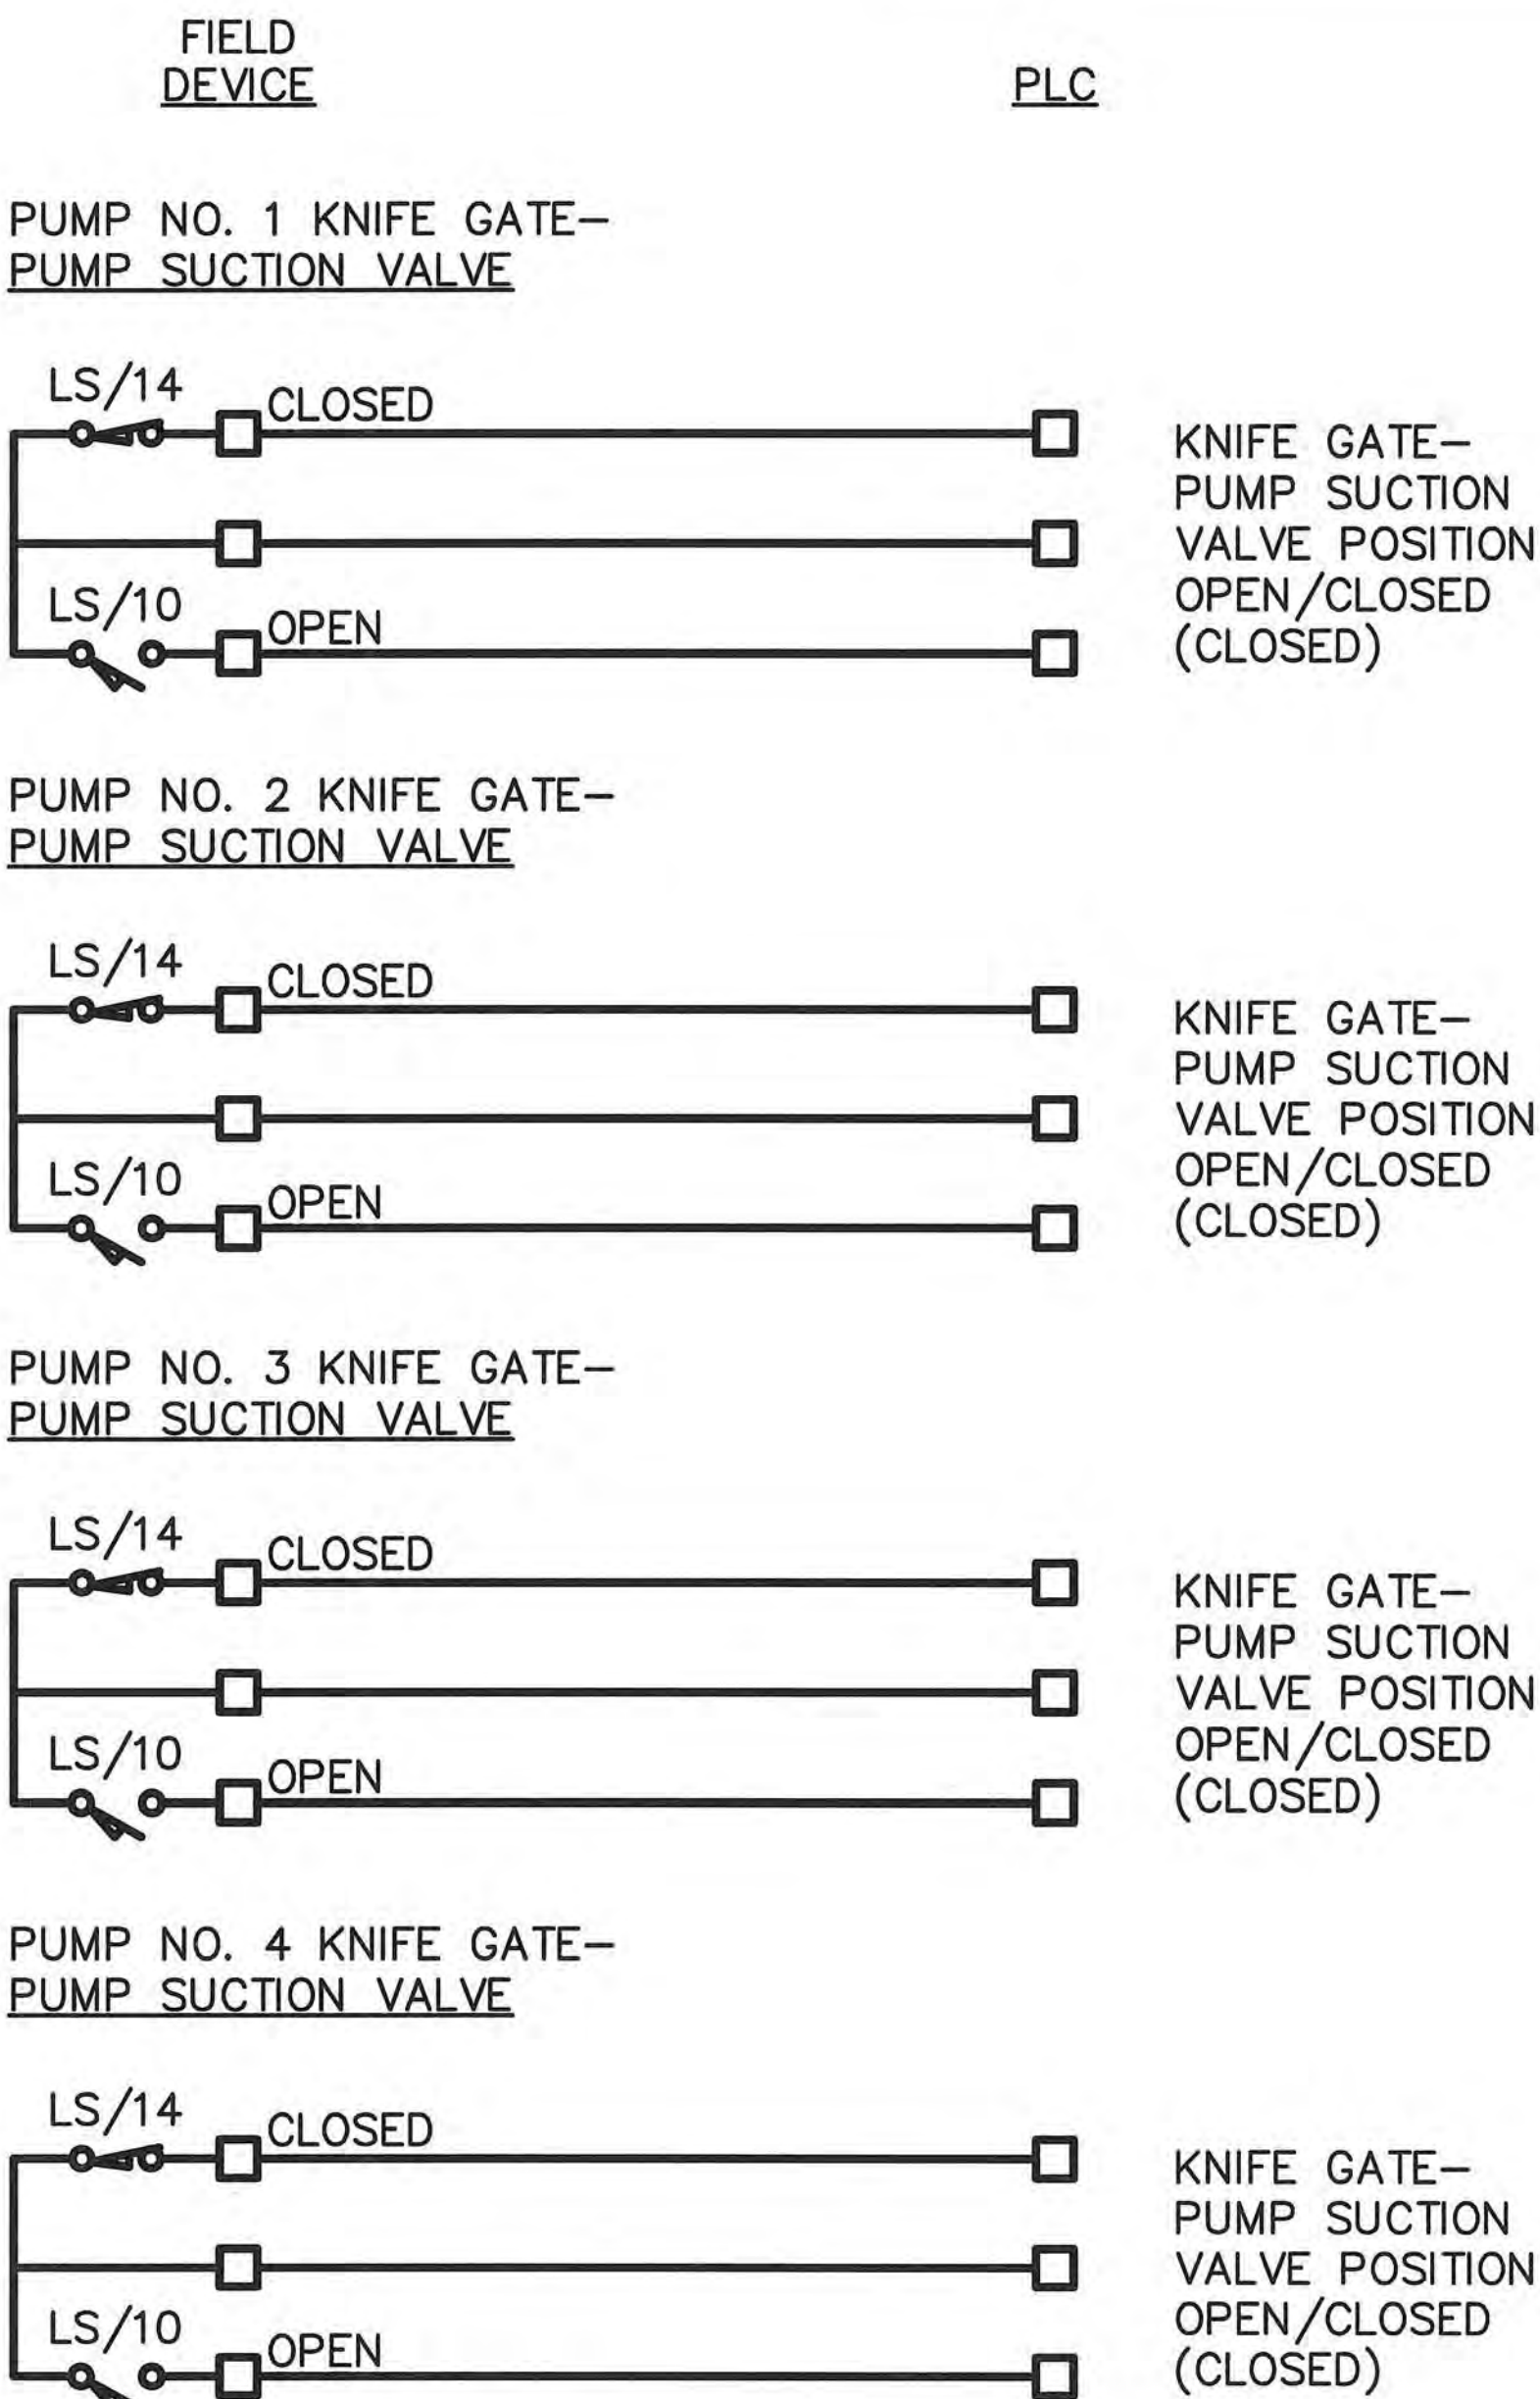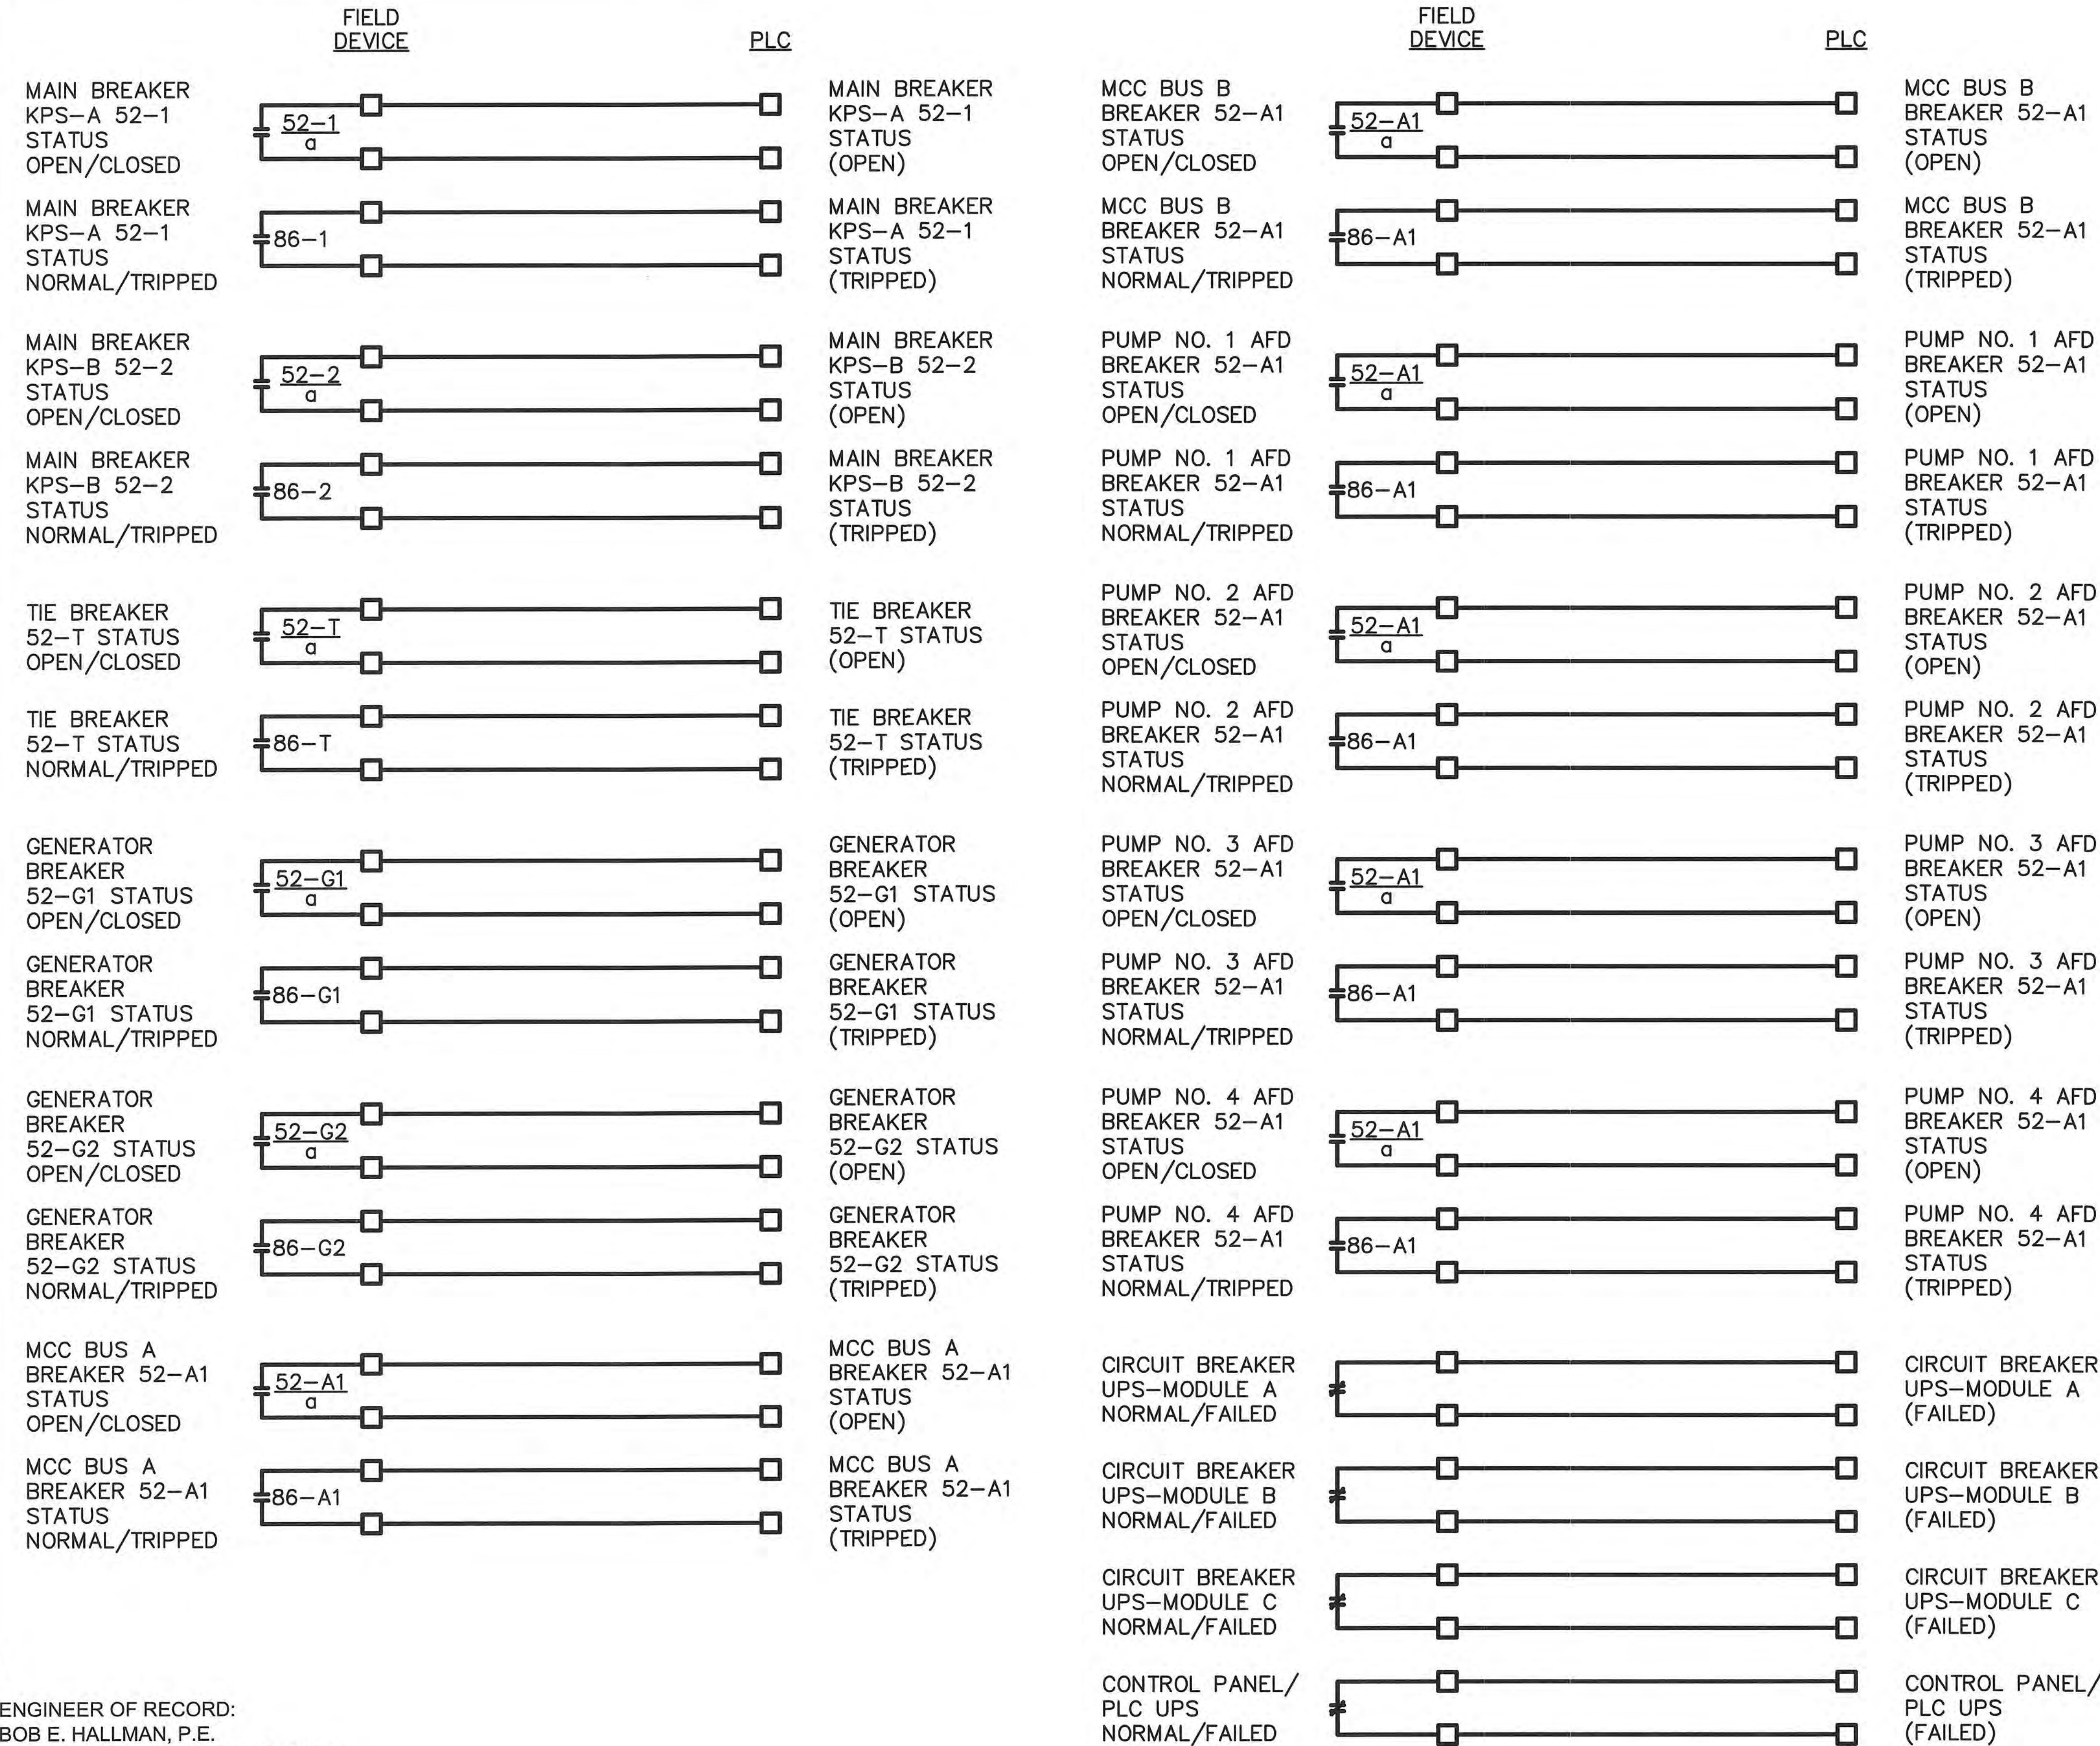

- NOTES:
- CONTACTS ARE SHOWN IN DE-ENERGIZED STATE.
 - THE STATUS FOR FIELD CONTACT POSITIONS ARE DENOTED IN PARENTHESIS.
 - THE SHIELD & DRAIN WIRES FOR ANALOG CABLES SHALL BE GROUNDED AT THE PLC ONLY. THE SHIELD & DRAIN WIRE AT THE END DEVICE SHALL BE NEATLY TRIMMED & TAPED w/ 2 LAYERS OF VINYL ELECTRICAL TAPE (SCOTCH 33+).
 - A TIME DELAY OF 20 SECONDS SHALL BE PROVIDED BEFORE THE STARTING OF ANY MOTOR AFTER A LOSS OF UTILITY POWER.

ENGINEER OF RECORD:
BOB E. HALLMAN, P.E.
FLORIDA REGISTRATION NO. 20761




Engineering Design
Technologies Corp.
P.O. Box 152403
Tampa, FL 33684-2403
813.289.8080
813.282.9184 FAX
engineering@edt1.com

CITY of TAMPA
WASTEWATER DEPARTMENT


KRAUSE PS REHABILITATION
PLC INTERCONNECTION DIAGRAM
(SHEET 6 OF 6)

NO.	DATE	REVISIONS			

DRAWN: RWB
DESIGN: STK
QC: BEH
DATE: 05/01/14

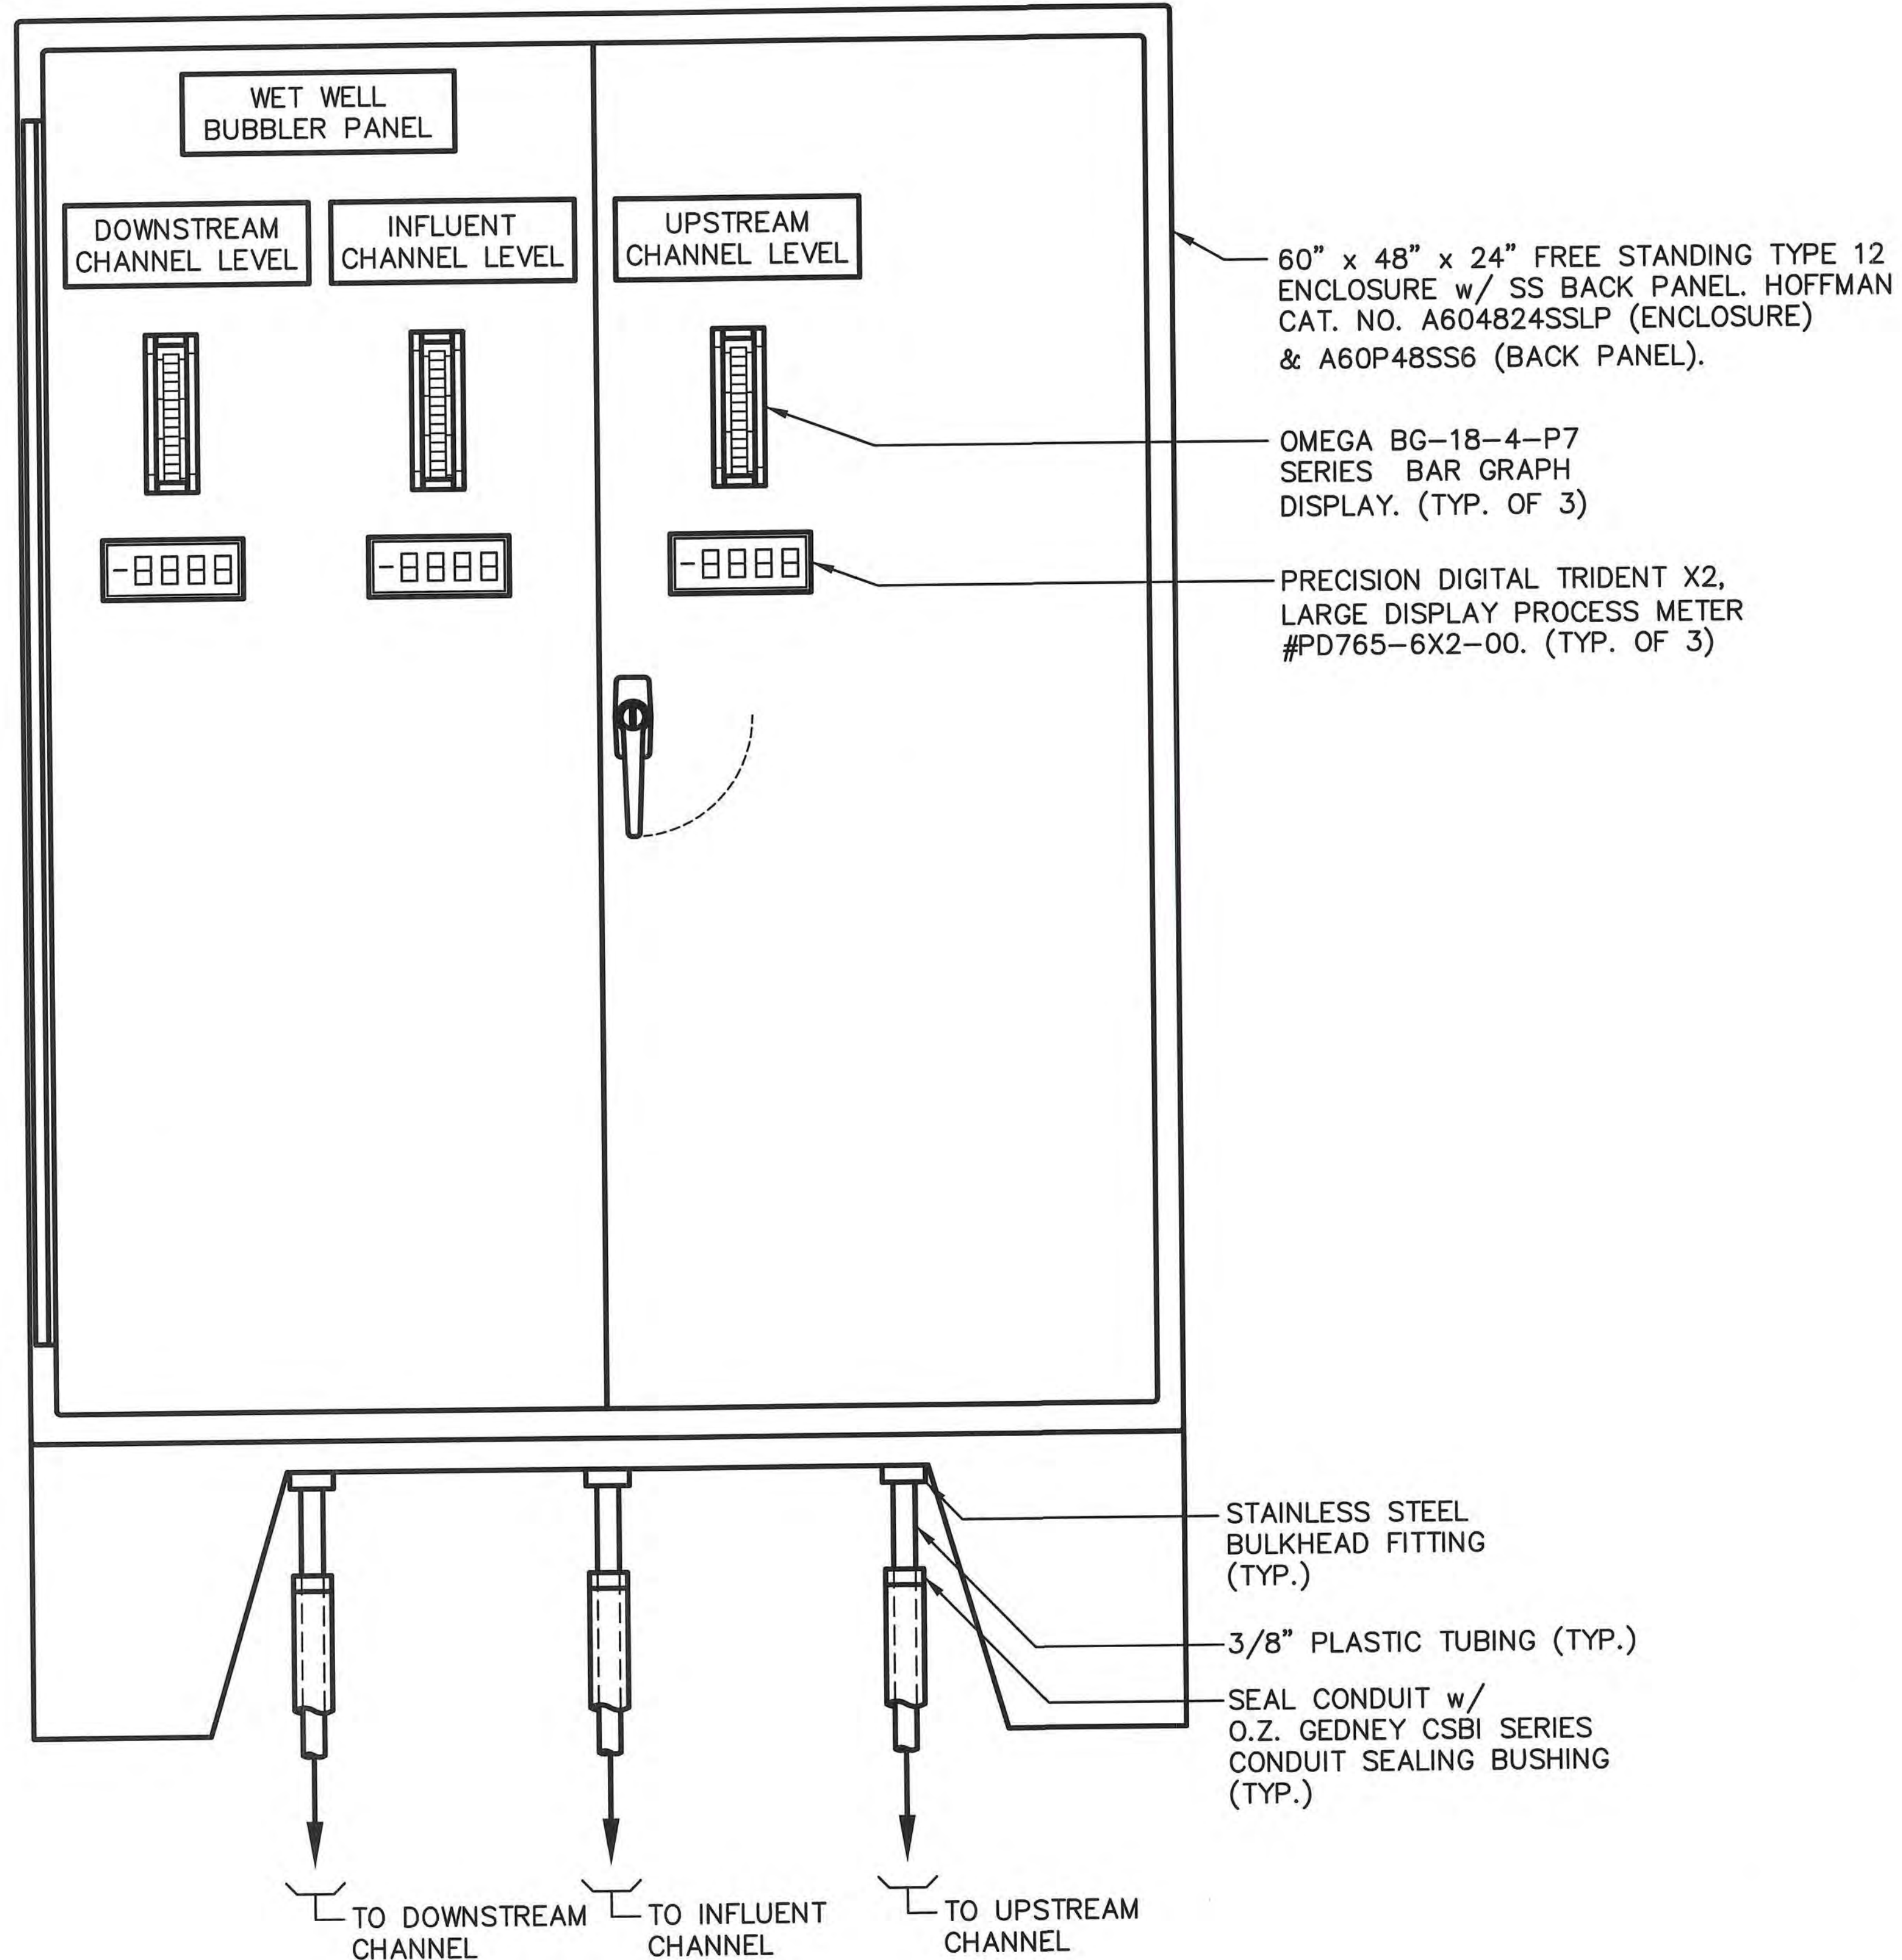

BUBBLER PANEL
NOT TO SCALE

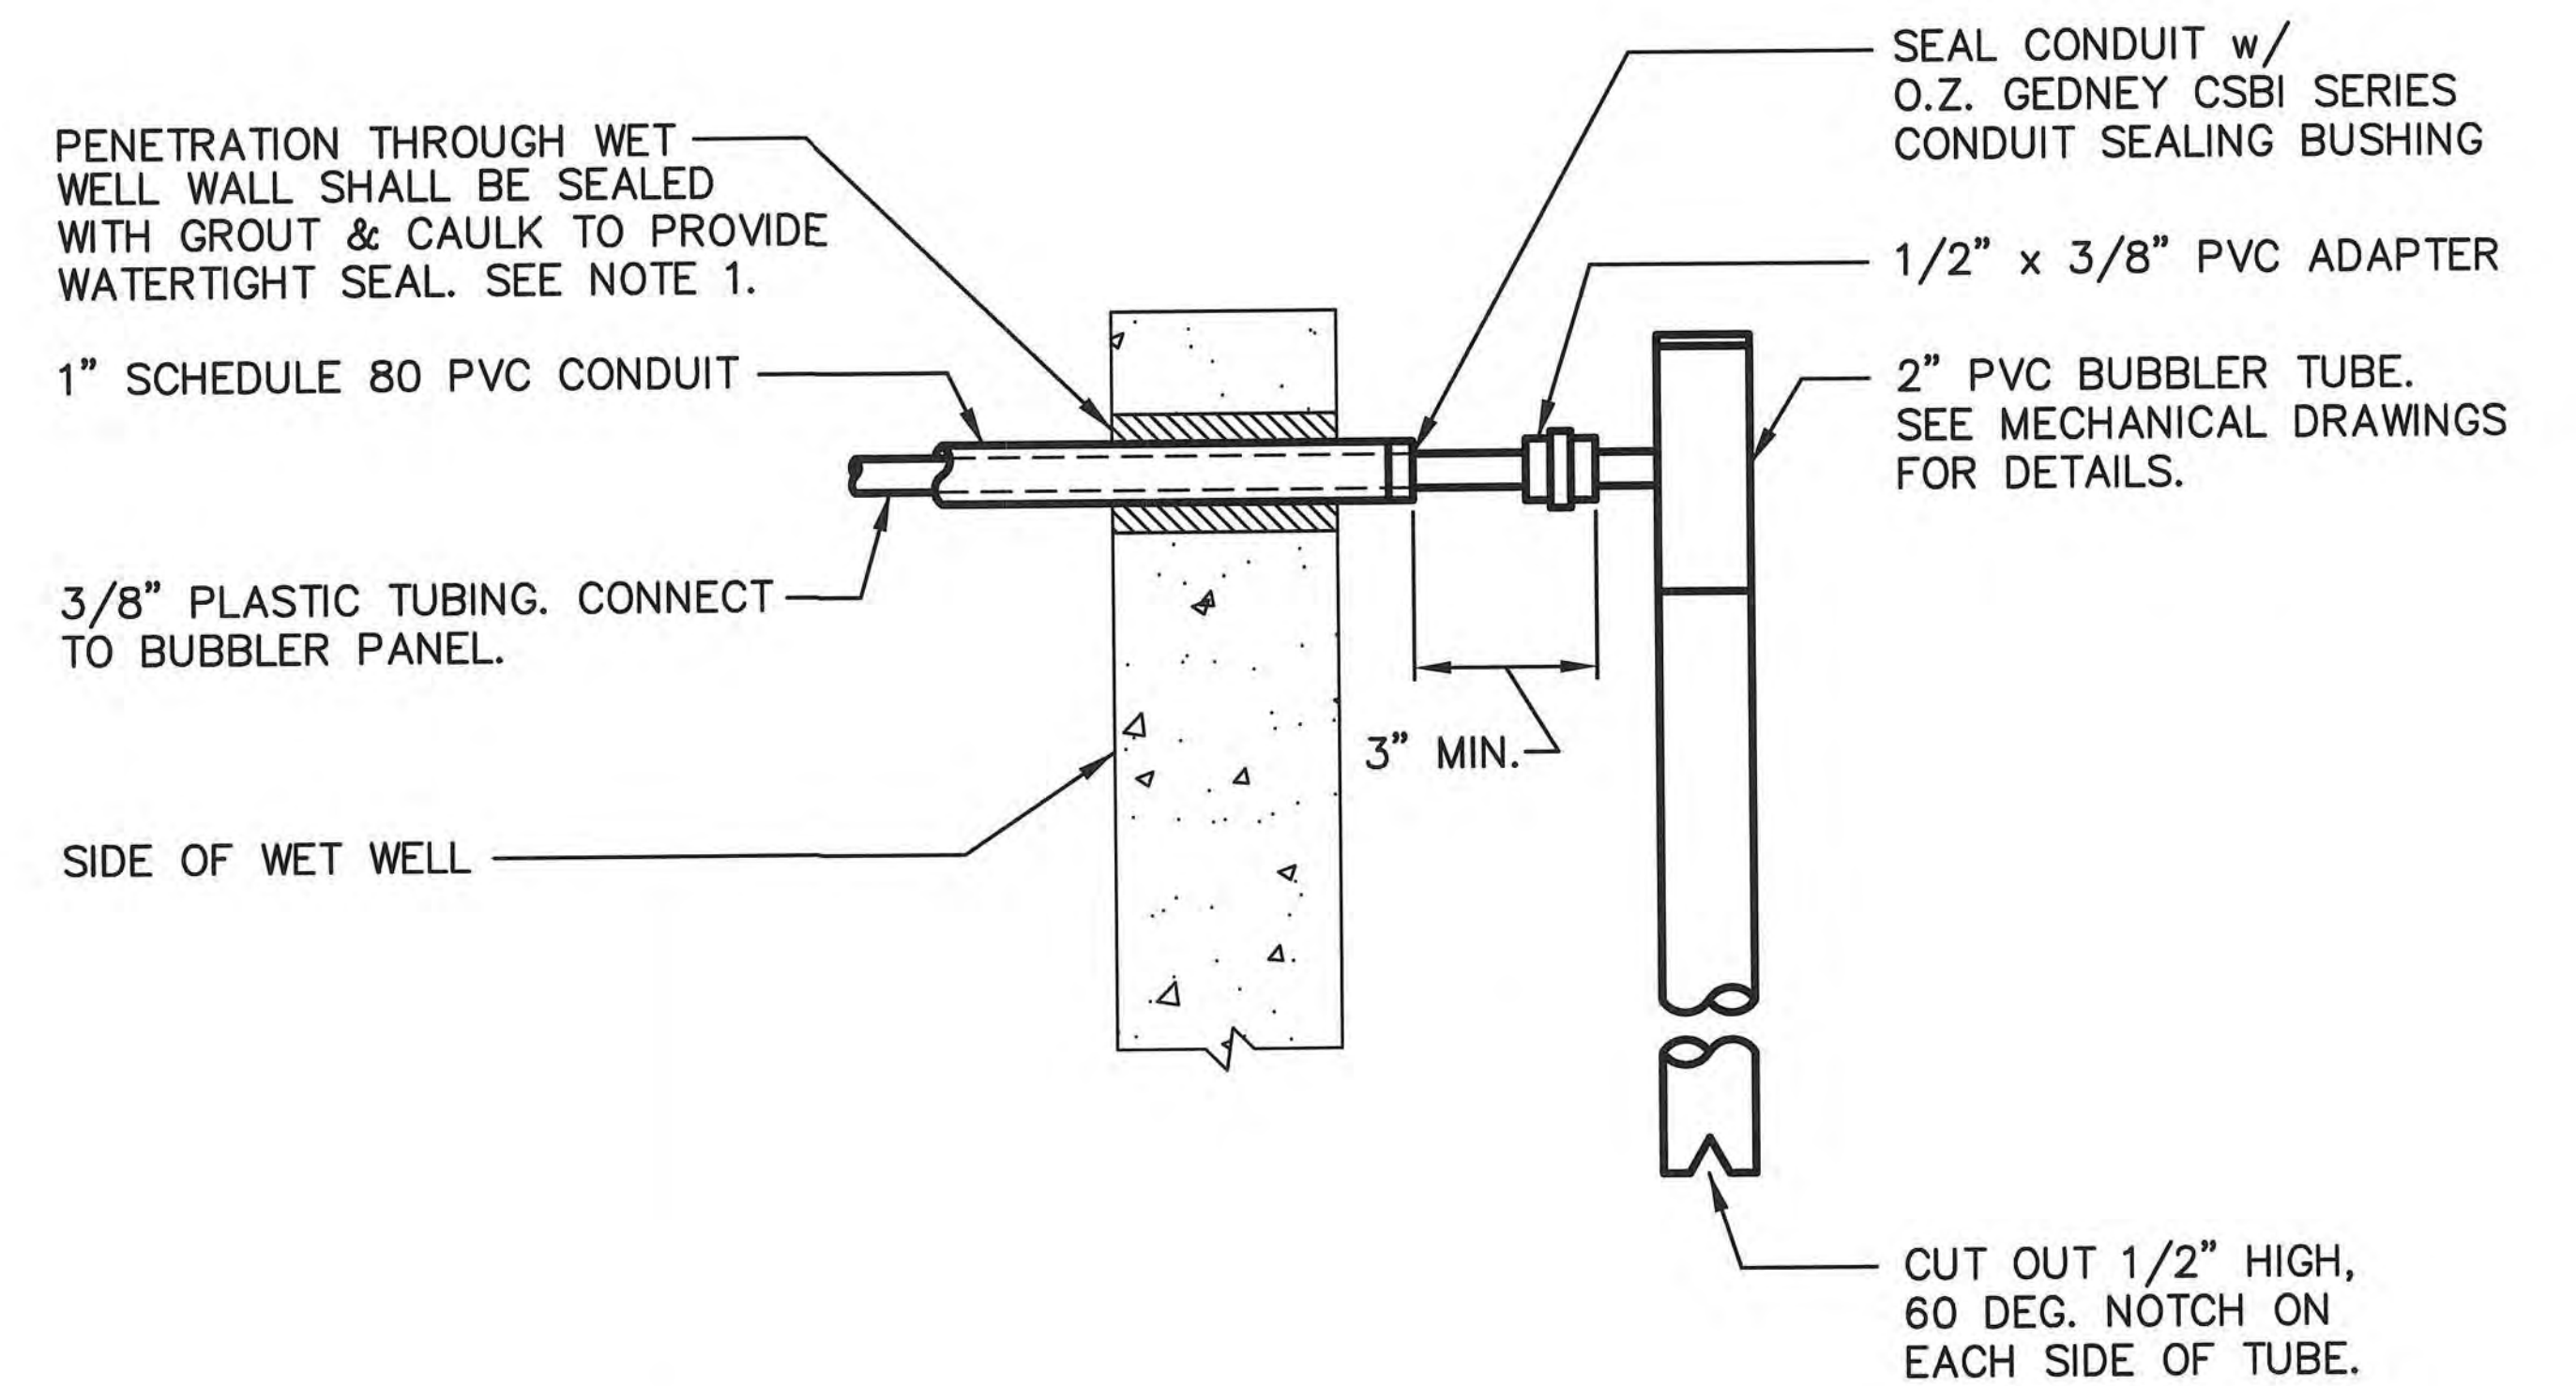


BUBBLER TUBE CONNECTION DETAIL
(TYP.)

NOTES:

1. AFTER CORE DRILLING HOLES THROUGH REINFORCED CONCRETE WALLS AND FLOORS, COAT EXPOSED REINFORCING STEEL CONCRETE SURFACES WITH EMACO P24 BY BASF. AFTER ROUTING CONDUIT THROUGH HOLE, FILL AND FINISH CONCRETE WITH A SHRINKAGE COMPENSATING REPAIR MORTAR WITH CORROSION INHIBITING PROPERTIES, EMACO S66 C1 BY BASF. REFERENCE STRUCTURAL DRAWINGS.

ENGINEER OF RECORD:
BOB E. HALLMAN, P.E.
FLORIDA REGISTRATION NO. 20761

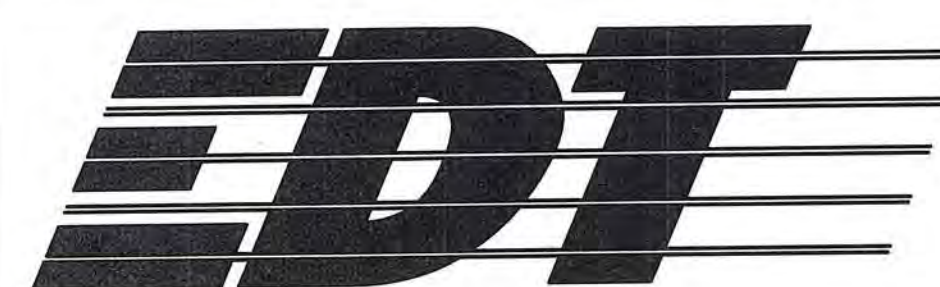

Certificate of Authorization Number: 4795

Engineering Design Technologies Corp.
P.O. Box 152403
Tampa, FL 33684-2403
813.289.8080
813.282.9184 FAX
engineering@edt1.com

CITY of TAMPA
WASTEWATER DEPARTMENT

KRAUSE PS REHABILITATION


BUBBLER PANEL DETAILS
(SHEET 1 OF 2)

NO.	DATE	REVISIONS

DRAWN: RWB
DESIGN: STK
QC: BEH
DATE: 05/01/14

SHEET I-9

B080-127

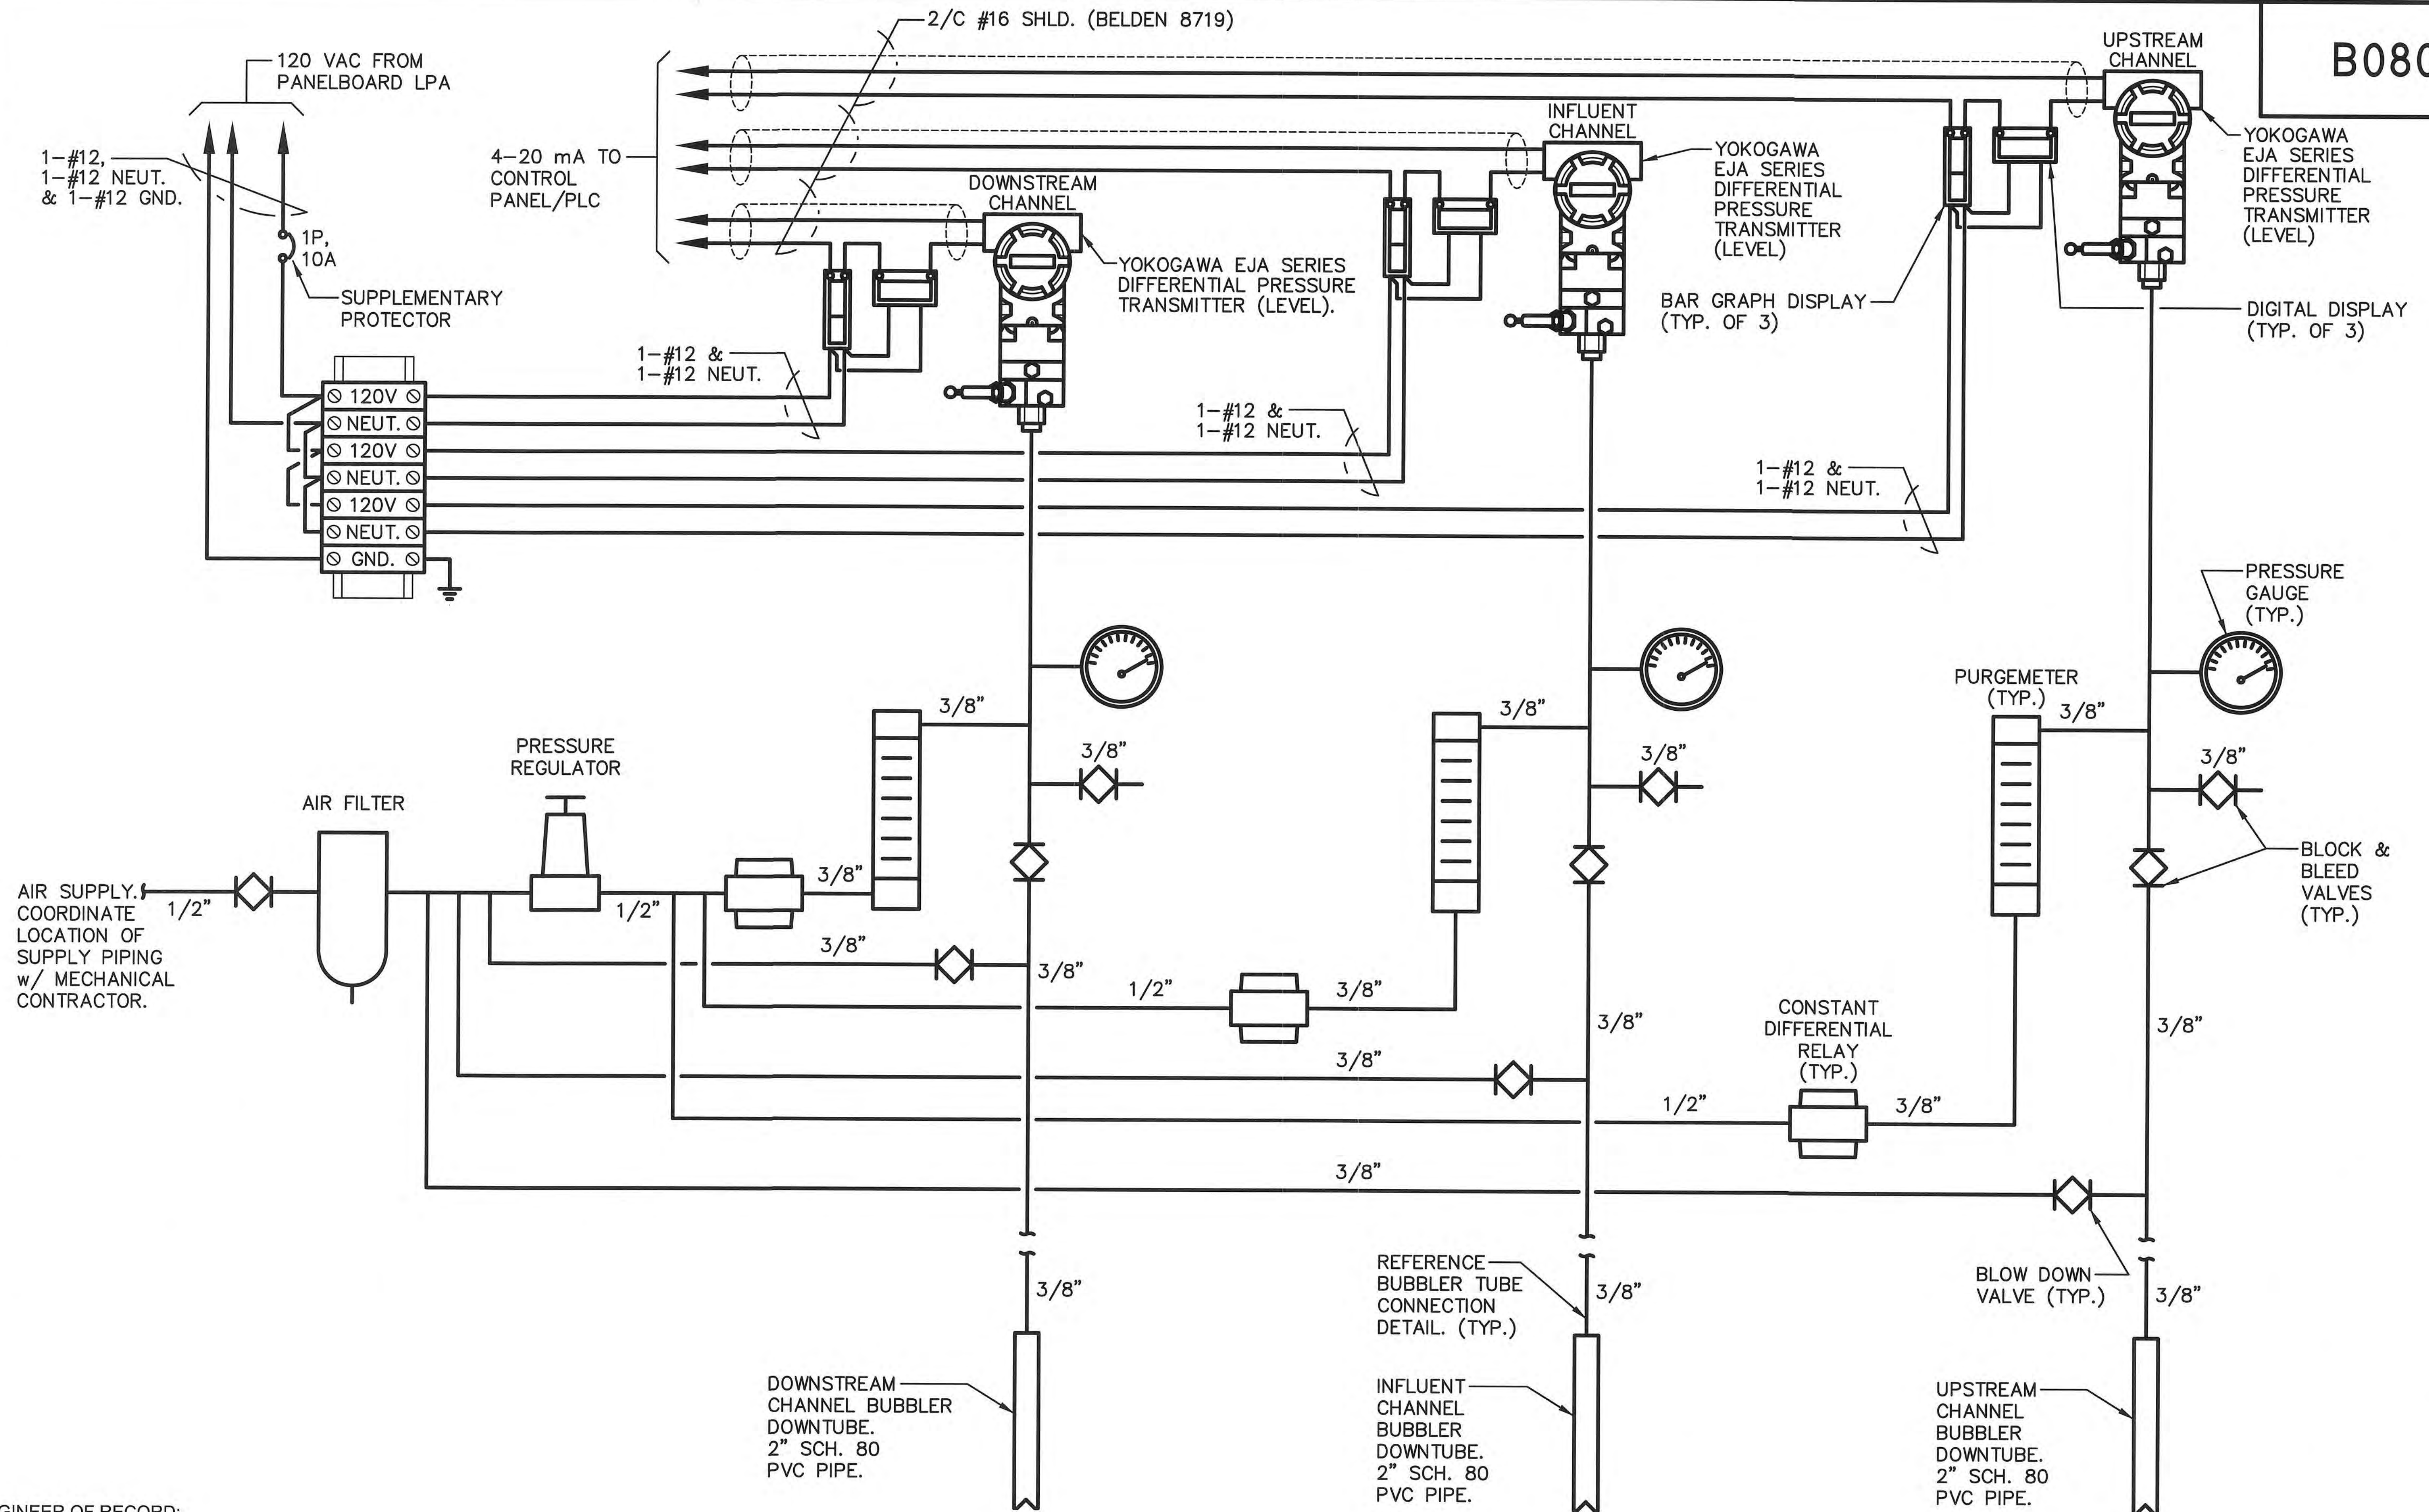

ENGINEER OF RECORD:
BOB E. HALLMAN, P.E.
FLORIDA REGISTRATION NO. 20761



**Engineering Design
Technologies Corp.**
P.O. Box 152403
Tampa, FL 33684-2403
813.289.8080
813.282.9184 FAX
engineering@edt1.com

CITY of TAMPA
WASTEWATER DEPARTMENT


KRAUSE PS REHABILITATION

**BUBBLER PANEL DETAILS
(SHEET 2 OF 2)**

NO.	DATE	REVISIONS

DRAWN: RWB
DESIGN: STK
QC: BEH
DATE: 05/01/14


SHEET I-10

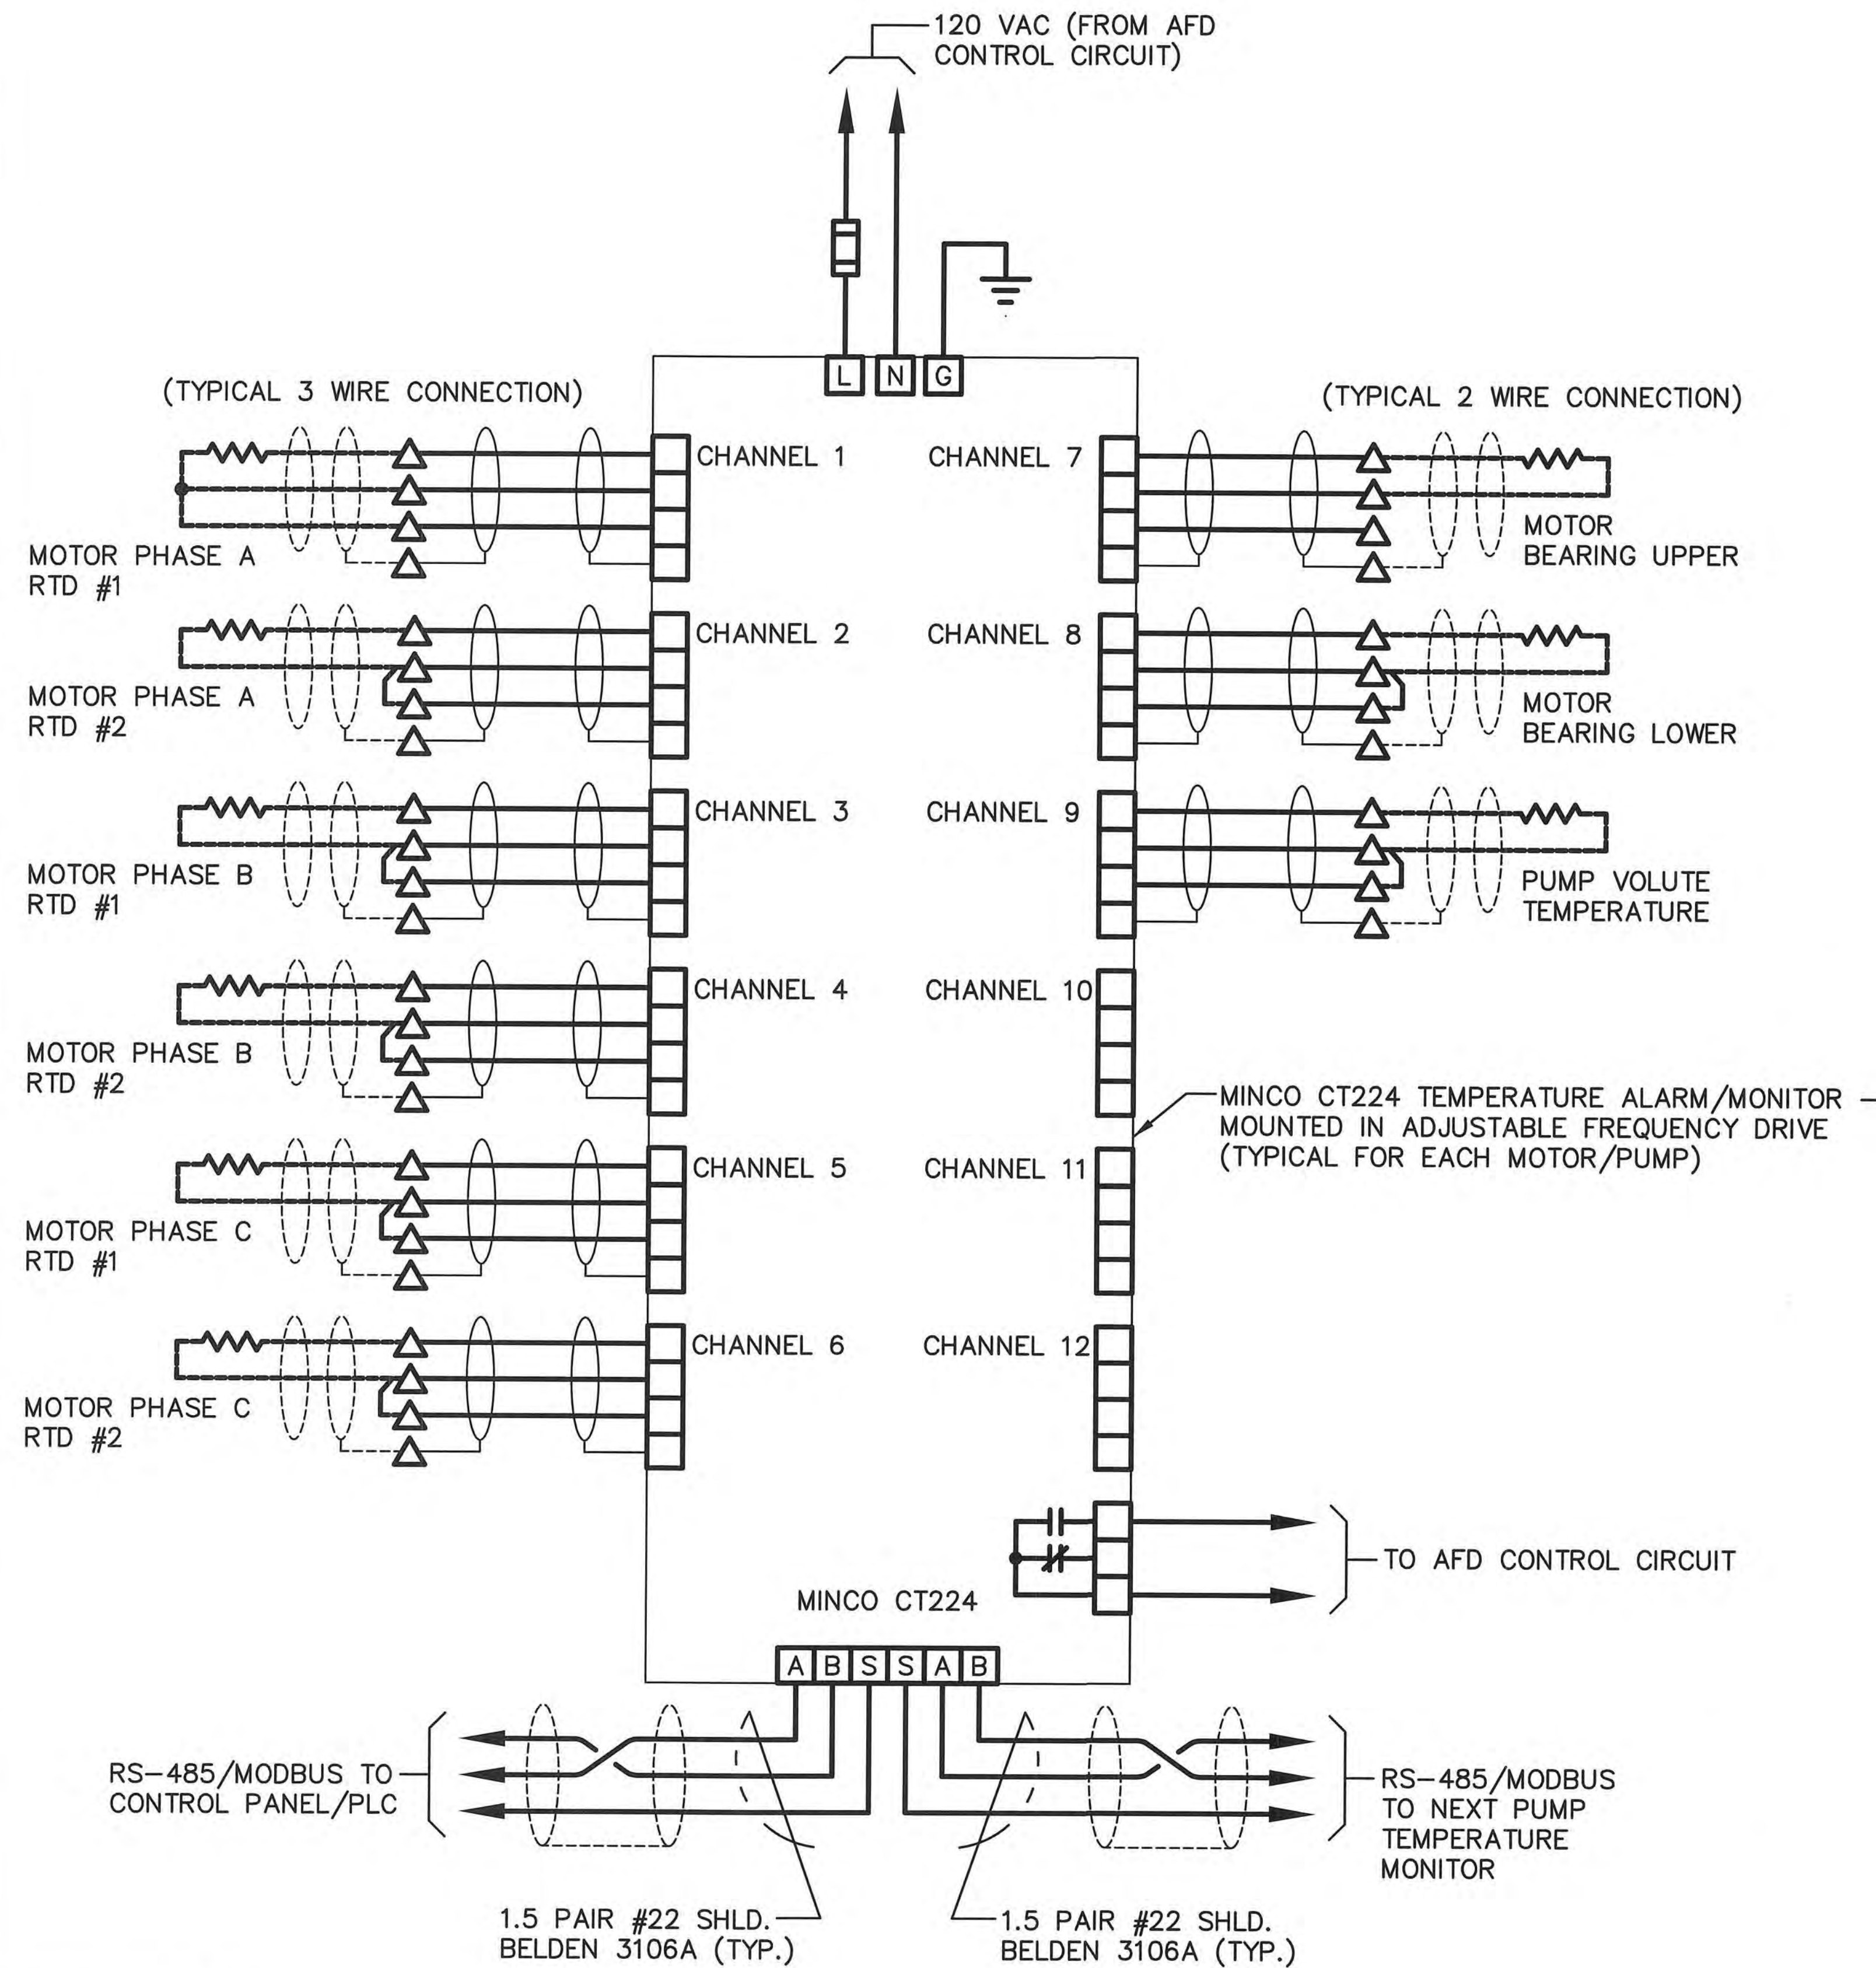

NOTES:

△ DENOTES TERMINAL FOR FIELD CONNECTION.

ENGINEER OF RECORD:
BOB E. HALLMAN, P.E.
FLORIDA REGISTRATION NO. 20761

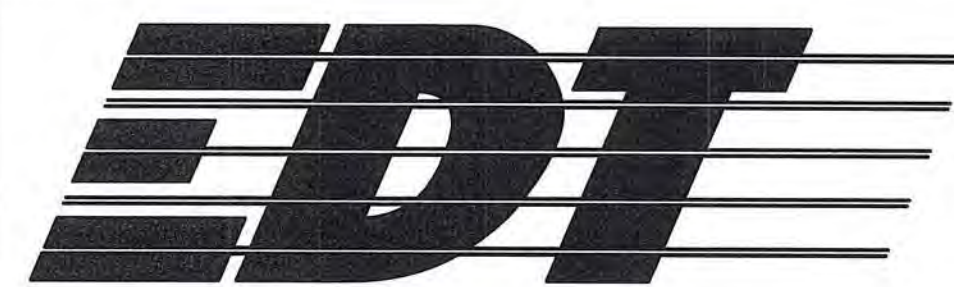

**Engineering Design
Technologies Corp.**
P.O. Box 152403
Tampa, FL 33684-2403
813.289.8080
813.282.9184 FAX
engineering@edt1.com

CITY of TAMPA
WASTEWATER DEPARTMENT

KRAUSE PS REHABILITATION
TEMPERATURE ALARM/MONITOR DETAILS

NO.	DATE	REVISIONS

DRAWN: RWB
DESIGN: STK
QC: BEH
DATE: 05/01/14

PLANS

FOR

CITY OF TAMPA FLORIDA
WASTEWATER DEPARTMENT

FOR


THE CONSTRUCTION OF THE
YBOR PUMPING STATION
REHABILITATION

JUNE 2011



GREELEY AND HANSEN

1715 NORTH WESTSHORE BLVD., STE. 464
TAMPA, FLORIDA 33607
CERTIFICATE OF AUTHORIZATION NO. 37

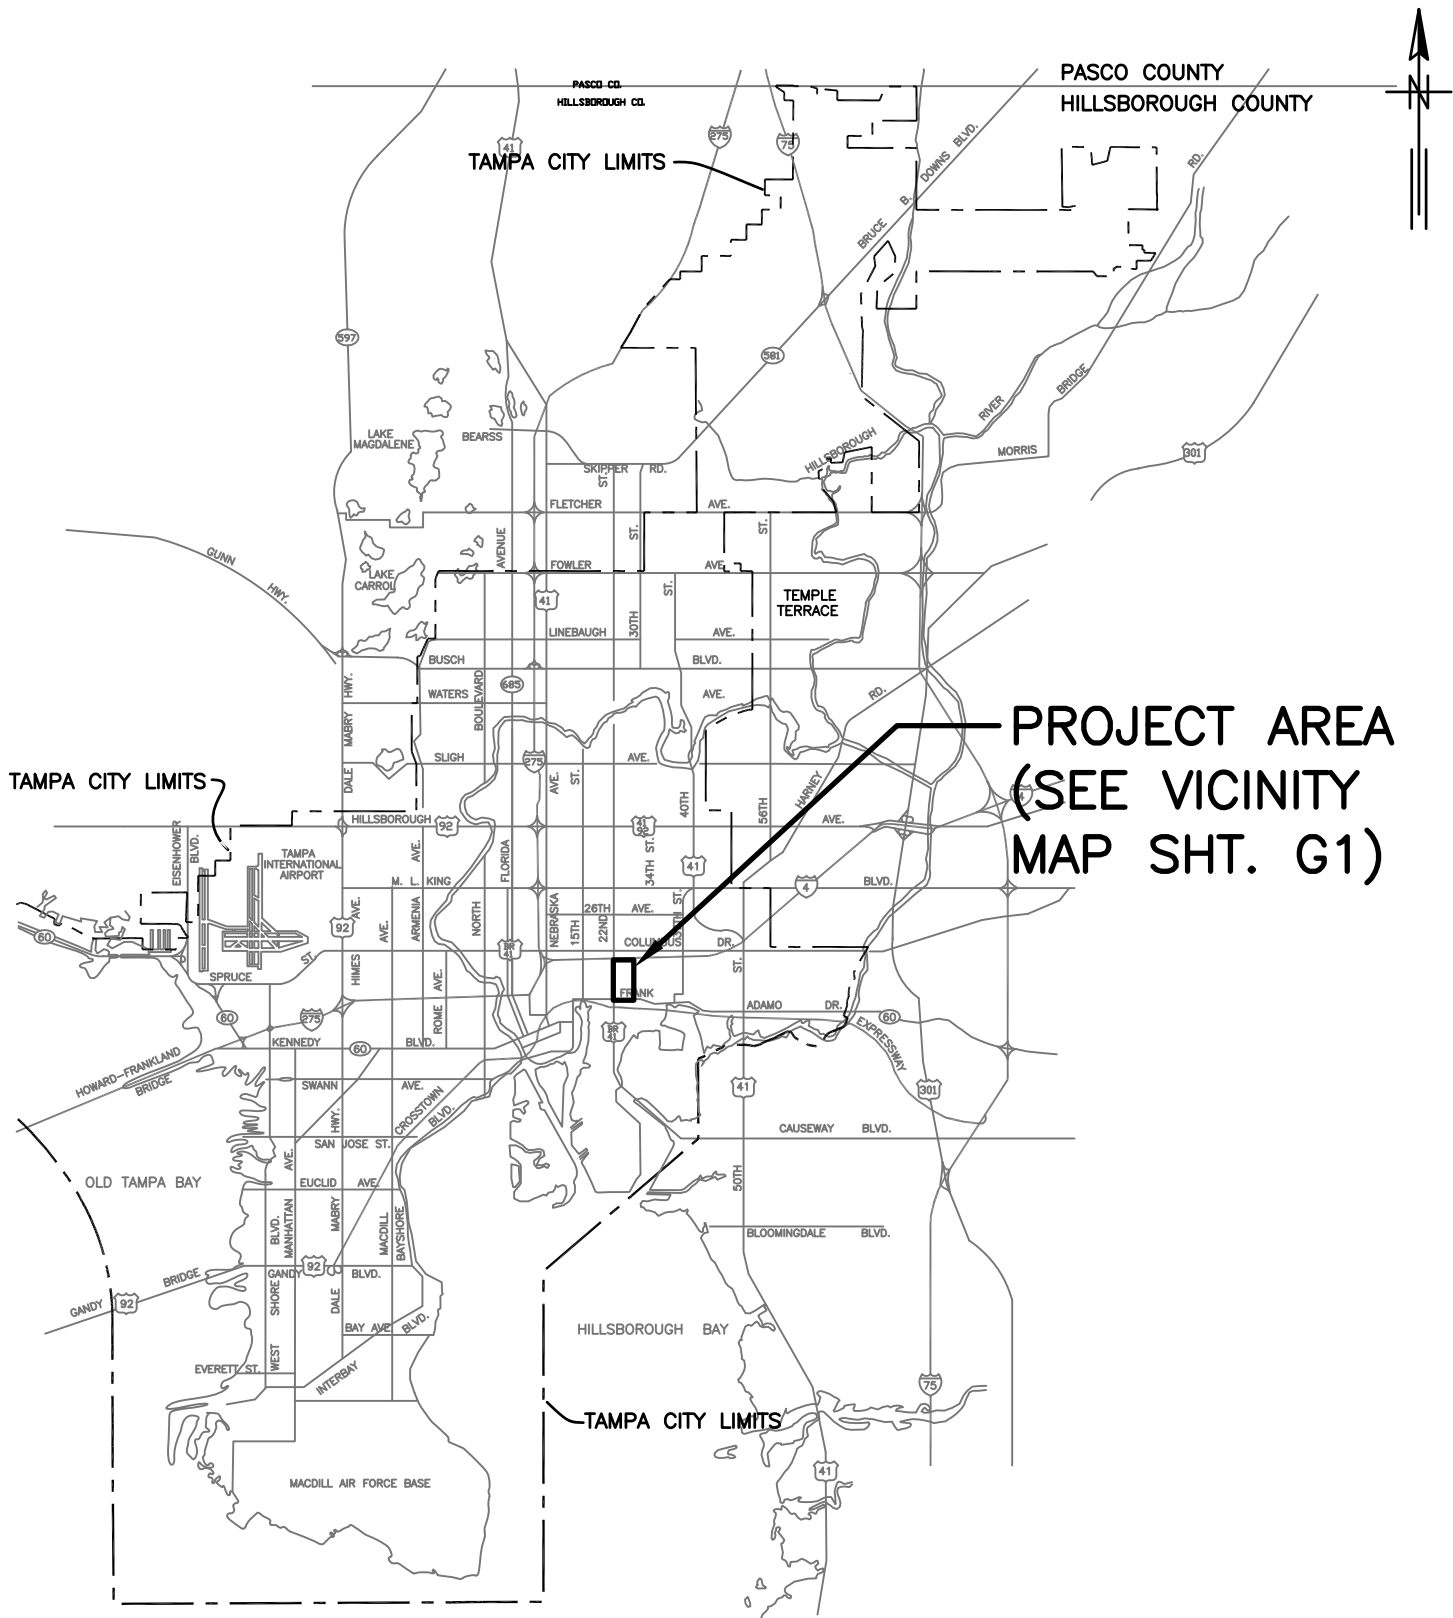


P.E. NAME: DAVID C. HAGAN P.E. NO. 39163


P.E. NAME: _____

DATE: _____

G1, 6/21/2011 3:48:08 PM

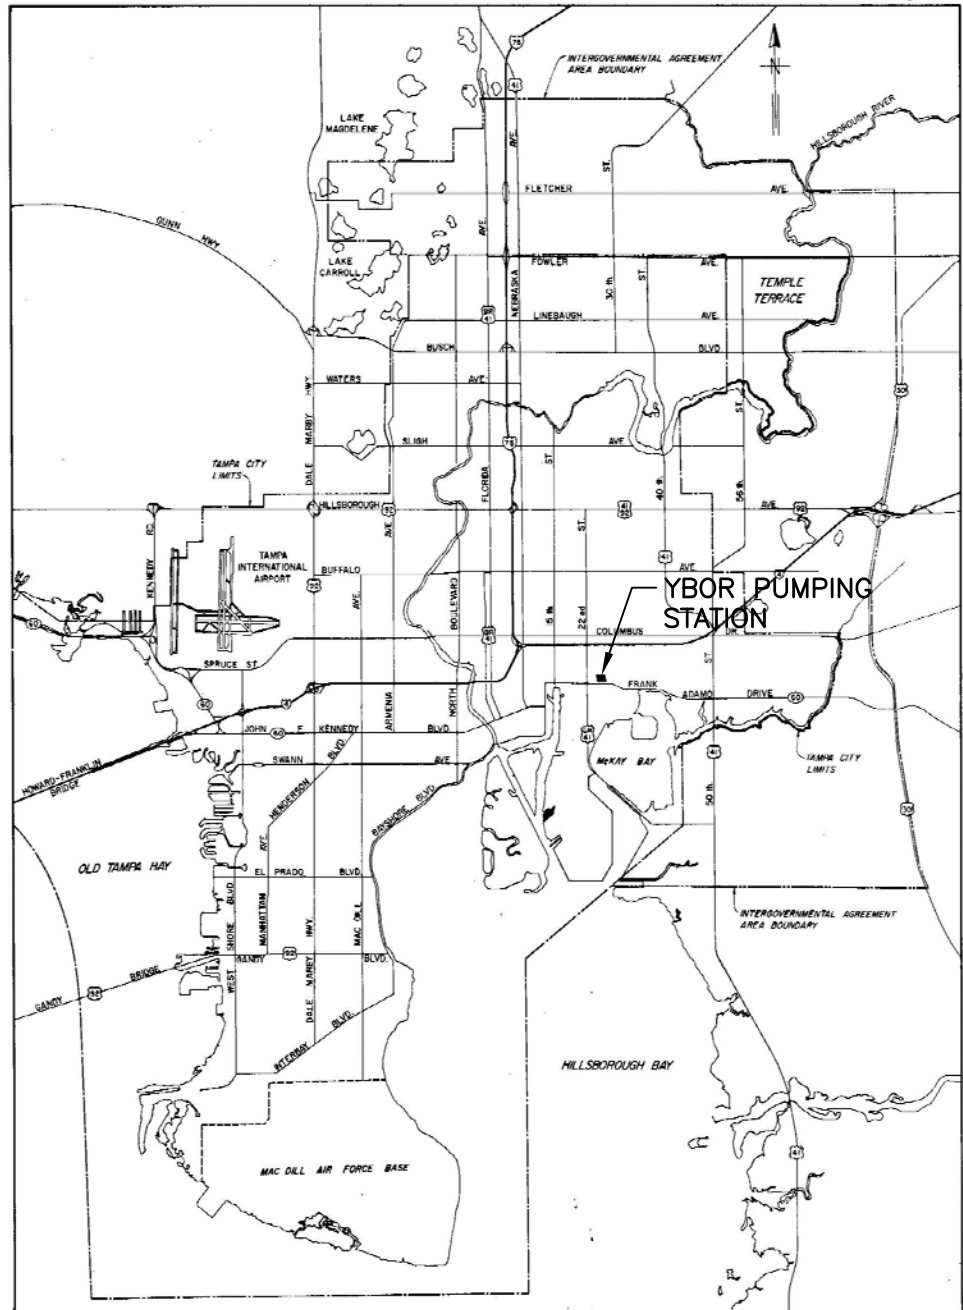

LOCATION MAP
NOT TO SCALE

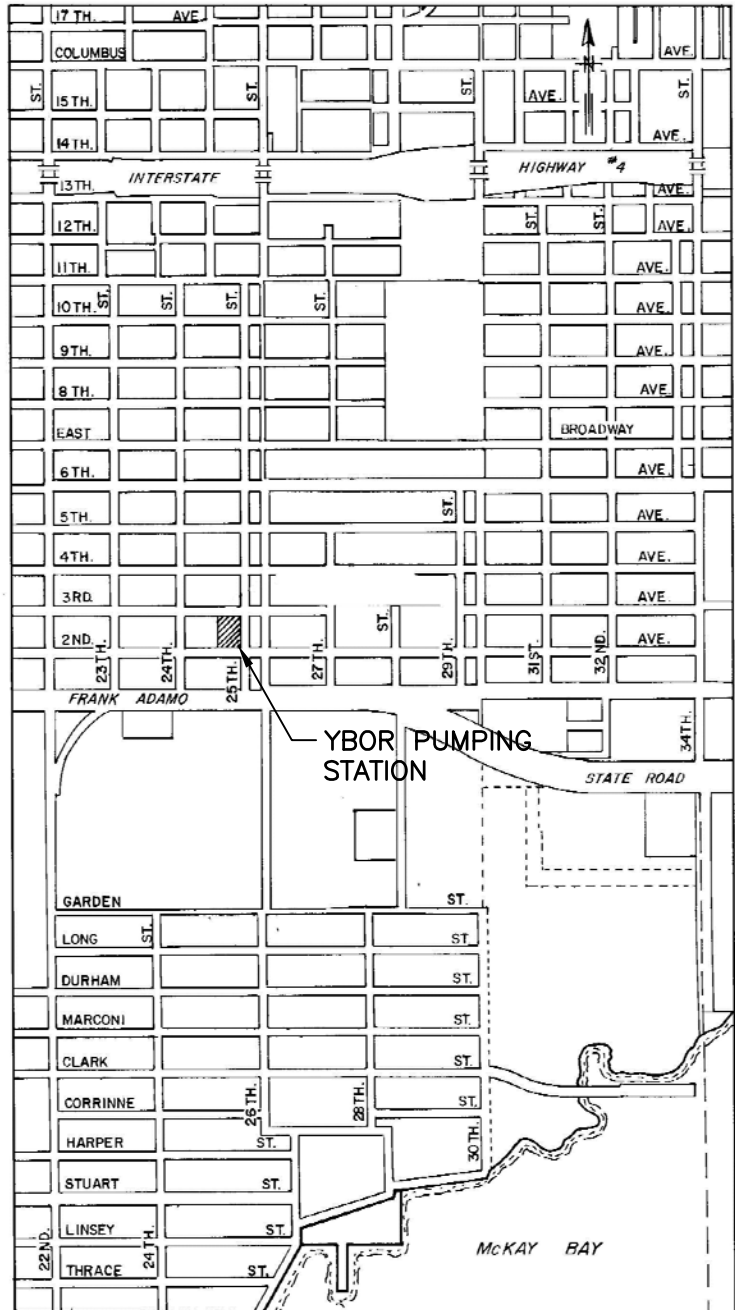

AREA MAP
NOT TO SCALE

INDEX

DESIGNATED SHEET NO.	TITLE
	COVER SHEET
GENERAL	
G1	LOCATION MAP, AREA MAP, INDEX
G2	GENERAL NOTES AND LEGEND
G3	SITE PLAN
G4	GENERAL DETAILS
G5	SECTION AND DETAILS
DEMOLITION	
D1	DEMOLITION PLAN FL EL 12.00'
D2	DEMOLITION PLAN - MEZZANINE
D3	DEMOLITION PLAN FL EL -15.00'
D4	DEMOLITION SECTION AND DETAILS
D5	DEMOLITION SECTION, DIAGRAM AND DETAILS
D6	DEMOLITION DETAILS
MECHANICAL	
M1	PIPING PLAN FL EL 12.00'
M2	PIPING PLAN - MEZZANINE
M3	PIPING PLAN FL EL -15.00'
M4	PIPING SECTIONS AND DETAILS
M5	TEMPERATURE CONTROL LAYOUT FL EL 12.00'
ELECTRICAL	
E1	LEGEND AND SYMBOLS
E2	SITE PLAN
E3	MAIN SERVICE SWITCHGEAR SES-1 - ONE LINE DIAGRAM
E4	MOTOR CONTROL CENTER - ONE LINE DIAGRAM
E5	MISCELLANEOUS DIAGRAMS
E6	CONTROL DIAGRAMS
E7	CONTROL DIAGRAMS
E8	CONTROL DIAGRAMS
E9	CONTROL DIAGRAMS
E10	POWER PLAN - FL EL 12.00'
E11	POWER PLAN - FL EL 0.00'
E12	POWER PLAN - FL EL -15.00'
E13	LIGHTING PLAN - FL EL 12.00'
E14	LIGHTING PLAN - FL EL 0.00'
E15	LIGHTING PLAN - FL EL -15.00'
E16	MISCELLANEOUS
E17	SCHEDULES
E18	SCHEDULES
E19	TYPICAL DETAILS
E20	GROUNDING PLAN
INSTRUMENTATION AND CONTROL	
I1	SYMBOLS AND NOMECLATURE
I2	P & ID
I3	P & ID AND MISCELLANEOUS DETAILS
I4	PANEL DETAILS



GREELEY AND HANSEN

1715 N. WESTSHORE BLVD., STE. 464
TAMPA, FLORIDA 33607
CERTIFICATE OF AUTHORIZATION NO. 37

DESIGNED	FJB
DRAWN	JMW
CHECKED	DCH

NO.	DATE	APPD	REVISION
P.E. NAME: DAVID C. HAGAN		P.E. NO. 39163	
P.E. NAME:			
DATE:			

CITY OF TAMPA WASTEWATER DEPARTMENT
YBOR PUMPING STATION REHABILITATION

GENERAL
**LOCATION MAP, AREA MAP
AND INDEX**

FILE: YBORG01

NO. **G1**

DATE JUNE 2011


GENERAL NOTES:

- 1. CONTRACTOR SHALL COORDINATE ALL CONSTRUCTION ACTIVITIES WITH THE ENGINEER AND THE CITY OF TAMPA WASTEWATER DEPARTMENT PERSONNEL PRIOR TO COMMENCING CONSTRUCTION ACTIVITIES.
- 2. ALL ELEVATIONS SHOWN ARE RELATIVE TO FINISHED FLOOR EL. 12.00.
- 3. EXISTING DIMENSIONS AND ELEVATIONS ARE BASED ON THE BEST INFORMATION AVAILABLE. TRUE DIMENSIONS AND ELEVATIONS SHALL BE DETERMINED IN THE FIELD PRIOR TO LAYOUT AND SHOP DRAWING SUBMITTALS.
- 4. ALL SUBMITTALS AND SHOP DRAWINGS SHALL BE ORIGINALS OR HIGH QUALITY COPIES (EASILY READABLE). NO FAXED SHEETS OR POOR QUALITY COPIES WILL BE ACCEPTED FOR SUBMITTAL REVIEW.
- 5. THE CONTRACTOR IS RESPONSIBLE FOR PROVIDING, INSTALLING, LEVELING AND ALIGNING MOTOR AND PUMP. PROCEDURES FOR INSTALLATION, AS OUTLINED IN THE HYDRAULICS INSTITUTE STANDARDS, MOST CURRENT EDITION, SHALL BE ADHERED TO. SEE SPECIFIC PROVISIONS. IF THERE IS A CONFLICT BETWEEN THE REQUIREMENTS OF THE CONTRACT SPECIFICATIONS AND THE HYDRAULIC INSTITUTE STANDARDS, THE MOST STRINGENT STANDARD SHALL BE FOLLOWED.
- 6. NEW AIR SUPPLY PIPING FOR PNEUMATICALLY ACTUATED PUMP-CHECK VALVES, AIR COMPRESSOR, AND AIR DRYER SHALL BE PROVIDED FROM EXISTING STATION AIR PIPING AS REQUIRED FOR THE LAY-OUT OF THE NEW EQUIPMENT. ISOLATION BALL VALVES AND PIPE UNIONS SHALL BE PROVIDED TO ALLOW REMOVAL OF EQUIPMENT. EXISTING VALVES AT THESE LOCATIONS SHALL BE REPLACED. ARRANGEMENT OF PIPING AND CONNECTIONS TO THE EXISTING PIPES SHALL BE MADE BY THE CONTRACTOR UNDER THE DIRECTION OF THE ENGINEER. PIPING SHALL BE TYPE K HARD DRAWN COPPER WITH CAST BRASS SOLDERED FITTINGS. ALL JOINTS SHALL BE THREADED OR SOLDERED. COPPER PIPE SHALL MEET THE REQUIREMENTS AND SHALL BE PAINTED IN ACCORDANCE WITH THE CONTRACT SPECIFICATIONS. ALL REMAINING EXISTING AIR PIPING INSIDE STATION SHALL BE CLEANED AND PAINTED.
- 7. PUMP ANCHOR BOLTS SHALL BE PER PUMP MANUFACTURER'S RECOMMENDATIONS. ANCHOR BOLTS SHALL BE DOUBLE-NUTTED AND SHALL HAVE SUFFICIENT LENGTH SO THAT THE BOLTS EXTEND BEYOND THE FASTENING NUTS BY A MINIMUM OF 1/2 INCH.
- 8. ALL HARDWARE, UNLESS OTHERWISE NOTED, SHALL BE TYPE 316 STAINLESS STEEL.
- 9. PROPOSED STEEL SPOOL PIECES AND FITTINGS (INCLUDING PUMP DISCHARGE AND SUCTIONS REDUCERS) SHALL BE FABRICATED TO SUIT THE DIMENSIONS OF THE PROPOSED EQUIPMENT OR LAYOUT, AND SHALL BE ASTM A 36 STEEL WITH A MINIMUM WALL THICKNESS OF 1/2 INCH STEEL PIPE SHALL BE LINED WITH COAL TAR EPOXY (MINIMUM 3/32" THICK) IN ACCORDANCE WITH AWWA C203. FABRICATED STEEL FITTINGS SHALL BE MANUFACTURED BY AN AWWA CERTIFIED FABRICATOR.
- 10. ALL FIELD WELDS SHALL CONFORM TO PROCEDURES OUTLINED IN AWWA M 11 AND AWWA C 206.
- 11. CONTRACTOR SHALL PROCURE THE SERVICES OF AN INDEPENDENT CERTIFIED WELD INSPECTOR TO TEST ALL FIELD WELDS. CERTIFIED WELL INSPECTOR SHALL PERFORM AS A MINIMUM A VISUAL INSPECTION AND EITHER A DYE PENETRATING TINT OR MAG PARTICLE TEST TO ASSERT QUALITY OF FIELD WELDS.
- 12. BURIED DUCTILE IRON PIPE SHALL BE MINIMUM PRESSURE CLASS 200 AND SHALL A HAVE CEMENT MORTAR LINING, EXCEPT WHERE REQUIRED TO HAVE CERAMIC EPOXY LINING. ALL FITTINGS, BENDS AND VALVES FOR THIS PIPELINE SHALL BE POLYETHYLENE ENCASED AND INSTALLED USING CLASS C BEDDING, UNLESS OTHERWISE SHOWN OR DIRECTED.
- 13. EXPOSED DUCTILE IRON PIPE SHALL BE FLANGED, MINIMUM CLASS 53 AND SHALL HAVE CERAMIC EPOXY LINER.
- 14. THE CONTRACTOR SHALL INSTALL THE FORCE MAIN TO THE ELEVATIONS AND SLOPES SHOWN ON THE DRAWINGS. THERE SHALL BE NO INTERMEDIATE HIGH OR LOW POINTS BETWEEN V.P.I.'S.
- 15. ALL CONCRETE AND GROUT, UNLESS OTHERWISE SPECIFIED, SHALL BE CLASS "B" WITH A 28 DAY COMPRESSIVE STRENGTH OF 4,000 PSI.
- 16. ALL STEEL REINFORCING SHALL BE DETAILED ACCORDING TO THE LATEST " ACI MANUAL OF STANDARD PRACTICE FOR DETAILING REINFORCED CONCRETE STRUCTURES." ACTUAL PLACEMENT OF STEEL REINFORCING SHALL BE SHOWN ON SHOP DRAWINGS. ALL LAPS AND SPLICES SHALL BE AT LEAST 32 BAR DIAMETERS OR 24 INCHES.

DEMOLITION NOTES:


- 1. ALL DIMENSIONS ARE APPROXIMATE. ACTUAL DIMENSIONS SHALL BE DETERMINED IN THE FIELD.
- 2. SALVAGEABLE MATERIALS AS DETERMINED BY THE WASTEWATER DEPARTMENT PERSONNEL SHALL BE DELIVERED TO THE CITY OF TAMPA'S HOWARD F. CURREN AWTP AT 2700 MARITIME BOULEVARD. NON-SALVAGEABLE MATERIALS ARE TO BE REMOVED FROM THE SITE AND PROPERLY DISPOSED OF AT THE CONTRACTOR'S EXPENSE. IN GENERAL, ALL PUMP AND CONTROLS EQUIPMENT SHALL REMAIN PROPERTY OF THE CITY AND SHALL BE DELIVERED TO THE TREATMENT PLANT.REFER TO SPECIFIC PROVISIONS.
- 3. CONSTRCTOR SHALL CUT ALL EXPOSED REINFORCING STEEL TO A DEPTH OF 1-INCH BELOW THE EXPOSED SURFACE AND THE OPENING SHALL BE SEALED WITH GROUT.

LEGEND

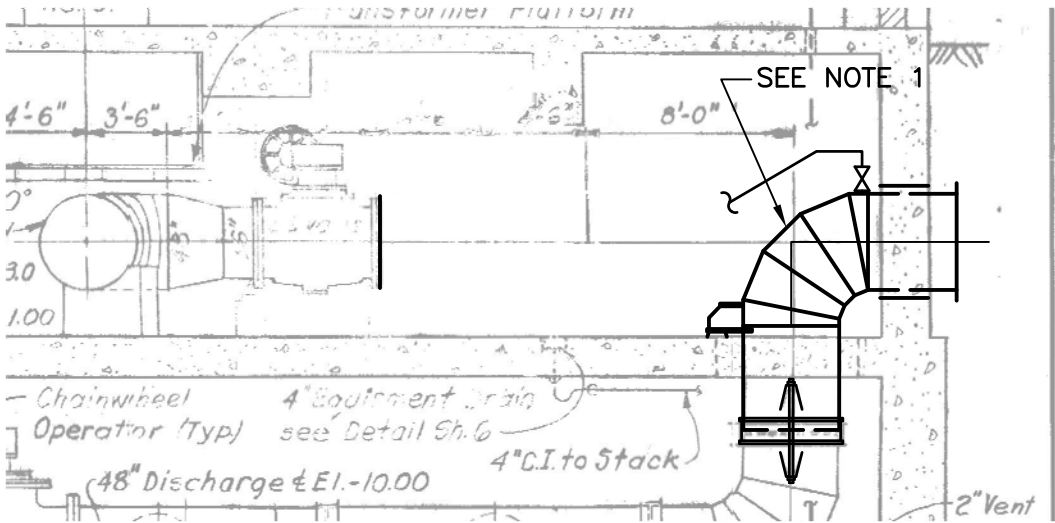


- NOTES:
- 1. ALL WORK INCLUDED IN THIS CONTRACT IS SHOWN IN BOLD. LIGHT LINEWEIGHT INDICATES BACKGROUND INFORMATION, EXCEPT WHERE NOTED OTHERWISE IN THESE PLANS BY BOLD ANNOTATION.

G2, 6/21/2011 9:35:05 AM


 GREELEY AND HANSEN 1715 N. WESTSHORE BLVD., STE. 464 TAMPA, FLORIDA 33607 CERTIFICATE OF AUTHORIZATION NO. 37						CITY OF TAMPA WASTEWATER DEPARTMENT YBOR PUMPING STATION REHABILITATION GENERAL GENERAL NOTES AND LEGEND	FILE: YBORG02	
	DESIGNED FJB	P.E. NAME: DAVID C. HAGAN	P.E. NO. 39163					
	DRAWN JMW	P.E. NAME:						
CHECKED DCH	DATE:						NO. G2 DATE JUNE 2011	

DATE JUNE 2011

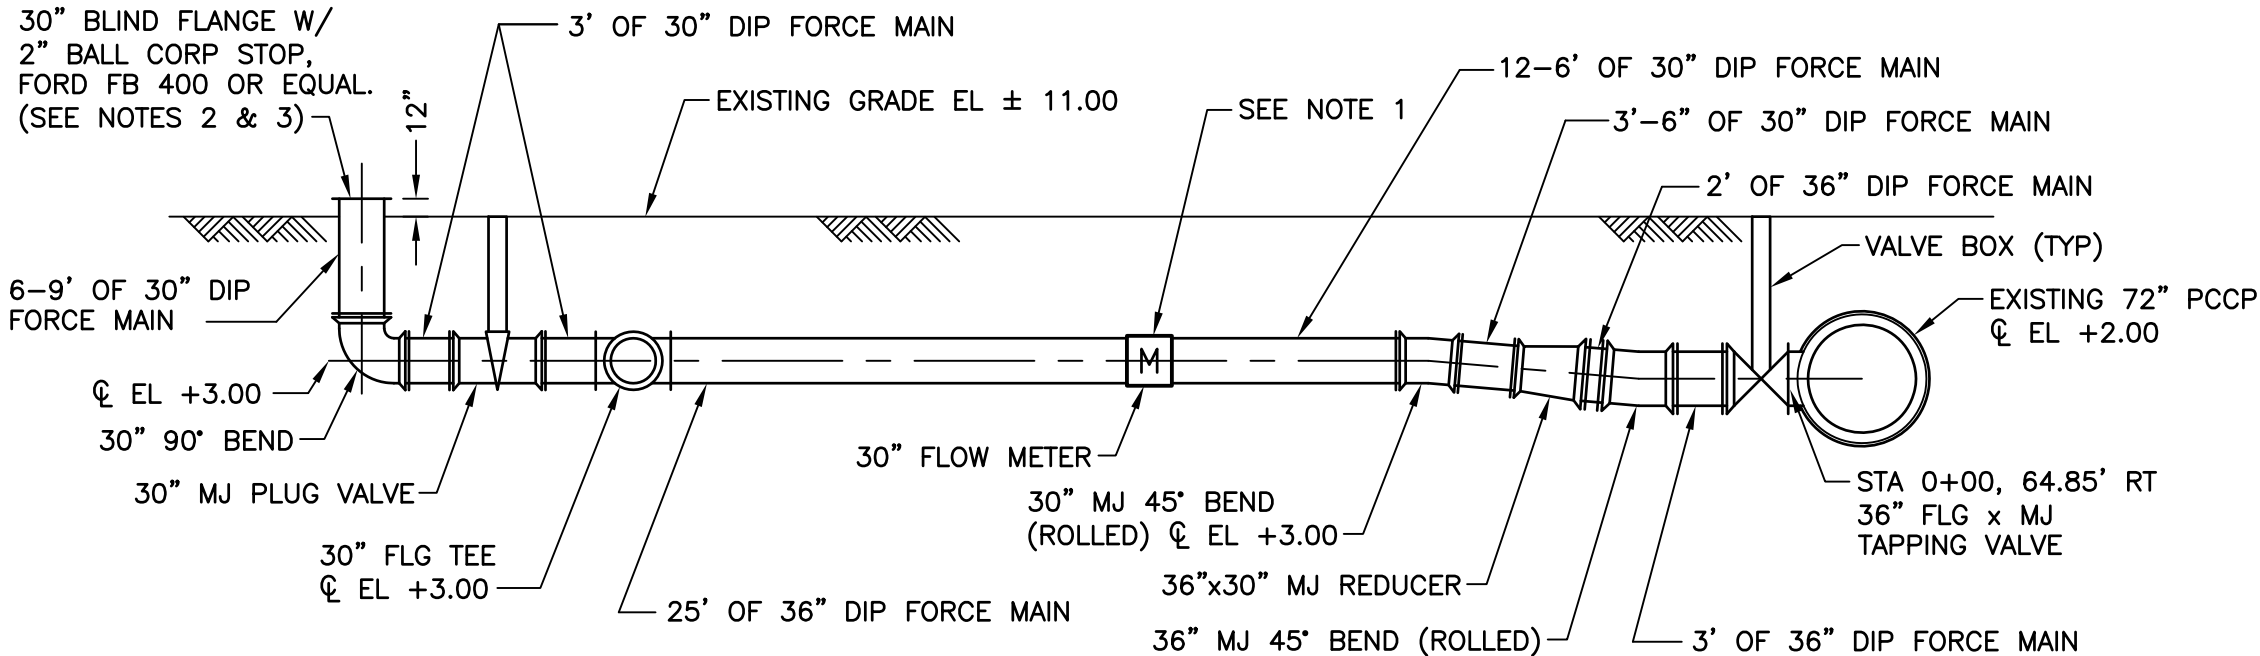


- NOTES:**
1. INSTALL METER CONVERTER/TRANSMITTER INSIDE PUMP STATION.
 2. LINE INTERIOR FACE OF PERMANENT BLIND FLANGE AND VERTICAL RISER OF ASSEMBLY WITH CERAMIC EPOXY AS SPECIFIED.
 3. PAINT ALL ABOVE GROUND DIP PIPING AS SPECIFIED.


SECTION 2/G3
SCALE: 3/32" = 1'-10'

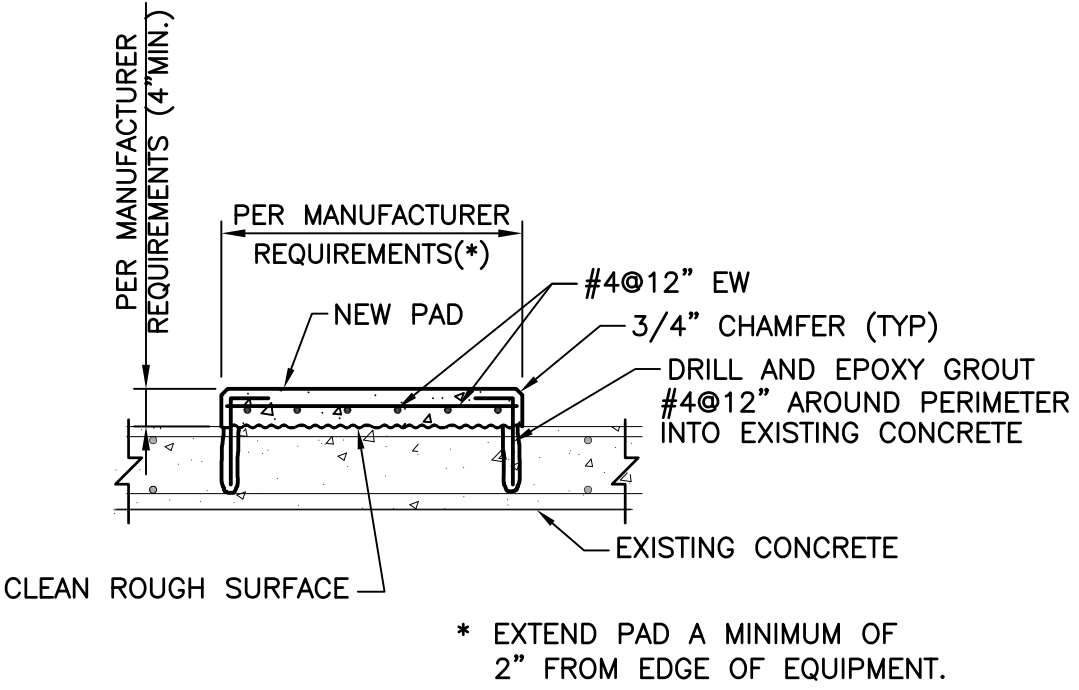

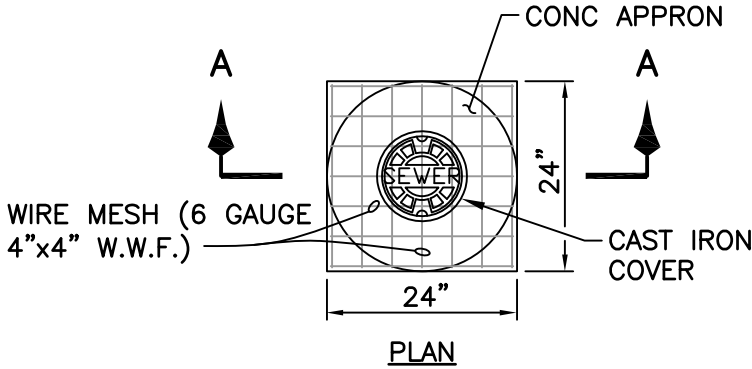

**NEW EQUIPMENT PAD
ON EXISTING SLAB DETAIL**
NOT TO SCALE

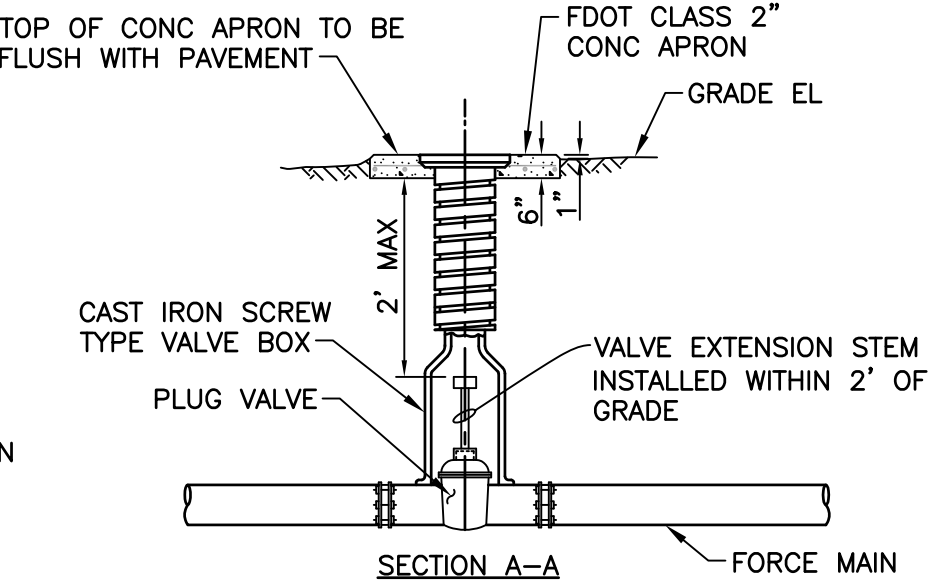

VALVE BOX DETAIL
NOT TO SCALE




G5, 6/20/2011 5:17:43 PM

<div></div> <div>GREELEY AND HANSEN</div> <div>1715 N. WESTSHORE BLVD., STE. 464 TAMPA, FLORIDA 33607 CERTIFICATE OF AUTHORIZATION NO. 37</div>	<div><div>04816</div><div></div><div>SCALE IN FEET</div></div>	<table><tr><td></td><td></td><td></td><td></td></tr><tr><td></td><td></td><td></td><td></td></tr><tr><td>NO.</td><td>DATE</td><td>APPD</td><td>REVISION</td></tr></table>									NO.	DATE	APPD	REVISION	<div>CITY OF TAMPA WASTEWATER DEPARTMENT YBOR PUMPING STATION REHABILITATION</div>	<div>FILE: YBORG05</div>
	NO.	DATE	APPD	REVISION												
<div>DESIGNED FJB DRAWN JMW CHECKED DCH</div>	<div>P.E. NAME: DAVID C. HAGAN P.E. NO. 39163</div>	<div>GENERAL</div>	<div>NO. G5</div>													
	<div>P.E. NAME: _____ DATE: _____</div>	<div>SECTION AND DETAILS</div>	<div>DATE JUNE 2011</div>													

D2, 6/16/2011 9:54:19 AM

ABANDON IN PLACE SEAL
WATER EQUIPMENT AND
PIPING (SEE SHEET D5)

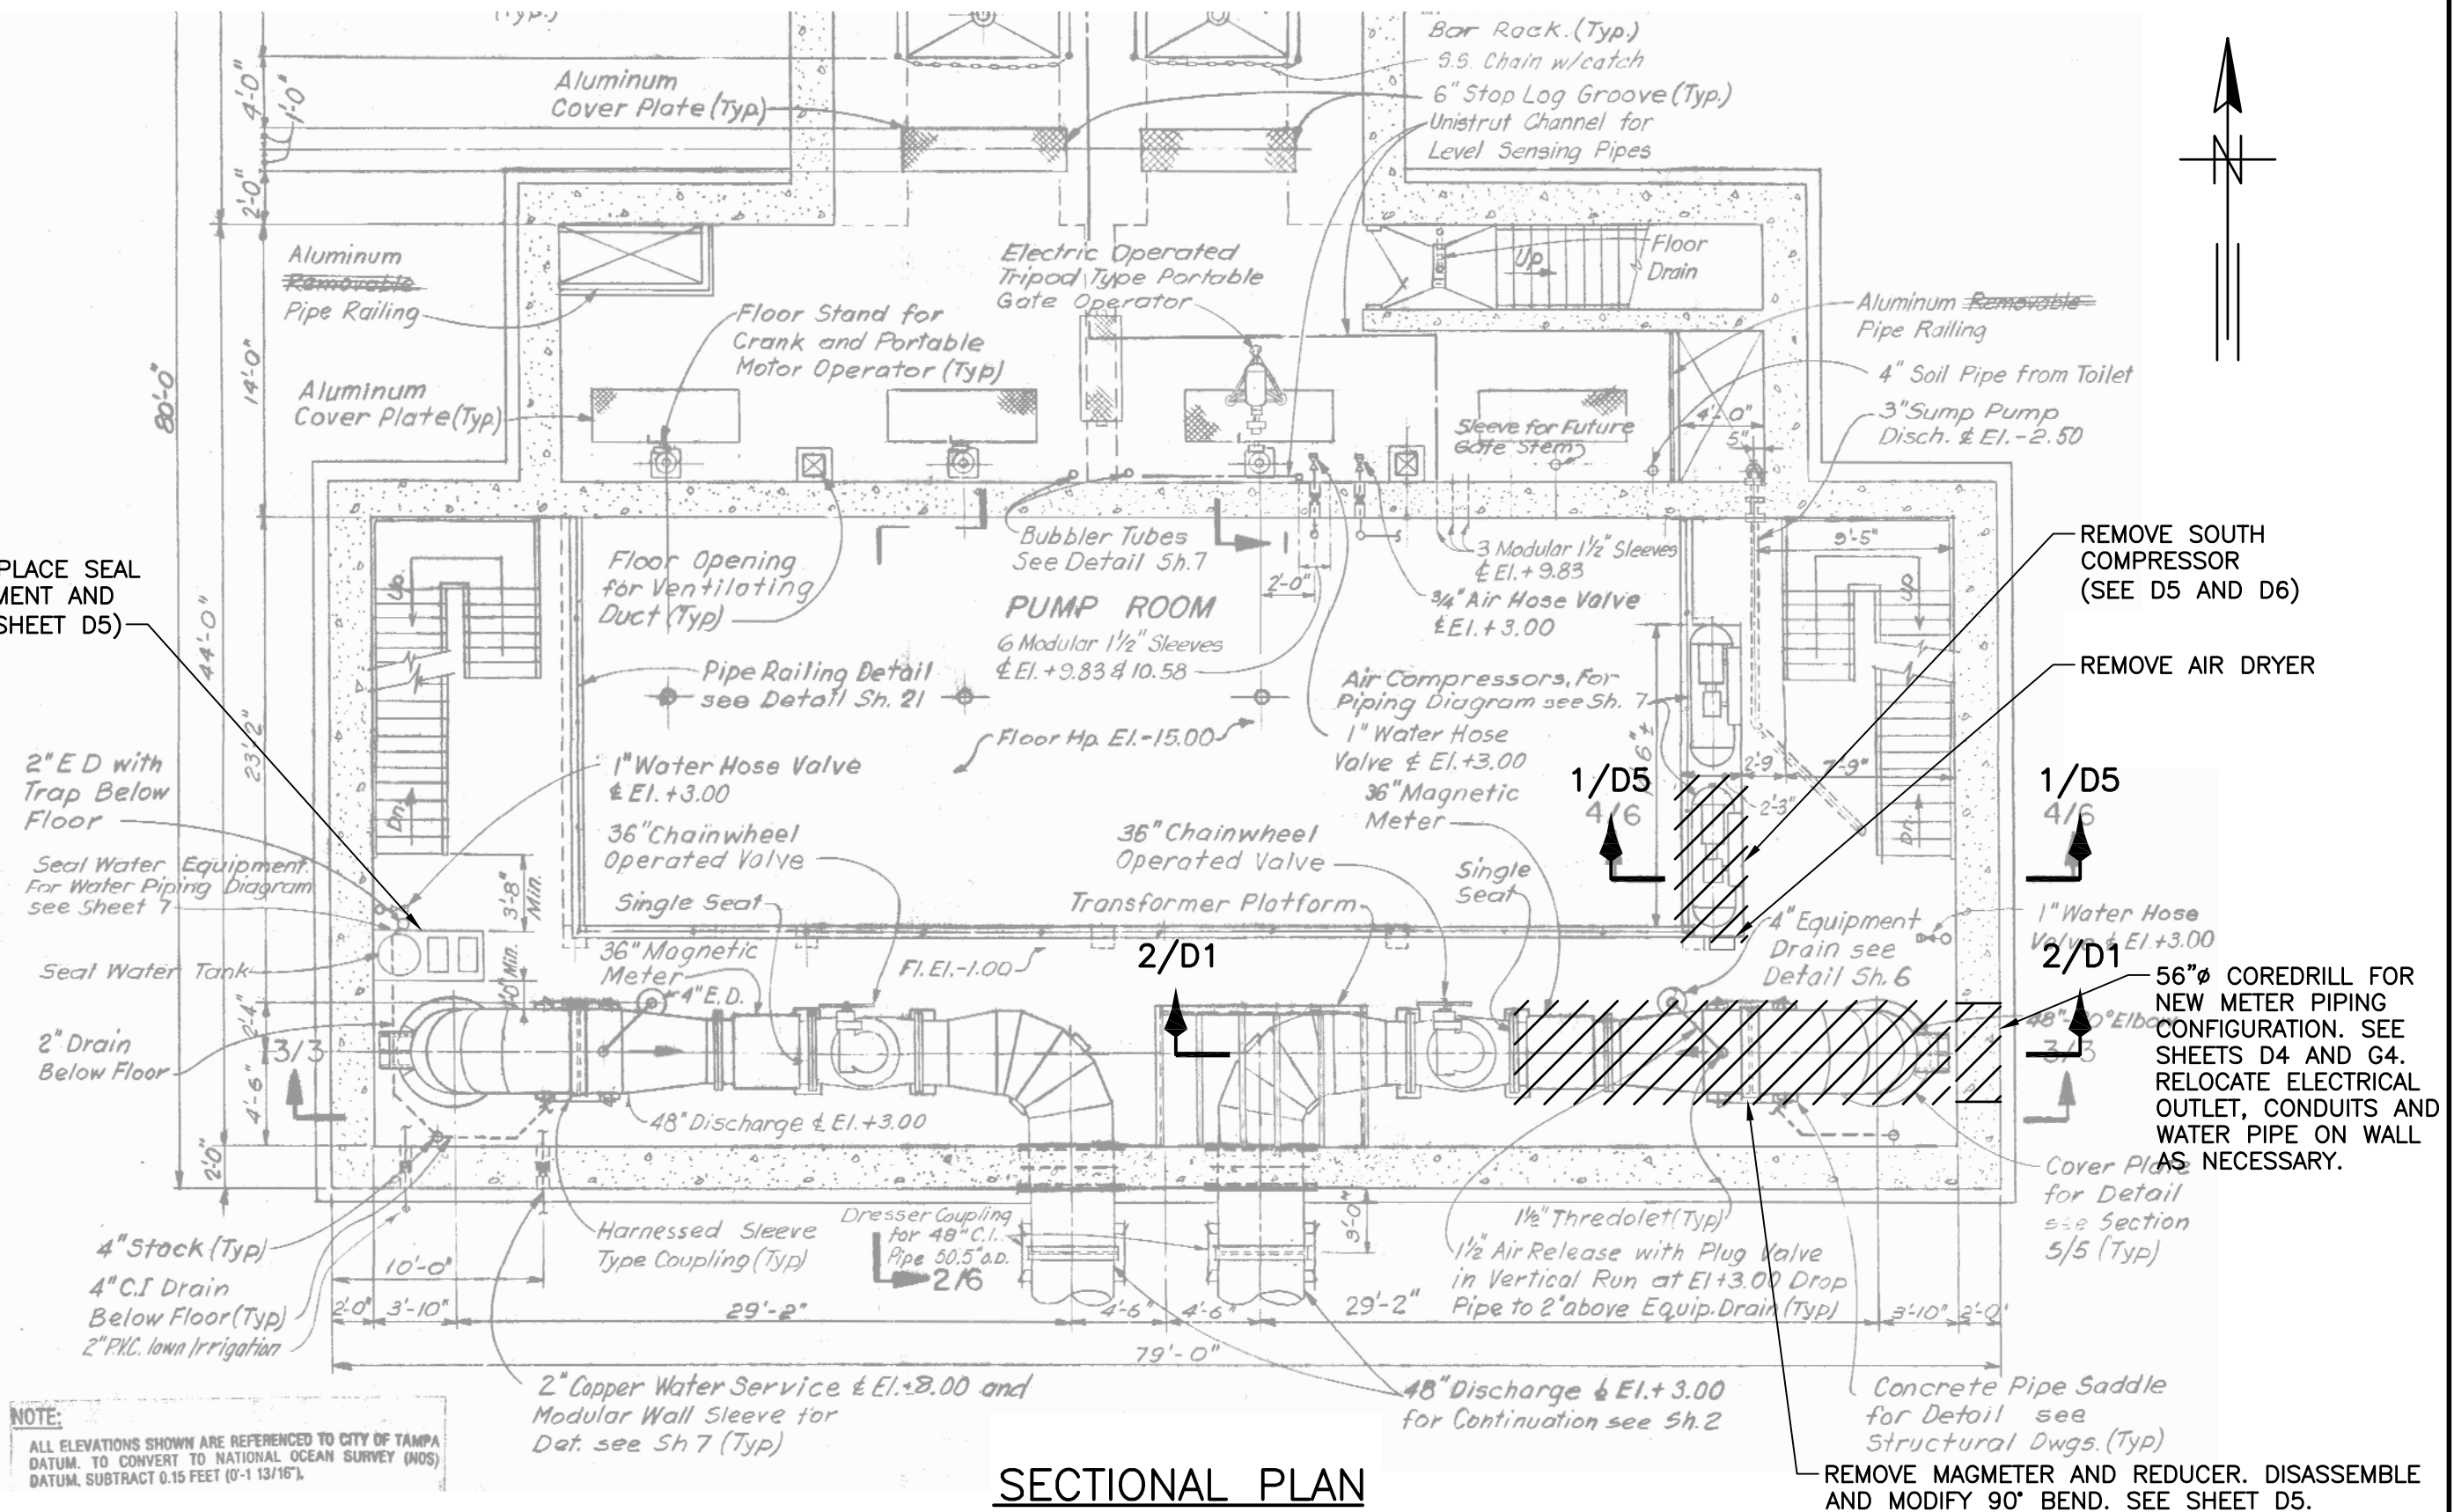


SECTIONAL PLAN

SCALE: 1/8"=1'-0"



GREELEY AND HANSEN

1715 N. WESTSHORE BLVD., STE. 464
TAMPA, FLORIDA 33607
CERTIFICATE OF AUTHORIZATION NO. 37

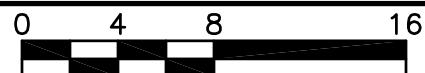

SCALE IN FEET

DESIGNED	FJB
DRAWN	JMW
CHECKED	DCH

NO.	DATE	APPD	REVISION
P.E. NAME: DAVID C. HAGAN		P.E. NO. 39163	
P.E. NAME:			
DATE:			

CITY OF TAMPA WASTEWATER DEPARTMENT
YBOR PUMPING STATION REHABILITATION

DEMOLITION

DEMOLITION PLAN - MEZZANINE

FILE: YBORD02


NO. **D2**

DATE JUNE 2011

1. REMOVE PUMP, MOTOR, EXTENDED SHAFT, AND PLUG VALVE WITH ACTUATOR FOR PUMPS NO. 1, 2 AND 3.
2. REMOVE MOTOR (CLOSE COUPLED) AND PLUG VALVE WITH ACTUATOR AT PUMP NO. 4.
3. REMOVE EXISTING PUMP ISOLATION SLUICE GATES AND OPERATORS FOR PUMPS NO. 1, NO. 2 AND NO. 3. SLUICE GATE FRAMES TO REMAIN.



SCALE: 1/8" = 1'-0"

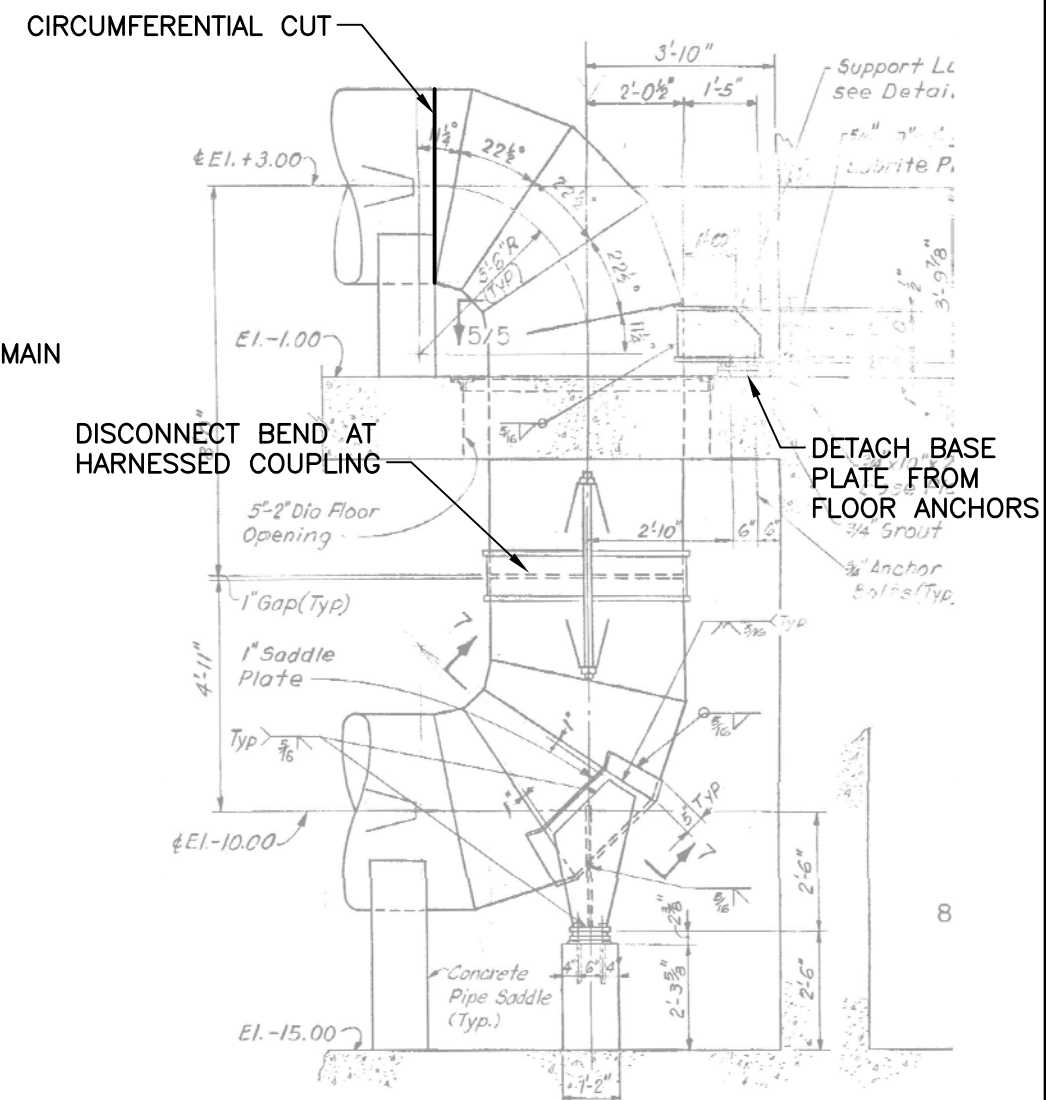


BEND DISASSEMBLY DETAIL

SCALE: 1/4" = 1'-0"

**GREELEY AND HANSEN**

1715 N. WESTSHORE BLVD., STE. 464
TAMPA, FLORIDA 33607
CERTIFICATE OF AUTHORIZATION NO. 37

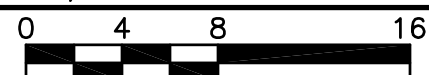

SCALE IN FEET

DESIGNED	FJB
DRAWN	JMW
CHECKED	DCH

NO.	DATE	APPD	REVISION
P.E. NAME: DAVID C. HAGAN			P.E. NO. 39163
P.E. NAME: _____			
DATE: _____			

CITY OF TAMPA WASTEWATER DEPARTMENT
YBOR PUMPING STATION REHABILITATION

DEMOLITION

DEMOLITION SECTION AND DETAILS

FILE:	YBORD04
-------	---------

NO. D4

DATE JUNE 2011


NOTES:

1. ABANDON IN PLACE SEAL WATER SYSTEM AND PIPING.
2. REMOVE PIPING ASSOCIATED WITH REMOVED EQUIPMENT AND THAT OBSTRUCTS WORKING AREA OR WALKING AREA.

LEGEND

- Globe Valve
 - Gate Valve
 - Hose Valve
 - Check Valve
 - Pressure Switch
 - Flow Switch
 - Pressure Gage
 - Manual Air Switch
- See Diagram this Sheet

MODULAR WALL SLEEVE SEALING SCHEDULE							
Service	Nom Pipe Dia	Actual Pipe OD Dim. A	Pipe Sleeve Nom Dia	Pipe Sleeve ID Dim. B	Link Seal Model	Links Per Seal	Dim. C
Level Sensing Pipe	3/8"	0.5"	1 1/2"	1.610"	LS200C	3	7"
Air Pipe	3/4"	0.875"	2"	2.067"	LS200C	4	7"
Water Hose Pipe	3/4"	0.875"	2"	2.067"	LS200C	4	7"
City Water	1 1/2"	1.625"	3"	3.068"	LS300C	4	8"

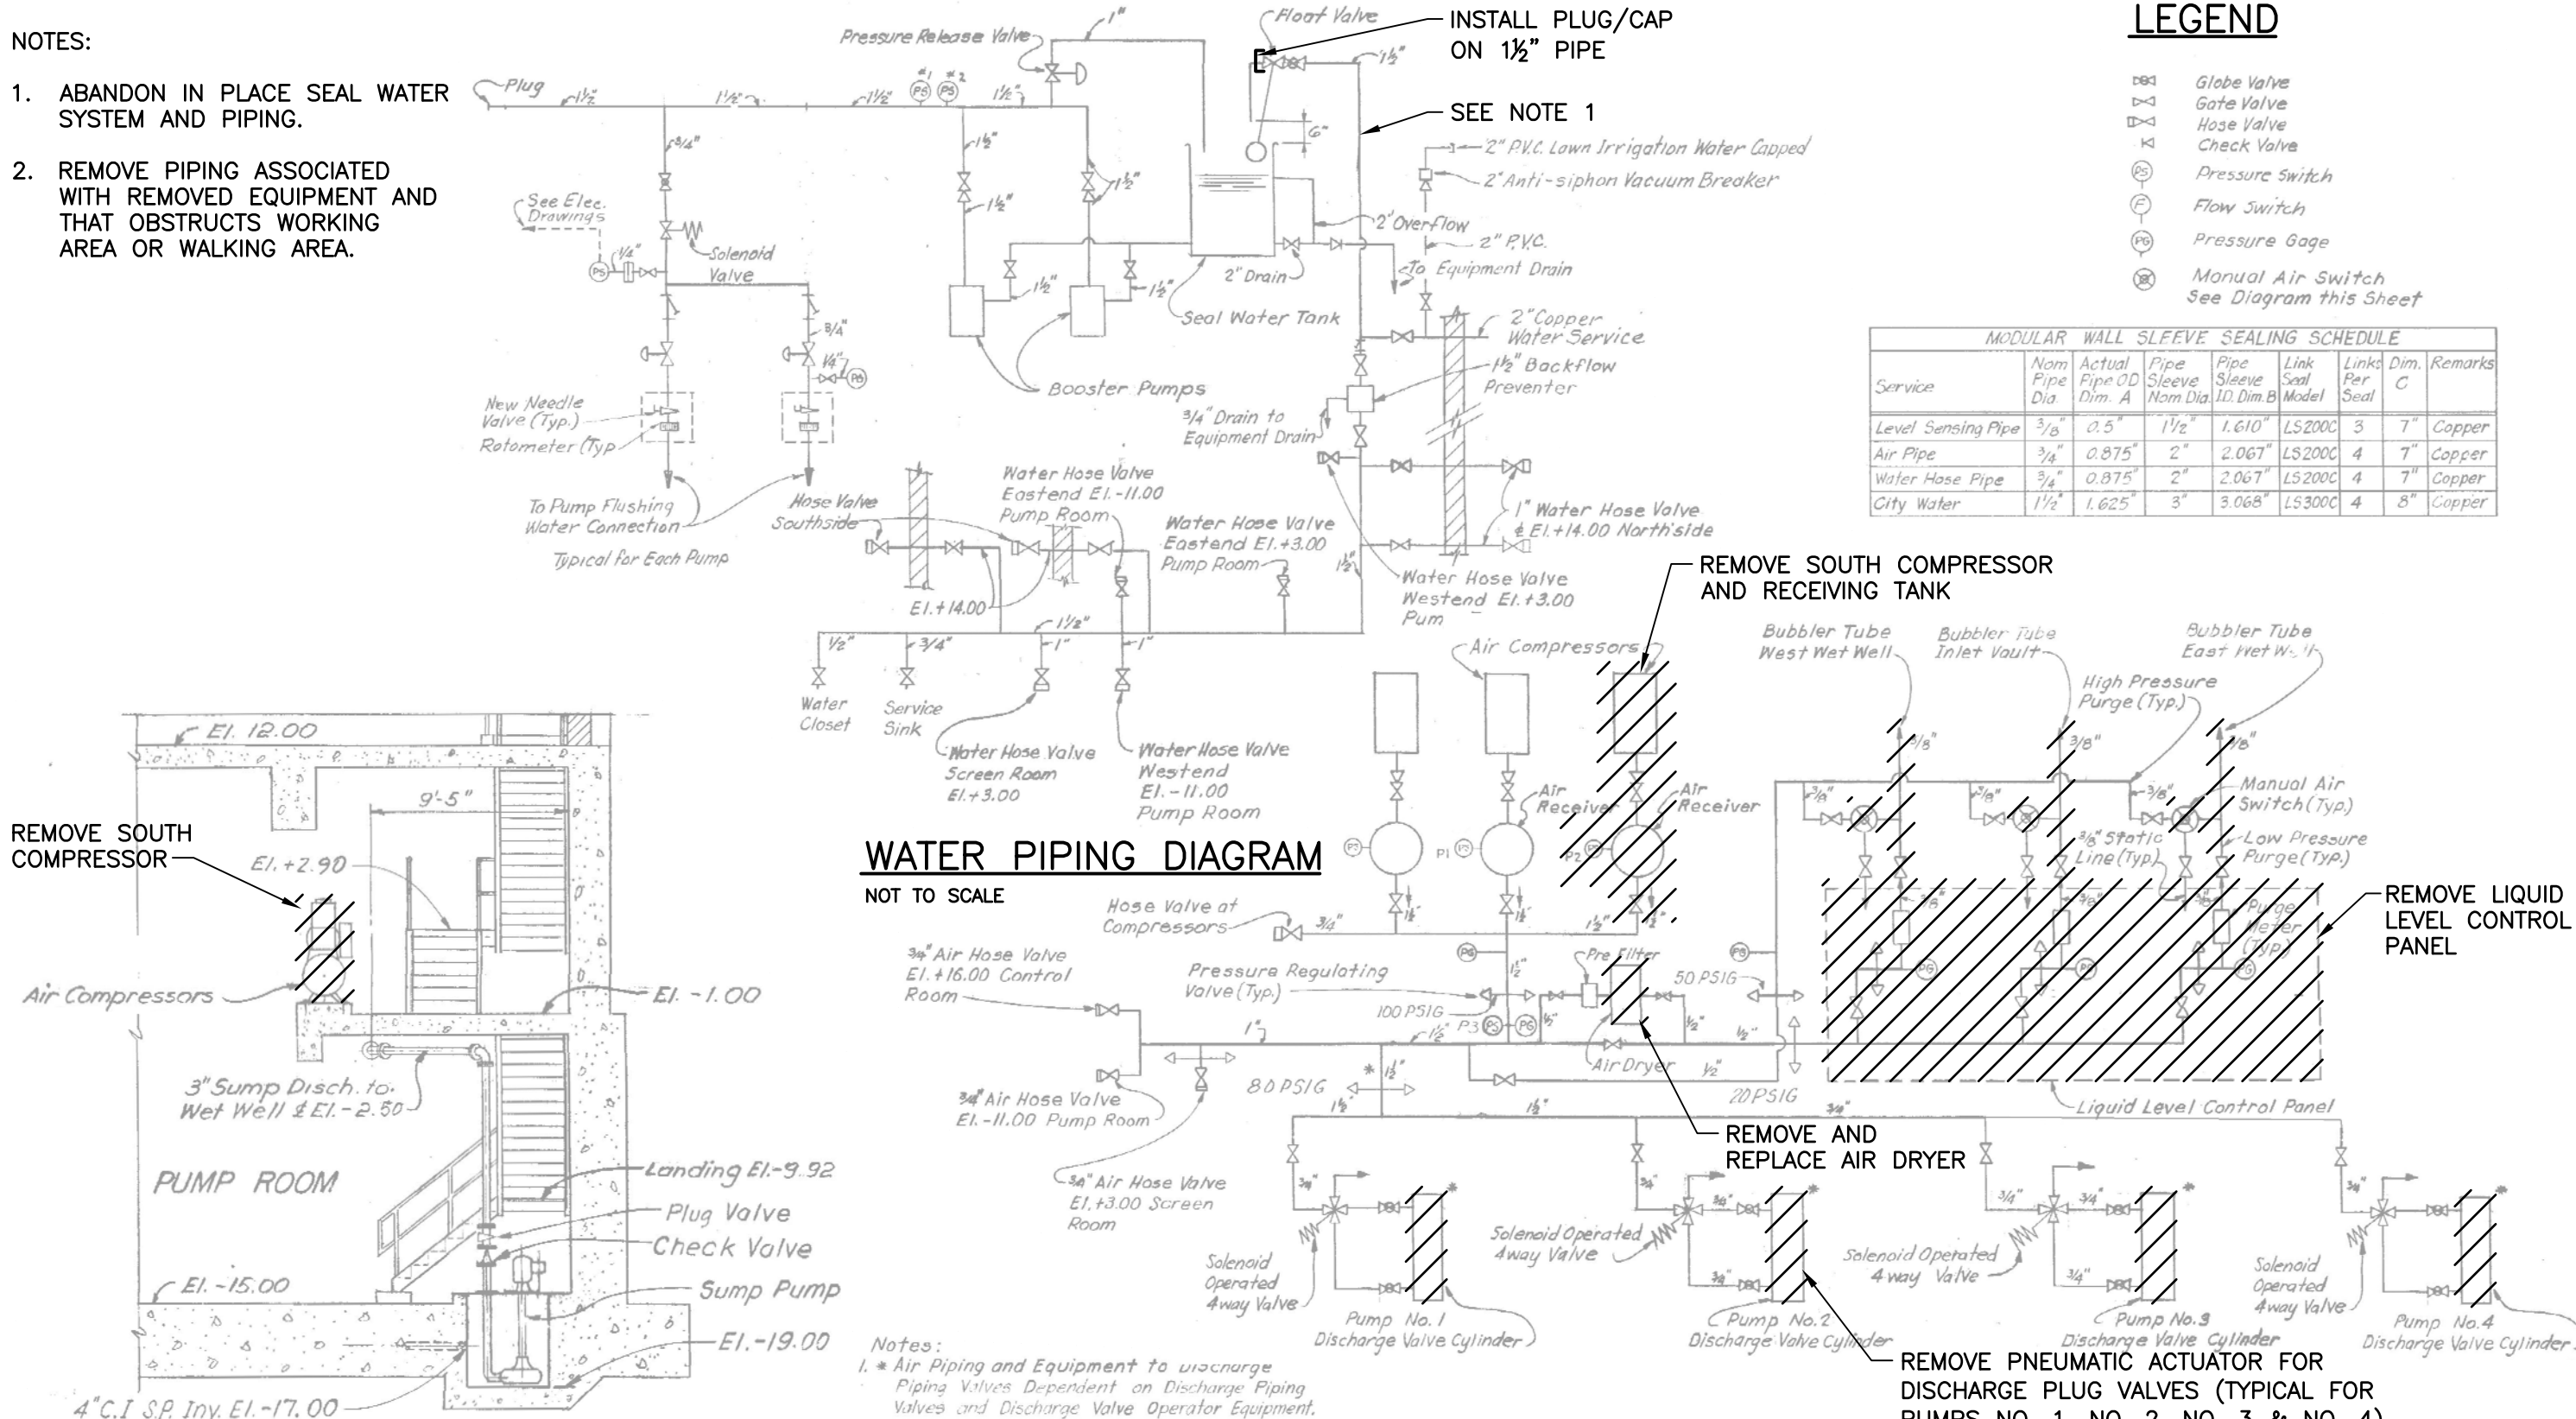


D5, 6/16/2011 10:35:53 AM



GREELEY AND HANSEN

1715 N. WESTSHORE BLVD., STE. 464
TAMPA, FLORIDA 33607
CERTIFICATE OF AUTHORIZATION NO. 37

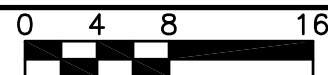

SCALE IN FEET

DESIGNED FJB
DRAWN JMW
CHECKED DCH

NO.	DATE	APPD	REVISION

P.E. NAME: DAVID C. HAGAN P.E. NO. 39163
P.E. NAME: _____
DATE: _____

CITY OF TAMPA WASTEWATER DEPARTMENT
YBOR PUMPING STATION REHABILITATION

DEMOLITION

DEMOLITION SECTION, DIAGRAM AND DETAILS

FILE: YBORD05

NO. **D5**

DATE JUNE 2011



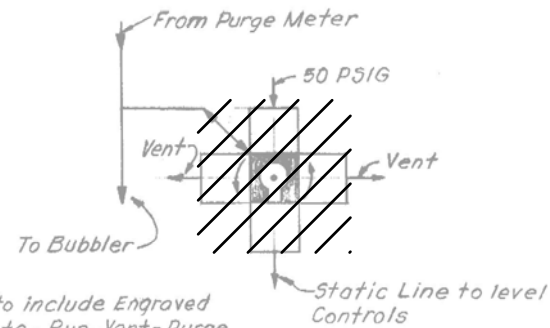


DIAGRAM – MANUAL AIR SWITCH

NOT TO SCALE

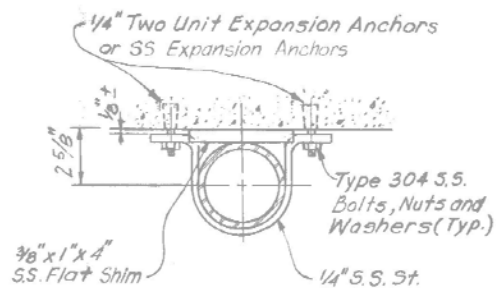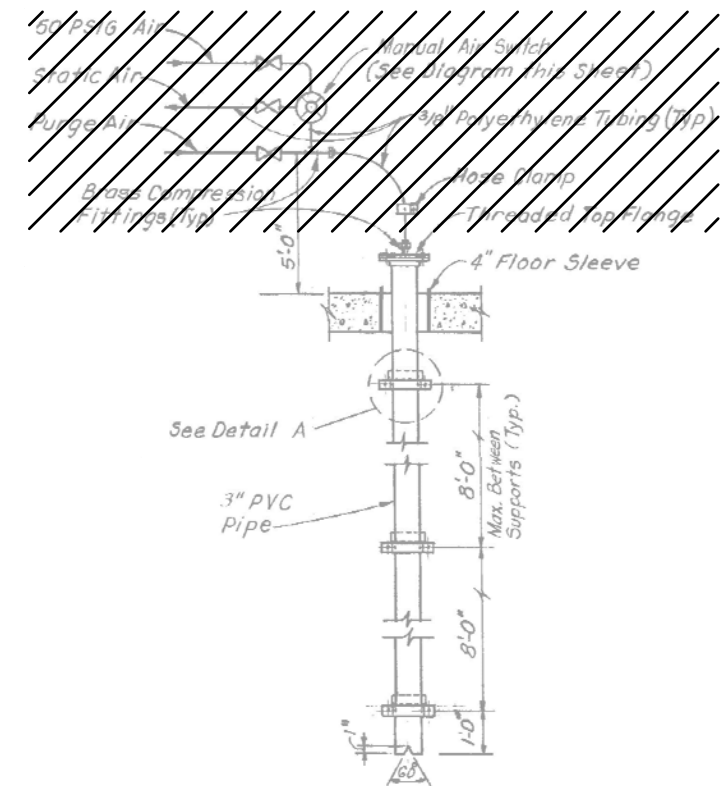

DETAIL A

NOT TO SCALE


DETAIL – BUBBLER TUBE


NOT TO SCALE

NOTES:

1. REMOVE EXISTING PIPE CONNECTING TO THE PVC BUBBLER TUBE AND SWITCH. PVC BUBBLER TUBE TO REMAIN.

D6, 6/10/2011 11:15:01 AM

 GREELEY AND HANSEN 1715 N. WESTSHORE BLVD., STE. 464 TAMPA, FLORIDA 33607 CERTIFICATE OF AUTHORIZATION NO. 37	NO SCALE					CITY OF TAMPA WASTEWATER DEPARTMENT YBOR PUMPING STATION REHABILITATION	FILE: YBORD05
		NO.	DATE	APPD	REVISION		
	DESIGNED FJB DRAWN JMW CHECKED DCH	P.E. NAME: DAVID C. HAGAN P.E. NO. 39163 P.E. NAME: _____ DATE: _____		DEMOLITION DEMOLITION DETAILS		NO. D6 DATE JUNE 2011	

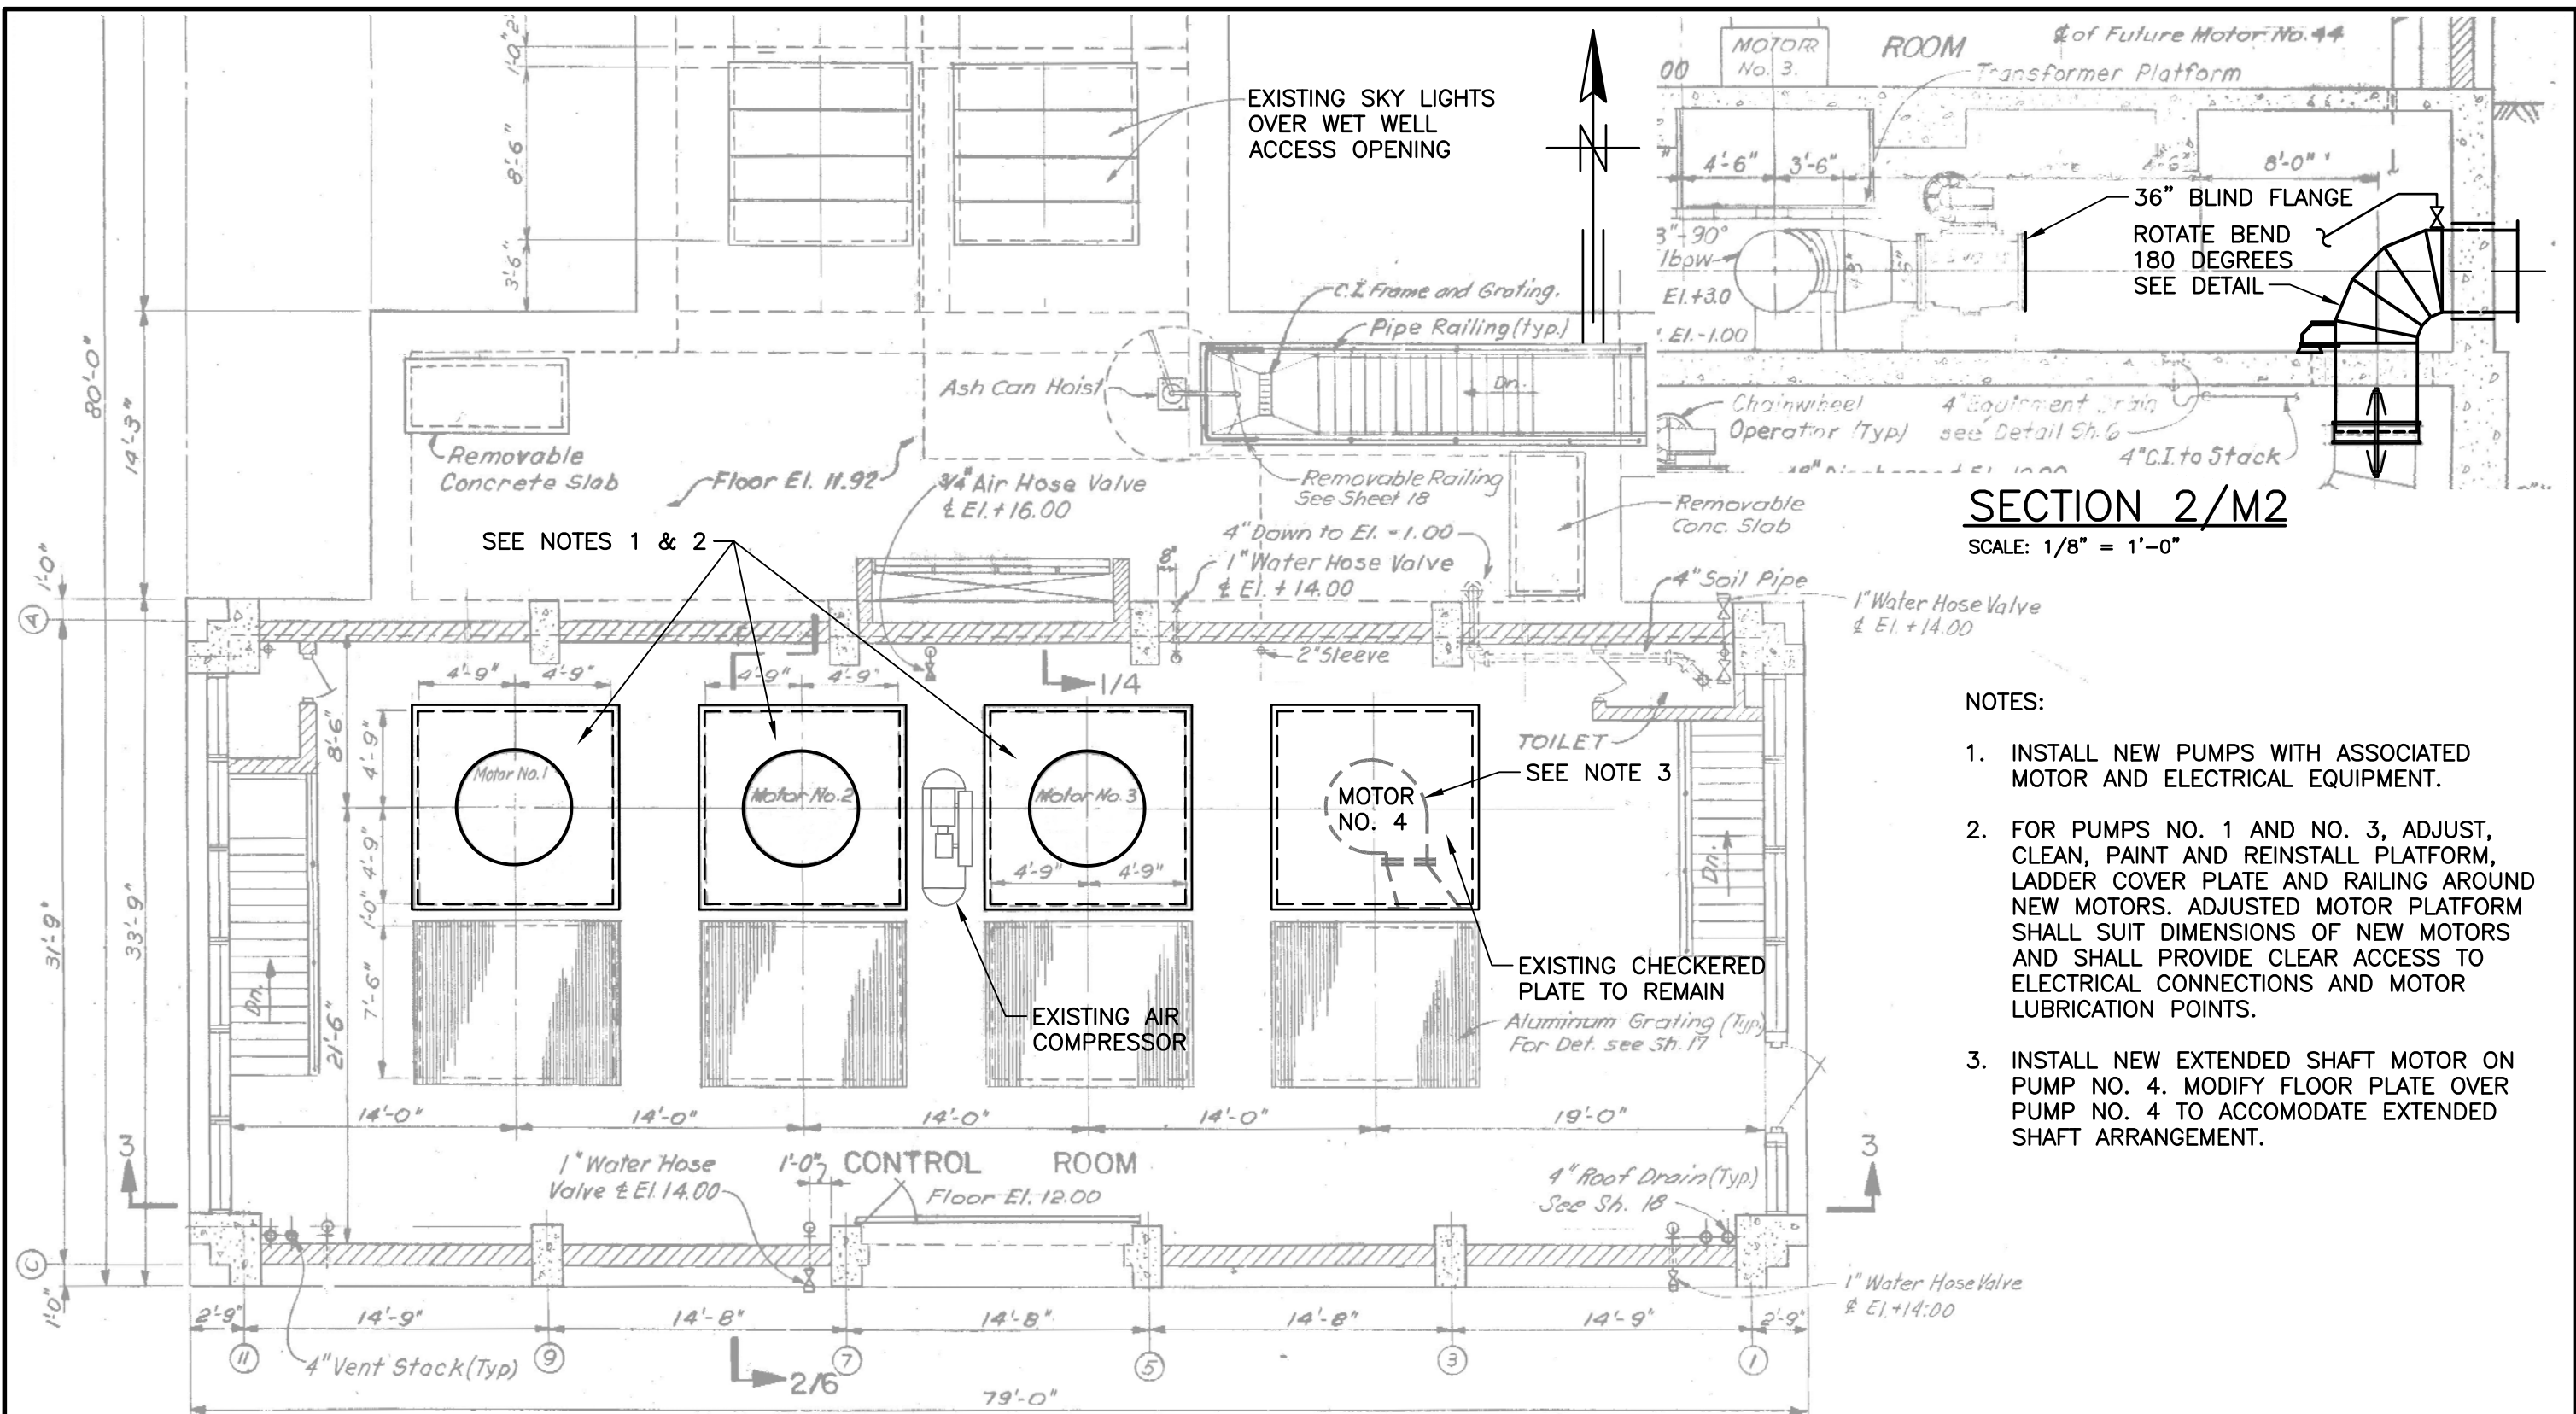


PIPING PLAN EL 12.0

SCALE: 1/8" = 1'-0"



GREELEY AND HANSEN

1715 N. WESTSHORE BLVD., STE. 464
TAMPA, FLORIDA 33607
CERTIFICATE OF AUTHORIZATION NO. 37

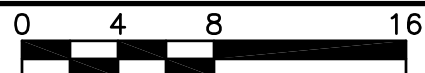

SCALE IN FEET

DESIGNED
DRAWN
CHECKED

FJB
JMW
DCH

NO.	DATE	APPD	REVISION

P.E. NAME: DAVID C. HAGAN P.E. NO. 39163
P.E. NAME: _____
DATE: _____

CITY OF TAMPA WASTEWATER DEPARTMENT
YBOR PUMPING STATION REHABILITATION


MECHANICAL

PIPING PLAN FL EL 12.00'

FILE: YBORM01

NO. **M1**


DATE JUNE 2011

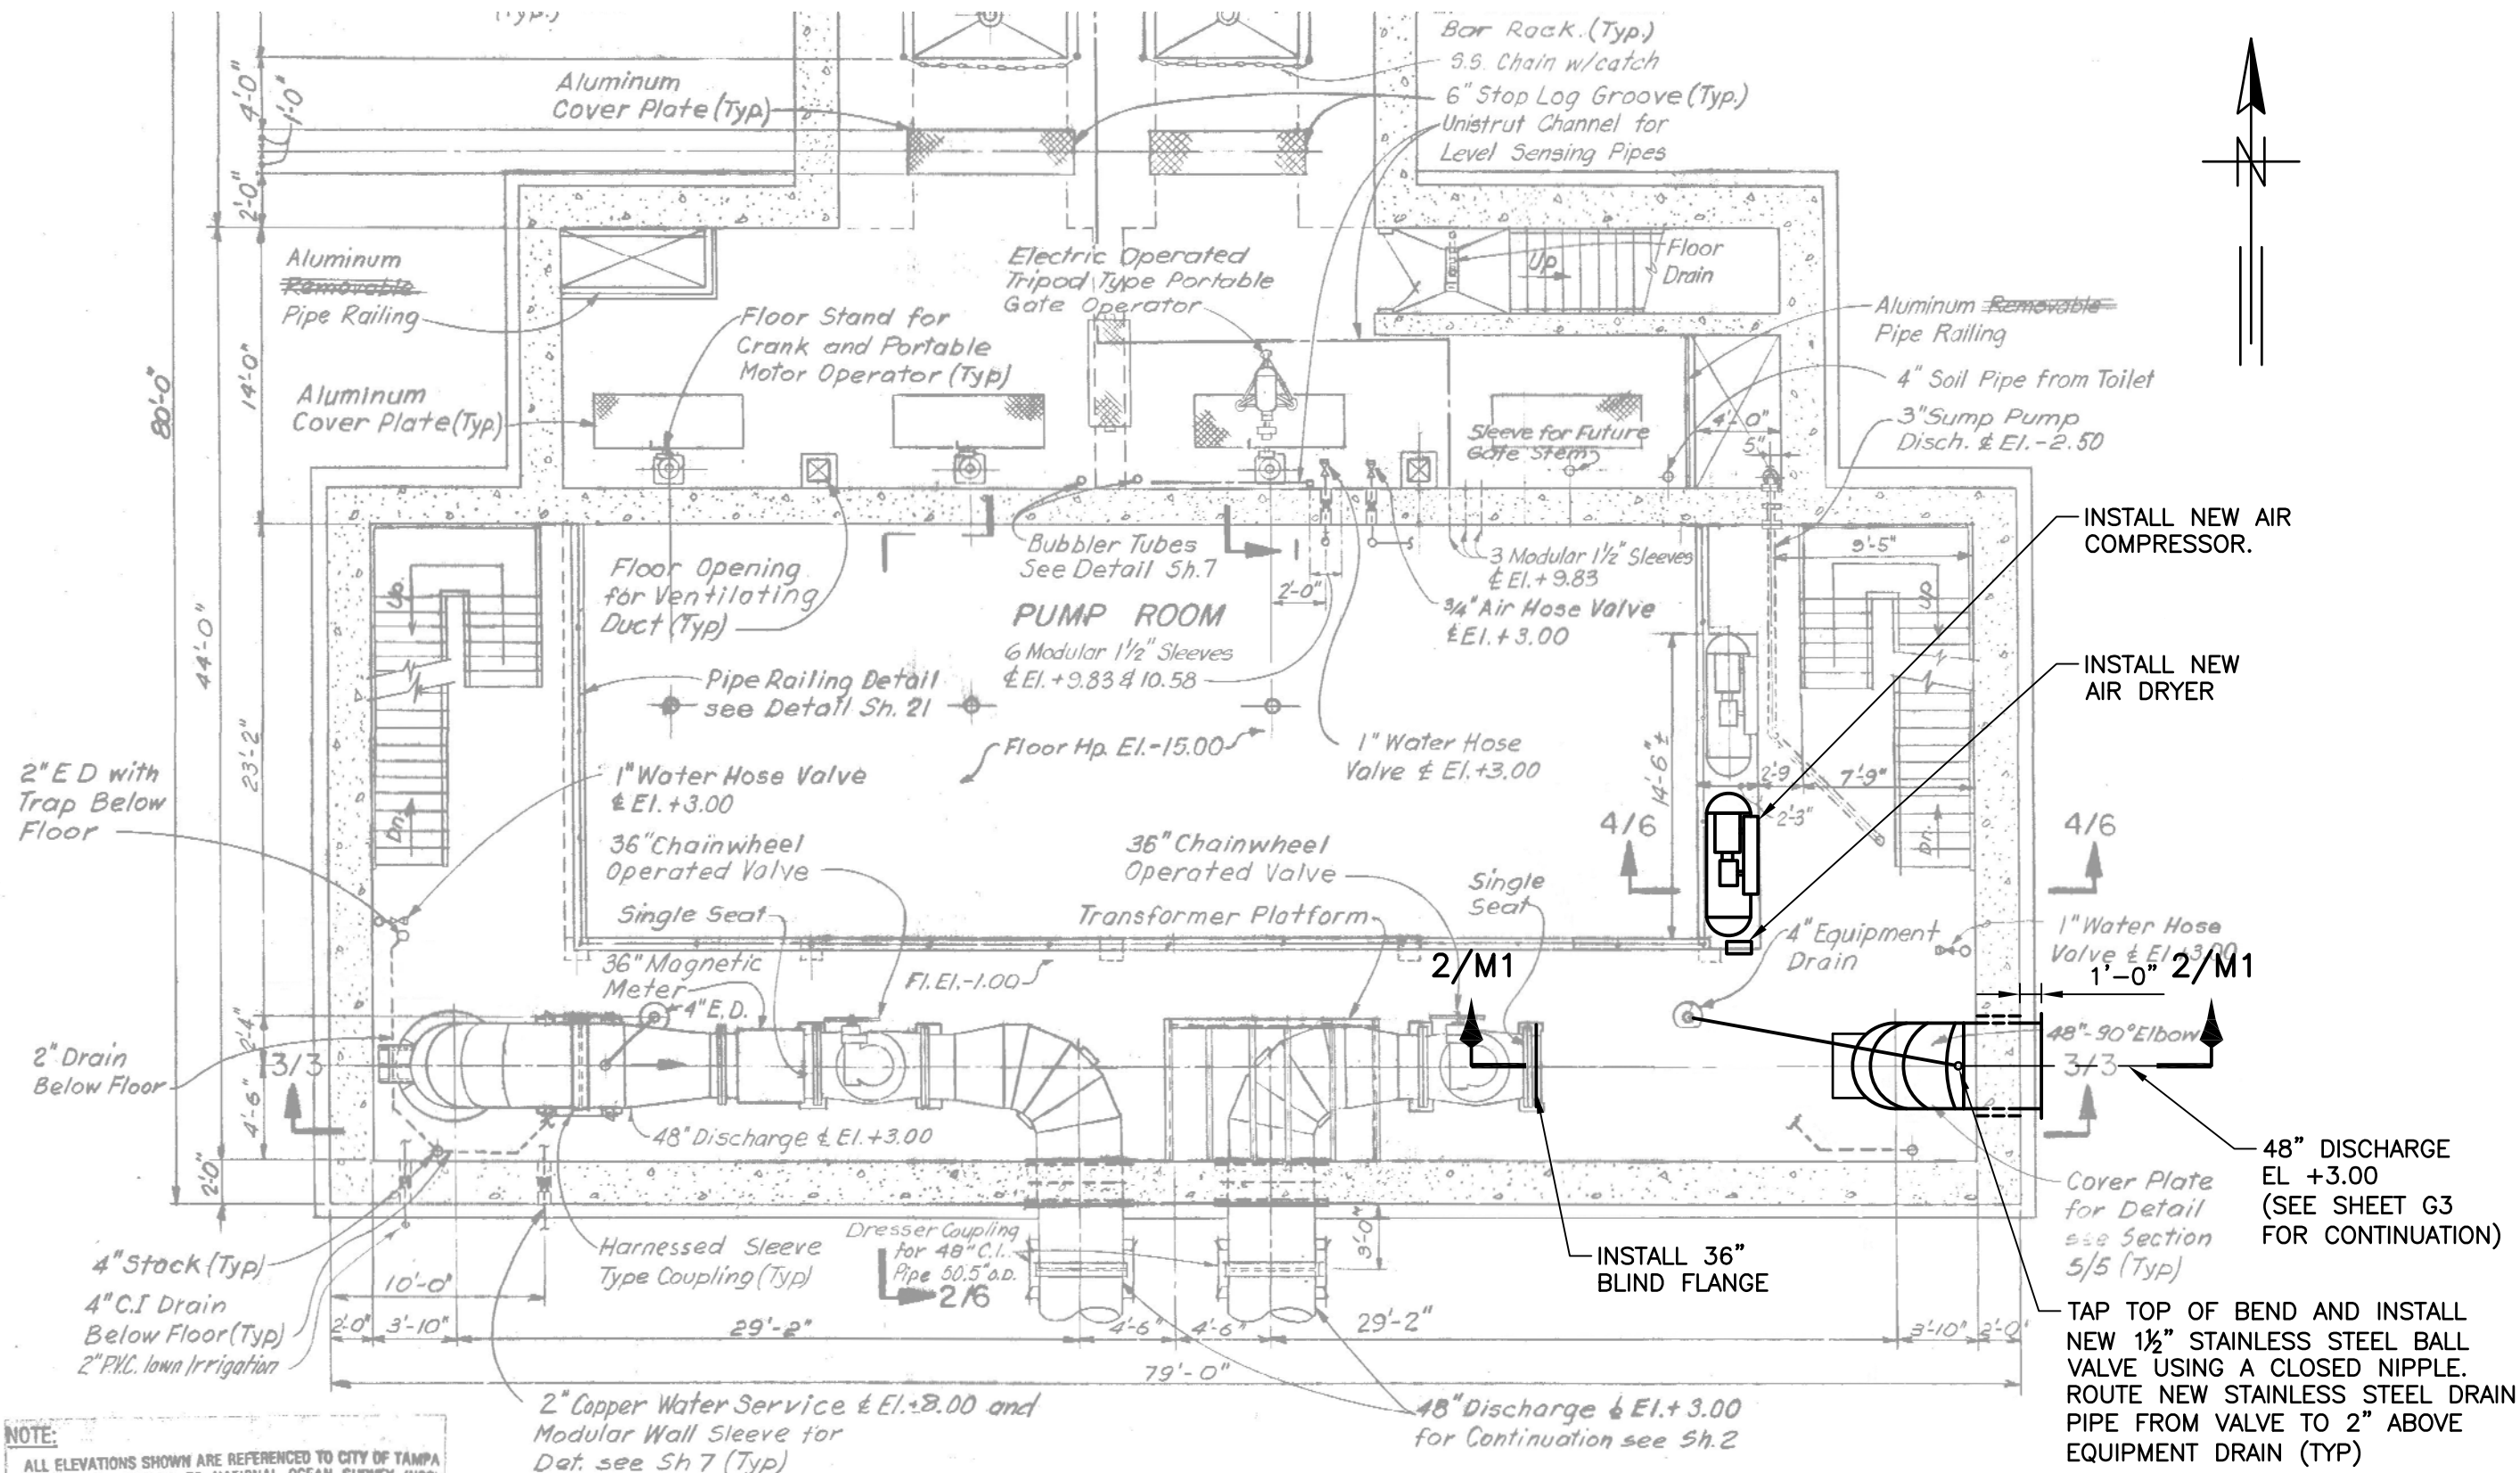

NOTE:
ALL ELEVATIONS SHOWN ARE REFERENCED TO CITY OF TAMPA
DATUM. TO CONVERT TO NATIONAL OCEAN SURVEY (NOS)
DATUM, SUBTRACT 0.15 FEET (0'-1 13/16").

PIPING SECTIONAL PLAN

SCALE: 1/8"=1'-0"

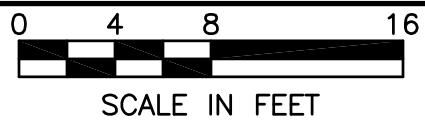

DESIGNED FJB
DRAWN JMW
CHECKED DCH

NO.	DATE	APPD	REVISION
P.E. NAME: DAVID C. HAGAN		P.E. NO. 39163	
P.E. NAME:			
DATE:			

CITY OF TAMPA WASTEWATER DEPARTMENT
YBOR PUMPING STATION REHABILITATION

MECHANICAL

PIPING PLAN – MEZANNINE


FILE: YBORM02

NO. **M2**


DATE JUNE 2011

M2_6/16/2011 2:10:18 PM

M4, 6/20/2011 5:21:33 PM

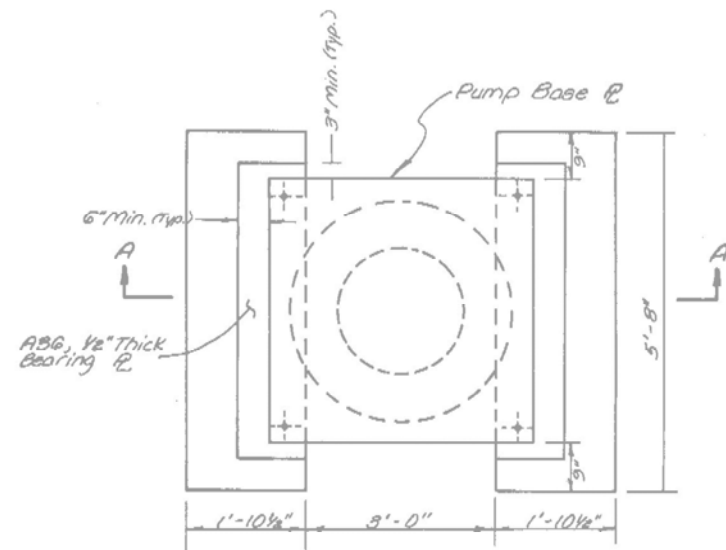

PLAN

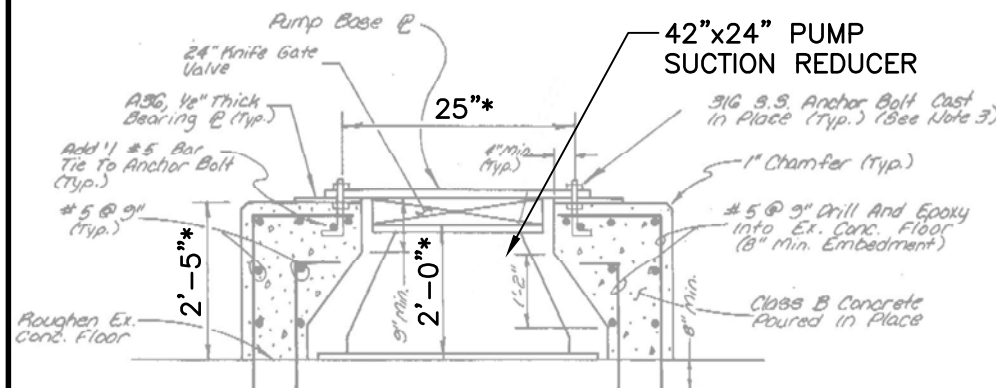

* FIELD VERIFY DIMENSIONS PRIOR TO FABRICATION. ADJUST DIMENSIONS IF NECESSARY TO ALIGN PUMP DISCHARGE.


SECTION A

PUMP PEDESTAL DETAIL

SCALE: 1/8" = 1'-0"


NOTES:

- ABOVE DETAIL SHOWS EXISTING ARRANGEMENT FOR PUMP NO. 4. USE SAME DETAIL FOR NEW PUMP PEDESTALS FOR PUMPS NO. 1, 2, AND 3.
- SIZE AND ALIGNMENT OF ANCHOR BOLTS SHALL BE AS RECOMMENDED BY PUMP MANUFACTURER.

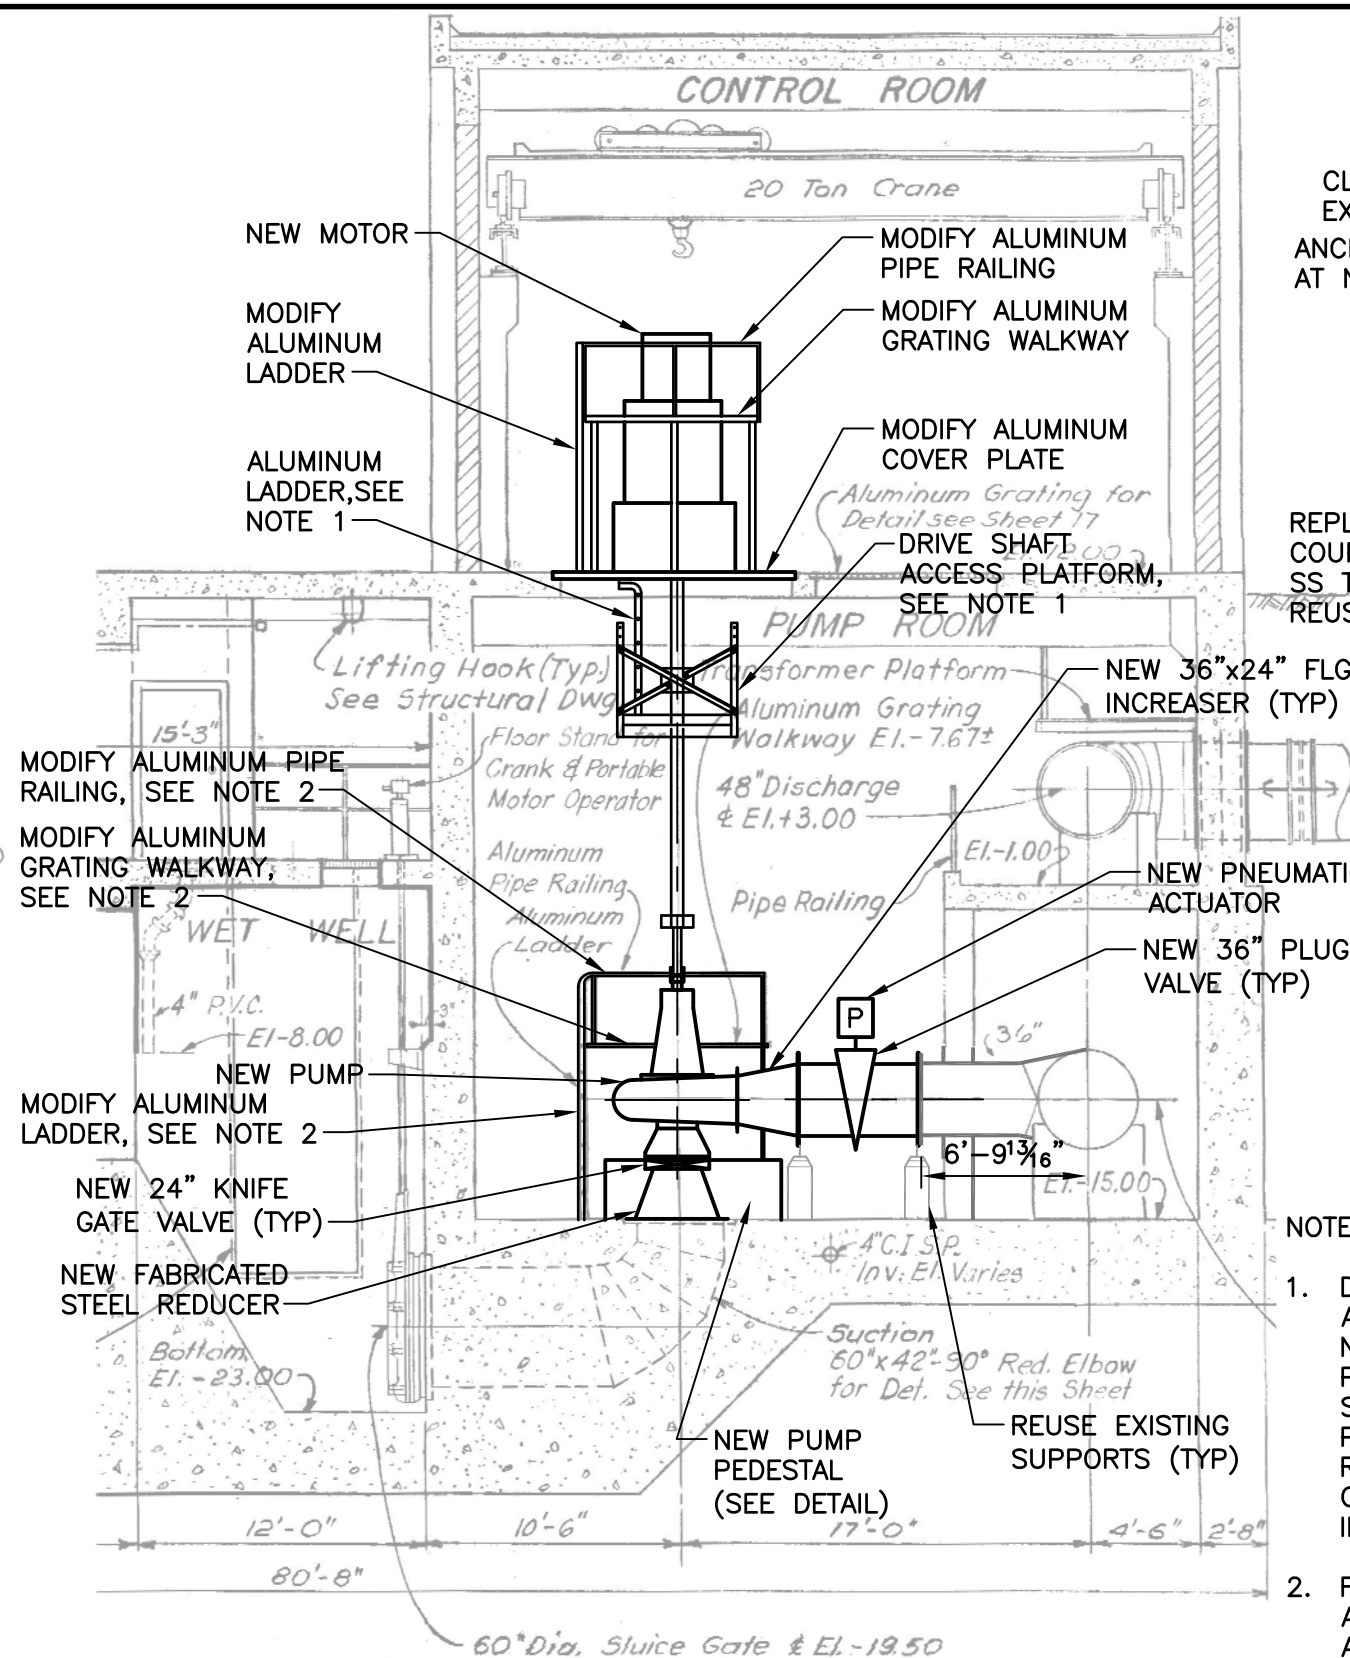

PIPING SECTION 1/M3

SCALE: 1/8" = 1'-0"

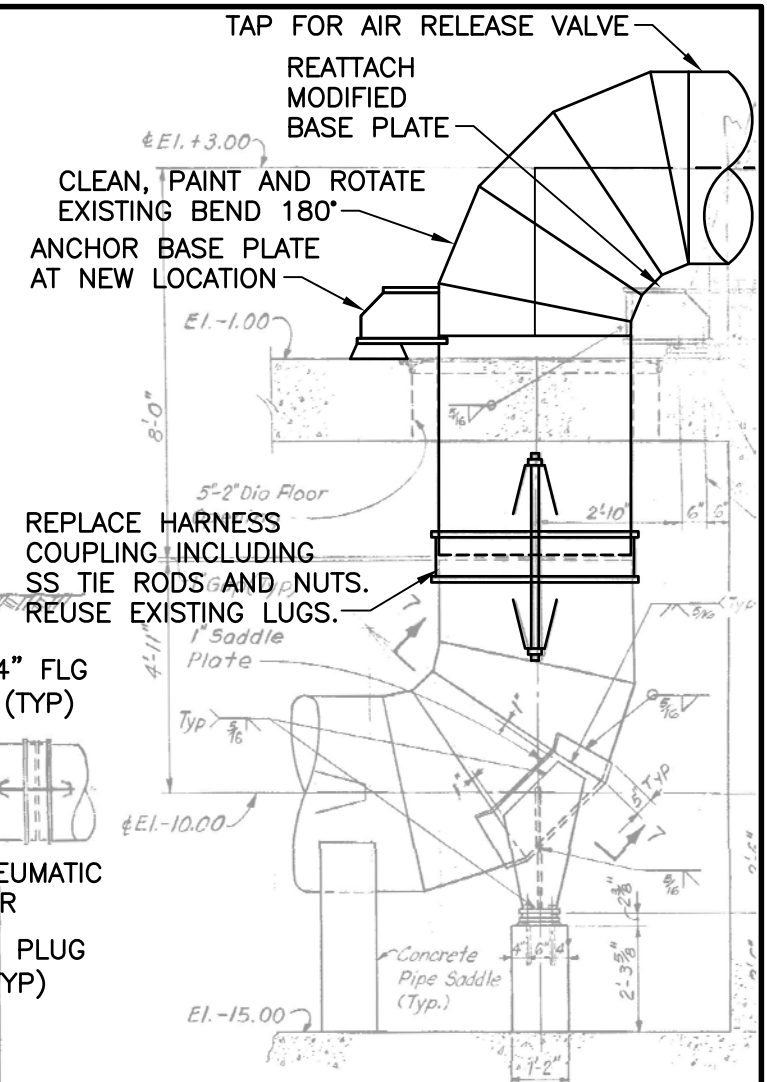

BEND ASSEMBLY DETAIL

SCALE: 1/4" = 1'-0"


NOTE:

- DESIGN FABRICATE AND INSTALL DRIVE SHAFT ACCESS PLATFORM AND LADDER FOR PUMP NO. 4. SIMILAR TO EXISTING PLATFORMS FOR PUMPS NO. 1, NO. 2 AND NO. 3. SUBMIT SHOP DRAWING SIGNED AND SEALED BY PROFESSIONAL STRUCTURAL ENGINEER REGISTERED IN FLORIDA. DESIGN SHALL CONFORM TO ALL APPLICABLE STANDARDS INCLUDING OSHA AND FLORIDA BUILDING CODE.
- FOR PUMPS NO. 1, NO. 2 AND NO. 3, ADJUST, CLEAN, PAINT AND REINSTALL PUMP ACCESS PLATFORMS. ADJUSTED PUMP ACCESS PLATFORMS SHALL SUIT DIMENSIONS OF NEW PUMPS AND SHALL PROVIDE CLEAR ACCESS TO NEW SEALS AND DRIVE SHAFT CONNECTIONS.



GREELEY AND HANSEN

1715 N. WESTSHORE BLVD., STE. 464
TAMPA, FLORIDA 33607
CERTIFICATE OF AUTHORIZATION NO. 37

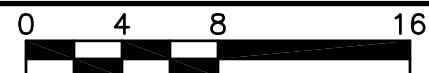

SCALE IN FEET

DESIGNED FJB
DRAWN JMW
CHECKED DCH

NO.	DATE	APPD	REVISION
P.E. NAME: DAVID C. HAGAN		P.E. NO. 39163	
P.E. NAME:			
DATE:			

CITY OF TAMPA WASTEWATER DEPARTMENT
YBOR PUMPING STATION REHABILITATION

MECHANICAL

PIPING SECTIONS AND DETAILS


FILE: YBORM04

NO. **M4**

DATE JUNE 2011

MECHANICAL NOTES.

- 1 - EXISTING THERMOSTAT TO BE REMOVED AND REPLACED WITH NEW.
- 2 - NEW THERMOSTAT EQUAL TO PECO MODEL TF115-001 AS DISTRIBUTED BY GRAINGER, ITEM NO. 4E636. NEMA 4X ENCLOSURE SUITABLE FOR LOCATIONS THAT ARE WET OR MILDLY CORROSIVE, WITH HIGH HUMIDITY OR AIRBORNE CONTAMINANTS.
- 3 - EXISTING THERMOSTAT TO BE REMOVED.
- 4 - NEW TEMPERATURE CONTROL PANEL.
- 5 - MOUNT THERMOSTAT ON WALL ABOVE EQUIPMENT. COORDINATE WITH ELECTRICAL INSTALLER FOR EXACT LOCATION.

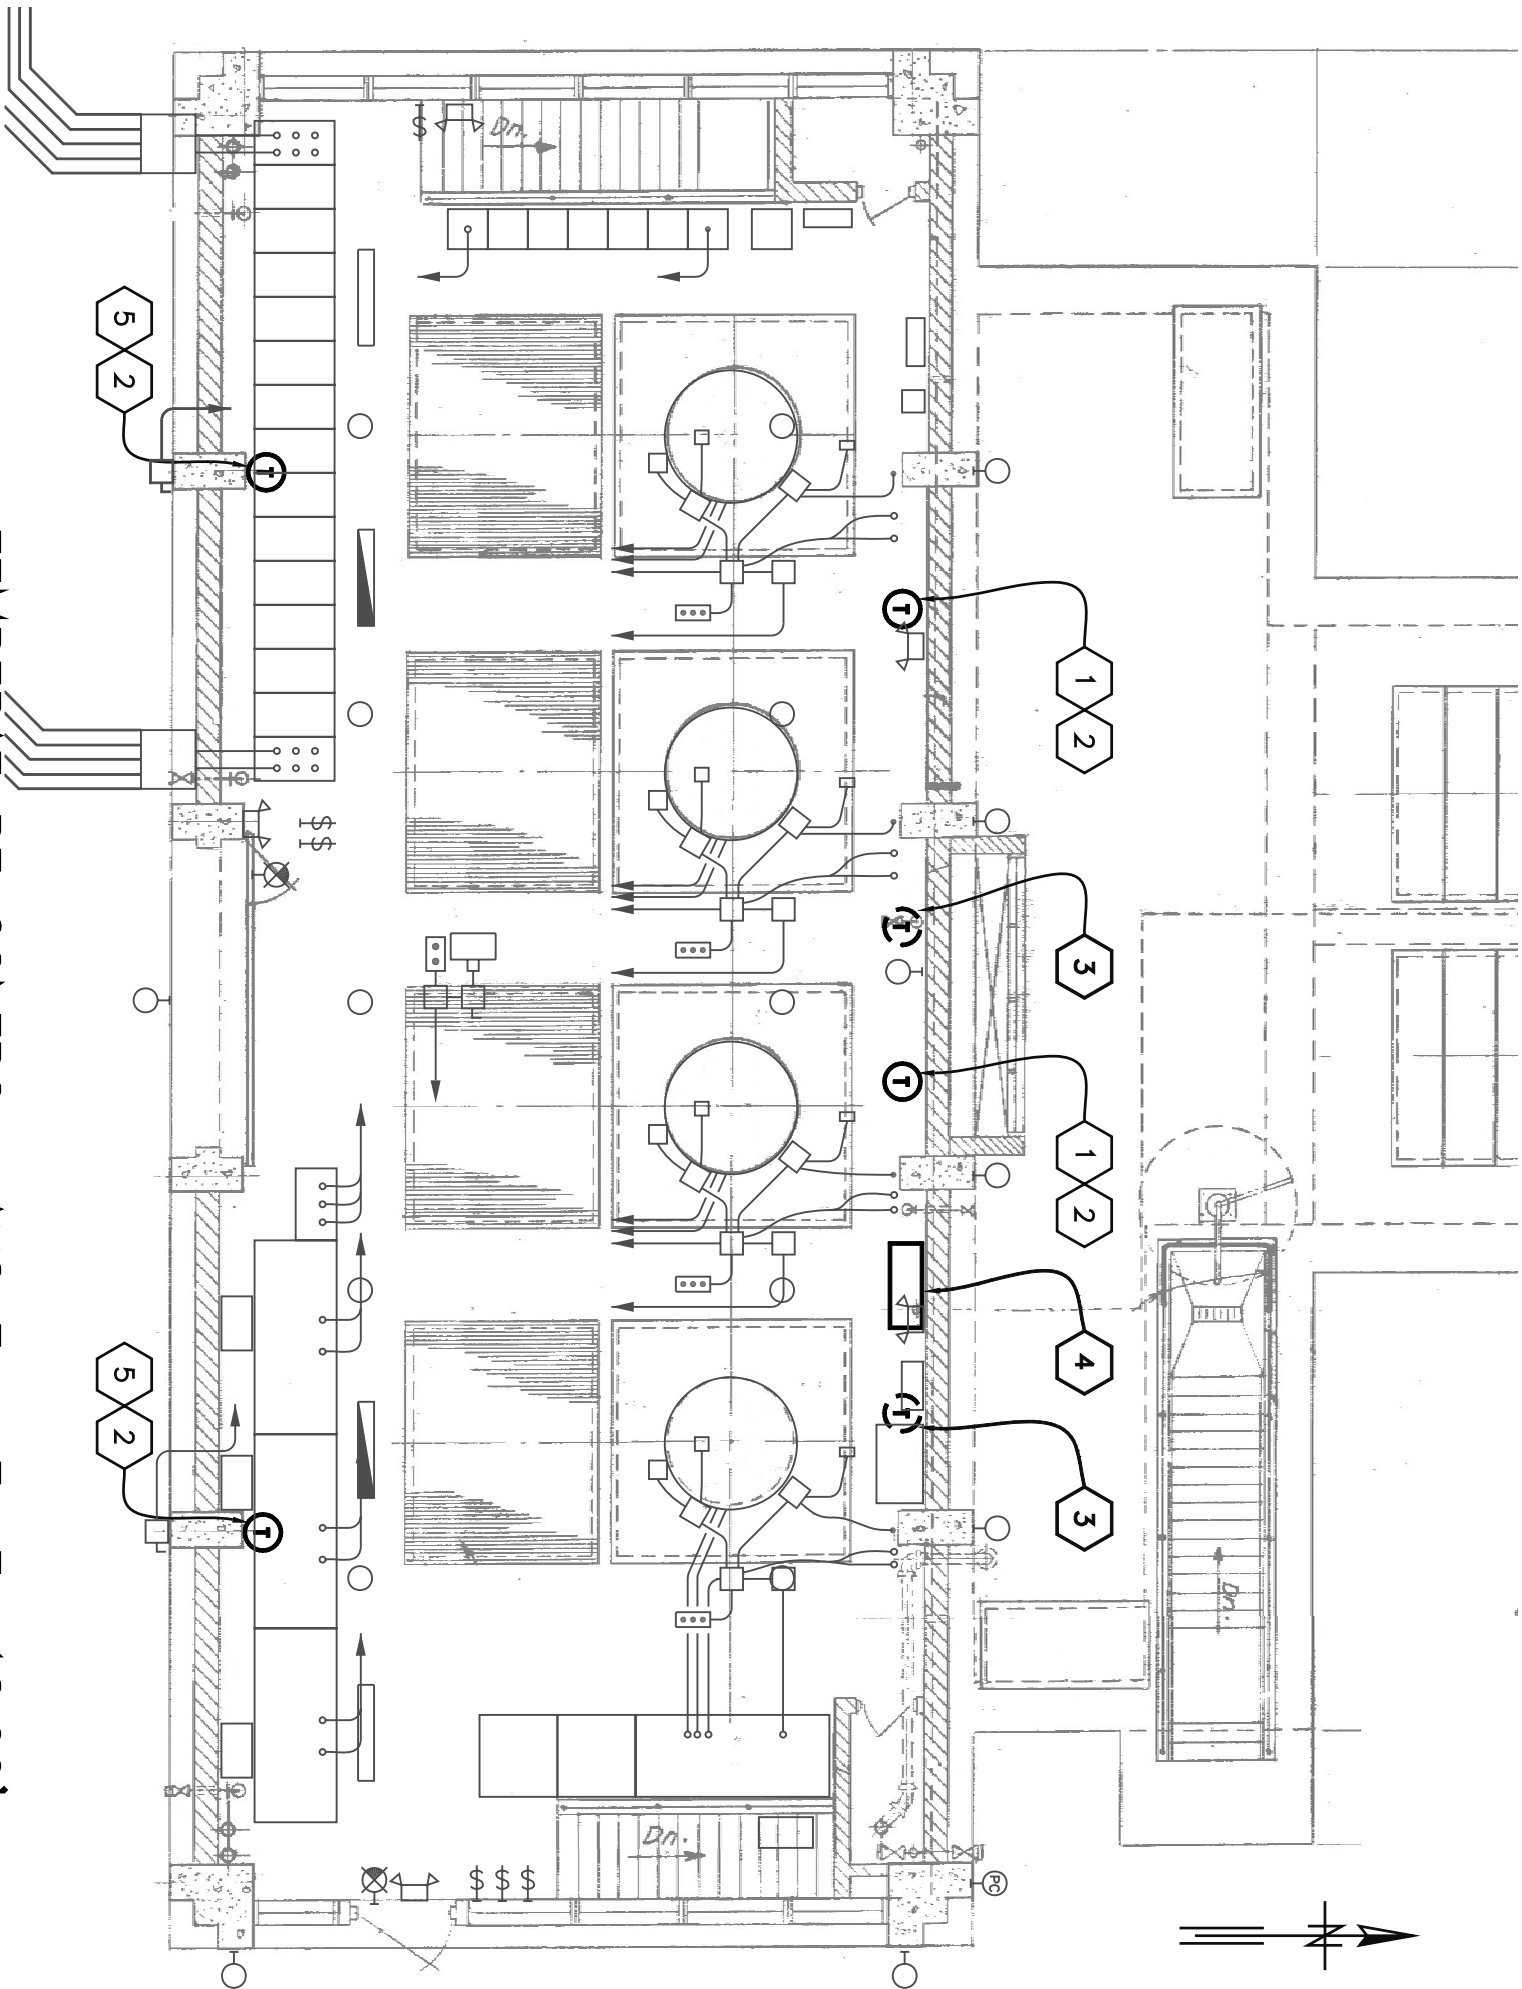

TEMPERATURE CONTROL LAYOUT – FL EL 12.00’

SCALE: 1/8" = 1'-0"

YBOR PUMPING STATION					
EXHAUST FANS SEQUENCE OF OPERATIONS					
<div>1. Each fan is to be provided with a Hand-Off-AUTO (HOA) selector switch installed in the motor control center.</div> <div>2. In the Hand (H) position fan runs continuously.</div> <div>3. In the Off (O) position fan is de-energized and off line</div> <div>4. In the Auto (A) position fan operation is controlled as hereinafter indicated.</div> <div>4.1 Two (2) fans run continuously to maintain Code required minimum exhaust air flow. refer to Table 1 for proposed run time sequence. Time for change over to adjustable (30 days/60 days or as desired).</div> <div>4.2 The other three (3) Stand By (SB) fans operate on/off on a signal from space thermostats. As space temperature rises above set point, fans are energized as required to maintain space temperature. Program initial set points for SB fans at 80°, 82°, and 84° respectively. Reverse sequence takes place in a drop in space temperature.</div> <div>4.3 All set points are adjustable and should automatically reset to default position upon restart after power failure.</div>					
TABLE 1					
EF-1	EF-2	EF-3	EF-5	EF-6	
RUN	RUN	SB	SB	SB	
SB	RUN	RUN	SB	SB	
SB	SB	RUN	RUN	SB	
SB	SB	SB	RUN	RUN	
RUN	SB	SB	SB	RUN	
EXISTING SUPPLY FAN SEQUENCE OF OPERATIONS					
<div>1. Fan shall run continuously.</div> <div>2. In a drop in space temperature, below minimum set point, the fan is de-energized.</div>					

A. J SANCHEZ

CONSULTING ENGINEERS INC.

3825 Henderson Blvd. – Suite 103

Tampa, Florida 33629

TEL: (813) 281-0001 FAX: (813) 281 – 9041

EMAIL: AJSCE@TAMPABAY.RR.COM

WWW.AJSCE.COM

EB0005016

GREELEY AND HANSEN

1715 N. WESTSHORE BLVD., STE. 464

TAMPA, FLORIDA 33607

CERTIFICATE OF AUTHORIZATION NO. 37

04816

SCALE IN FEET

DESIGNED

DRAWN

CHECKED

AJS

MH

AJS

NO.

DATE

APPD

P.E. NAME: ALBERTO J. SANCHEZ

FL. P.E. NO. 21368

REVISION

DATE

APPD

FILE:

YBOREE10

MECHANICAL

TEMPERATURE CONTROL LAYOUT – FL EL 12.00’

NO.

DATE

M5

JUNE 2011

ONE LINE AND SCHEMATIC DIAGRAM SYMBOLS			
SYMBOL	DESCRIPTION	SYMBOL	DESCRIPTION
	INCOMING FEEDER		OPERATING COIL (C-CONTACTOR, F-FAST, F-FORWARD, H-HIGH, L-LOW, M-MOTOR STARTER, R-REVERSE, S-SLOW)
	OUTGOING FEEDER		RELAY COIL (AR-AUXILIARY RELAY, CR-CONTROL RELAY, LOR-LOCKOUT RELAY, TR-TIME DELAY RELAY WHERE 'XX' DENOTES RELAY FUNCTION OR NUMBER)
	CONDUCTORS CONNECTED		NORMALLY OPEN CONTACT
	GROUNDING CONNECTION		NORMALLY CLOSED CONTACT
	LIGHTNING OR SURGE ARRESTOR		OVERLOAD RELAY CONTACT
	RECTIFIER OR DIODE		NORMALLY OPEN (SHOWN) OR NORMALLY CLOSED RESET TIMER CONTACT (X-X-O - DENOTES TIMER SEQUENCE FOR RESET-TIMING-TIMED OUT PERIODS. X INDICATES CONTACT CLOSED)
	SURGE CAPACITOR		NORMALLY OPEN CONTACT WITH TIME DELAY CLOSING (ON DELAY)
	POWER TRANSFORMER		NORMALLY CLOSED CONTACT WITH TIME DELAY CLOSING (OFF DELAY)
	CONTROL POWER TRANSFORMER		NORMALLY CLOSED CONTACT WITH TIME DELAY OPENING (ON DELAY)
	CURRENT TRANSFORMER (NUMBER DENOTES QUANTITY REQUIRED)		NORMALLY OPEN CONTACT WITH TIME DELAY OPENING (OFF DELAY)
	CURRENT TRANSFORMER 3 PHASE WINDOW TYPE		LIMIT SWITCH
	POTENTIAL TRANSFORMER (NUMBER DENOTES QUANTITY REQUIRED)		FLOAT SWITCH
	MEDIUM VOLTAGE DRAWOUT TYPE CIRCUIT BREAKER		PRESSURE OR VACUUM SWITCH
	DISCONNECTING OR DRAWOUT DEVICE		FLOW SWITCH
	LOW VOLTAGE AIR CIRCUIT BREAKER WITH 100A TRIP		TEMPERATURE SWITCH
	LOW VOLTAGE AIR CIRCUIT BREAKER 225A FRAME AND 125A TRIP		TORQUE SWITCH
	LOW VOLTAGE AIR CIRCUIT BREAKER WITH COORDINATED CURRENT LIMITING FUSES - 225A FRAME AND 150A TRIP		LATCHING RELAY WITH CLEARING CONTACTS
	KEY INTERLOCK - DASHED LINE WITH ARROWS INDICATES MOVEMENT OF KEY DURING INTERLOCK PROCEDURE		SELECTOR SWITCH
	FULL VOLTAGE MAGNETIC COMBINATION STARTER WITH MOTOR CIRCUIT PROTECTOR, CONTROL TRANSFORMER AND OVERLOAD RELAYS (M - OPERATING COIL)		NORMALLY OPEN PUSHBUTTON
	FULL VOLTAGE MAGNETIC COMBINATION REVERSING STARTER WITH MOTOR CIRCUIT PROTECTOR, CONTROL TRANSFORMER AND OVERLOAD RELAYS (F - FORWARD, R - REVERSE)		NORMALLY CLOSED PUSHBUTTON
	FULL VOLTAGE MAGNETIC COMBINATION TWO SPEED STARTER WITH MOTOR CIRCUIT PROTECTOR, CONTROL TRANSFORMER AND OVERLOAD RELAYS (H - HIGH, L - LOW, F - FAST, S - SLOW)		PUSHBUTTON STATION (ONE, TWO OR THREE UNIT)
	REDUCED VOLTAGE MAGNETIC COMBINATION AUTOTRANSFORMER STARTER WITH MOTOR CIRCUIT PROTECTOR, CONTROL TRANSFORMER AND OVERLOAD RELAYS (R - RUN, TR - TIMER, 1S & 2S - TRANSITION)		INDICATING LIGHT (A-AMBER, B-BLUE, G-GREEN, R-RED, W-WHITE)
	SOLID STATE REDUCED VOLTAGE COMBINATION STARTER WITH MOTOR CIRCUIT PROTECTOR AND CONTROL TRANSFORMER		THERMAL OVERLOAD ELEMENT (OL)
	MOTOR - THREE PHASE (NUMBER DENOTES HORSEPOWER)		ON-OFF SWITCH
			RESISTOR
			FUSE
			BATTERY
			HEATING ELEMENT
			MAINTAINED CONTACT PUSHBUTTON WITH MUSHROOM HEAD OPERATOR
			SELECTOR SWITCH X INDICATES CONTACT CLOSED IN CORRESPONDING SWITCH POSITION
			CURRENT SENSOR TRIP SWITCH

PROTECTIVE RELAYS:	
25	SYNCHRONIZING CHECK
27	UNDERVOLTAGE
32	REVERSE POWER
43	SELECTOR SWITCH
47	PHASE SEQUENCE
48	THERMAL
50	INSTANTANEOUS OVERCURRENT
51	AC TIME OVERCURRENT
52	AC CIRCUIT BREAKER
58	OVERVOLTAGE
60	VOLTAGE OR CURRENT BALANCE
62	TIME DELAY
64	GROUND
67	DIRECTIONAL OVERCURRENT
68	LOCKOUT
67	DIFFERENTIAL CURRENT
DBX	DEAD BUS AUXILIARY
G	DEVICE IN GROUND CIRCUIT
GSR	GROUND SENSING
IR	INTERPOSING
LOR	LOCKOUT
N	DEVICE IN NEUTRAL CIRCUIT
PSR	PHASE SENSING
X	AUXILIARY
CONTROL DEVICES:	
DP	DIFFERENTIAL PRESSURE SWITCH
F	FLOAT SWITCH
FL	FLOW SWITCH
LL	LEVEL SWITCH
LS	LIMIT SWITCH
P	PRESSURE SWITCH
RDS	REVERSING DRUM SWITCH
ST	SHUNT TRIP
S	SOLENOID VALVE
T	THERMOSTAT
TQ	TORQUE SWITCH
T	TEMPERATURE SWITCH
VIB	VIBRATION SWITCH
V	VACUUM SWITCH
XS	TAMPER SWITCH
METER, INSTRUMENT OR INSTRUMENT SWITCHES:	
A	AMMETER
AS	AMMETER SWITCH
AT	CURRENT TRANSDUCER
CS	BREAKER CONTROL SWITCH
DT	DUTY TRANSFER SWITCH
MMS	MICROPROCESSOR METERING SYSTEM
MPR	MICROPROCESSOR PROTECTION RELAY
MSH	MOTOR SPACE HEATER
PF	POWER FACTOR METER
POT	POTENTIOMETER
SI	SPEED INDICATOR
SS	SELECTOR SWITCH
TM	ELAPSED TIME METER
TMR	TIMER
V	VOLTMETER
VAR	VARIOMETER
VARV	VARS TRANSDUCER
VS	VOLTMETER SWITCH
V	VOLTAGE TRANSDUCER
W	WATTMETER
WH	WATTHOUR METER
WHD	WATTHOUR DEMAND METER
WT	WATTS TRANSDUCER
ZT	POSITION TRANSMITTER
ABBREVIATIONS	
AFF	ABOVE FINISHED FLOOR
ATS	AUTOMATIC TRANSFER SWITCH
BKR	BREAKER
BOB	BOTTOM OF DUCT
CKT	CIRCUIT
DP	DISTRIBUTION PANELBOARD
DTC	DATA TERMINAL CABINET
GND	GROUND
GRS	GALVANIZED RIGID STEEL
HH	HAND HOLE
JB	JUNCTION BOX
LCP	LIGHTING CONTROL PANEL
LP	LIGHTING PANELBOARD
LT	LIGHTING TRANSFORMER
MCC	MOTOR CONTROL CENTER
MH	MAN HOLE
MH	MOUNTING HEIGHT
PB	PULL BOX
PLC	PROGRAMMABLE LOGIC CONTROLLER
PVC	POLYVINYL CHLORIDE
RTU	REMOTE TERMINAL UNIT
SP	SPACE
TB	TERMINAL BOX
TCP	TEMPERATURE CONTROL PANEL
TTC	TELEPHONE TERMINAL CABINET
WP	WEATHERPROOF
XP	EXPLOSION-PROOF
RBCP	REMOTE BREAKER CONTROL PANEL

POWER, LIGHTING AND MISCELLANEOUS PLAN SYMBOLS			
SYMBOL	DESCRIPTION	SYMBOL	DESCRIPTION
	EXPOSED CONDUIT RUN		WALL OR CEILING MOUNTED INCANDESCENT OR HID LIGHTING FIXTURE UPPER LETTER DENOTES FIXTURE TYPE NUMBER DENOTES CIRCUIT NUMBER AND LETTER DENOTES SWITCH CONTROLLING FIXTURE
	CONCEALED CONDUIT RUN ABOVE CEILING OR IN WALLS		EMERGENCY LIGHTING FIXTURE
	CONCEALED CONDUIT RUN IN OR BELOW FLOOR SLAB		WALL OR CEILING MOUNTED EXIT OR DIRECTIONAL SIGN (SHADED SIDE DENOTES ILLUMINATED FACE ARROW INDICATES DIRECTION)
	UNDERGROUND CONDUIT (CONCRETE ENCASED)		POLE MOUNTED LIGHTING FIXTURE
	UNDERGROUND CONDUIT (DIRECT BURIED)		FLOODLIGHT
	UNDERGROUND CABLE (DIRECT BURIED)		FLUORESCENT STRIP LIGHTING FIXTURE
	CONDUIT CAPPED		FLUORESCENT LIGHTING FIXTURE
	CONDUIT UP		EMERGENCY FLUORESCENT LIGHTING FIXTURE
	CONDUIT DOWN		REMOTE TEST PUSHBUTTON AND "ON" INDICATING LIGHT FOR BATTERY EQUIPPED LIGHTING FIXTURES
	CONDUIT WITH HOT, NEUTRAL AND GROUND WIRES (LONG LINE DENOTES NEUTRAL; LONG LINE WITH DOT DENOTES GROUND)		EMERGENCY BATTERY PACK WITH TWO LIGHTING HEADS
	HOME RUN TO LIGHTING PANELBOARD (LP# INDICATES PANELBOARD AND 1,3,5 INDICATES CIRCUITS 1, 3 AND 5)		EMERGENCY BATTERY PACK - REMOTE HEAD
	FLEXIBLE CONDUIT OR CABLE		PHOTOELECTRIC CELL
	GROUNDING CONDUCTOR		SINGLE RECEPTACLE
	NEUTRAL CONDUCTOR		2 POLE, 3 WIRE, 120 VOLT, 20A, OR AS NOTED
	EQUIPMENT ENCLOSURE AS INDICATED ON PLAN		DUPLEX RECEPTACLE
	LIGHTING PANELBOARD 208Y/120V OR 120/240V		DUPLEX RECEPTACLE
	LIGHTING PANELBOARD 480Y/277V		FLOOR OUTLET BOX WITH DUPLEX RECEPTACLE
	DRY TYPE TRANSFORMER		2 POLE, 3 WIRE, 120 VOLT, 20A, OR AS NOTED
	JUNCTION BOX, PULL BOX OR TERMINAL BOX		SINGLE RECEPTACLE - SINGLE PHASE (RATING AS NOTED)
	MANUALLY OPERATED DISCONNECTING CIRCUIT BREAKER OR SWITCH (SEE SPECIFICATIONS)		SINGLE RECEPTACLE - THREE PHASE (RATING AS NOTED)
	MANUAL REVERSING DRUM SWITCH, FORWARD-OFF-REVERSE, MAINTAINED CONTACTS		CLOCK WITH RECEPTACLE
	FULL VOLTAGE MAGNETIC STARTER OR CONTACTOR		SINGLE POLE SWITCH UNLESS NOTED OTHERWISE
	COMBINATION CIRCUIT BREAKER STARTER		2P - TWO POLE
	MOTOR - THREE PHASE		MS - MOTOR STARTING
	MOTOR - SINGLE PHASE		3 - THREE WAY
	MOTOR OPERATED VALVE OR SLUICE GATE WITH INTEGRAL CONTROLLER AND CONTROL STATION		PL - WITH PILOT LIGHT
	CONTROL STATION (SEE SCHEMATIC DIAGRAMS FOR ASSOCIATED DEVICES)		4 - FOUR WAY
	CONTROL STATION AND FIELD CONTROL DEVICES (SEE ONE LINE DIAGRAMS AND SCHEMATICS FOR DETAILS)		D - DOOR SWITCH
	GROUND ROD		M - MOMENTARY CONTACT
	GROUND ROD WITH ACCESS BOX		INTERCOM TELEPHONE OUTLET
	LIGHTNING ROD		INTERCOM TELEPHONE FLOOR OUTLET
	METER SOCKET		PUBLIC TELEPHONE OUTLET
	WATER HEATER		PUBLIC TELEPHONE FLOOR OUTLET
	UNIT HEATER		SPEAKER
	LIGHT LINE DENOTES EXISTING WORK		BI-DIRECTIONAL SPEAKER
	HEAVY LINE DENOTES NEW WORK		INTERCOMMUNICATION SPEAKER
	WORK TO BE DEMOLISHED		INTERCOMMUNICATION SPEAKER VOLUME CONTROL
			CLOSED CIRCUIT TELEVISION CAMERA
			ALARM HORN
			ALARM BELL
			FIRE ALARM CONTROL PANEL
			FIRE ALARM ANNUNCIATOR PANEL
			MANUAL PULL STATION
			SMOKE DETECTOR
			HEAT DETECTOR
			PHOTOELECTRIC BEAM SMOKE DETECTOR TRANSMITTER
			PHOTOELECTRIC BEAM SMOKE DETECTOR RECEIVER
			AUDIBLE/VISUAL INDICATING DEVICE WITH HORN
			AUDIBLE/VISUAL INDICATING DEVICE WITH BELL
			VISUAL INDICATING DEVICE
			SPRINKLER SYSTEM FLOW SWITCH
			SPRINKLER SYSTEM TAMPER SWITCH
			MAGNETIC DOOR SWITCH
			PASSIVE INFRARED MOTION DETECTOR
			INFRARED BEAM MOTION DETECTION TRANSMITTER
			INFRARED BEAM MOTION DETECTION RECEIVER

NOTE:
THIS IS A GENERAL LEGEND PROVIDED TO FACILITATE USE OF THE ELECTRICAL DRAWINGS.
ALL SYMBOLS MAY NOT BE USED IN THIS SET OF ELECTRICAL DRAWINGS.
REFER TO THE DRAWINGS AND SPECIFICATIONS FOR ITEMS REQUIRED.



GREELEY AND HANSEN

1715 N. WESTSHORE BLVD., STE. 464
TAMPA, FLORIDA 33607
CERTIFICATE OF AUTHORIZATION NO. 37

NO SCALE

DESIGNED RZ
DRAWN TT
CHECKED DD

NO.	DATE	APPD	REVISION

P.E. NAME: NORBERT VIRANYI P.E. NO. 72587
P.E. NAME: _____
DATE: _____

CITY OF TAMPA WASTEWATER DEPARTMENT
YBOR PUMPING STATION REHABILITATION

ELECTRICAL


LEGEND AND SYMBOLS

FILE: YBOREE01





NO. E1

DATE JUNE 2011


FILE: YBOREE02 1:1 06/21/11 07:18 GH-A

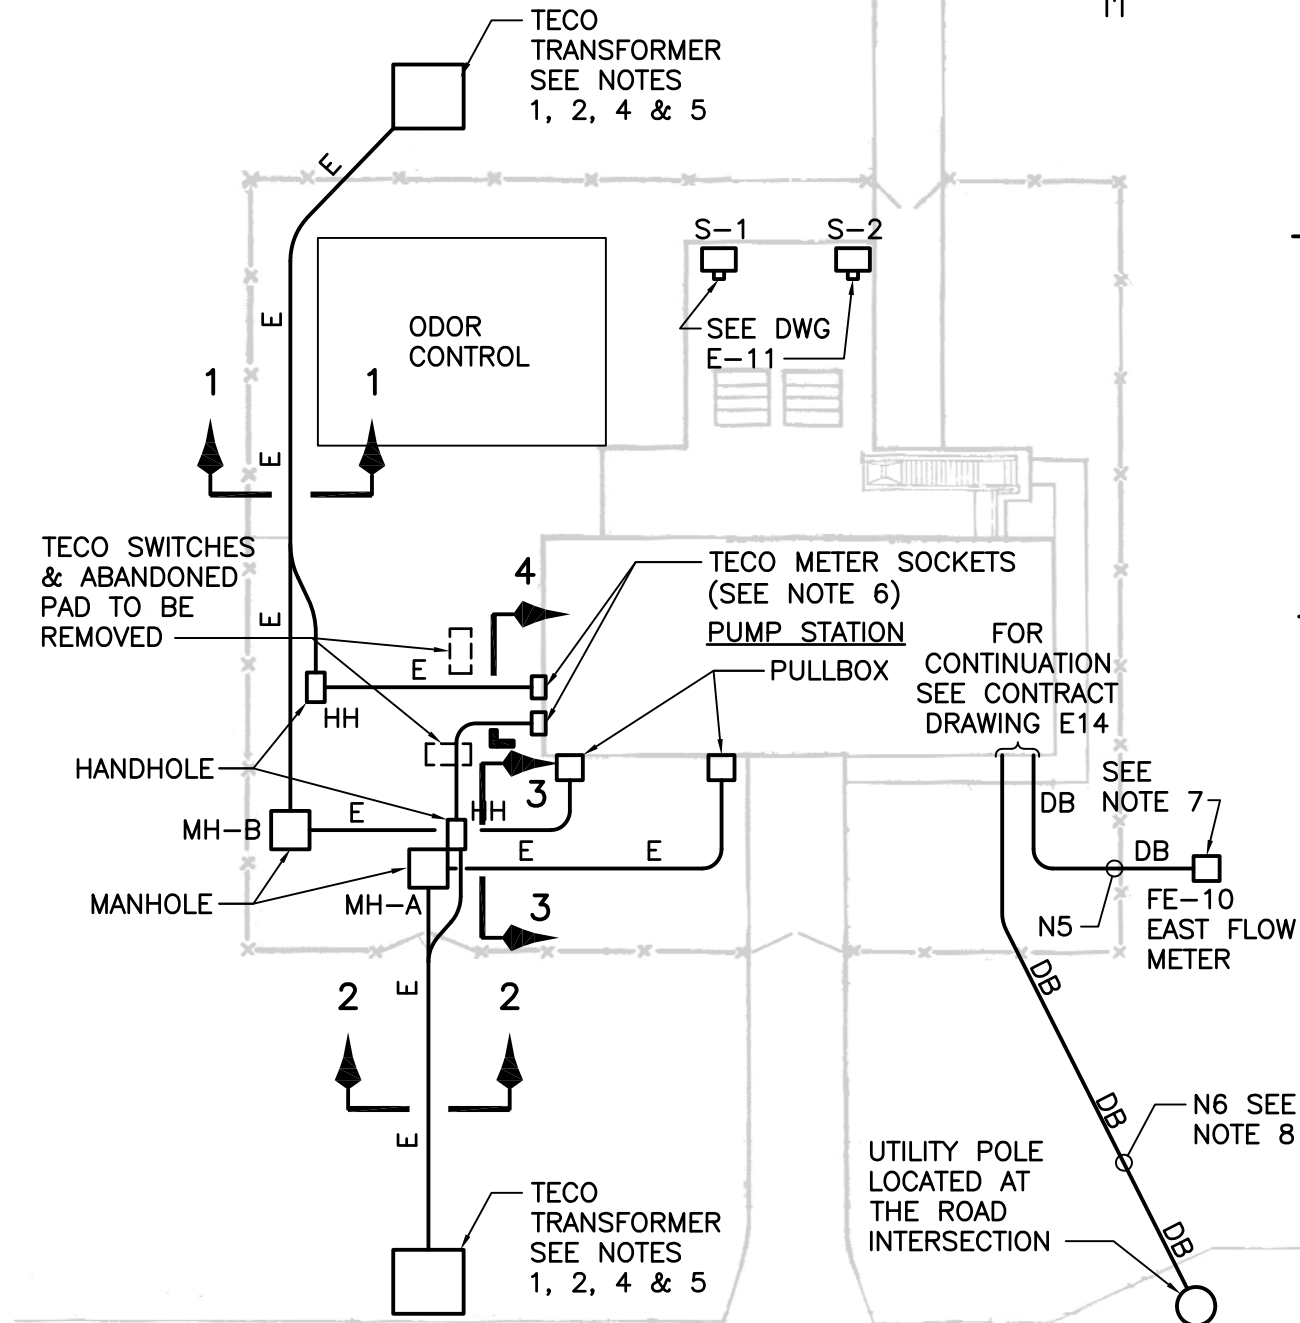

SITE PLAN
SCALE: 1" = 30'

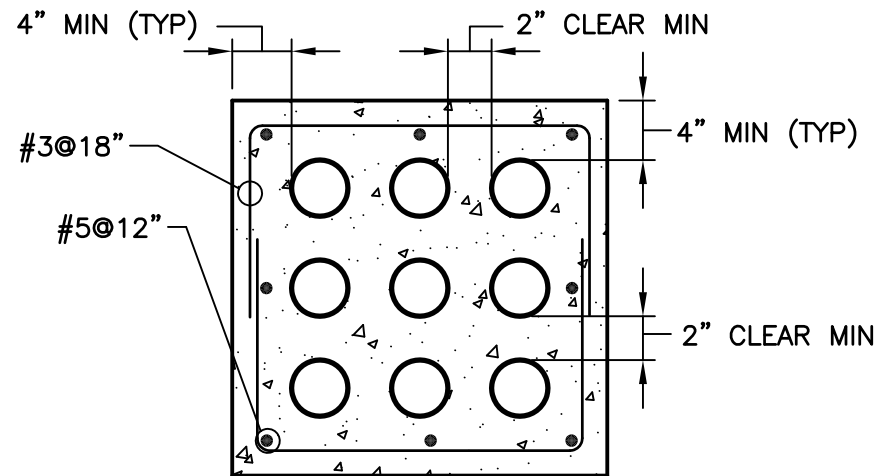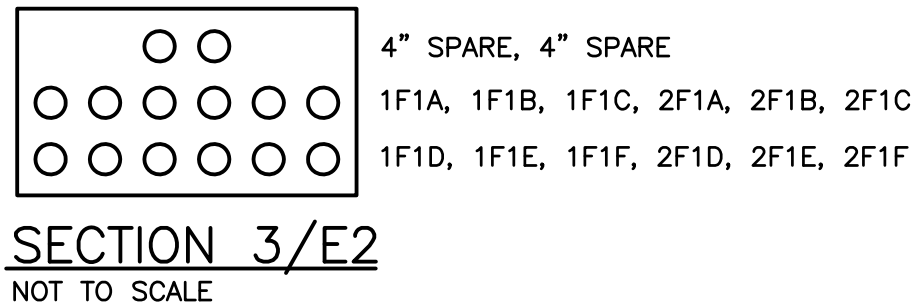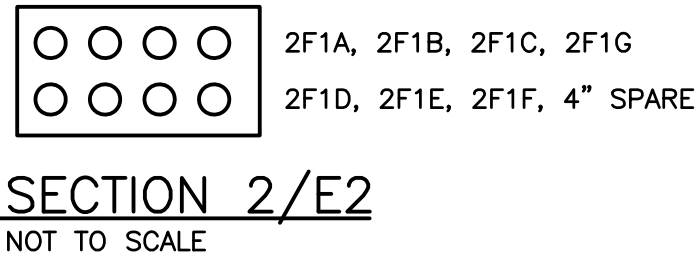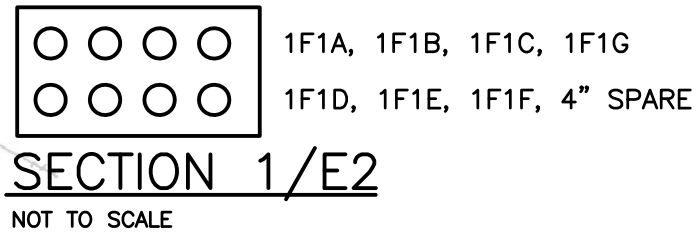

TYPICAL REINFORCING FOR CONCRETE ENCASTED ELECTRICAL CONDUITS
NOT TO SCALE

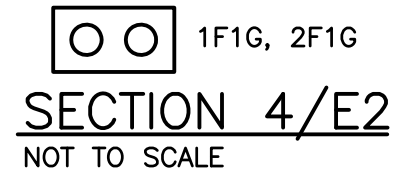


NOTES:

1. A NEW CONCRETE PAD LOCATED IN CLOSE PROXIMITY TO THE EXISTING TECO TRANSFORMER PAD WILL BE PROVIDED BY TECO.
2. A GROUND GRID FOR GROUNDING THE TRANSFORMER WILL BE PROVIDED BY TECO.
3. ALL CONDUITS SHOWN IN THE UNDERGROUND DUCT BANKS ARE A MINIMUM OF 4" ID UNLESS OTHERWISE NOTED.
4. EXISTING UNDERGROUND SERVICE CONDUITS DETERMINED TO BE IN CONFLICT WITH NEW WORK ARE TO BE DEMOLISHED AND REMOVED. THOSE NOT IN CONFLICT ARE TO BE ABANDONED IN PLACE.
5. EXISTING TECO TRANSFORMER PADS ARE TO BE DEMOLISHED.
6. COORDINATE THE MAXIMUM ALLOWABLE DISTANCE BETWEEN INSTRUMENT TRANSFORMERS AND THE METERS WITH TAMPA ELECTRIC COMPANY (TECO). IF THE LOCATION SHOWN EXCEEDS THE ALLOWABLE DISTANCE RELOCATE THE METERS PER TECO DIRECTION. PROVIDE CONCRETE PADS, ENCLOSURES, AND THE REQUIRED SUPPORTS AS DIRECTED BY TECO AND AS REQUIRED BY TECO INSTALLATION BULLETIN.
7. SEE SPECIFICATION 13420 FOR FLOW METER INSTALLATION REQUIREMENTS.
8. COORDINATE ALL WORK WITH LOCAL CABLE COMPANY. DISCONNECT AND REMOVE EXISTING OVERHEAD CABLE AND REPLACE WITH UNDERGROUND CONDUIT AND CABLE AS SHOWN.



GREELEY AND HANSEN

1715 N. WESTSHORE BLVD., STE. 464
TAMPA, FLORIDA 33607
CERTIFICATE OF AUTHORIZATION NO. 37

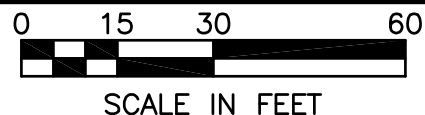


DESIGNED RZ
DRAWN TT
CHECKED DD



NO.	DATE	APPD	REVISION
P.E. NAME: NORBERT VIRANYI		P.E. NO. 72587	
P.E. NAME:			
DATE:			

CITY OF TAMPA WASTEWATER DEPARTMENT
YBOR PUMPING STATION REHABILITATION
ELECTRICAL
SITE PLAN

FILE: YBOREE02
NO. **E2**
DATE JUNE 2011

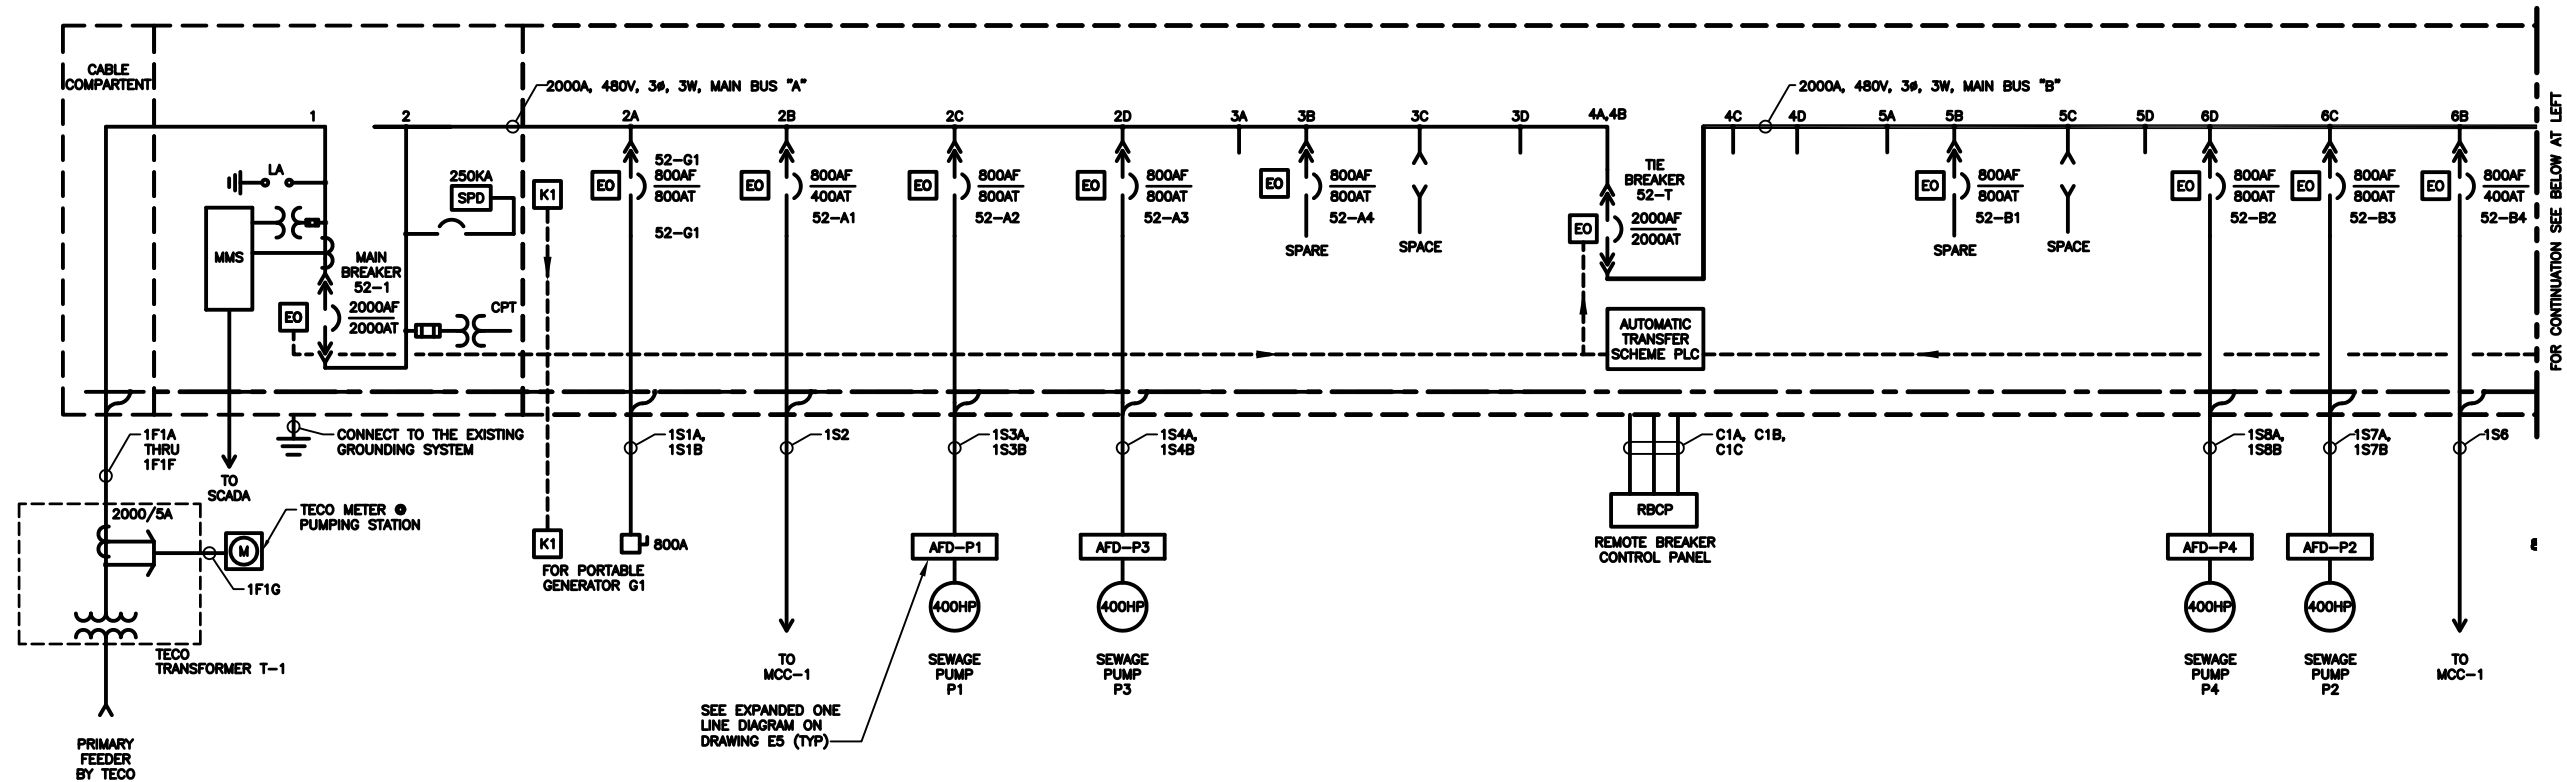

480V MAIN SERVICE SWITCHGEAR SES-1

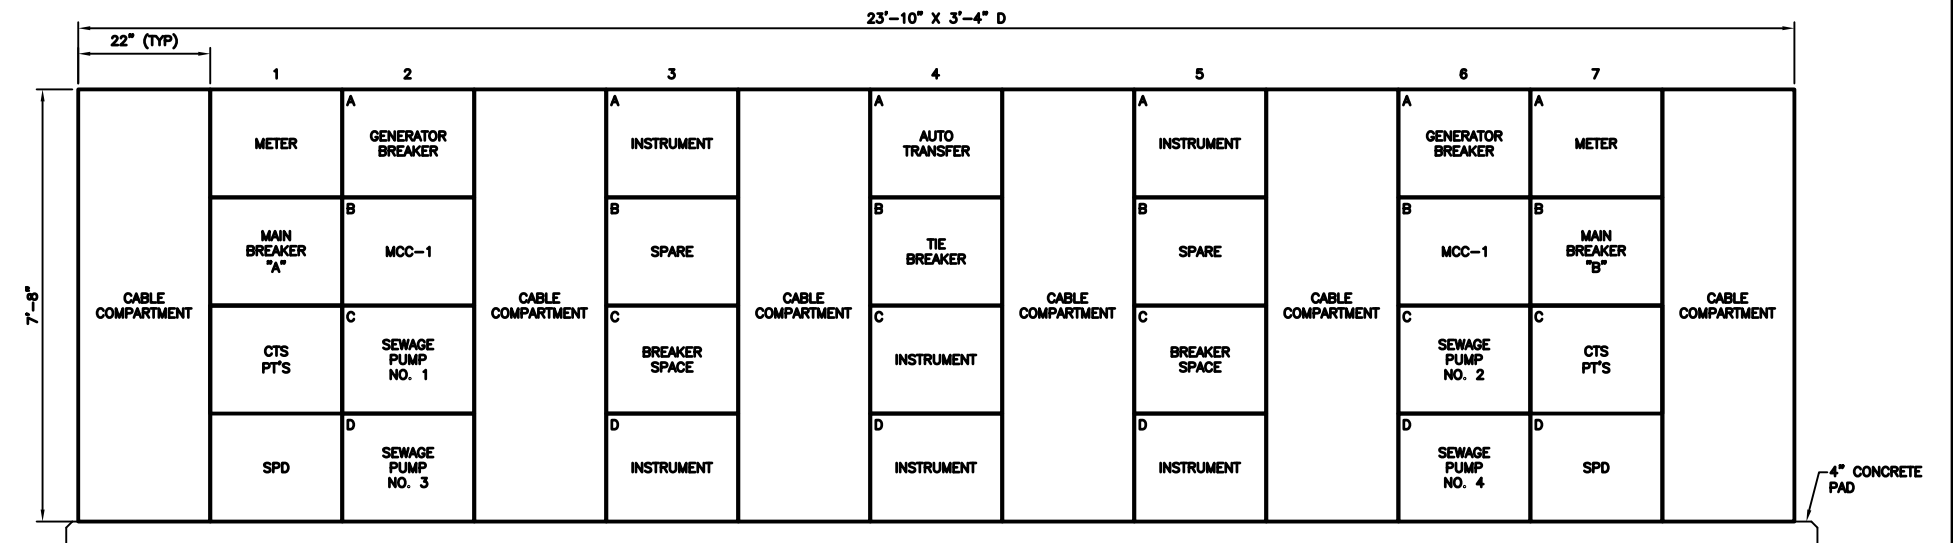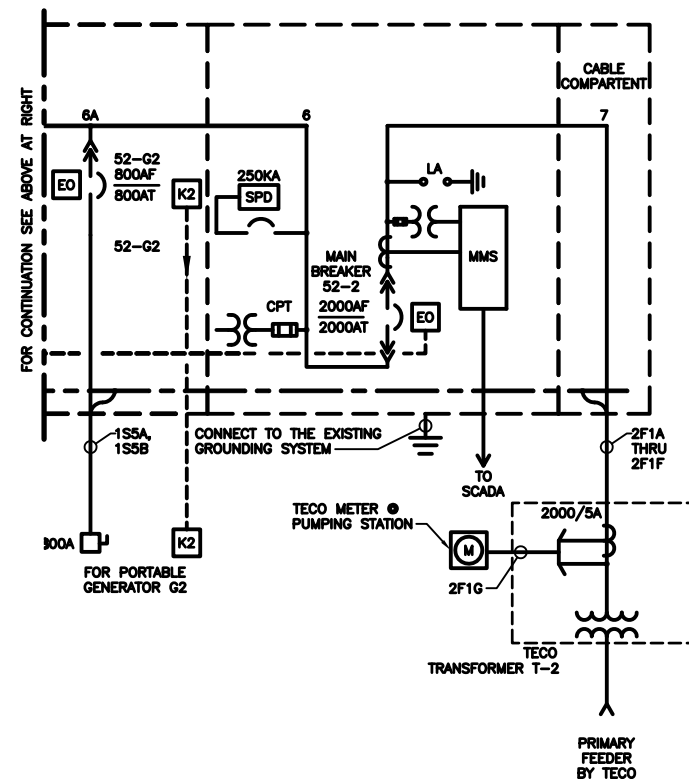


MAIN SERVICE SWITCHGEAR SES-1 FRONT ELEVATION

NOT TO SCALE



GREELEY AND HANSEN

1715 N. WESTSHORE BLVD., STE. 464
TAMPA, FLORIDA 33607
CERTIFICATE OF AUTHORIZATION NO. 37

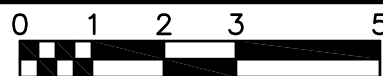

SCALE IN FEET

DESIGNED RZ
DRAWN TT
CHECKED DD

NO.	DATE	APPD	REVISION
P.E. NAME: NORBERT VIRANYI		P.E. NO. 72587	
P.E. NAME:			
DATE:			

CITY OF TAMPA WASTEWATER DEPARTMENT
YBOR PUMPING STATION REHABILITATION

ELECTRICAL




**MAIN SERVICE SWITCHGEAR SES-1
ONE LINE DIAGRAM**

FILE: YBOREE03

NO. **E3**

DATE JUNE 2011

FILE: YBOREE04 1:1 06/20/11 14:49 GH-A

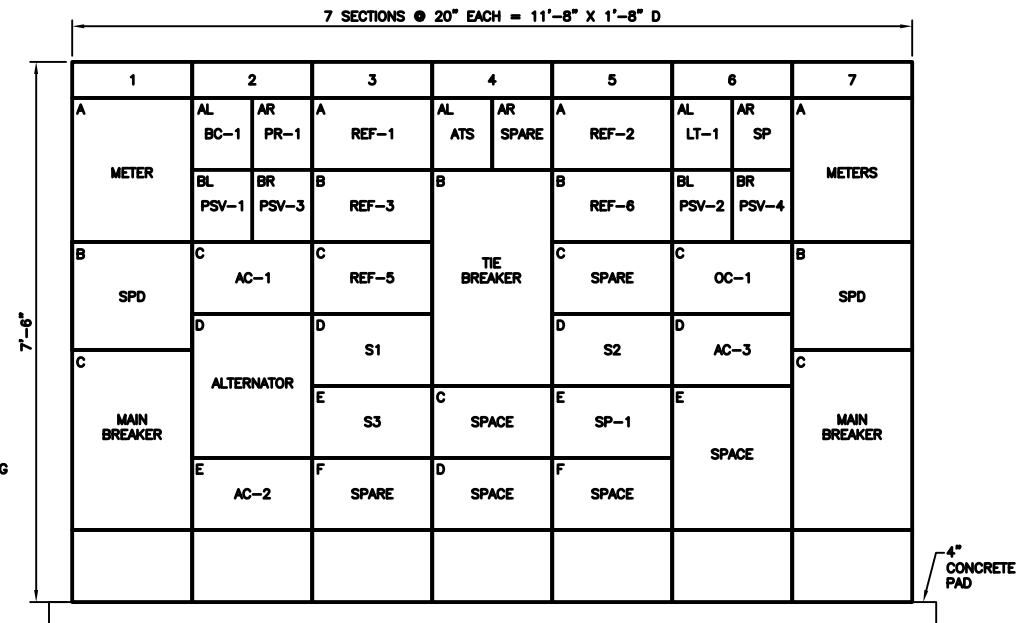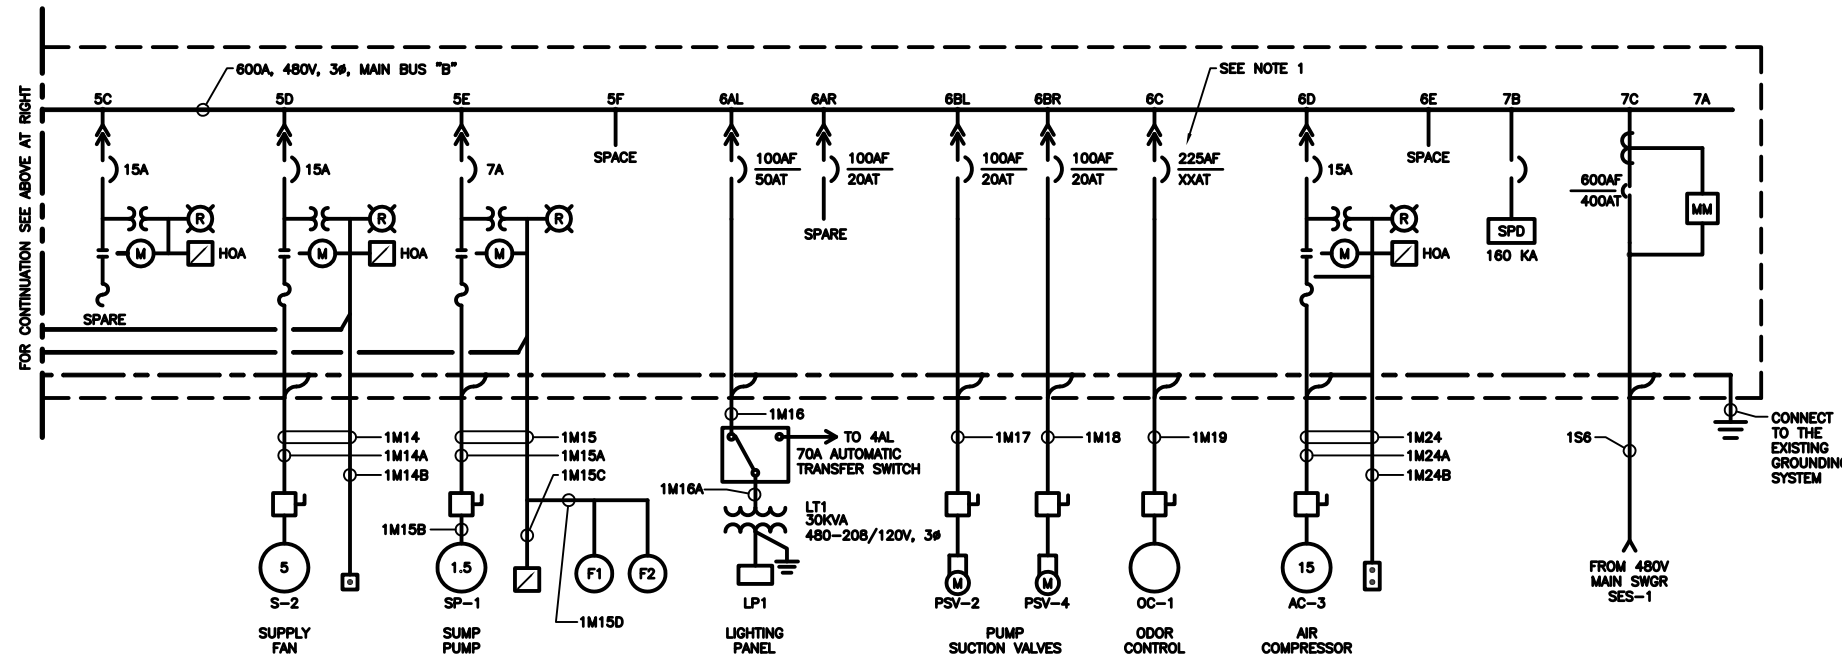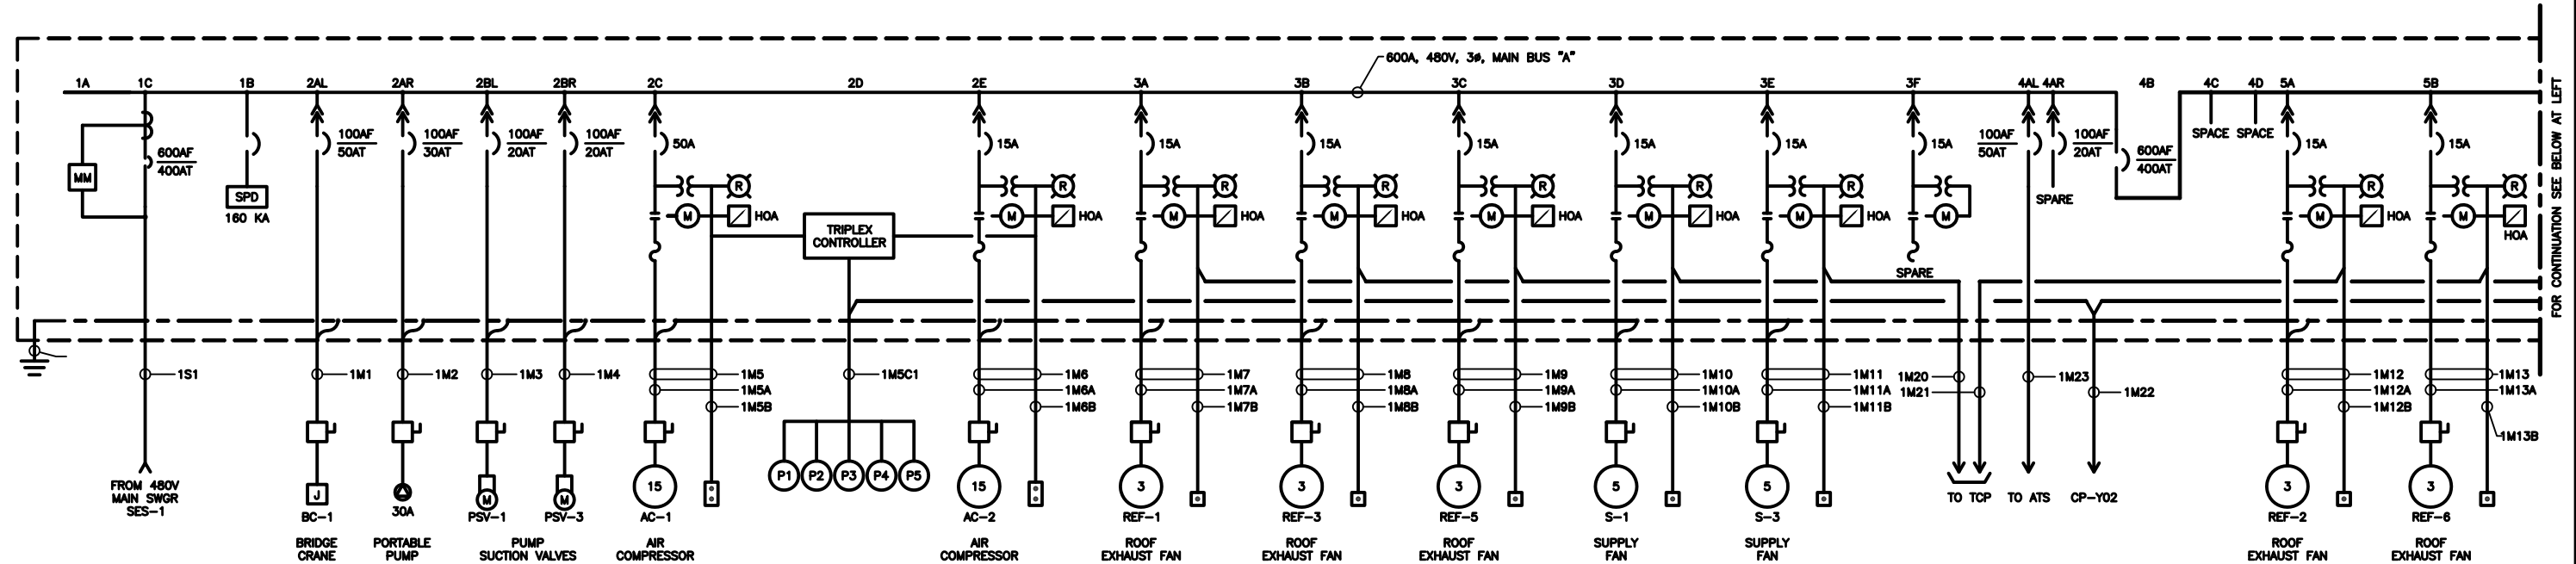

MOTOR CONTROL CENTER MCC-1
ONE LINE DIAGRAM

MCC-1 FRONT ELEVATION
NOT TO SCALE


NOTE:

1. ODOR CONTROL FEEDER CIRCUIT BREAKER AND DISCONNECT SWITCH TO MATCH EXISTING ODOR CONTROL POWER REQUIREMENTS.
2. ALL SPACES TO BE SUITABLE FOR FUTURE UPGRADES WITH NEW STARTERS OR CIRCUIT BREAKERS.



GREELEY AND HANSEN

1715 N. WESTSHORE BLVD., STE. 464
TAMPA, FLORIDA 33607
CERTIFICATE OF AUTHORIZATION NO. 37

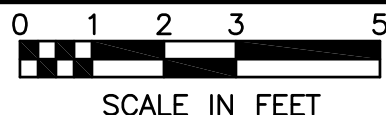

SCALE IN FEET

DESIGNED RZ
DRAWN OC
CHECKED DD

NO.	DATE	APPD	REVISION
P.E. NAME: NORBERT VIRANYI		P.E. NO. 72587	
P.E. NAME:			
DATE:			

CITY OF TAMPA WASTEWATER DEPARTMENT
YBOR PUMPING STATION REHABILITATION


ELECTRICAL

MOTOR CONTROL CENTER
ONE LINE DIAGRAM

FILE: YBOREE04


NO. **E4**

DATE JUNE 2011

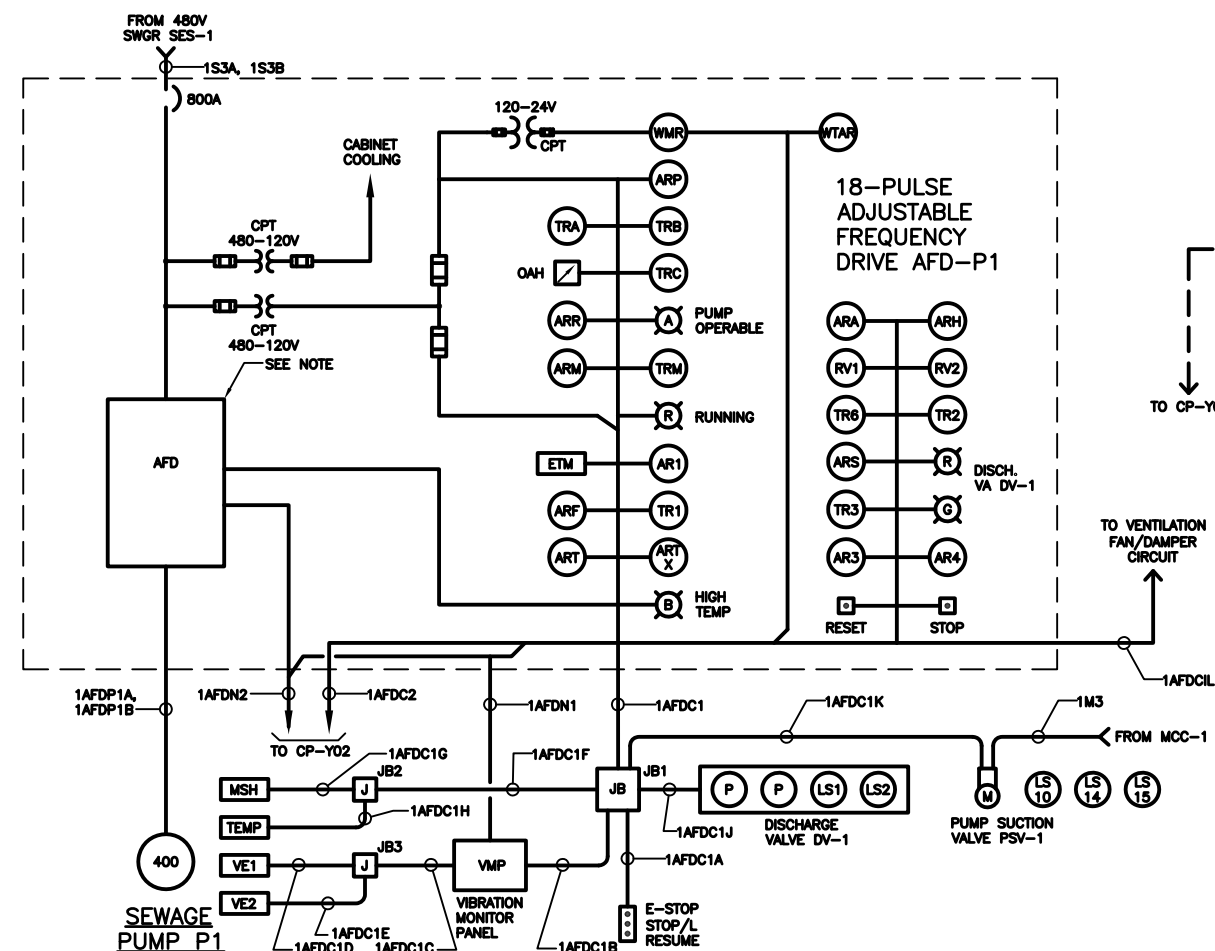


AFD-P1 ONE LINE DIAGRAM


SIMILAR FOR AFD-P2, P3 AND P4
NOTE: PROVIDE STANDARD INPUT FRONT END DEVICES PER THE
SPECIFIED MANUFACTURER

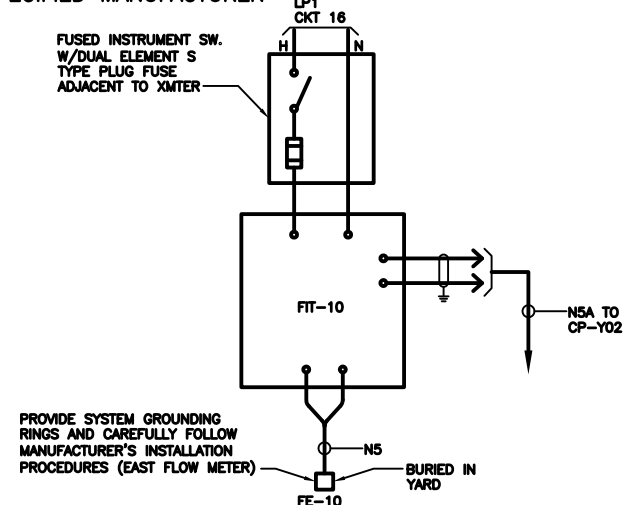

STATION DISCHARGE FLOWMETER BLOCK WIRING DIAGRAM

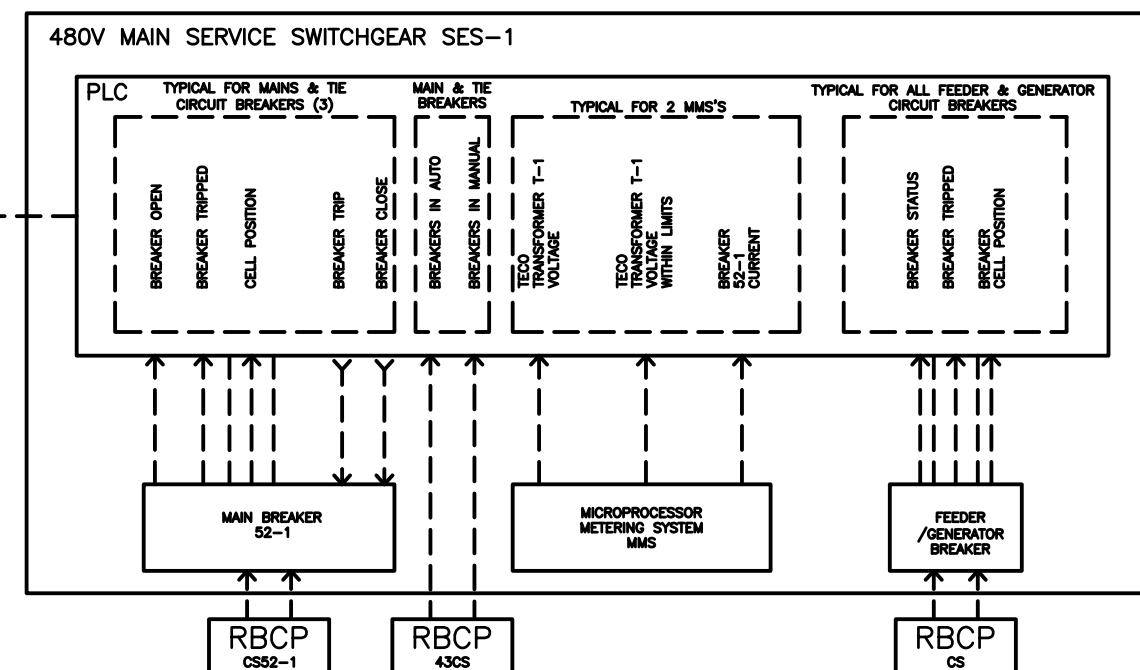

ELECTRICAL SWITCHGEAR CONTROL AND MONITORING P&ID DIAGRAM

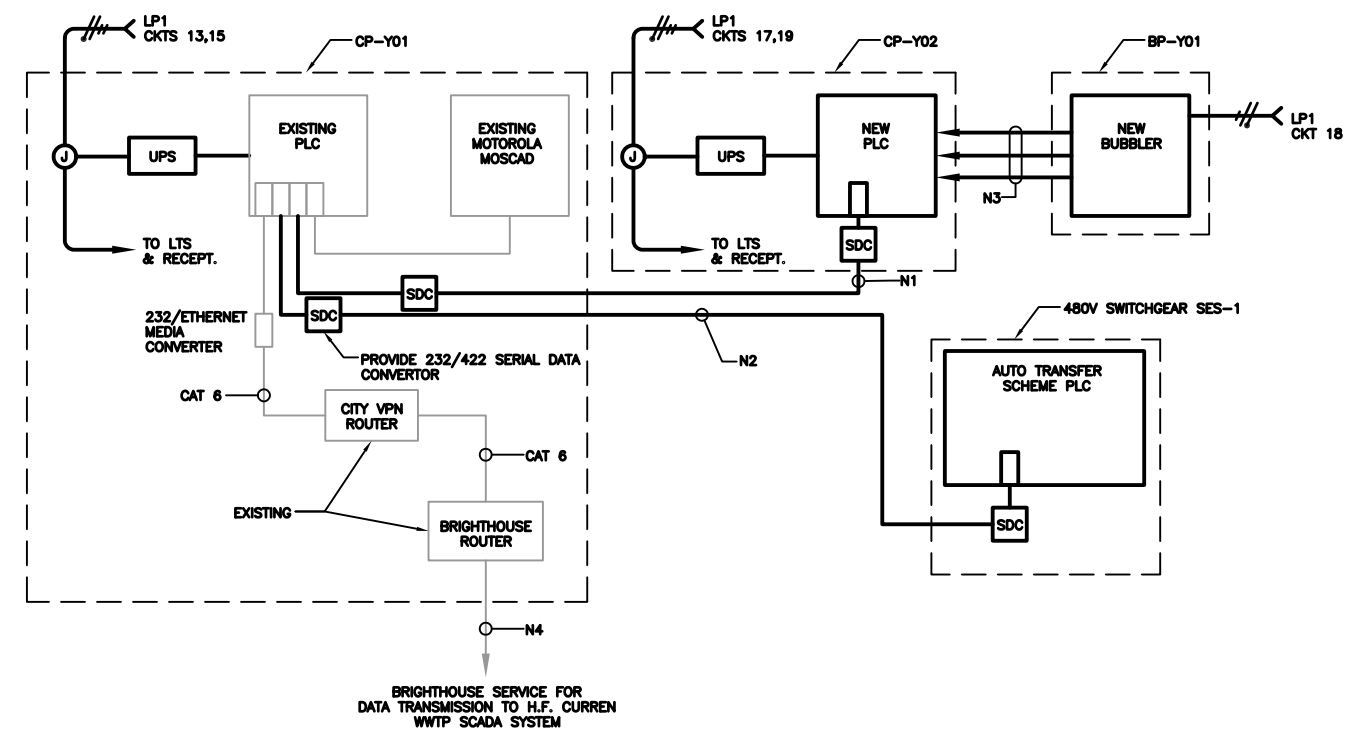

PUMP STATION SCADA COMMUNICATIONS BLOCK WIRING DIAGRAM

**GREELEY AND HANSEN**

1715 N. WESTSHORE BLVD., STE. 464
TAMPA, FLORIDA 33607
CERTIFICATE OF AUTHORIZATION NO. 37

NO SCALE

DESIGNED	RZ
DRAWN	OC
CHECKED	DD

NO.	DATE	APPD	REVISION
P.E. NAME: NORBERT VIRANYI		P.E. NO. 72587	
P.E. NAME: _____			
DATE: _____			

CITY OF TAMPA WASTEWATER DEPARTMENT
YBOR PUMPING STATION REHABILITATION





ELECTRICAL

MISCELLANEOUS DIAGRAMS

FILE: YBOREE05

NO. E5

DATE JUNE 2011

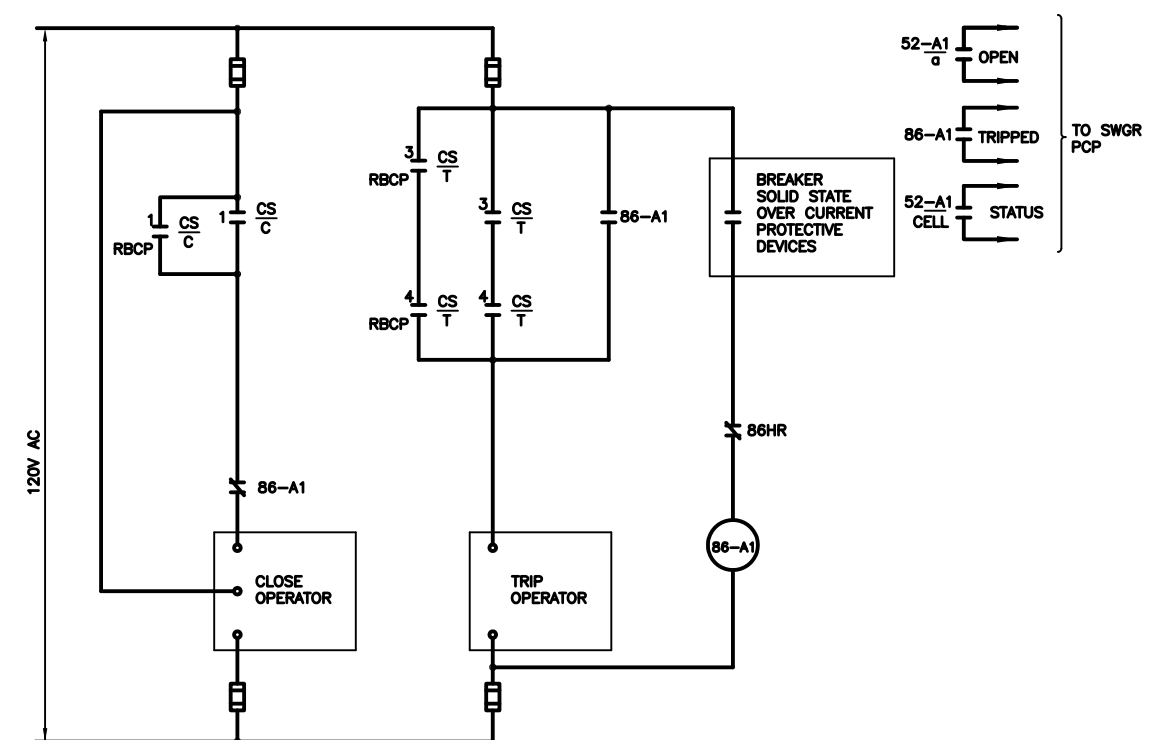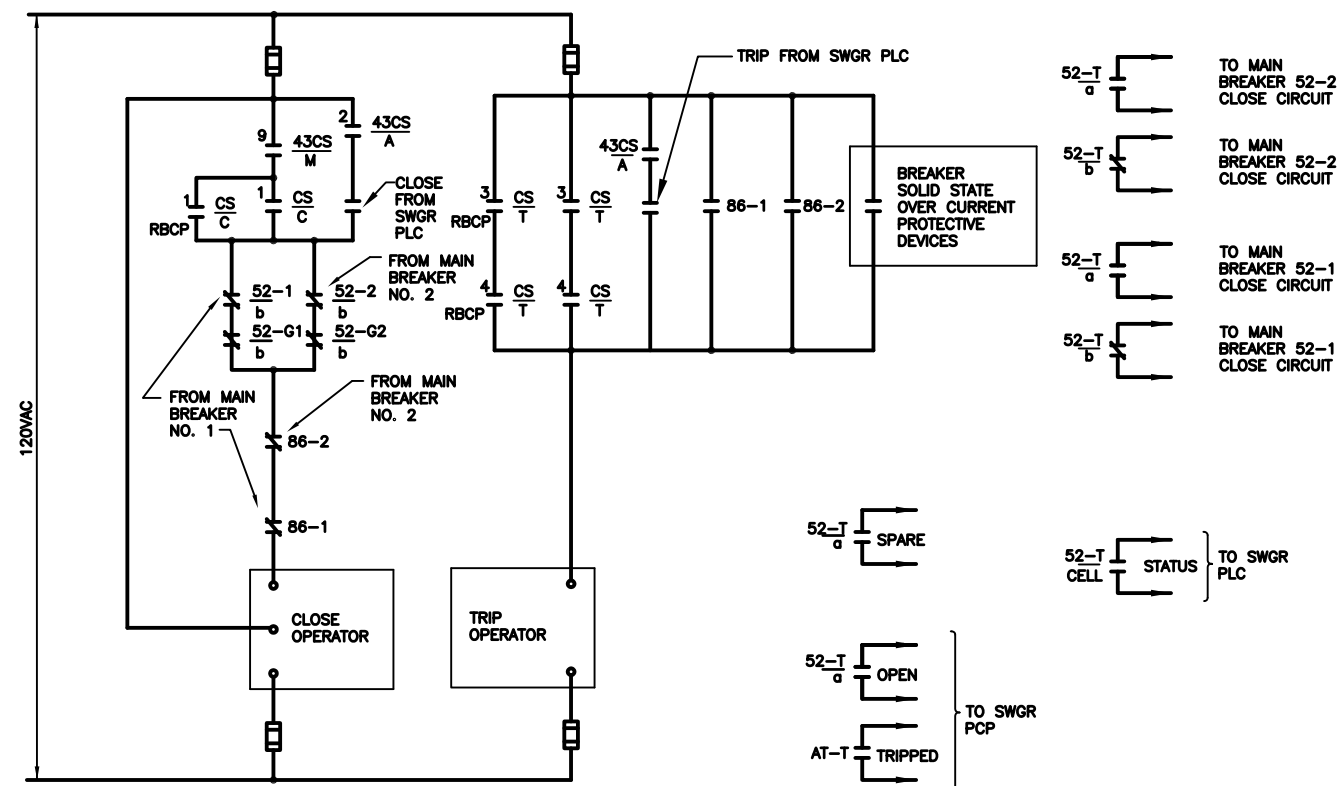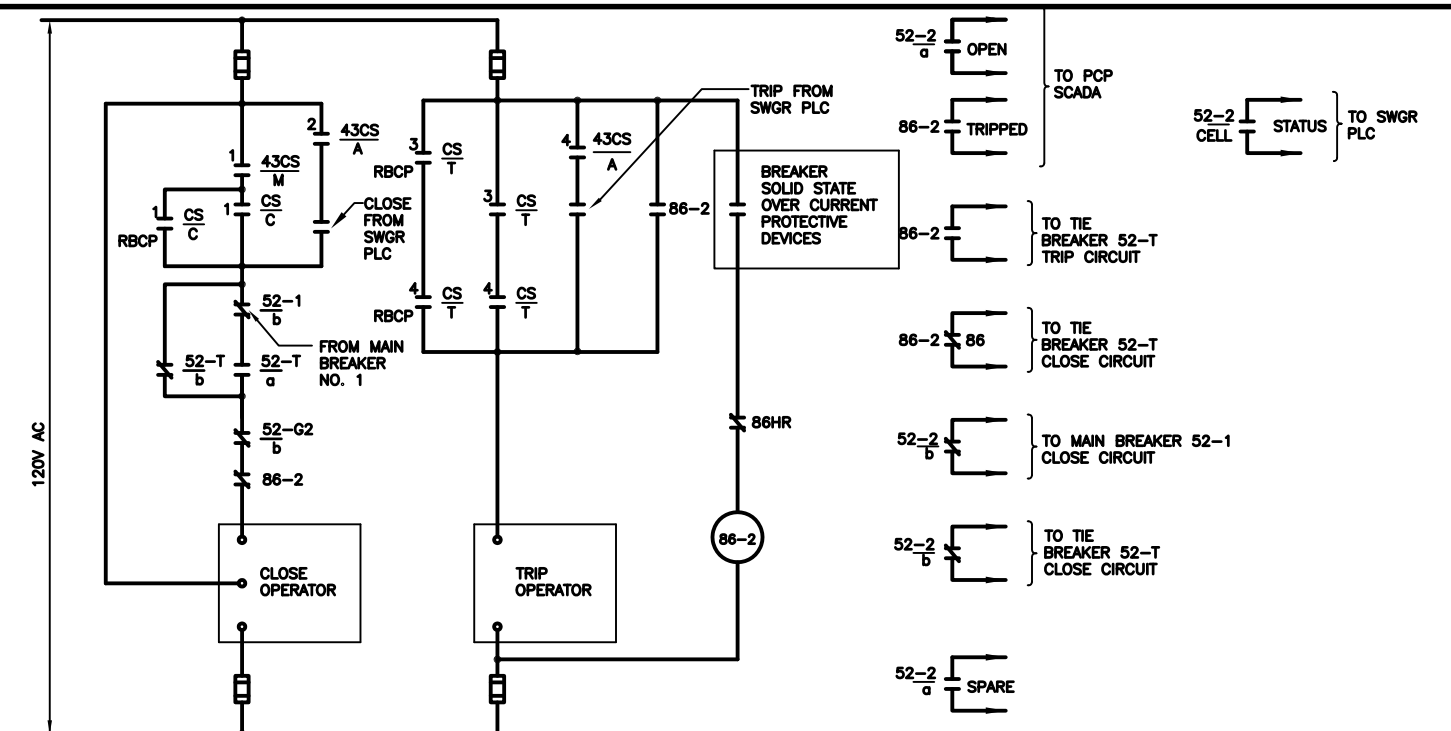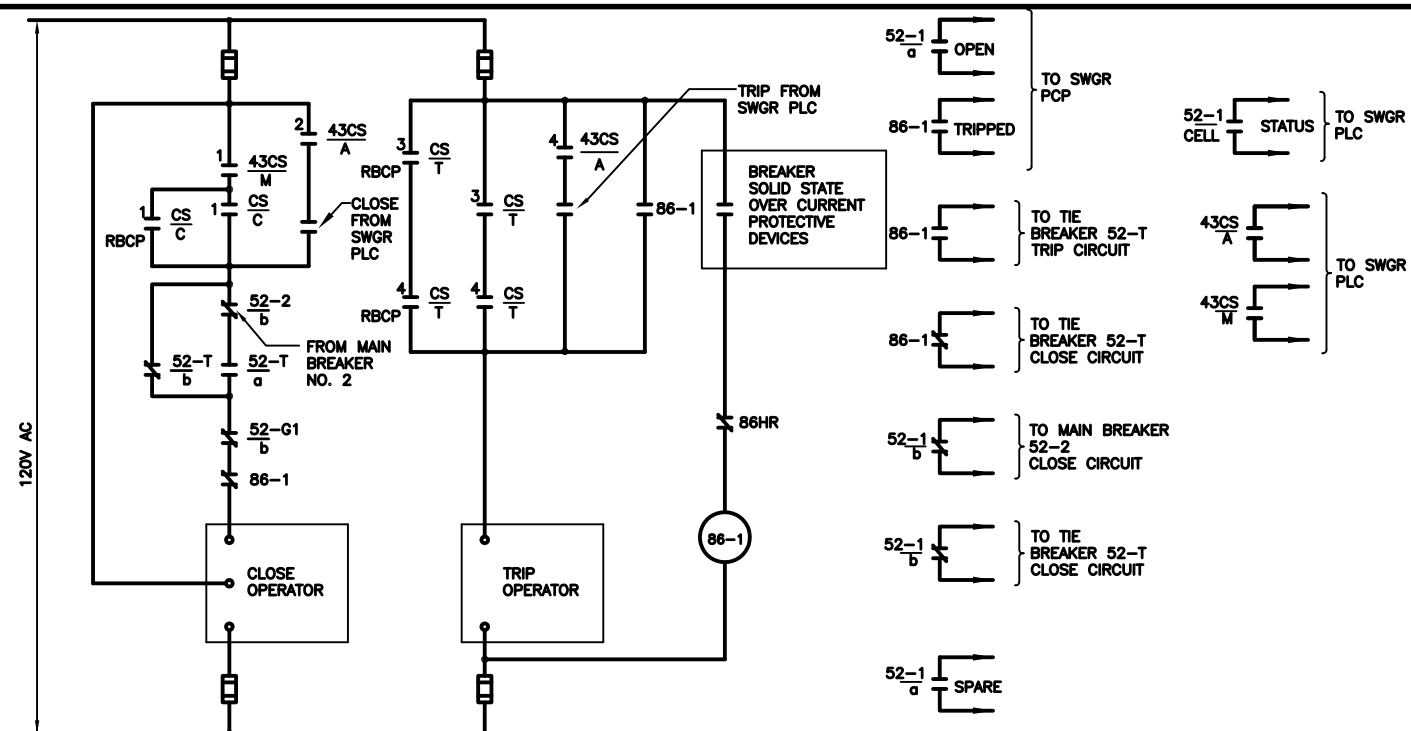


FEEDER BREAKER 52-A1 CONTROL CIRCUIT

SIMILAR FOR 52-A2, 3, 4, 52-B1, 2, 3 & 4

**GREELEY AND HANSEN**

1715 N. WESTSHORE BLVD., STE. 464
TAMPA, FLORIDA 33607
CERTIFICATE OF AUTHORIZATION NO. 37

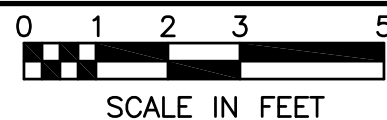

SCALE IN FEET

DESIGNED	RZ
DRAWN	OC
CHECKED	DD

NO.	DATE	APPD	REVISION
P.E. NAME: NORBERT VIRANYI		P.E. NO. 72587	
P.E. NAME: _____			
DATE: _____			

CITY OF TAMPA WASTEWATER DEPARTMENT
YBOR PUMPING STATION REHABILITATION



ELECTRICAL







 

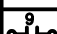
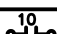
 
 
 
 
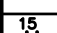
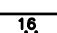
CONTROL DIAGRAMS

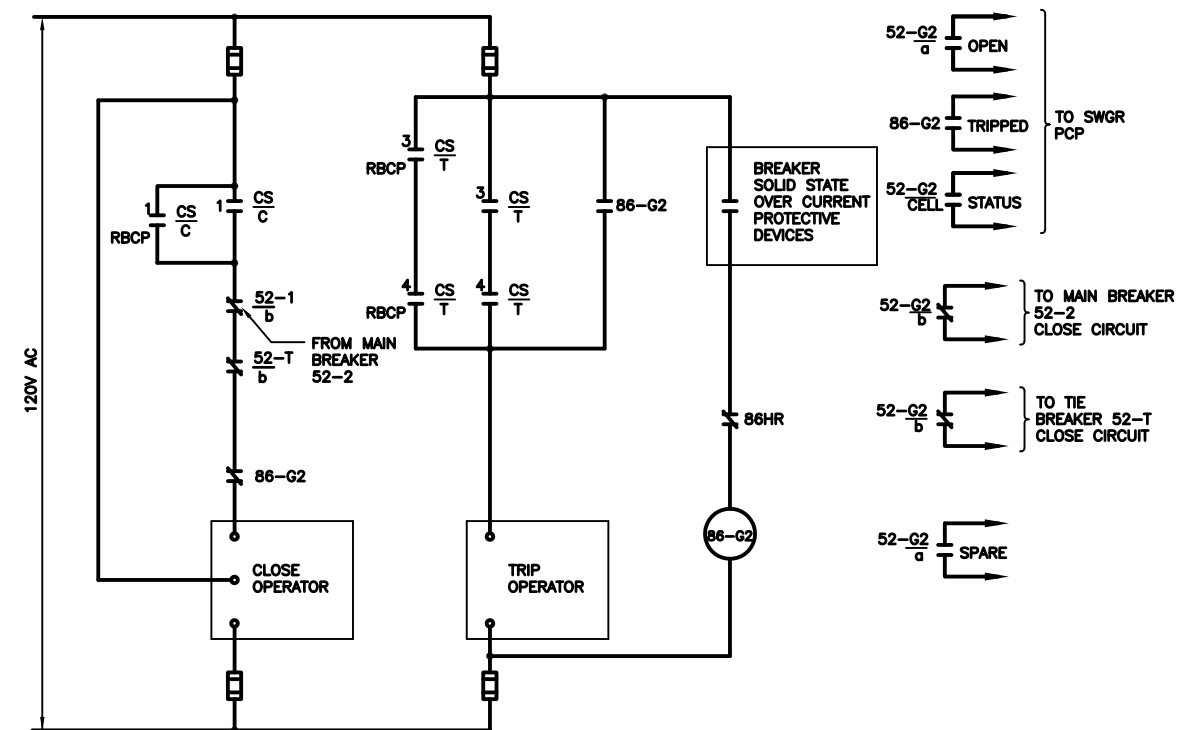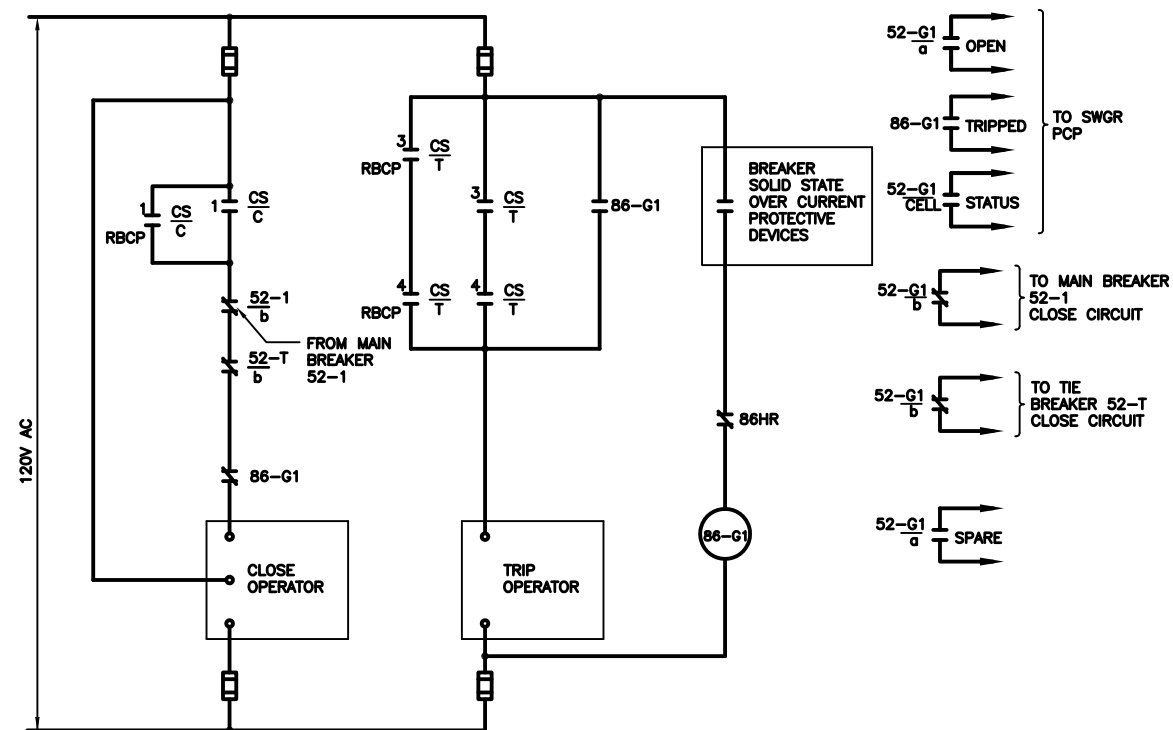FILE: YBOREE06







NO. **E6**

DATE JUNE 2011






MAIN-TIE-MAIN BREAKERS MANUAL/AUTO TRANSFER SELECTOR SWITCH 43CS				
CONTACTS HANDLE END		POSITION		FUNCTION
		MANUAL	AUTO	
 	1	X		MAIN BREAKER NO. 1 CLOSE CIRCUIT
	2		X	MAIN BREAKER NO. 1 CLOSE CIRCUIT
 	3	X		SPARE
	4		X	MAIN BREAKER NO. 1 TRIP CIRCUIT
 	5	X		MAIN BREAKER NO. 2 CLOSE CIRCUIT
	6		X	MAIN BREAKER NO. 2 CLOSE CIRCUIT
 	7	X		SPARE
	8		X	MAIN BREAKER NO. 2 TRIP CIRCUIT
 	9	X		TIE BREAKER NO. 2 CLOSE CIRCUIT
	10		X	SPARE
 	11	X		TO SWGR PLC
	12		X	
 	13	X		SPARE
	14		X	
 	15	X		
	16		X	

X - INDICATES CONTACT CLOSED
(MAINTAINED CONTACT)

TYPICAL BREAKER CONTROL SWITCH CS ②					
SES-1 AND RBCP					
CONTACTS HANDLE END		POSITION			FUNCTION
		CLOSE	NORMAL	TRIP	
 1  2	1	X			CLOSE CIRCUIT
	2	X			SPARE
 3  4	3			X	TRIP CIRCUIT
	4			X	
 5  6	5	X	X		SPARE
	6		X	X	

X - INDICATES CONTACT CLOSED
(SPRING RETURN FROM CLOSE AND TRIP TO NORMAL)

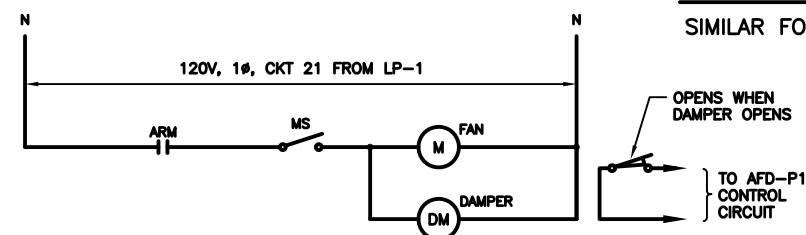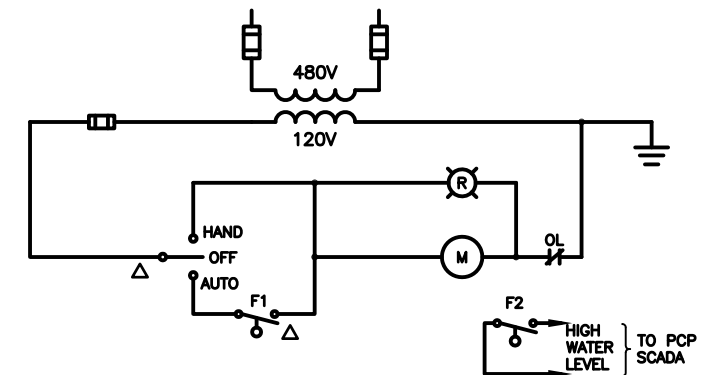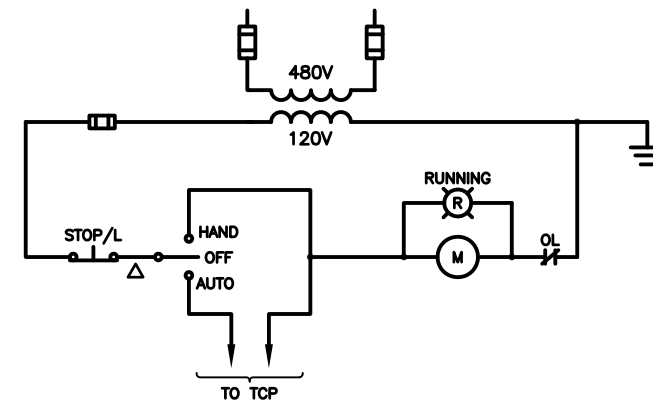**GREELEY AND HANSEN**

1715 N. WESTSHORE BLVD., STE. 464
TAMPA, FLORIDA 33607
CERTIFICATE OF AUTHORIZATION NO. 37



DESIGNED	RZ
DRAWN	OC
CHECKED	DD

NO.	DATE	APPD	REVISION
P.E. NAME: NORBERT VIRANYI		P.E. NO. 72587	
P.E. NAME: _____			
DATE: _____			

CITY OF TAMPA WASTEWATER DEPARTMENT
YBOR PUMPING STATION REHABILITATION


ELECTRICAL

CONTROL DIAGRAMS

FILE: YBOREE07

NO. **E7**

DATE JUNE 2011

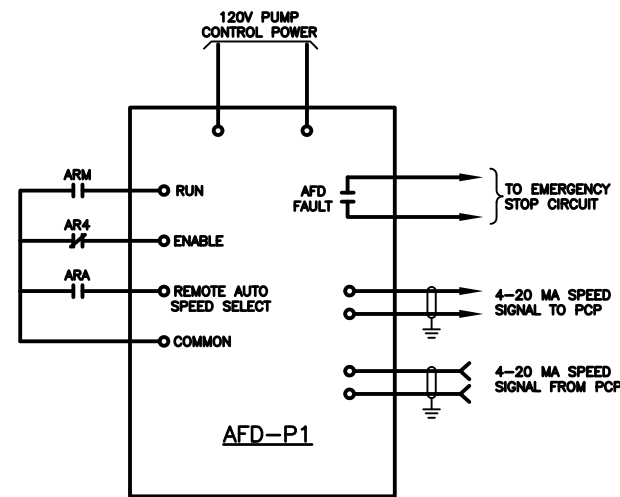



ADJUSTABLE FREQUENCY DRIVE AFD-P1 WIRING DIAGRAM

LIMIT SWITCH CONTACT DEVELOPMENT FOR PNEUMATIC DISCHARGE VALVE OPERATORS					
ROTOR NO.	CONTACT NO.	OPERATOR POSITION			CONTACT FUNCTION
		FULL OPEN	INTER-MEDIATE	FULL CLOSED	
LS1	1				VA. OPEN IND. LT.
	2				START DELAY CKT
	3				RUN CKT
	4				SPARE
LS2	1				VA. CLOSED IND. LT.
	2				SPARE
	3				SPARE
	4				SPARE


LIMIT SWITCH CONTACT DEVELOPMENT FOR MOTORIZED SUCTION VALVE OPERATORS					
ROTOR NO.	CONTACT NO.	OPERATOR POSITION			CONTACT FUNCTION
		FULL OPEN	INTER-MEDIATE	FULL CLOSED	
1	1				BYPASS CKT
	2				PUMP PERMISSIVE
	3				INDICATOR LIGHT
	4				FORWARD (OPEN) LIMIT
2	5				BYPASS CKT
	6				SPARE
	7				INDICATOR LIGHT
	8				REVERSE (CLOSED) LIMIT
3	9				AUXILIARY
	10				CP-Y02
	11				AUXILIARY
	12				AUXILIARY
4	13				AUXILIARY
	14				CP-Y02
	15				PUMP START CKT
	16				AUXILIARY

TQ/C - CLOSING TORQUE SWITCH
TQ/O - OPENING TORQUE SWITCH
— INDICATES CONTACT CLOSED
— INDICATES CONTACT OPEN

SEE SCHEMATIC DIAGRAMS FOR FUNCTION OF THE "AUXILIARY" LIMIT SWITCH CONTACTS

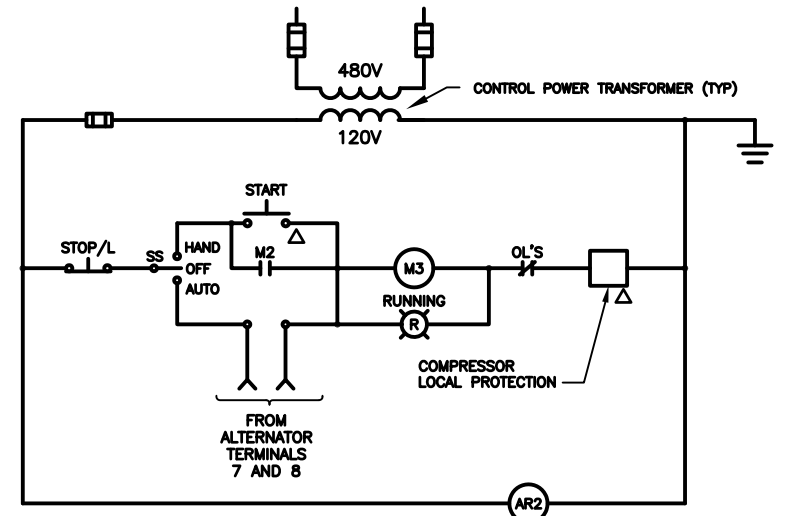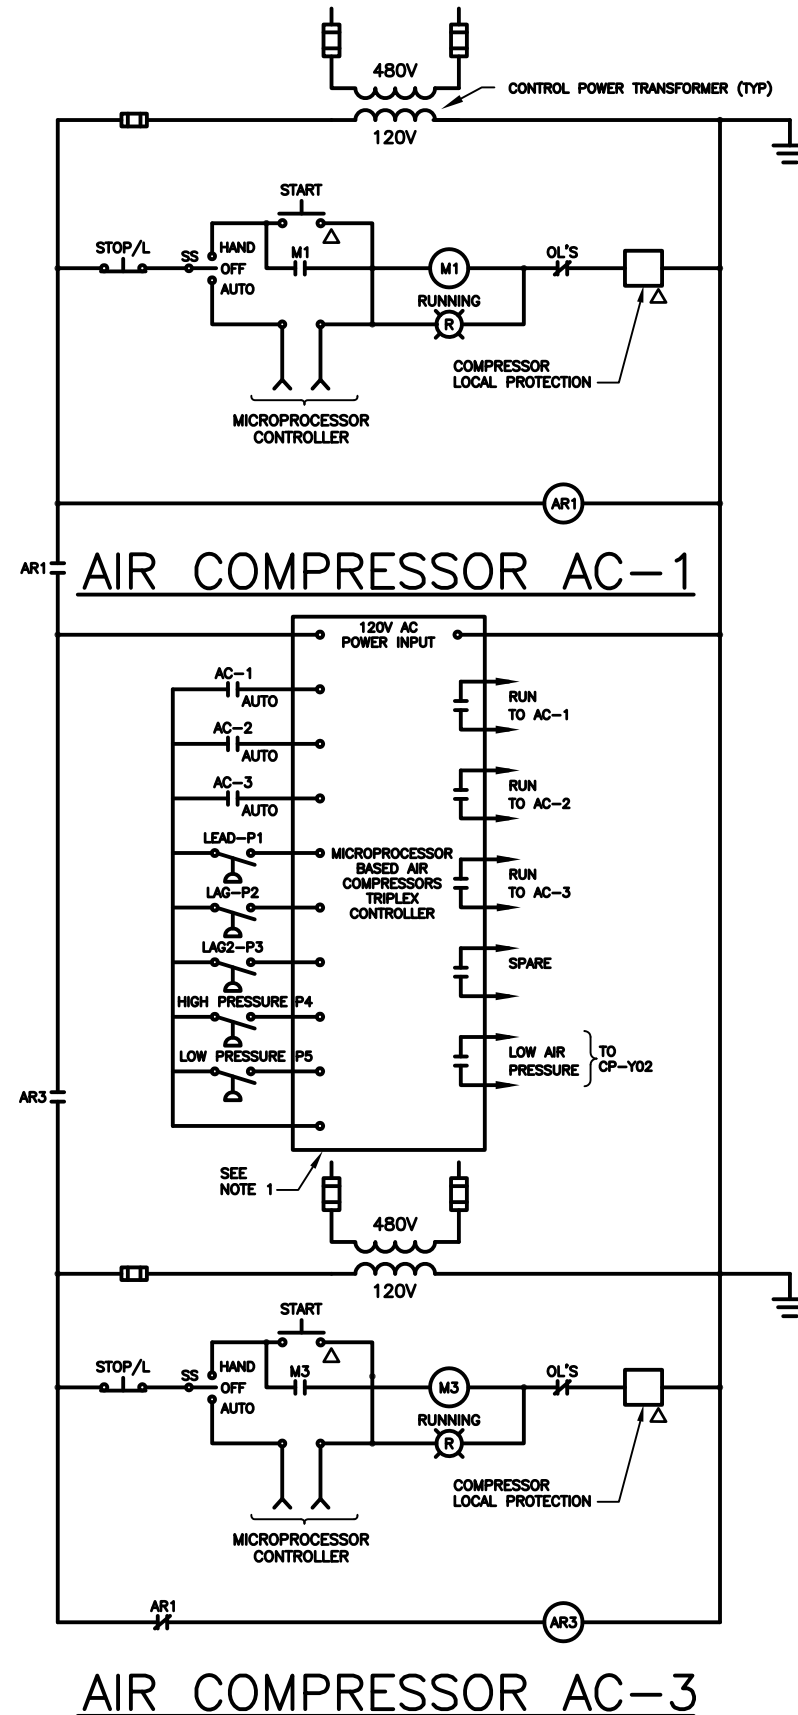

AIR COMPRESSOR AC-2

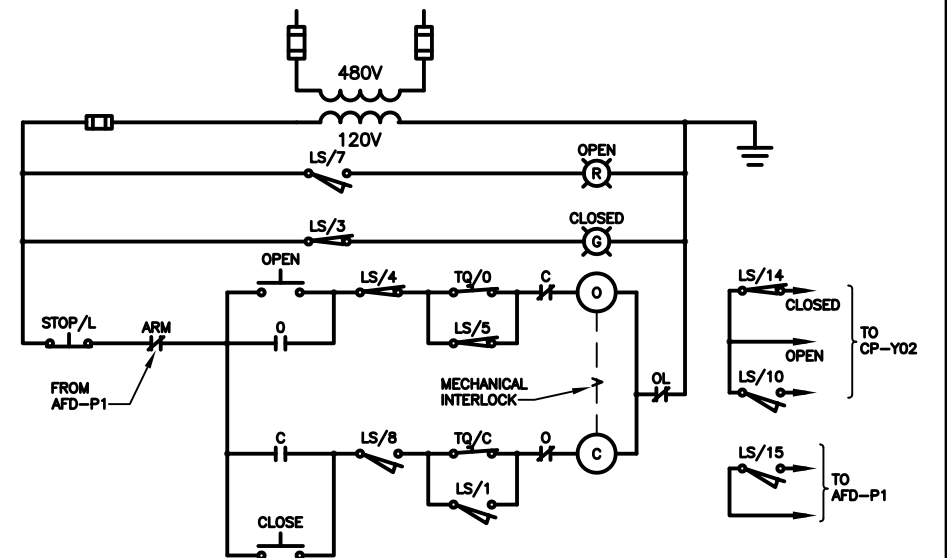

PUMP SUCTION VALVE PSV-1

SIMILAR FOR PSV-2, PSV-3 AND PSV-4

NOTES:

1. PROVIDE MICROPROCESSOR BASED CONTROLLER FOR CONTROLLING THE OPERATION OF THE THREE AIR COMPRESSORS. PROVIDE CONTROLLER WITH AN LCD DISPLAY AND A MINIMUM OF THREE FUNCTION KEYS. THE CONTROLLER IS TO BE EQUIPPED WITH EIGHT DIGITAL INPUTS AND A MINIMUM OF FOUR FORM "C" RELAY OUTPUTS. PROVIDE ONE RS485 MODBUS MASTER/SLAVE COMMUNICATION PORT.



GREELEY AND HANSEN

1715 N. WESTSHORE BLVD., STE. 464
TAMPA, FLORIDA 33607
CERTIFICATE OF AUTHORIZATION NO. 37



DESIGNED RZ
DRAWN OC
CHECKED DD

NO.	DATE	APPD	REVISION

P.E. NAME: NORBERT VIRANYI P.E. NO. 72587
P.E. NAME: _____
DATE: _____

CITY OF TAMPA WASTEWATER DEPARTMENT
YBOR PUMPING STATION REHABILITATION

ELECTRICAL

CONTROL DIAGRAMS

FILE: YBOREE09

NO. **E9**


DATE JUNE 2011

NOTES:

1. SEE DRAWING D1 FOR ELECTRICAL DEMOLITION PLAN.
2. EXISTING CONDUITS MAY BE REUSED FOR NEW WORK WHERE DETERMINED TO BE SERVICEABLE. OTHERWISE, ALL EXISTING CONDUIT AND WIRES ARE TO BE REMOVED. CONCEALED CONDUITS ARE TO BE ABANDONED IN PLACE, CUT OFF FLUSH WHERE EXITING EXPOSED AND CAPPED WITH CONCRETE.

3. CORE DRILL EXISTING WALLS AND FLOORS FOR ALL CONDUIT PENETRATIONS. PROVIDE WATERTIGHT FITTINGS FOR ALL EXTERIOR WALL PENETRATIONS.
4. TURN UP DUCT BANK ENCASEMENT 2'-0" ABOVE GRADE. END ENCASEMENT AND TRANSITION TO RIGID ALUMINUM CONDUITS UP TO THE PULLBOX.
5. ALL PHYSICAL WIRING HAS NOT BEEN SHOWN ON THE PLANS DUE TO SPACE LIMITATIONS AND THE POSSIBILITY FOR REUSING EXISTING CONDUITS. REFER TO THE ONE LINE DIAGRAMS, BLOCK WIRING DIAGRAMS AND CONDUIT AND CABLE SCHEDULES FOR COMPLETE WIRING REQUIREMENTS.

6. THE EXISTING METERING PANEL AND PUMP CONTROL PANELS BEING DEMOLISHED CONTAIN WIRING FOR STATUS AND ALARM SIGNALS THAT ARE TO BE RECONNECTED TO CP-Y02. FIELD VERIFY WHICH SIGNALS TERMINATE AT EACH PANEL, INTERCEPT AND EXTEND WIRING TO CP-Y02. PROVIDE CONDUIT, JUNCTION BOXES AND WIRING AS REQUIRED. SIGNALS TO BE RECONNECTED ARE AS FOLLOWS:
WEST METER FLOW
COMBUSTIBLE GAS % LEL
HYPO TANK LEVEL
WET WELL HIGH WATER
ODOR CONTROL FAN FAILED
ODOR CONTROL TOWER 2
DRY WELL HIGH WATER
ODOR CONTROL TOWER 1
COMBUSTIBLE GAS DETECTION FAILURE
AIR COMPRESSOR LOW PRESSURE
50% COMBUSTIBLE GAS ALARM
ODOR CONTROL FAILED
25% LEL ALARM
7. EXISTING WIRING FOR SIGNALS DESCRIBED IN NOTE 6 WHICH ARE FOUND NOT TO BE INSTALLED IN CONDUIT ALONG THEIR ENTIRE ROUTE ARE TO BE PULLED BACK TO A CONVENIENT LOCATION, CONDUIT AND BOXES PROVIDED AS REQUIRED AND THE WIRING RE-INSTALLED OR REPLACED.
8. THE HEAT GENERATED BY EACH OF THE ADJUSTABLE FREQUENCY DRIVES IS TO BE INDIVIDUALLY DUCTED OFF THE TOP OF THE AFD THRU THE EXISTING WALL DIRECTLY TO THE REAR OF THE AFD. PROVIDE A MOTORIZED DAMPER AND FAN FOR EACH AFD THAT OPENS/STARTS WHEN THE ASSOCIATED AFD RECEIVES A START COMMAND. THE MOTORIZED DAMPERS ARE TO BE POWERED FROM THE LP-1. FOR AFD-P4 ROUTE THE DUCT THROUGH THE EXISTING BLANKED OFF LOUVER AT THE NORTH END OF THE EAST WALL LOUVER/DAMPER COMBINATION.
9. FOR ACTUAL LOCATION OF EXISTING SUPPLY FANS S-1 AND S-2, SEE DWG E2. CORE DRILL THE WALL BETWEEN THE SCREEN ROOM AND PUMP ROOM IF NEW CONDUITS ARE REQUIRED. SEAL AROUND THE CONDUITS WHERE PENETRATING THE WALL TO MAINTAIN THE INTEGRITY OF THE AFFECTED AREAS.
10. SEE DRAWING E13 FOR PLAN LOCATION OF EXHAUST FANS.
11. WHERE FIELD DETERMINED THAT ADDITIONAL BRANCH CIRCUIT AND MISCELLANEOUS WIRING IS NEEDED FOR RECONNECTING EXISTING LOADS THAT HAVE NOT BEEN IDENTIFIED ON THE PLAN, PROVIDE WIRE AND CONDUIT AS REQUIRED. UPDATE THE LP1 PANELBOARD DIRECTORY AND CONDUIT AND CABLE SCHEDULE TO REFLECT ALL CHANGES.
12. PROVIDE CONCRETE HOUSEKEEPING PADS FOR THE FOLLOWING ELECTRICAL EQUIPMENT AS DETAILED ON DRAWING G5:
480V SWITCHGEAR SES-1
480V MOTOR CONTROL CENTER MCC-1
AFD-P1, P2, P3, P4
CP-Y01 AN CP-Y02
BP-Y01
TRANSFORMER LT1

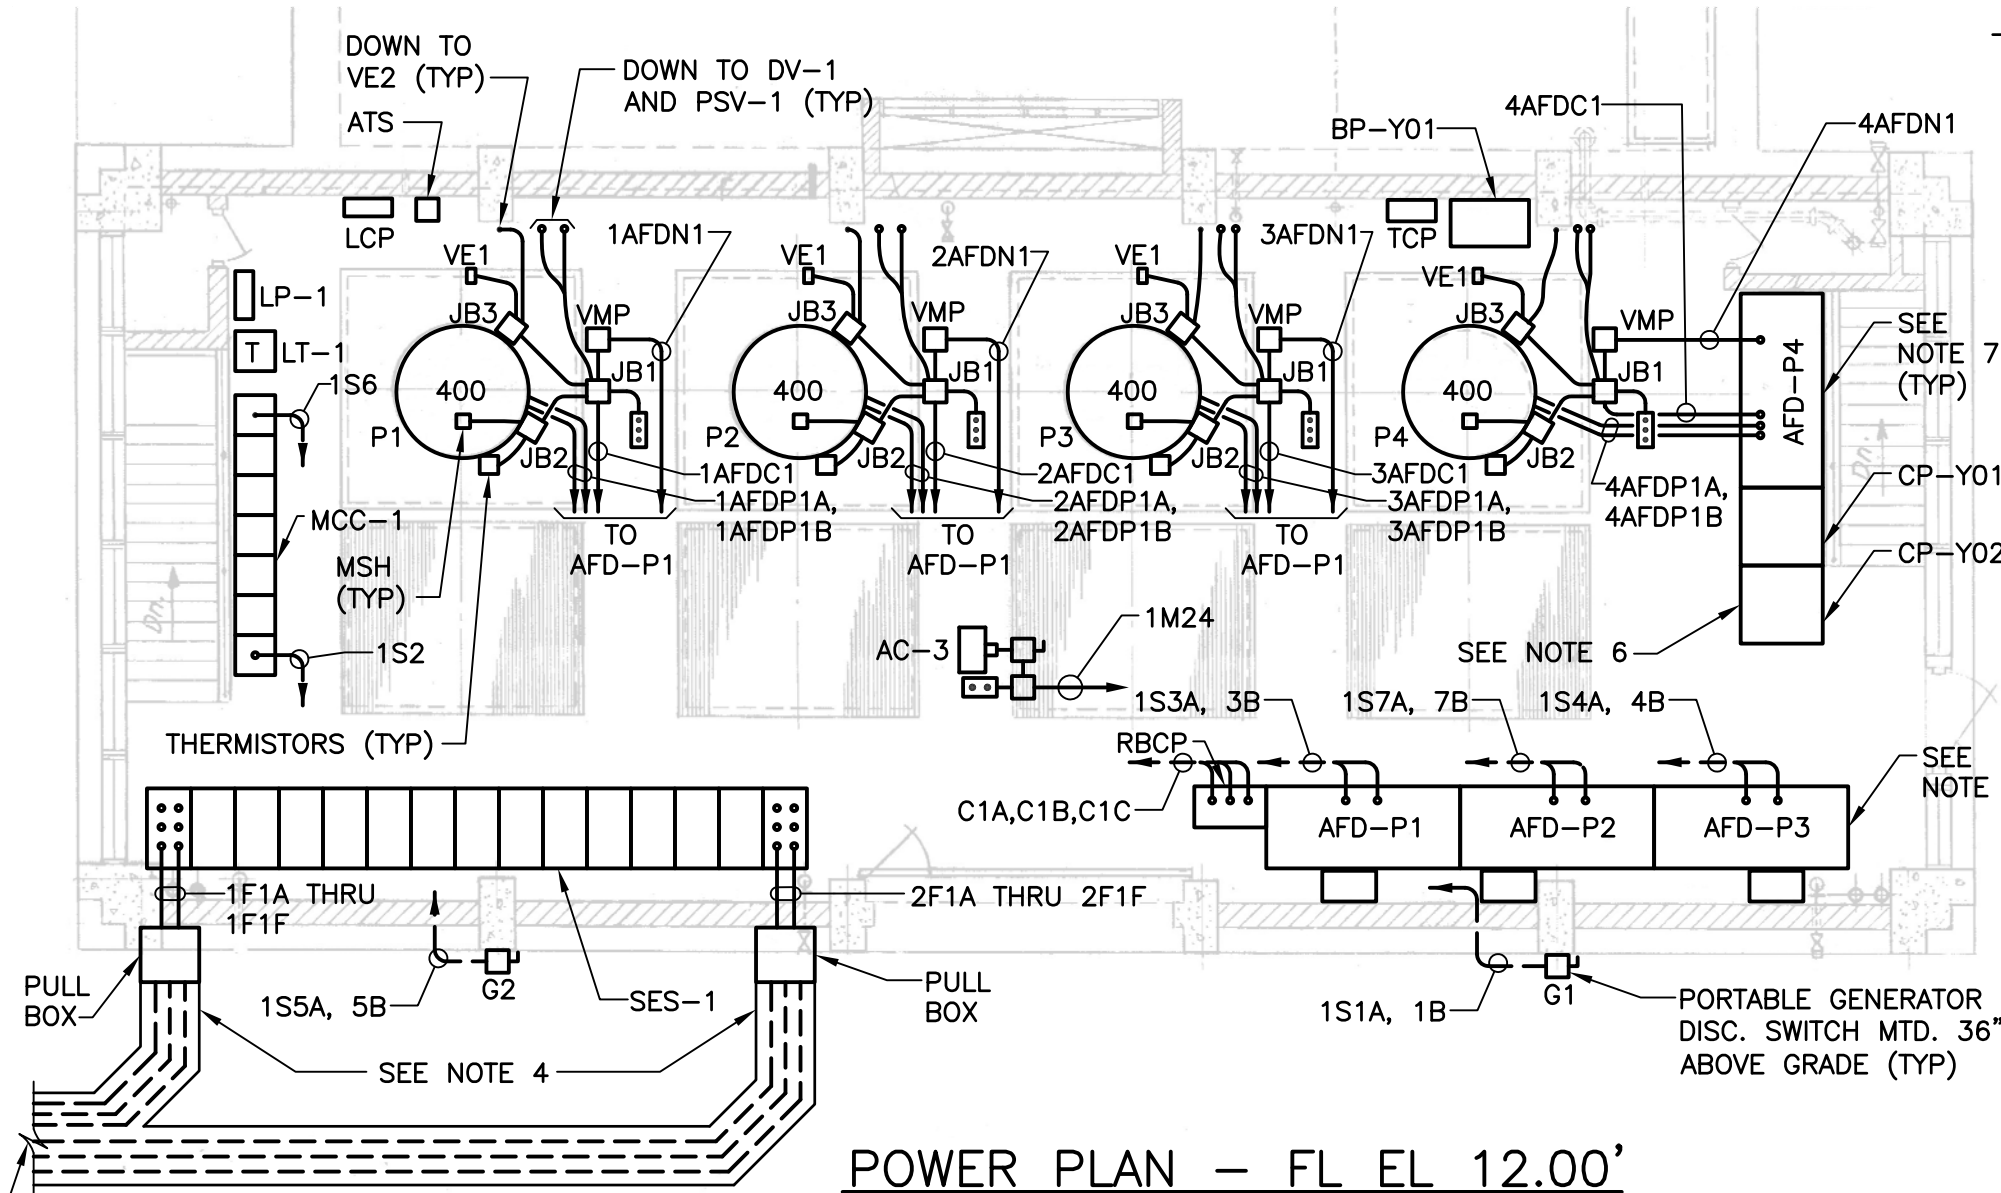

POWER PLAN - FL EL 12.00'

SCALE: 1/8" = 1'-0"

FILE: YBOREE10 1:1 06/21/11 10:25 GH-A



GREELEY AND HANSEN

1715 N. WESTSHORE BLVD., STE. 464
TAMPA, FLORIDA 33607
CERTIFICATE OF AUTHORIZATION NO. 37



SCALE IN FEET

DESIGNED RZ
DRAWN OC
CHECKED DD

NO.	DATE	APPD	REVISION
P.E. NAME: NORBERT VIRANYI		P.E. NO. 72587	
P.E. NAME:			
DATE:			

CITY OF TAMPA WASTEWATER DEPARTMENT
YBOR PUMPING STATION REHABILITATION

ELECTRICAL


POWER PLAN - FL EL 12.00'

FILE: YBOREE10

NO. **E10**

DATE JUNE 2011

FILE: YBOREE11 1:1 06/21/11 10:19 GH-A

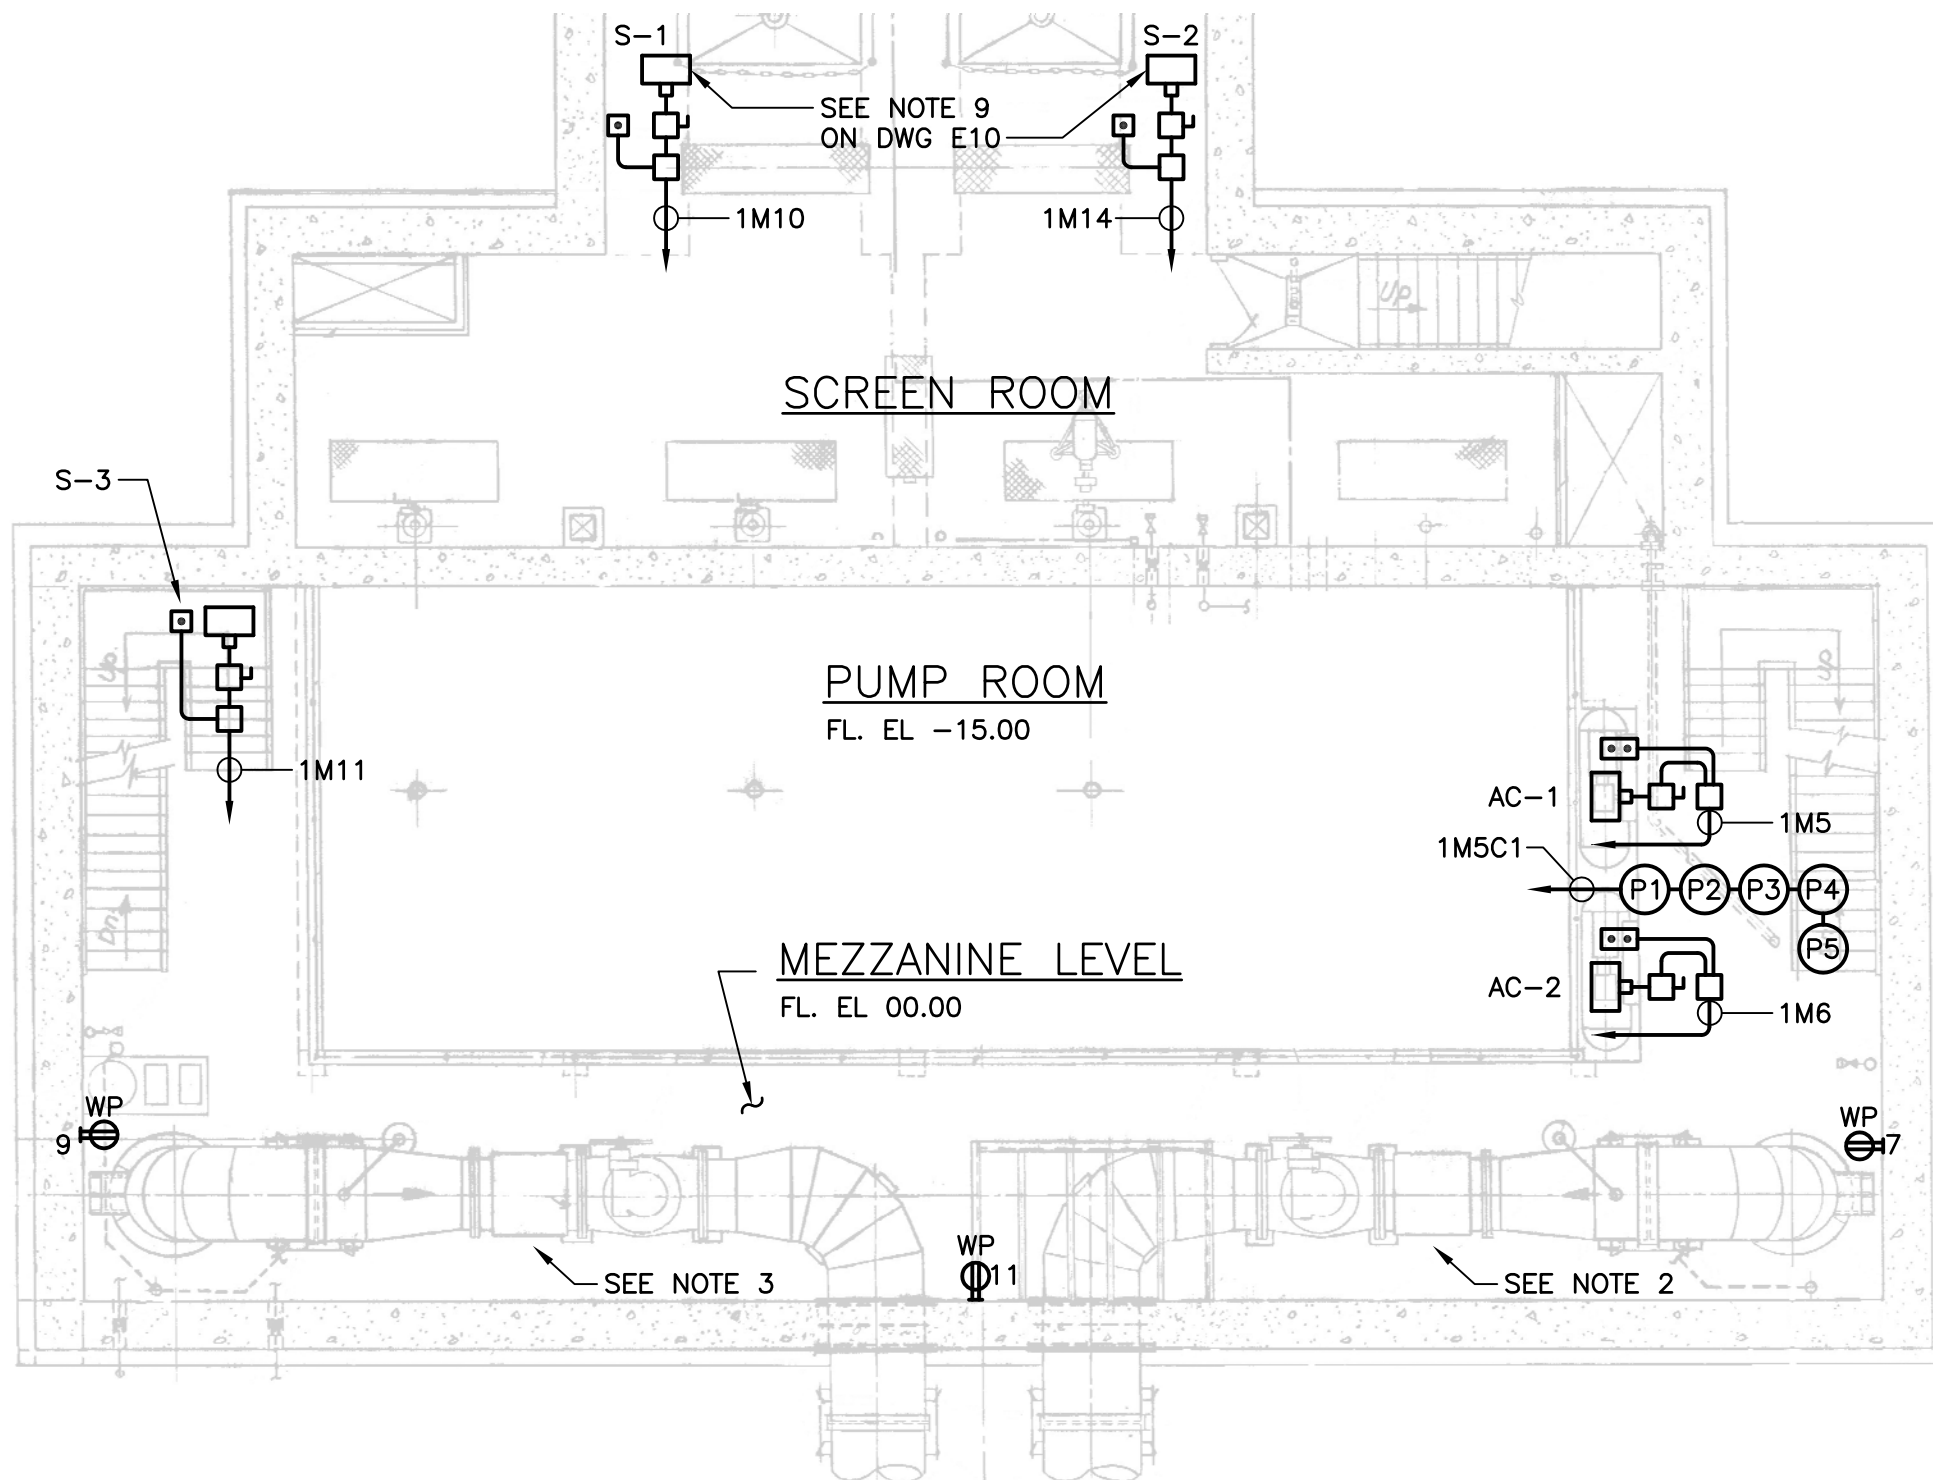

POWER PLAN - FL EL 00.00'
SCALE: 1/8"=1'-0"


NOTES:

1. SEE NOTES ON DWG E-10.
2. EXISTING EAST FLOW METER TO BE REMOVED. SEE DEMOLITION DRAWING FOR DETAIL.
3. EXISTING WEST FLOW METER TO REMAIN. RECONNECT AS SHOWN AND REQUIRED. SEE INSTRUMENTATION DRAWING FOR DETAIL.



GREELEY AND HANSEN

1715 N. WESTSHORE BLVD., STE. 464
TAMPA, FLORIDA 33607
CERTIFICATE OF AUTHORIZATION NO. 37

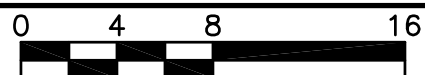

SCALE IN FEET

DESIGNED RZ
DRAWN OC
CHECKED DD

NO.	DATE	APPD	REVISION
P.E. NAME: NORBERT VIRANYI		P.E. NO. 72587	
P.E. NAME:			
DATE:			

CITY OF TAMPA WASTEWATER DEPARTMENT
YBOR PUMPING STATION REHABILITATION

ELECTRICAL


POWER PLAN - FL EL 00.00'

FILE: YBOREE11

NO. **E11**

DATE JUNE 2011

FILE: YBOREE14 1:1 06/21/11 08:12 GH-A

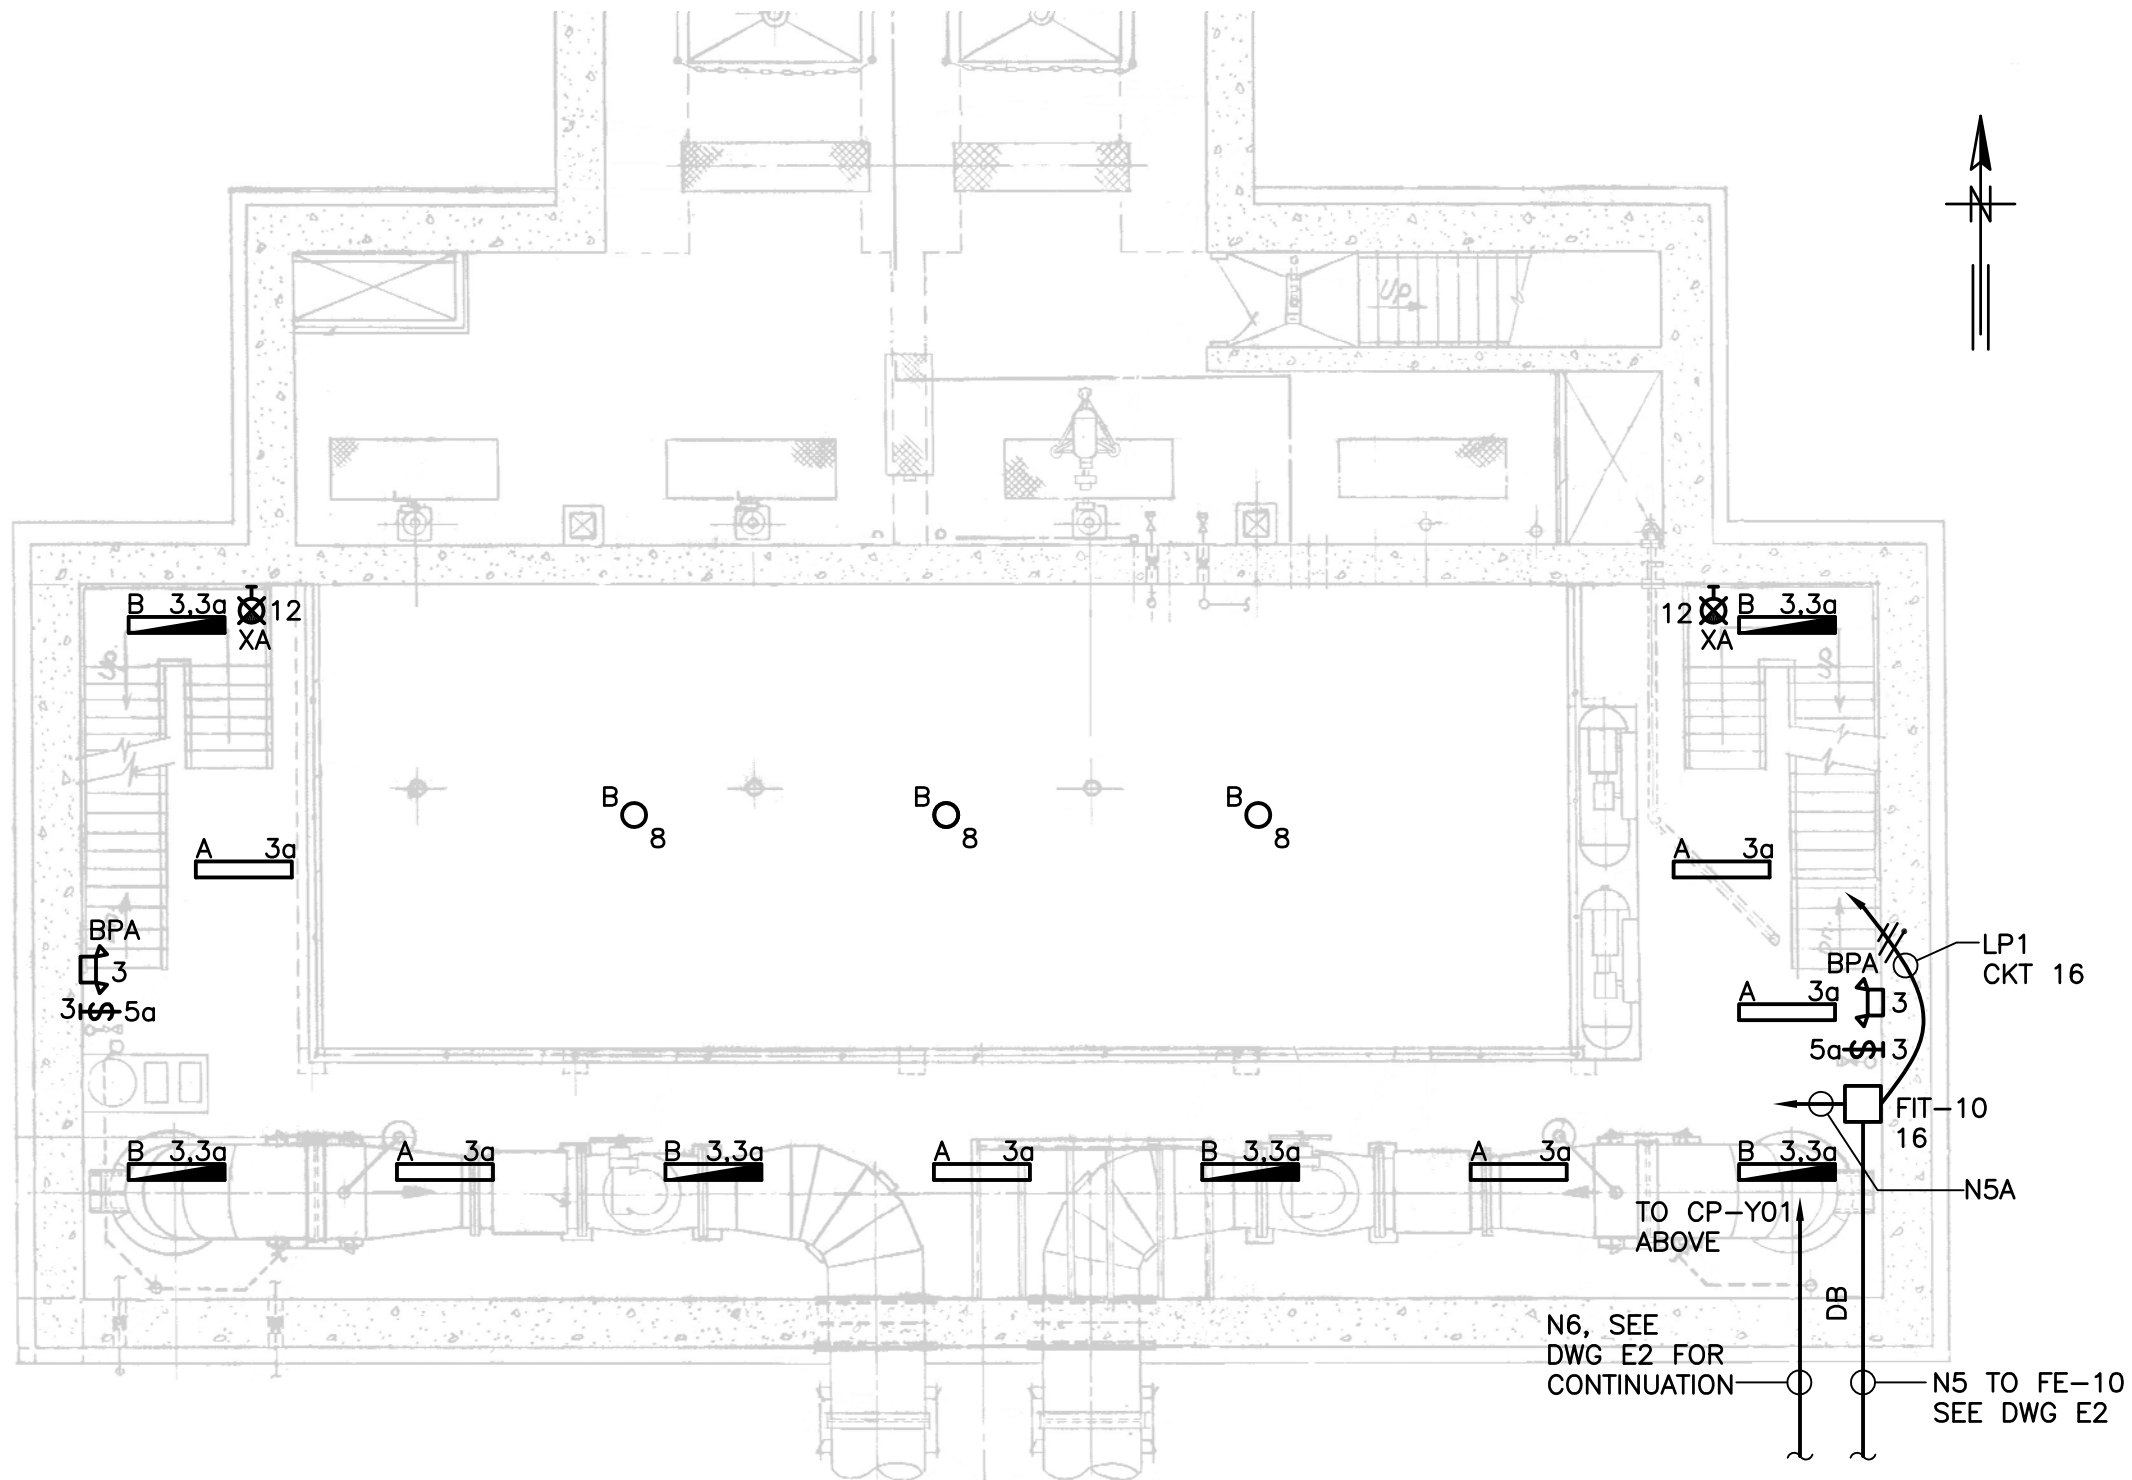

LIGHTING PLAN - FL EL 00.00'

SCALE: 1/8"=1'-0"


NOTES:

1. SEE NOTES ON DWG E13



GREELEY AND HANSEN

1715 N. WESTSHORE BLVD., STE. 464
TAMPA, FLORIDA 33607
CERTIFICATE OF AUTHORIZATION NO. 37

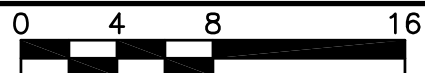

SCALE IN FEET

DESIGNED RZ
DRAWN TT
CHECKED DD

NO.	DATE	APPD	REVISION
P.E. NAME: NORBERT VIRANYI		P.E. NO. 72587	
P.E. NAME:			
DATE:			

CITY OF TAMPA WASTEWATER DEPARTMENT
YBOR PUMPING STATION REHABILITATION

ELECTRICAL


LIGHTING PLAN - FL EL 00.00'

FILE: YBOREE14

NO. **E14**

DATE JUNE 2011

FILE: YBOREE15 1:1 06/21/11 09:31 GH-A

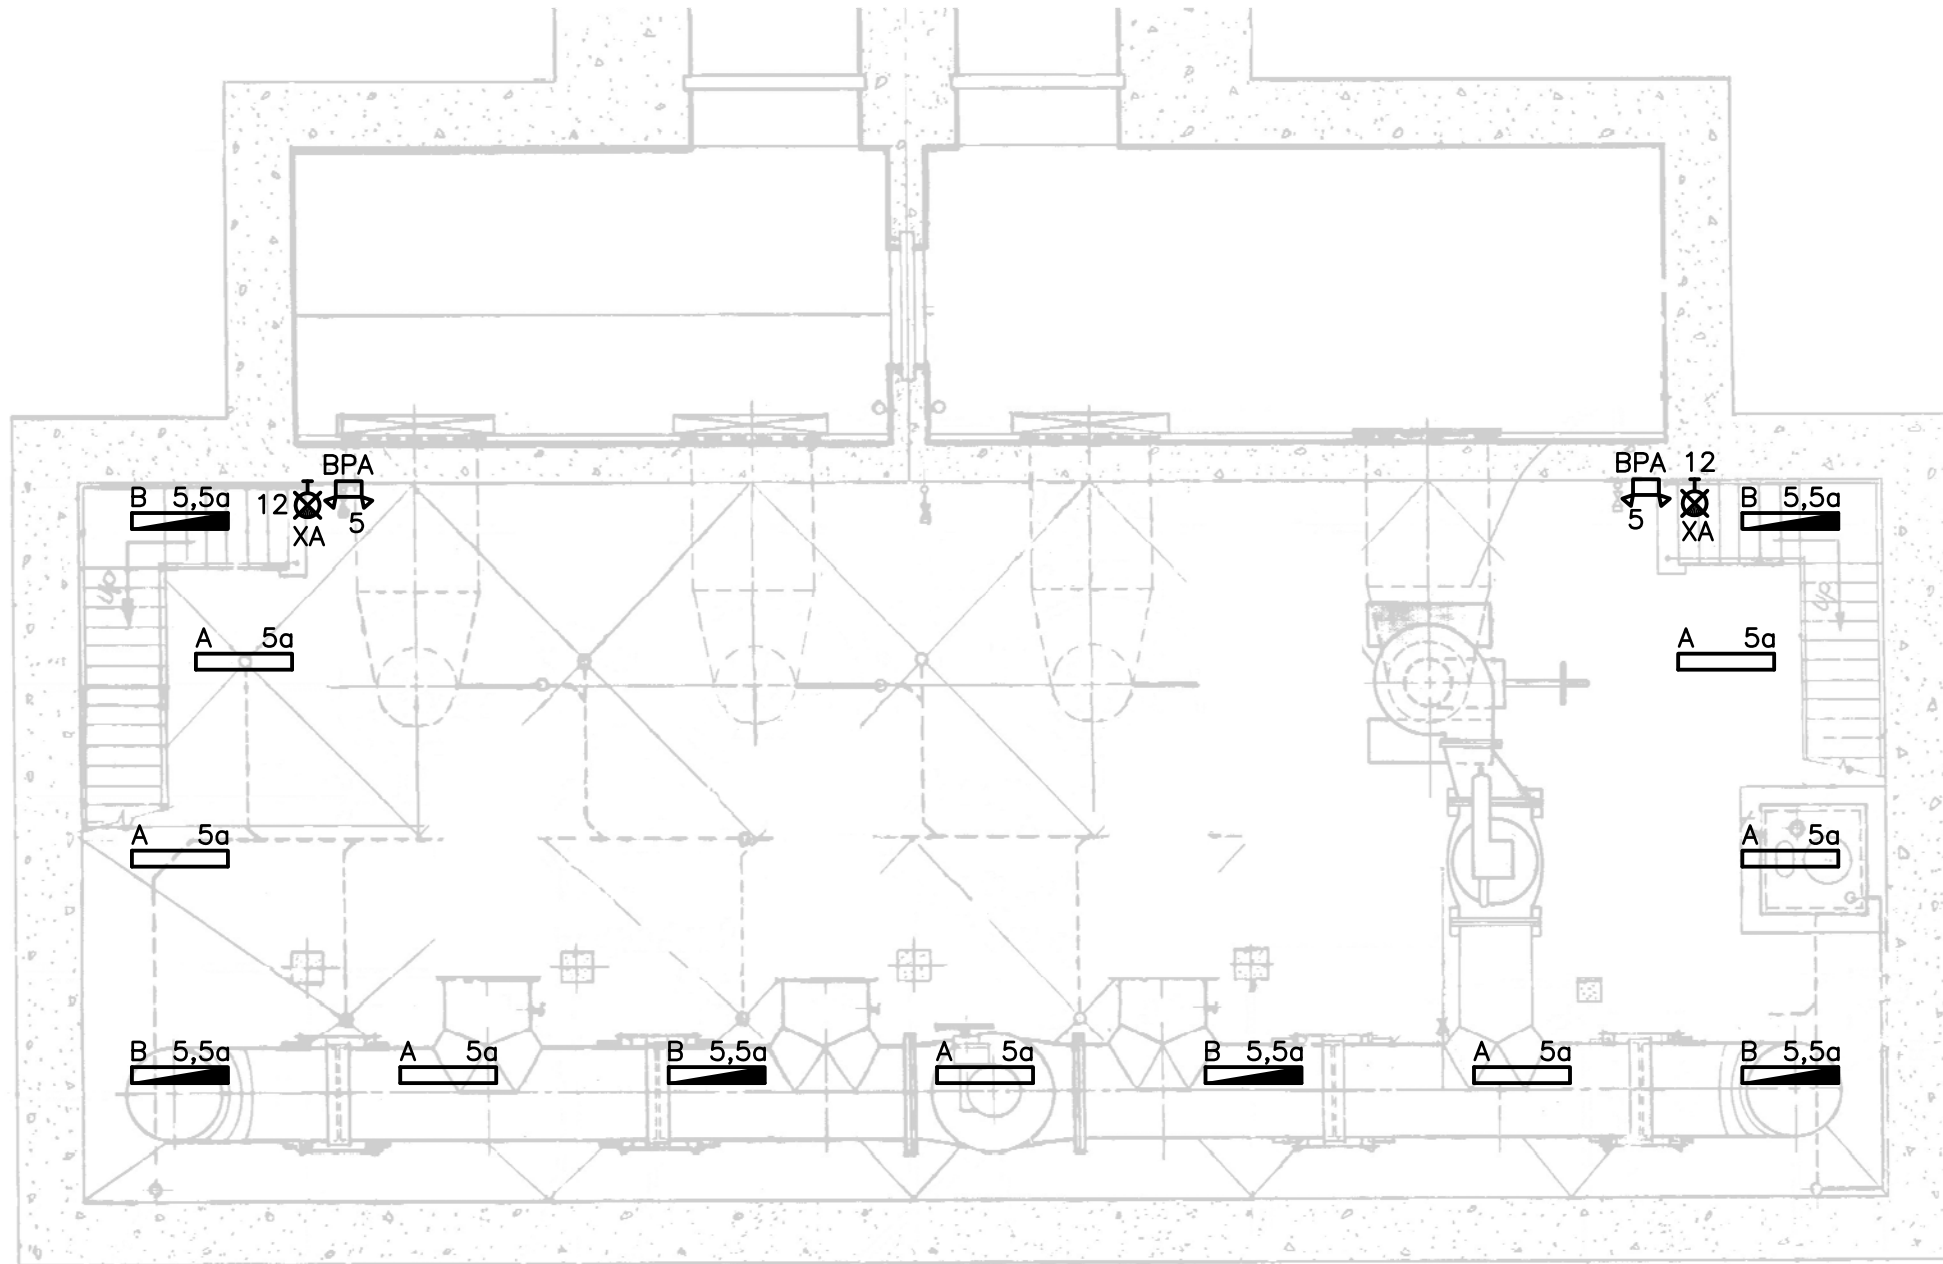


POWER AND LIGHTING
PLAN - FL EL -15.00'
SCALE: 1/8"=1'-0"

NOTES:
1. SEE NOTES ON DWG
E13



GREELEY AND HANSEN

1715 N. WESTSHORE BLVD., STE. 464
TAMPA, FLORIDA 33607
CERTIFICATE OF AUTHORIZATION NO. 37

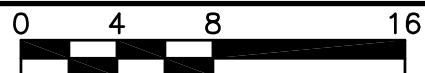

SCALE IN FEET

DESIGNED RZ
DRAWN TT
CHECKED DD

NO.	DATE	APPD	REVISION
P.E. NAME: NORBERT VIRANYI		P.E. NO. 72587	
P.E. NAME:			
DATE:			

CITY OF TAMPA WASTEWATER DEPARTMENT
YBOR PUMPING STATION REHABILITATION

ELECTRICAL

LIGHTING PLAN - FL EL -15.00'


FILE: YBOREE15

NO. **E15**

DATE JUNE 2011

FILE: YBOREE16 1:1 06/21/11 08:20 GH-A

LIGHTING FIXTURE SCHEDULE								
MARK	MANUFACTURER OR EQUAL	CATALOG NUMBER	VOLTS	NO.	LAMPS		MOUNTING	DESCRIPTION
					WATTS	TYPE		
A	METALUX	VT3232DRUNV-ERB1WLM4	120V	2	32WT8	FLUORESCENT	SUSPENDED	4'-0" VAPORTIGHT FIXTURE WITH FIBERGLASS HOUSING TB ELECTRONIC RAPID START BALLAST, AND ACRYLIC PRISMATIC REFRACTOR WRAP AROUND LENS.
B	METALUX	VT3232DRUNVE-LEB1WLM4	120V	2	32WT8	FLUORESCENT	SUSPENDED	SAME AS TYPE "A" EXCEPT W/EMERGENCY BATTERY PACK
C	LUMARK	MP55SA23M-40 OMTORSCRWG23	120V	1	400	METAL HALIDE	PENDANT	HIGH BAY HID FIXTURE WITH HEAVY DUTY FORMED STEEL HOUSING AND FIELD ADJUSTABLE REFLECTOR, PULSE START BALLAST, OPEN RATED SOCKET AND SUITABLE FOR WET/DAMP LOCATIONS.
D	LUMARK	MPWFC200MT-F1WG/WPFC	120V	1	200	METAL HALIDE	SURFACE WALL	WALL PACK FIXTURE, UL LISTED FOR WET LOCATIONS, RUGGED DIE CAST ALUMINUM HOUSING WITH STAINLESS STEEL HARDWARE AND POWDER COAT FINISH.
BPA	SURE LITES	UMB-7	120V	2	9W	8VDC 29-03 INCAND	SURFACE WALL	EMERGENCY LIGHTING BATTERY PACK WITH NEMA 4X INDUSTRIAL FIBERGLASS ENCLOSURE, 8VDC LEAD CALCIUM MAINTENANCE FREE BATTERY, SOLID CHARGER, TEST PUSHBUTTON POWER ON INDICATING LIGHT, INTEGRAL FIXTURE HEADS OF HIGH IMPACT THERMOPLASTIC AND CAPABLE OF PROVIDING EMERGENCY ILLUMINATION FOR 1-1/2 HOURS DURING LOSS OF NORMAL POWER AT 87-1/2% OF RATED DC VOLTAGE.
XA	SURE LITES	CAX-717-000-R	120V	1	7	LED	SURFACE WALL	SELF POWER EMERGENCY EXIT SIGN WITH DIE CAST ALUMINUM HOUSING, STENCILED BRUSHED ALUMINUM FACE PLATE WITH RED LETTERS, NICKEL CADMIUM MAINTENANCE FREE BATTERY, SOLID STATE INTEGRAL CHARGER AND TEST SWITCH.

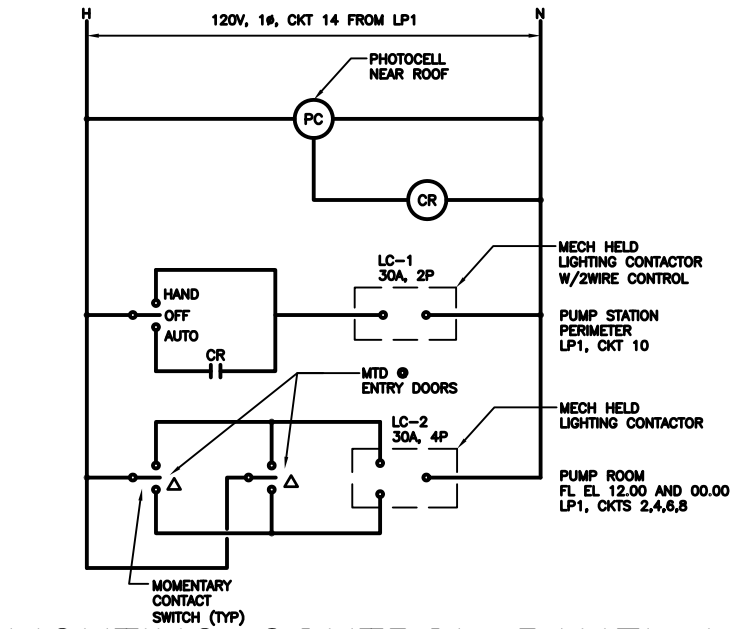


LIGHTING CONTROL PANEL LCP


NOTE: DEVICES ARE MOUNTED ON OR IN THE LCP UNLESS OTHERWISE NOTED.

CIRCUIT SCHEDULE – PANEL LP1										150A MAIN BREAKER, 208/120V, 3PHASE, 4 WIRE W/GRD									
PHASE A					PHASE B					PHASE C									
CKT	WATTS	BRKR	SERVES		CKT	WATTS	BRKR	SERVES		CKT	WATTS	BRKR	SERVES						
1	566	20A	LIGHTING		3	832	20A	LIGHTING		5	771	20A	LIGHTING						
2	1356	20A	LIGHTING		4	1808	20A	LIGHTING		6	1356	20A	LIGHTING						
7	800	20A	RECEPTACLES		9	800	20A	RECEPTACLES		11	800	20A	RECEPTACLES						
8	1356	20A	LIGHTING		10	1589	20A	LIGHTING		12	300	20A	EXIT SIGNS						
13	1000	20A	CP–Y01		15	1000	20A	CP–Y01		17	1000	20A	CP–Y02						
14	500	20A	LTG CONTACTOR PANEL		16	500	20A	FIT–100		18	500	20A	BP–Y01						
19	1000	20A	CP–Y02		21		20A	SPARE		23	1000	20A	AFD–P3						
20	1000	20A	AFD–P1		22	1000	20A	AFD–P2		24	1000	20A	AFD–P4						
25		20A	SPARE		27		20A	SPARE		27		20A	SPARE						
26		20A	SPARE		28		20A	SPARE		28		20A	SPARE						
31		20A	SPACE		33		20A	SPACE		33		20A	SPACE						
32		20A	SPACE		34		20A	SPACE		34		20A	SPACE						
37		20A	SPACE		39		20A	SPACE		41		20A	SPACE						
38		20A	SPACE		40		20A	SPACE		42		20A	SPACE						
	7578					7529					6727								

A	7578
B	7529
C	6727
TOTAL	21834 WATTS

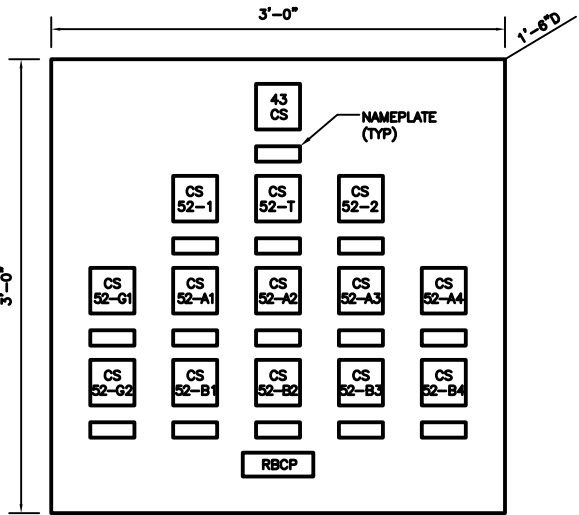

REMOTE BREAKER CONTROL PANEL RBCP FRONT ELEVATION

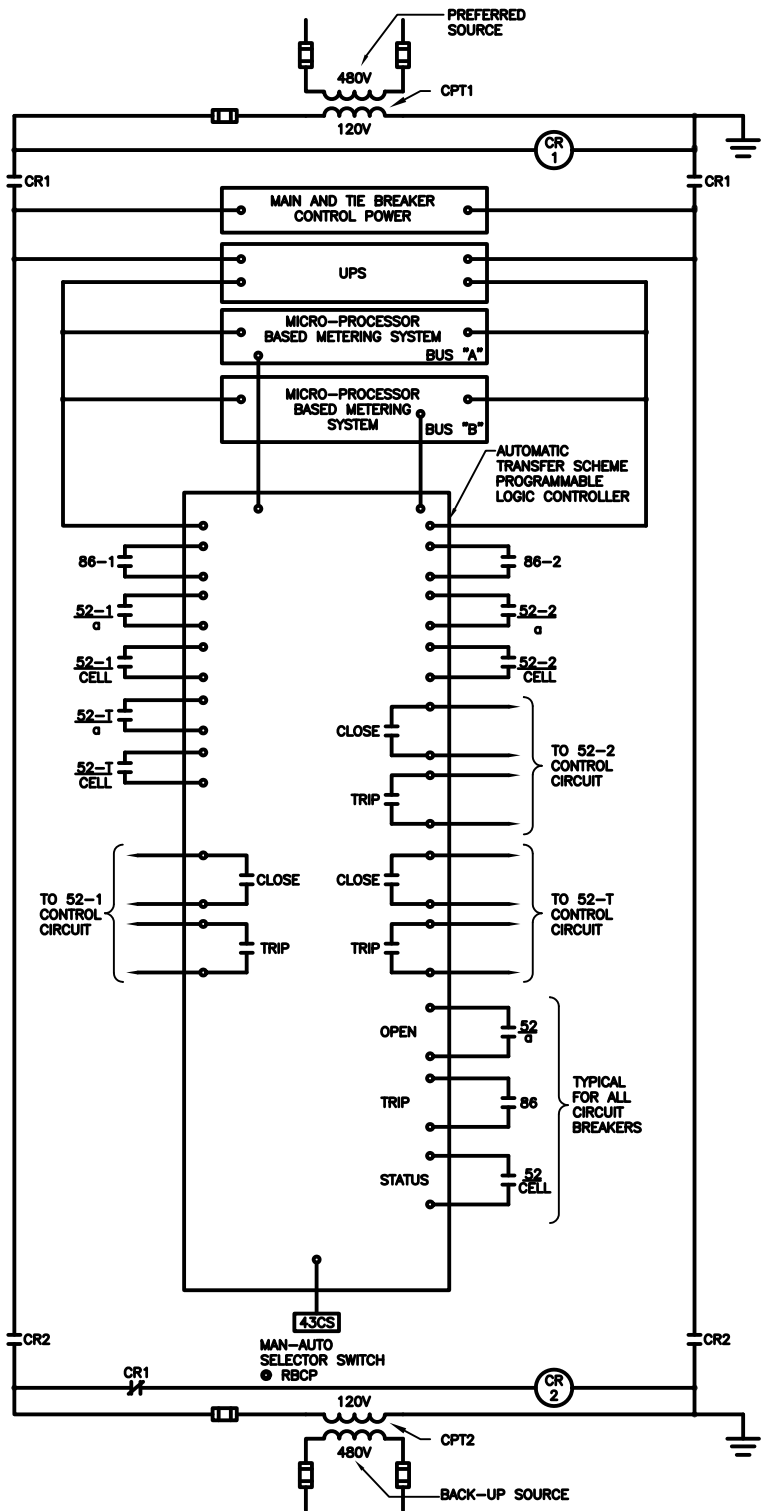


MAIN AND TIE BREAKER CONTROL POWER AND AUTO TRANSFER SCHEME SYSTEM



GREELEY AND HANSEN

1715 N. WESTSHORE BLVD., STE. 464
TAMPA, FLORIDA 33607
CERTIFICATE OF AUTHORIZATION NO. 37

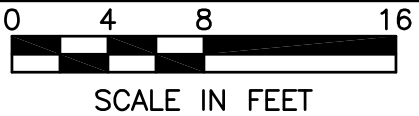

DESIGNED RZ
DRAWN TT
CHECKED DD

NO. DATE APPD REVISION
P.E. NAME: NORBERT VIRANYI P.E. NO. 72587
P.E. NAME: _____
DATE: _____

CITY OF TAMPA WASTEWATER DEPARTMENT
YBOR PUMPING STATION REHABILITATION

ELECTRICAL

MISCELLANEOUS

FILE: YBOREE16

NO. **E16**

DATE JUNE 2011

FILE: YBOREE17 1:1 06/21/11 08:30 GH-A

CONDUIT		CONDUCTOR QUANTITY & SIZE	FROM	TO	REMARKS
NUMBER	SIZE				

INCOMING SERVICE FEEDER

1F1A	4"	3-500KCM, 1#3/OG	TECO TRANSFORMER	480V SES-1, MAIN BREAKER "A"	
1F1B	4"	3-500KCM, 1#3/OG	TECO TRANSFORMER	480V SES-1, MAIN BREAKER "A"	
1F1C	4"	3-500KCM, 1#3/OG	TECO TRANSFORMER	480V SES-1, MAIN BREAKER "A"	
1F1D	4"	3-500KCM, 1#3/OG	TECO TRANSFORMER	480V SES-1, MAIN BREAKER "A"	
1F1E	4"	3-500KCM, 1#3/OG	TECO TRANSFORMER	480V SES-1, MAIN BREAKER "A"	
1F1F	4"	3-500KCM, 1#3/OG	TECO TRANSFORMER	480V SES-1, MAIN BREAKER "A"	
1F1G	2"	CABLE PER TECO REQUIREMENTS	TECO TRANSFORMER	TECO METER SOCKET	ON P.S. EXTERIOR WALL
2F1A	4"	3-500KCM, 1#3/OG	TECO TRANSFORMER	480V SES-1, MAIN BREAKER "B"	
2F1B	4"	3-500KCM, 1#3/OG	TECO TRANSFORMER	480V SES-1, MAIN BREAKER "B"	
2F1C	4"	3-500KCM, 1#3/OG	TECO TRANSFORMER	480V SES-1, MAIN BREAKER "B"	
2F1D	4"	3-500KCM, 1#3/OG	TECO TRANSFORMER	480V SES-1, MAIN BREAKER "B"	
2F1E	4"	3-500KCM, 1#3/OG	TECO TRANSFORMER	480V SES-1, MAIN BREAKER "B"	
2F1F	4"	3-500KCM, 1#3/OG	TECO TRANSFORMER	480V SES-1, MAIN BREAKER "B"	
2F1G	2"	CABLE PER TECO REQUIREMENTS	TECO TRANSFORMER	TECO METER SOCKET	ON P.S. EXTERIOR WALL

480V MAIN SERVICE SWITCHGEAR SES-1

1S1A	3 1/2"	3-500KCM, 1#1/OG	SES-1, BUS "A"	GENERATOR DISC. SW.	
1S1B	3 1/2"	3-500KCM, 1#1/OG	SES-1, BUS "A"	GENERATOR DISC. SW.	
1S2	3 1/2"	3-500KCM, 1#3G	SES-1, BUS "A"	MCC-1	
1S3A	3 1/2"	3-500KCM, 1#1/OG	SES-1, BUS "A"	AFD-P1	
1S3B	3 1/2"	3-500KCM, 1#1/OG	SES-1, BUS "A"	AFD-P1	
1S4A	3 1/2"	3-500KCM, 1#1/OG	SES-1, BUS "A"	AFD-P3	
1S4B	3 1/2"	3-500KCM, 1#1/OG	SES-1, BUS "A"	AFD-P3	
1S5A	3 1/2"	3-500KCM, 1#1/OG	SES-1, BUS "B"	GENERATOR DISC. SW.	
1S5B	3 1/2"	3-500KCM, 1#1/OG	SES-1, BUS "B"	GENERATOR DISC. SW.	
1S6	3 1/2"	3-500KCM, 1#3G	SES-1, BUS "B"	MCC-1	
1S7A	3 1/2"	3-500KCM, 1#1/OG	SES-1, BUS "B"	AFD-P2	
1S7B	3 1/2"	3-500KCM, 1#1/OG	SES-1, BUS "B"	AFD-P2	
1S8A	3 1/2"	3-500KCM, 1#1/OG	SES-1, BUS "B"	AFD-P4	
1S8B	3 1/2"	3-500KCM, 1#1/OG	SES-1, BUS "B"	AFD-P4	

ADJUSTABLE FREQUENCY DRIVE AFD-P1

1AFDP1A	3 1/2"	3-500KCM, 1#1/OG	AFD-P1	SEWAGE PUMP P1	
1AFDP1B	3 1/2"	3-500KCM, 1#1/OG	AFD-P1	SEWAGE PUMP P1	
1AFDC1	1 1/2"	42#14 (4 SPARE), 1#14G	AFD-P1	CONTROL TB ● MOTOR	COIL SPARES
1AFDC1A	3/4"	6#14, 1#14G	CONTROL TB ● MOTOR	PUSHBUTTON STATION	
1AFDC1B	3/4"	12#14, 1#14G	CONTROL TB ● MOTOR	VIBRATION MONITORING PNL VMP	
1AFDC1C	-	CABLES BY MANUFACTURER	JB ● PUMP/MOTOR	CONDUIT AS REQUIRED	
1AFDC1D	-	CABLES BY MANUFACTURER	JB ● PUMP/MOTOR	MOTOR VIBRATION SENSOR	CONDUIT AS REQUIRED
1AFDC1E	-	CABLES BY MANUFACTURER	JB ● PUMP/MOTOR	PUMP VIBRATION SENSOR	CONDUIT AS REQUIRED
1AFDC1F	3/4"	4#14, 1#14G	CONTROL TB ● MOTOR	JB ● MOTOR	
1AFDC1G	3/4"	2#14, 1#14G	JB ● MOTOR	MOTOR SPACE HEATER	
1AFDC1H	3/4"	2#14, 1#14G	JB ● MOTOR	MOTOR TEMP SWITCH	
1AFDC1J	3/4"	10#14, 1#14G	CONTROL TB ● MOTOR	DISCH. VALVE DV-1	
1AFDC1K	3/4"	4#14, 1#14G	CONTROL TB ● MOTOR	SUNCTION VALVE PSV-1	
1AFDC1L	3/4"	4#14, 1#14G	AFD-P1	VENT FAN/DAMPER CIRCUIT	
1AFDN1	1"	2-2/C#16SH	AFD-P1	VMP	
1AFDC2	1 1/4"	28#14 (6 SPARE), 1#14G	AFD-P1	CP-Y02	
1AFDN2	1"	4-2/C#16SH	AFD-P1	CP-Y02	

ADJUSTABLE FREQUENCY DRIVE AFD-P2

2AFDP1A	3 1/2"	3-500KCM, 1#1/OG	AFD-P2	SEWAGE PUMP P2	
2AFDP1B	3 1/2"	3-500KCM, 1#1/OG	AFD-P2	SEWAGE PUMP P2	
2AFDC1	1 1/2"	42#14 (4 SPARE), 1#14G	AFD-P2	CONTROL TB ● MOTOR	COIL SPARES
2AFDC1A	3/4"	6#14, 1#14G	CONTROL TB ● MOTOR	PUSHBUTTON STATION	
2AFDC1B	3/4"	12#14, 1#14G	CONTROL TB ● MOTOR	VIBRATION MONITORING PNL VMP	
2AFDC1C	-	CABLES BY MANUFACTURER	JB ● PUMP/MOTOR	CONDUIT AS REQUIRED	
2AFDC1D	-	CABLES BY MANUFACTURER	JB ● PUMP/MOTOR	MOTOR VIBRATION SENSOR	CONDUIT AS REQUIRED
2AFDC1E	-	CABLES BY MANUFACTURER	JB ● PUMP/MOTOR	PUMP VIBRATION SENSOR	CONDUIT AS REQUIRED
2AFDC1F	3/4"	4#14, 1#14G	CONTROL TB ● MOTOR	JB ● MOTOR	
2AFDC1G	3/4"	2#14, 1#14G	JB ● MOTOR	MOTOR SPACE HEATER	
2AFDC1H	3/4"	2#14, 1#14G	JB ● MOTOR	MOTOR TEMP SWITCH	

CONDUIT		CONDUCTOR QUANTITY & SIZE	FROM	TO	REMARKS
NUMBER	SIZE				

2AFDC1J	3/4"	10#14, 1#14G	CONTROL TB ● MOTOR	DISCH. VALVE DV-2	
2AFDC1K	3/4"	4#14, 1#14G	CONTROL TB ● MOTOR	SUNCTION VALVE PSV-2	
2AFDC1L	3/4"	4#14, 1#14G	AFD-P2	VENT FAN/DAMPER CIRCUIT	
2AFDN1	1"	2-2/C#16SH	AFD-P2	VMP	
2AFDC2	1 1/4"	28#14 (6 SPARE), 1#14G	AFD-P2	CP-Y02	
2AFDN2	1"	4-2/C#16SH	AFD-P2	CP-Y02	

ADJUSTABLE FREQUENCY DRIVE AFD-P3

3AFDP1A	3 1/2"	3-500KCM, 1#1/OG	AFD-P3	SEWAGE PUMP P3	
3AFDP1B	3 1/2"	3-500KCM, 1#1/OG	AFD-P3	SEWAGE PUMP P3	
3AFDC1	1 1/2"	42#14 (4 SPARE), 1#14G	AFD-P3	CONTROL TB ● MOTOR	COIL SPARES
3AFDC1A	3/4"	6#14, 1#14G	CONTROL TB ● MOTOR	PUSHBUTTON STATION	
3AFDC1B	3/4"	12#14, 1#14G	CONTROL TB ● MOTOR	VIBRATION MONITORING PNL VMP	
3AFDC1C	-	CABLES BY MANUFACTURER	VMP	JB ● PUMP/MOTOR	CONDUIT AS REQUIRED
3AFDC1D	-	CABLES BY MANUFACTURER	JB ● PUMP/MOTOR	MOTOR VIBRATION SENSOR	CONDUIT AS REQUIRED
3AFDC1E	-	CABLES BY MANUFACTURER	JB ● PUMP/MOTOR	PUMP VIBRATION SENSOR	CONDUIT AS REQUIRED
3AFDC1F	3/4"	4#14, 1#14G	CONTROL TB ● MOTOR	JB ● MOTOR	
3AFDC1G	3/4"	2#14, 1#14G	JB ● MOTOR	MOTOR SPACE HEATER	
3AFDC1H	3/4"	2#14, 1#14G	JB ● MOTOR	MOTOR TEMP SWITCH	
3AFDC1J	3/4"	10#14, 1#14G	CONTROL TB ● MOTOR	DISCH. VALVE DV-3	
3AFDC1K	3/4"	4#14, 1#14G	CONTROL TB ● MOTOR	SUNCTION VALVE PSV-3	
3AFDC1L	3/4"	4#14, 1#14G	AFD-P3	VENT FAN/DAMPER CIRCUIT	
3AFDN1	1"	2-2/C#16SH	AFD-P3	VMP	
3AFDC2	1 1/4"	28#14 (6 SPARE), 1#14G	AFD-P3	CP-Y02	
3AFDN2	1"	4-2/C#16SH	AFD-P3	CP-Y02	

ADJUSTABLE FREQUENCY DRIVE AFD-P4

4AFDP1A	3 1/2"	3-500KCM, 1#1/OG	AFD-P4	SEWAGE PUMP P4	
4AFDP1B	3 1/2"	3-500KCM, 1#1/OG	AFD-P4	SEWAGE PUMP P4	
4AFDC1	1 1/2"	42#14 (4 SPARE), 1#14G	AFD-P4	CONTROL TB ● MOTOR	COIL SPARES
4AFDC1A	3/4"	6#14, 1#14G	CONTROL TB ● MOTOR	PUSHBUTTON STATION	
4AFDC1B	3/4"	12#14, 1#14G	CONTROL TB ● MOTOR	VIBRATION MONITORING PNL VMP	
4AFDC1C	-	CABLES BY MANUFACTURER	VMP	JB ● PUMP/MOTOR	CONDUIT AS REQUIRED
4AFDC1D	-	CABLES BY MANUFACTURER	JB ● PUMP/MOTOR	MOTOR VIBRATION SENSOR	CONDUIT AS REQUIRED
4AFDC1E	-	CABLES BY MANUFACTURER	JB ● PUMP/MOTOR	PUMP VIBRATION SENSOR	CONDUIT AS REQUIRED
4AFDC1F	3/4"	4#14, 1#14G	CONTROL TB ● MOTOR	JB ● MOTOR	
4AFDC1G	3/4"	2#14, 1#14G	JB ● MOTOR	MOTOR SPACE HEATER	
4AFDC1H	3/4"	2#14, 1#14G	JB ● MOTOR	MOTOR TEMP SWITCH	
4AFDC1J	3/4"	10#14, 1#14G	CONTROL TB ● MOTOR	DISCH. VALVE DV-4	
4AFDC1K	3/4"	4#14, 1#14G	CONTROL TB ● MOTOR	SUNCTION VALVE PSV-4	
4AFDC1L	3/4"	4#14, 1#14G	AFD-P4	VENT FAN/DAMPER CIRCUIT	
4AFDN1	1"	2-2/C#16SH	AFD-P4	VMP	
4AFDC2	1 1/4"	28#14 (6 SPARE), 1#14G	AFD-P4	CP-Y02	
4AFDN2	1"	4-2/C#16SH	AFD-P4	CP-Y02	

480V MOTOR CONTROL CENTER

1M1	1"	3#8, 1#10G	MCC-1	BRIDGE CRANE BC-1 J	VIA DISC. SW.
1M2	3/4"	3#10, 1#12G	MCC-1	PORTABLE PUMP RECEPT.	VIA DISC. SW.
1M3	3/4"	3#12, 1#12G	MCC-1	SUCTION VALVE PSV-1	VIA DISC. SW.
1M3A	3/4"	4#14, 1#14G	SUCTION VALVE PSV-1	CP-Y02	
1M4	3/4"	3#12, 1#12G	MCC-1	SUCTION VALVE PSV-3	VIA DISC. SW.
1M4A	3/4"	4#14, 1#14G	SUCTION VALVE PSV-3	PCP	
1M5	3/4"	3#10, 6#14, 1#10G	MCC-1	JB ● AIR COMPRESSOR AC-1	
1MSA	3/4"	3#10, 1#10G	JB ● AIR COMPRESSOR AC-1	AIR COMPRESSOR AC-1	VIA DISC. SW.
1MSB	3/4"	6#14, 1#14G	JB ● AIR COMPRESSOR AC-1	PUSHBUTTON STATION AND COMPRESSOR PROTECTION	
1MSC1	3/4"	12#14, 1#14G	MCC-1	PRESSURE SWITCHES	
1M6	3/4"	3#10, 6#14, 1#10G	MCC-1	JB ● AIR COMPRES. AC-2	
1M6A	3/4"	3#10, 1#10G	JB ● AIR COMPRESSOR AC-2	AIR COMPRESSOR AC-2	VIA DISC. SW.
1M6B	3/4"	6#14, 1#14G	JB ● AIR COMPRESSOR AC-2	PUSHBUTTON STATION AND COMPRESSOR PROTECTION	
1M7	3/4"	3#12, 2#14, 1#12G	MCC-1	JB ● EXH. FAN REF-1	
1M7A	3/4"	3#12, 1#12G	JB ● EXHAUST FAN REF-1	EXHAUST FAN REF-1	VIA DISC. SW.
1M7B	3/4"	2#14, 1#14G	JB ● EXHAUST FAN REF-1	PUSHBUTTON STATION	
1M8	3/4"	3#12, 2#14, 1#12G	MCC-1	JB ● EXH. FAN REF-3	
1M8A	3/4"	3#12, 1#12G	JB ● EXHAUST FAN REF-3	EXHAUST FAN REF-3	VIA DISC. SW.
1M8B	3/4"	2#14, 1#14G	JB ● EXHAUST FAN REF-3	PUSHBUTTON STATION	
1M9	3/4"	3#12, 2#14, 1#12G	MCC-1	JB ● EXH. FAN REF-5	
1M9A	3/4"	3#12, 1#12G	JB ● EXHAUST FAN REF-5	EXHAUST FAN REF-5	VIA DISC. SW.

CITY OF TAMPA WASTEWATER DEPARTMENT
YBOR PUMPING STATION REHABILITATION

ELECTRICAL

SCHEDULES

FILE: YBOREE17

NO. E17

DATE JUNE 2011



GREELEY AND HANSEN

1715 N. WESTSHORE BLVD., STE. 464
TAMPA, FLORIDA 33607
CERTIFICATE OF AUTHORIZATION NO. 37

NO SCALE

DESIGNED RZ
DRAWN OC
CHECKED DD

NO. DATE APPD REVISION

P.E. NAME: NORBERT VIRANYI P.E. NO. 72587

P.E. NAME: _____
DATE: _____


FILE: YBOREE18 1:1 06/21/11 08:56 GH-A

CONDUIT		CONDUCTOR QUANTITY & SIZE	FROM	TO	REMARKS
NUMBER	SIZE				
1M9B	3/4"	2#14, 1#14G	JB ● EXHAUST FAN REF-5	PUSHBUTTONSTATION	
1M10	3/4"	3#12, 2#14, 1#12G	MCC-1	JB ● SUPPLY FAN S-1	
1M10A	3/4"	3#12, 1#12G	JB ● SUPPLY FAN S-1	SUPPLY FAN S-1	VIA DISC. SW.
1M10B	3/4"	2#14, 1#14G	JB ● SUPPLY FAN S-1	PUSHBUTTON STATION	
1M11	3/4"	3#12, 2#14, 1#12G	MCC-1	JB ● SUPPLY FAN S-3	
1M11A	3/4"	3#12, 1#12G	JB ● SUPPLY FAN S-3	SUPPLY FAN S-3	VIA DISC. SW.
1M11B	3/4"	2#14, 1#14G	JB ● SUPPLY FAN S-3	PUSHBUTTON STATION	
1M12	3/4"	3#12, 2#14, 1#12G	MCC-1	JB ● EXH. FAN REF-2	
1M12A	3/4"	3#12, 1#12G	JB ● EXHAUST FAN REF-2	EXHAUST FAN REF-2	VIA DISC. SW.
1M12B	3/4"	2#14, 1#14G	JB ● EXHAUST FAN REF-2	PUSHBUTTON STATION	
1M13	3/4"	3#12, 2#14, 1#12G	MCC-1	JB ● EXH. FAN REF-6	
1M13A	3/4"	3#12, 1#12G	JB ● EXHAUST FAN REF-6	EXHAUST FAN REF-6	VIA DISC. SW.
1M13B	3/4"	2#14, 1#14G	JB ● EXHAUST FAN REF-6	PUSHBUTTON STATION	
1M14	3/4"	3#12, 2#14, 1#12G	MCC-1	JB ● SUPPLY FAN S-2	
1M14A	3/4"	3#12, 1#12G	JB ● SUPPLY FAN S-2	SUPPLY FAN S-2	VIA DISC. SW.
1M14B	3/4"	2#14, 1#14G	JB ● SUPPLY FAN S-2	PUSHBUTTON STATION	
1M15	3/4"	3#12, 2#14, 1#12G	MCC-1	JB ● SUMP PUMP SP-1	
1M15A	3/4"	3#12, 1#12G	JB ● SUMP PUMP SP-1	SP-1 DISC. SW.	
1M15B	1"	CABLE BY MANUFACTURER	SP-1 DISC. SW.	SUMP PUMP SP-1	
1M15C	3/4"	3#14, 1#14G	JB ● SUMP PUMP SP-1	SELECTOR SWITCH	
1M15D	1"	CABLE BY MANUFACTURER	JB ● SUMP PUMP SP-1	FLOAT SWITCHES F1, F2	
1M16	1 1/4"	3#6, 1#10G	MCC-1	TRANSFORMER LT1	
1M16A	2"	4#2, 1#8G	TRANSFORMER LT1	LTG. PANEL LP1	
1M17	3/4"	3#12, 1#12G	MCC-1	SUCTION VALVE PSV-2	VIA DISC. SW.
1M17A	3/4"	4#14, 1#14G	SUCTION VALVE PSV-2	PCP	
1M18	3/4"	3#12, 1#12G	MCC-1	SUCTION VALVE PSV-4	VIA DISC. SW.
1M18A	3/4"	4#14, 1#14G	SUCTION VALVE PSV-4	PCP	
1M19	2"	MATCH EXISTING LOAD REQ.	MCC-1	ODOR CONTROL OC-1	
1M20	1"	16#14 (6 SPARE), 1#14G	MCC-1	TEMP CONTROL PANEL TCP	
1M21	3/4"	10#14 (4 SPARE), 1#14G	MCC-1	TEMP CONTROL PANEL TCP	
1M22	3/4"	10#14 (6 SPARE), 1#14G	MCC-1	CP-Y02	
1M23	1 1/4"	3#6, 1#10G	MCC-1	AUTO TRANSFER SWITCH (ATS)	
1M24	3/4"	3#10, 6#14, 1#10G	MCC-1	JB ● AIR COMPRES. AC-3	
1M24A	3/4"	3#10, 1#10G	JB ● AIR COMPRESSOR AC-3	AIR COMPRESSOR AC-3	VIA DISC. SW.
1M24B	3/4"	6#14, 1#14G	JB ● AIR COMPRESSOR AC-3	PUSHBUTTON STATION AND COMPRESSOR PROTECTION	VIA DISC. SW
CONTROL CIRCUITS					
C1A	1 1/2"	38#14 (6 SPARE), 1#14G	SWITCHGEAR SES-1	RBCP	43CS, M-T-M BRKR CS
C1B	1"	20#14, 1#14G	SWITCHGEAR SES-1	RBCP	BUS "A" FDR BRKR CS
C1C	1"	20#14, 1#14G	SWITCHGEAR SES-1	RBCP	BUS "B" FDR BRKR CS
INSTRUMENTATION CIRCUITS					
N1	1"	CAT 5 STP CABLE	CP-Y01	CP-Y02	
N2	1"	CAT 5 STP CABLE	CP-Y01	480V SWGR SES-1 ATS	
N3	1"	3-2/C#16SH	CP-Y02	PLC	
N4	-	EXISTING CABLE	CP-Y01 (BRITEHOUSE ROUTER)	BUBBLER BP-Y01	
				HF CURREN WWTP SCADA	EX CABLE TO PUMP STATION EXTEND AND RECONNECT AS REQUIRED TO NEW CP-Y01
N5	1"	CABLE BY MANUFACTURER	FIT-10	FE-10	
N5A	3/4"	1-2/C#16SH	FIT-10	CP-Y02	
N6	1"	SEE REMARKS	CABLE COMPANY MODEM	CABLE COMPANY POLE	COORDINATE CABLE REQUIREMENTS WITH CABLE COMPANY



GREELEY AND HANSEN

1715 N. WESTSHORE BLVD., STE. 464
TAMPA, FLORIDA 33607
CERTIFICATE OF AUTHORIZATION NO. 37

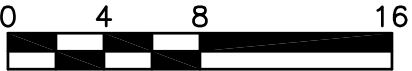

SCALE IN FEET

DESIGNED RZ
DRAWN OC
CHECKED DD

NO.	DATE	APPD	REVISION
P.E. NAME: NORBERT VIRANYI		P.E. NO. 72587	
P.E. NAME:			
DATE:			

CITY OF TAMPA WASTEWATER DEPARTMENT
YBOR PUMPING STATION REHABILITATION

ELECTRICAL


SCHEDULES

FILE: YBOREE18


NO. E18

DATE JUNE 2011

FILE: YBOREE19 1:1 06/21/11 09:32 GH-A

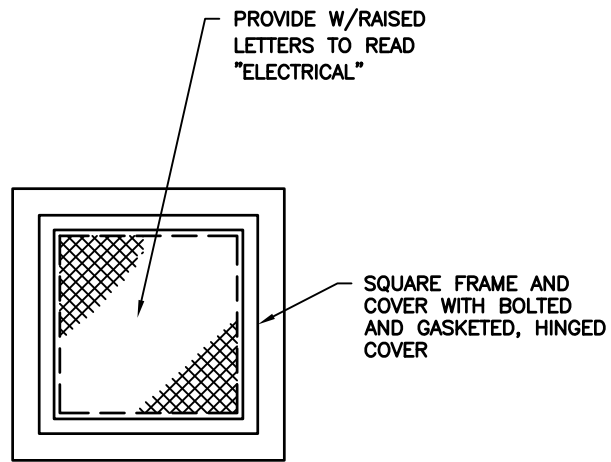


PLAN

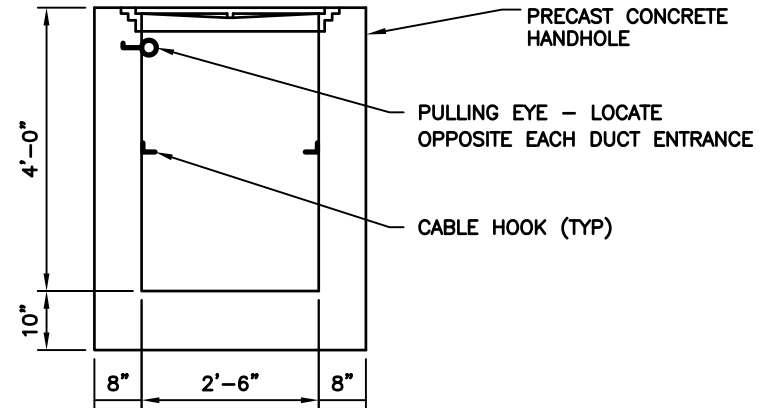


ELEVATION

TYPICAL ELECTRICAL HANDHOLE

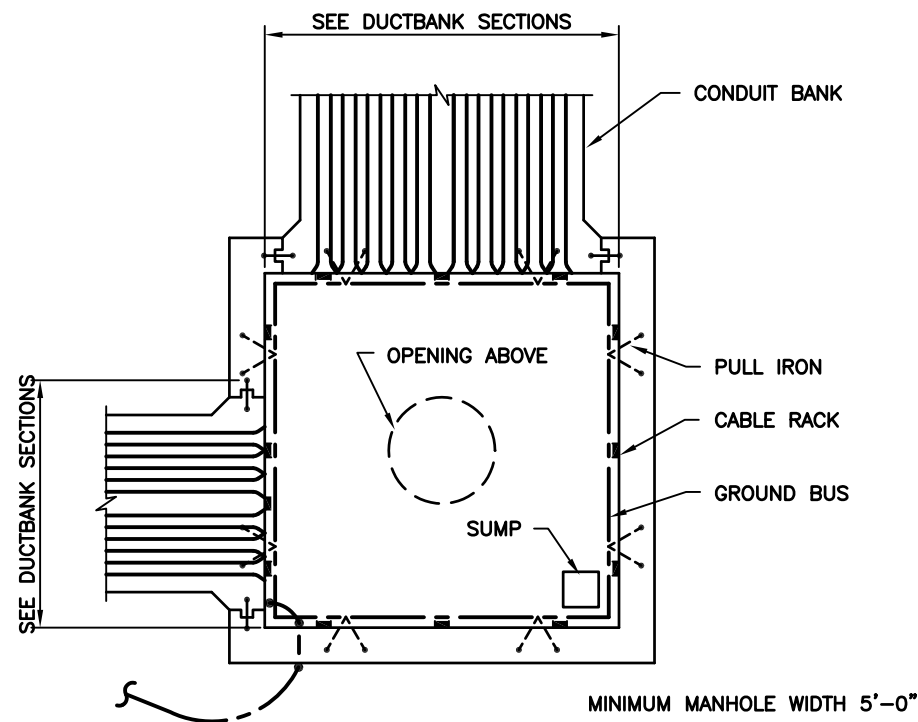

SECTIONAL PLAN

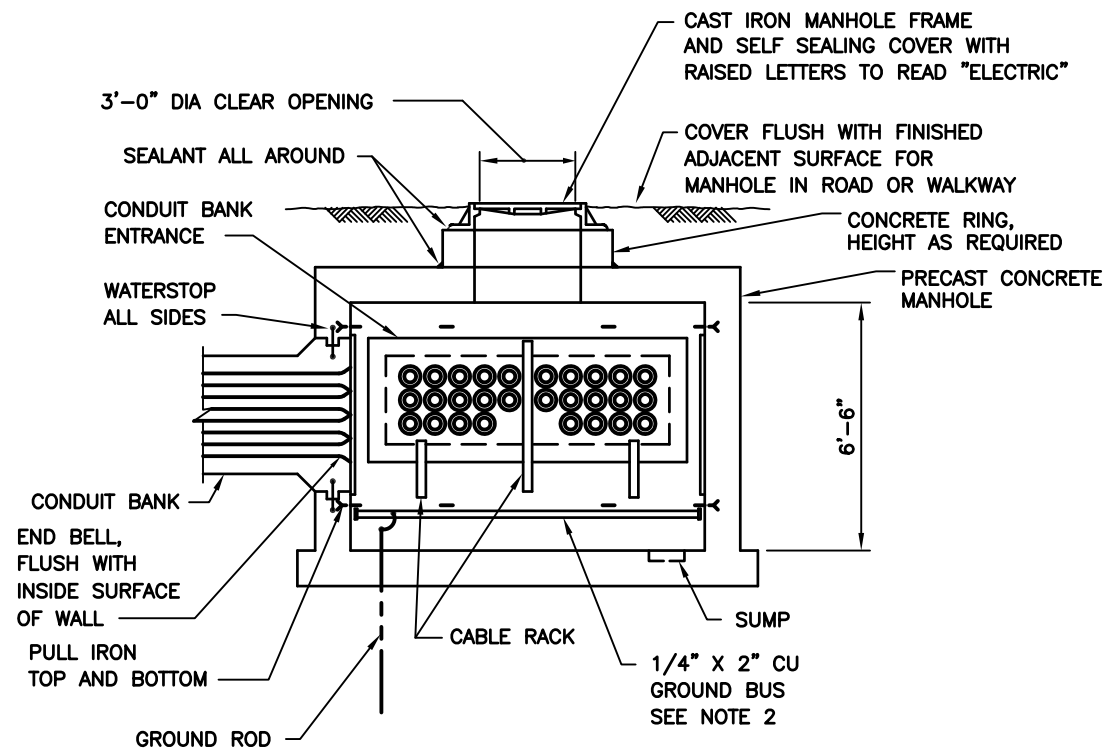

ELEVATION

TYPICAL ELECTRICAL MANHOLE

NOT TO SCALE



GREELEY AND HANSEN

1715 N. WESTSHORE BLVD., STE. 464
TAMPA, FLORIDA 33607
CERTIFICATE OF AUTHORIZATION NO. 37

NOT TO SCALE

DESIGNED RZ
DRAWN TT
CHECKED DD

NO.	DATE	APPD	REVISION
P.E. NAME: NORBERT VIRANYI		P.E. NO. 72587	
P.E. NAME: _____			
DATE: _____			

CITY OF TAMPA WASTEWATER DEPARTMENT
YBOR PUMPING STATION REHABILITATION

ELECTRICAL


DETAILS

FILE: YBOREE19

NO. **E19**

DATE JUNE 2011

FILE: YBOREE20 1:1 06/21/11 09:33 GH-A

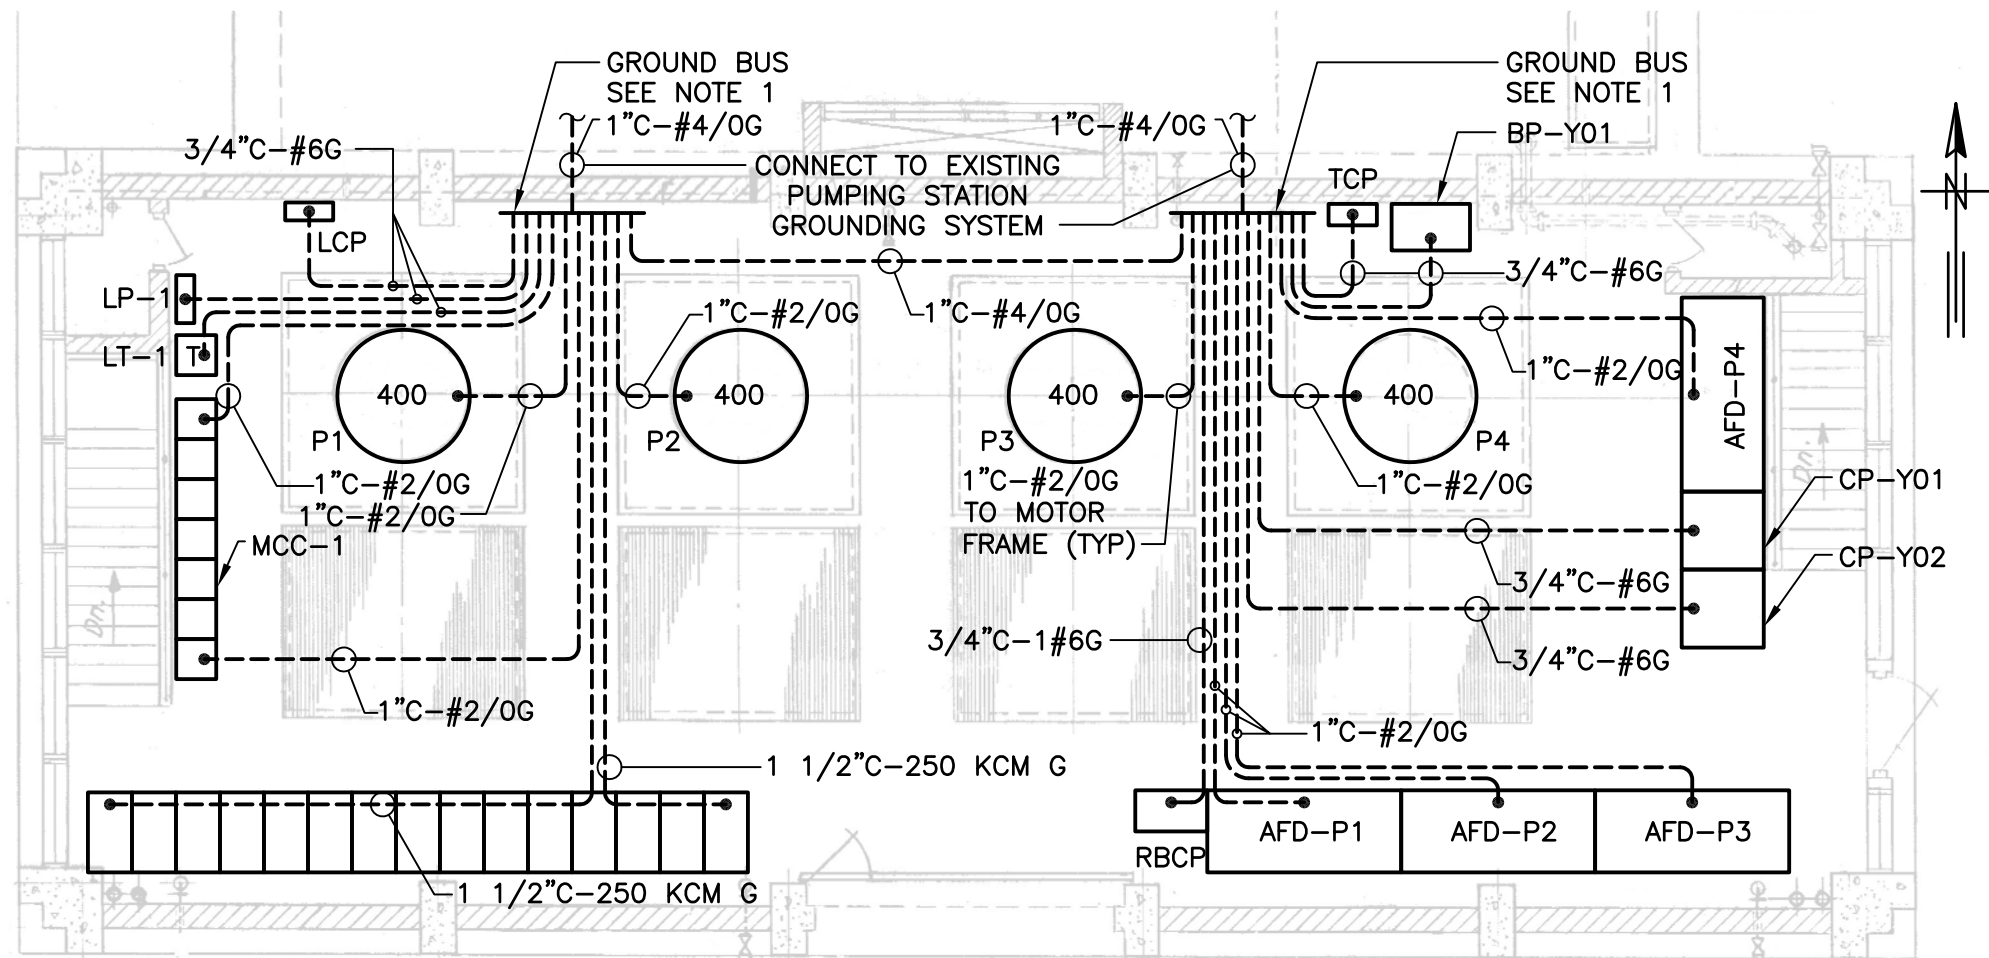

GROUNDING PLAN - FL EL 12.00'

SCALE: 1/8" = 1'-0"


NOTES:

1. PROVIDE A 4"W X 36"L X 1/4" THICK BARE COPPER GROUND BUS WITH STAND OFF INSULATORS. TERMINATE ALL GROUND CABLES USING TWO HOLE BOLTED LUG CONNECTORS.
2. FOR GROUNDING REQUIREMENTS NOT SHOWN ON THIS DRAWING SEE CONDUIT AND CABLE SCHEDULES. WHERE NOT NOTED OR OTHERWISE IDENTIFIED, PROVIDE A MINIMUM OF 3/4" CONDUIT AND #6 BARE COPPER GROUND WIRE.
3. ROUTE ALL CONDUITS SHOWN BELOW FLOOR ELEVATION 12.00'
4. PROVIDE GROUNDING BUSHINGS AT BOTH ENDS OF ALL GROUNDING CONDUITS.



GREELEY AND HANSEN

1715 N. WESTSHORE BLVD., STE. 464
TAMPA, FLORIDA 33607
CERTIFICATE OF AUTHORIZATION NO. 37

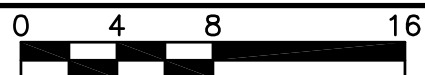

SCALE IN FEET

DESIGNED RZ
DRAWN OC
CHECKED DD

NO.	DATE	APPD	REVISION
P.E. NAME: NORBERT VIRANYI		P.E. NO. 72587	
P.E. NAME:			
DATE:			

CITY OF TAMPA WASTEWATER DEPARTMENT
YBOR PUMPING STATION REHABILITATION

ELECTRICAL

GROUNDING PLAN

FILE: YBOREE20

NO. **E20**

DATE JUNE 2011

INSTRUMENT TAGGING AND LABELING

INSTRUMENT TAG

1000-FIT-1501A

SUFFIX
(IF NEEDED)

SITE IDENTIFIER

1000

DIGESTION FACILITIES

LOOP NUMBER

1501

DEVICE NUMBER

A

FIRST LETTER

F

SUCCESSING LETTERS

IT

1000 IS THE DESIGNATED PREFIX FOR ALL INSTRUMENT LOOPS AND EQUIPMENT TAGS ON THESE DRAWINGS

PSL
XXXX

INSTRUMENT - FIELD MOUNTED

PHS
XXXX

INSTRUMENT - PANEL MOUNTED

FR
XX

AR
XX

SINGLE INSTRUMENT HOUSING CONTAINING TWO (OR MORE) INSTRUMENT FUNCTIONS (CIRCLES TOUCHING)

X
FY
XXXX

INSTRUMENT RELAY MOUNTED IN REAR OF PANEL (BROKEN LINE). ACTIVATES AND DEACTIVATES CONTROL AND/OR ALARM SWITCHES AT PRESET SIGNAL VALUES. SEE BELOW FOR FUNCTIONS (X).

Δ
▽
S/I
I/I
Z
AV
%

DIFFERENCE
HIGH SELECTOR
LOW SELECTOR
FREQUENCY/CURRENT CONVERTER
CURRENT/CURRENT REPEATER (ISOLATOR)
SUMMATION
AVERAGE
RATIO

Z
PSL
XXXX

ANALYSIS INSTRUMENT
SEE BELOW FOR FUNCTIONS (Z)

CH₄-METHANE
Cl₂-SODIUM HYPOCHLORITE
COMB-COMBUSTIBLES
DO-DISSOLVED OXYGEN
FeCl₃-FERRIC CHLORIDE
F-FLUORIDE
H₂S-HYDROGEN SULFIDE
H₃PO₄-PHOSPHORIC ACID
H₂SO₄-SULFURIC ACID
Na₂S₂O₅-SODIUM METHA-BISULFITE
NH₃-AMMONIA
O₂-OXYGEN
ORP-OXYDATION REDUCTION POTENTIAL
pH-HYDROGEN ION CONCENTRATION (-LOG)₁₀
PO₄-PHOSPHATE

ACK
AM
CO
COA
ES
FR
FOR
HOA
HOC
LA
LOC
LOR
LOS
LR
MOA
OOA
O/O
OSC
POT
PTT
RS
ROL
R/O
S/R/S
SS
SS/L
1-2
SIL

ACKNOWLEDGE
AUTO-MANUAL
CLOSE-OPEN
CLOSE-OPEN-AUTO
EMERGENCY STOP
FORWARD-REVERSE
FORWARD-OFF-REVERSE
HAND-OFF-AUTO
HAND-OFF-COMPUTER
LOCAL-AUTO
LOCAL-OFF-COMPUTER
LOCAL-OFF-REMOTE
STOP WITH LOCKOUT
LOCAL-REMOTE
MANUAL-OFF-AUTO
ON-OFF-AUTO
ON-OFF
OPEN-STOP-CLOSE
SPEED POTENTIOMETER
PUSH-TO-TEST
RESET
RAISE-OFF-LOWER
RUN-OFF
START-RUN-STOP
START-STOP
START- STOP WITH LOCKOUT
SELECT DEVICE 1 OR 2
SILENCE

INDICATING LIGHT UNIT

ALARM LIGHT OR ANNUNCIATOR

PUSHBUTTON

HAND CONTROL

HAND (MANUAL) SELECTOR SWITCH.

FUNCTION LEGEND FOR HAND SWITCH AND PUSHBUTTON CONTROLS

CONTROL SYSTEM INPUTS AND OUTPUTS

DISCRETE INPUT

ANALOG INPUT

DISCRETE OUTPUT

ANALOG OUTPUT

INSTRUMENT IDENTIFICATION LETTERS
ISA 55.1 MODIFIED

FIRST LETTER		SUCCEEDING LETTERS		
MEASURED OR INITIATING VARIABLE	MODIFIER	READOUT OR PASSIVE FUNCTION	OUTPUT FUNCTION	MODIFIER
A ANALYSIS,		ALARM		
B BURNER FLAME			CLOSE, STOP, DECREASE	OFF
C CONDUCTIVITY (ELECTRICAL)	COMPUTER		CONTROL	
D DENSITY (MASS) OR SPECIFIC GRAVITY	DIFFERENTIAL		OPEN, START, INCREASE	
E VOLTAGE (EMF)		PRIMARY ELEMENT		
F FLOW RATE	RATIO (FRACTION)		FORWARD	FAIL
G MOISTURE		GAUGE, GLASS, GATE		
H HAND (MANUALLY INITIATED)				HIGH, OPEN
I CURRENT (ELECTRICAL)		INDICATE		
J POWER	SCAN			
K TIME OR TIME SCHEDULE	TIME RATE OF CHANGE		CONTROL STATION	
L LEVEL		LIGHT		LOW, CLOSED
M MOISTURE, MOTOR	MANUAL	MOMENTARY	MOTOR	MIDDLE OR INTERMEDIATE
N INTRUSION				ON, OPERATE, RUNNING
O		ORIFICE (RESTRICTION)		OVERLOAD
P PRESSURE OR VACUUM		POINT (TEST CONNECTION)	PUMP	
Q QUANTITY	INTEGRATE OR TOTALIZE			
R RADIOACTIVITY		RECORD	REVERSE	
S SPEED, FREQUENCY, MOTION	SAFETY		SWITCH	STOP
T TEMPERATURE			TRANSMIT	
U MULTIVARIABLE		MULTIFUNCTION	MULTIFUNCTION	MULTIFUNCTION
V VIBRATION, VALVE			VALVE, DAMPER OR LOUVER	
W WEIGHT, FORCE, TORQUE		WELL		
X UNCLASSIFIED	X AXIS	UNCLASSIFIED	UNCLASSIFIED	UNCLASSIFIED
Y EVENT, STATE, PRESENCE	Y AXIS		RELAY OR COMPUTE	
Z POSITION, DIMENSION	Z AXIS		DRIVE, ACTUATE OR UNCLASSIFIED FINAL CONTROL ELEMENT	

MISC INSTRUMENT SYMBOLS

STROBE LIGHT/ROTATING BEACON
A = AMBER R = RED
W = WHITE G = GREEN

ALARM HORN

MAGNETIC FLOW METER

ULTRASONIC (DOPPLER) FLOW METER

VENTURI METER

FLUME

VORTEX SHEDDING FLOW METER

PD TYPE FLOW METER

STANDARD OFF-LINE DIAPHRAGM SEAL

ANNULAR TYPE DIAPHRAGM SEAL

ULTRASONIC LEVEL ELEMENT

FLOAT SWITCH

RADAR LEVEL ELEMENT

VALVE SYMBOLS

DIAPHRAGM VALVE (N.O.)

DIAPHRAGM VALVE (N.C.)

GATE VALVE

KNIFE GATE VALVE

GLOBE VALVE

PLUG VALVE

BUTTERFLY VALVE (N.O.)

BUTTERFLY VALVE (N.C.)

BALL VALVE (N.O.)

BALL VALVE (N.C.)

CHECK VALVE

PINCH VALVE

HOSE/COUPLING CONNECTION

3-WAY VALVE

RELIEF VALVE

PRESSURE REGULATING VALVE

BACKPRESSURE REGULATING VALVE

SOLENOID VALVE

4-WAY SOL VALVE

LINE SYMBOLS

MAIN PROCESS LINE

AUXILIARY SYSTEMS

ELECTRIC (ELECTRONIC) SIGNAL

TWO-WIRE VALVE ACTUATOR LINK

DATA LINK

PNEUMATIC SIGNAL

CAPILLARY LINE

HYDRAULIC SIGNAL

HEAT TRACED AND INSULATED

AIR PURGE SET

AIR SUPPLY

ELECTRICAL SUPPLY
ES = VOLTAGE

PROCESS FLOW LINE CONTINUED TO/FROM ANOTHER DRAWING.

PROCESS SIGNAL LINE CONTINUED TO/FROM ANOTHER DRAWING.

* = DRAWING REFERENCE
N = INTERFACE ID

PROCESS FLOW LINE CONTINUED OUTSIDE SCOPE OF DRAWINGS

AUXILIARY SYSTEM FLOW

PROCESS AND EQUIPMENT SYMBOLS

PULSATION DAMPENER OR ACCUMULATOR

DAMPER

ELECTRIC MOTOR ACTUATOR

ELECTRIC MOTOR ACTUATOR WITH FLOOR-STAND

DIAPHRAGM ACTUATOR

CYLINDER ACTUATOR
XX: FO FAIL OPEN
FC FAIL CLOSED
FLP FAIL LAST POSITION
NOTE: PILOT SOLENOID VALVE FOR CYLINDER ACTUATOR NOT SHOWN UNLESS NEEDED FOR CLARITY

SOLENOID ACTUATOR

ROTAMETER (FLOW INDICATOR)

CALIBRATION COLUMN

ELECTRIC MIXER

SLUICE GATE OR SLIDE GATE
SG = SLUICE GATE
SLG = SLIDE GATE

CENTRIFUGAL PUMP
VS = VARIABLE SPEED

CENTRIFUGAL TYPE FAN/COMPRESSOR/BLOWER

PD BLOWER/COMPRESSOR (ROTARY)

PD BLOWER/COMPRESSOR (RECIPROCATING)


PROGRESSIVE CAVITY PUMP

CHEMICAL METERING PUMP

SUBMERSIBLE PUMP
VS = VARIABLE SPEED

SCREW PUMP

DRAIN

**GREELEY AND HANSEN**

1715 N. WESTSHORE BLVD., STE. 464
TAMPA, FLORIDA 33607
CERTIFICATE OF AUTHORIZATION NO. 37

NO SCALE

DESIGNED TRG
DRAWN TRG
CHECKED DCH

NO. DATE APPD REVISION

P.E. NAME: NORBERT VIRANYI P.E. NO. 72587
P.E. NAME: _____
DATE: _____

CITY OF TAMPA WASTEWATER DEPARTMENT
YBOR PUMPING STATION REHABILITATION

INSTRUMENTATION AND CONTROL

LEGEND AND SYMBOLS


FILE: YBOREI01

NO. 11


DATE JUNE 2011




ITEM	DESCRIPTION	LEGEND	COMMENT
1	NAMEPLATE	BUBBLER PANEL BP-Y01	
2	NAMEPLATE	INLET VAULT LEVEL	
3	NAMEPLATE	WEST WET WELL LEVEL	
4	NAMEPLATE	EAST WET WELL LEVEL	
5	BARGRAPH INDICATOR	--	TYP OF 3
6	DIGITAL INDICATOR	--	TYP OF 3

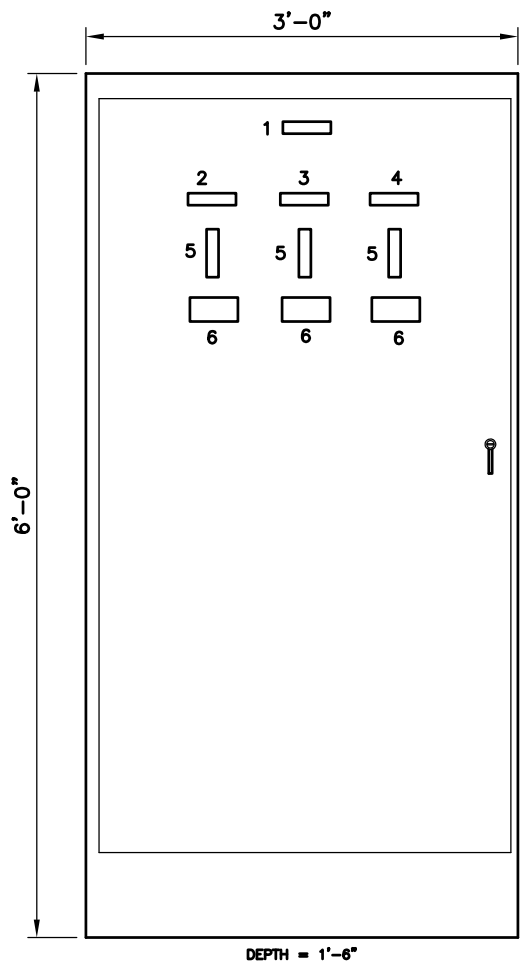

BUBBLER PANEL BP-Y01
NOT TO SCALE

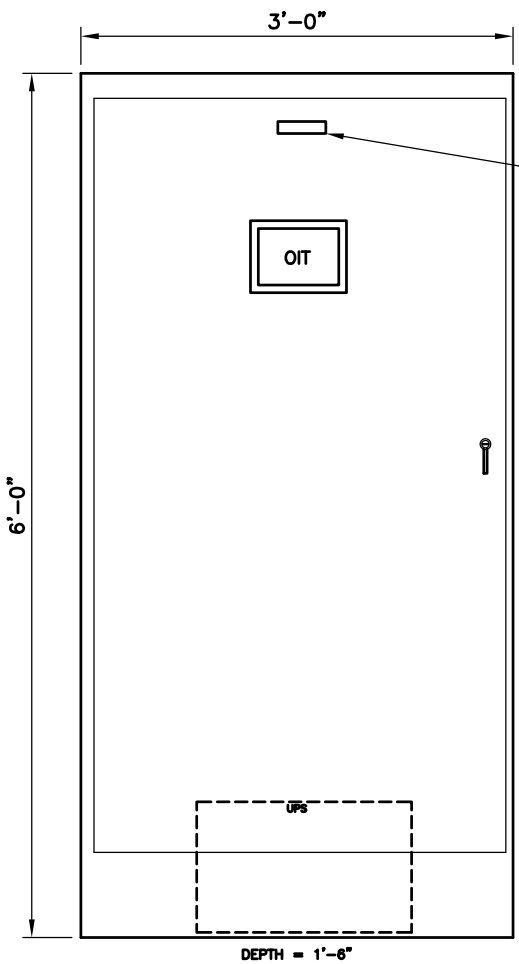

SCADA PLC PANEL CP-Y01
NOT TO SCALE

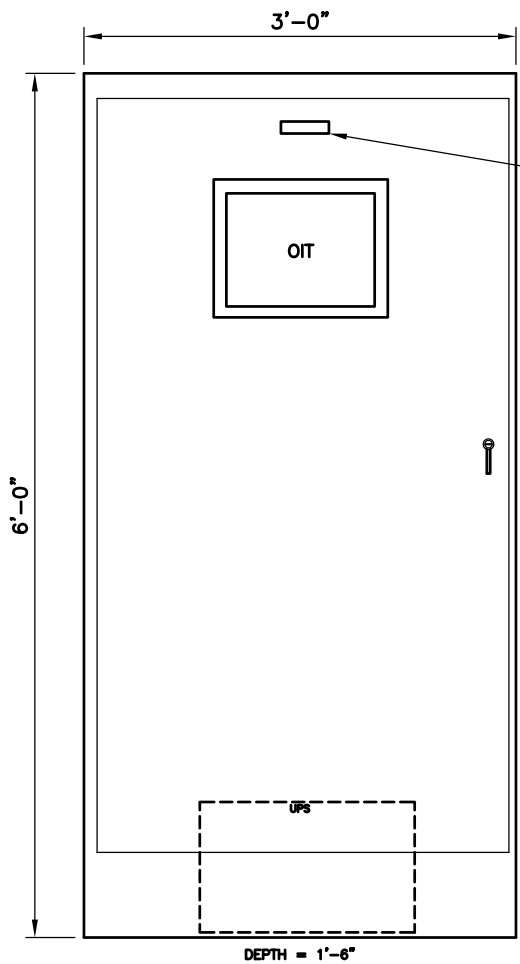

PUMP CONTROL PLC PANEL CP-Y02
NOT TO SCALE